




FED. ROAD DIST. NO.	STATE	PROJ. NO.	FISCAL YEAR	SHEET NO.	TOTAL SHEETS
HAWAII	HAW.	99D-01-17	2022	17	35

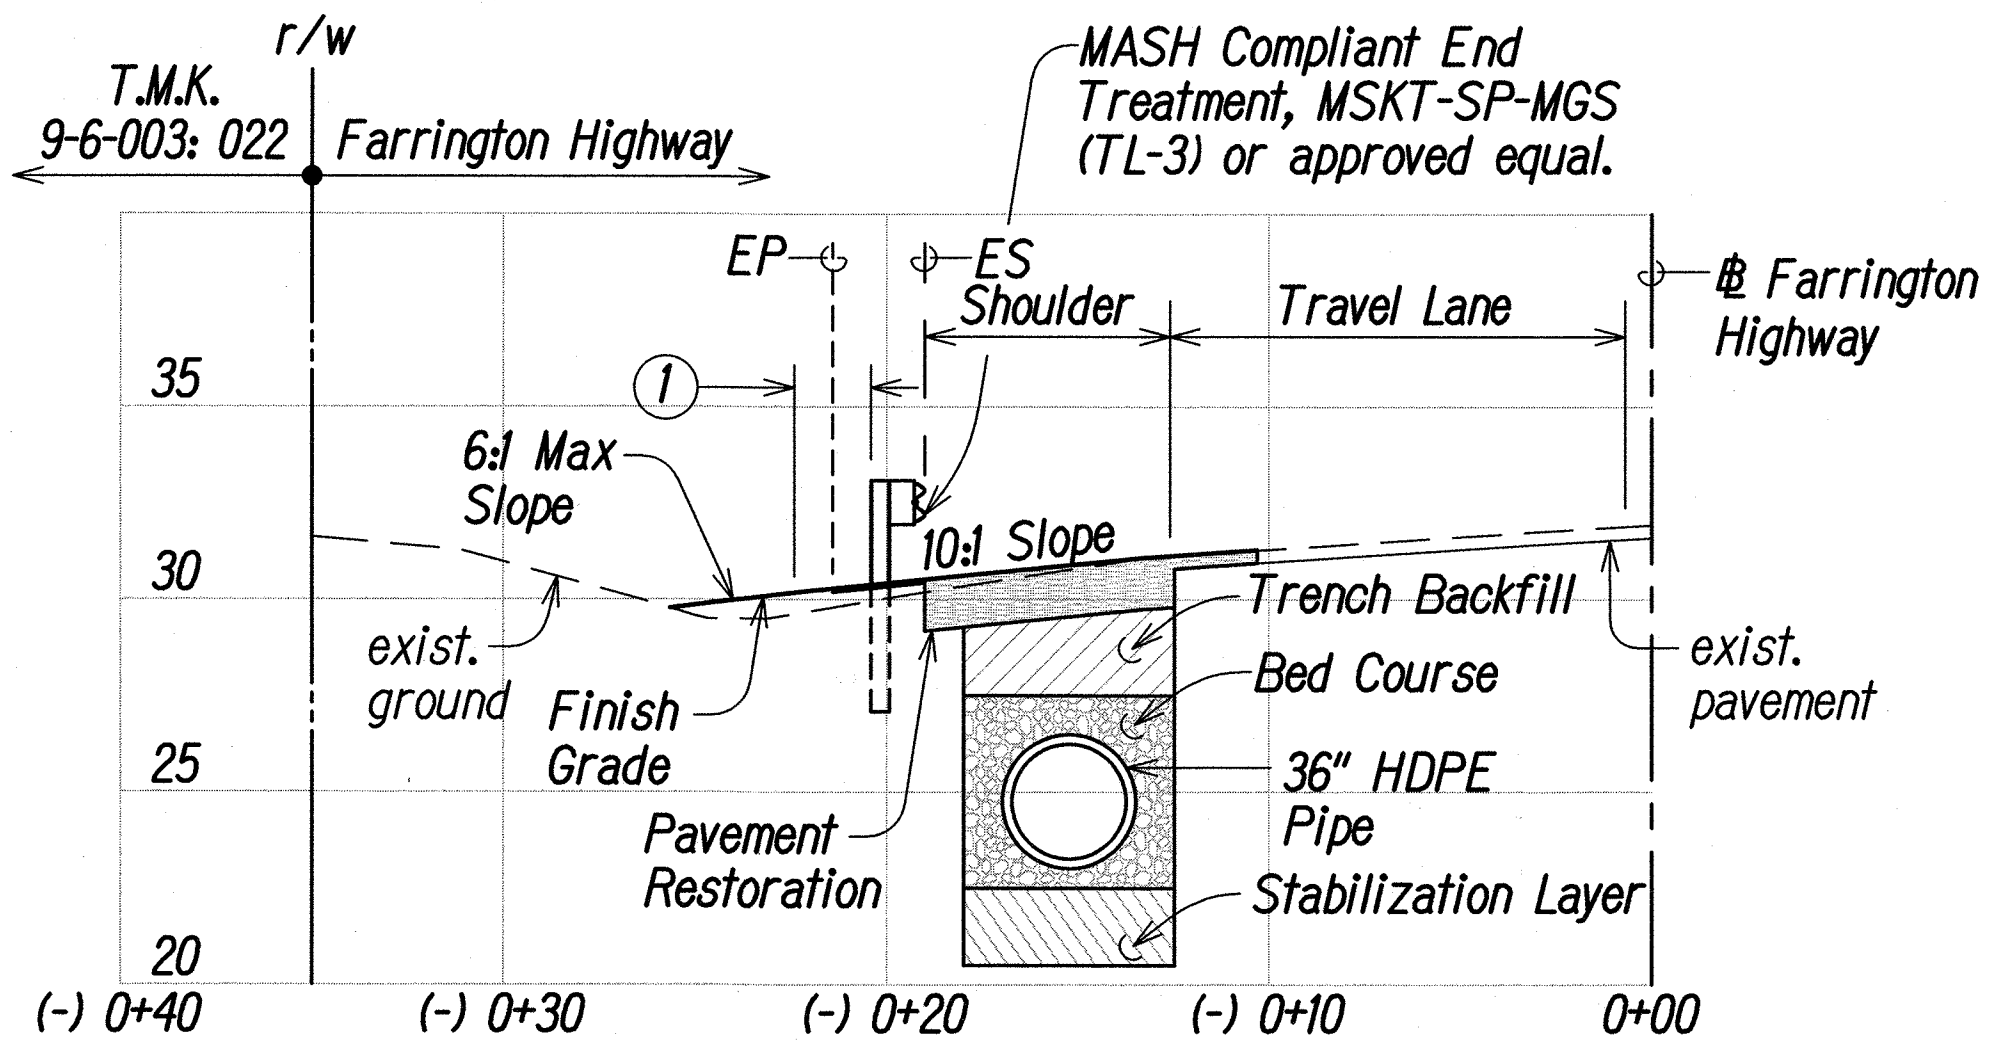


SECTION A
Scale: 1" = 5'

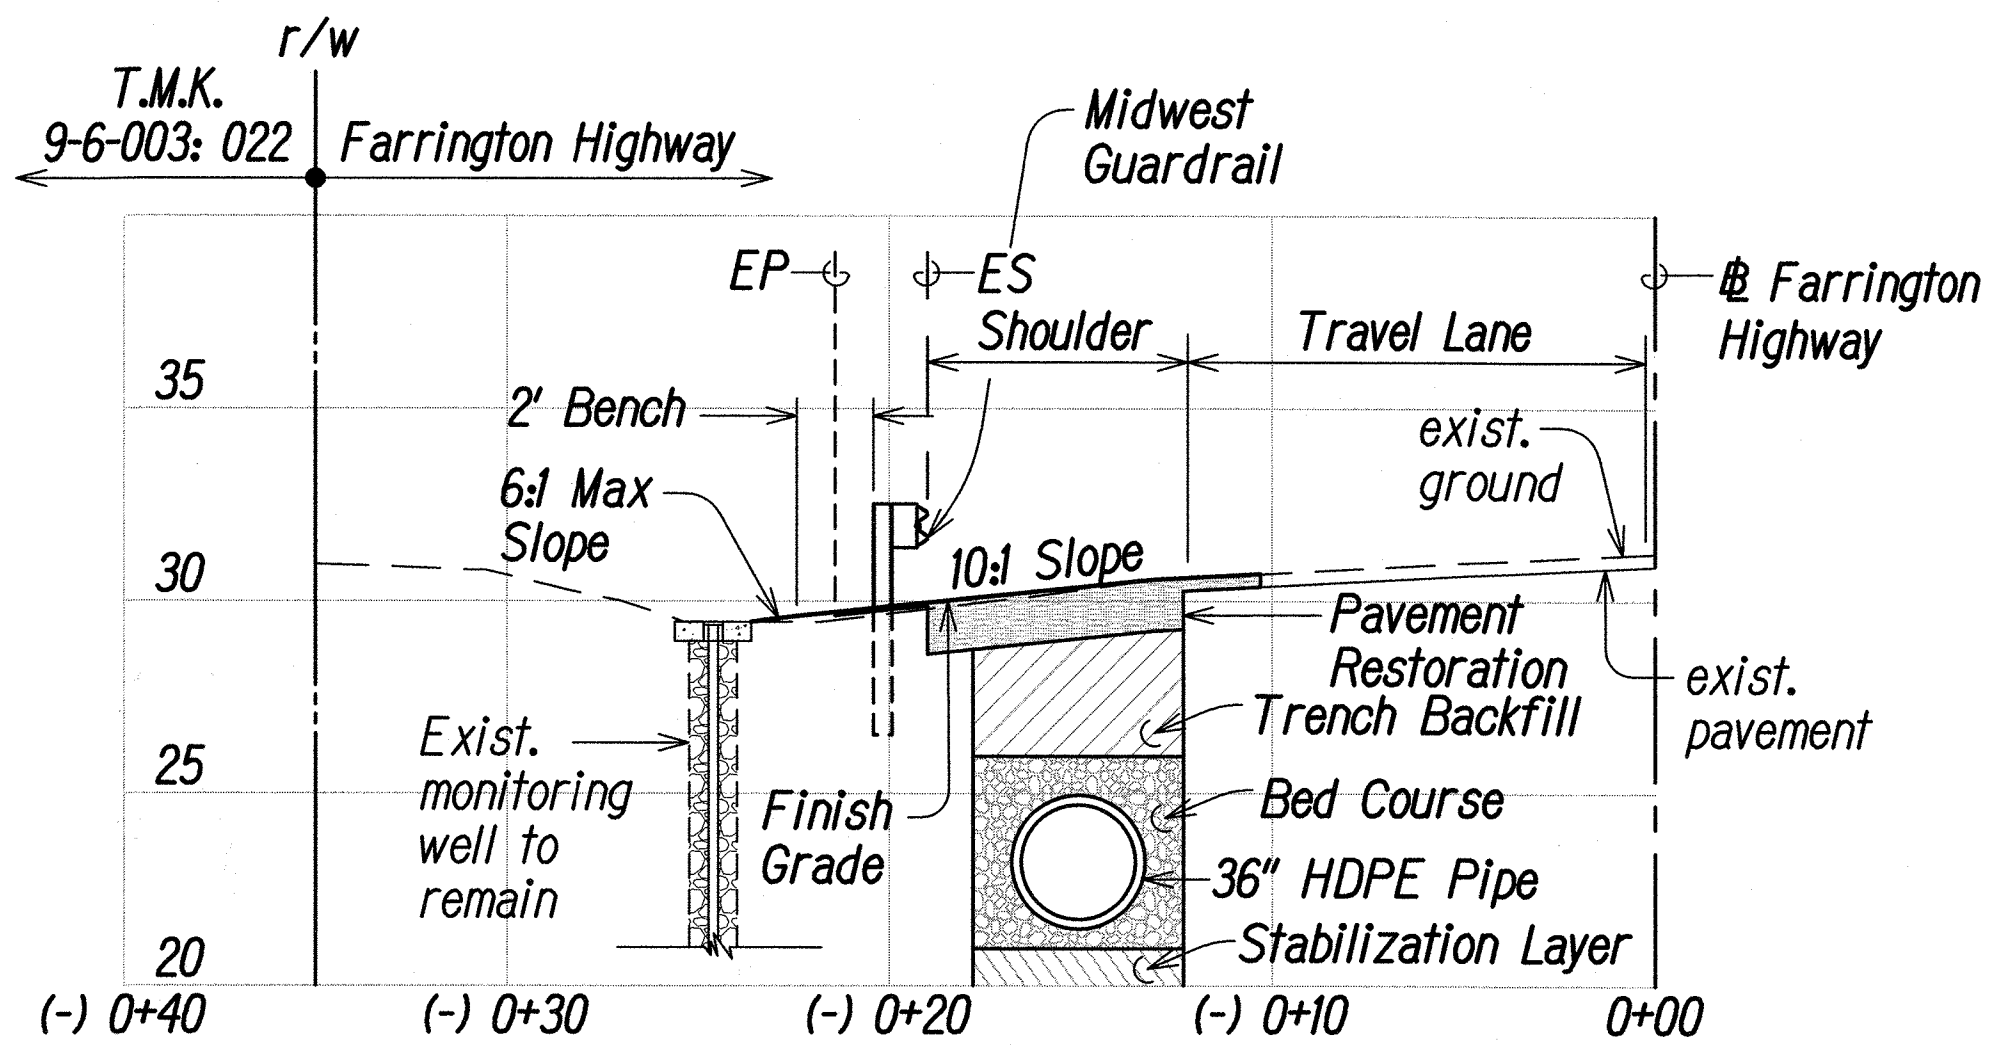


SECTION B
Scale: 1" = 5'

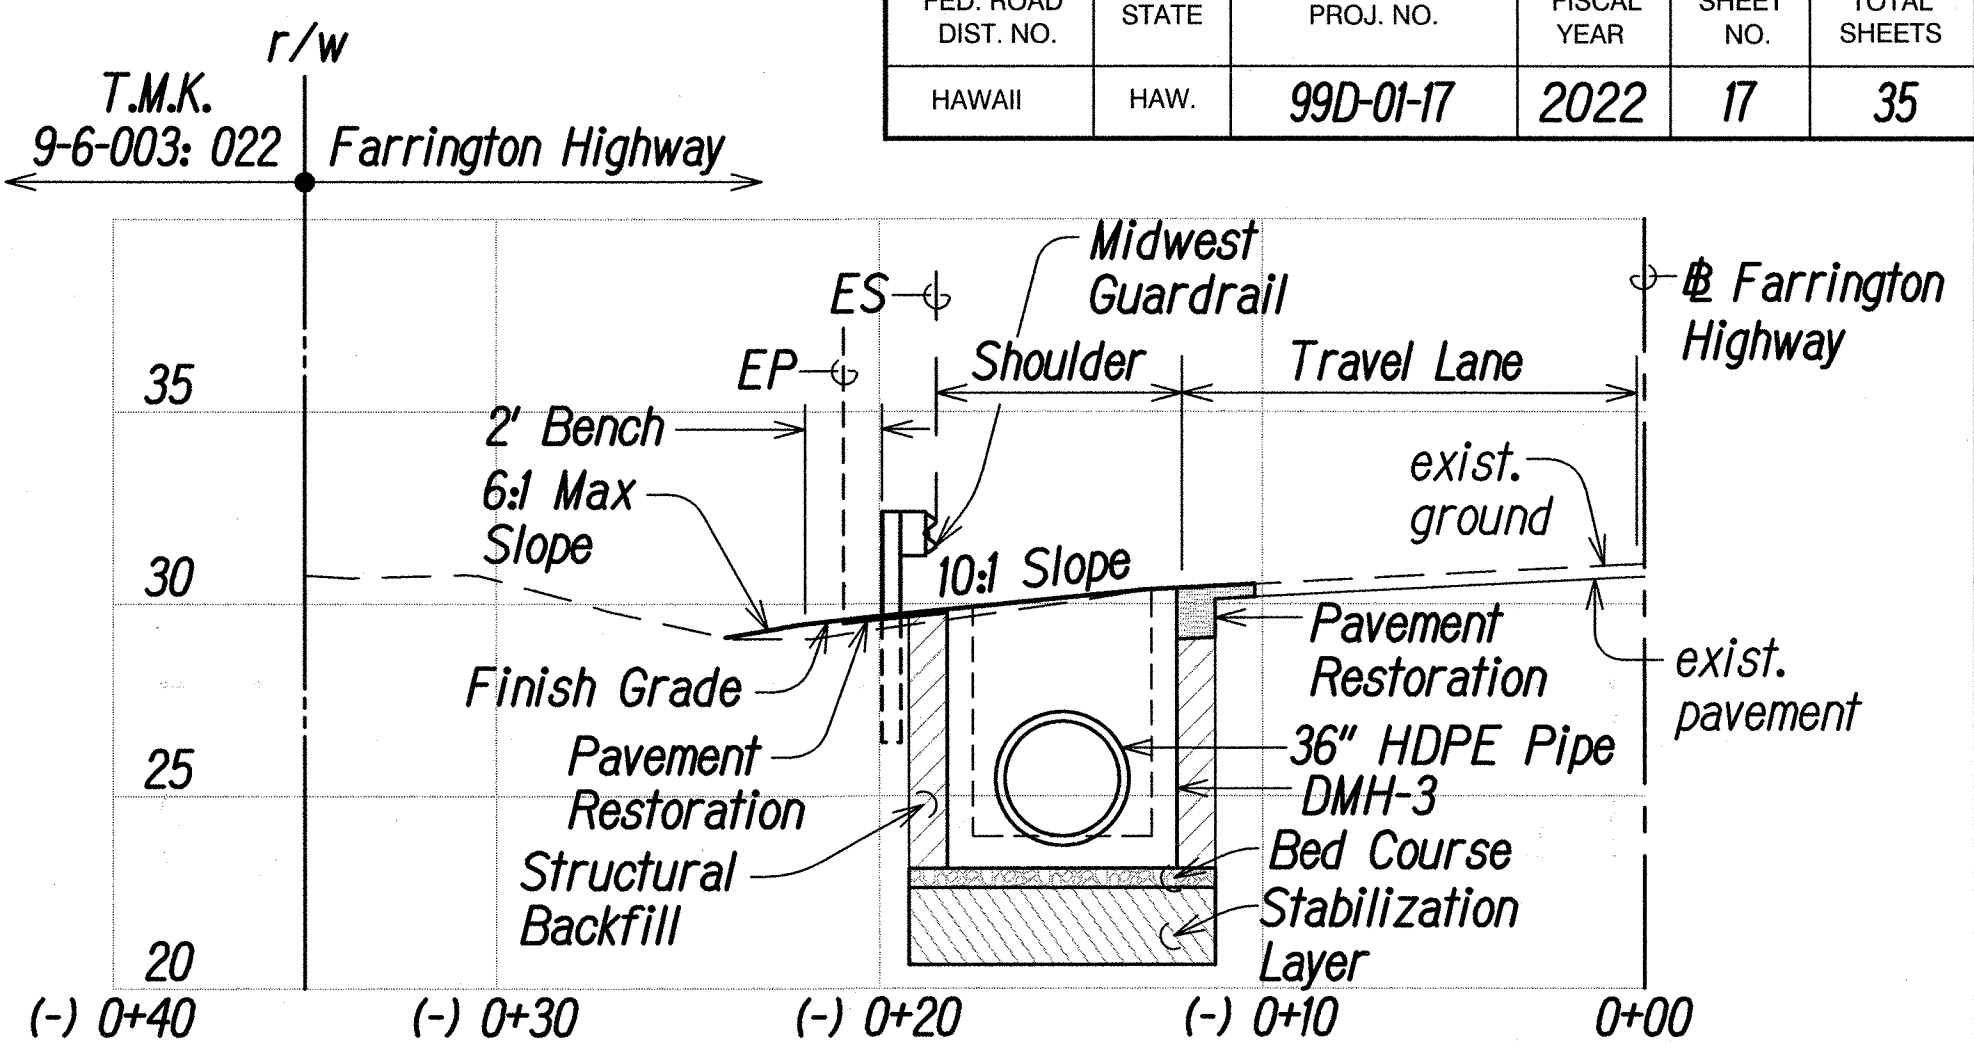

SECTION C
Scale: 1" = 5'

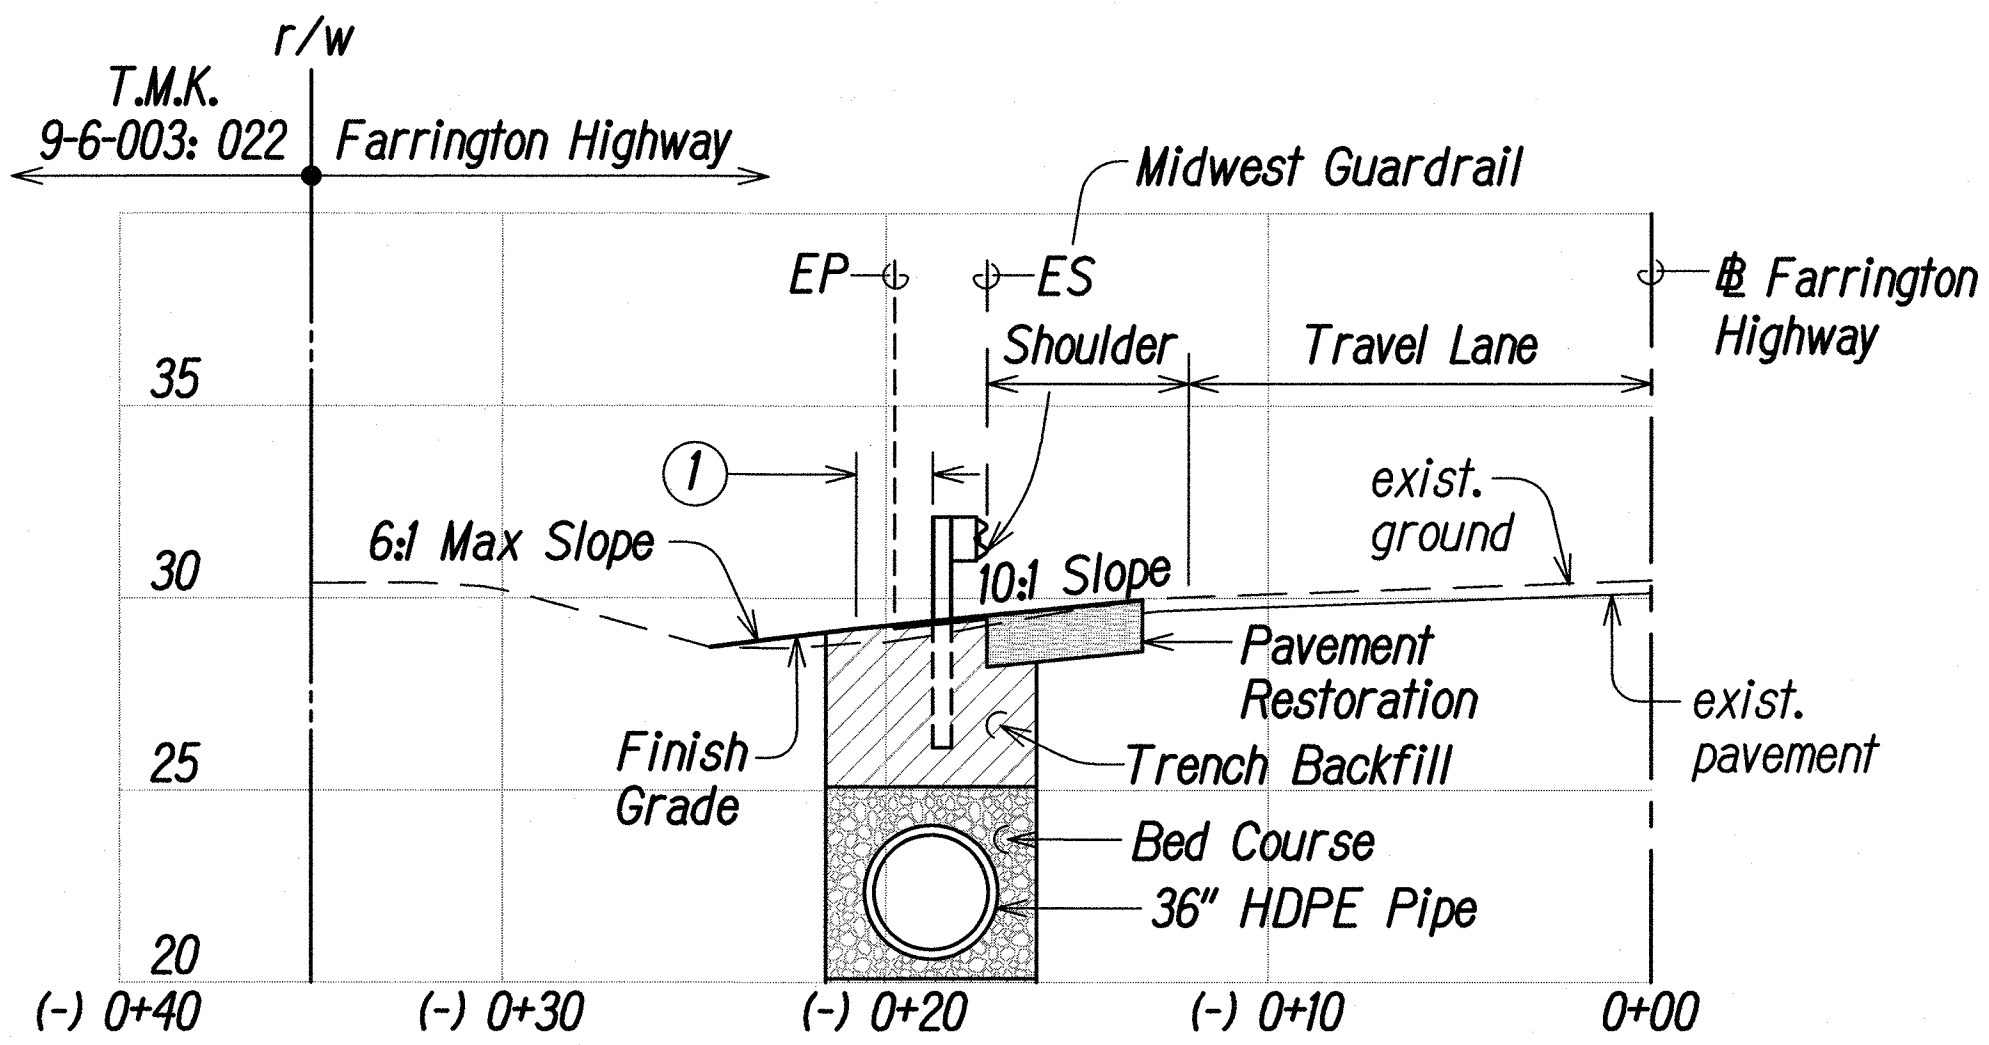

SECTION D
Scale: 1" = 5'

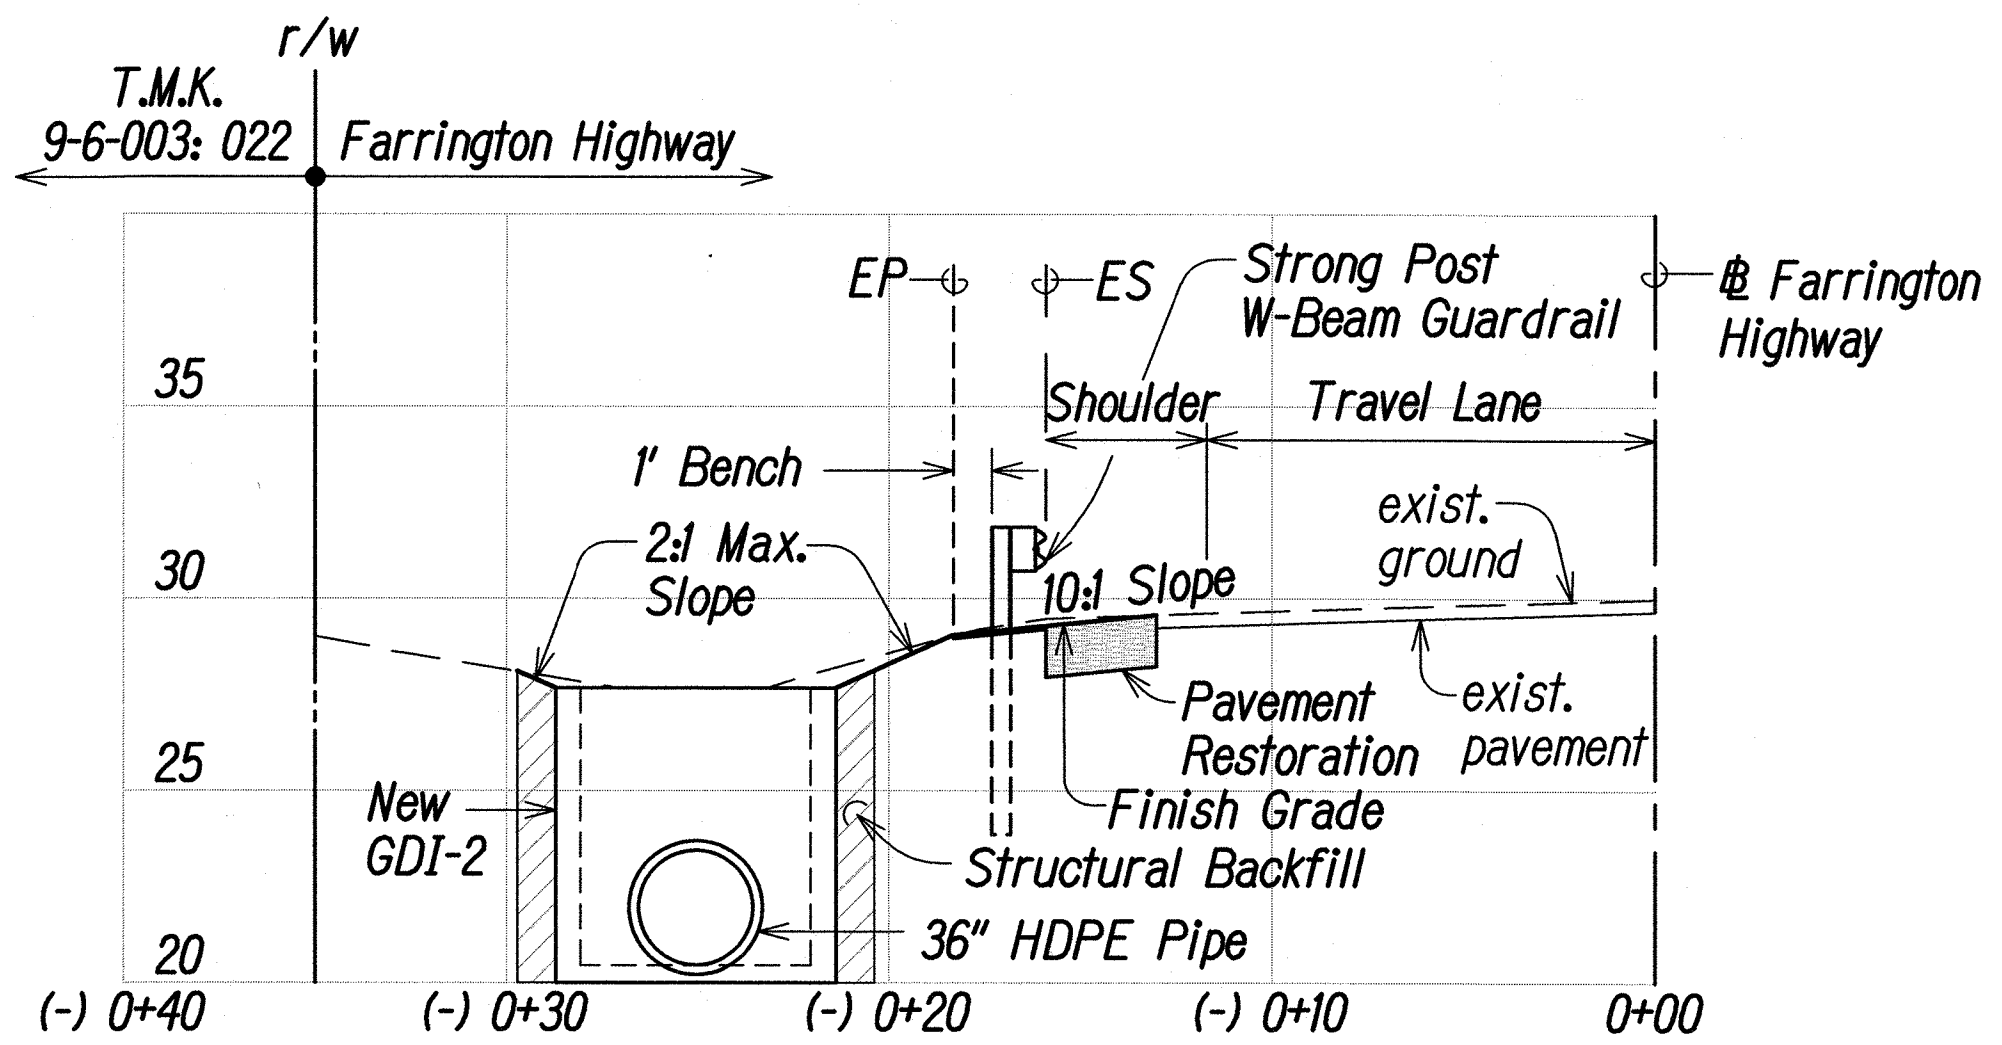

SECTION E
Scale: 1" = 5'

Note:

- 5' Bench (@ Sta. 19+62.81 to 19+85)
2' Bench (@ Sta. 19+85 to 20+74)
Bench Varies (@ Sta. 20+74 to 20+79)
1' Bench (@ Sta. 20+79 to 21+09.60)
- 10:1 Max. Slope within Bench Area.



THIS WORK WAS PREPARED BY ME
OR UNDER MY SUPERVISION.

Russell M. Arakawa
Farrington, Inc.
d/b/a PARK ENGINEERING

APRIL 30, 2022
LIC. EXP. DATE

STATE OF HAWAII
DEPARTMENT OF TRANSPORTATION
HIGHWAYS DIVISION

GUARDRAIL SECTIONS

FARRINGTON HIGHWAY
Drainage Improvements
Vicinity of Leeward Community College
PROJECT NO. 99D-01-17

Scale: As Shown Date: June 2021

SHEET No. GR2 OF GR6 SHEETS

SURVEY PLOTTED BY	DATE
DRAWN BY	
DESIGNED BY	
NOTED BY	
CHECKED BY	
ORIGINAL PLAN	
NOTE BOOK	
No.	