



INDEX TO DRAWINGS	
SHEET NO.	DESCRIPTION
1	TITLE SHEET
2	STANDARD PLANS SUMMARY
3-4	GENERAL NOTES
5	LEGEND & ABBREVIATIONS
6-8	WATER POLLUTION, EROSION CONTROL AND BMP NOTES AND DETAILS
9	EROSION CONTROL PLAN
10	DEMOLITION PLAN
11 ①	ROADWAY PLAN
12	DRAINAGE PLAN AND PROFILE
13	DRAINAGE OUTLET PLAN
14 ②	DRAINAGE DETAILS
15	DRAINAGE SECTIONS
16	GUARDRAIL PLAN
17	GUARDRAIL SECTIONS
18-21	GUARDRAIL DETAILS AND NOTES
22 ③	TRAFFIC CONTROL PLAN - 1
23 ④	TRAFFIC CONTROL PLAN - 2
24	STRIPING PLAN
25	STRIPING NOTES AND DETAILS
26	INDEX TO STRUCTURAL DRAWINGS
27	STRUCTURAL GENERAL NOTES
28	SYMBOLS AND ABBREVIATIONS
29-31	TYPICAL DETAILS
32	OUTLET PLAN
33-34	OUTLET SECTION
35	TYPICAL WINGWALL REINFORCING AND BACKFILL SECTION

STATE OF HAWAII  
DEPARTMENT OF TRANSPORTATION  
HIGHWAYS DIVISION  
HONOLULU, HAWAII  
**"AS-BUILT"**  
PLANS FOR  
**FARRINGTON HIGHWAY  
DRAINAGE IMPROVEMENTS**  
**VICINITY OF LEEWARD COMMUNITY COLLEGE**  
**PROJECT NO. 99D-01-17**

DISTRICT OF EWA  
ISLAND OF OAHU

TOTAL GROUND  
DISTURBANCE AREA: 0.39 ACRES

FED. ROAD DIST. NO.	STATE	PROJ. NO.	FISCAL YEAR	SHEET NO.	TOTAL SHEETS
HAWAII	HAW.	99D-01-17	2022	1	35

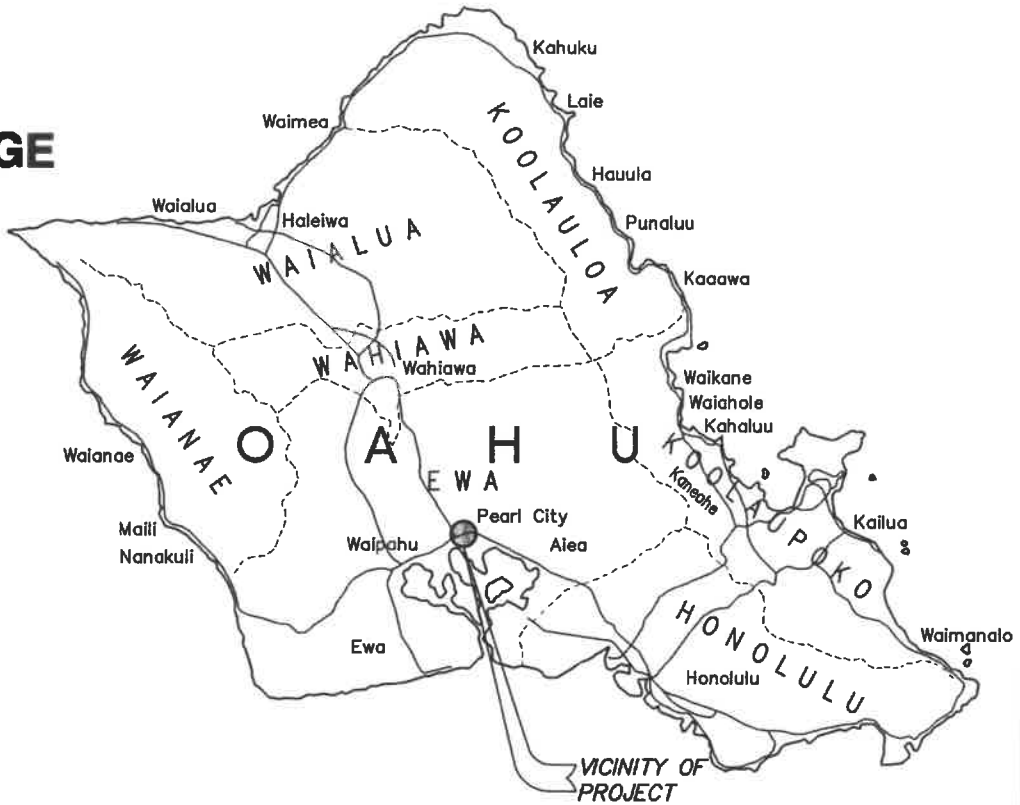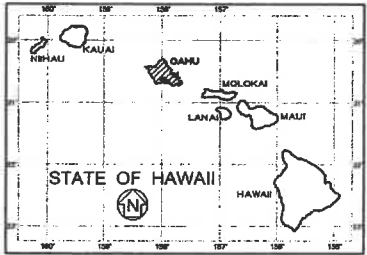


VICINITY MAP  
NOT TO SCALE  
SCALE IN MILES  
4 0 4 8

**FIELD POSTED  
AS-BUILT**  
Certified By: Sam Ramos, Project Engineer  
Integrated Construction, Inc.  
Date: November 30, 2022



DEPARTMENT OF TRANSPORTATION  
STATE OF HAWAII  
APPROVED:   
Nov 17, 2021  
DIR. OF TRANSPORTATION DATE

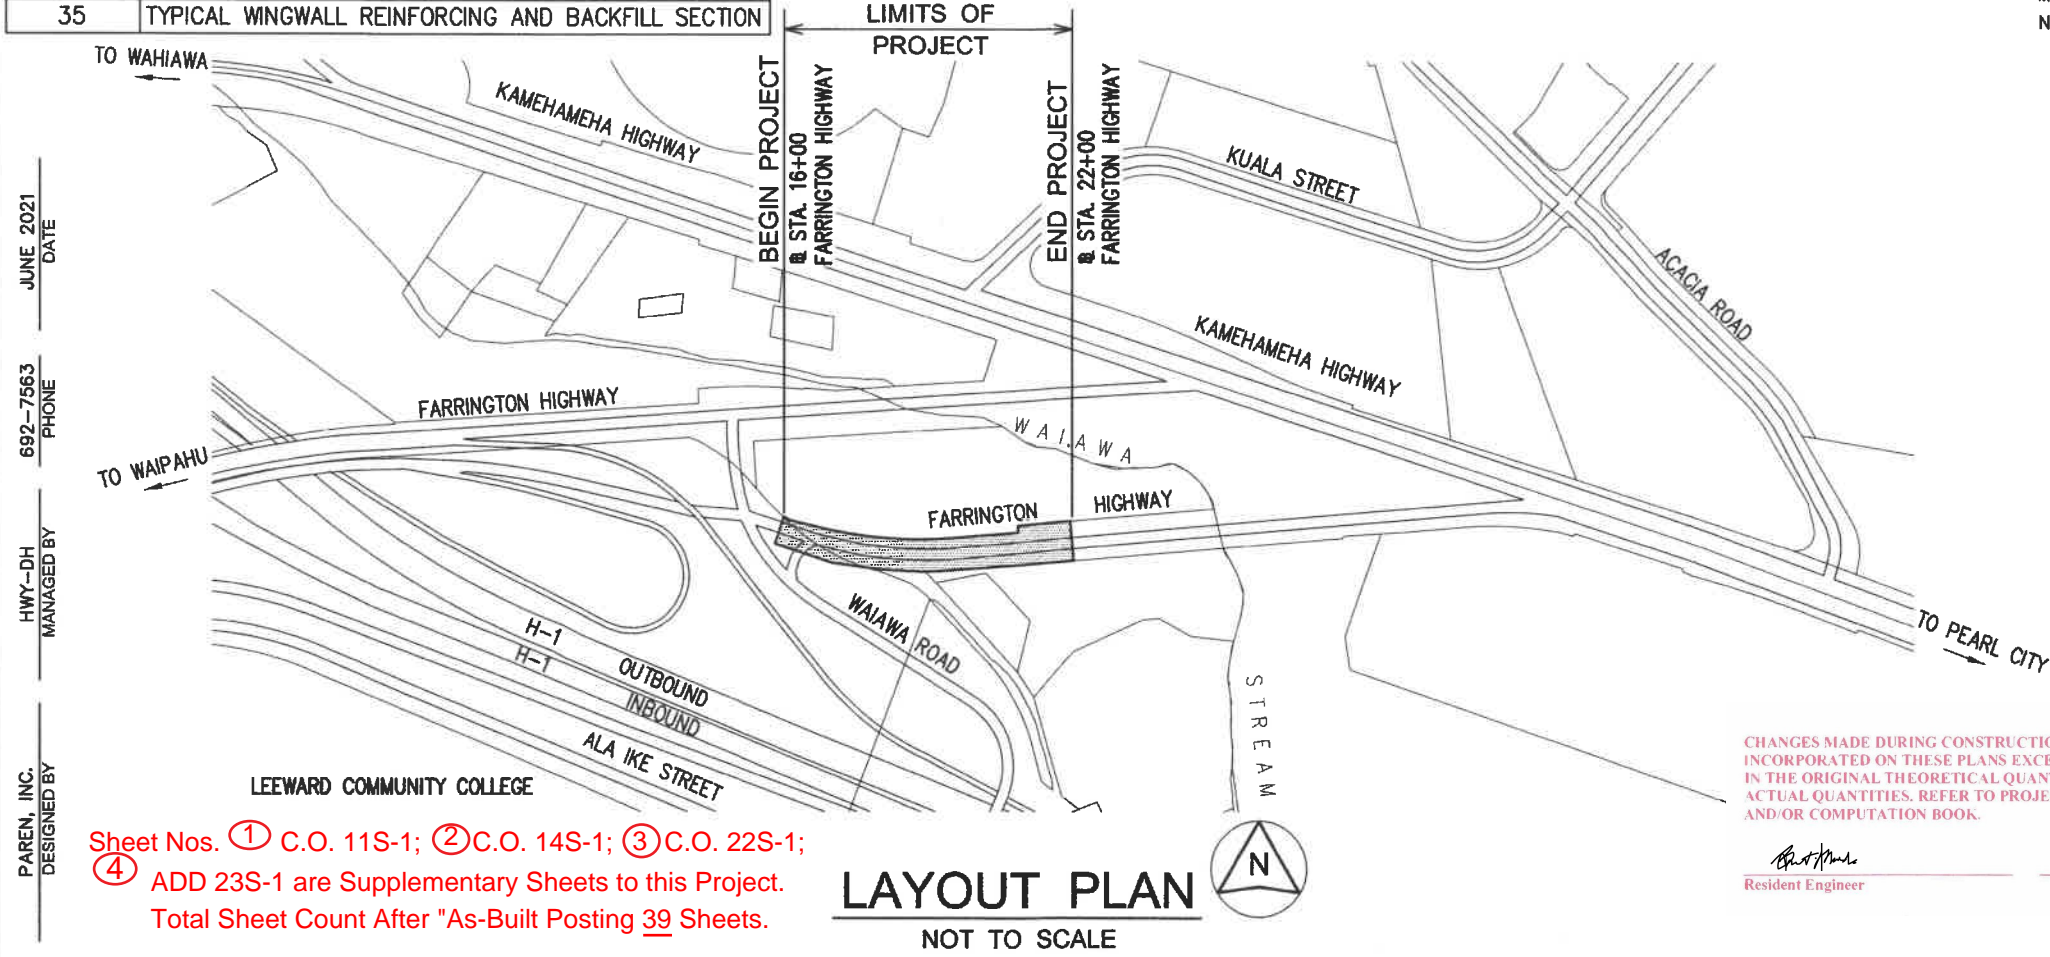

Sheet Nos. ① C.O. 11S-1; ② C.O. 14S-1; ③ C.O. 22S-1;  
④ ADD 23S-1 are Supplementary Sheets to this Project.  
Total Sheet Count After "As-Built Posting 39 Sheets.

**LAYOUT PLAN**  
NOT TO SCALE

CHANGES MADE DURING CONSTRUCTION HAVE BEEN  
INCORPORATED ON THESE PLANS EXCEPT CHANGES  
IN THE ORIGINAL THEORETICAL QUANTITIES. FOR  
ACTUAL QUANTITIES, REFER TO PROJECT LEDGER  
AND/OR COMPUTATION BOOK.

Resident Engineer 1/25/23 Date

THIS WORK WAS PREPARED BY ME  
OR UNDER MY SUPERVISION.  
  
Russell M. Araki  
PAREN, INC. APR 30, 2022  
LIC. EXP. DATE

JUNE 2021 DATE  
692-7563 PHONE  
HWY-DH MANAGED BY  
PAREN, INC. DESIGNED BY