


FED. ROAD DIST. NO.	STATE	FED. AID PROJ. NO.	FISCAL YEAR	SHEET NO.	TOTAL SHEETS
HAWAII	HAW.	I-HI(73):15	1974	269	369

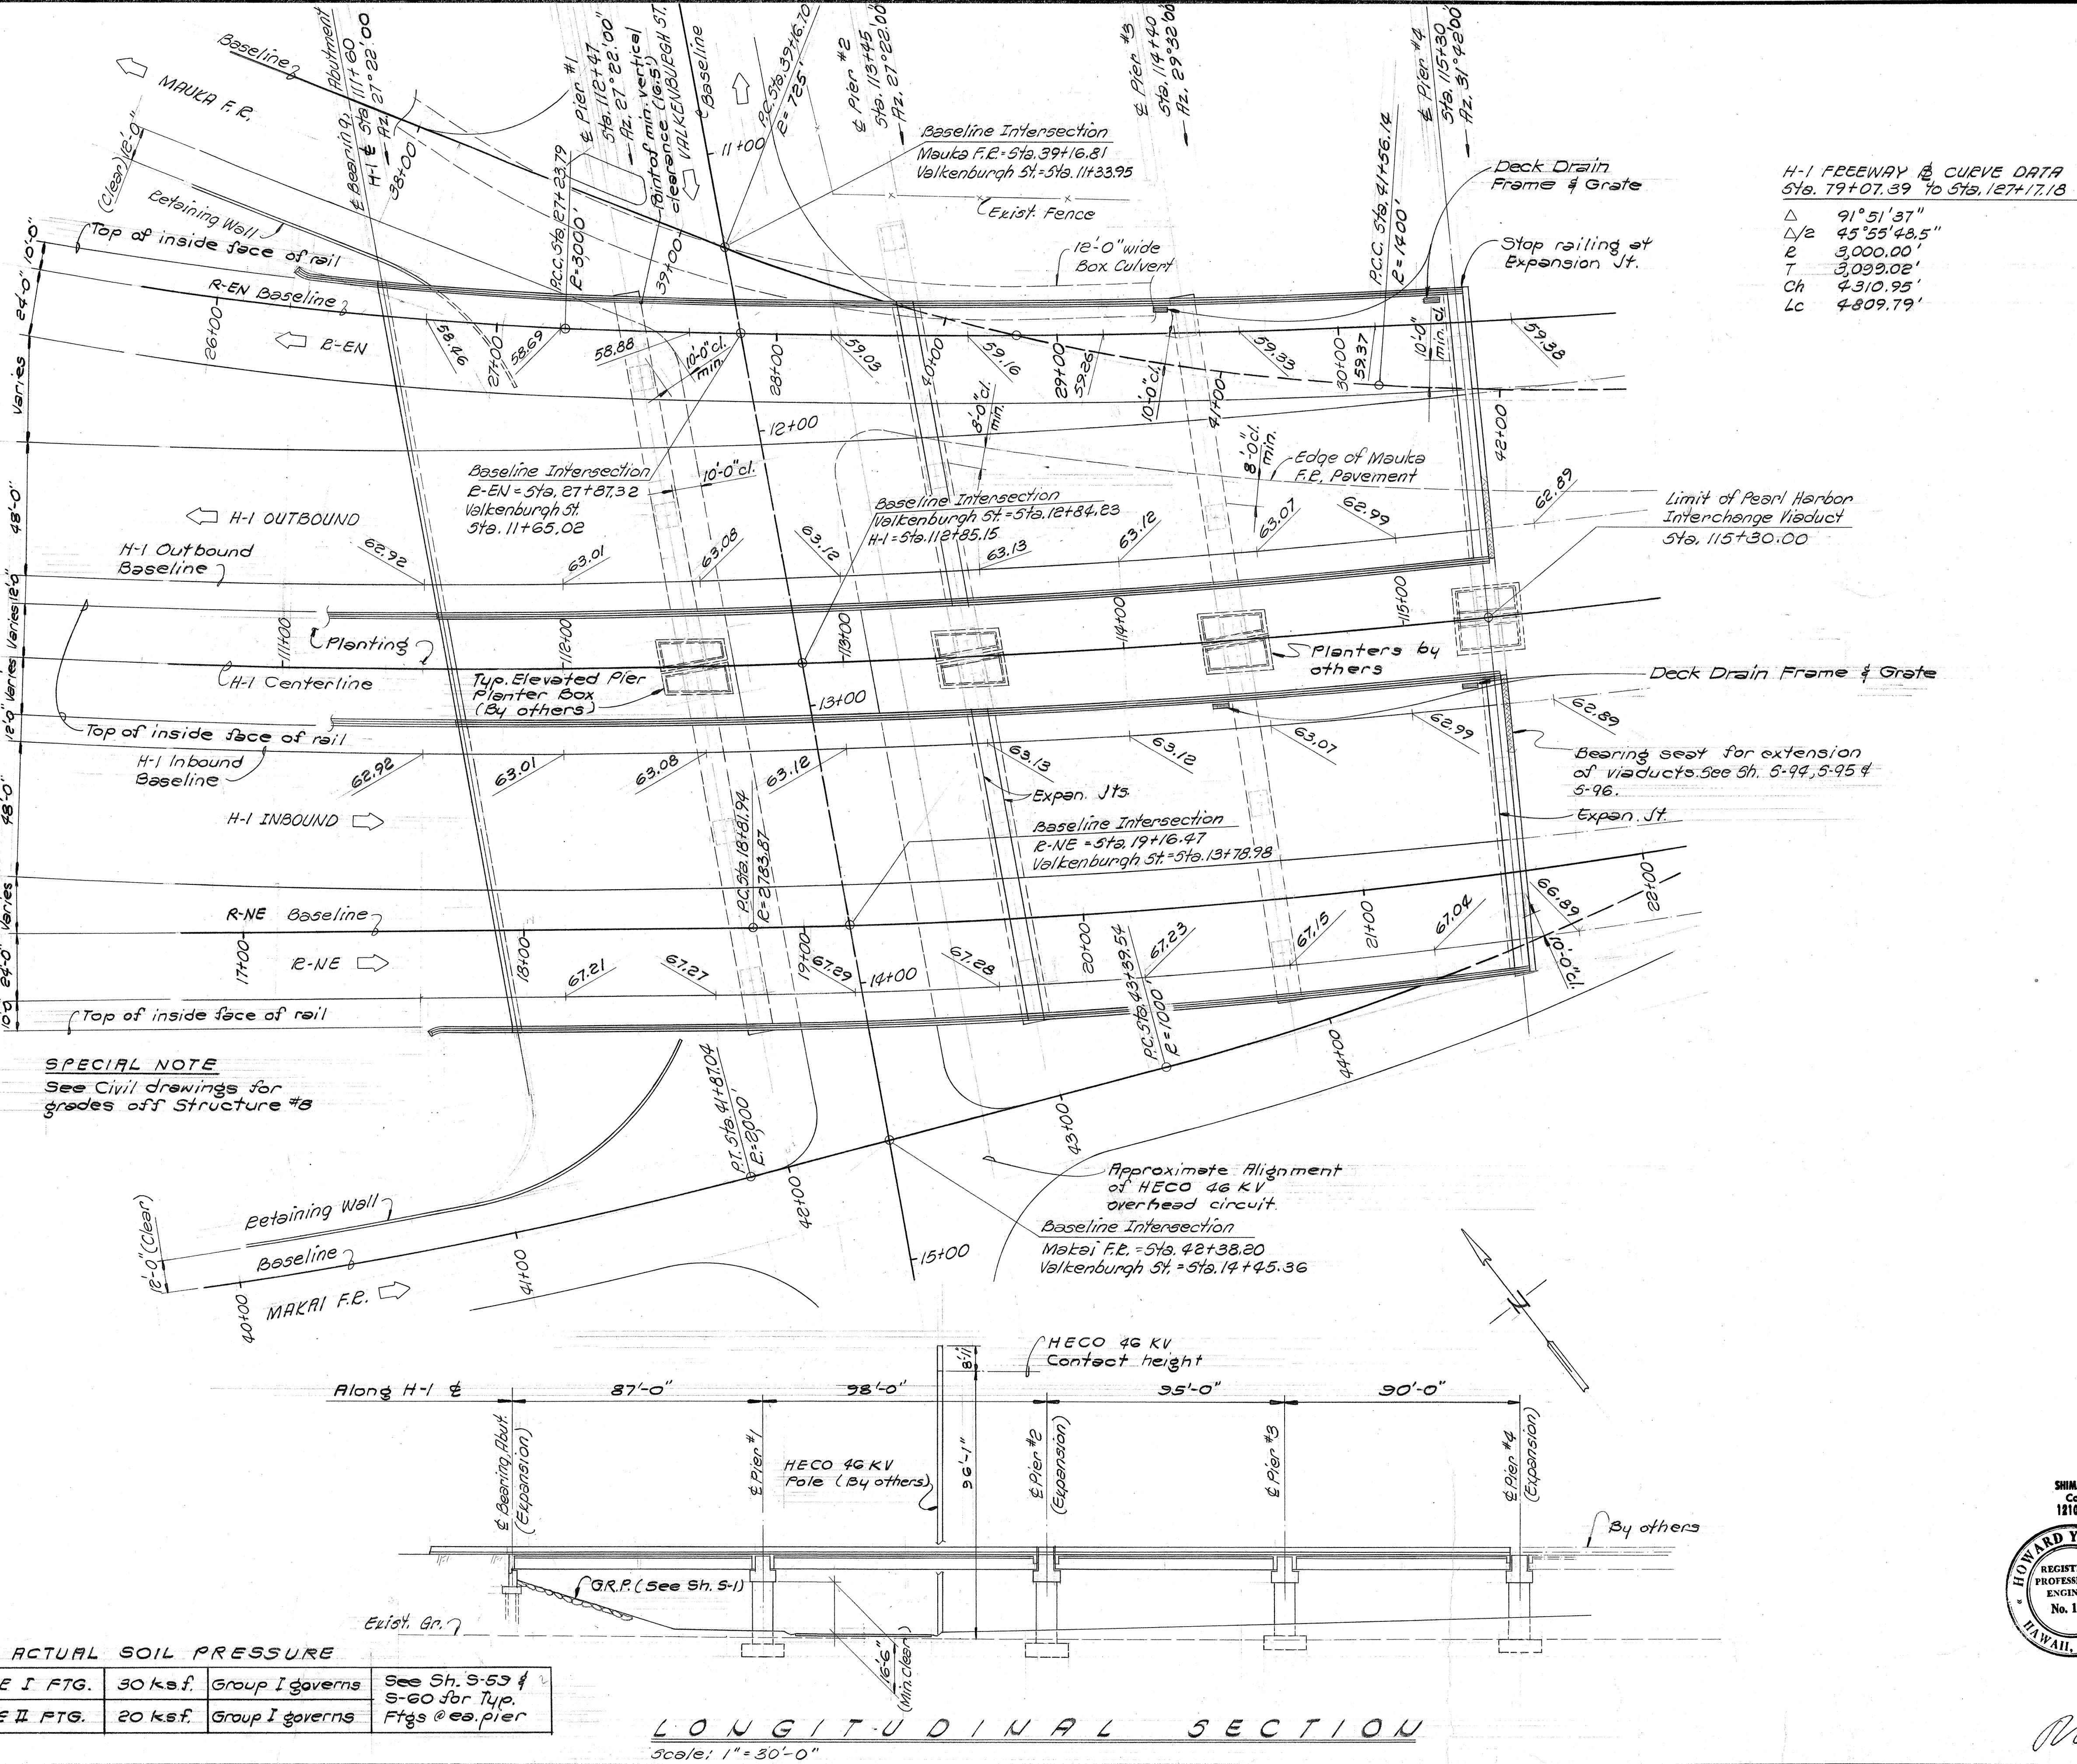

H-1 FREEWAY & CURVE DATA
Sta. 79+07.39 to Sta. 127+17.18

△ 91°51'37"
△/2 45°55'48.5"
E 3,000.00'
T 3,099.02'
Ch 4310.95'
Lc 4809.79'

RAMP EN & CURVE DATA
Sta. 23+82.99 to Sta. 27+23.79

△ 13°08'00"
△/2 6°34'00"
E 1986.78'
T 290.75'
Ch 340.05'
Lc 578.80'
Lc 579.70'


RAMP NE & CURVE DATA
Sta. 18+81.94 to Sta. 26+37.76

△ 15°33'21"
△/2 7°46'40.5"
E 2783.87'
T 380.25'
Ch 753.50'
Lc 755.82

AIRPORT VIADUCT
19 -

NAME & DATE OF STRUCTURE

6/3/74
REALIGNED PLANTER BOXES & REVISED NOTE CONCERNING BEARING SEAT FOR VIADUCT EXTENSION

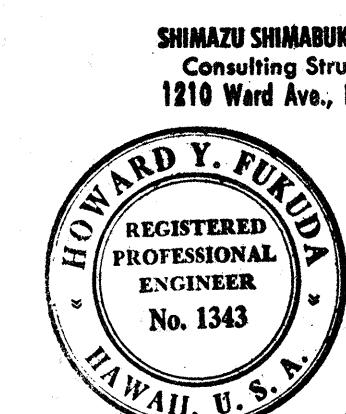

DATE 6/3/74
REVISION

STATE OF HAWAII
DEPARTMENT OF TRANSPORTATION
HIGHWAYS DIVISION

STRUCTURE No.8


LAYOUT PLAN
& LONGITUDINAL SECTION

PEARL HARBOR INTERCHANGE
F.A.I. Proj. No 1-HI-1 (73):15

Scale: As Shown Date: DEC. 7/1973

SHEET No. 5-55 OF 106 SHEETS

FED. ROAD DIST. NO.	STATE	FED. AID PROJ. NO.	FISCAL YEAR	HEET NO.	TOTAL SHEETS
HAWAII	HAW.	I-HI-1(73)-1B	1974	270	369

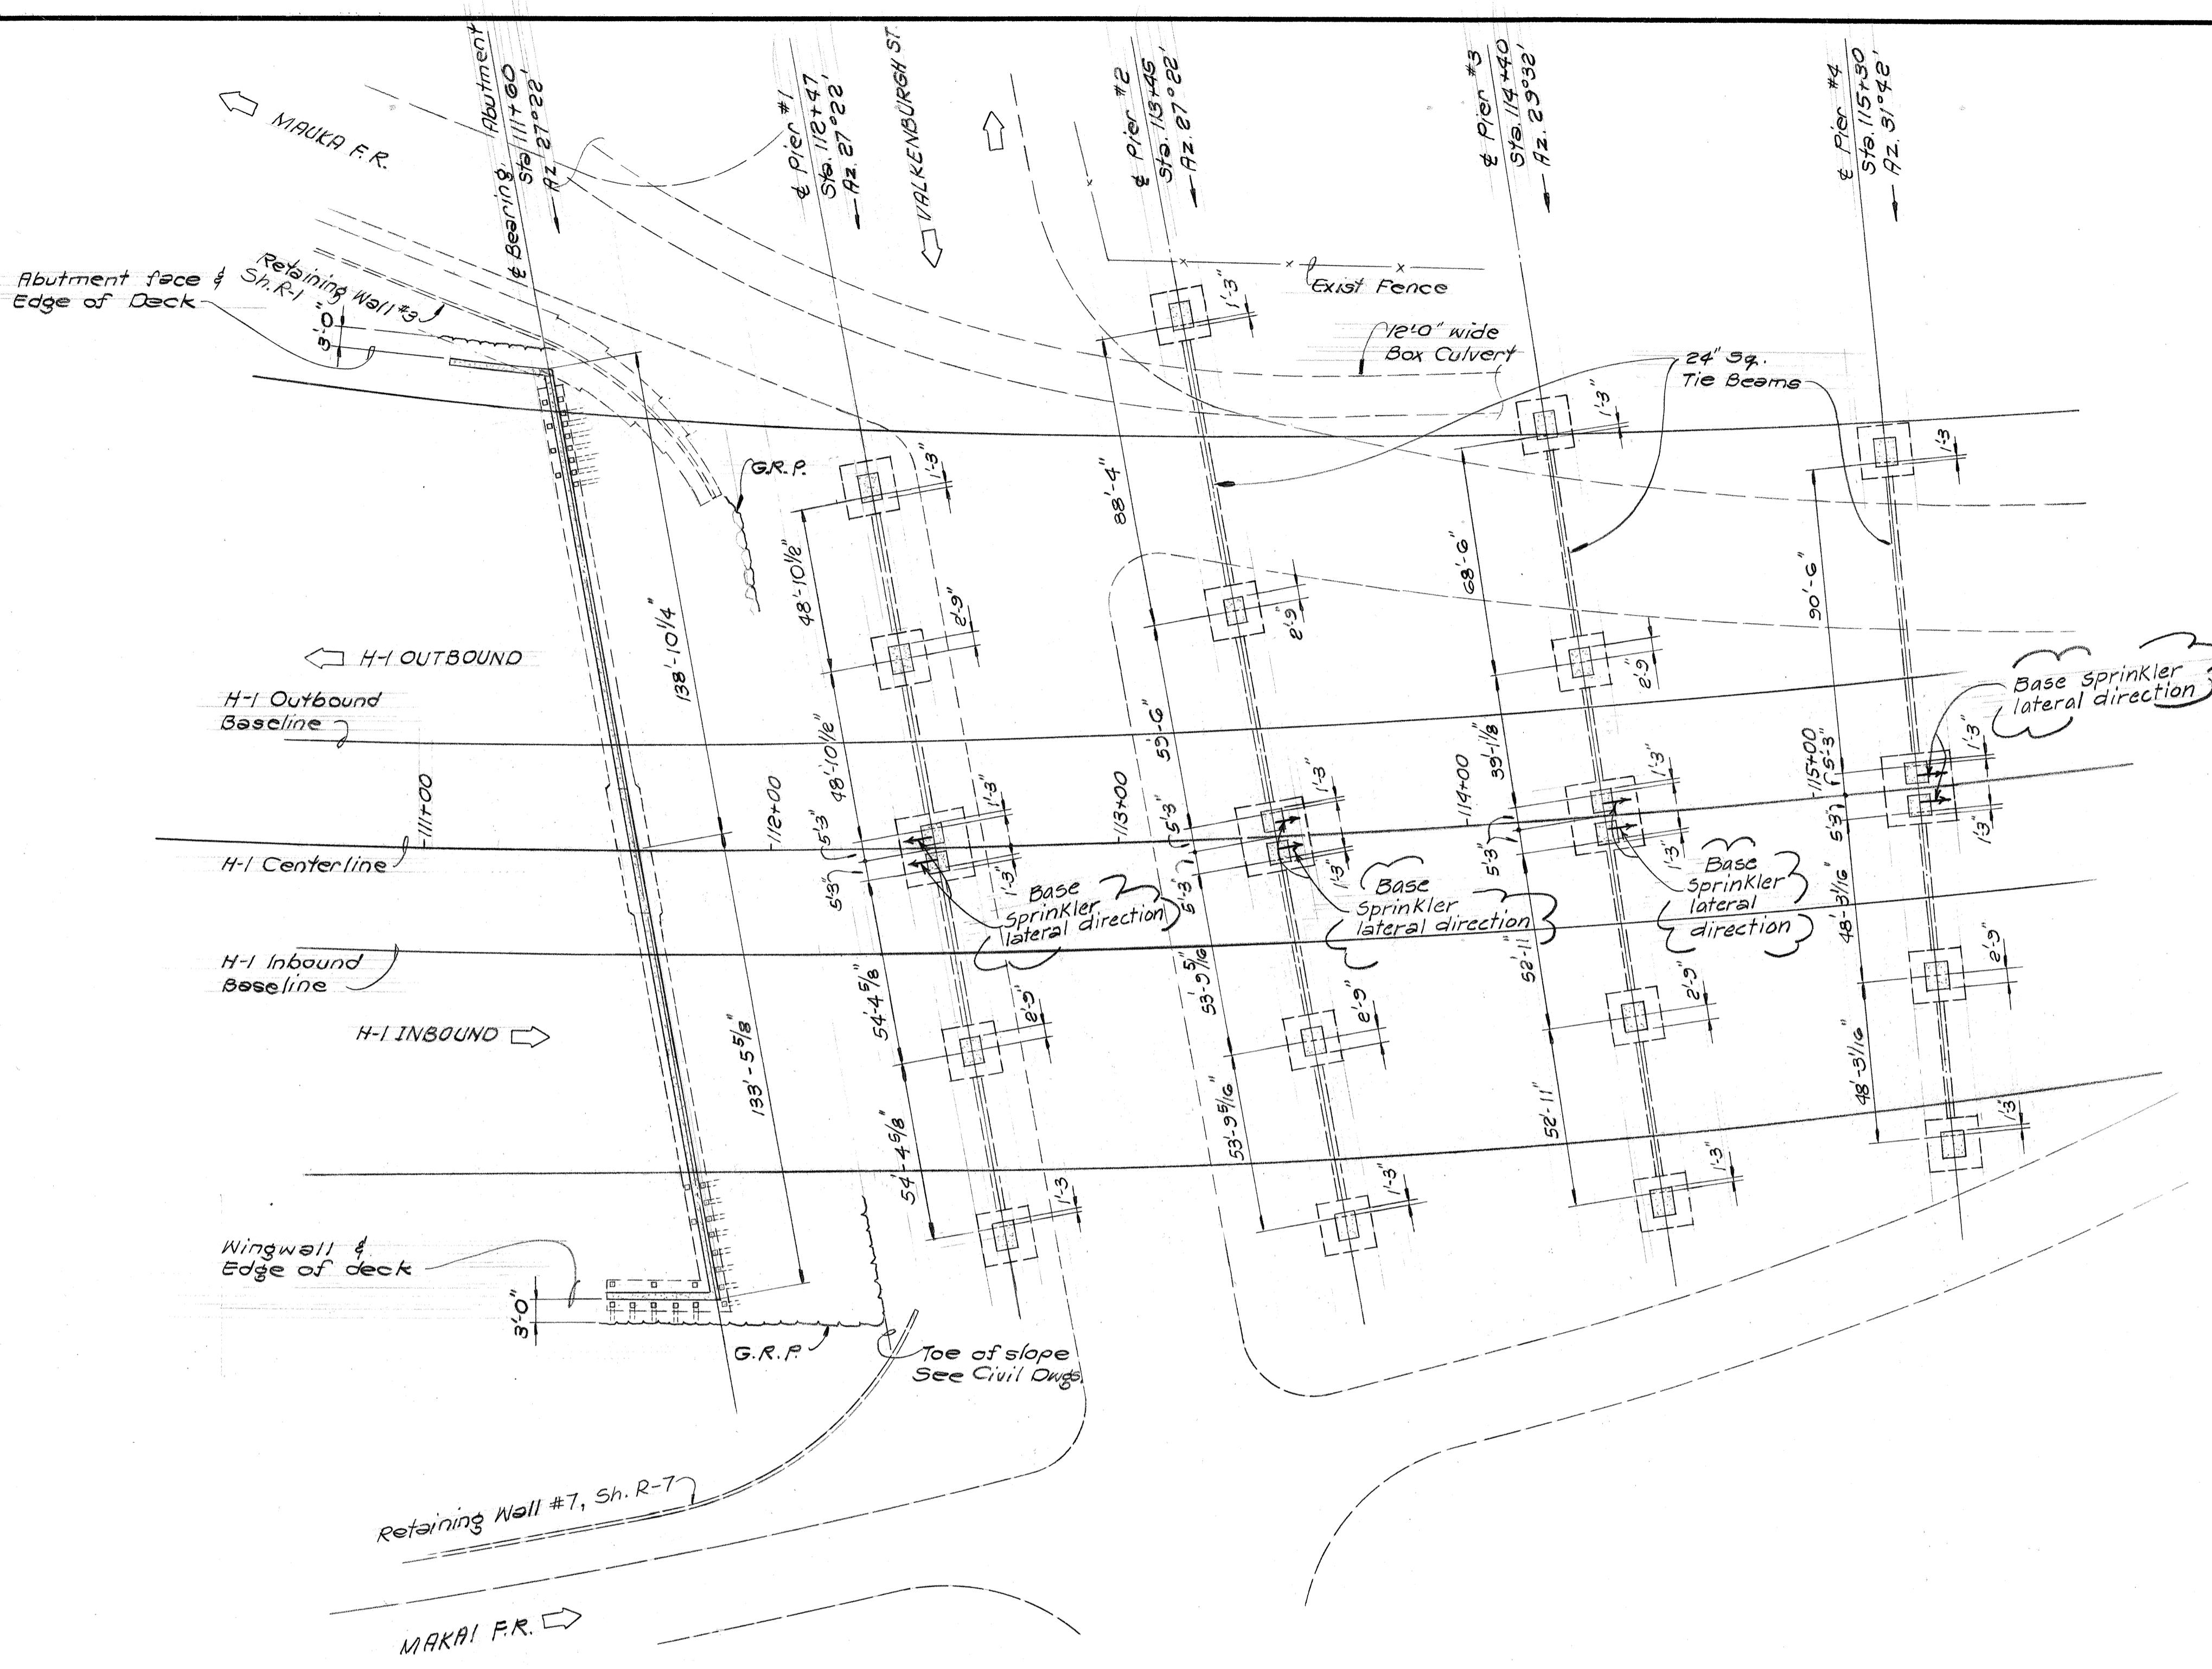

FOUNDATION LAYOUT PLAN

Scale: 1" = 30'-0"

ORIGINAL SURVEY PLOTTED BY	DATE
PLAN DRAWN BY	
NOTE BOOK TRACED BY	
DESIGNED BY	
QUANTITIES BY	
CHECKED BY	

4/25/75	REVISE SPRINKLER LATERAL AND LOCATION.
4/26/74	SHOW GROUTED RUBBLE PAVING ITEM

STRUCTURE No. 8 QUANTITY ESTIMATES

ITEM NO.	ITEM	UNIT	QUANTITY
206.60	Structural Excavation for Bridges	C.Y.	1668
206.65	Structural Backfill for Bridges	C.Y.	593
503.0717	Concrete in Footings	L.S.	1074 C.Y.
504.55	Post-Tensioning Operation for Structure	L.S.	56,530#
504.618	Concrete for Prestressed Cast-in-place Structure	L.S.	6551 C.Y.
602.018	Reinforcing Steel in Bridges	L.S.	1,428,000#
206.80	Filter Material	C.Y.	156
507.70	Concrete Bridge Parapet, Including End Post	L.F.	1493
505.700	Drilled Holes	L.F.	3049
505.040	Precast, prestressed concrete piles furnished	L.F.	4084
505.400	Precast, prestressed concrete piles driven	L.F.	754
505.040	Precast, Prestressed Concrete Test Piles, Furnished	L.F.	173
505.410	Precast, Prestressed Concrete Test Piles, Driven	L.F.	25
504.33	Prestressed Concrete Girders	L.F.	13,535
612.01	Grouted Rubble Paving	C.Y.	619


DESIGN CRITERIA

- A. Specifications: Standard Specifications for Highway Bridges, AASHTO 11th edition, including interim specifications & Standard Specifications for Road & Bridge Construction, Hawaii 1973.
- B. Allowable Foundation Pressure = 30,000 p.s.f.
(Footings shall bear 1'-0" minimum into tuff subject to the soils Engineer's approval)
- C. 28 Day Concrete strengths:
Abutment walls, wingwall, footings, columns
poured-in-place slabs
Post-tensioned pier caps
Reinforced concrete pier caps
3,000 p.s.i. (Class A concrete)
5,000 p.s.i.
3,000 p.s.i. (Class A concrete)
- D. Reinforcing Steel: ASTM A615, Grade 60
- E. Loads = HS 20-44

Note: E 3 Denotes changes to C.O. 270R 3

- REFERENCE DRAWINGS
1. Abutment Foundation-----Sh. S-55
 2. Pier Foundations-----Sh. S-61

SHIMAZU SHIMABUKURO & FUKUDA, INC.
Consulting Structural Engineers
1210 Ward Ave., Honolulu, HI 96814

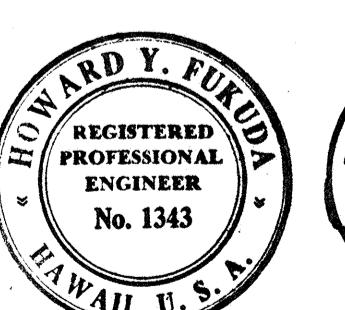

THIS WORK WAS PREPARED BY ME
OR UNDER MY SUPERVISION

STATE OF HAWAII
DEPARTMENT OF TRANSPORTATION
HIGHWAYS DIVISION

STRUCTURE No. 8 FOUNDATION LAYOUT PLAN


PEARL HARBOR INTERCHANGE
F.A. Proj. No. I-HI-1 (73)-1B

Scale: As Shown Date: DEC. 7, 1973
SHEET NO. 6-54 OF 106 SHEETS

C.O. 270R


FED. ROAD DIST. NO.	STATE	FED. AID PROJ. NO.	FISCAL YEAR	SHEET NO.	TOTAL SHEETS
HAWAII	HAW.	I-HI(73)-5	1974	270	369

SPECIAL NOTE
For sequence of construction
for pile driving & pile size &
capacity. See Sheet S-18

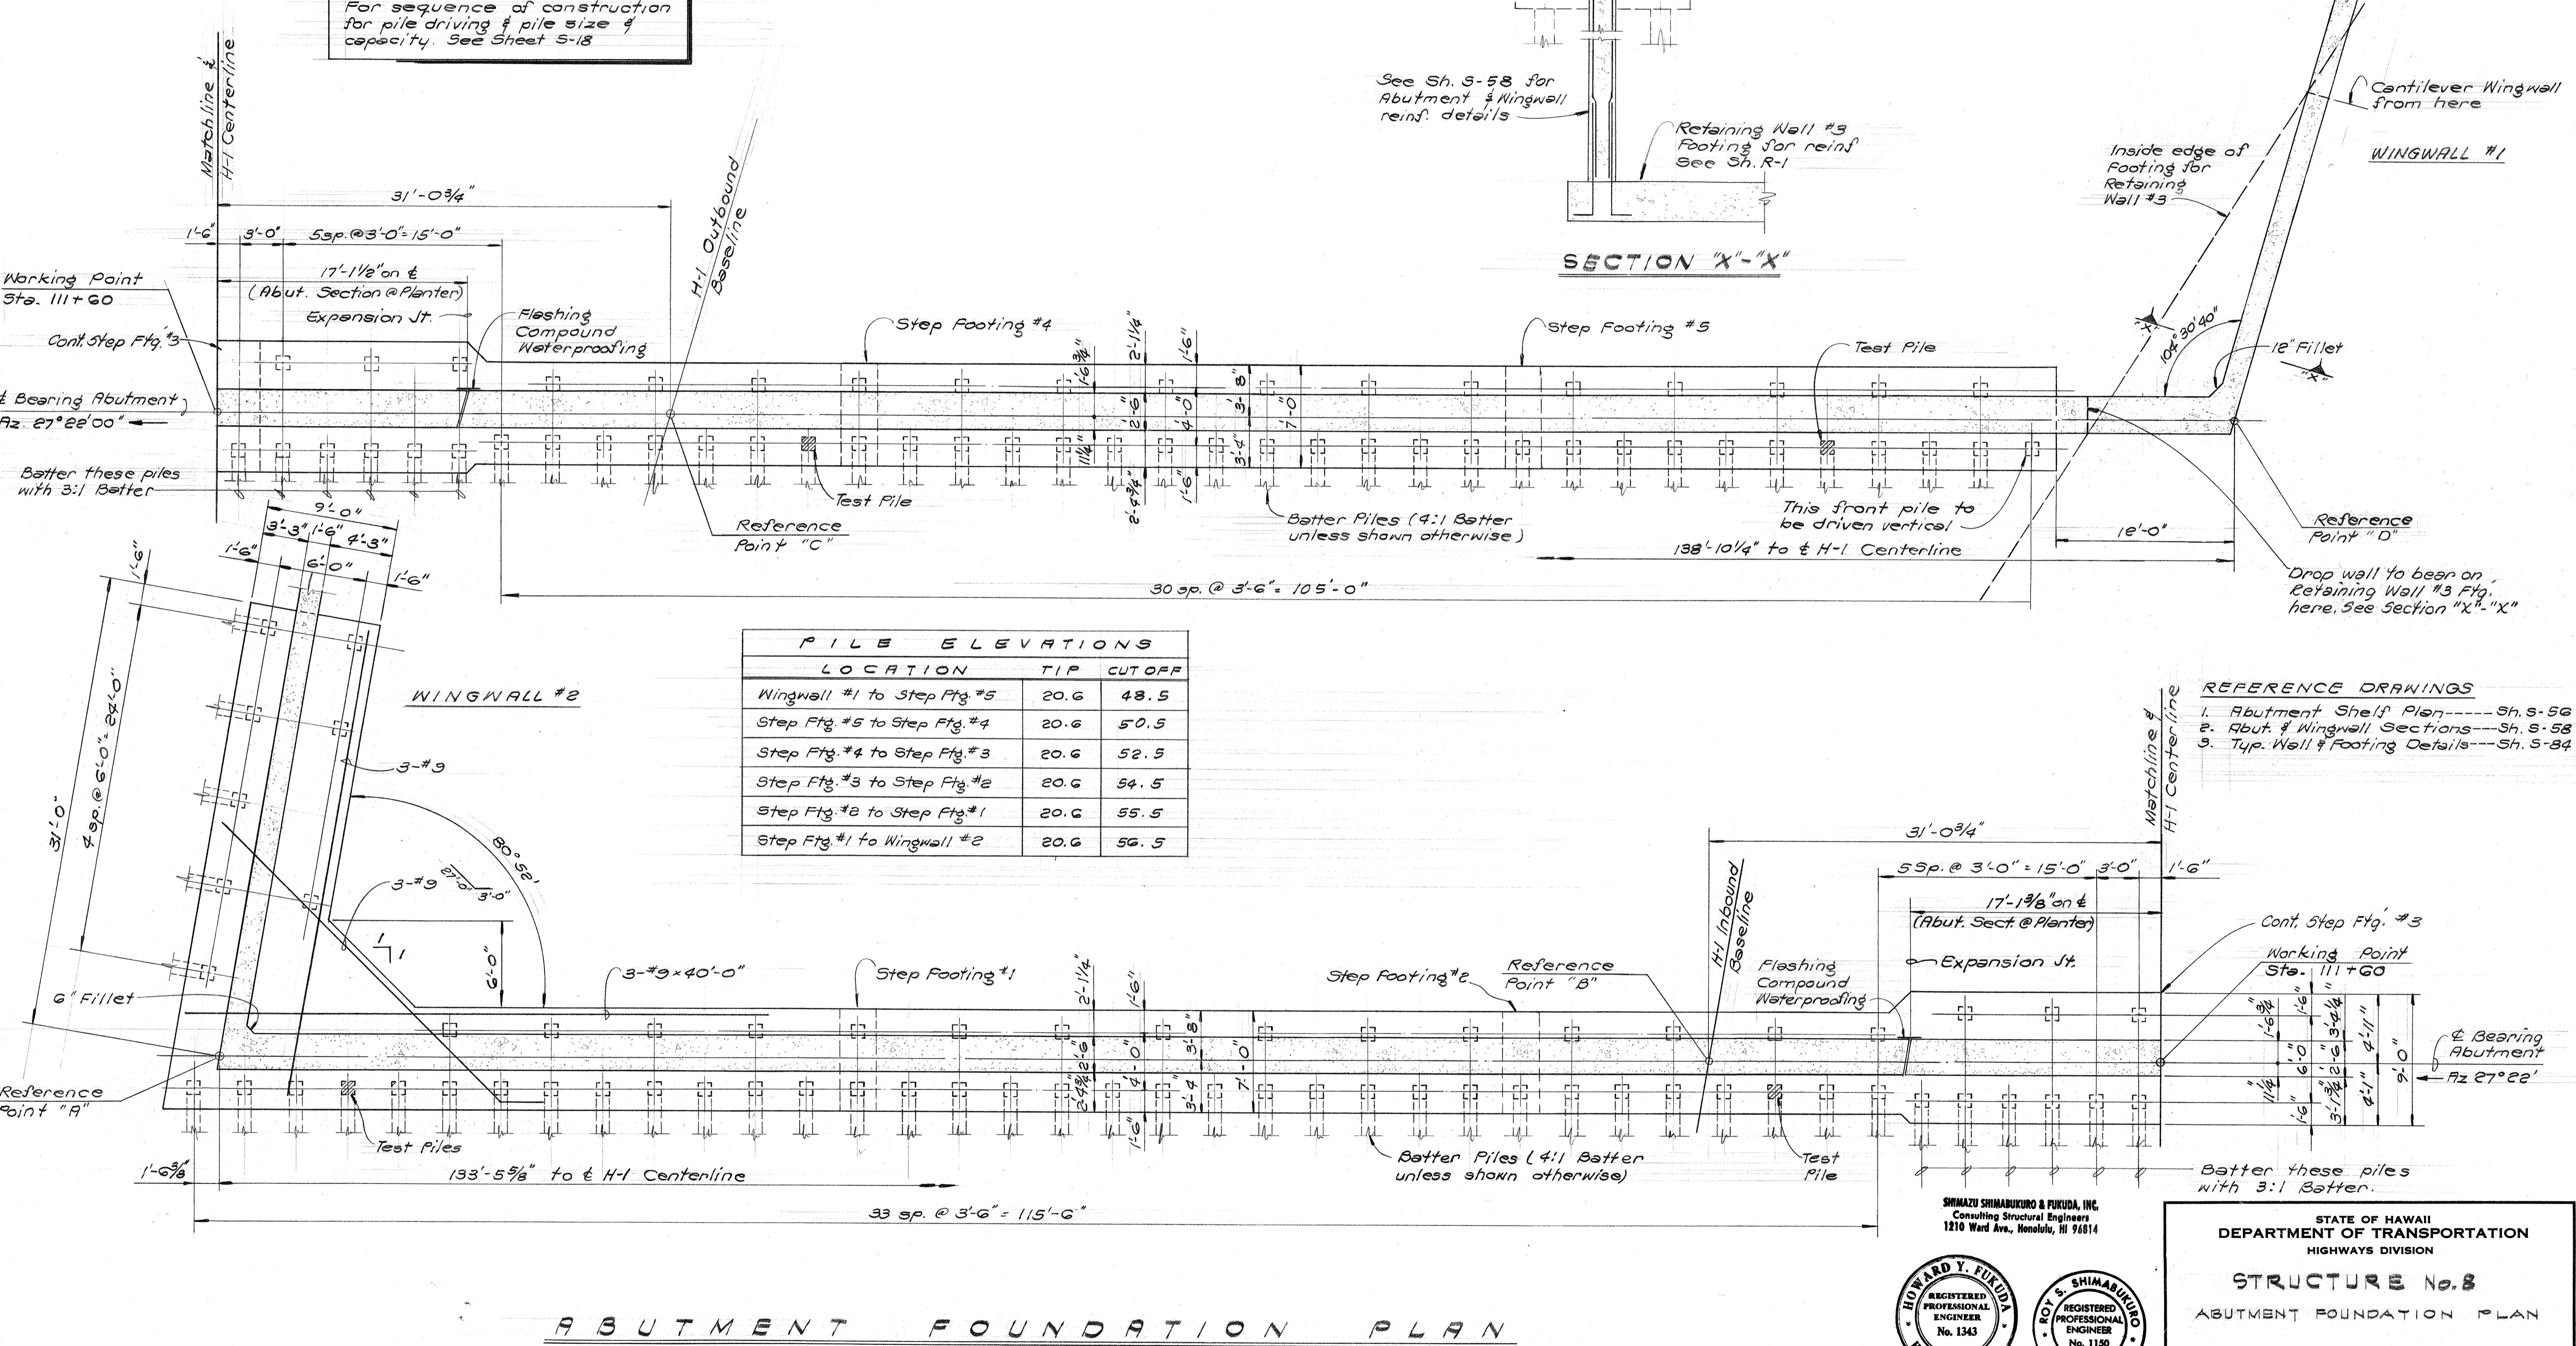


ORIGINAL SURVEY PLOTTED BY	DATE
PLAN	"
DRAWN BY	"
TRACED BY	"
NOTE BOOK	"
DESIGNED BY	"
QUANTITIES BY	"
CHECKED BY	"

FED. ROAD DIST. NO.	STATE	FED. AID PROJ. NO.	FISCAL YEAR	SHEET NO.	TOTAL SHEETS
HAWAII	HAW.	I-HI-1(73):15	1974	272	369


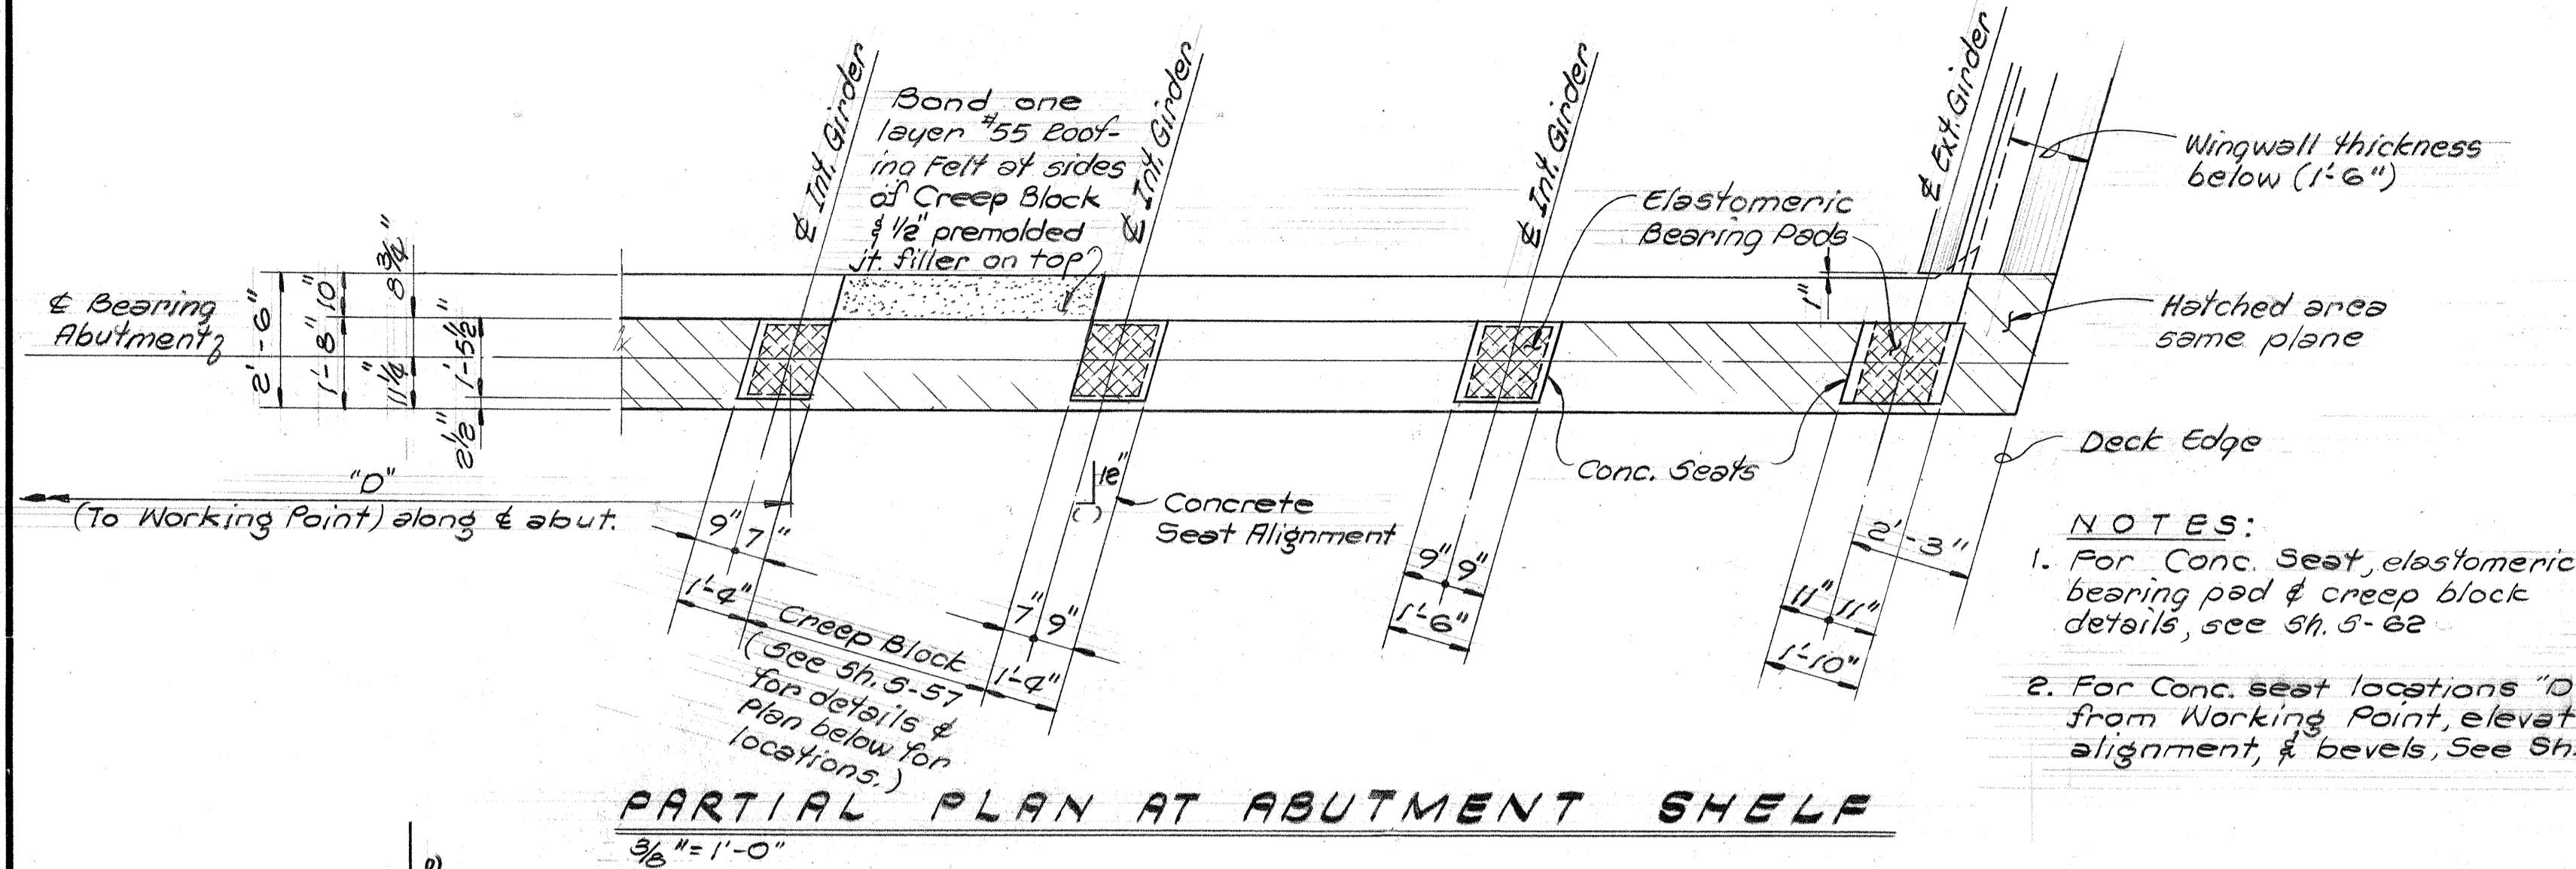


PARTIAL PLAN AT ABUTMENT SHEL

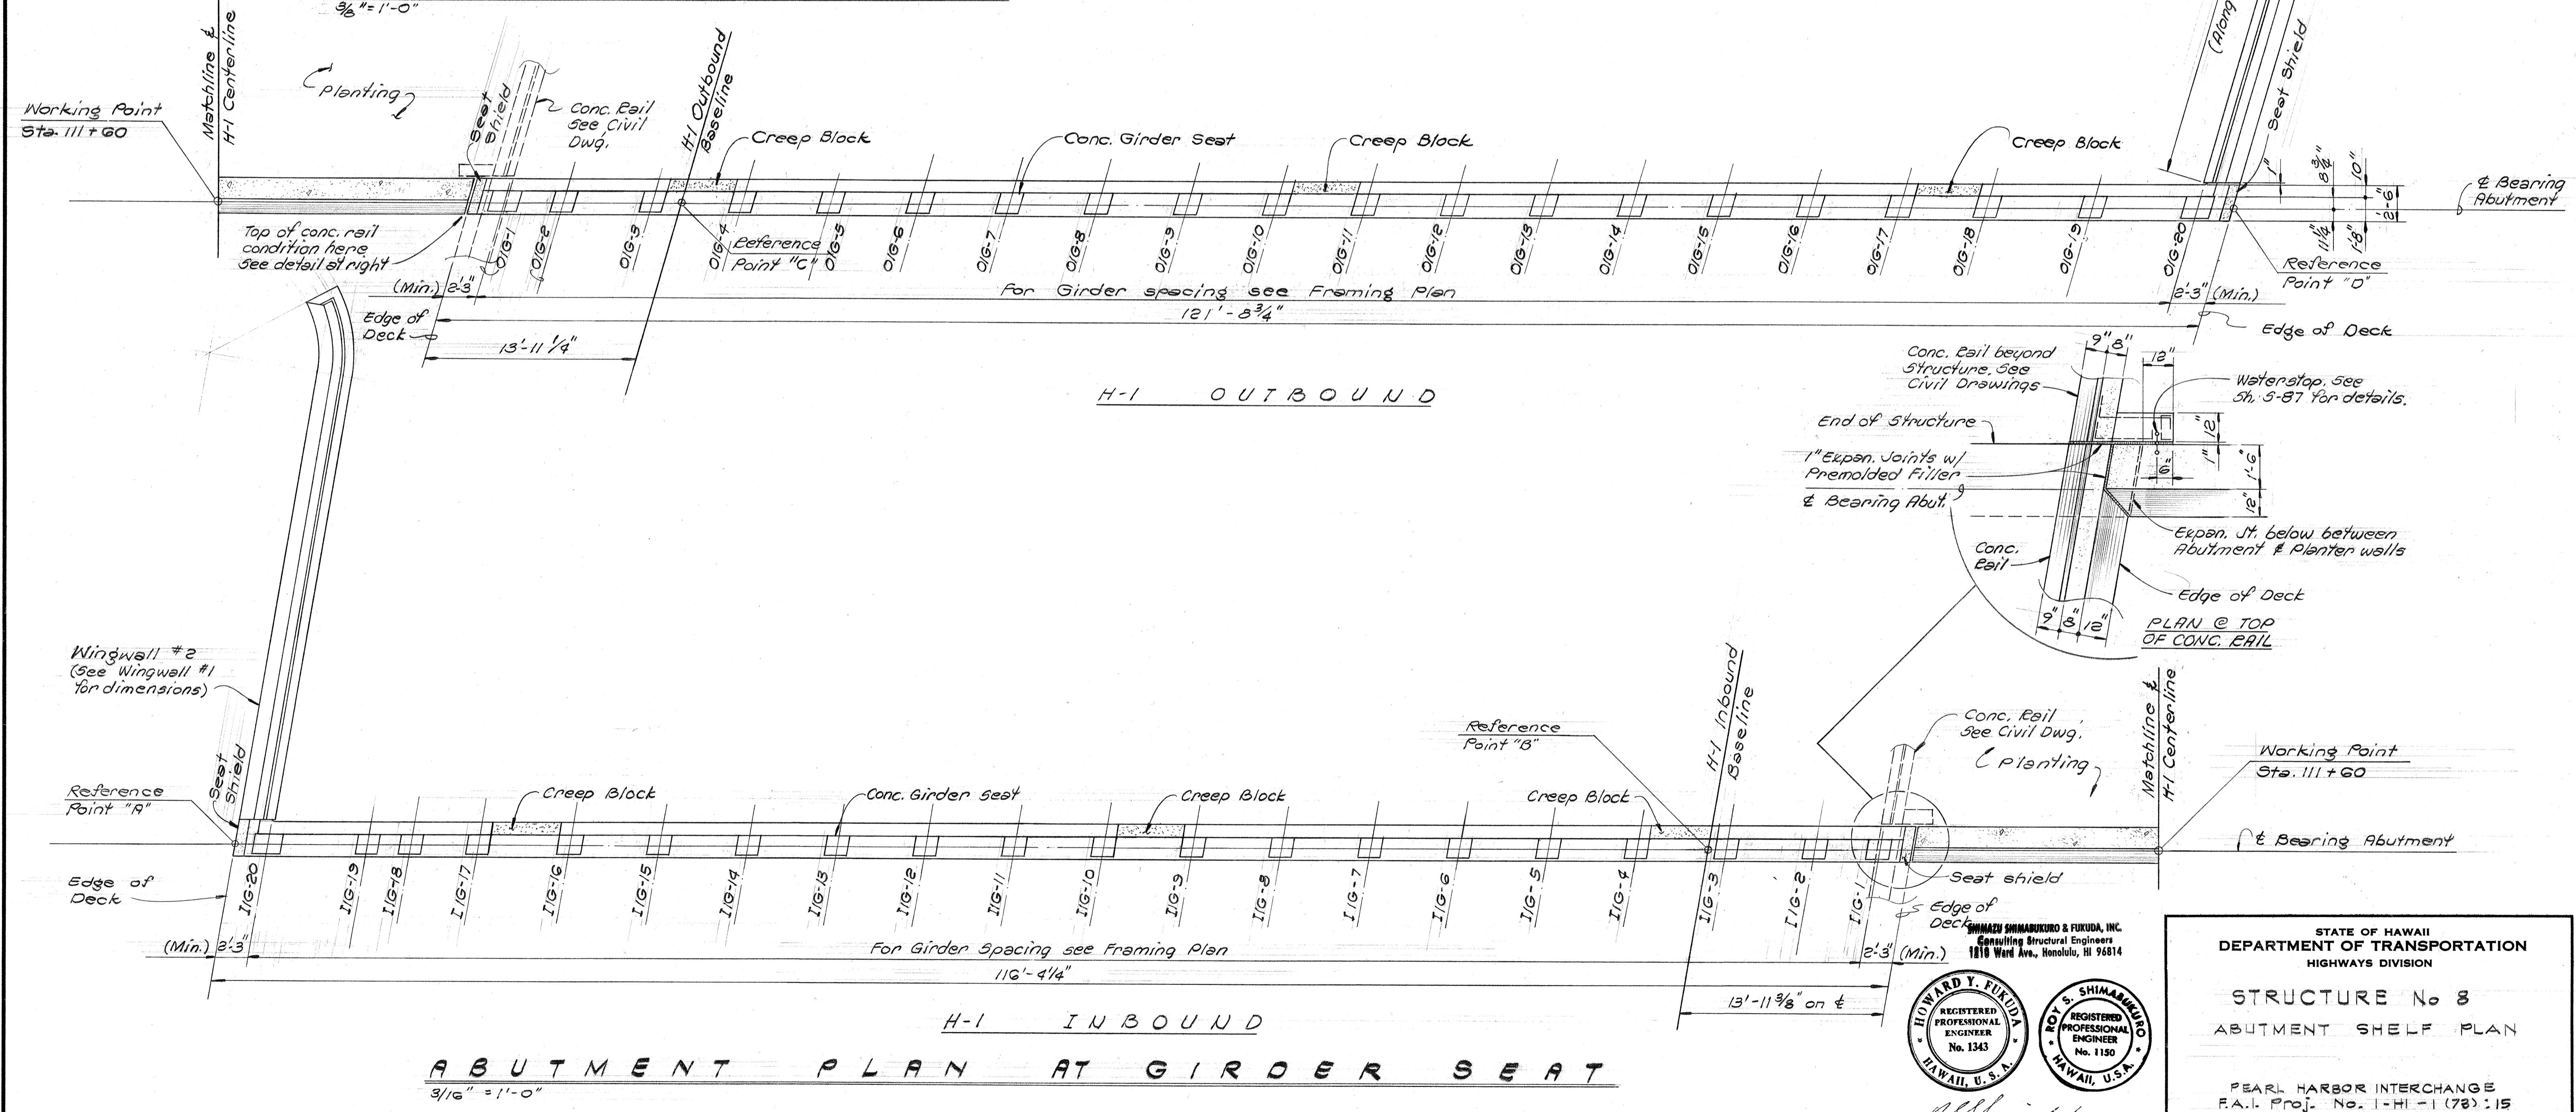

ABUTMENT PLAN AT GIRDERS SEAT

3/16" = 1.

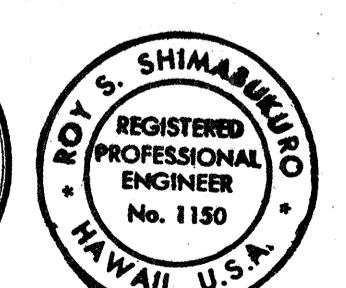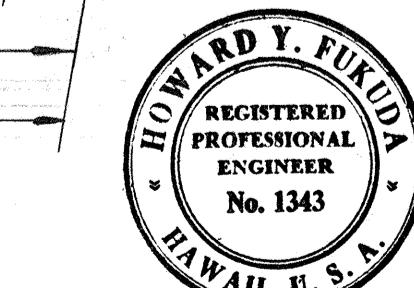

**THIS WORK WAS PREPARED BY ME
OR UNDER MY SUPERVISION**


**STATE OF HAWAII
DEPARTMENT OF TRANSPORTATION
HIGHWAYS DIVISION**

STRUCTURE No 8


PEARL HARBOR INTERCHANGE
F.A.I. Proj. No. I-HI-1 (78) : 15

Scale: As Shown Date: DEC. 7, 1973
SHEET NO. 5-56 OF 106 SHEETS

FED. ROAD DIST. NO.	STATE	FED. AID PROJ. NO.	FISCAL YEAR	SHEET NO.	TOTAL SHEETS
HAWAII	HAW.	I-H-1(73):15	1974	273	369

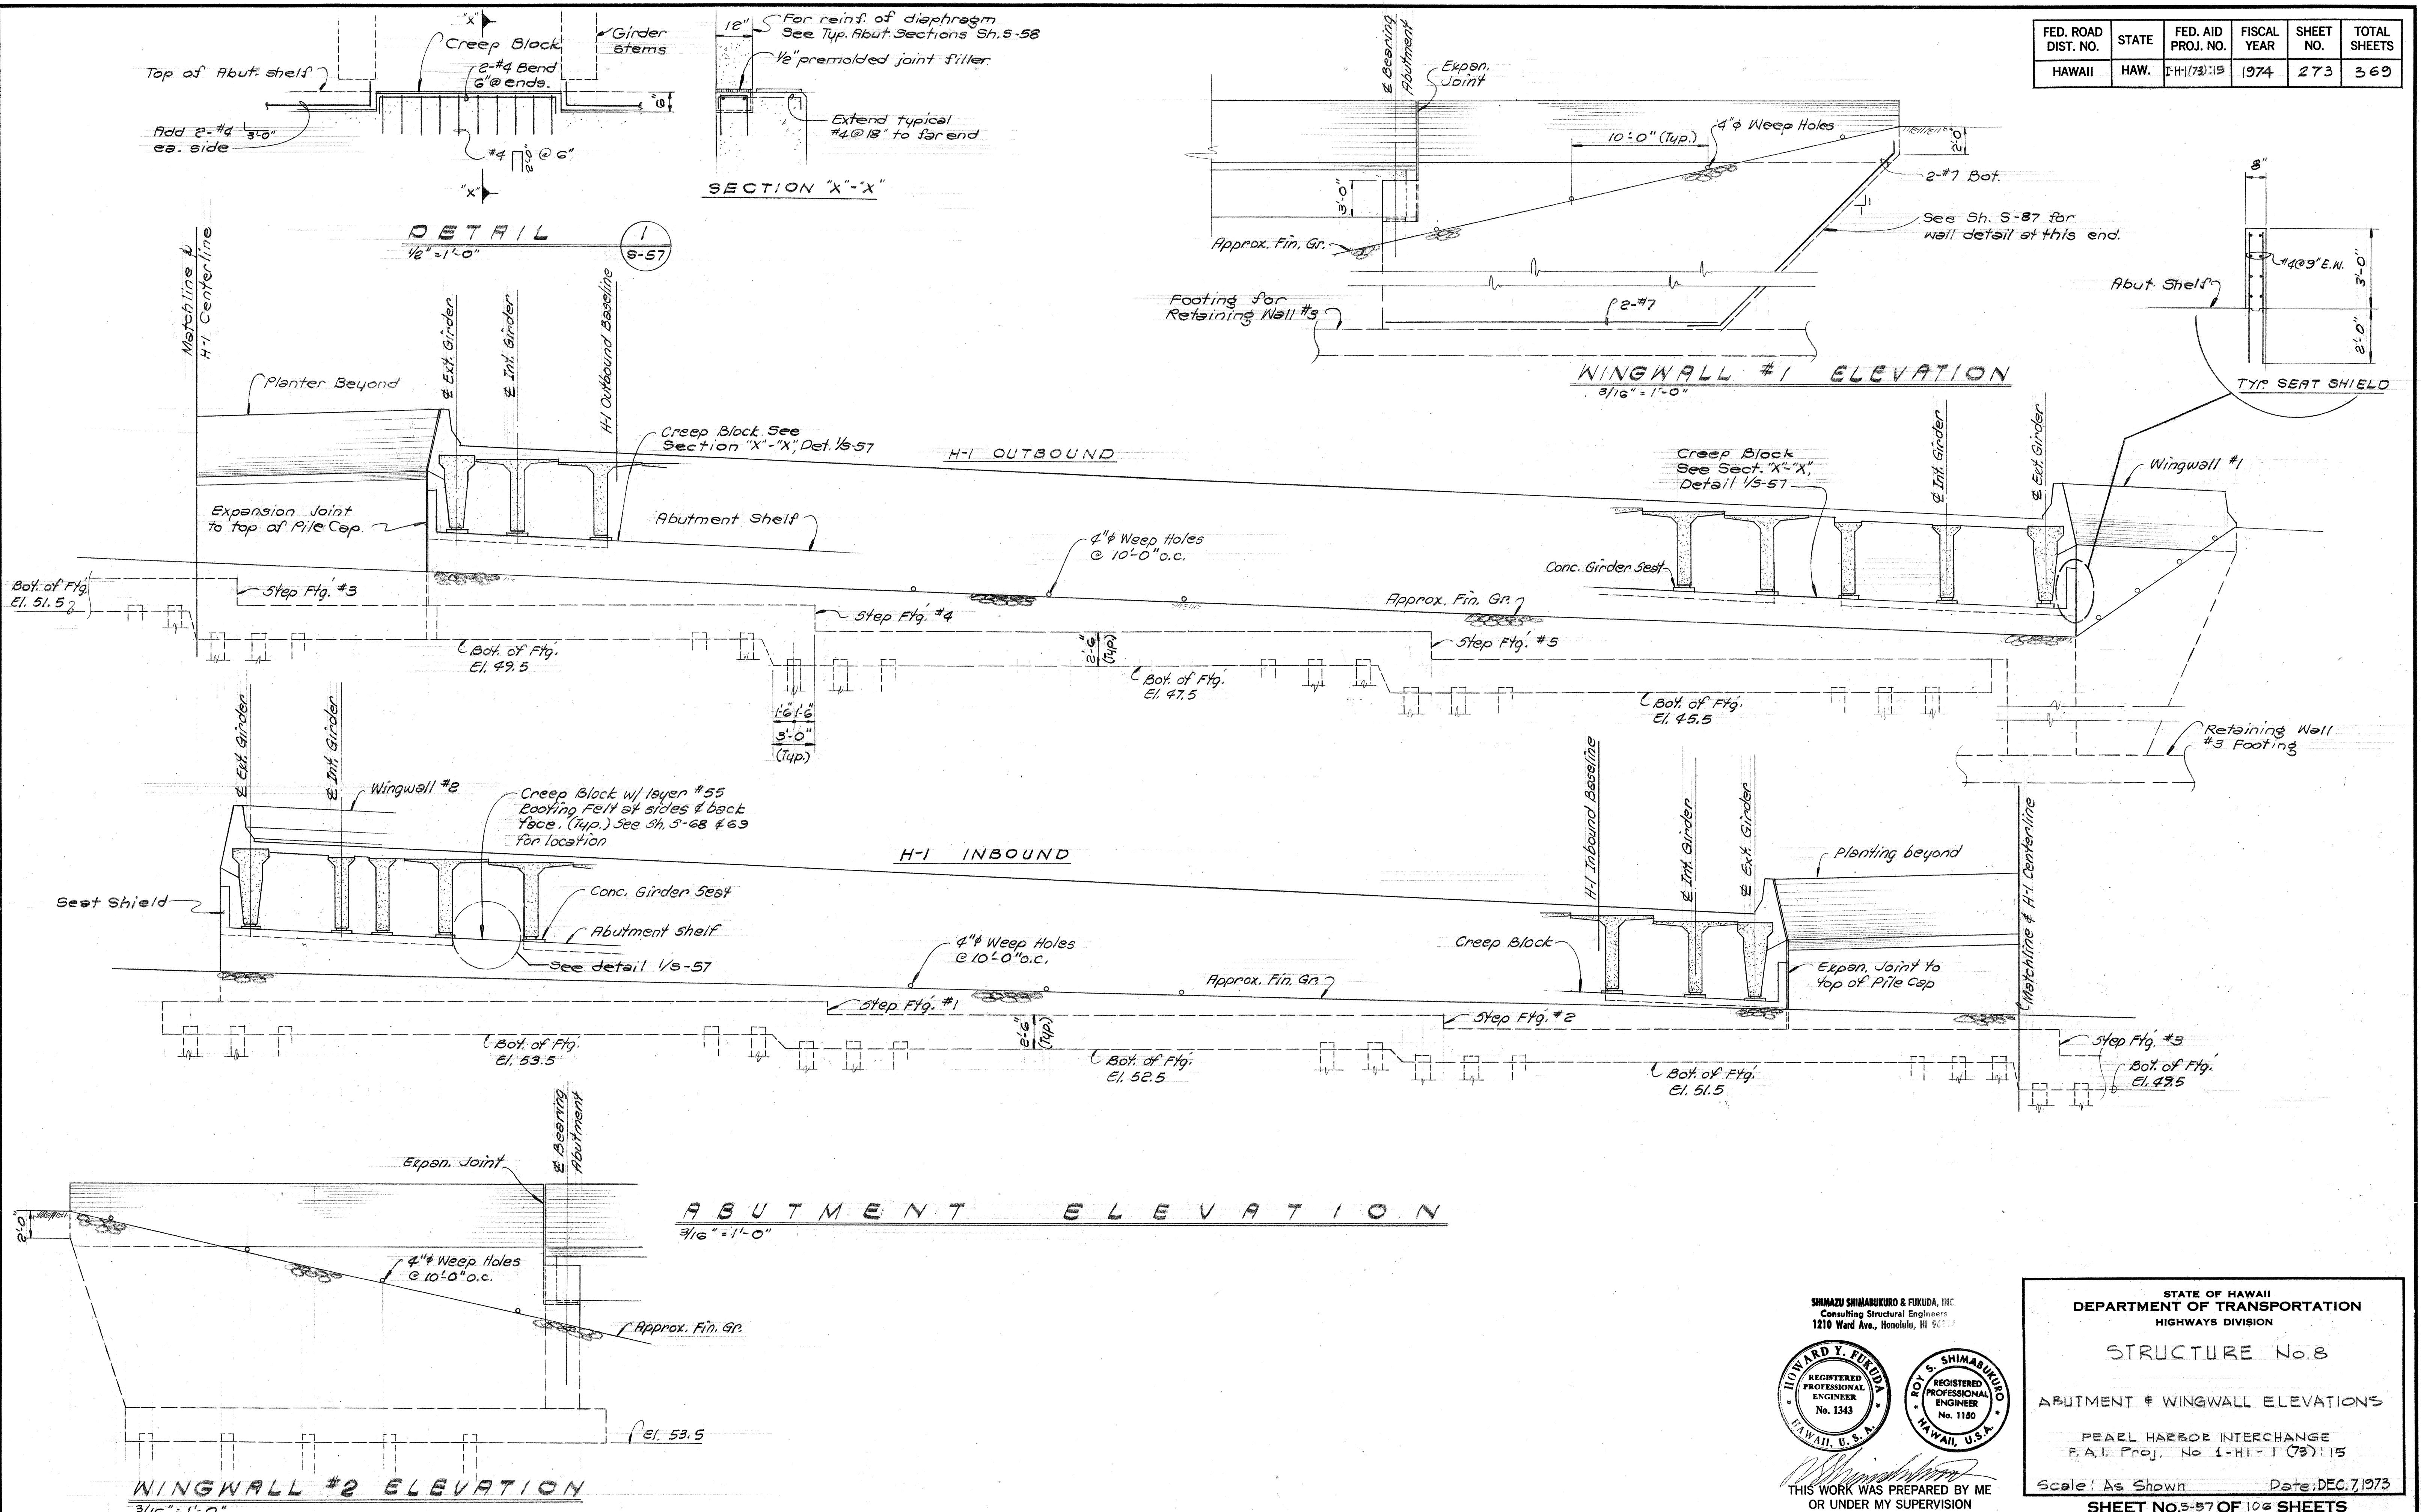

ORIGINAL PLAN	SURVEY PLOTTED BY DRAWN BY	DATE " "
	TRACED BY	" "
	DESIGNED BY	" "
NOTE BOOK	QUANTITIES BY	" "
No.	CHECKED BY	" "

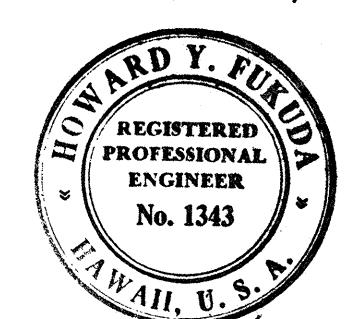

**THIS WORK WAS PREPARED BY ME
OR UNDER MY SUPERVISION**

**STATE OF HAWAII
DEPARTMENT OF TRANSPORTATION
HIGHWAYS DIVISION**


RECOMMENDED WILDCRAFTING PRACTICES

SUMMARY & WINGWALL ELEVATIONS

PEARL HARBOR INTERCHANGE
F.A.I. Proj. No 1-HI-1 (73) 115


ale! As Shown Date: DEC. 7, 1973
SHEET NO. 5-57 OF 106 SHEETS

FED. ROAD DIST. NO.	STATE	FED. AID PROJ. NO.	FISCAL YEAR	SHEET NO.	TOTAL SHEETS
HAWAII	HAW.	I-HI-1(73)-15	1974	274	369

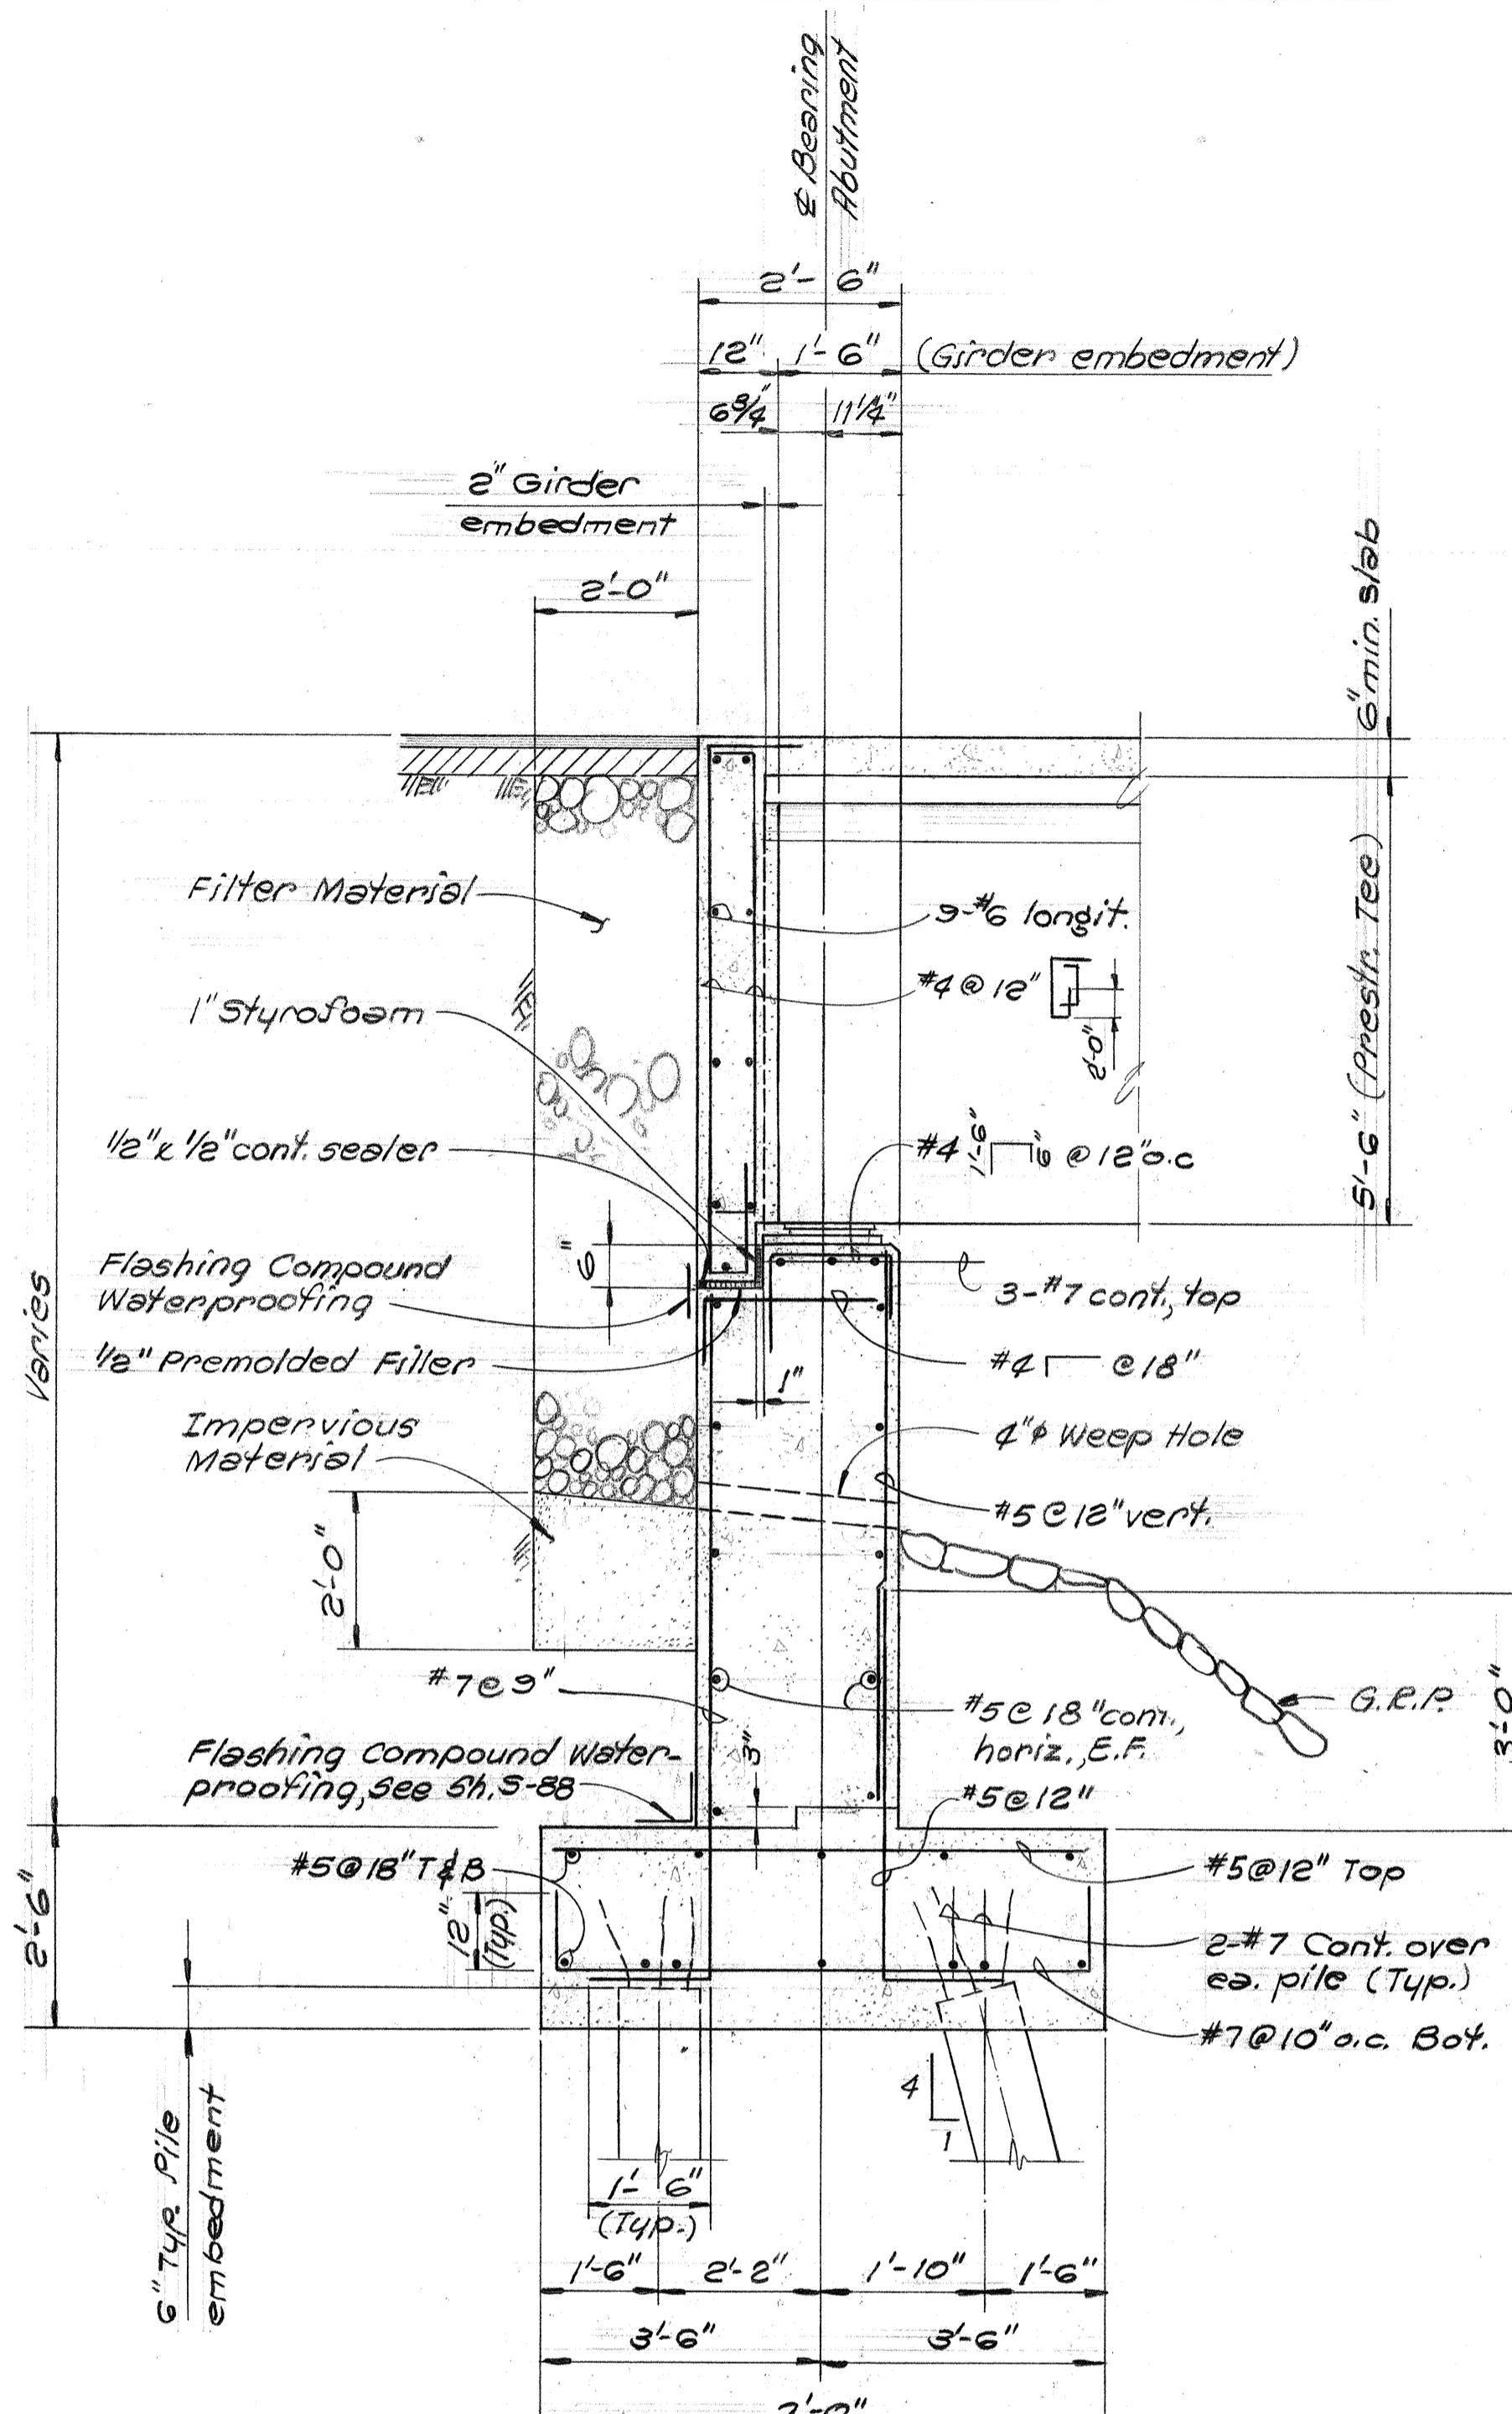


TYPICAL ABUTMENT SECTION

1/8" = 1'-0"

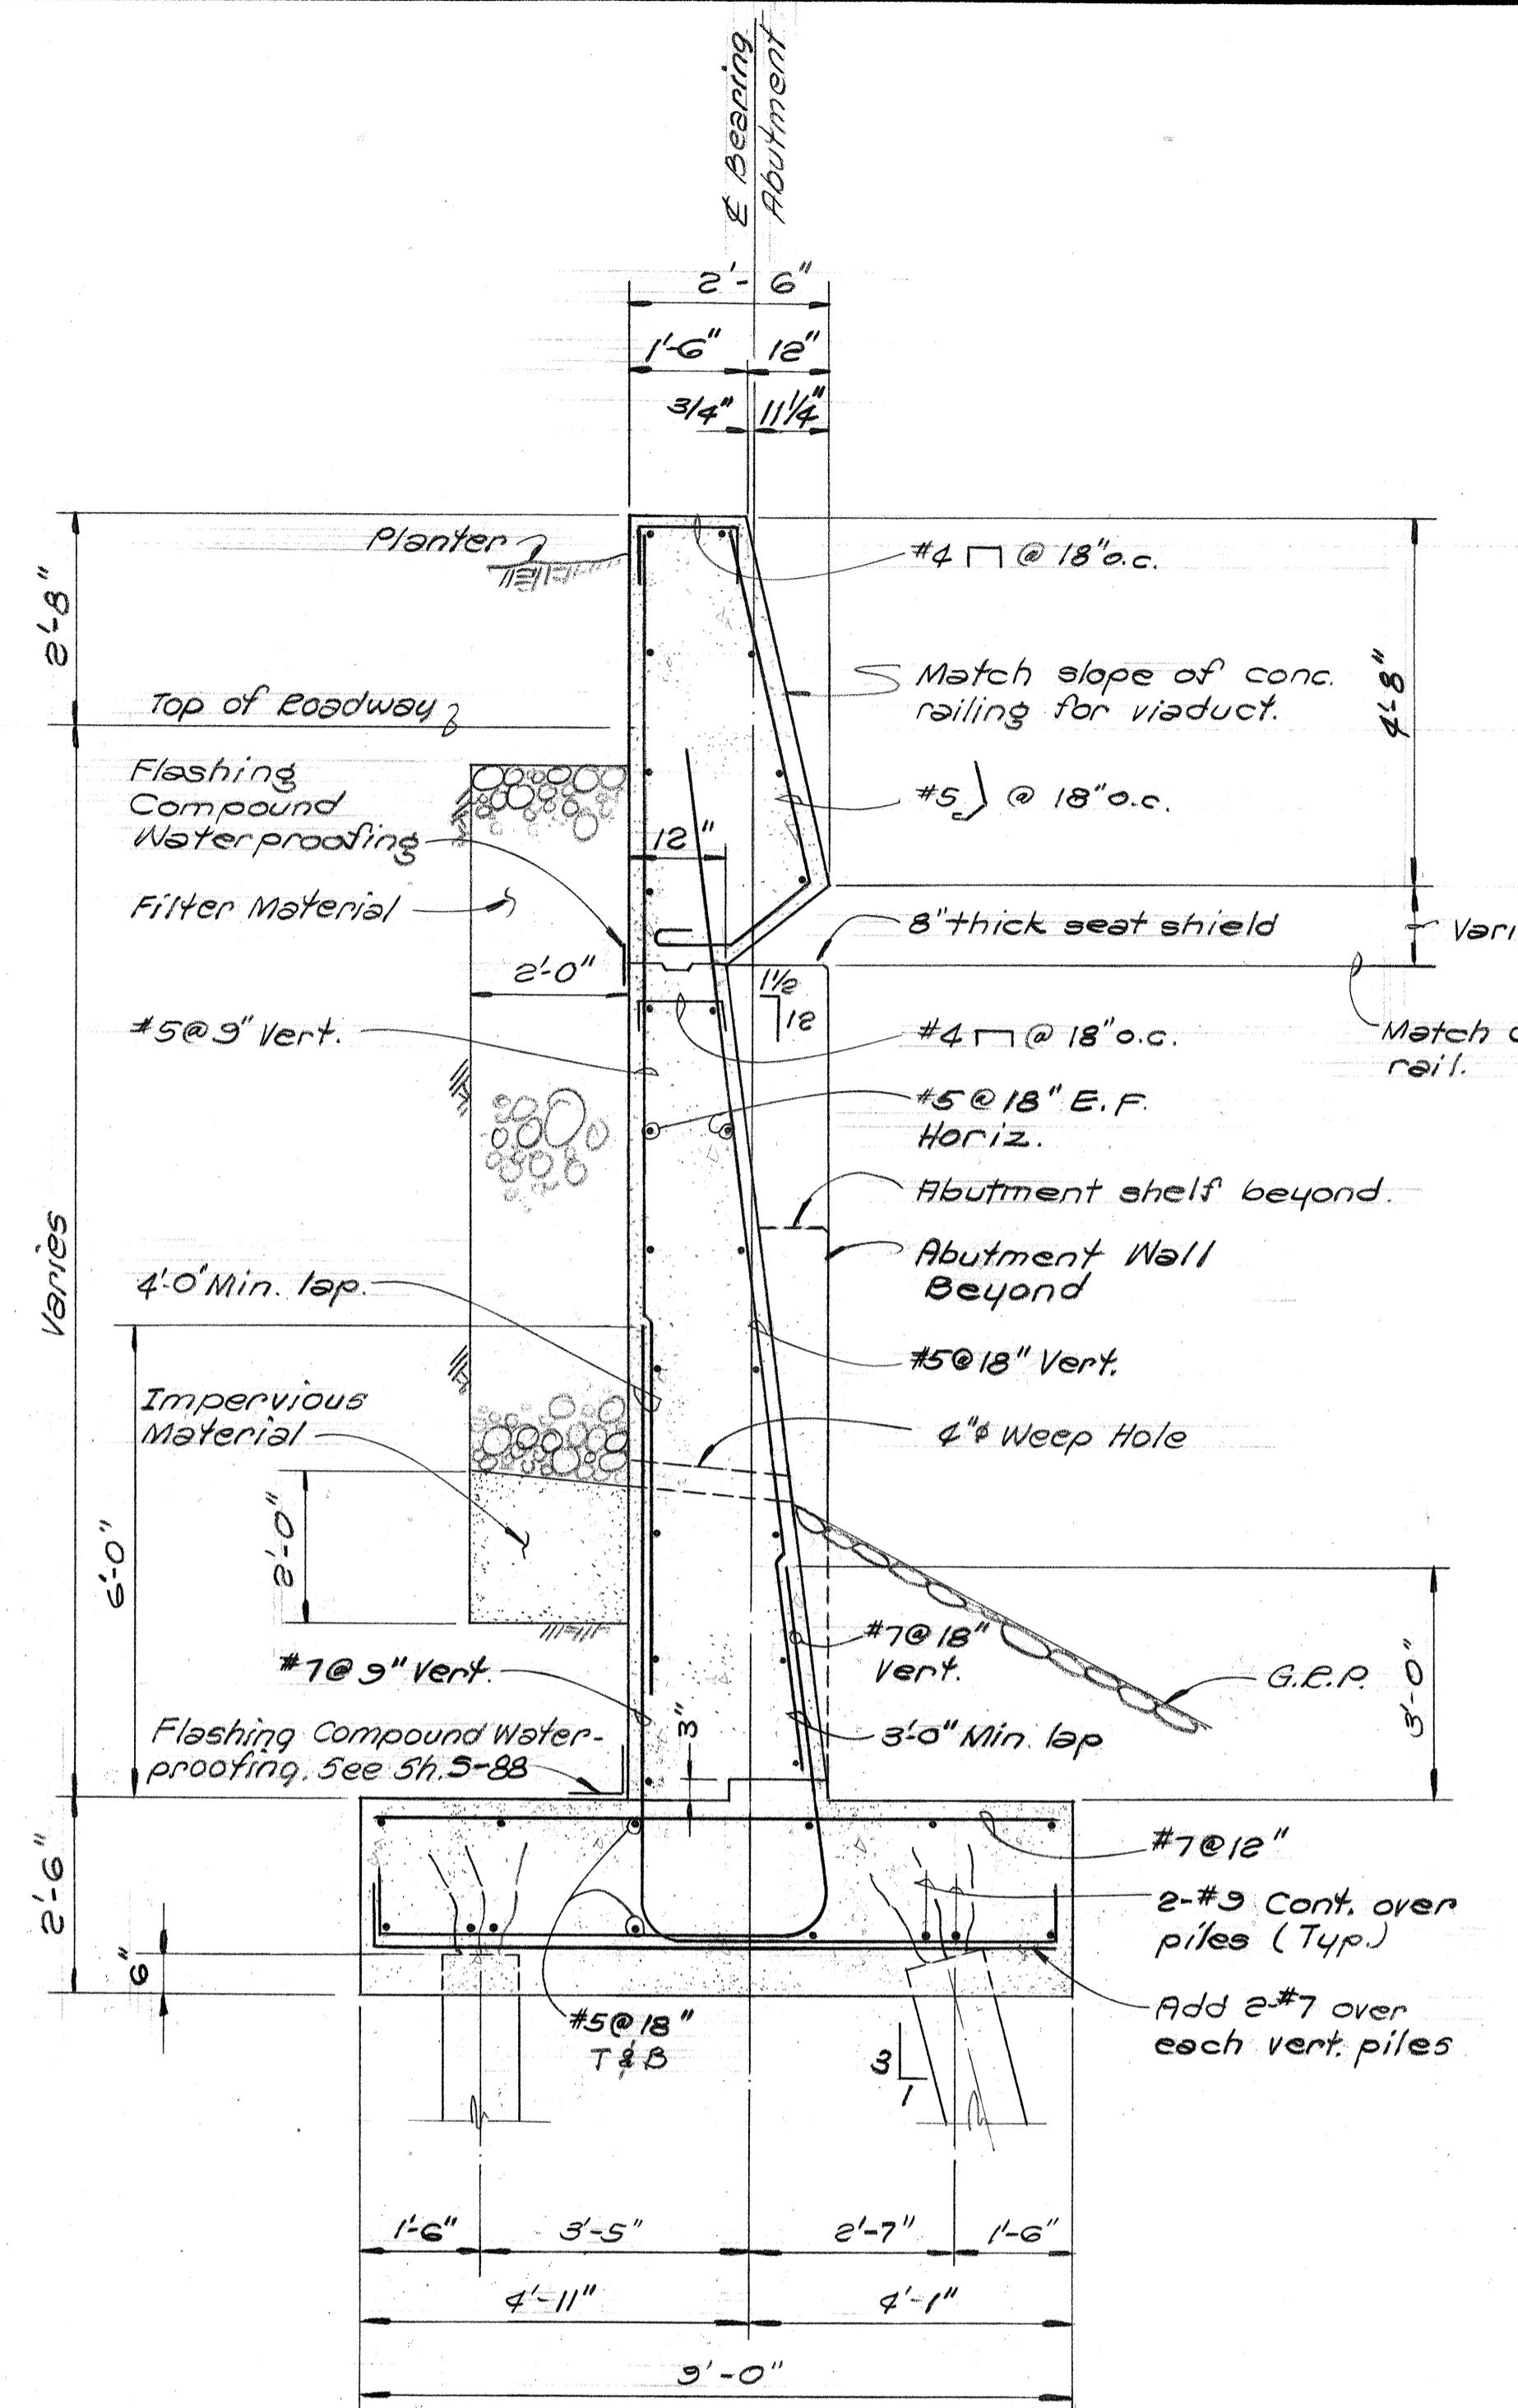

ABUTMENT SECTION AT PLANTER



1/8" = 1'-0"

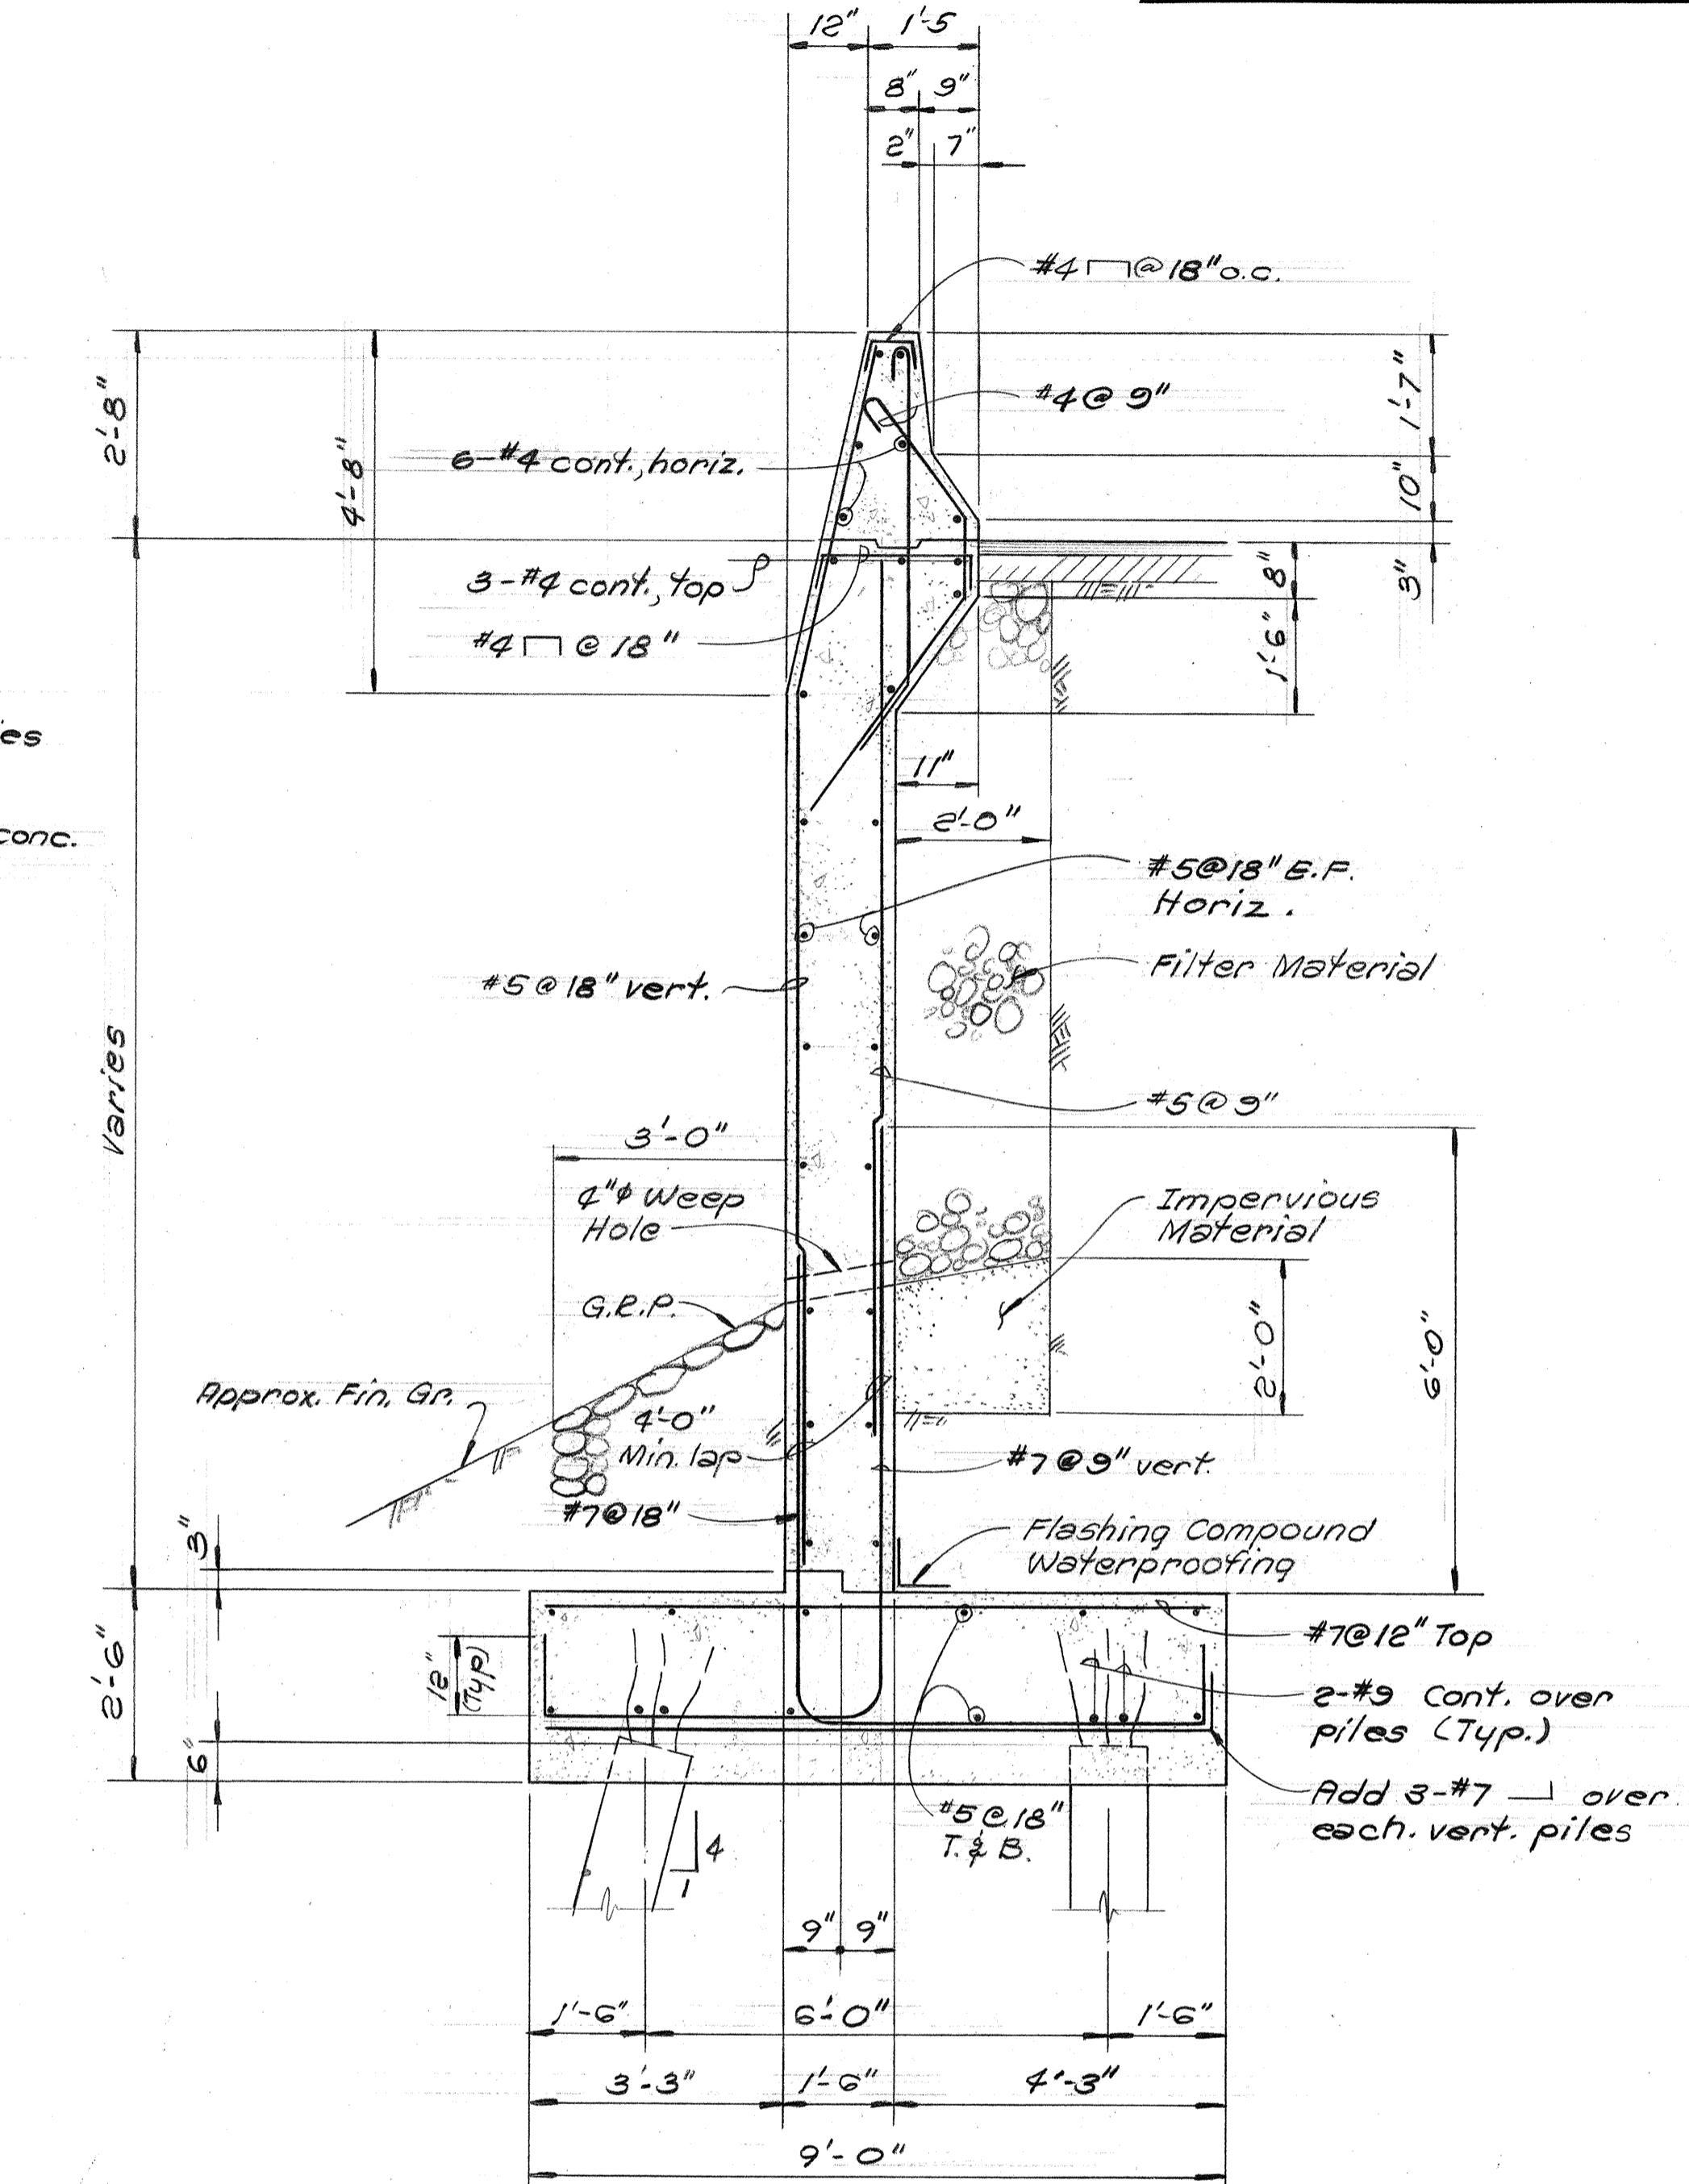

TYPICAL WINGWALL SECTION

1/8" = 1'-0"

SHIMABUKURO & FUKUDA, INC.
Consulting Structural Engineers
1210 Ward Ave., Honolulu, HI 96814

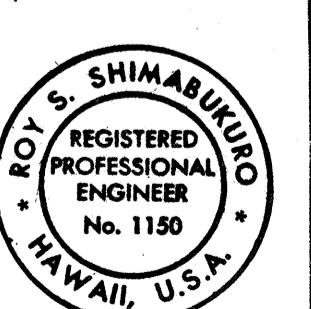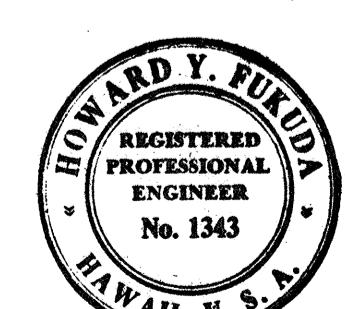

THIS WORK WAS PREPARED BY ME
OR UNDER MY SUPERVISION


STATE OF HAWAII
DEPARTMENT OF TRANSPORTATION
HIGHWAYS DIVISION

STRUCTURE No. 8

TYPICAL ABUTMENT &
WINGWALL SECTIONS

PEARL HARBOR INTERCHANGE
F.A.I. Proj. No. I-HI-1(73)-15

Scale: As Shown Date: DEC. 7, 1973
SHEET NO. 58 OF 106 SHEETS

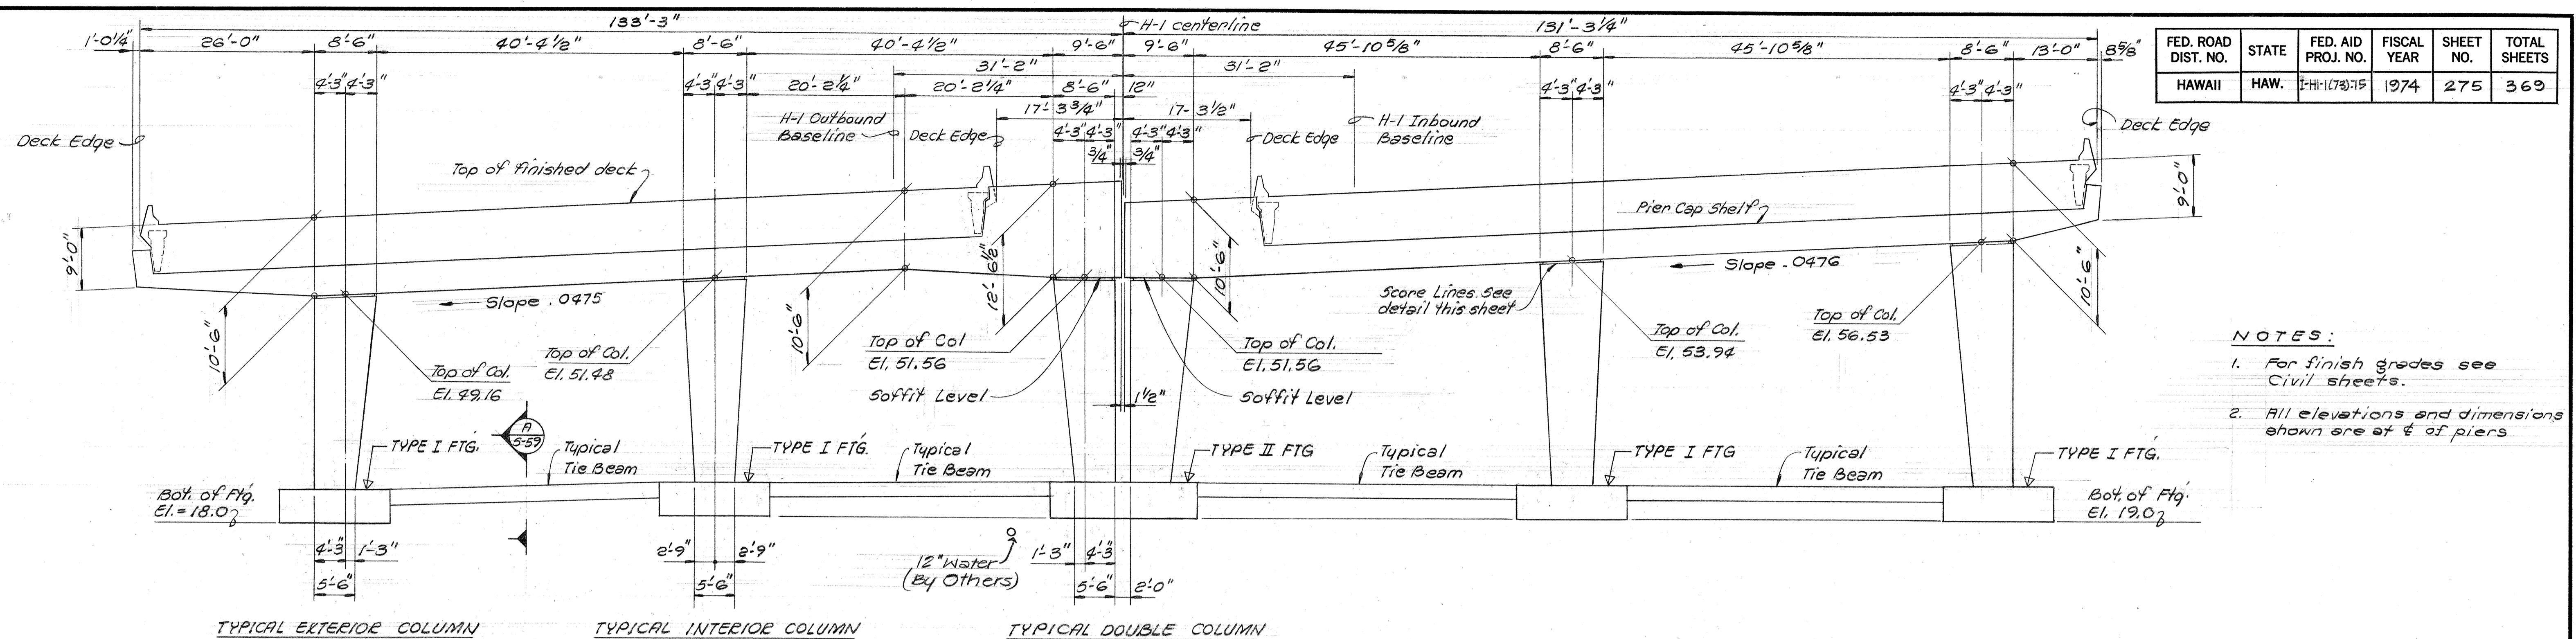

TYPICAL EXTERIOR COLUMN

TYPICAL INTERIOR COLUMN

TYPICAL DOUBLE COLUMN

H-1 OUTBOUND

H-1 INBOUND


3/32" = 1'-0" (All dimensions are given alone & pie.

(PyGMS) H-1 OUTBOUND

H-1 INBOUND

PIER #2 ELEVATION (EXPANSION)


$3/32"$ = $1\frac{1}{2}$ " (All dimensions are given along & /

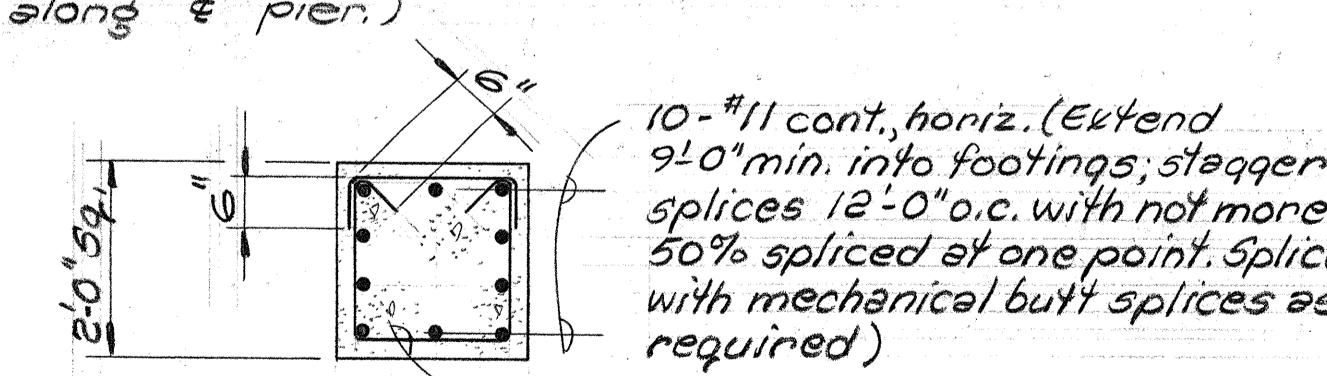

TYPICAL TIE BEAM SECTION

SECTION

SHIMADU SHIMABUKURO & FUKUDA, INC.
Consulting Structural Engineers
1810 Ward Ave., Honolulu, HI 96814

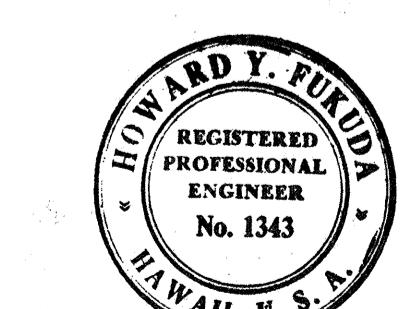

**THIS WORK WAS PREPARED BY ME
OR UNDER MY SUPERVISION**

**STATE OF HAWAII
DEPARTMENT OF TRANSPORTATION
HIGHWAYS DIVISION**



STRUCTURE No. 8

PEARL HARBOR INTERCHANGE

F.A.I. Proj. No 1-HI-1 (73) 15
Scale: As Shown Date: DEC. 7, 1973
SHEET NO 5-59 OF 106 SHEETS

- 35



FED. ROAD DIST. NO.	STATE	FED. AID PROJ. NO.	FISCAL YEAR	SHEET NO.	TOTAL SHEETS
HAWAII	HAW.	I-H-1(73)-15	1974	276	369

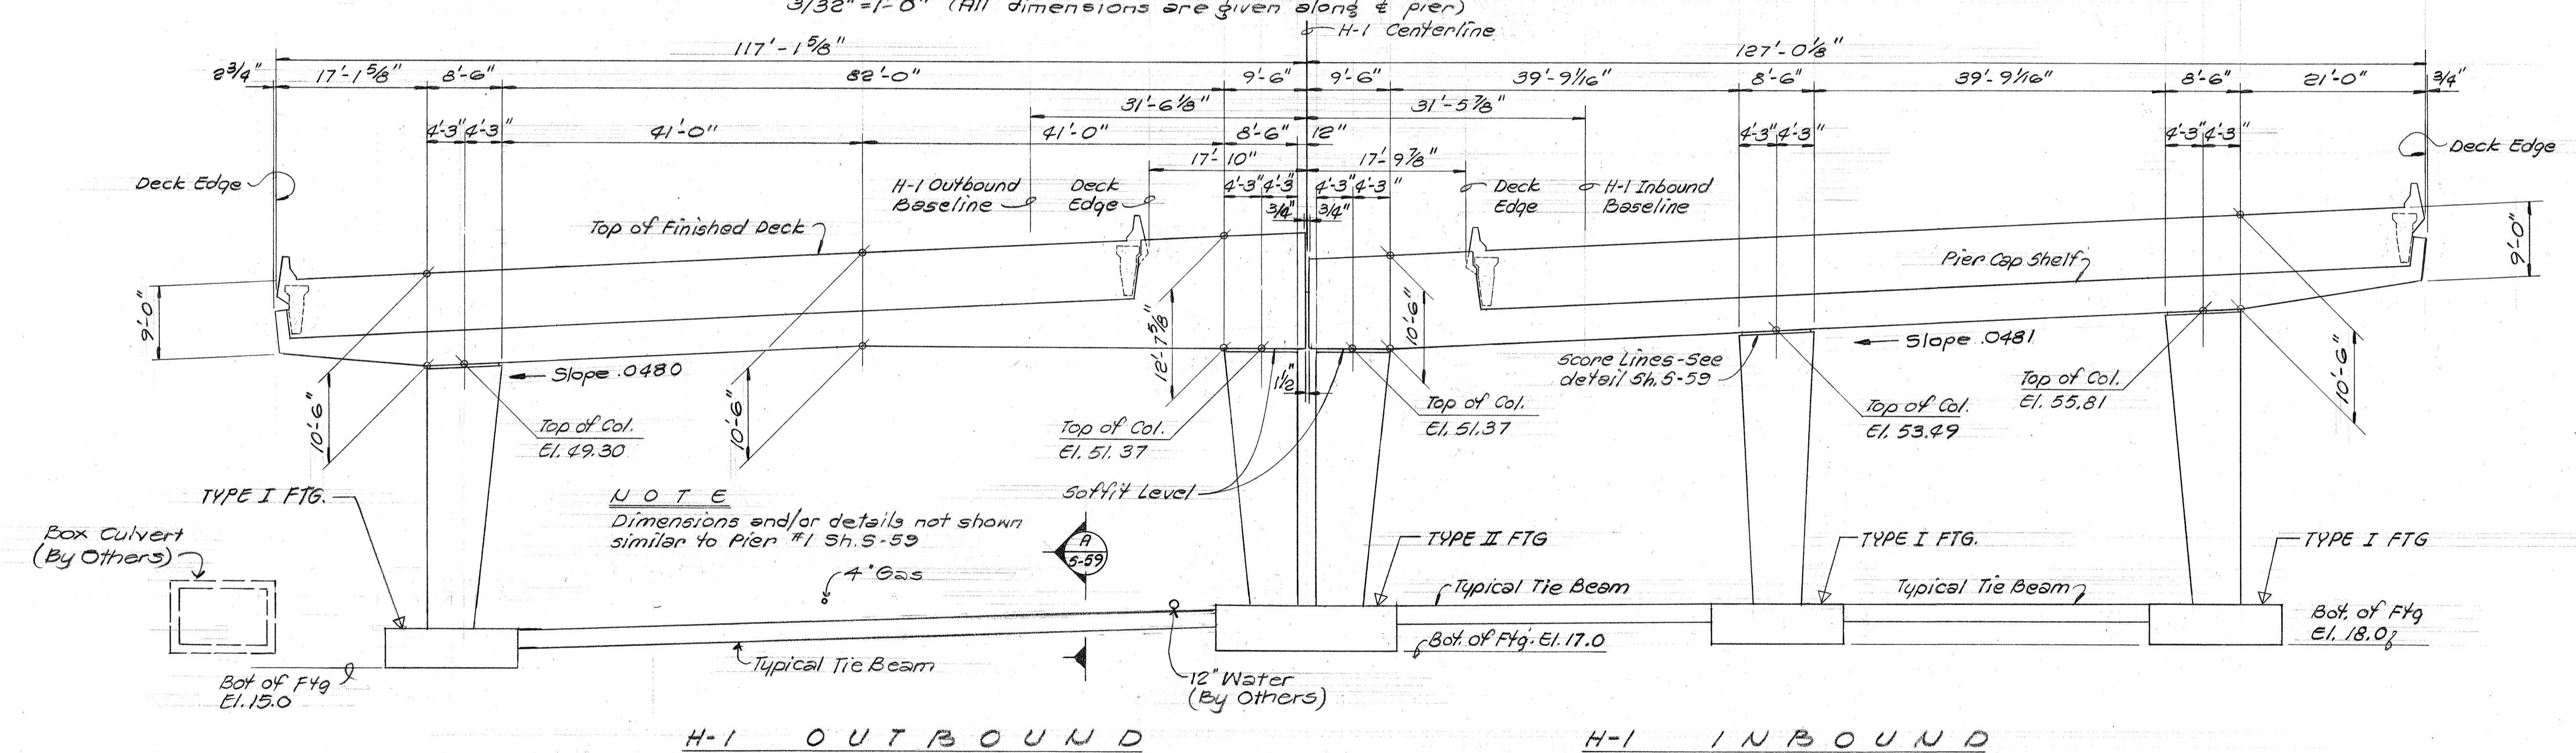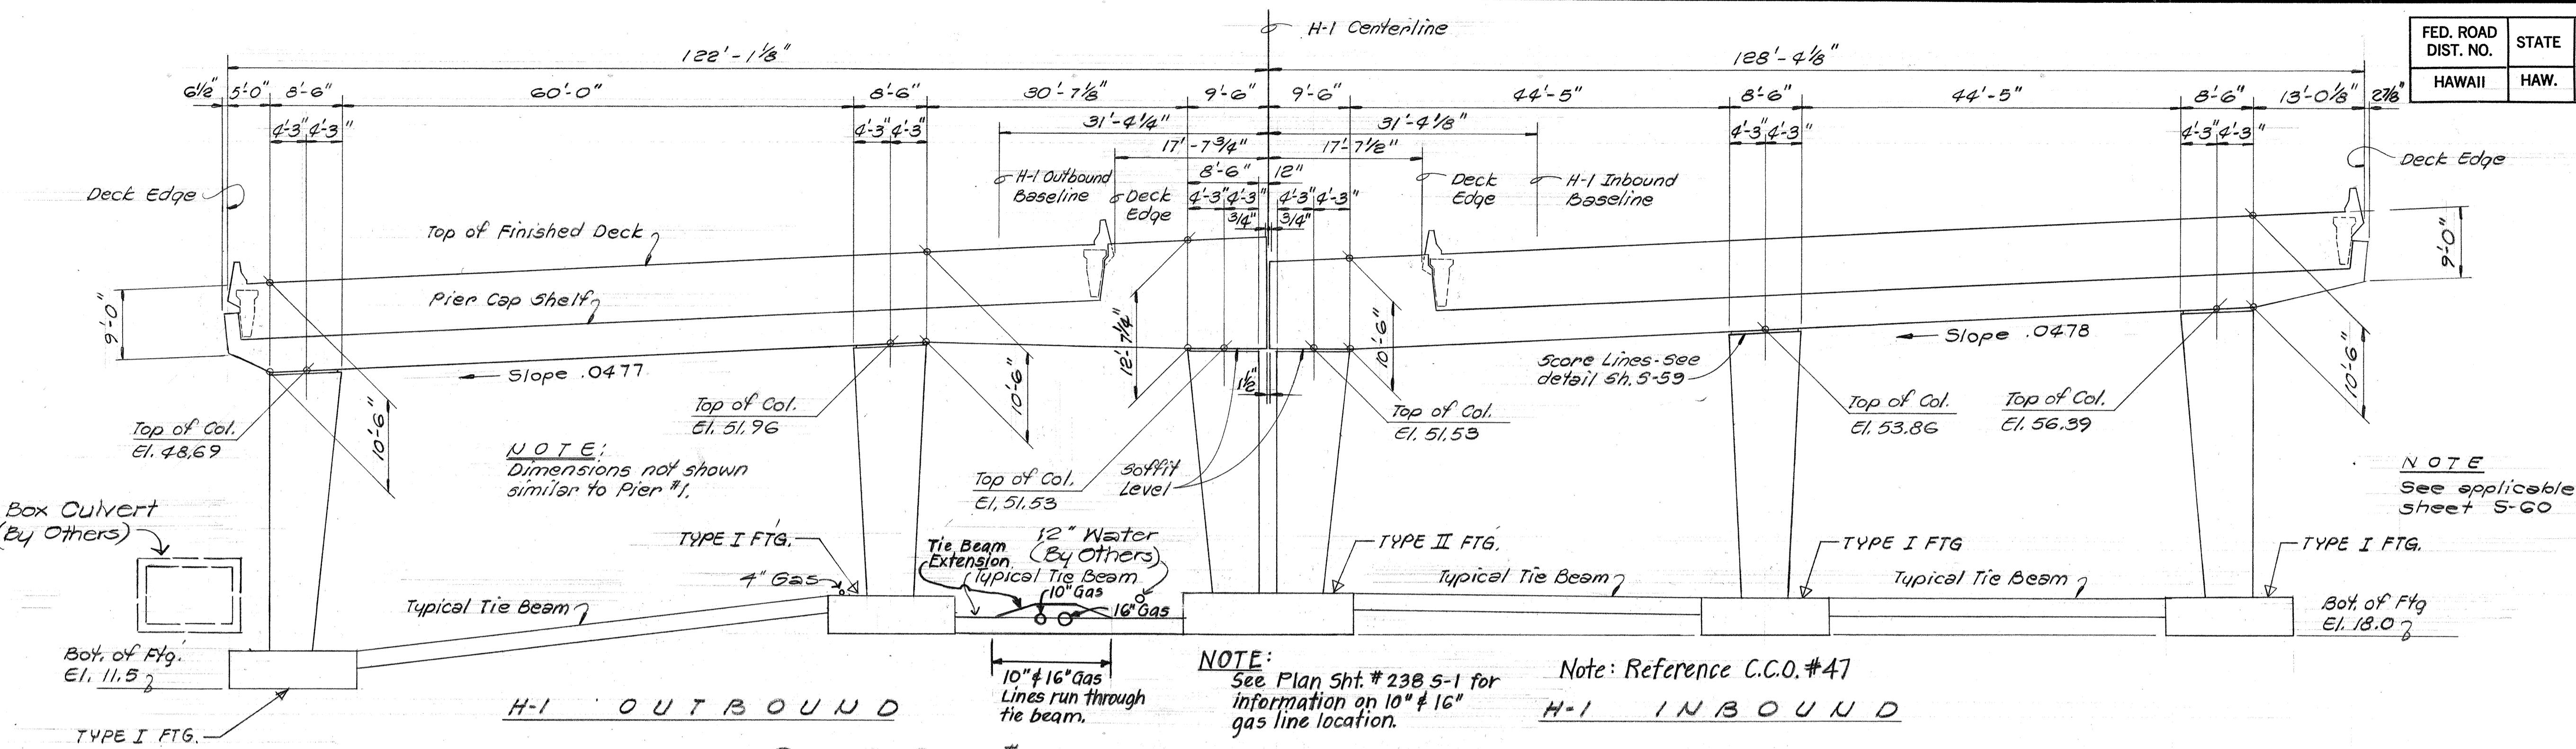

PIER #4 ELEVATION (EXPANSION)

3/32" = 1'-0" (All dimensions are given along pier)

SHIMAZU SHIMABUKURO & FUKUDA, INC.
Consulting Structural Engineers
1210 Ward Ave., Honolulu, HI 96814

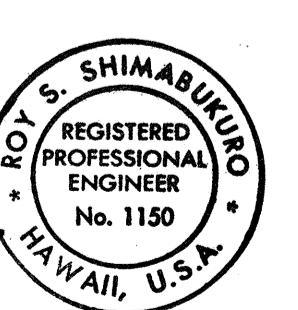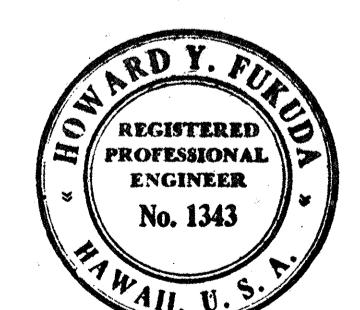

THIS WORK WAS PREPARED BY ME
OR UNDER MY SUPERVISION


STATE OF HAWAII
DEPARTMENT OF TRANSPORTATION
HIGHWAYS DIVISION

STRUCTURE No.8
PIER #3 & #4 ELEVATIONS


PEARL HARBOR INTERCHANGE
F.A.I. Proj. No 1-HI-1 (73)-15

Scale! As Shown Date: DEC. 7/1973
SHEET No. 5-60 OF 106 SHEETS

FED. ROAD DIST. NO.	STATE	FED. AID PROJ. NO.	FISCAL YEAR	SHEET NO.	TOTAL SHEETS
HAWAII	HAW.	I-HI-1(73)-5	1974	277	369

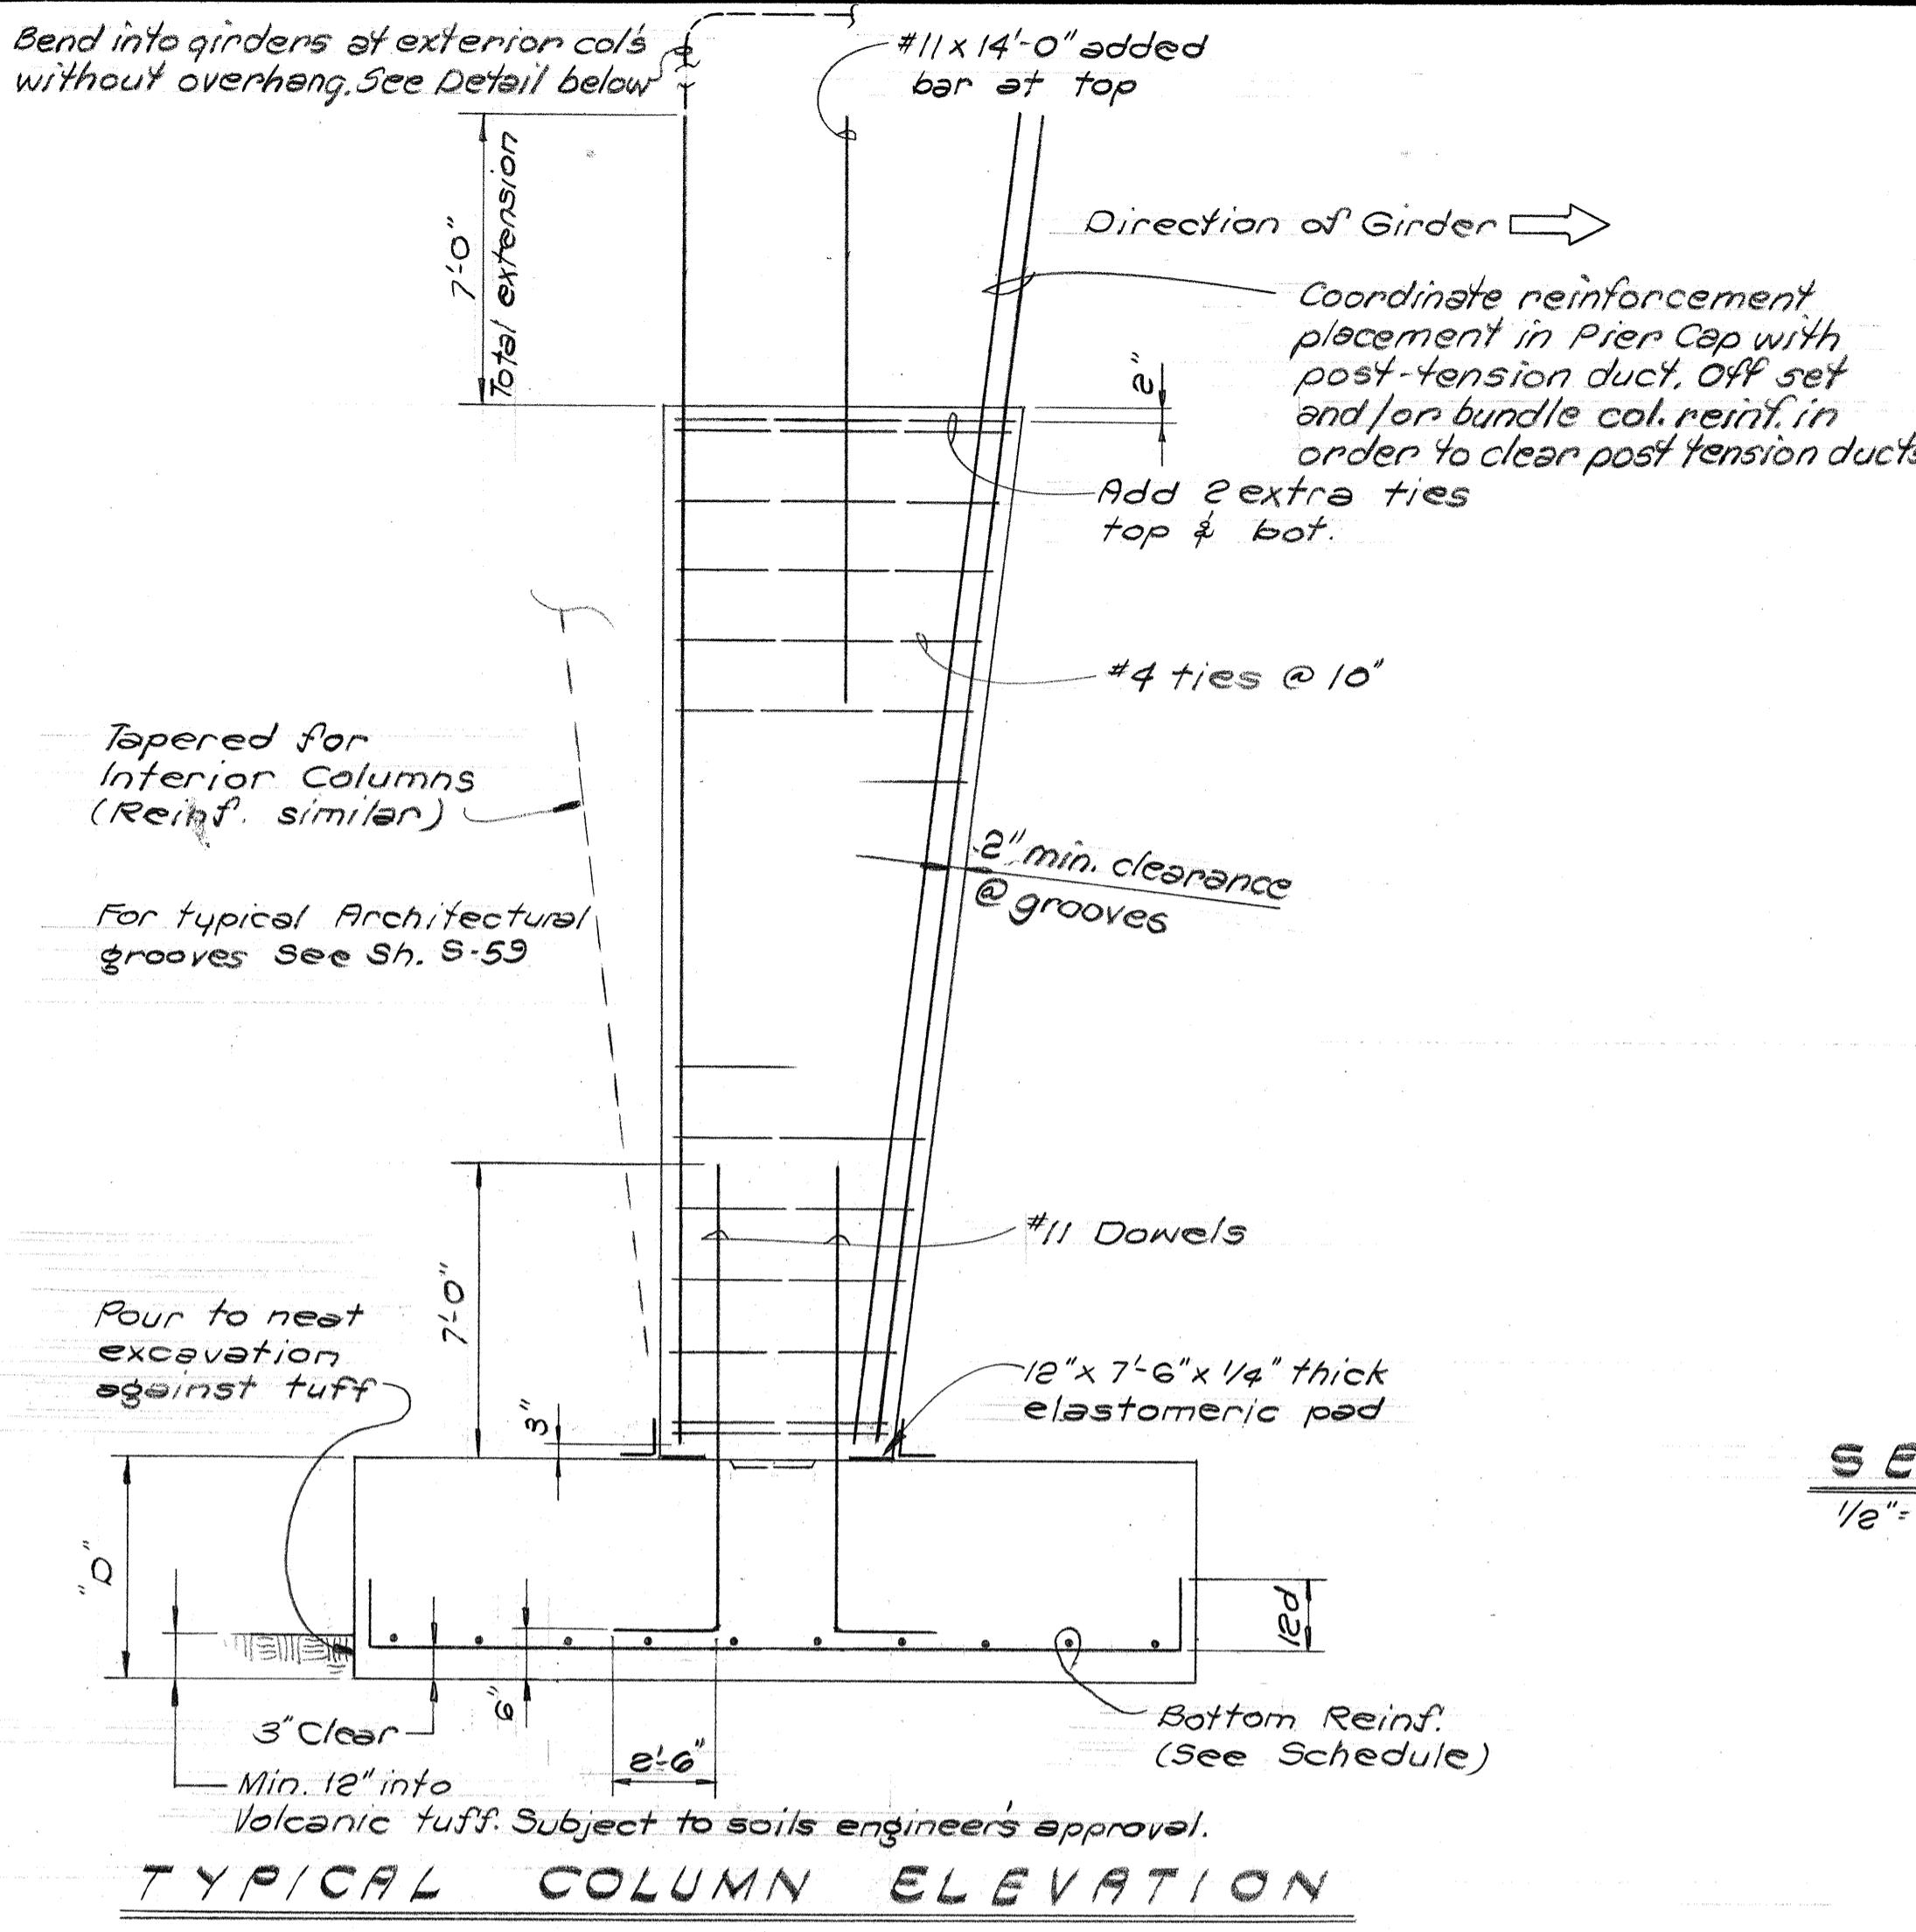


TYPIICAL COLUMN ELEVATION

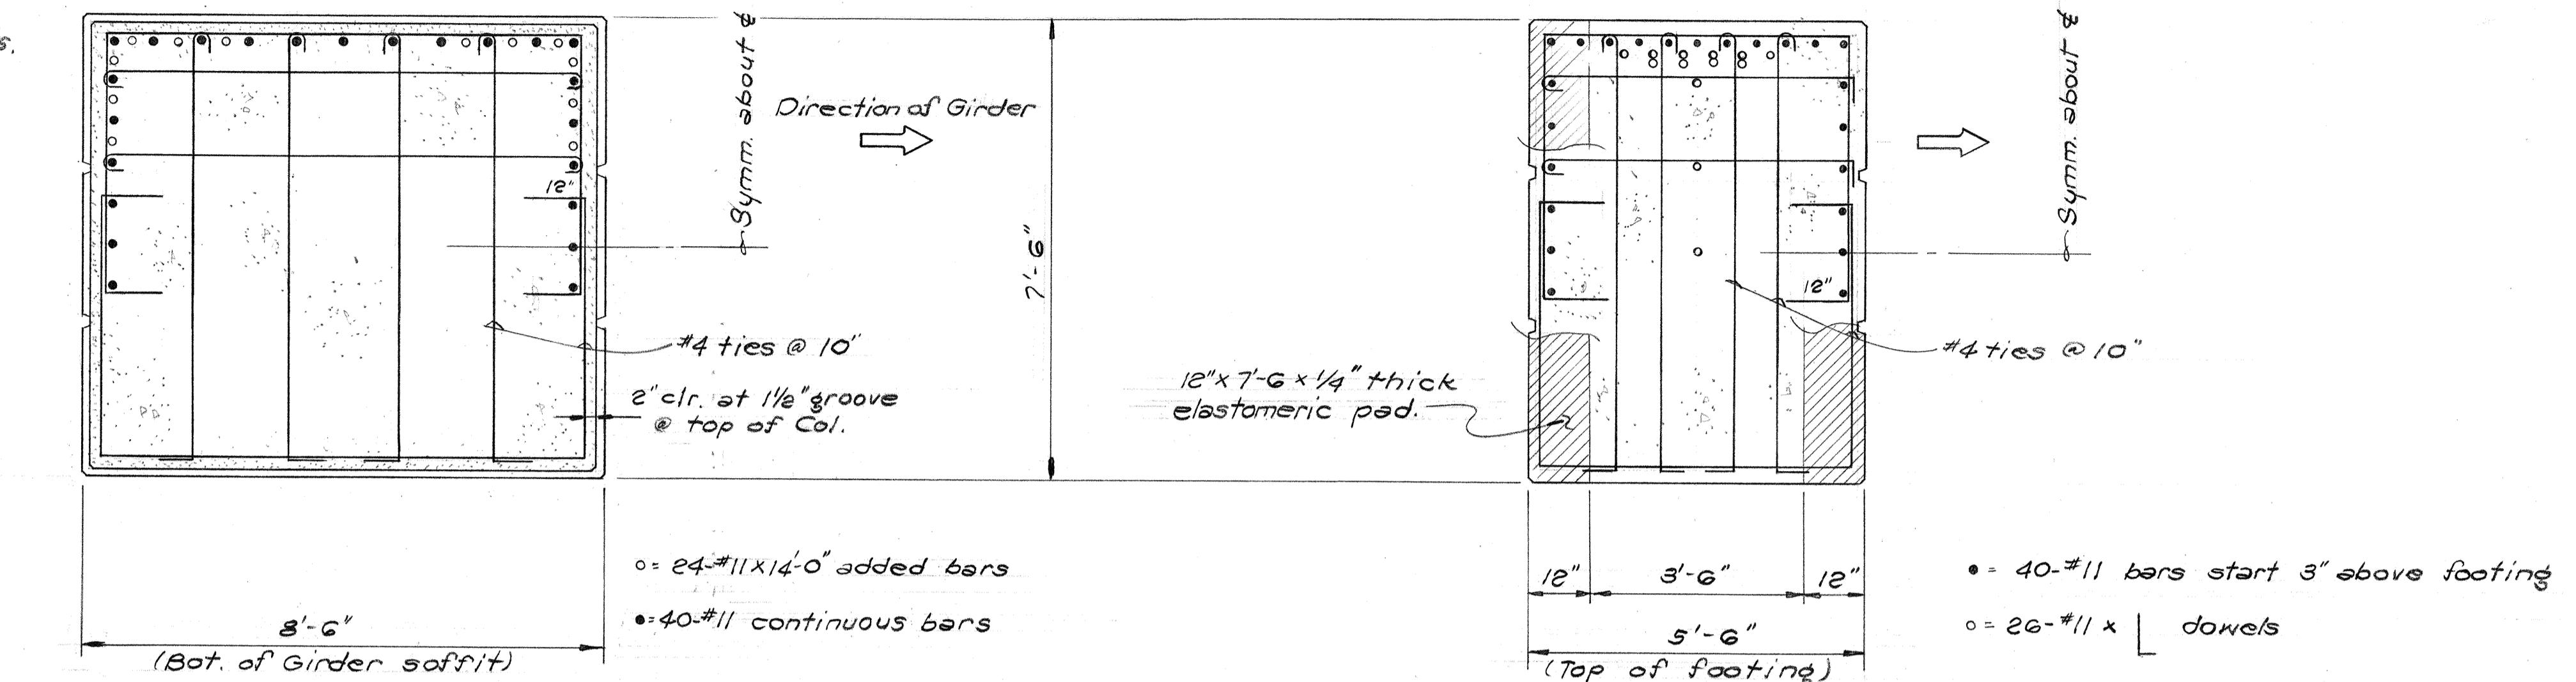


SECTION AT TOP OF COLUMN

SECTION AT TOP OF FOOTING

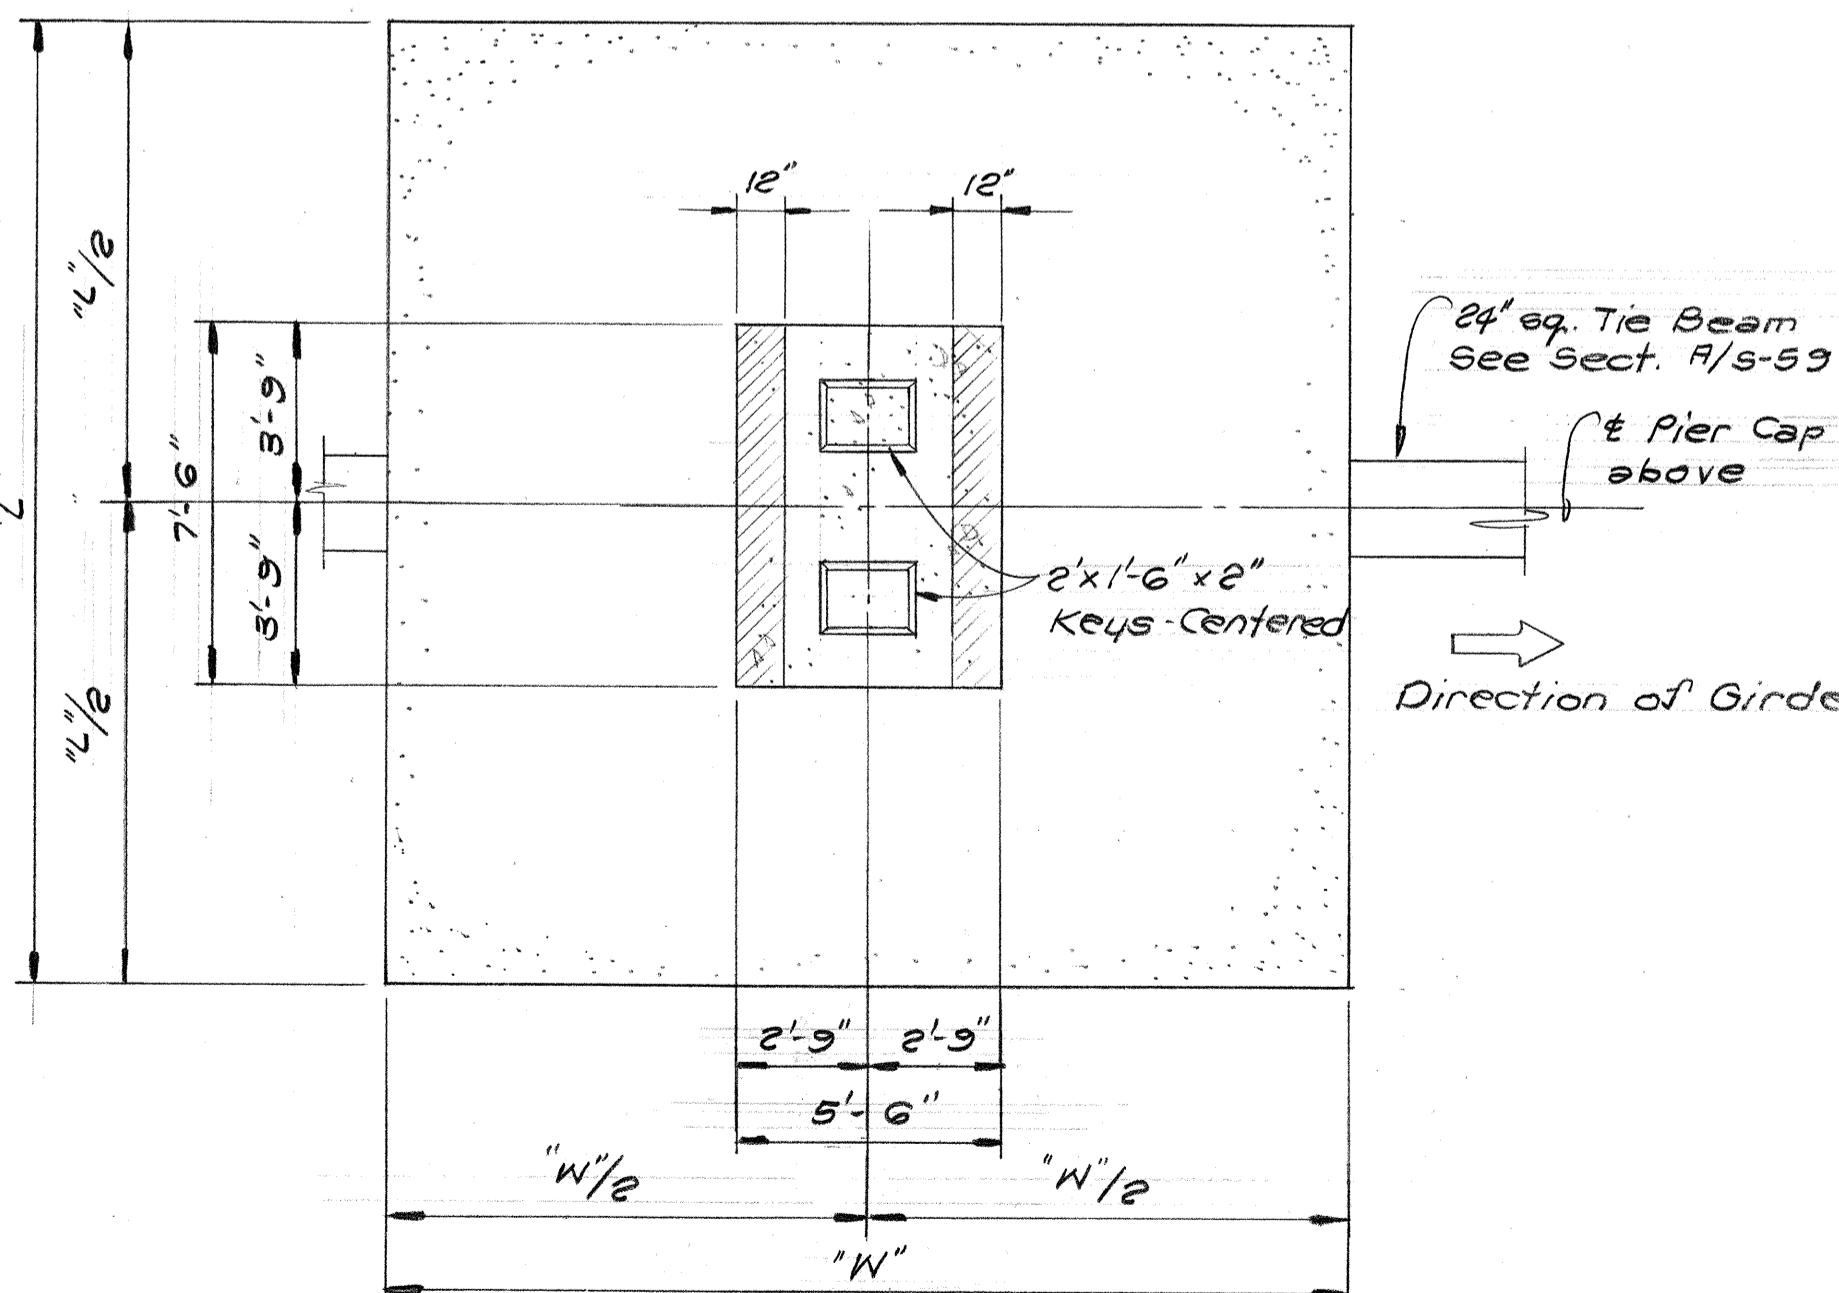

PLAN

PIER FOOTING SCHEDULE				
MARK TYPES	"L"	"W"	"D"	Reinforcement
TYPE I	15'-0"	15'-0"	4'-6"	#8@5 1/2" E.W. Bot.
TYPE II	20'-0"	20'-0"	5'-0"	#8@6" E.W. Bot. #8@6" Top in "W" direction #8@12" Top in "L" direction

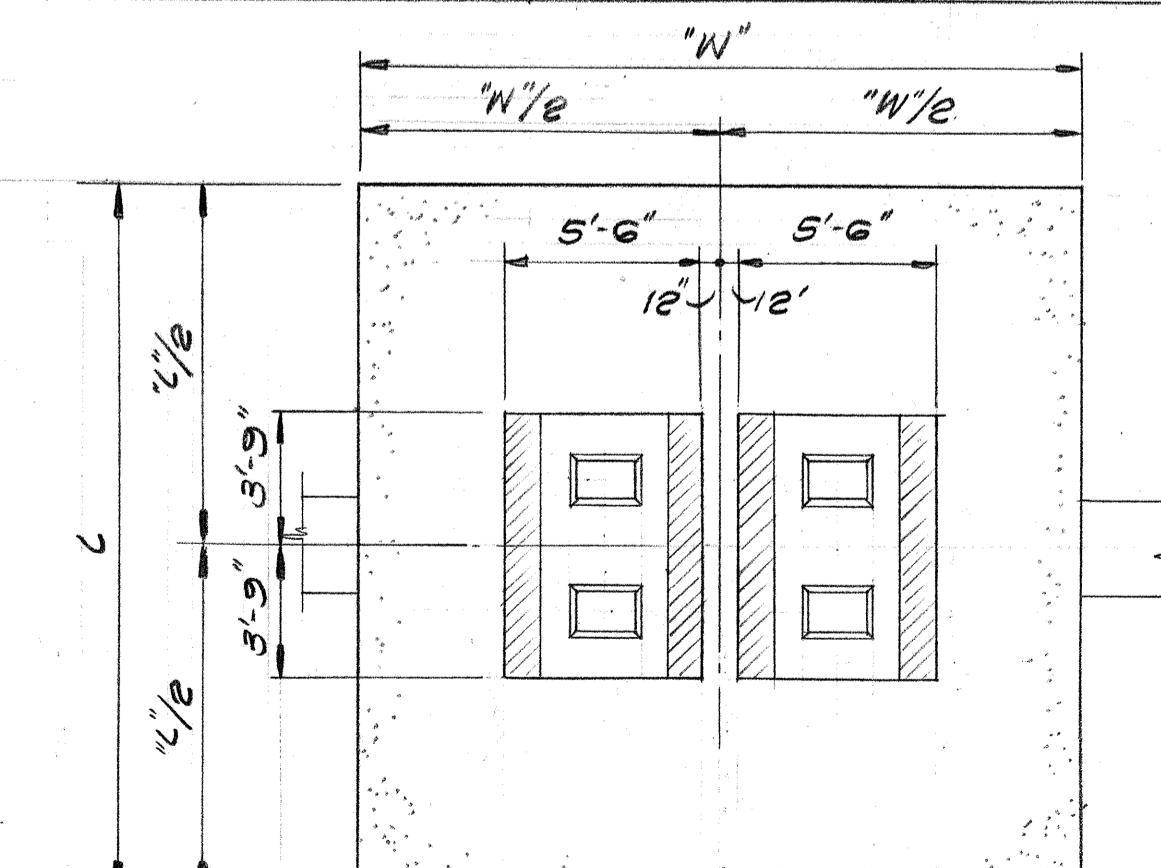

COLUMN REINF. AT NO OVERHANG OR WHERE OVERHANG IS 5'-0" OR LESS

N.T.S.

SHIMABUKURO & FUKUDA, INC.
Consulting Structural Engineers
1818 Ward Ave., Honolulu, HI 96814

HOWARD Y. FUKUDA
REGISTERED PROFESSIONAL ENGINEER
No. 1343
HAWAII, U.S.A.

ROY S. SHIMABUKURO
REGISTERED PROFESSIONAL ENGINEER
No. 1150
HAWAII, U.S.A.

THIS WORK WAS PREPARED BY ME
OR UNDER MY SUPERVISION

STATE OF HAWAII
DEPARTMENT OF TRANSPORTATION
HIGHWAYS DIVISION

STRUCTURE No. 8
PIER COLUMN &
FOOTING DETAILS

PEARL HARBOR INTERCHANGE
F.A.I. Proj. No. I-HI-1 (73)-5
Scope: As Shown Date: DEC. 7, 1973
SHEET NO. 5-61 OF 106 SHEETS

FED. ROAD DIST. NO.	STATE	FED. AID PROJ. NO.	FISCAL YEAR	SHEET NO.	TOTAL SHEETS
HAWAII	HAW.	I-HI-1(73)-15	1974	C0277S-1	369

H-I Centerline

8'-6"

#11 x 20'-0" added
bar at top

Continuous #11 bar


Coordinate reinforcement placement in Pier Cap with post-tension duct, off set end/or bundle column reinf, in order to clear post-tension ducts. Coordinate with post-tension Contractor.

8'-6" @ Bot. of Girder Soffit

Add 13-#11 x 20'-0"
each face of col.

Original bars shown light

Direction of Girder

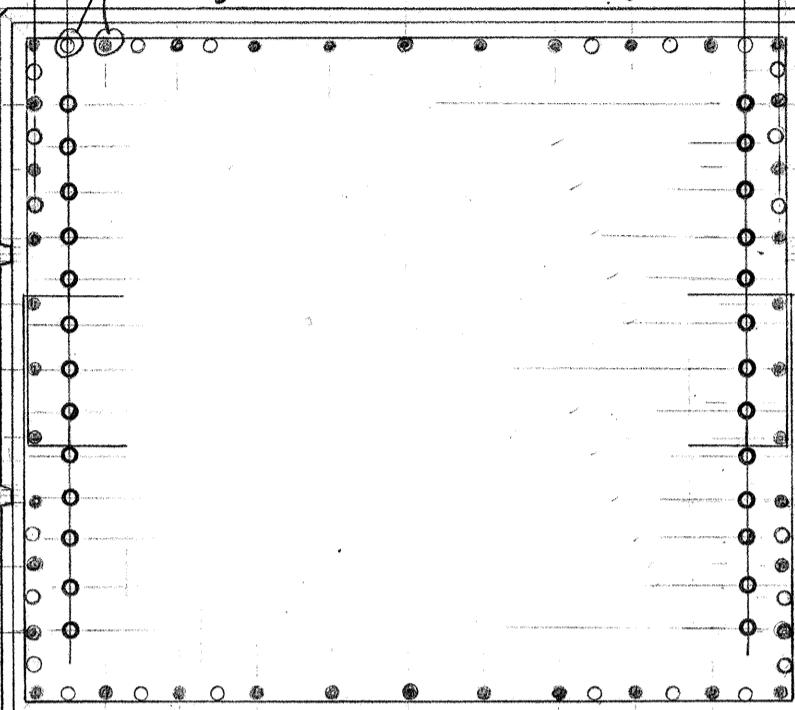

Cont. #11 bars

Original number of added #11 x 14'-0" = 24 total
New total = 50 bars with addition of 13 each face
x 20' shown in layer number two in column section above.

Total number of cont. #11 bars = 40 (same as original)

Added #11 bars

SECTION @ TOP OF COLUMN

1/8" = 1'-0"

H-I OUTBOUND

H-I INBOUND

5'-6"


COLUMN ELEVATION ~ H-I OUTBOUND - PIER #4

1/8" = 1'-0"

7/21/75 Added Steel Reinforcement

DATE REVISION

SHIMADUZU SHIMABUKURO & FUJUDA, INC.
Consulting Structural Engineers
1210 Ward Ave., Honolulu, HI 96814

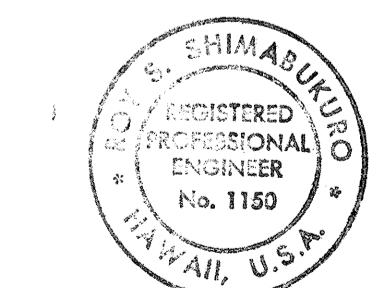

STATE OF HAWAII
DEPARTMENT OF TRANSPORTATION
HIGHWAYS DIVISION

STRUCTURE No. 8

PIER #4 COL. ~ H-I OUTBOUND
COL. ADJACENT TO H-I CENTERLINE

PEARL HARBOR INTERCHANGE
F.A.I. Proj. No I - HI - I (73) : 15




This work was prepared by
me or under my supervision,
M. Shima

SCALE 1 AS SHOWN
DATE: JULY 21, 1975


SHEET No. 56/106 SHEETS

C0277S-1


ORIGINAL	PLATED BY
PLAN	DRAWN BY
NOTE BOOK	TRACED BY
No. _____	DESIGNED BY
QUANTITIES BY	CHECKED BY

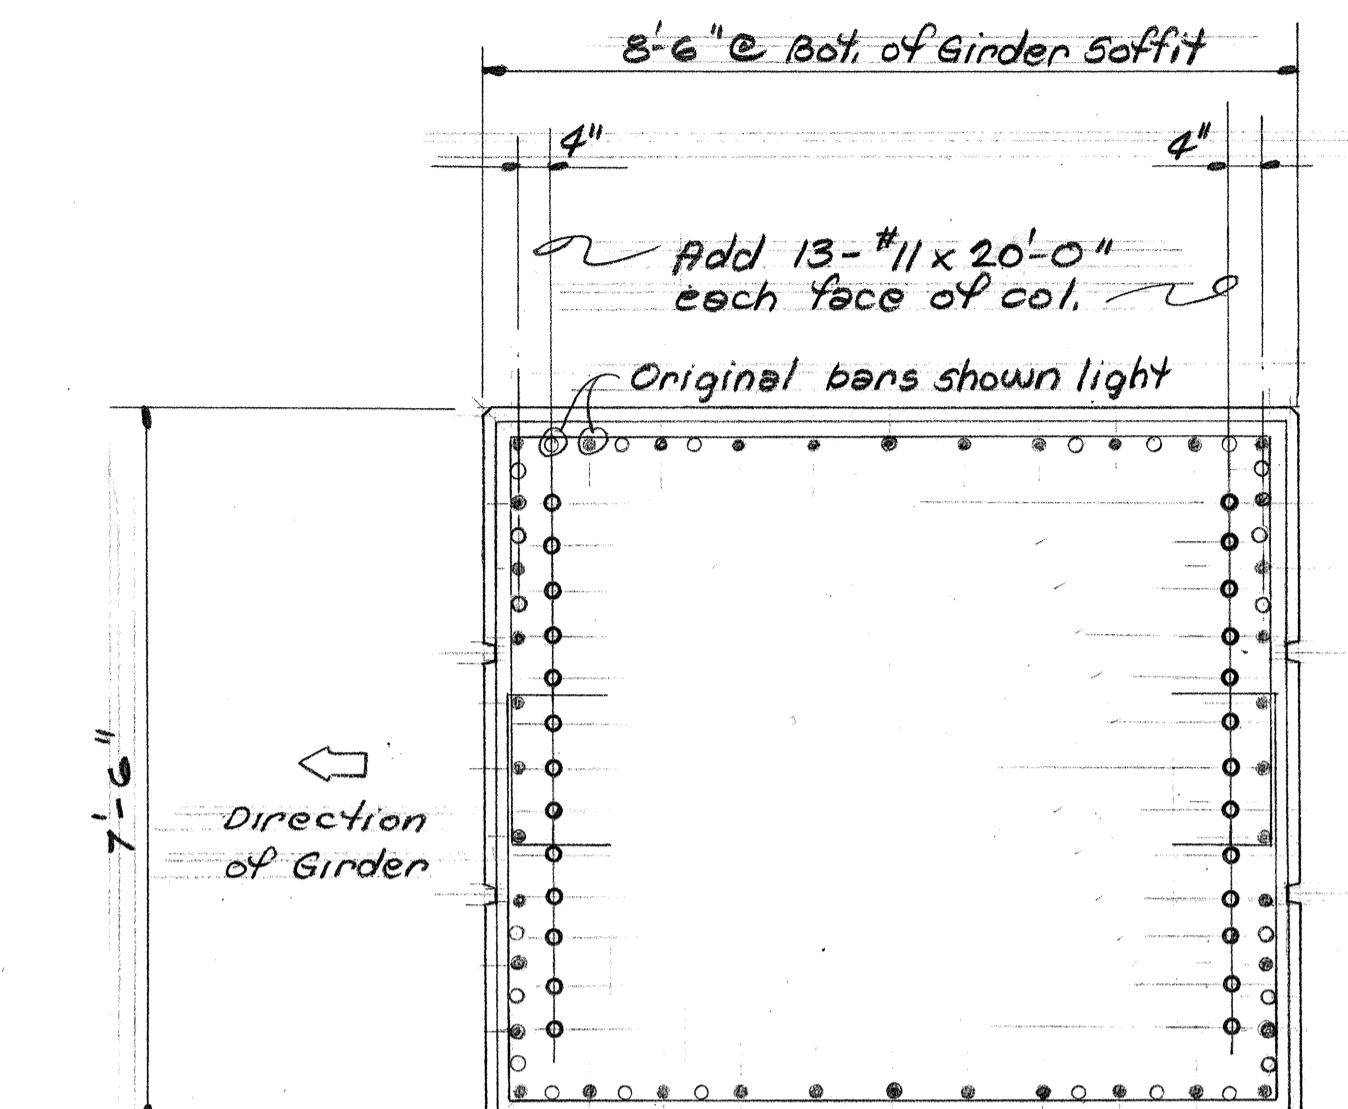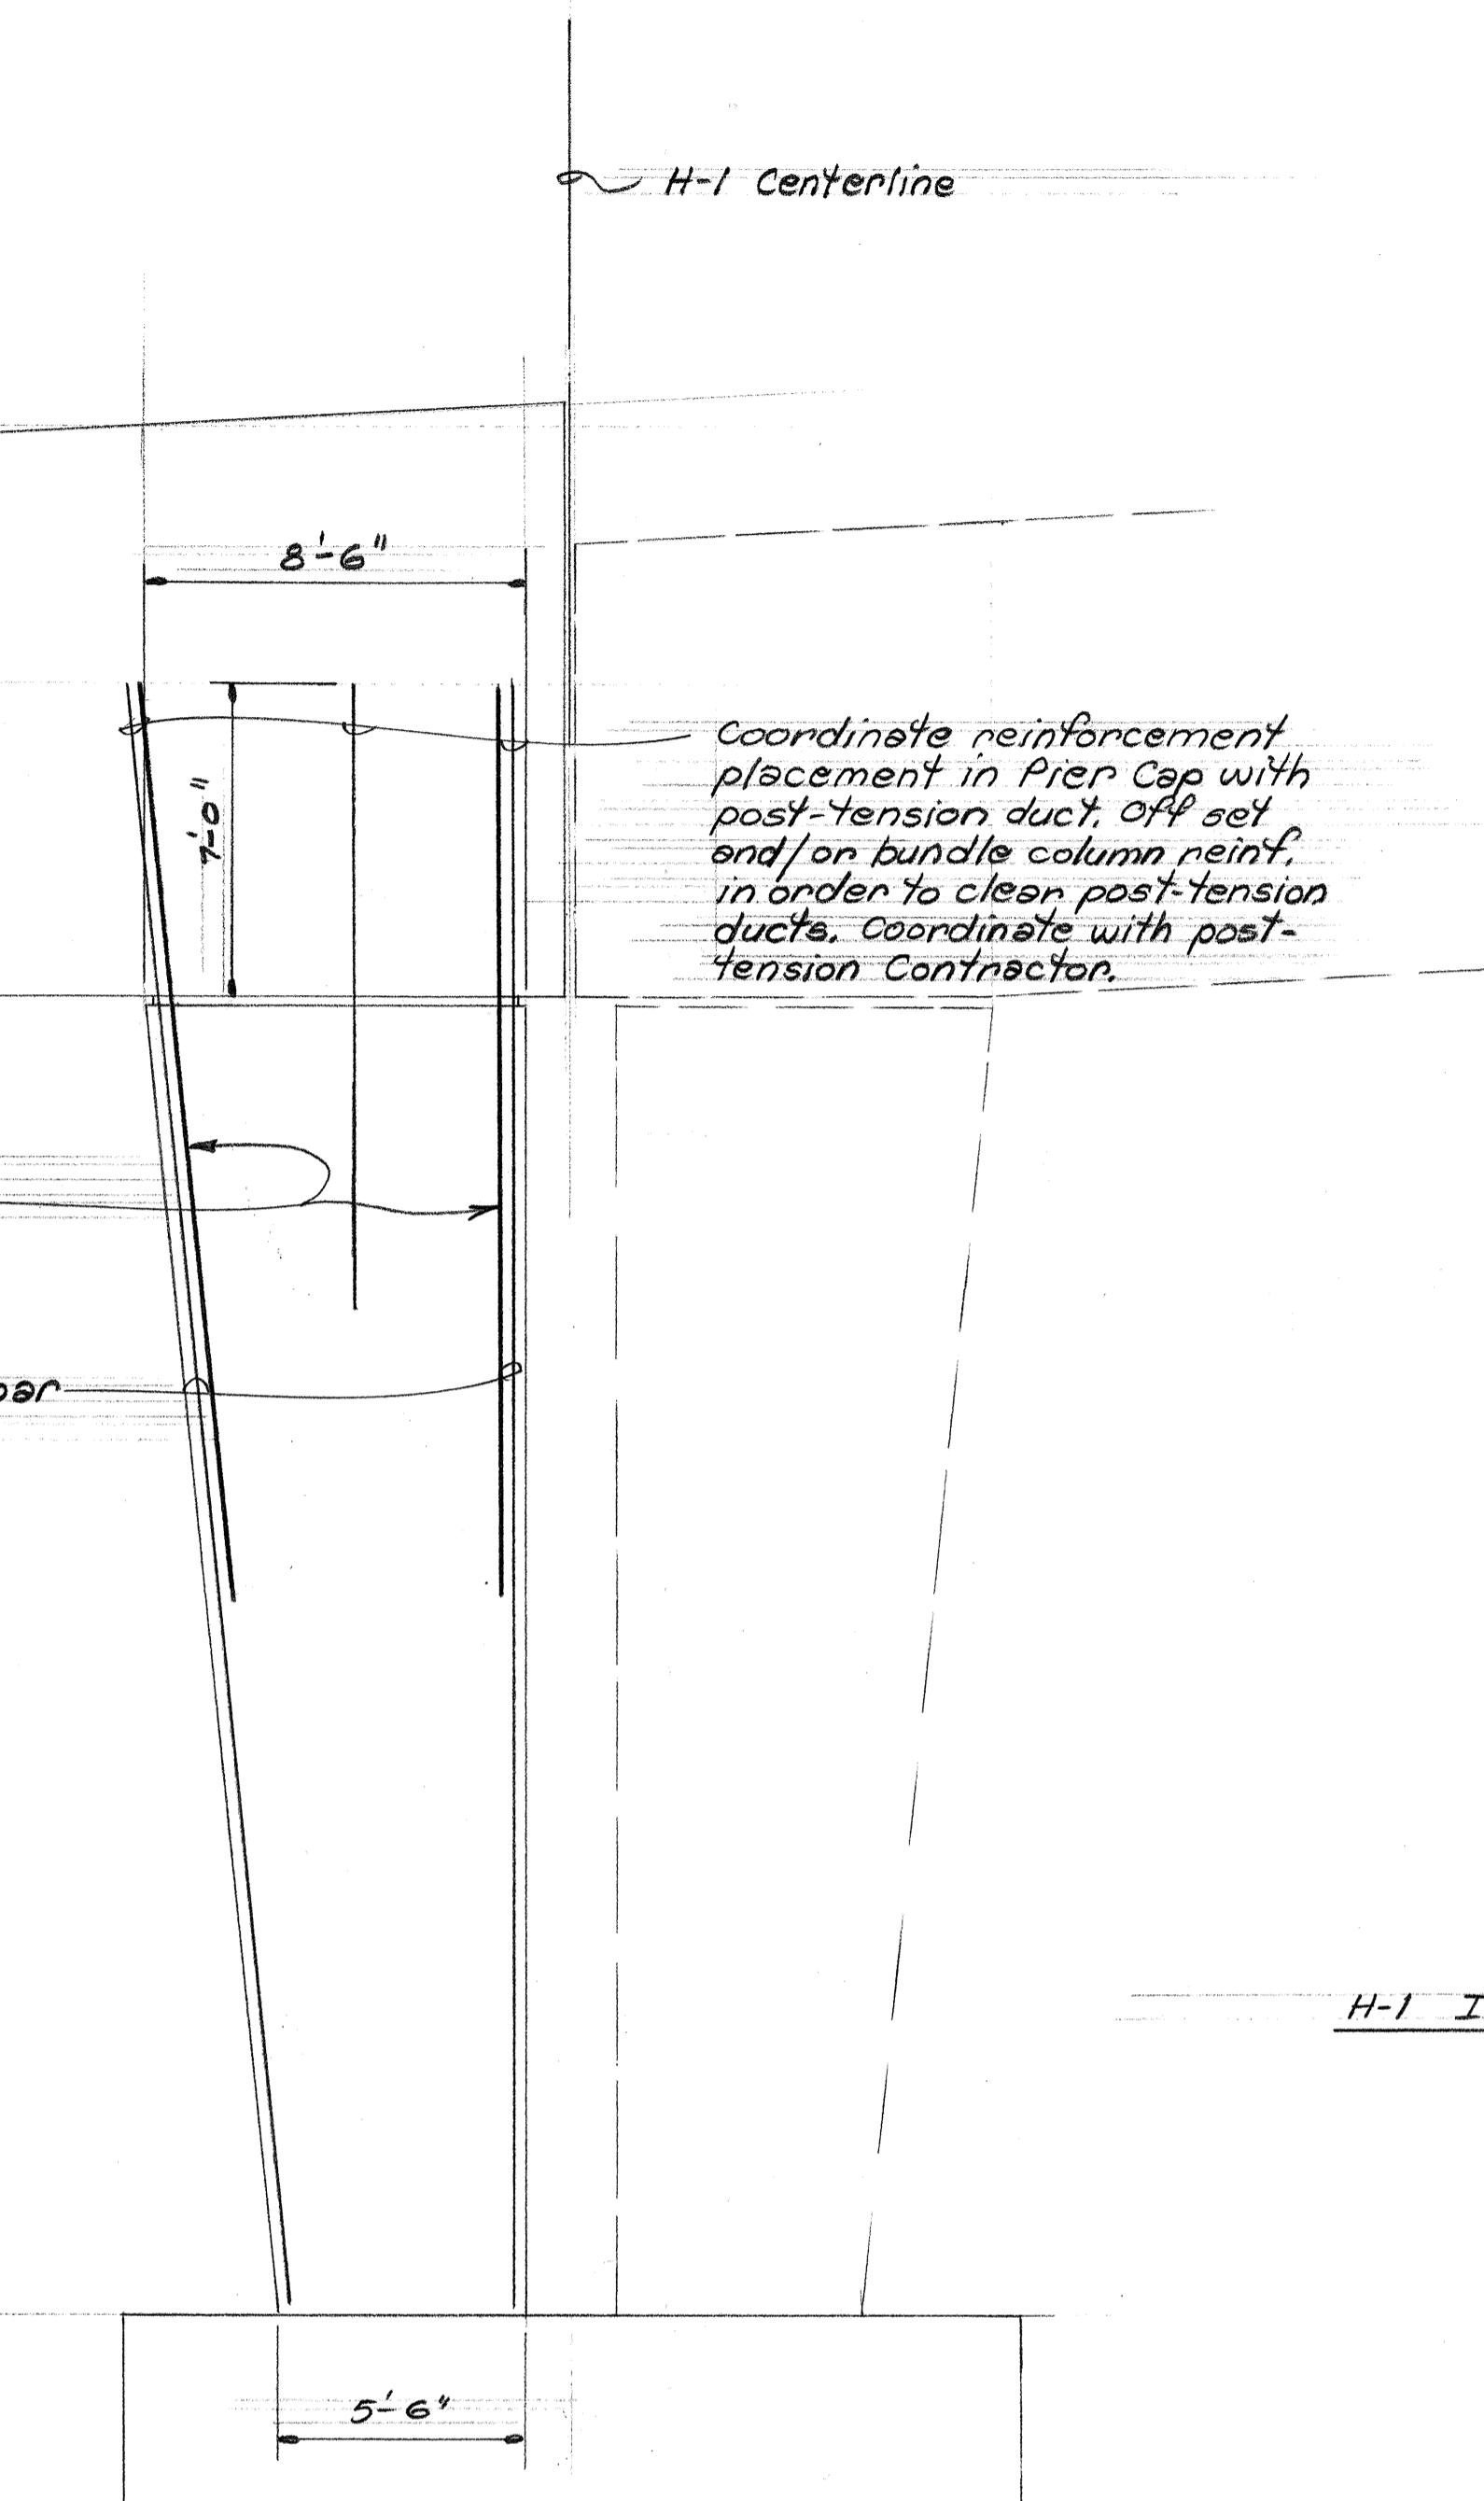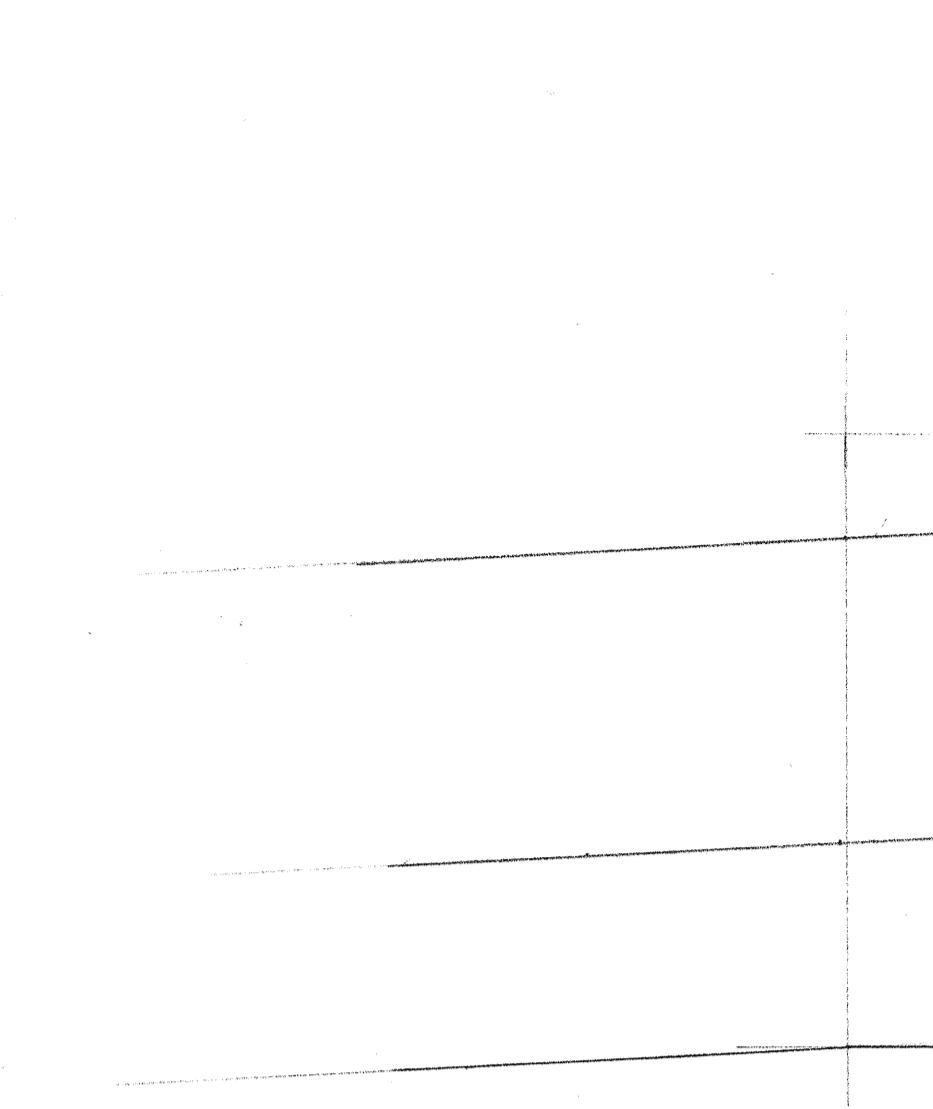

ORIGINAL	PLATED BY
PLAN	DRAWN BY
NOTE BOOK	TRACED BY
No. _____	DESIGNED BY
QUANTITIES BY	CHECKED BY

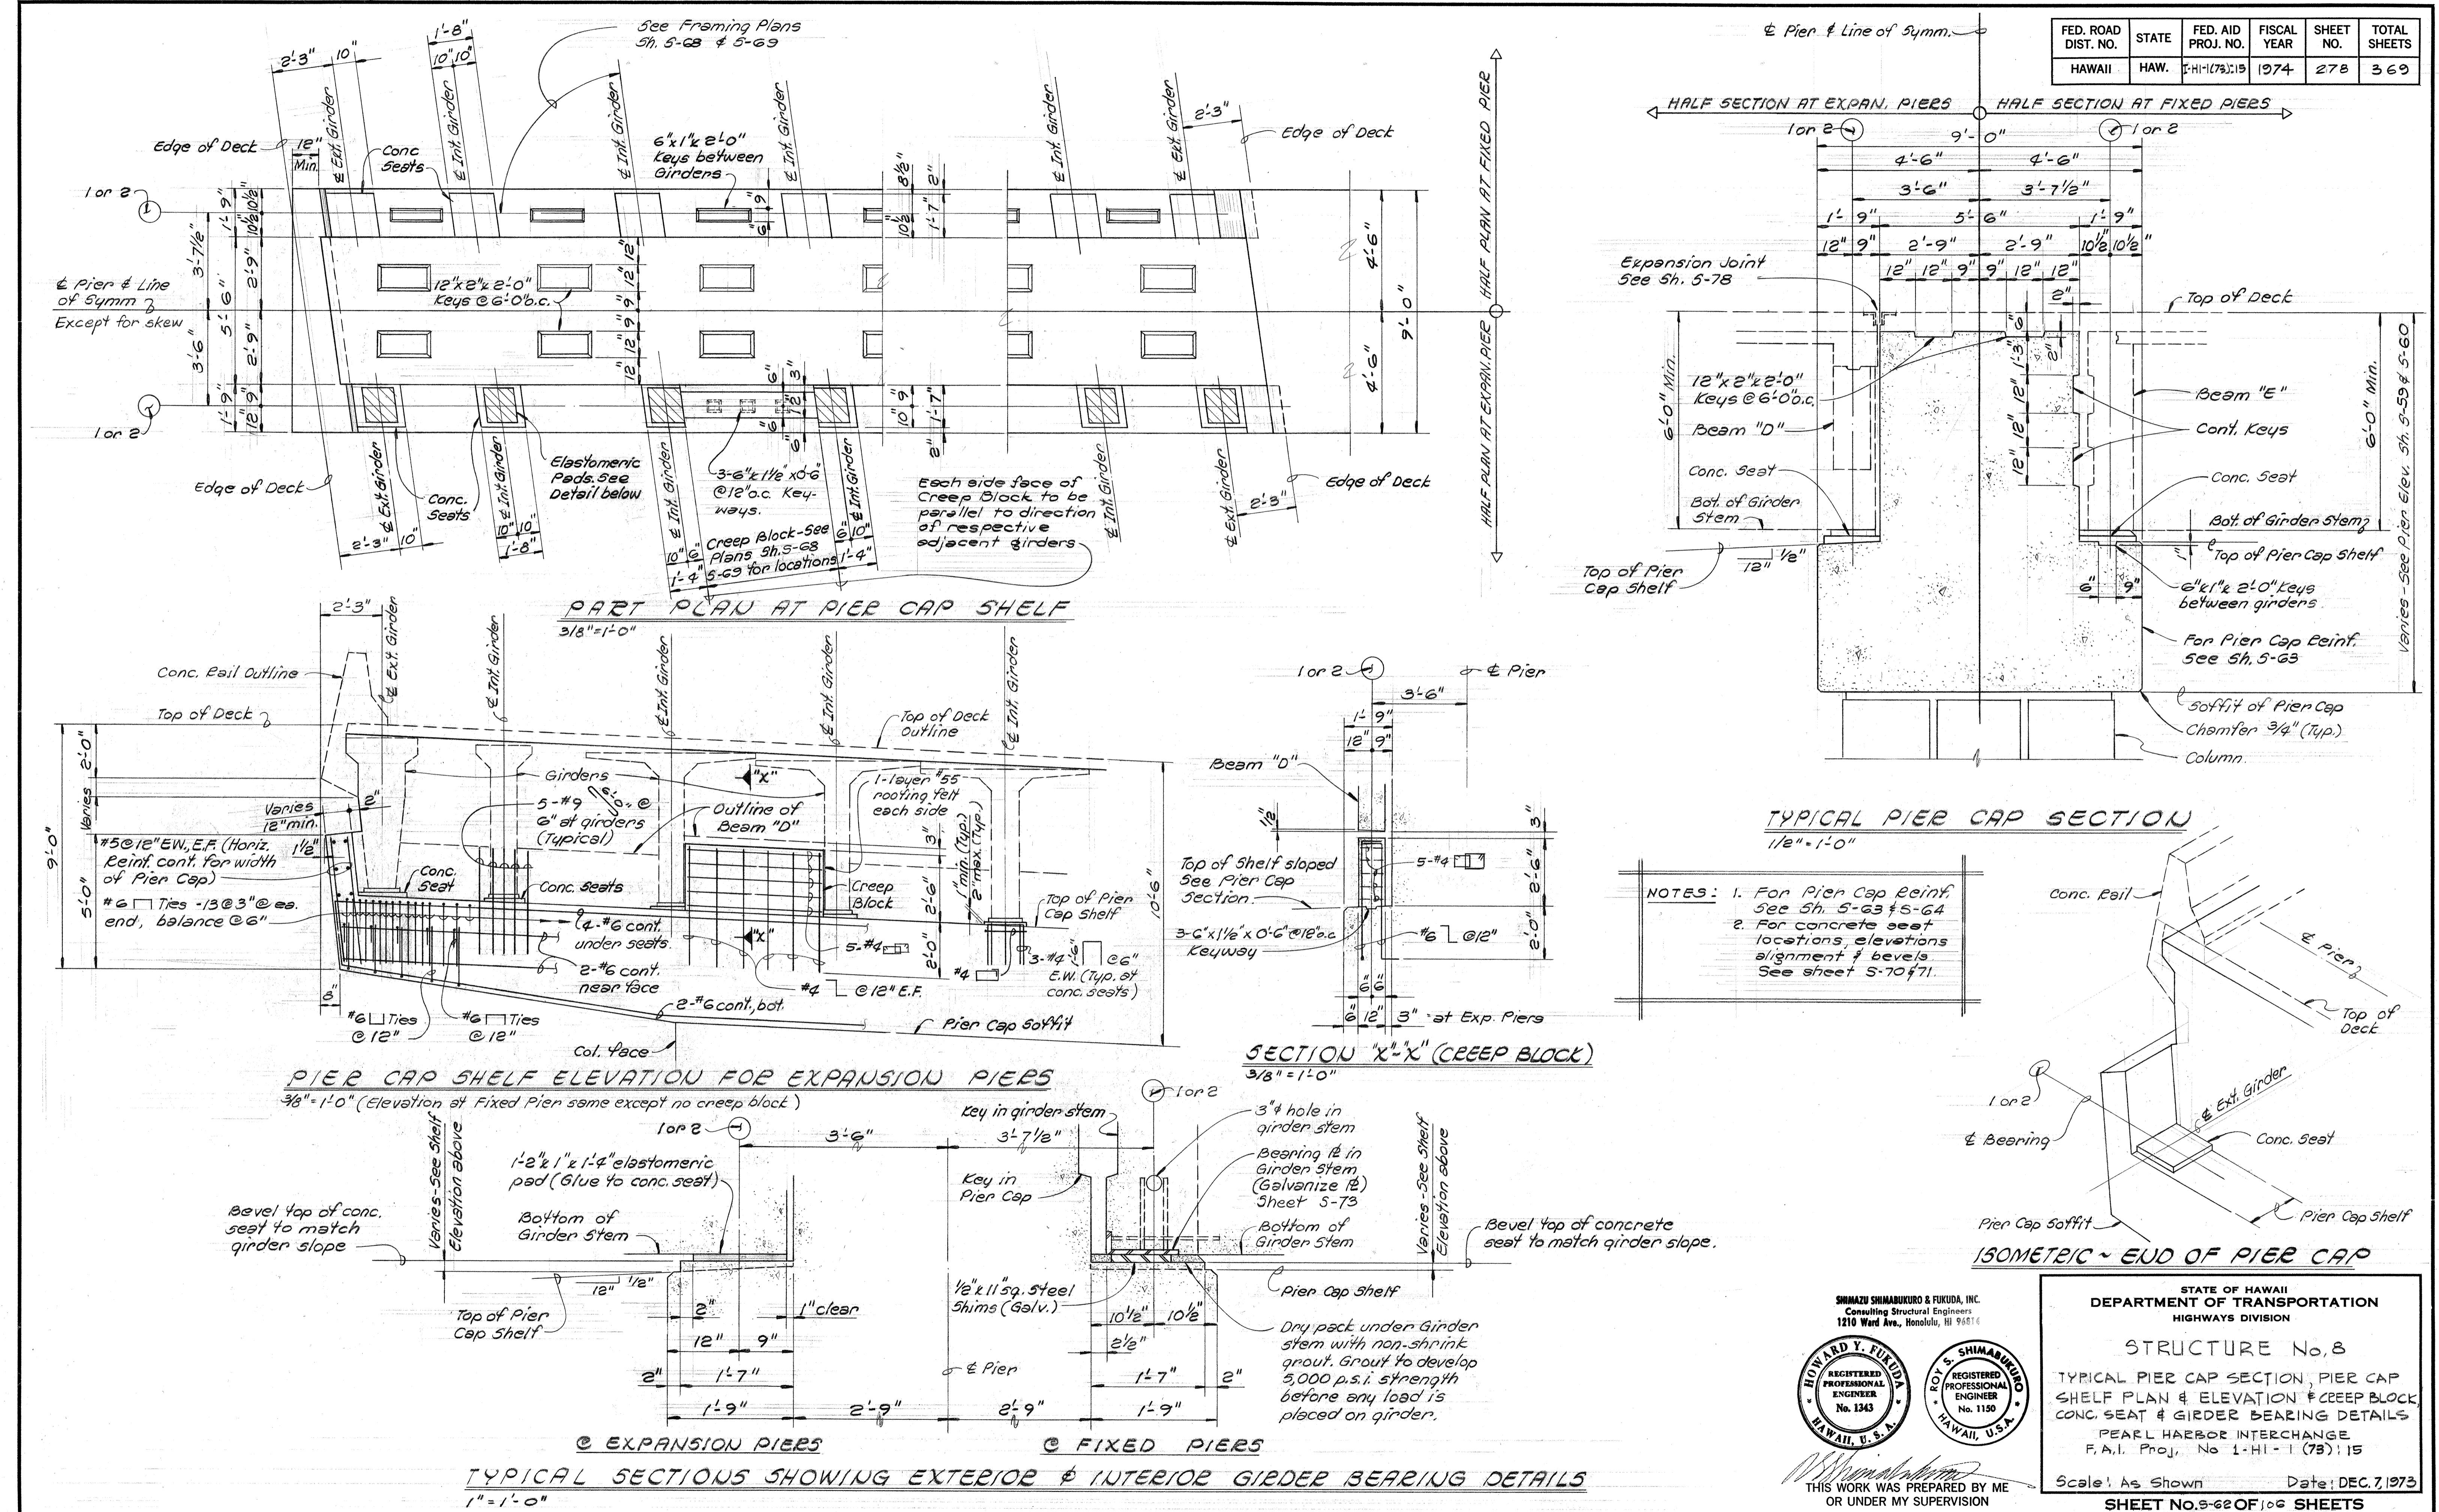

ORIGINAL PLAN	DATE
DRAWN BY	"
TRACED BY	"
DESIGNED BY	"
QUANTITIES BY	"
CHECKED BY	"

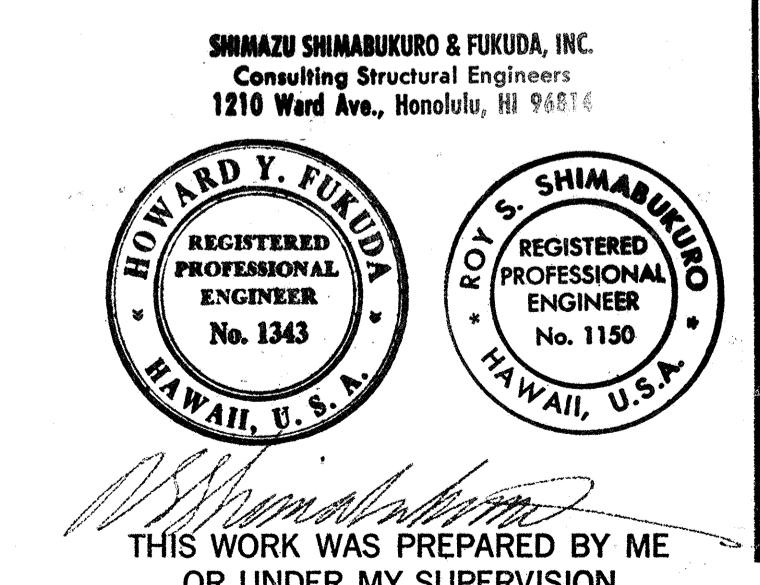


STRUCTURE No. 8

TYPICAL PIER CAP SECTION, PIER CAP SHELF PLAN & ELEVATION & CREEP BLOCK CONC. SEAT & GIRDER BEARING DETAILS PEARL HARBOR INTERCHANGE F.A.I. Proj. No 1-HI-1 (73) 15

Scale: As Shown Date: DEC. 7, 1973

SHEET NO. S-62 OF 106 SHEETS

FED. ROAD DIST. NO.	STATE	FED. AID PROJ. NO.	FISCAL YEAR	SHEET NO.	TOTAL SHEETS
HAWAII	HAW.	I-HI-1(73)-15	1974	279	369

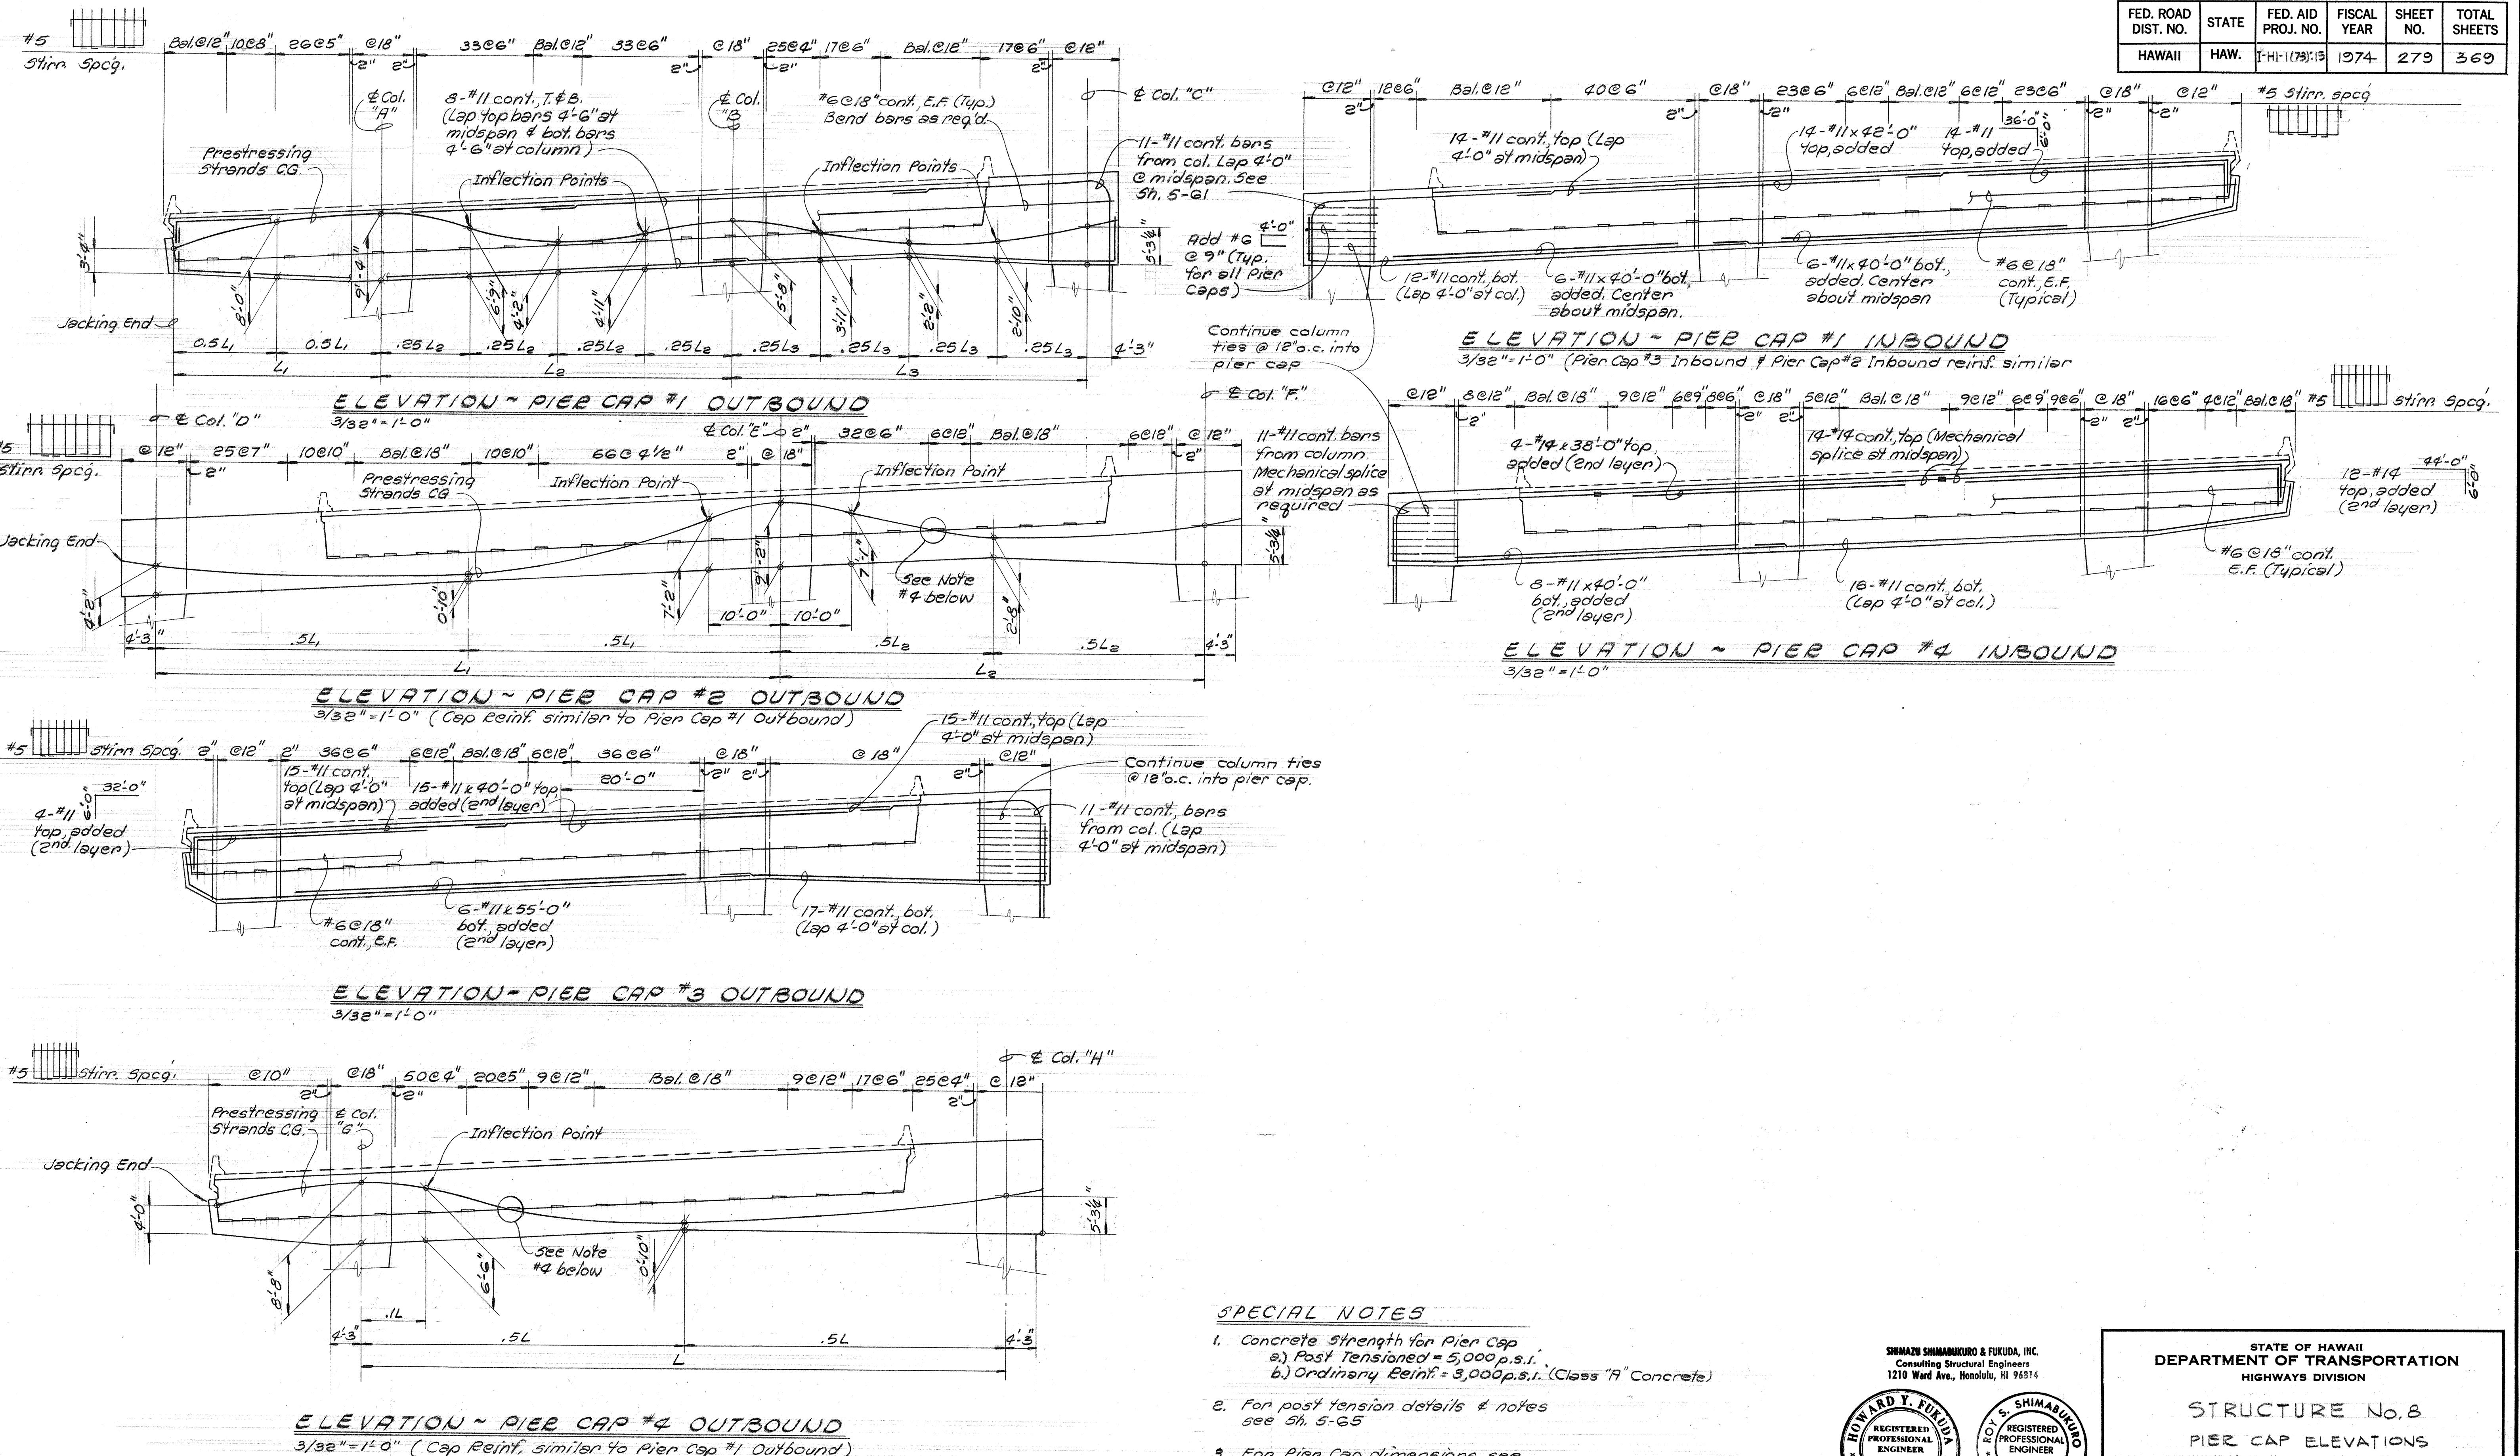


ORIGINAL SURVEY PLOTTED BY
PLANS DRAWN BY
TRANSFERRED BY
DESIGNED BY
QUANTITY BY
CHECKED BY

SPECIAL NOTES

- Concrete Strength for Pier Cap
 - Post Tensioned = 5,000 p.s.i.
 - Ordinary Reinf. = 3,000 p.s.i. (Class "A" Concrete)
- For post tension details & notes see Sh. S-65
- For Pier Cap dimensions see Pier Elevation, Sh. S-59 & S-56 & Pier Cap Section Sh. S-64
- Reinforcement interfering with Post Tension Ducts shall be removed as required to clear ducts.

SHIMABUKURO & FUKUDA, INC.
Consulting Structural Engineers
1210 Ward Ave., Honolulu, HI 96814

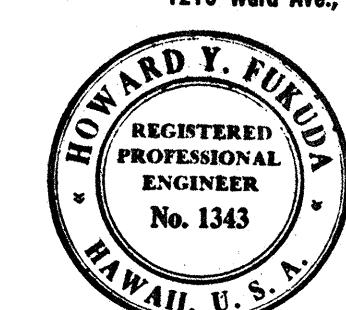

THIS WORK WAS PREPARED BY ME
OR UNDER MY SUPERVISION


STATE OF HAWAII
DEPARTMENT OF TRANSPORTATION
HIGHWAYS DIVISION

STRUCTURE No. 8
PIER CAP ELEVATIONS
SHOWING REINF.

PEARL HARBOR INTERCHANGE
F.A.I. Proj. No. I-HI-1(73)-15


Scale 1: As Shown Date DEC. 7, 1973
SHEET NO. 5-63 OF 106 SHEETS

FED. ROAD DIST. NO.	STATE	FED. AID PROJ. NO.	FISCAL YEAR	SHEET NO.	TOTAL SHEETS
HAWAII	HAW.	I-HI-173-15	1974	280	369

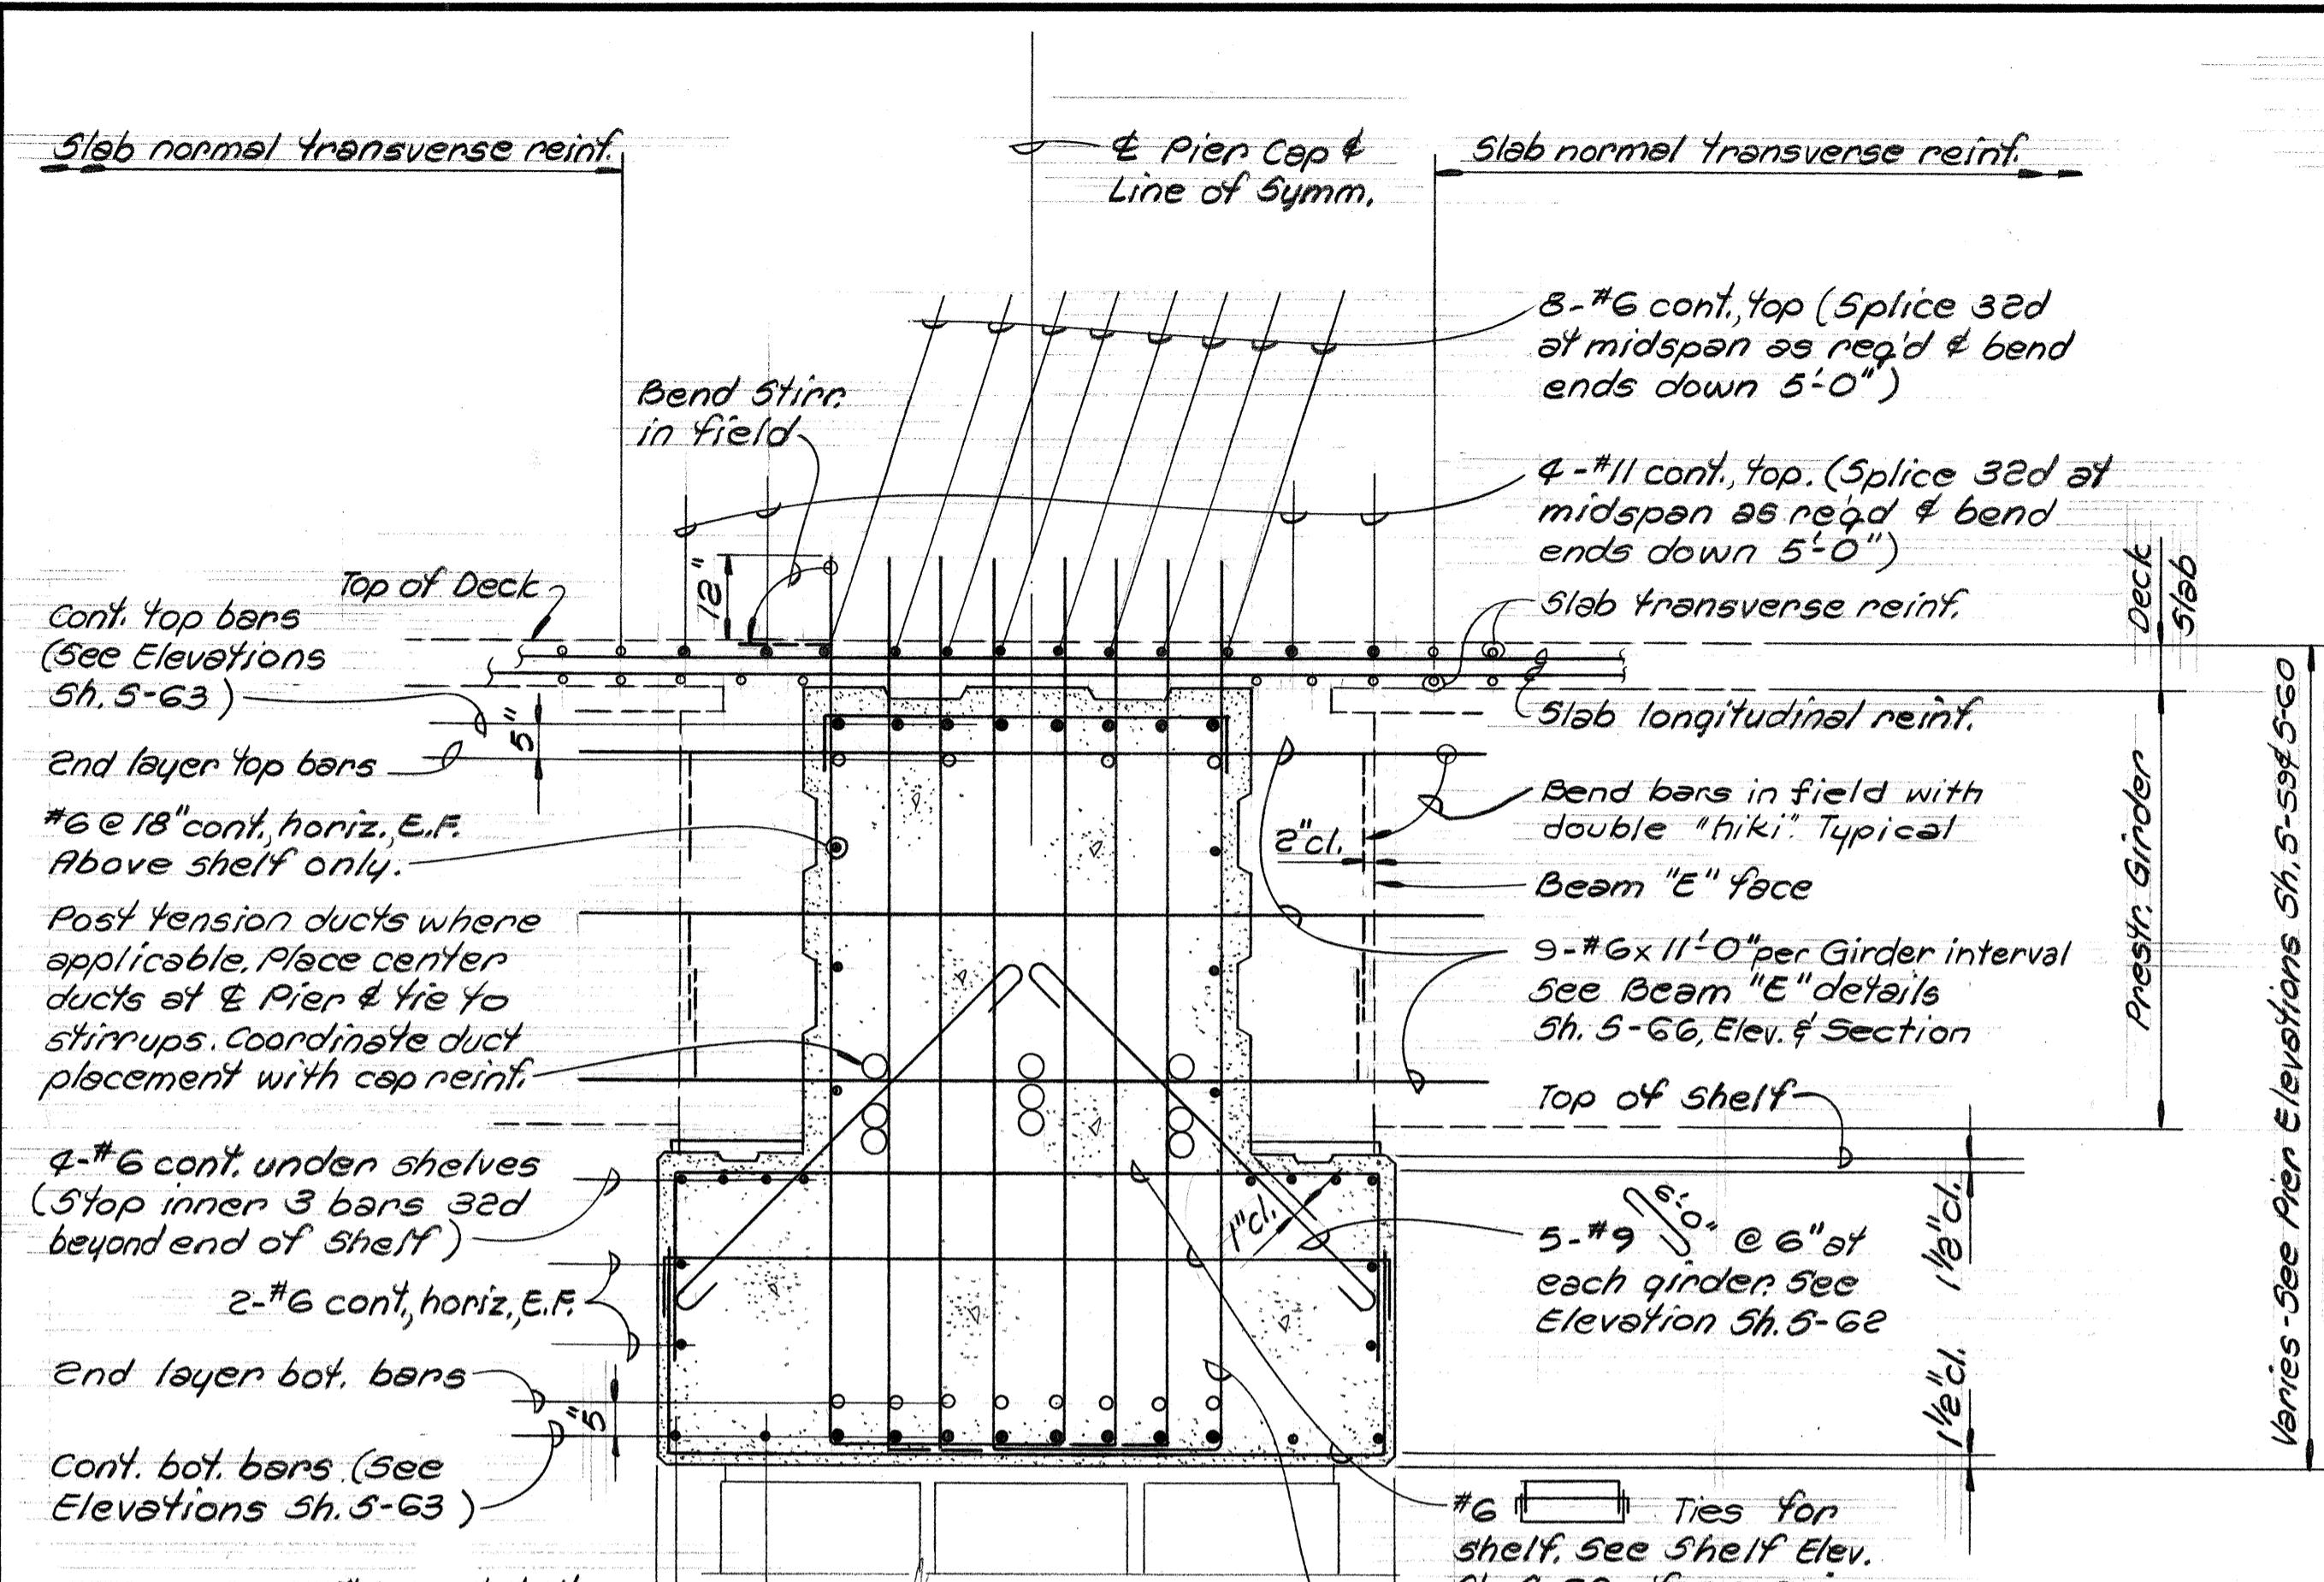


NOTE:
For key dimensions,
See Sh. 5-62

Pier Cap &
Line of Symm.

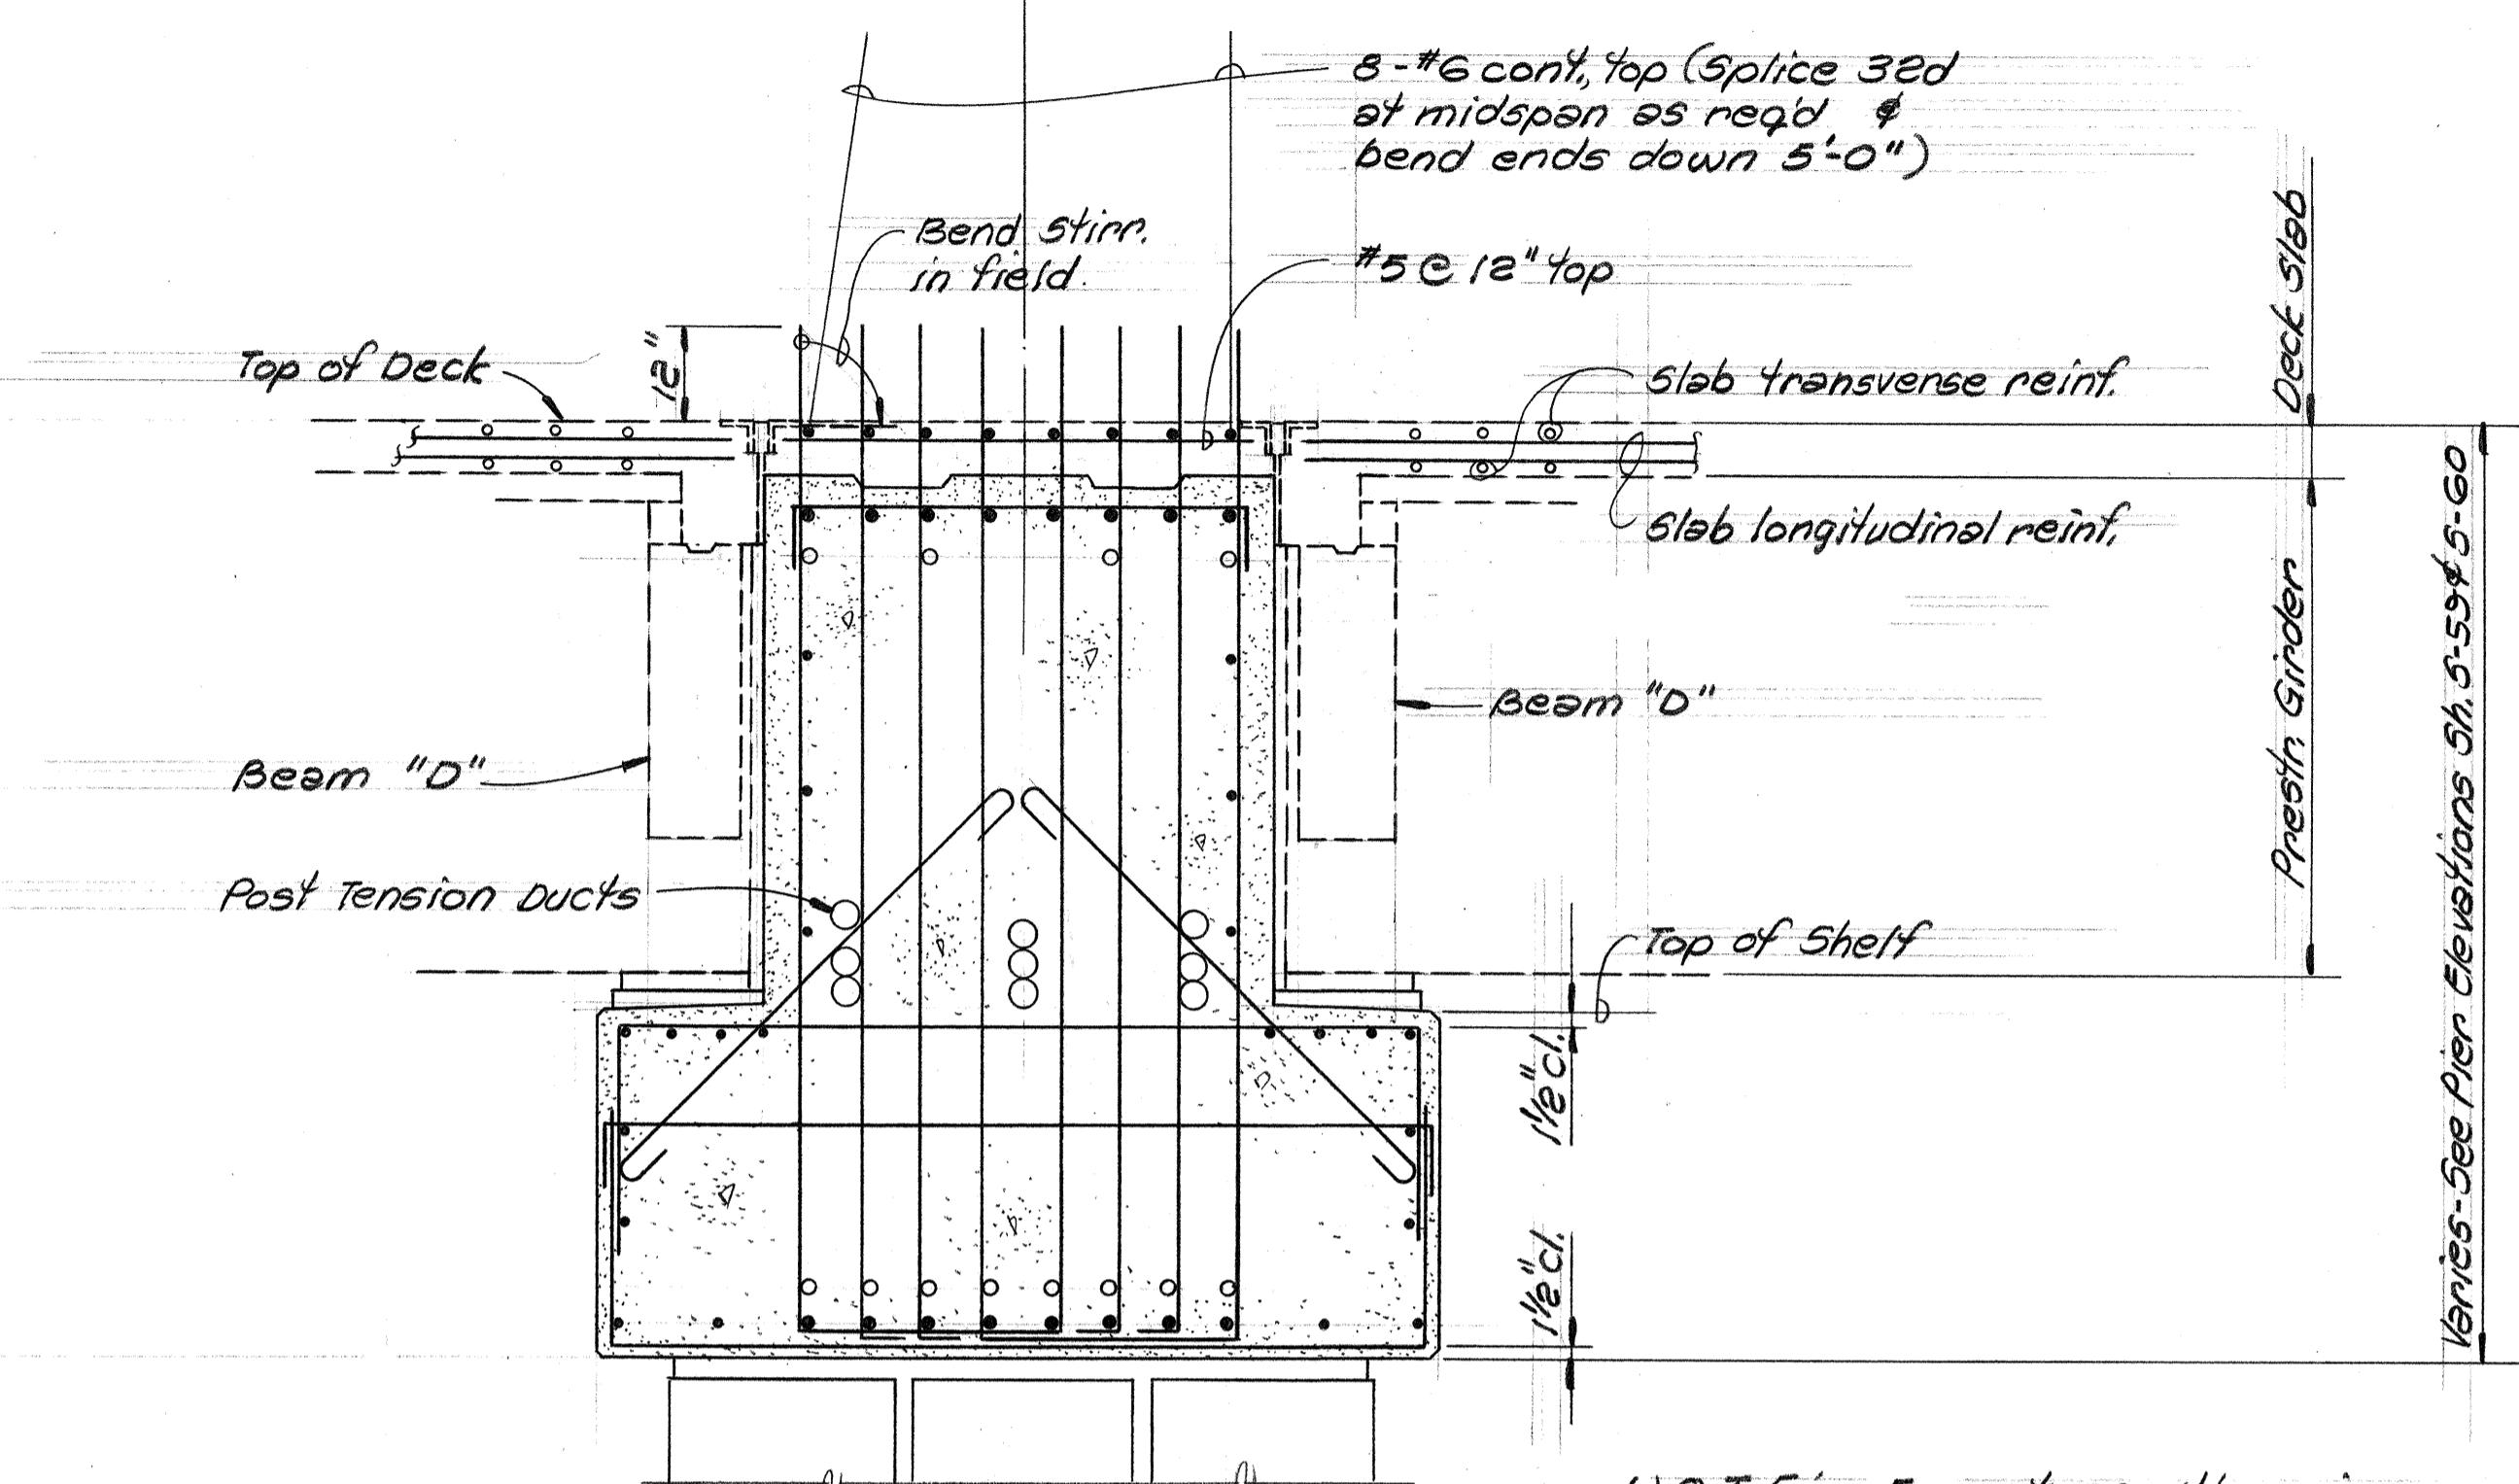


NOTE: Except as otherwise shown reinf. & details same as Pier Cap at fixed piers.

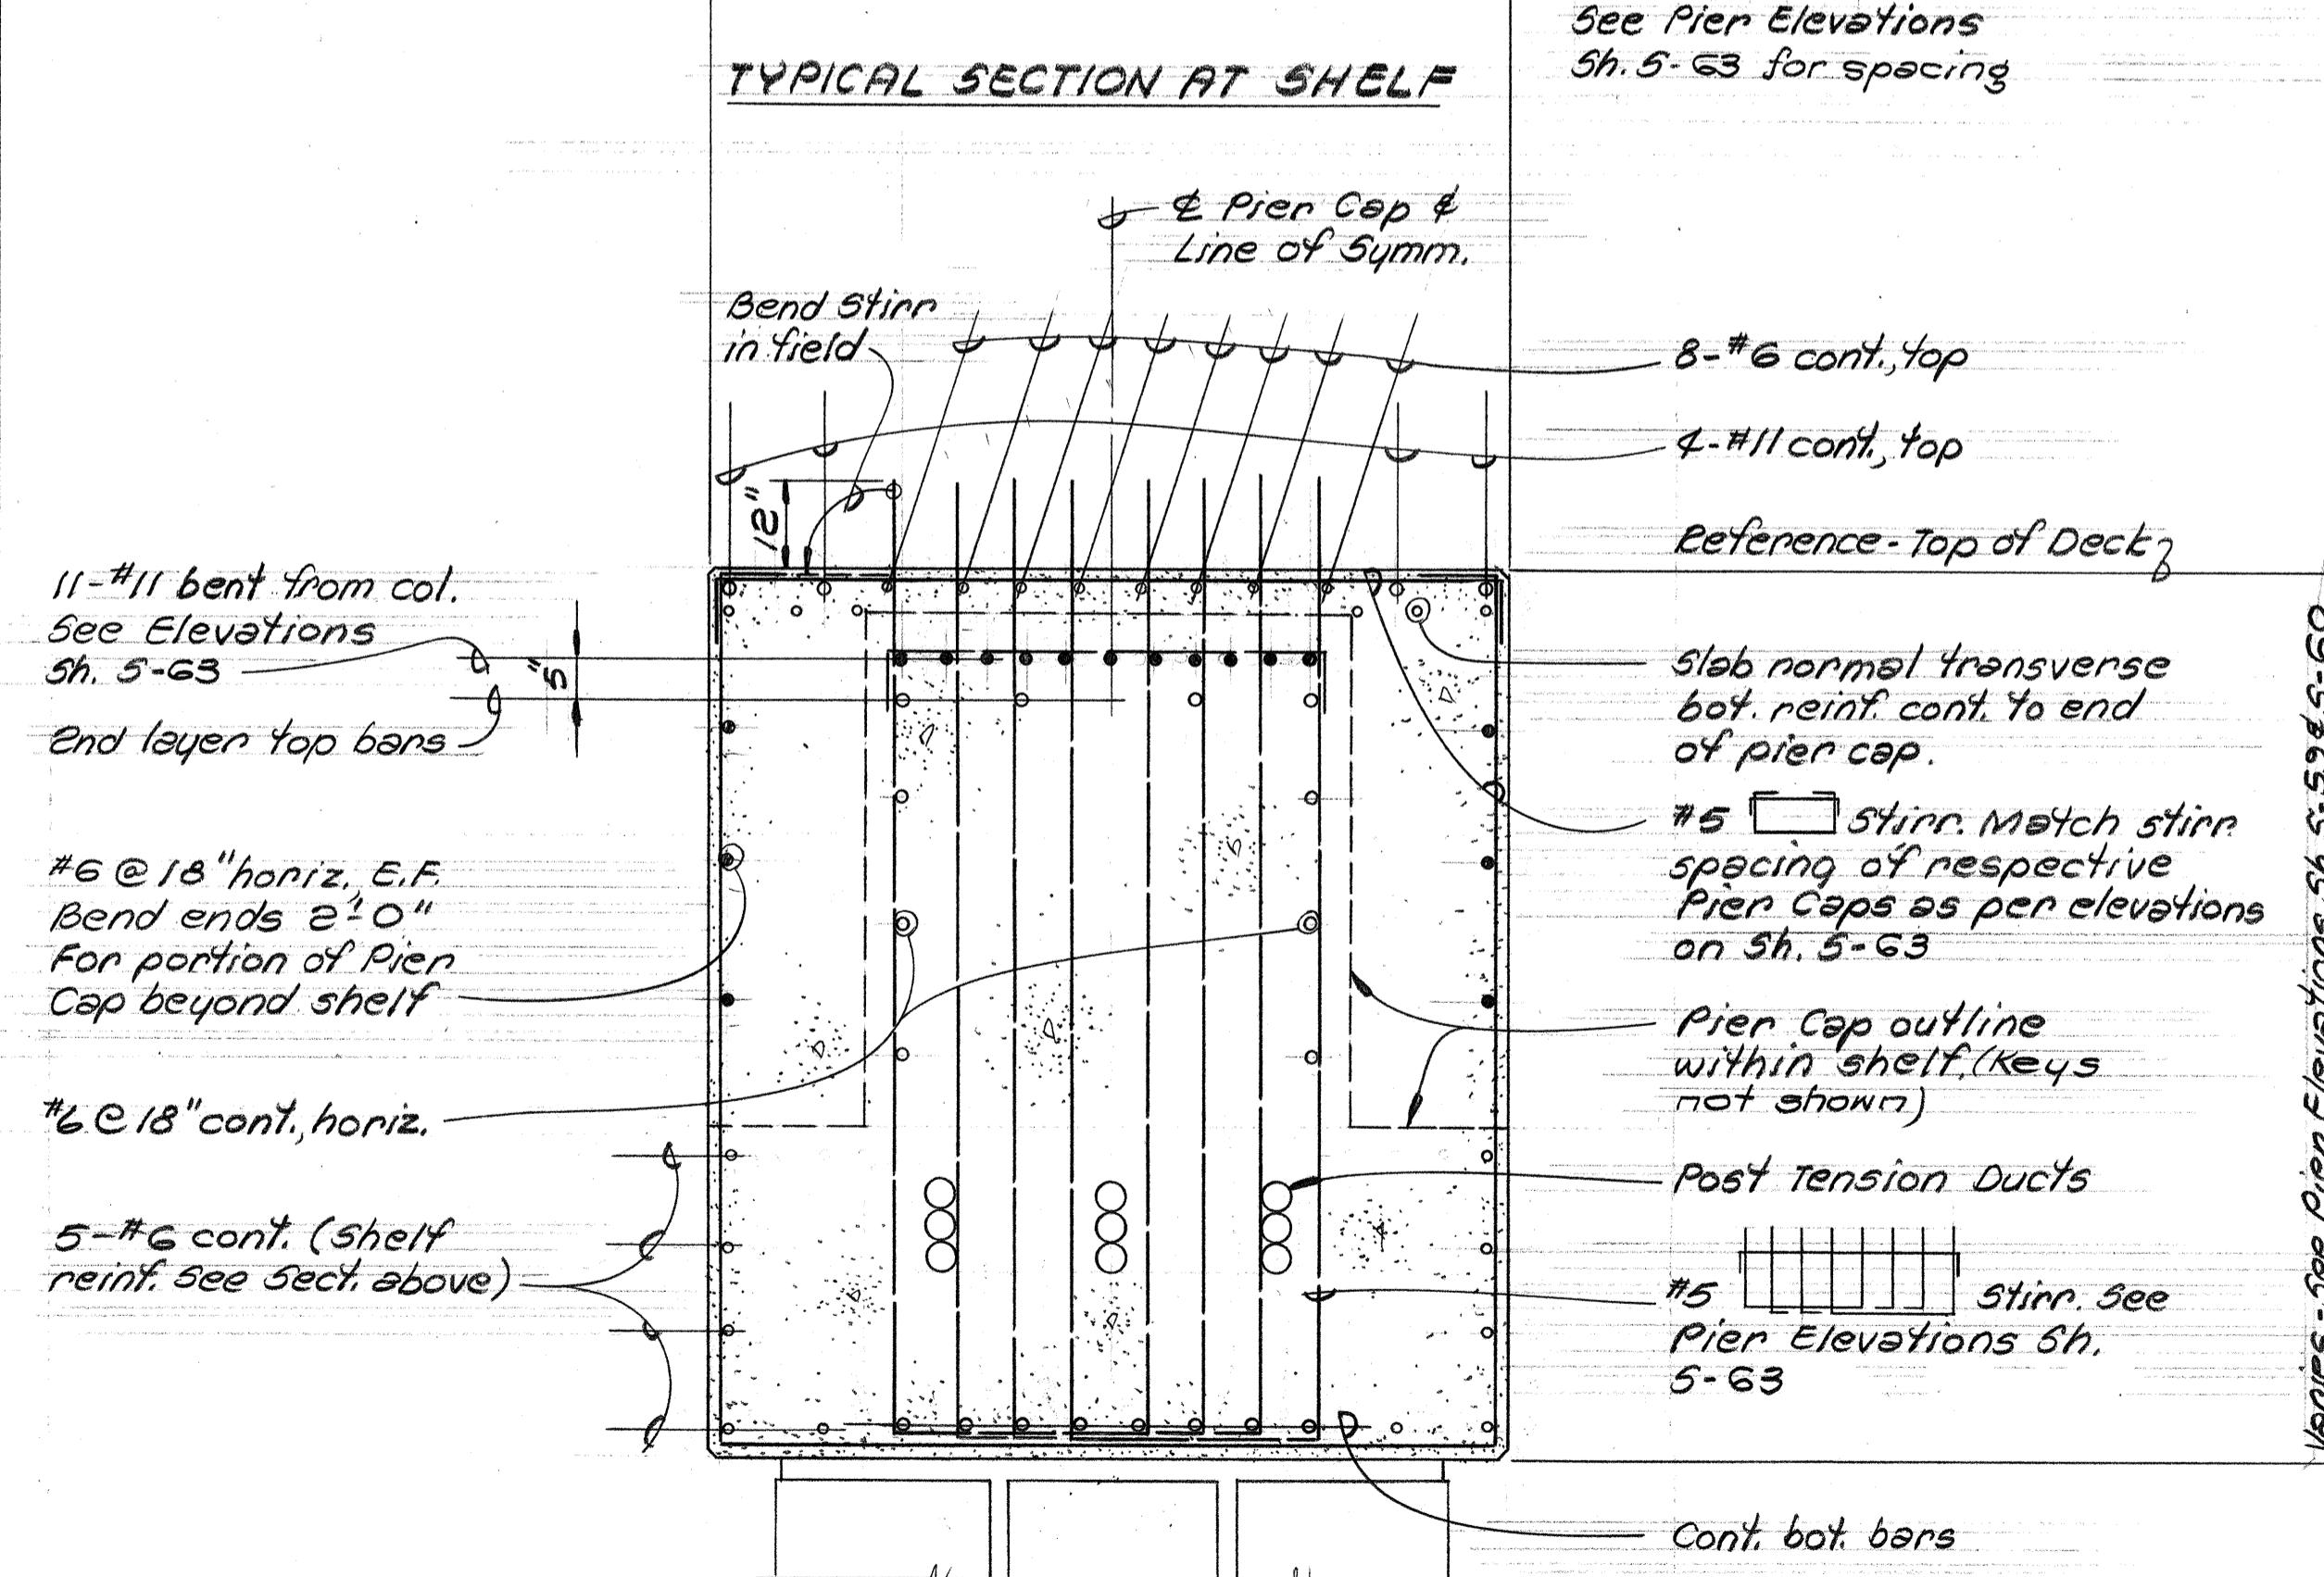

Varies - See Pier Elevations Sh. 5-59 & 5-60

TYPICAL SECTION AT SHELF

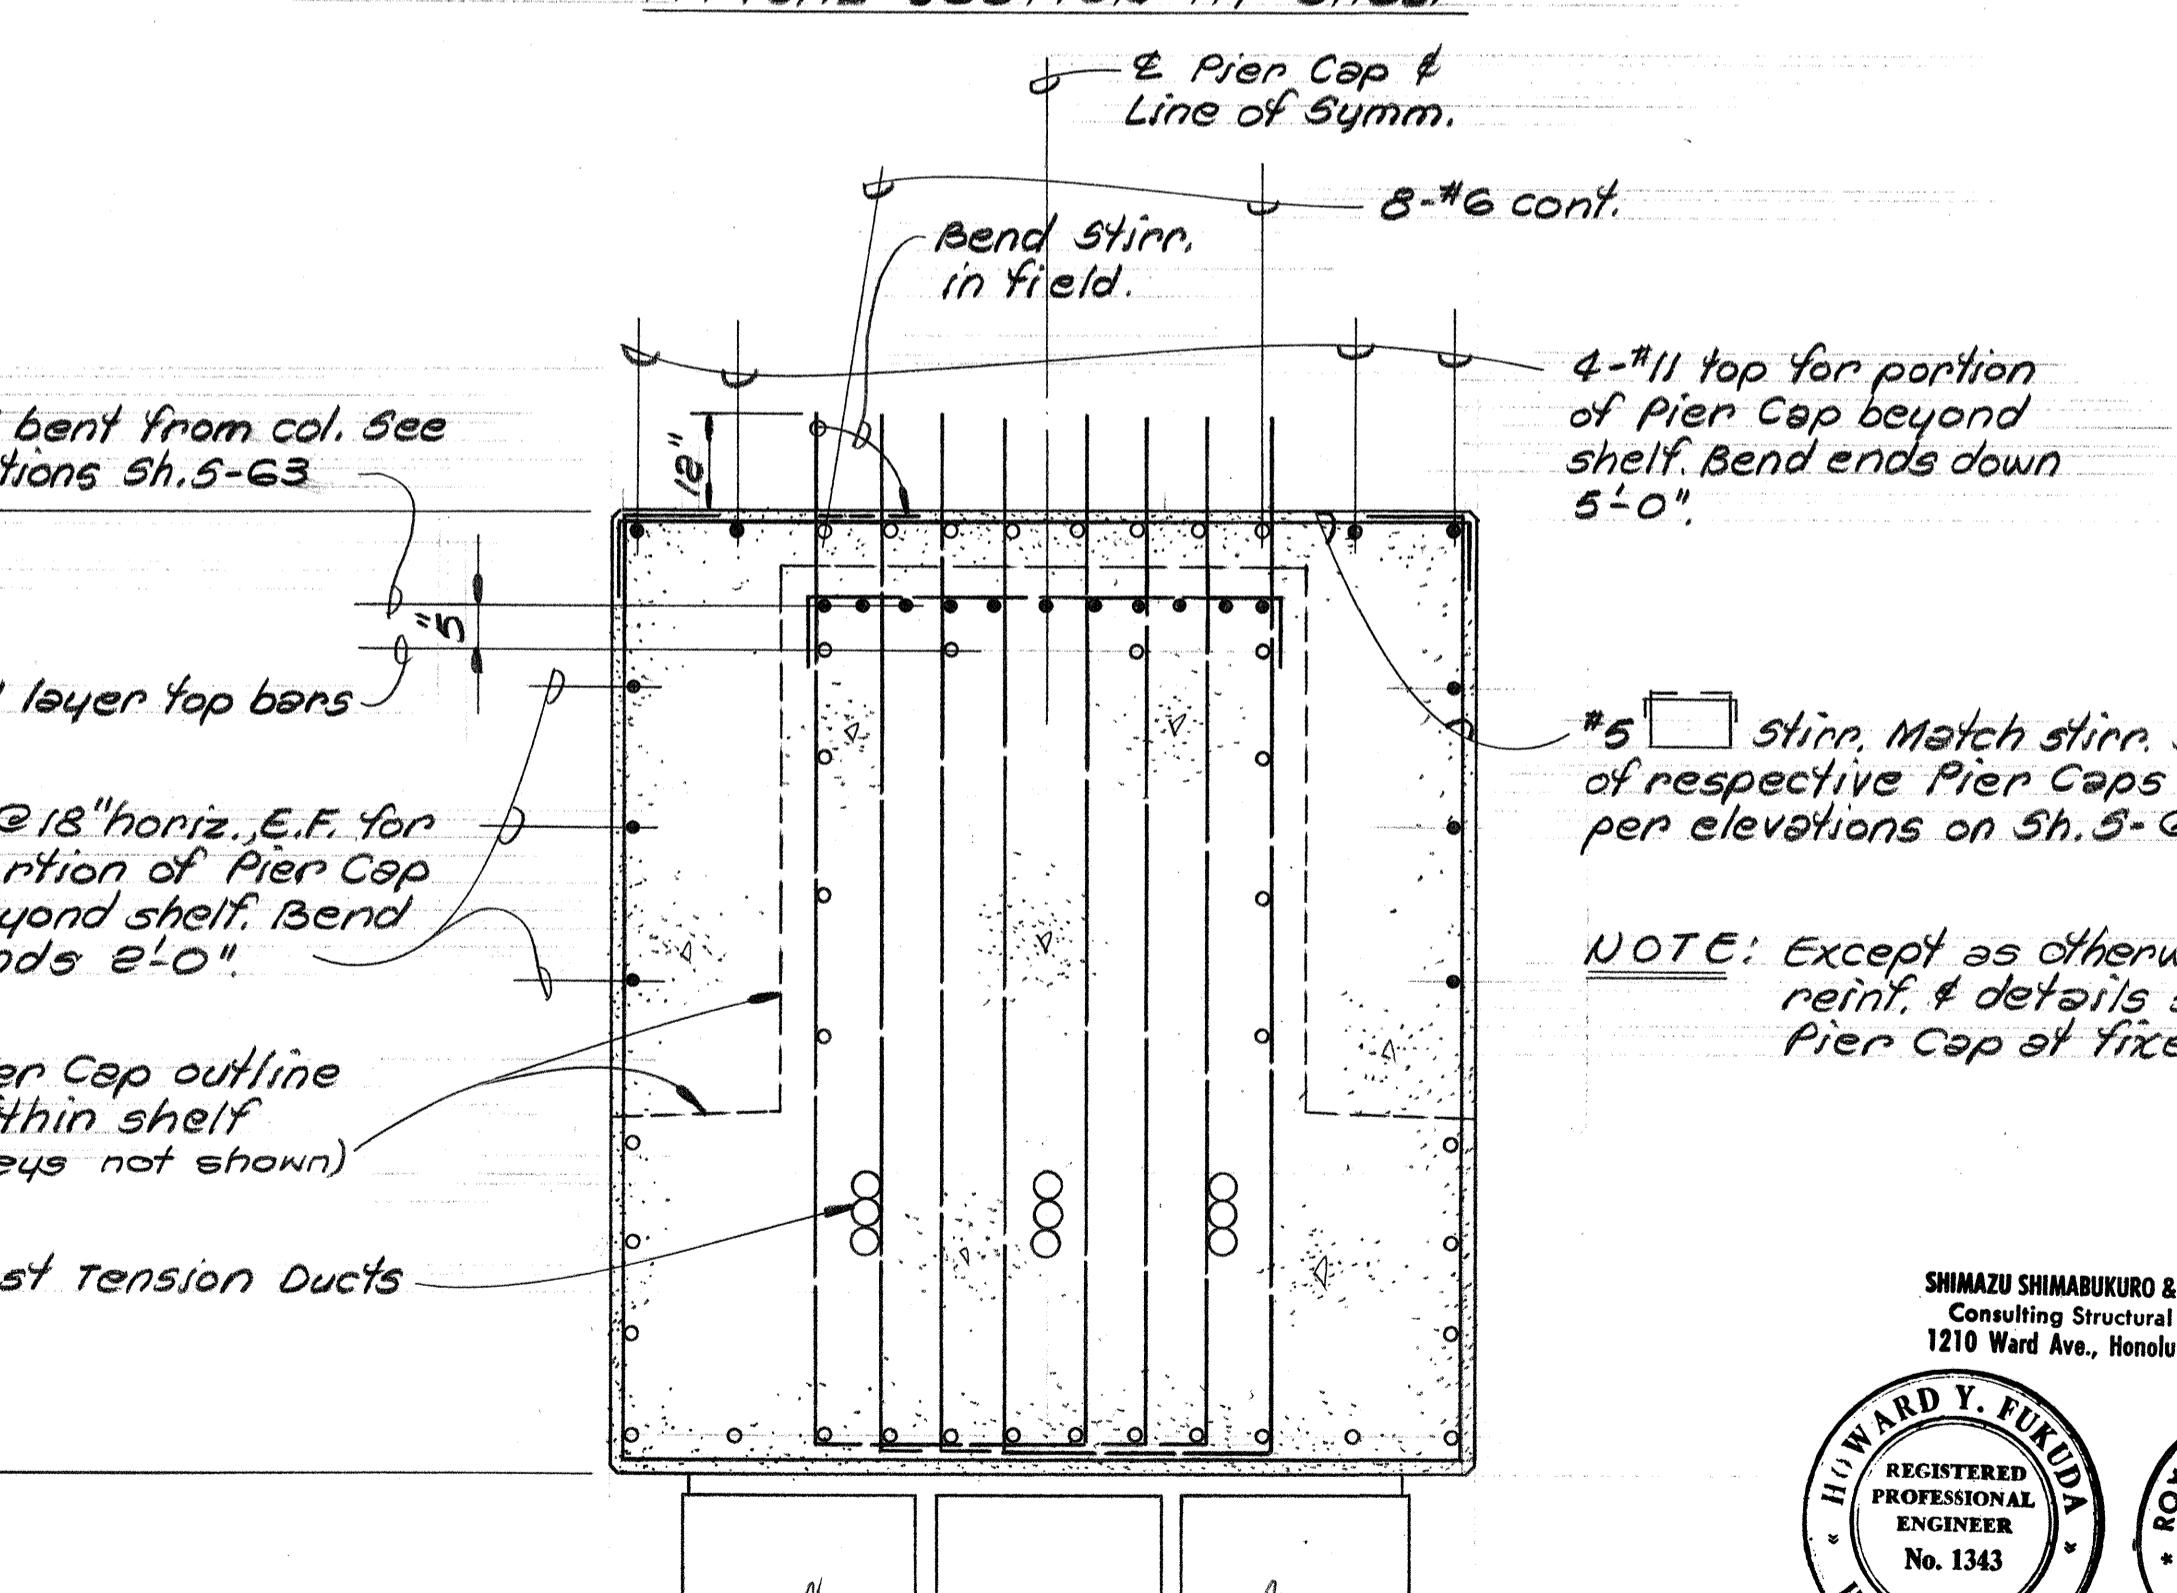

NOTE: Except as otherwise shown reinf. & details same as Pier Cap at fixed piers.

TYPICAL SECTION BEYOND SHELF



PIER CAP SECTIONS AT FIXED PIERS

Scale: 1/8" = 1'-0"

TYPICAL SECTION BEYOND SHELF

PIER CAP SECTIONS AT EXPANSION PIERS

Scale: 1/8" = 1'-0"

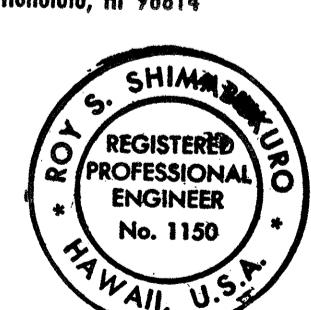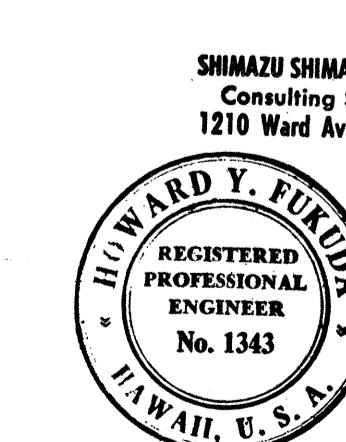

This work was prepared by
me or under my supervision.
[Signature]

STATE OF HAWAII
DEPARTMENT OF TRANSPORTATION
HIGHWAYS DIVISION

STRUCTURE No. 8
PIER CAP SECTIONS
SHOWING REINF.

PEARL HARBOR INTERCHANGE
F.A.I. Proj. No. I-HI-1 (C3)-15


Scale: As shown Date: DEC. 7, 1973
SHEET No. 5-64 OF 106 SHEETS

FED. ROAD DIST. NO.	STATE	FED. AID PROJ. NO.	FISCAL YEAR	SHEET NO.	TOTAL SHEETS
HAWAII	HAW.	I-HI-1(73):15	1974	281	369


POST TENSION NOTES

- See Typical Detail Sheets S-81 for applicable notes & special Notes.
- Min. effective post tension forces after all losses shall be: (See Sh. S-63 for locations of effective post tension forces)


Jacking End	Col. "H"	C.5L ₂	Col. "B"	C.5L ₃	Col. "C"
Pier #1 Outbound	4250k	4880k	5040k	4500k	3940k 3220k
Jacking End	C.5L ₁	C.5L ₂	C.5L ₃	Col. "F"	
Pier #2 Outbound	4820k	5730k	4870k	4250	3580
Jacking End	C.5L ₁	C.5L ₂	C.5L ₃	Col. "H"	
Pier #4 Outbound	3600k	3880	4050k	3300k	
- All strands shall be post tensioned from one end only. See Sh. S-63 for jacking ends.
- For each pier cap 2 ducts designated by the Engineer shall be jacked at the opposite end to check the effective post tension force at that end. (Cost incidental to post tensioning.)
- Maximum number of ducts per stem shall be nine (9).
- All curves in ducts shall be parabolic & smooth between inflection points & anchorages.

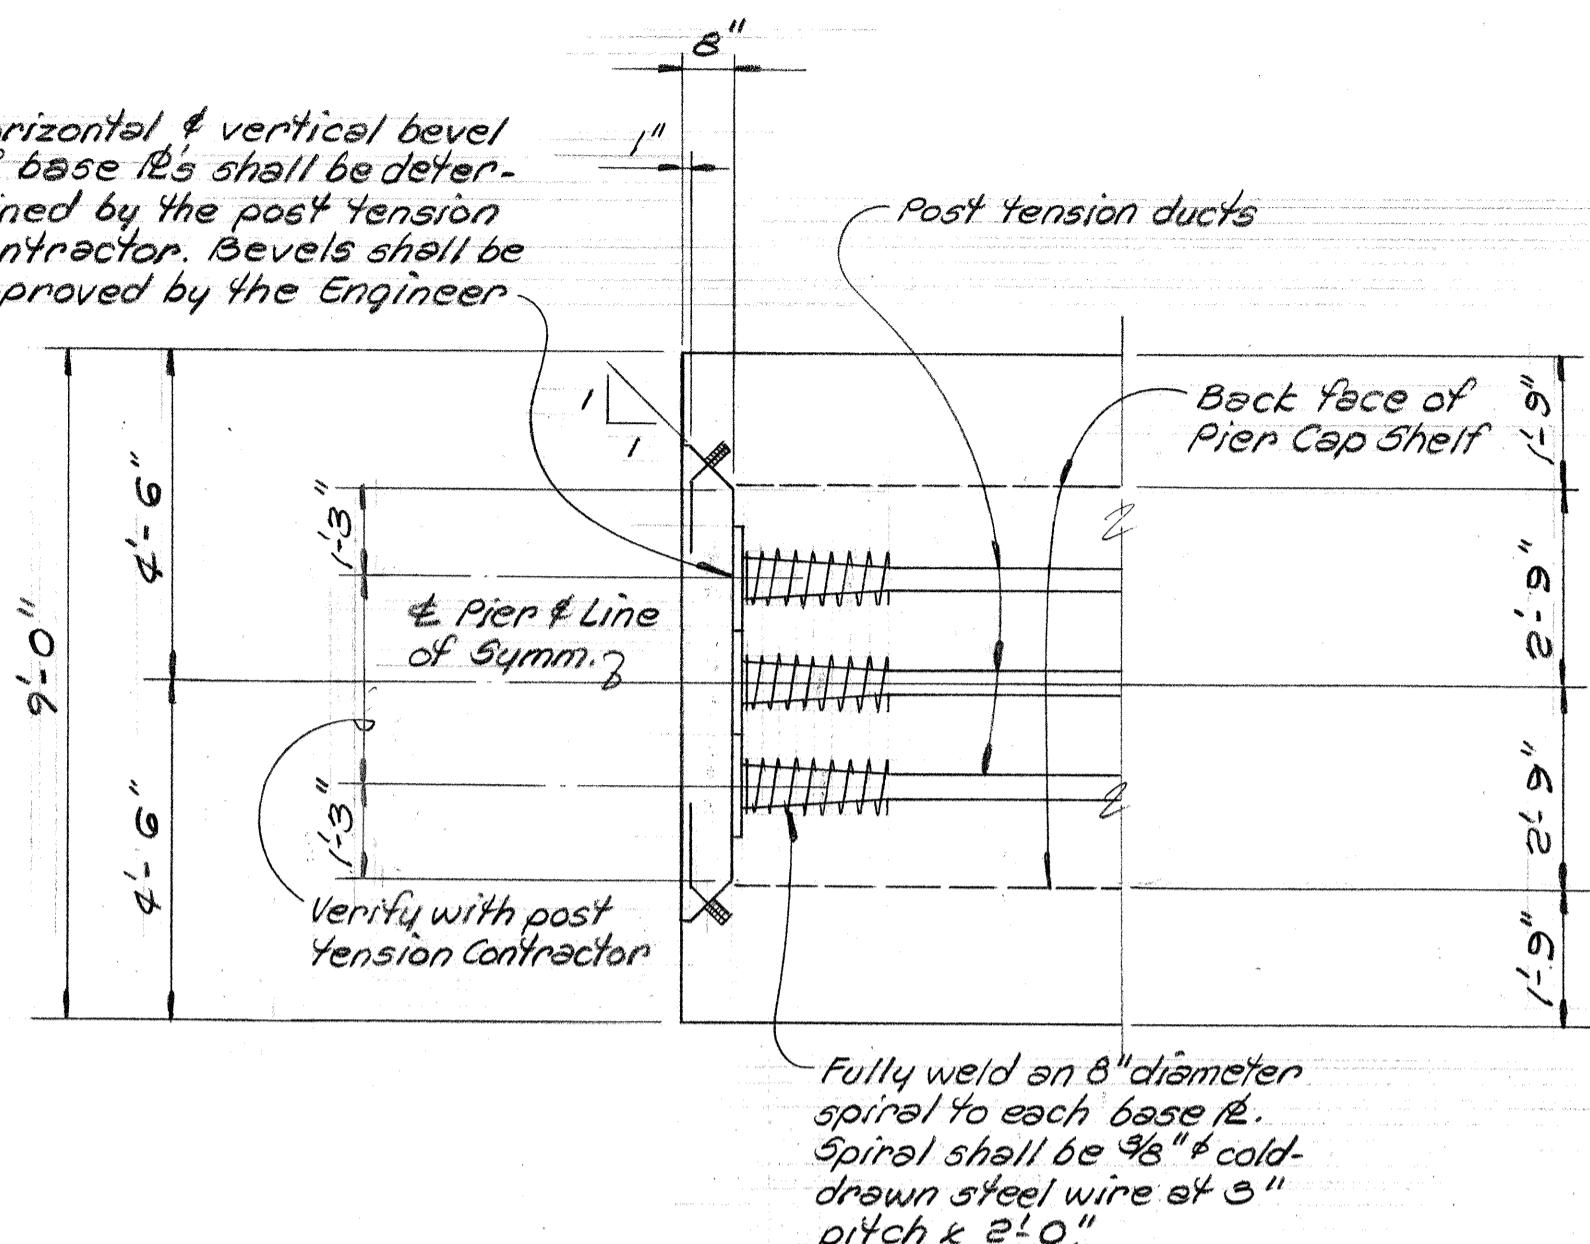

TYPICAL PLAN

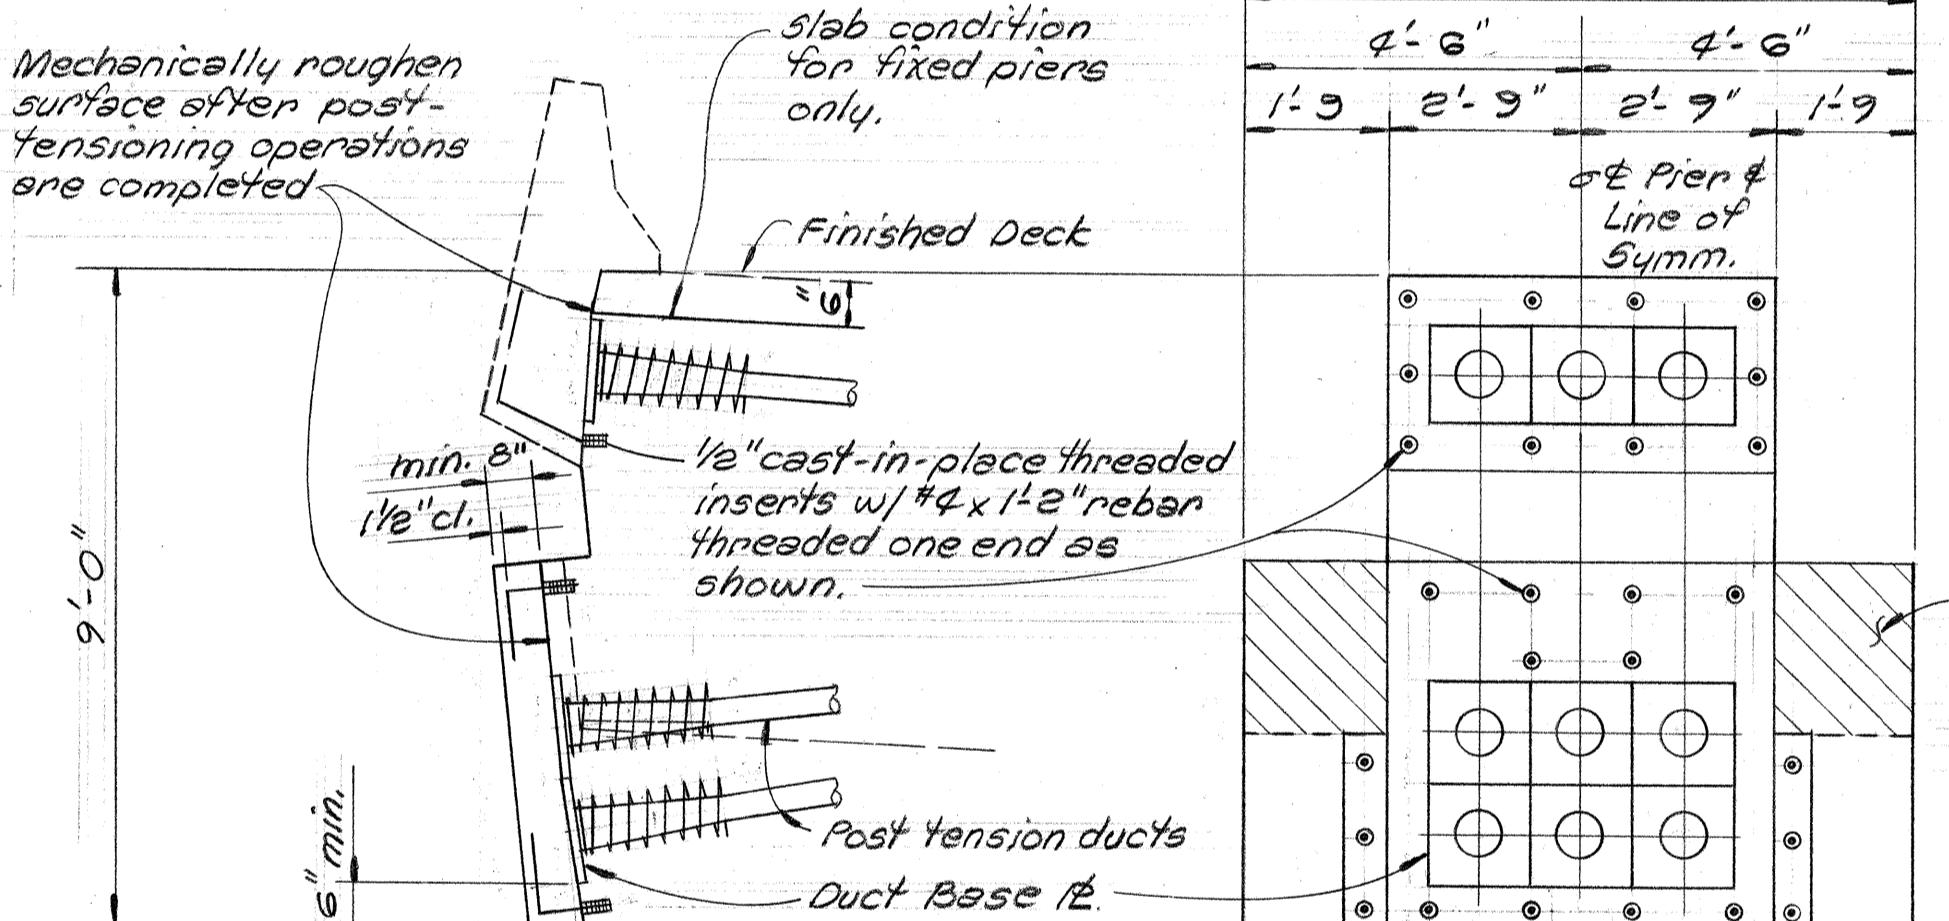


ELEVATION END VIEW CANTILEVERED PIER CAP END

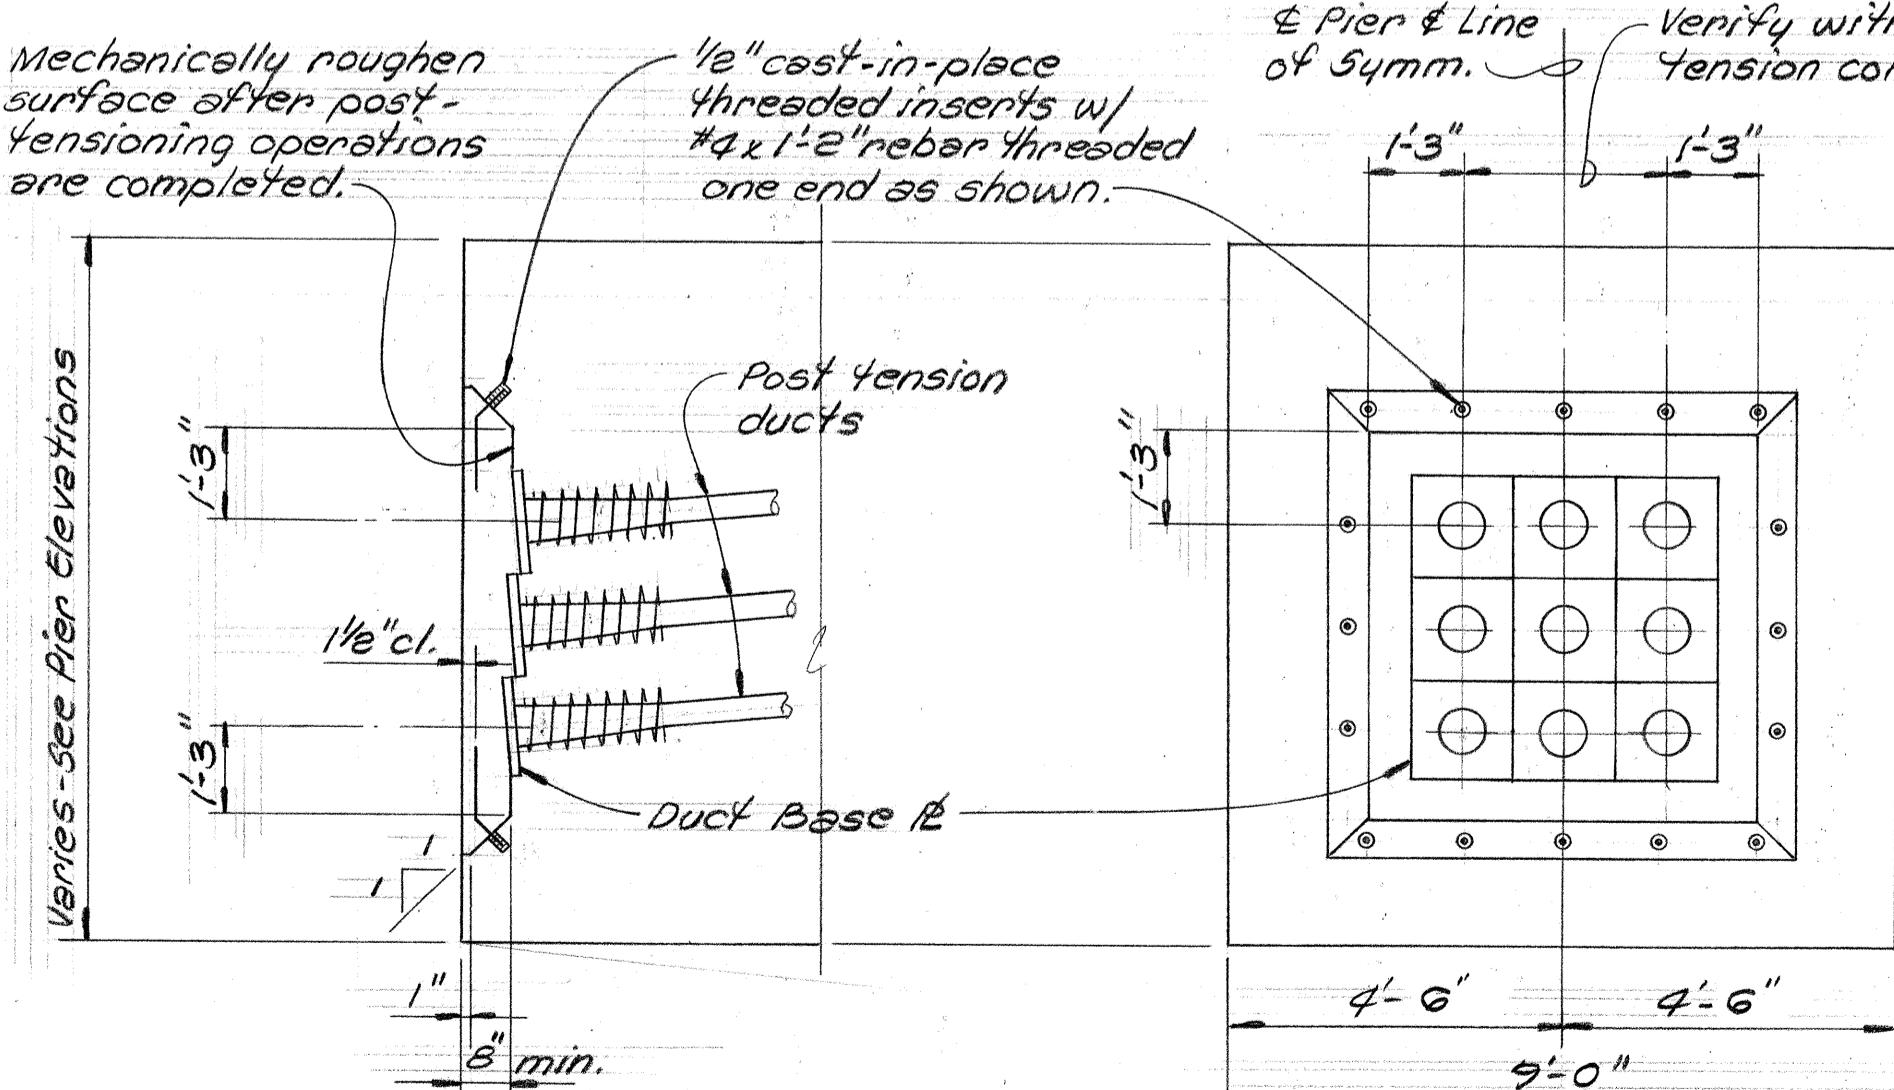

ELEVATION END VIEW PIER CAP END OVER SUPPORTS

POST TENSION ANCHORAGE POCKET DETAILS AND REINFORCING
3/8" = 1' 0"


TYPICAL PLAN ~ ADDED REINF LAYOUT AT POST TENSION DUCT ANCHORAGE

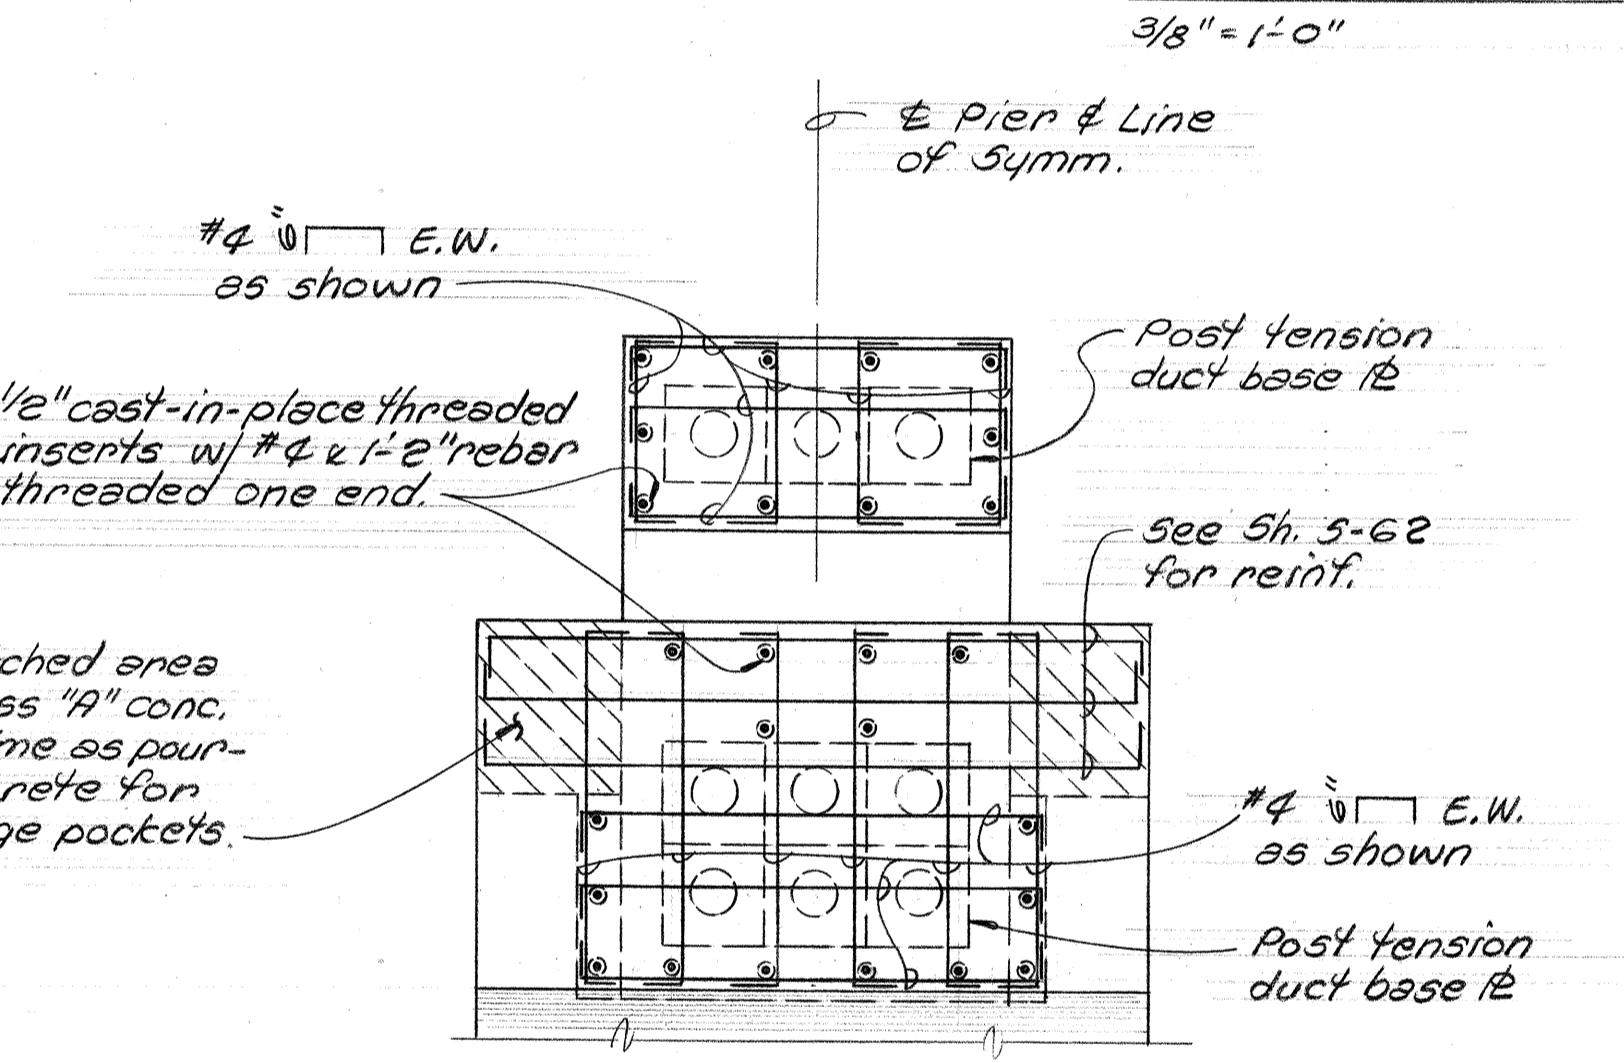

NOTE:
See Sheets S-62, S-63, & S-4 for typical reinf. at shelf & pier cap.

END VIEW

REINF. LAYOUT FOR CANTILEVERED PIER CAP END

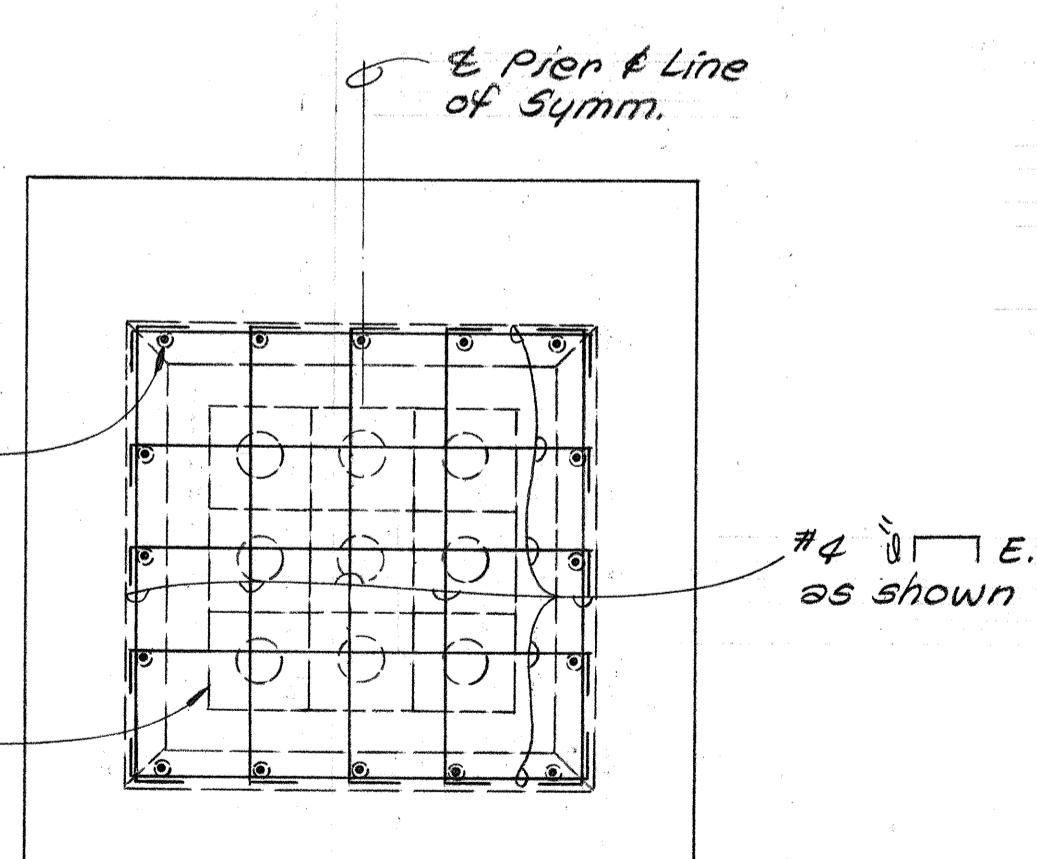


END VIEW

REINF. LAYOUT FOR PIER CAP END OVER SUPPORTS

NOTE
See Anchorage Assembly Protection notes 3 & 4 on sheet 81 for epoxy requirements on post tension hardware

SECTION AT PIER CAP END OVER SUPPORT



SECTION "X" ~ "X" 3/8" = 1' 0"

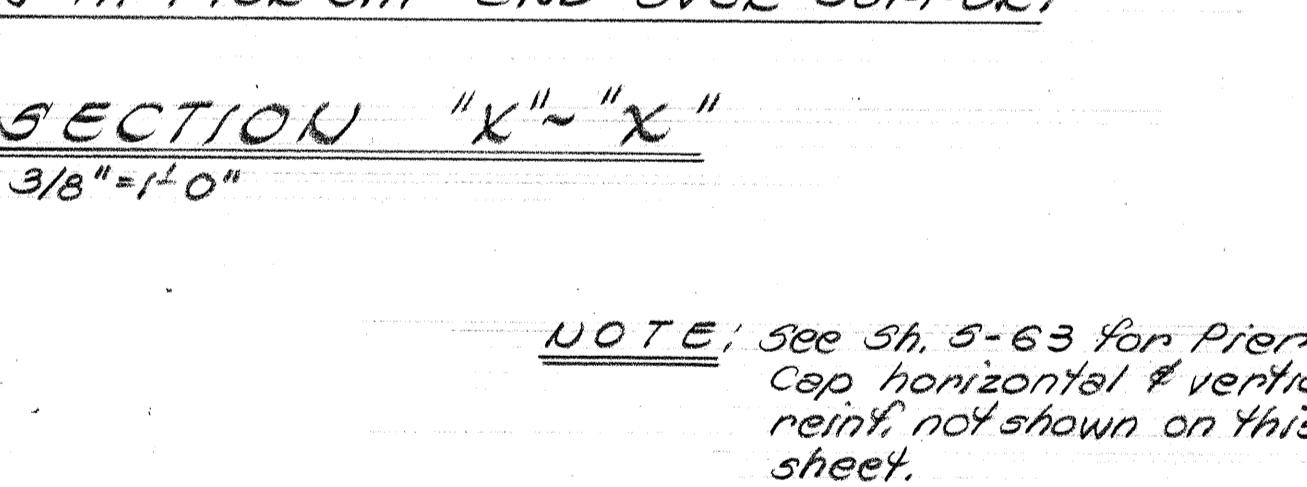

NOTE: See Sh. S-63 for Pier cap horizontal & vertical reinf. not shown on this sheet.

Paint existing concrete surface of pocket at jacking end with epoxy just before pouring concrete.

SHIMABUKURO & FURUDA, INC.
Consulting Structural Engineers
1210 Ward Ave., Honolulu, HI 96814

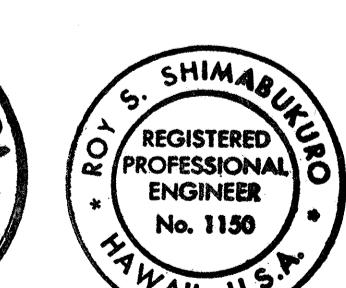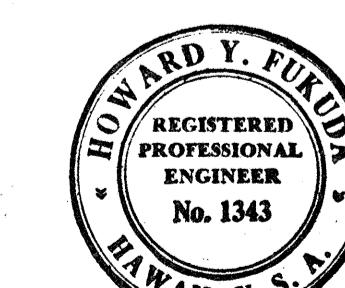

THIS WORK WAS PREPARED BY ME
OR UNDER MY SUPERVISION

STATE OF HAWAII
DEPARTMENT OF TRANSPORTATION
HIGHWAYS DIVISION


STRUCTURE No. 8

PIER CAP
POST TENSION ANCHORAGE DETAILS


PEARL HARBOR INTERCHANGE
F.A.I. Proj. No I-HI-1(73):15

Scale: As Shown Date: DEC. 7, 1973
SHEET NO. 565 OF 106 SHEETS


FED. ROAD DIST. NO.	STATE	FED. AID PROJ. NO.	FISCAL YEAR	SHEET NO.	TOTAL SHEETS
HAWAII	HAW.	I-HI-1(73)-15	1974	282	369

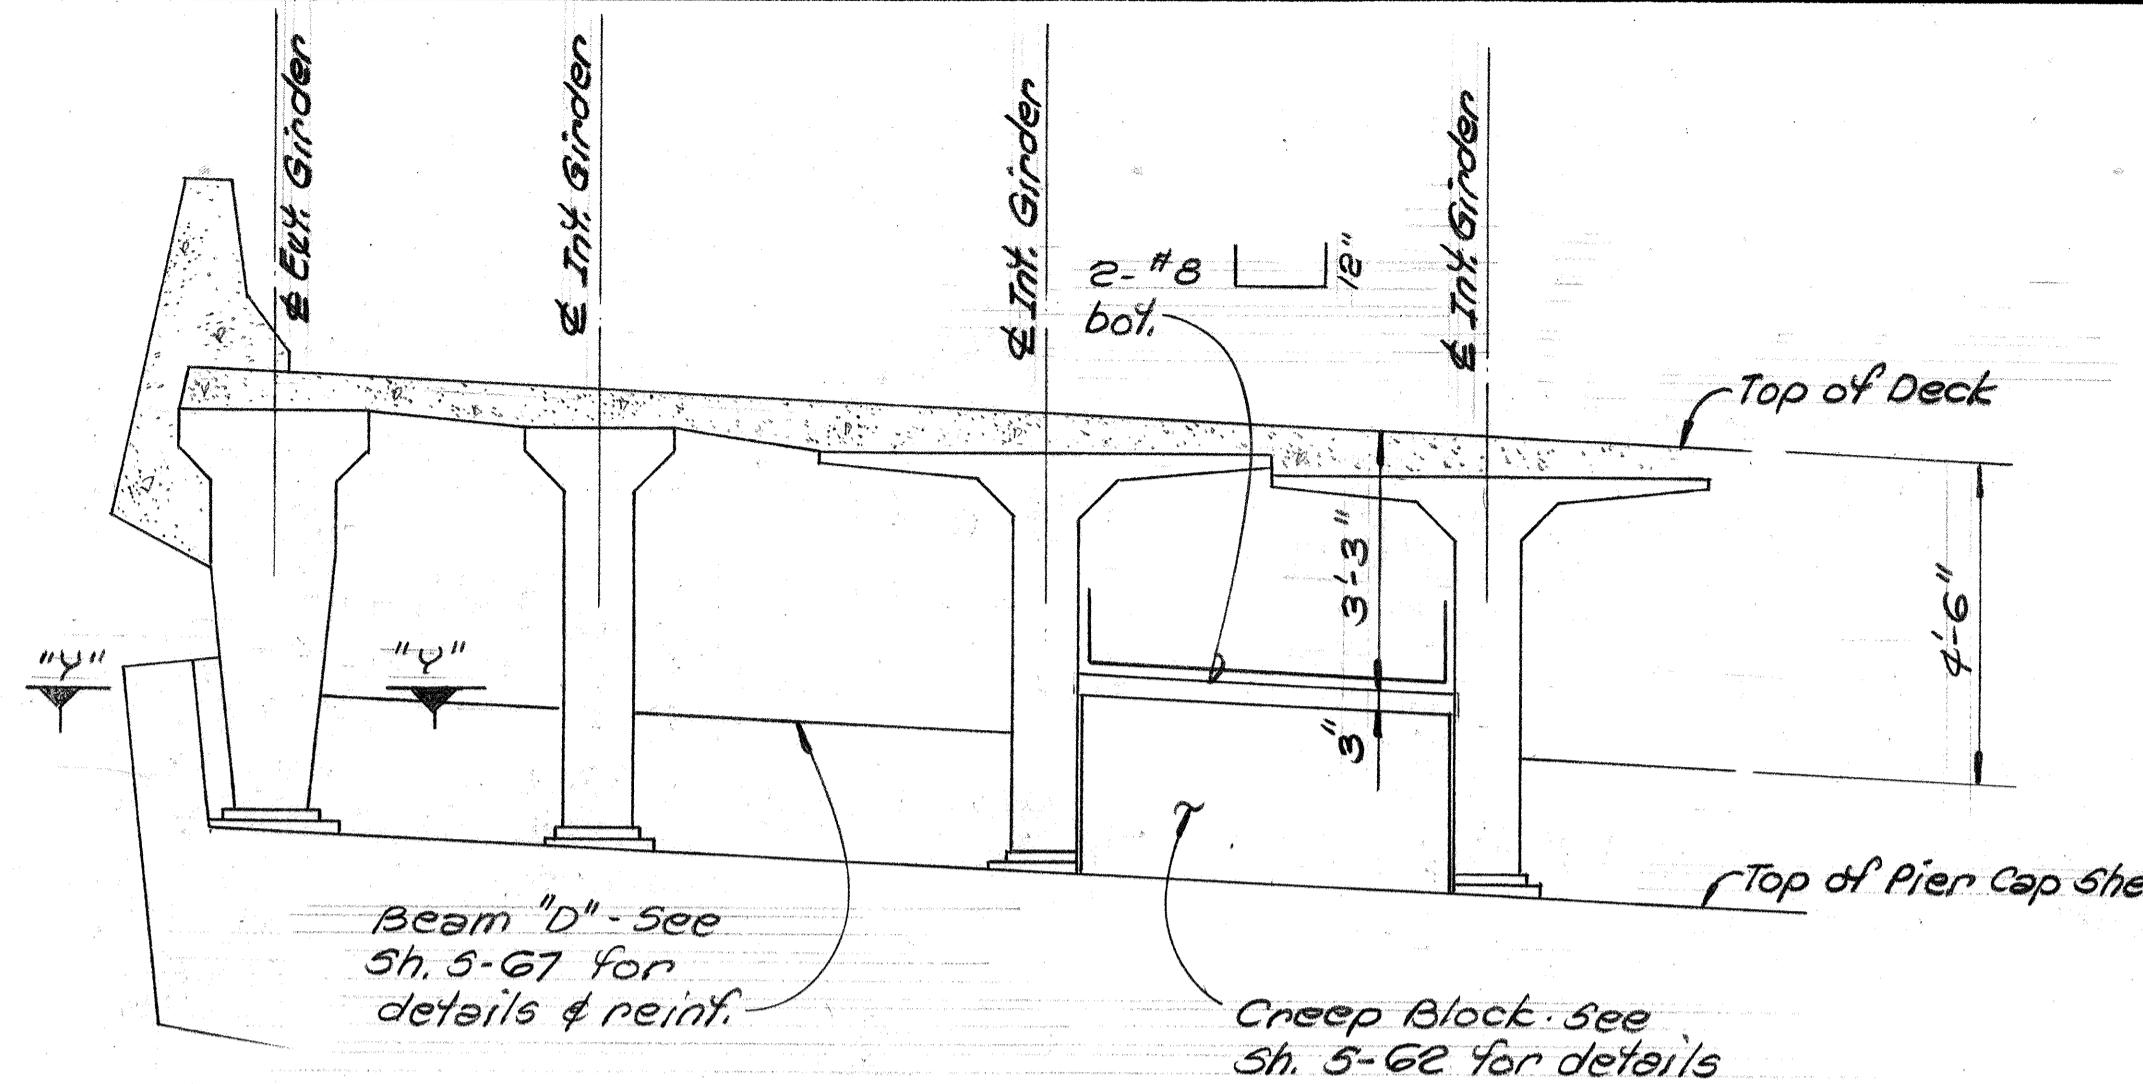

PART ELEVATION - BEAM "P" OVER EXPANSION PIECE

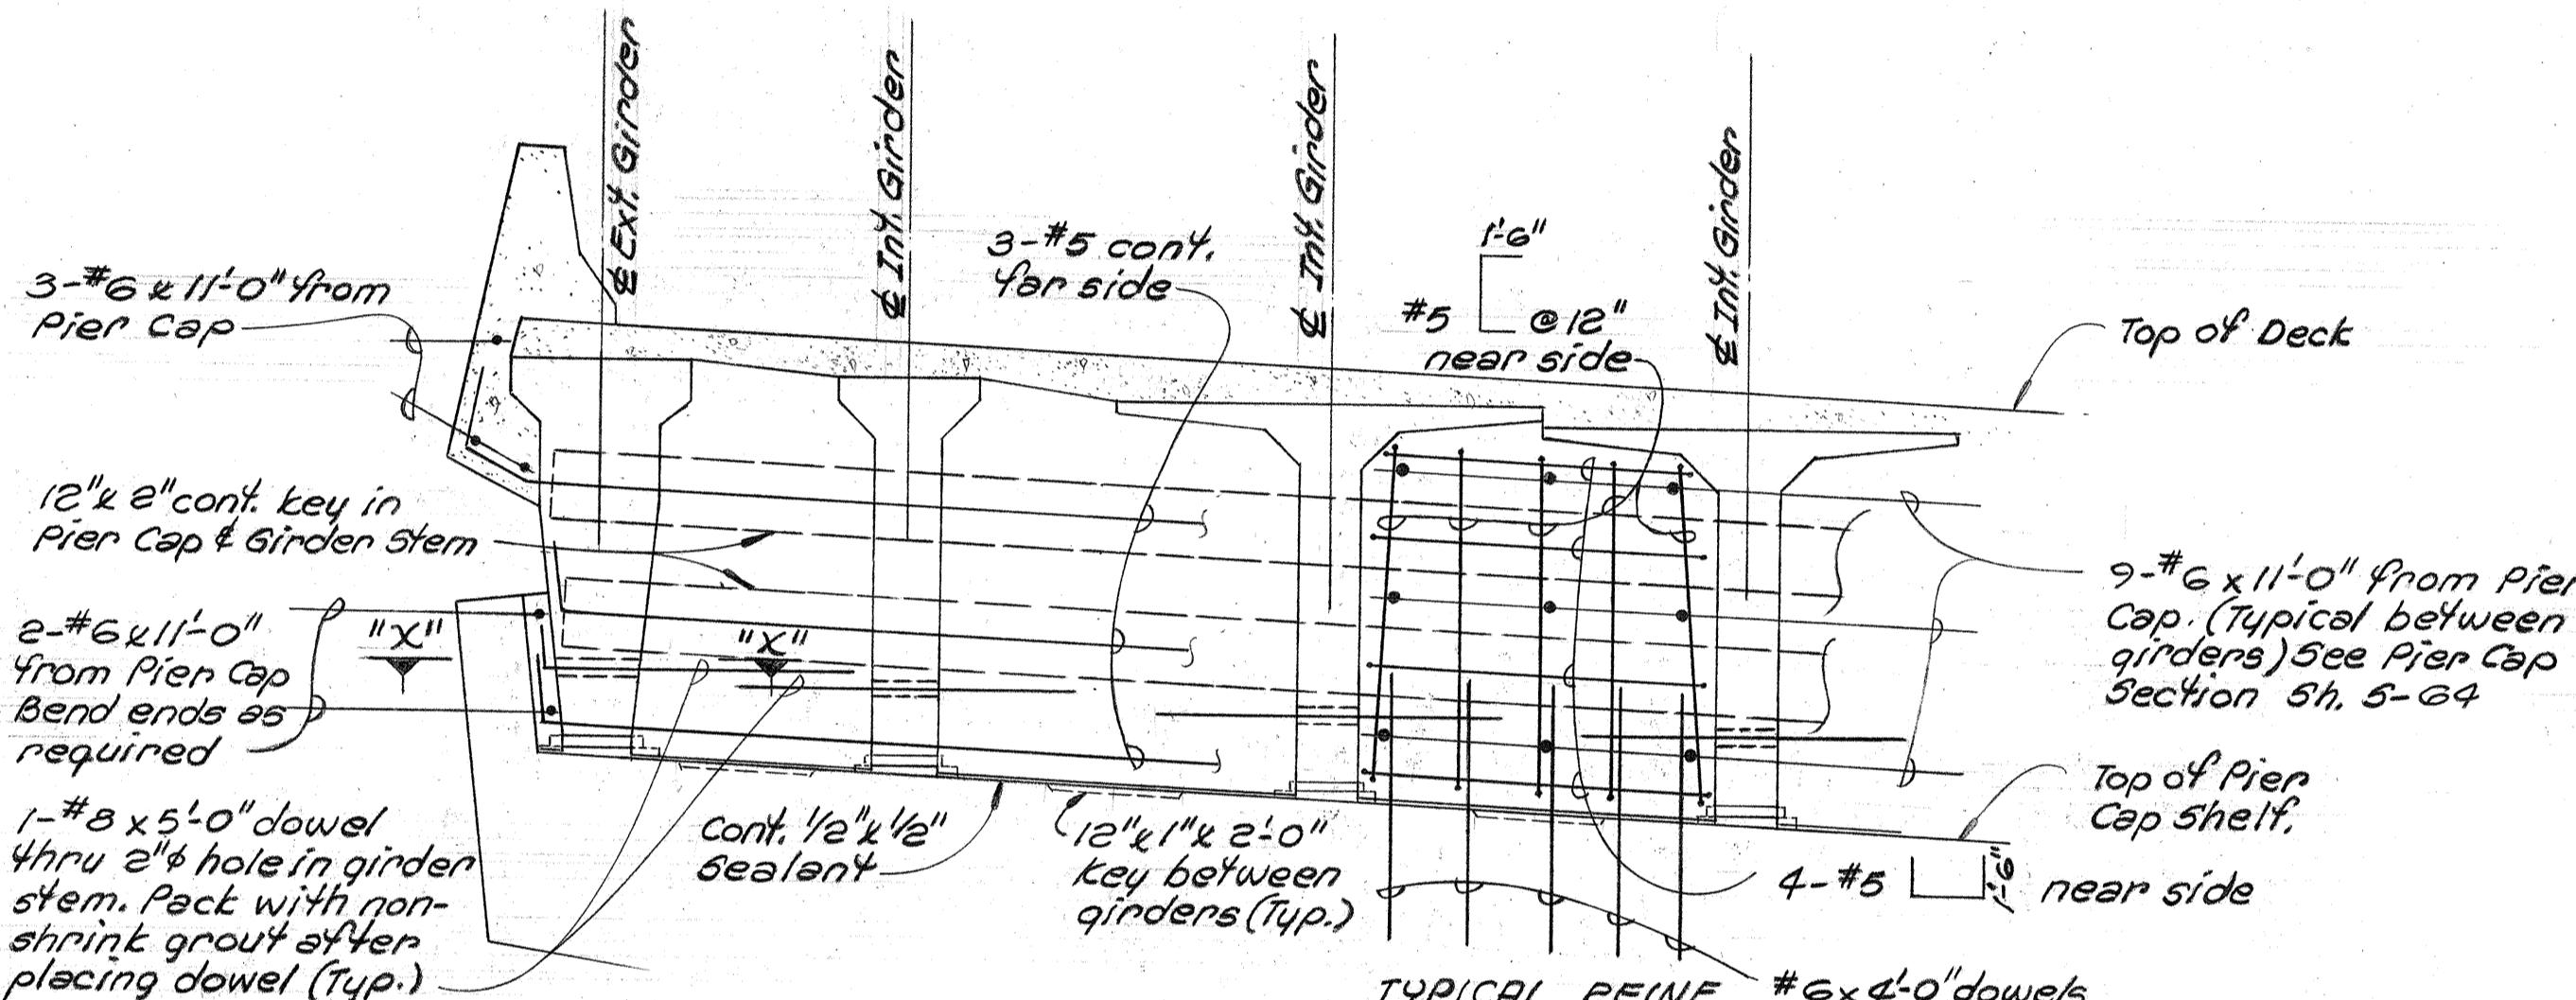


PART ELEVATION - BEAM "E" OVER FIXED PIECE

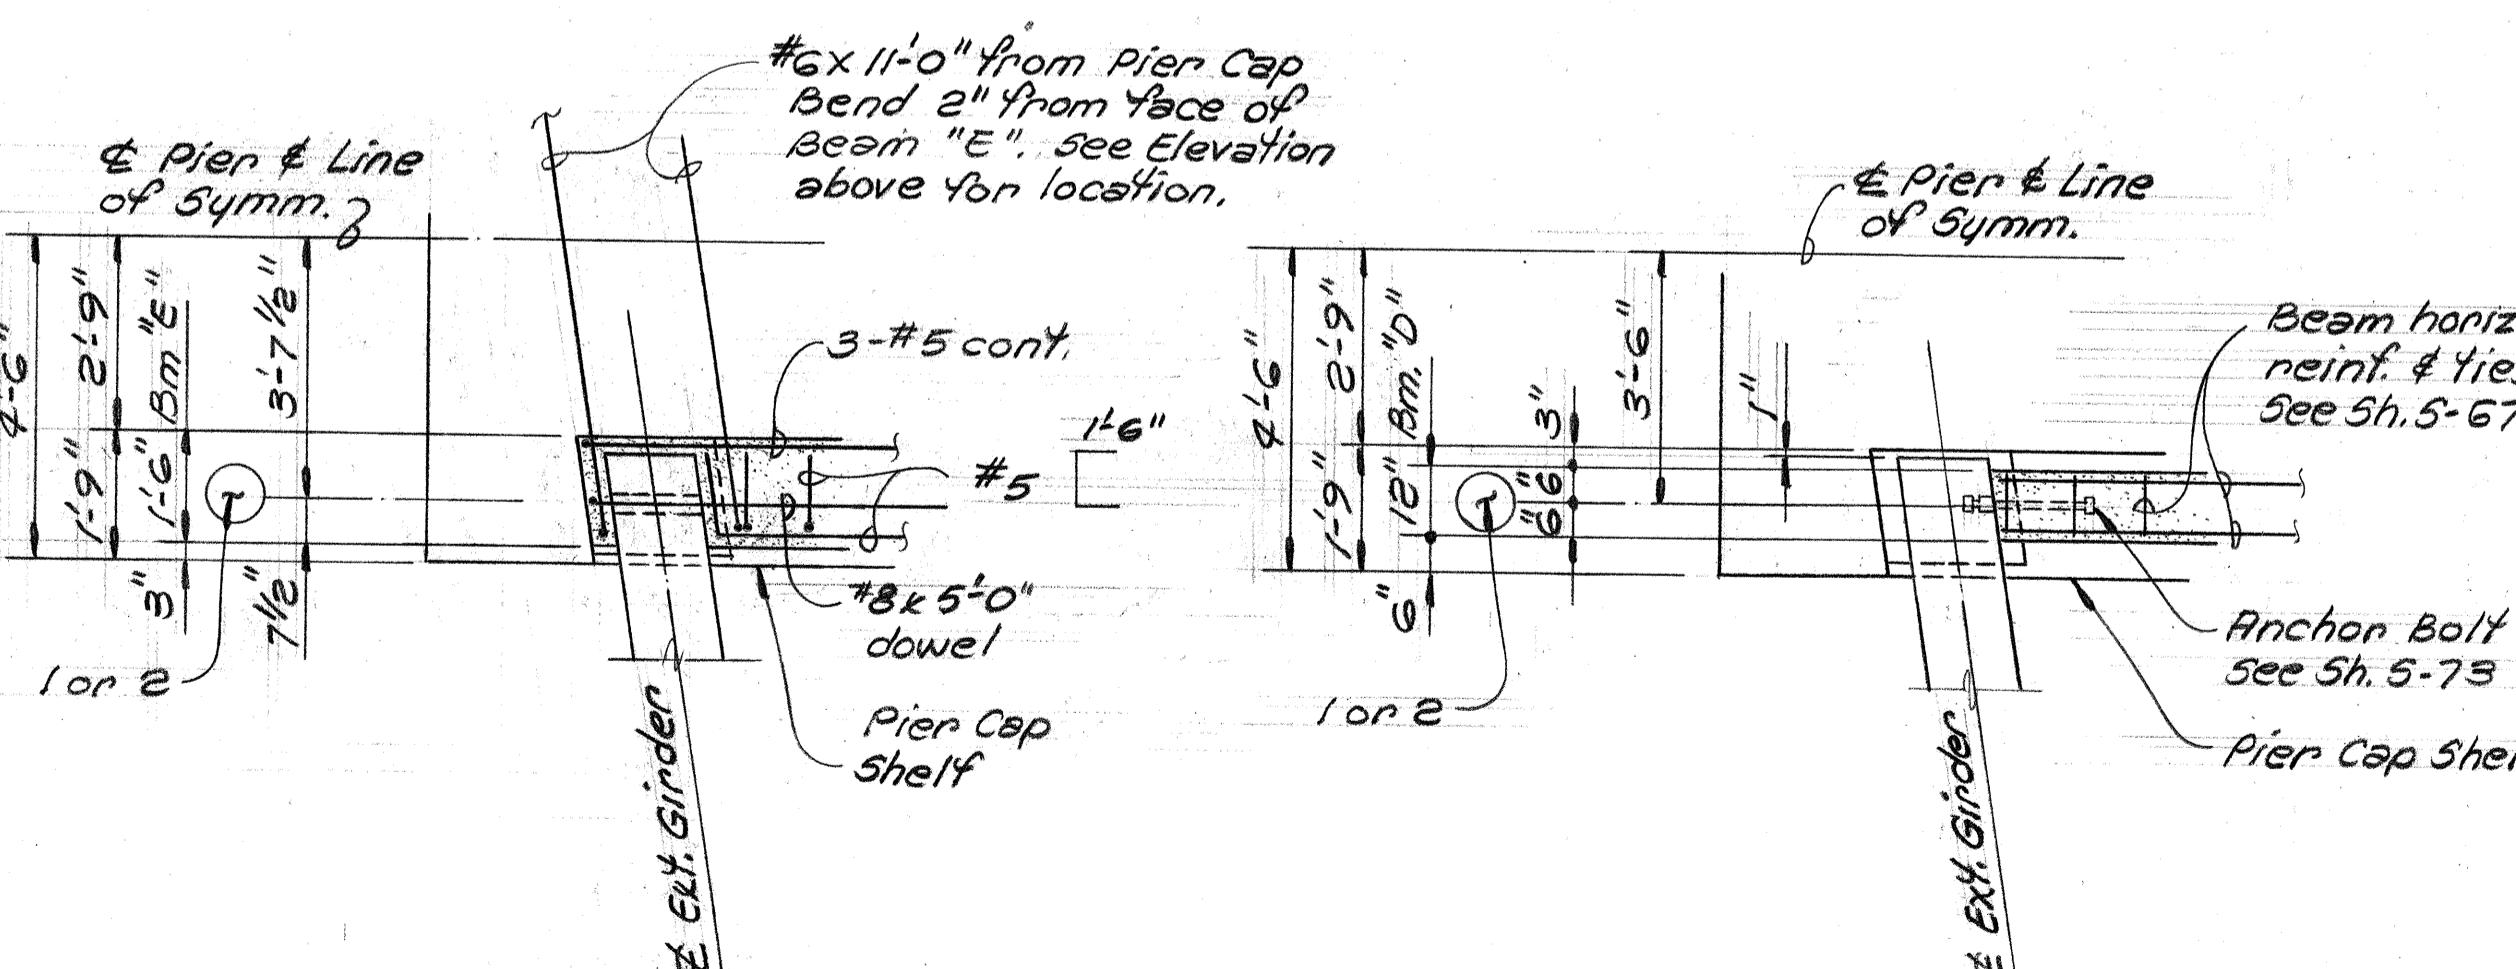


SECTION "X"- "X"


SECTION "4"- "4"

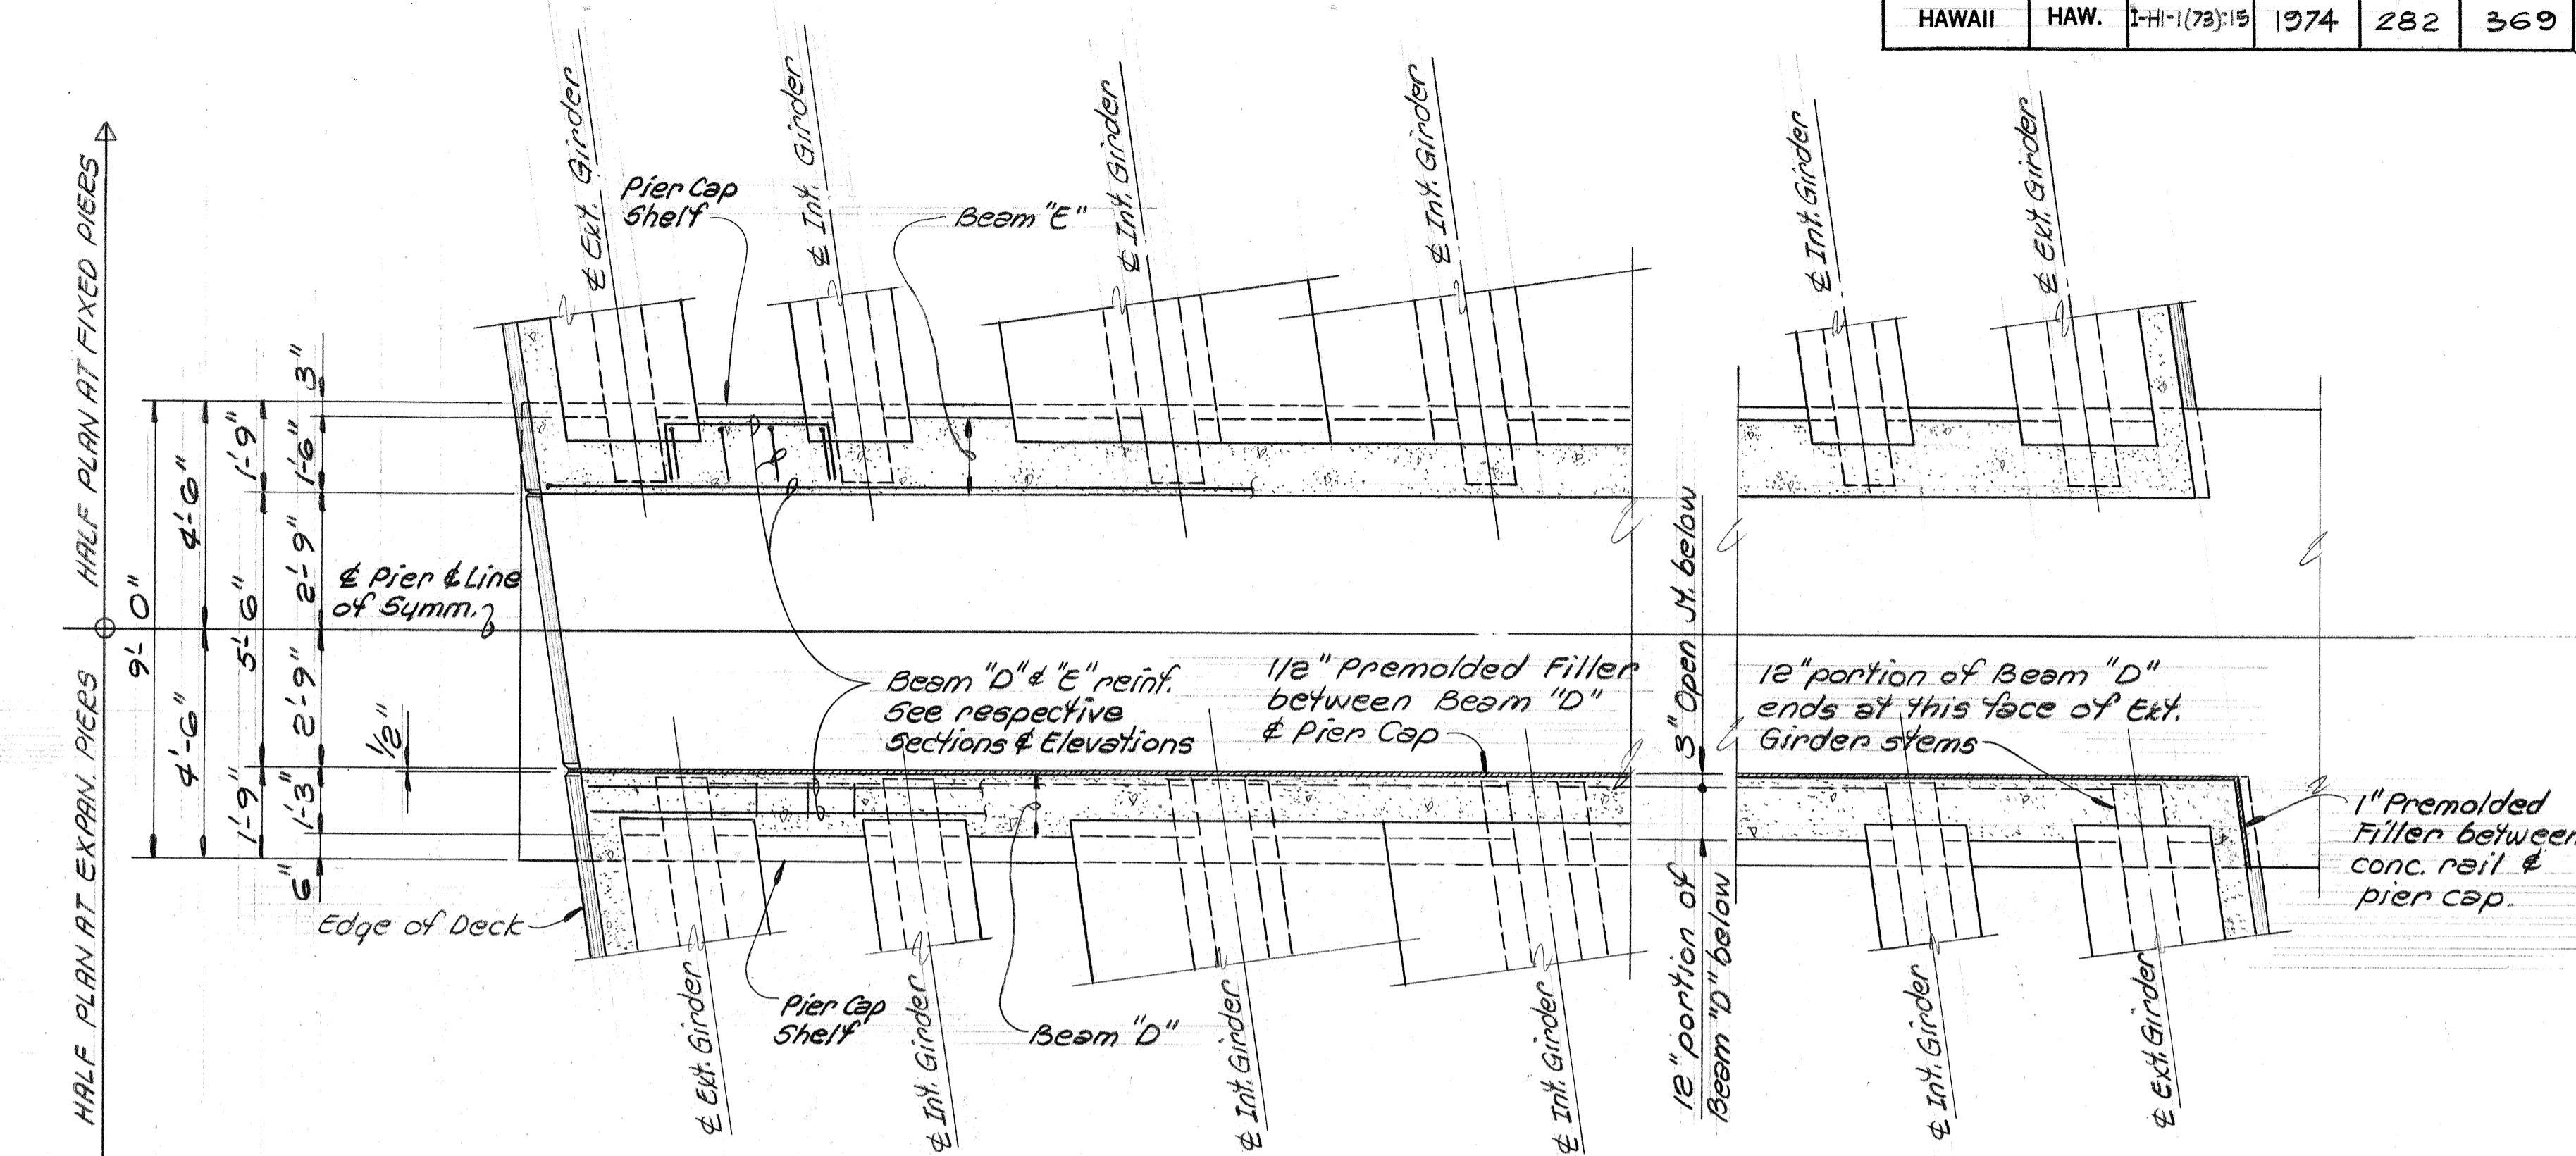

PART PLAN ~ BEAMS "D" & "E" AT TOP OF GIRDER FLANGE

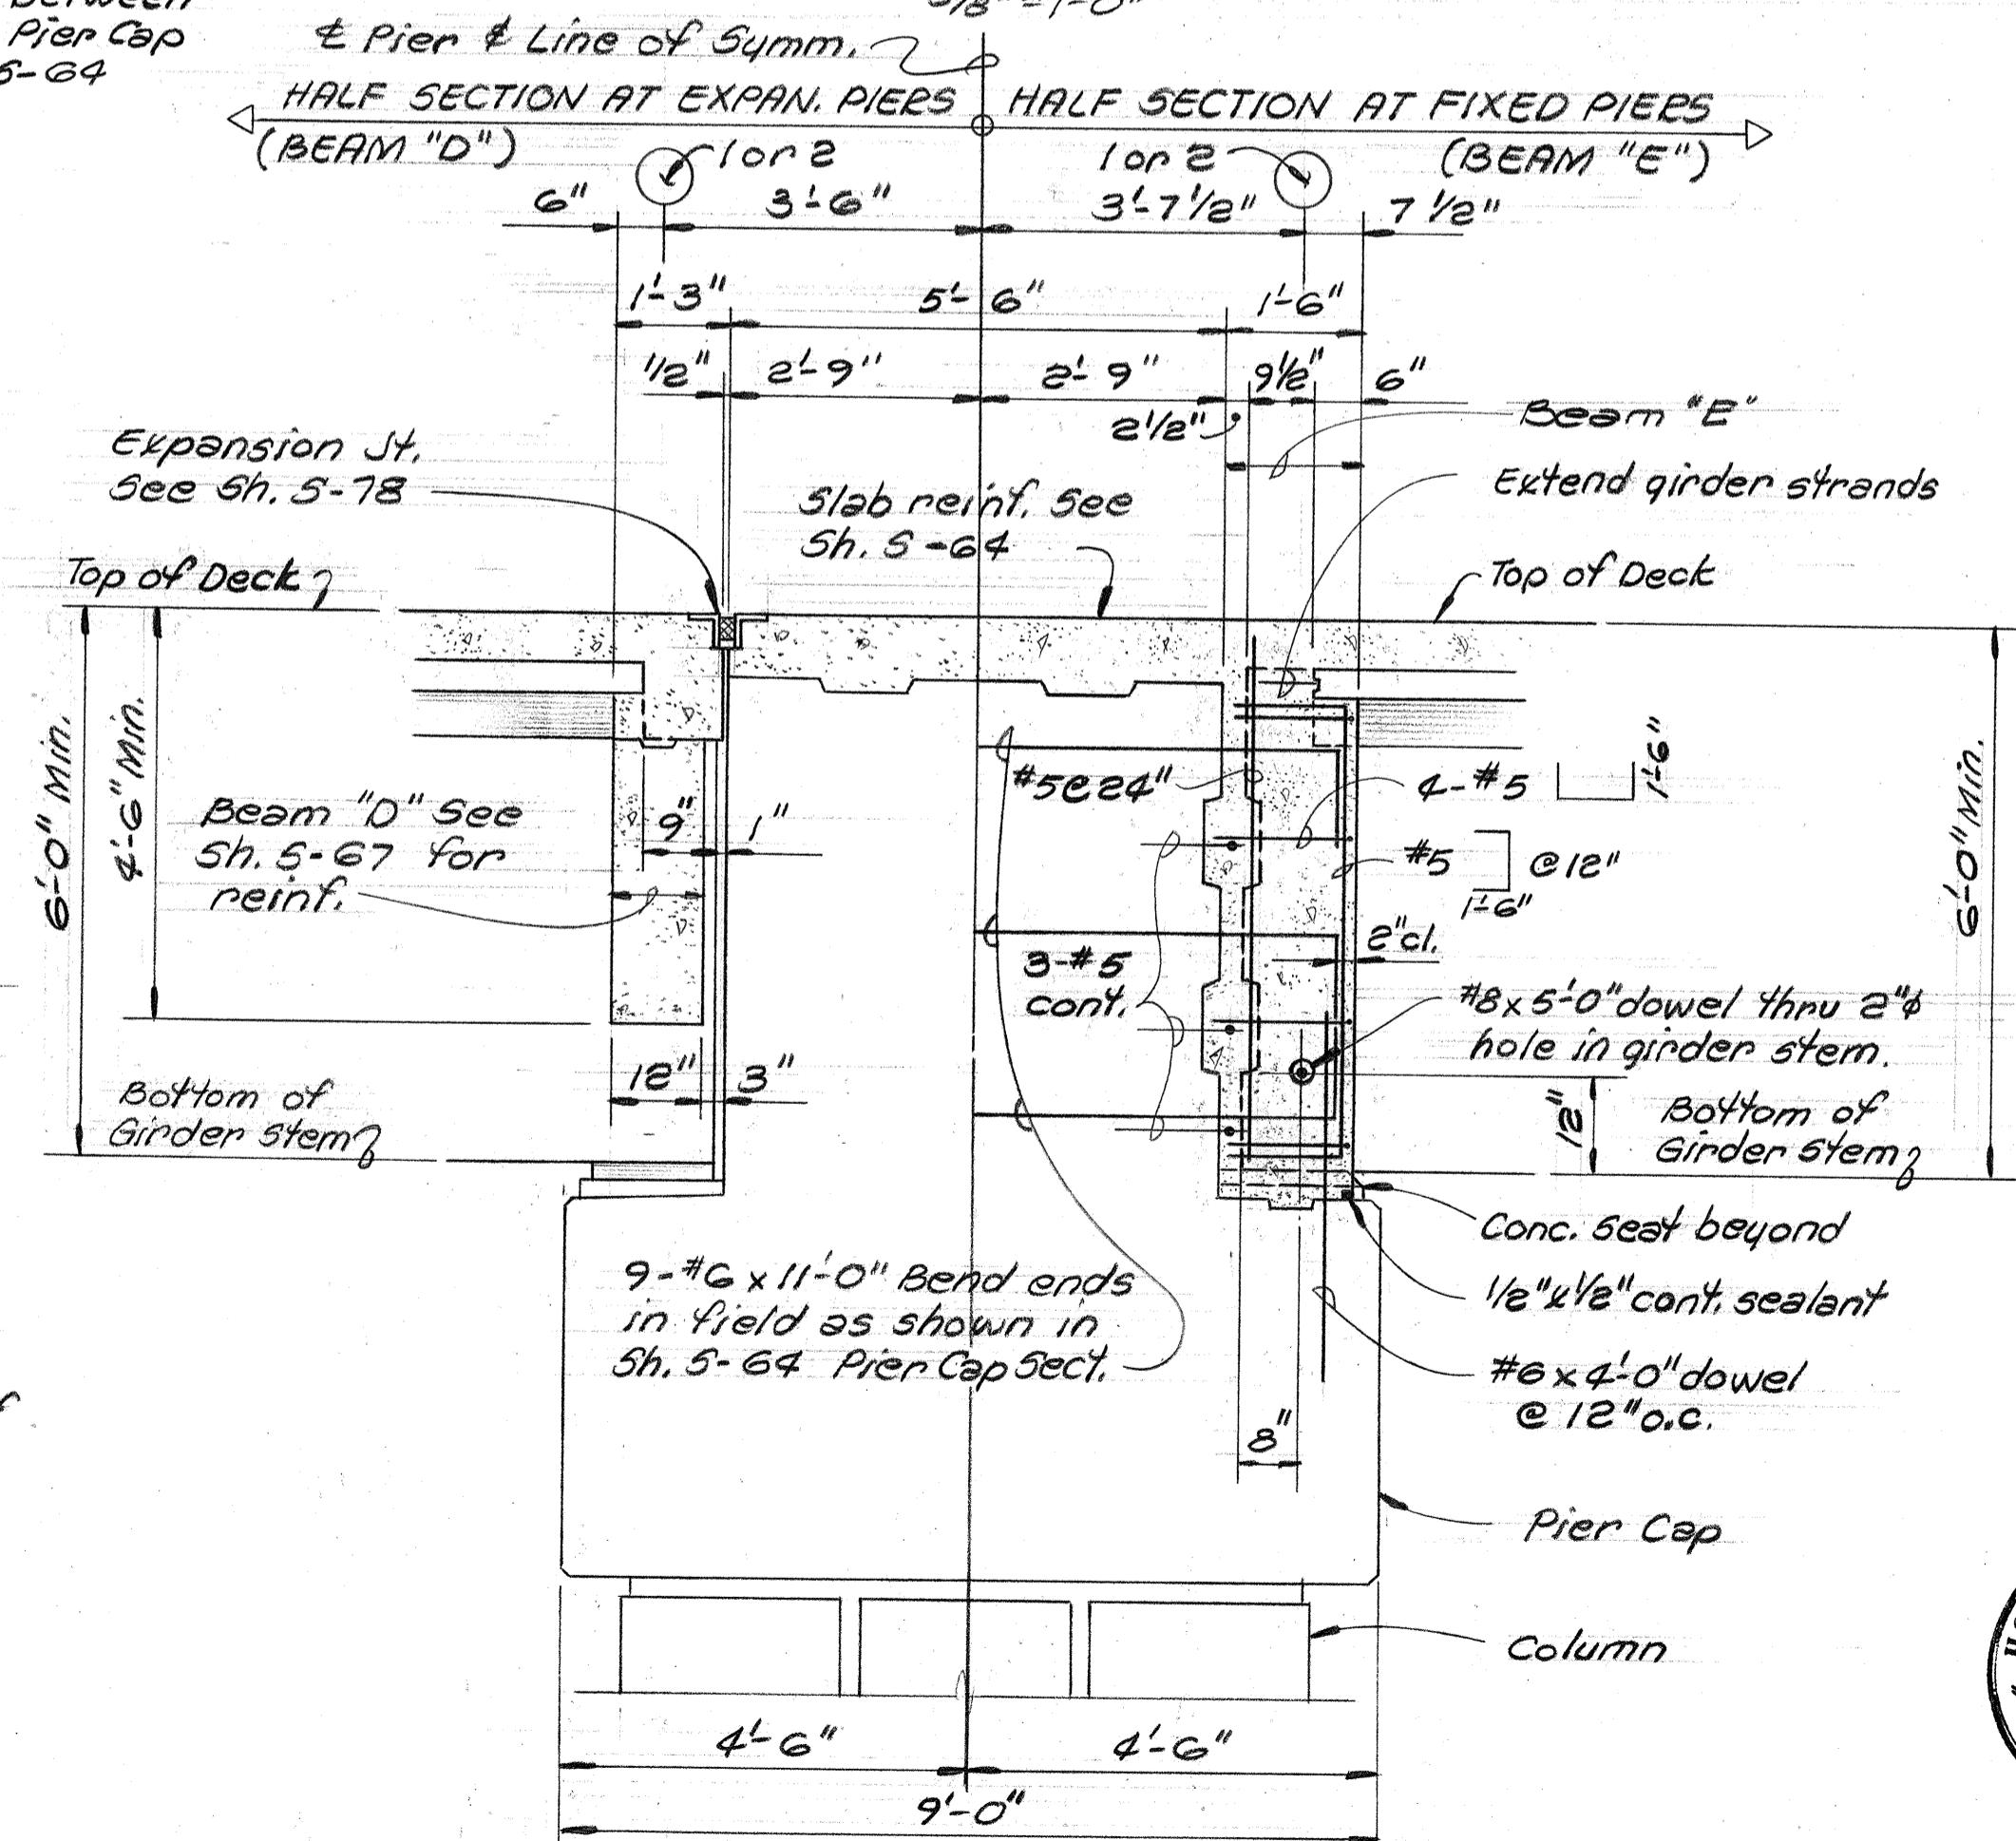

TYPICAL SECTION OF BEAM "D" & "E"

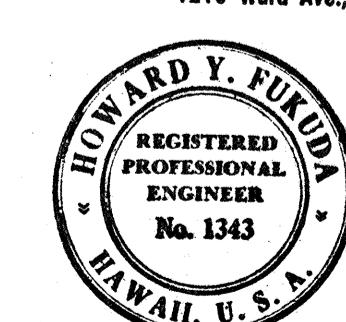

SHIMADU SHIMABUKURO & FUKUDA, INC.
Consulting Structural Engineers
1210 West Avenue, Hanover, Ill. 61031

**STATE OF HAWAII
DEPARTMENT OF TRANSPORTATION
HIGHWAYS DIVISION**


STRUCTURE No. 8

DETAILS OF BEAMS P E N

PEARL HARBOR INTERCHANGE
F.A.I. PROJ. NO 1-HI-1 (73) 115

Scale: As Shown Date: DEC. 7, 1973
SHEET No 9-660E 106 SHEETS

FED. ROAD DIST. NO.	STATE	FED. AID PROJ. NO.	FISCAL YEAR	SHEET NO.	TOTAL SHEETS
HAWAII	HAW.	I-HI-1(73)115	1974	284	369

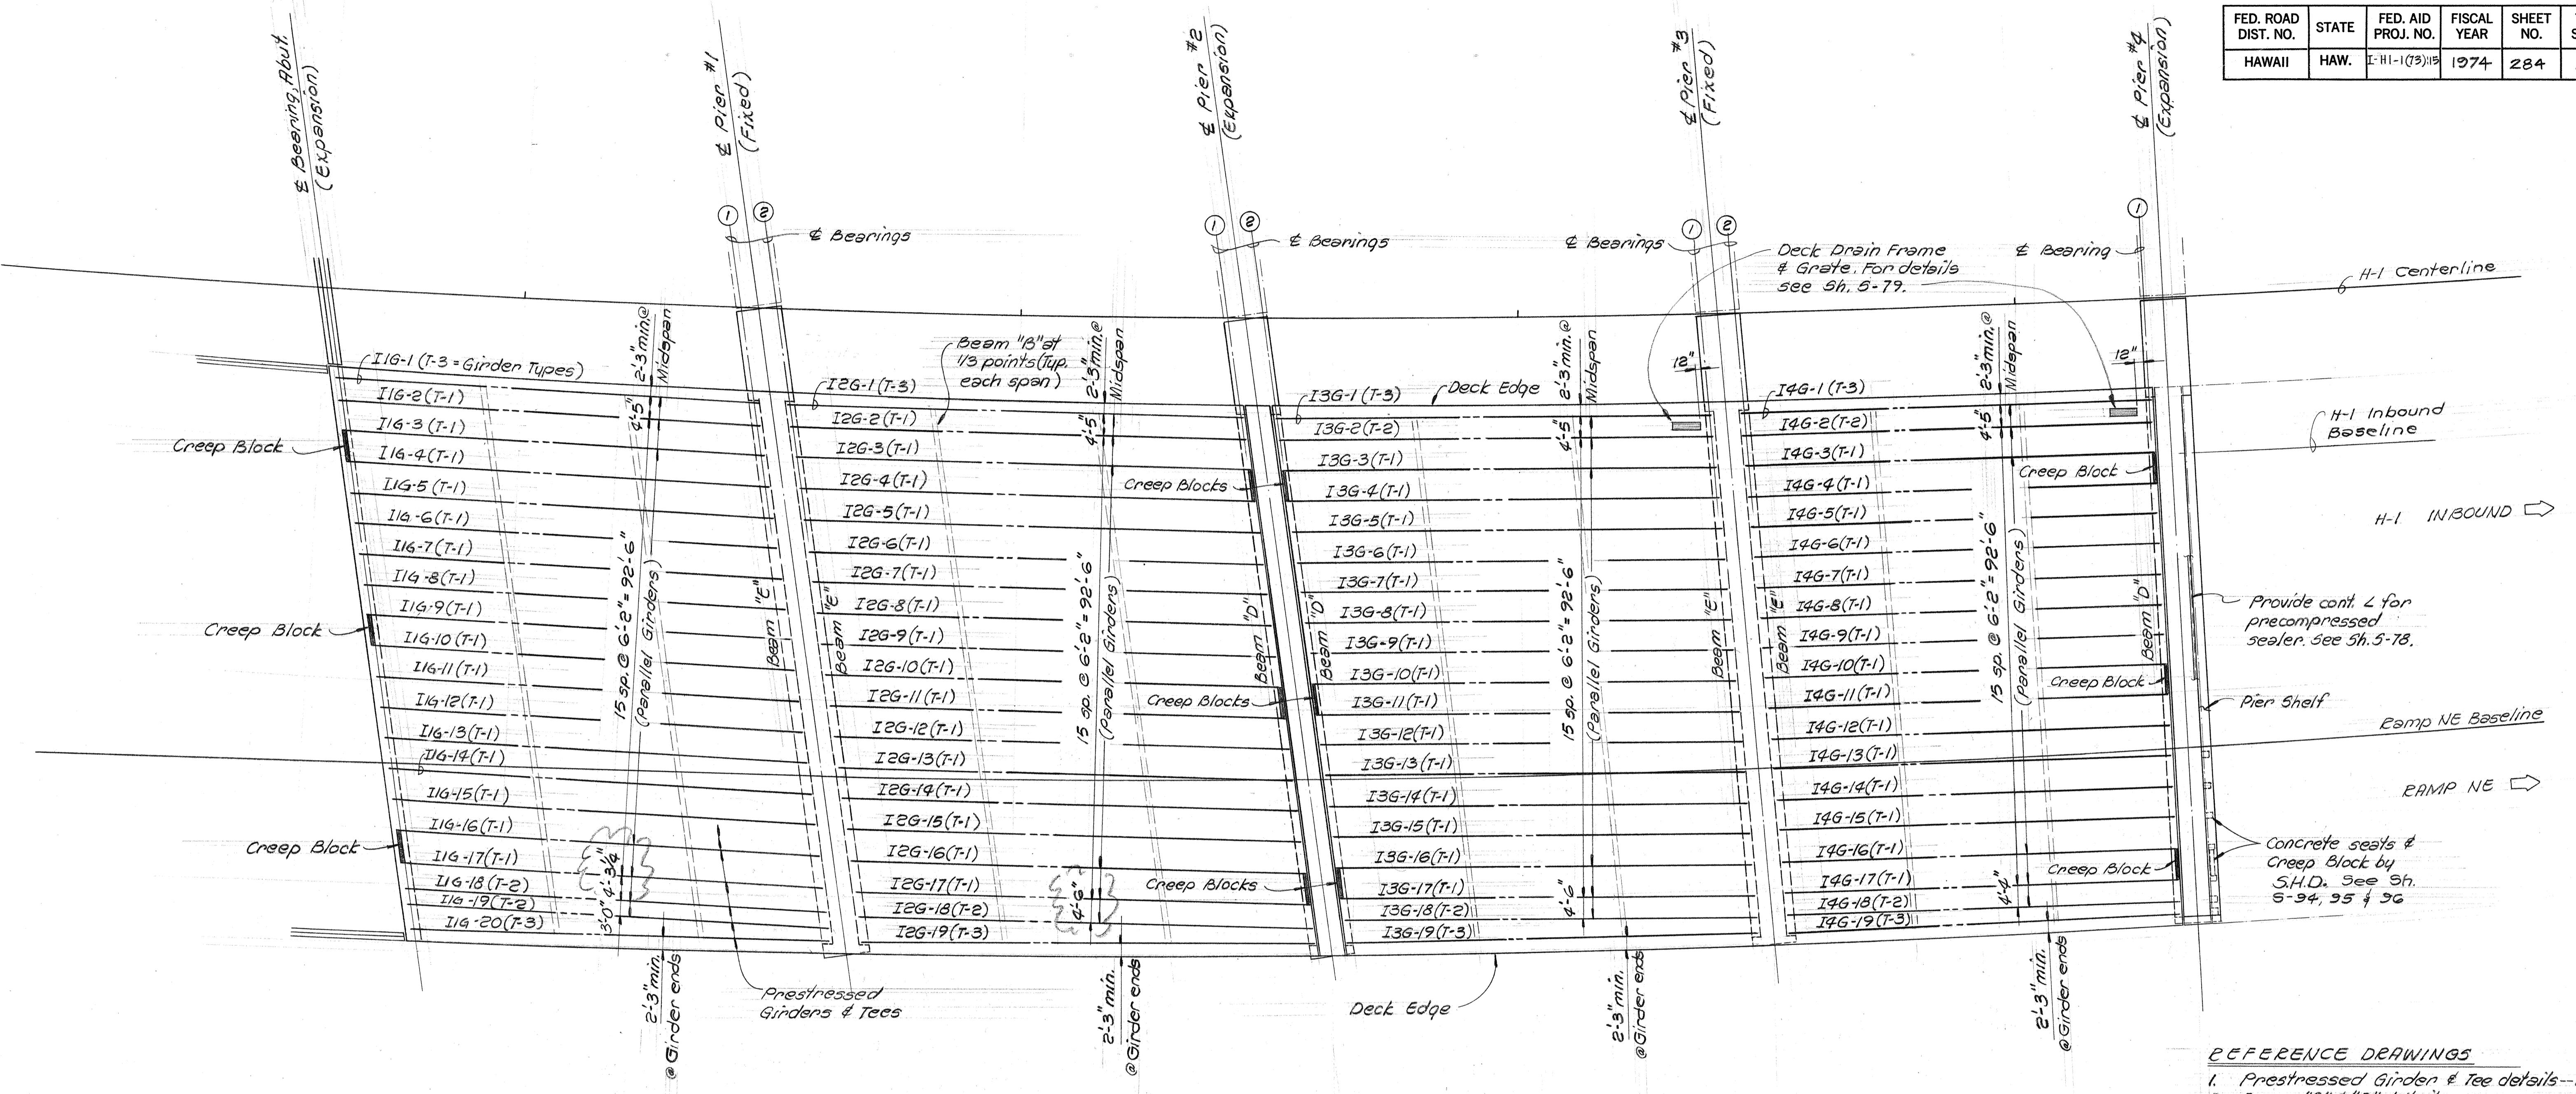


H-1 INBOUND DECK FRAMING PLAN

Scale: 1/16" = 1' 0"

NOTE:

For items purposely not shown here see other sheets.

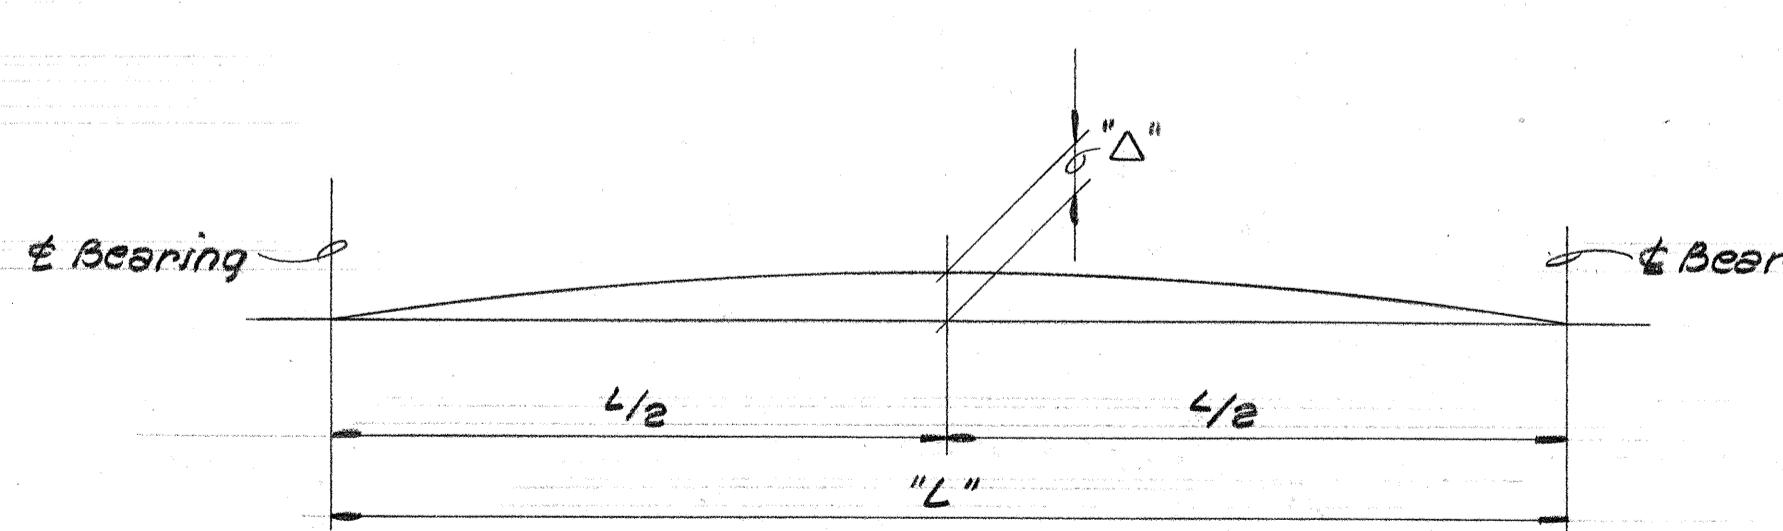


TYPICAL SLAB CAMBER DIAGRAM

TYPE T-1 "△"	TYPE T-3 "△"	TYPE T-2 "△" Spacing 3'-0" & less	Spacing over 3'-0"
5/8"	1/4"	1/4"	1/2"

PREFERENCE DRAWINGS

- STRUCTURAL DETAILS


 1. Prestressed Girder & Tee details -- Sh.5-73
 2. Beam "B" & "D" details ----- Sh.5-66
 3. Beam "E" details ----- Sh.5-67
 4. Creep Block details ----- Sh.5-62

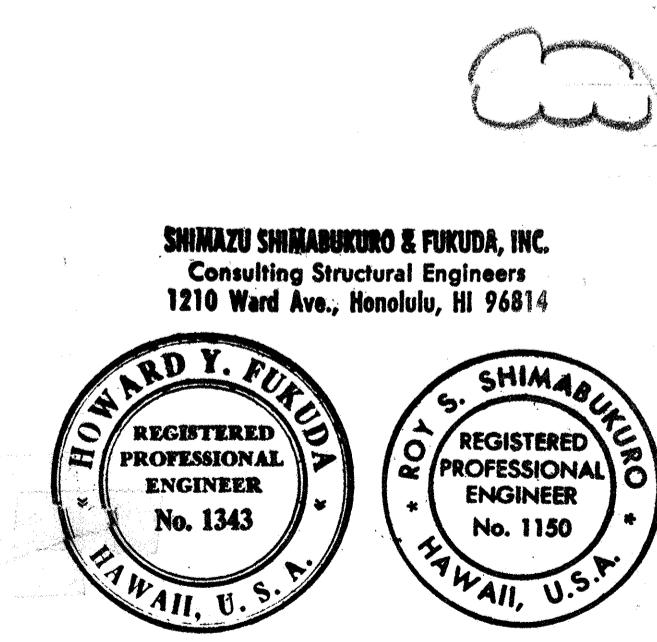

John Doe
THIS WORK WAS PREPARED BY ME
OR UNDER MY SUPERVISION

2-24-76	REVISED GIRDER SPACING,
DATE	REVISION
<p style="text-align: center;">STATE OF HAWAII DEPARTMENT OF TRANSPORTATION HIGHWAYS DIVISION</p>	
<p style="text-align: center;">STRUCTURE No.8</p>	
<p style="text-align: center;">H-I INBOUND DECK FRAMING PLAN</p>	
<p style="text-align: center;">PEARL HARBOR INTERCHANGE F.A.I. Proj. No 1-HI-1 (73) 15</p>	
<p style="text-align: left;">Scale: As Shown</p>	
<p style="text-align: right;">Date: DEC. 7, 1973</p>	
<p style="text-align: center;">SHEET NO. 6 OF 16 SHEETS</p>	

FED. ROAD DIST. NO.	STATE	FED. AID PROJ. NO.	FISCAL YEAR	SHEET NO.	TOTAL SHEETS
HAWAII	HAW.	I-HI-1(73)15	1974	285	369

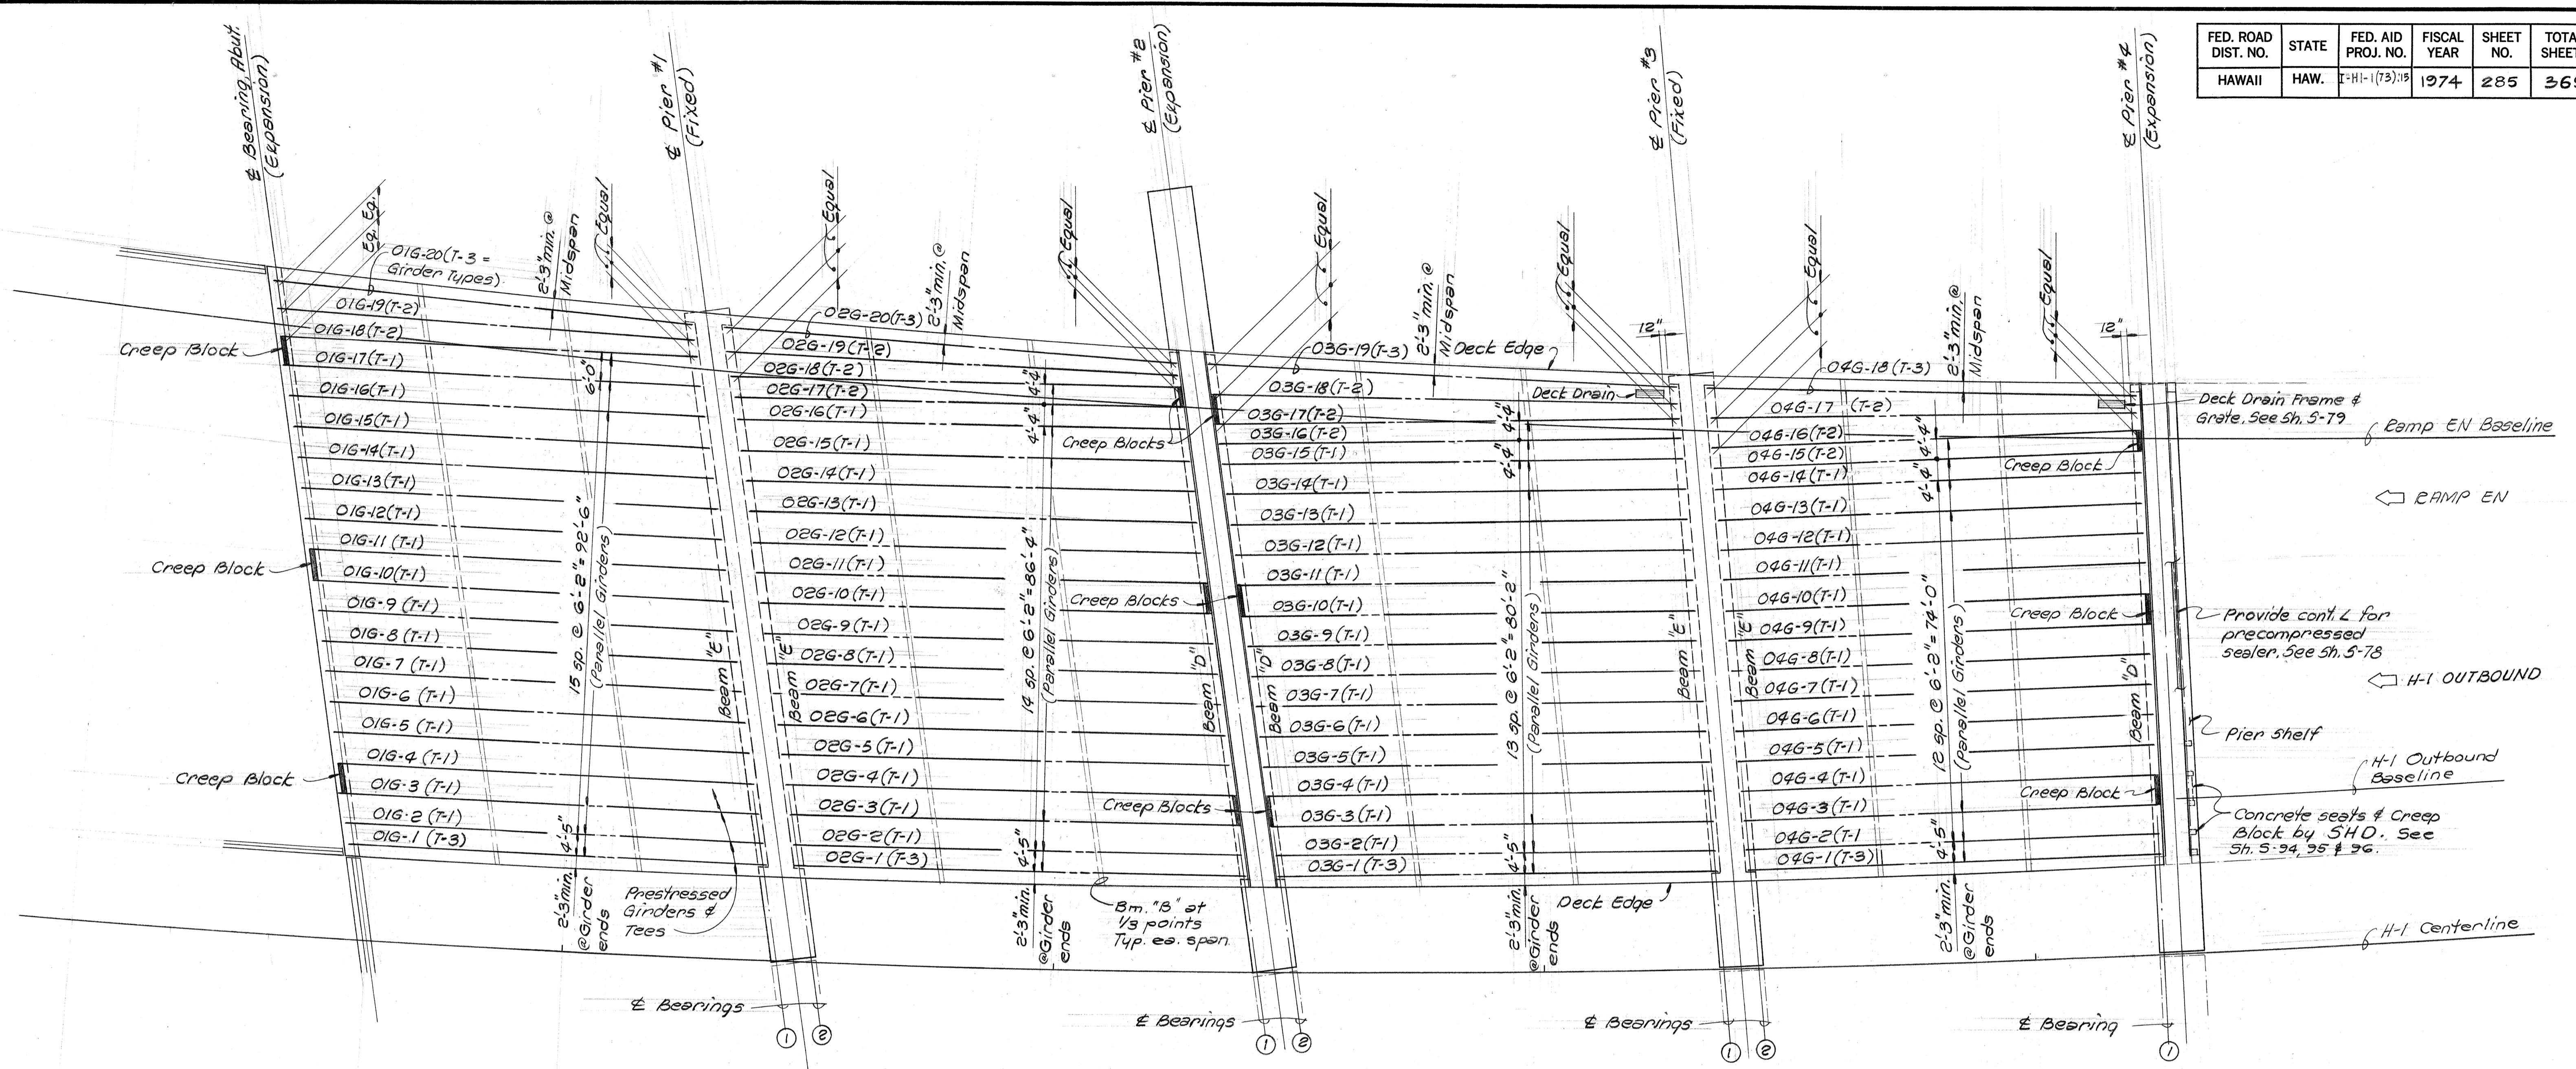

H-1 OUTBOUND DECK FRAMING PLAN

1/16" = 1'-0"


NOTE:
For items purposely not shown
here see other sheets.

NOTE: See Sh. S-68 for slab camber diagram.

REFERENCE DRAWINGS

1. Prestressed Girders & Tees details - Sh. S-73
2. Beam "B" & "D" details - Sh. S-66
3. Beam "E" details - Sh. S-67
4. Creep Block details - Sh. S-62

ORIGINAL	SURVEY PLOTTED BY	DATE
PLAN	DRAWN BY	"
NOTE BOOK	PLACED BY	"
No. _____	DESIGNED BY	"
QUANTIFIED BY	"	"
CHECKED BY	"	"

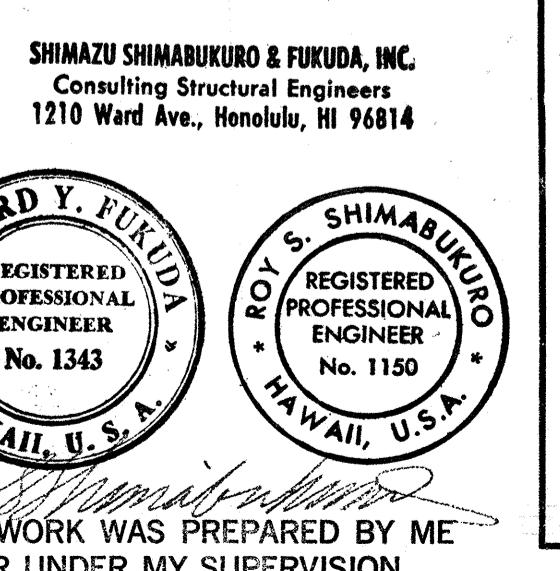

THIS WORK WAS PREPARED BY ME
OR UNDER MY SUPERVISION

STATE OF HAWAII
DEPARTMENT OF TRANSPORTATION
HIGHWAYS DIVISION

STRUCTURE No. 8
H-1 OUTBOUND
DECK FRAMING PLAN

PEARL HARBOR INTERCHANGE
F.A.I. Proj. No I-HI-1(73)15

Scale 1: As Shown Date DEC. 7, 1973
SHEET NO. S-69 OF 106 SHEETS

GEOMETRICS FOR INBOUND LANES ABUTMENT & PIERS

FED. ROAD DIST. NO.	STATE	FED. AID PROJ. NO.	FISCAL YEAR	SHEET NO.	TOTAL SHEETS
HAWAII	HAW.	I-HI-1(73):15	1974	286	369

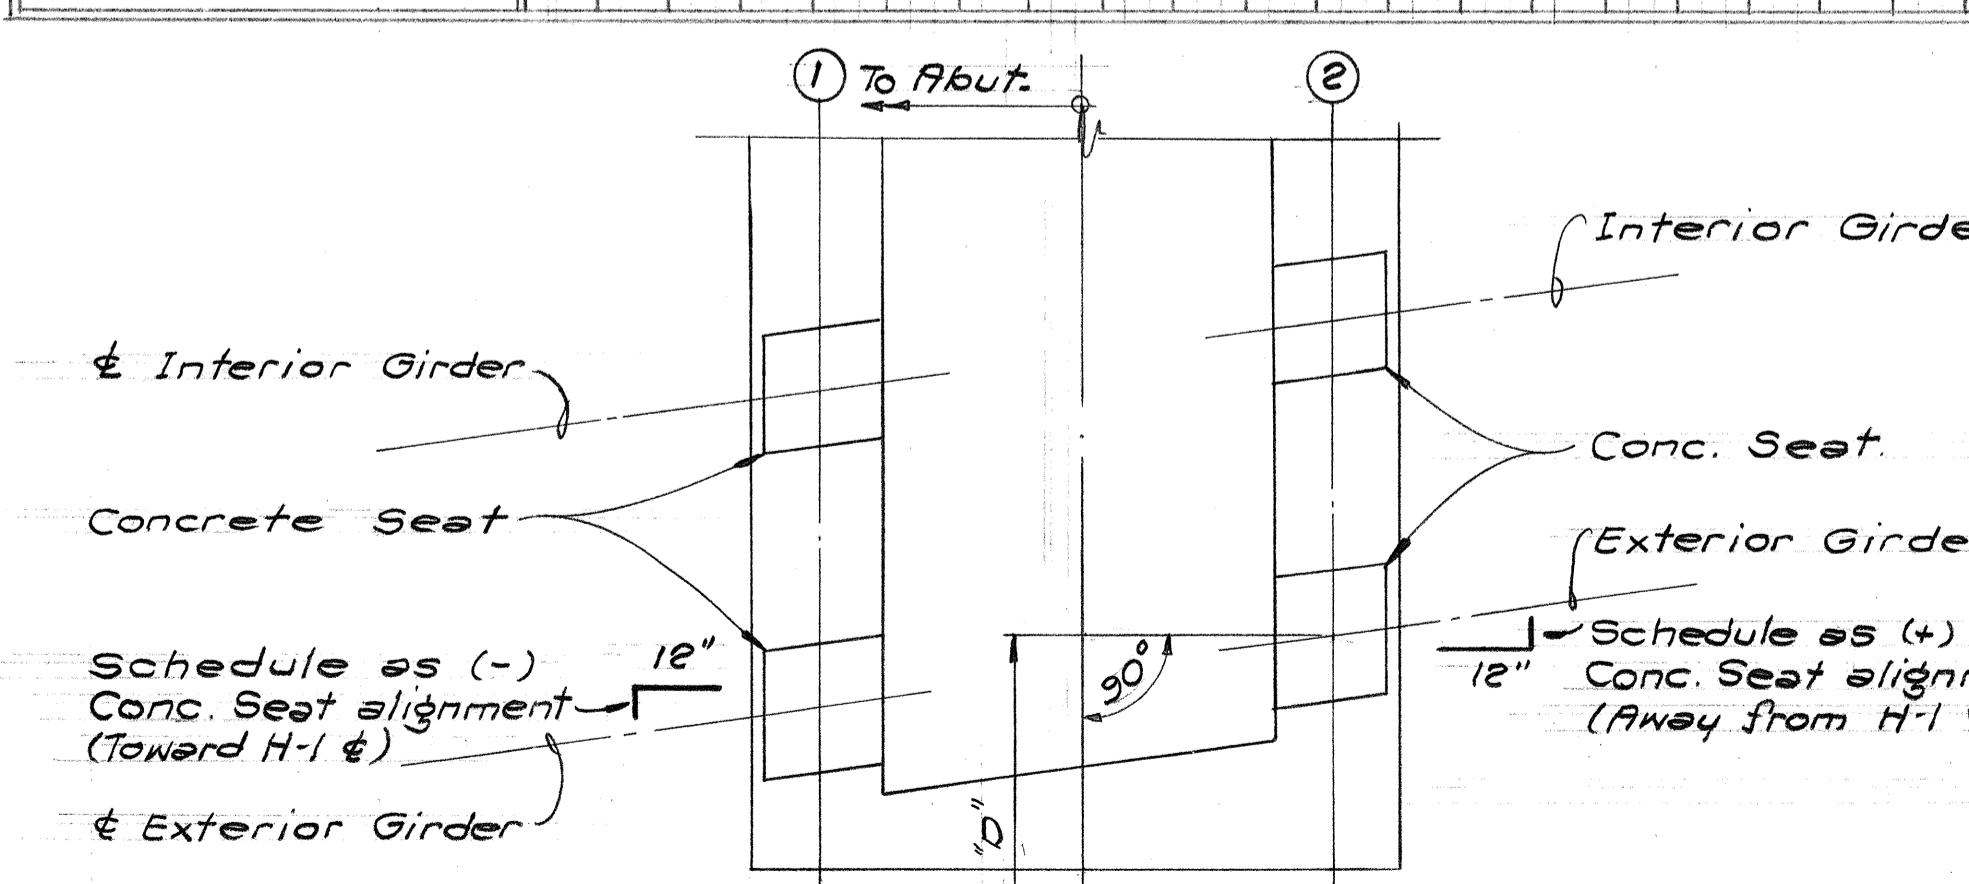
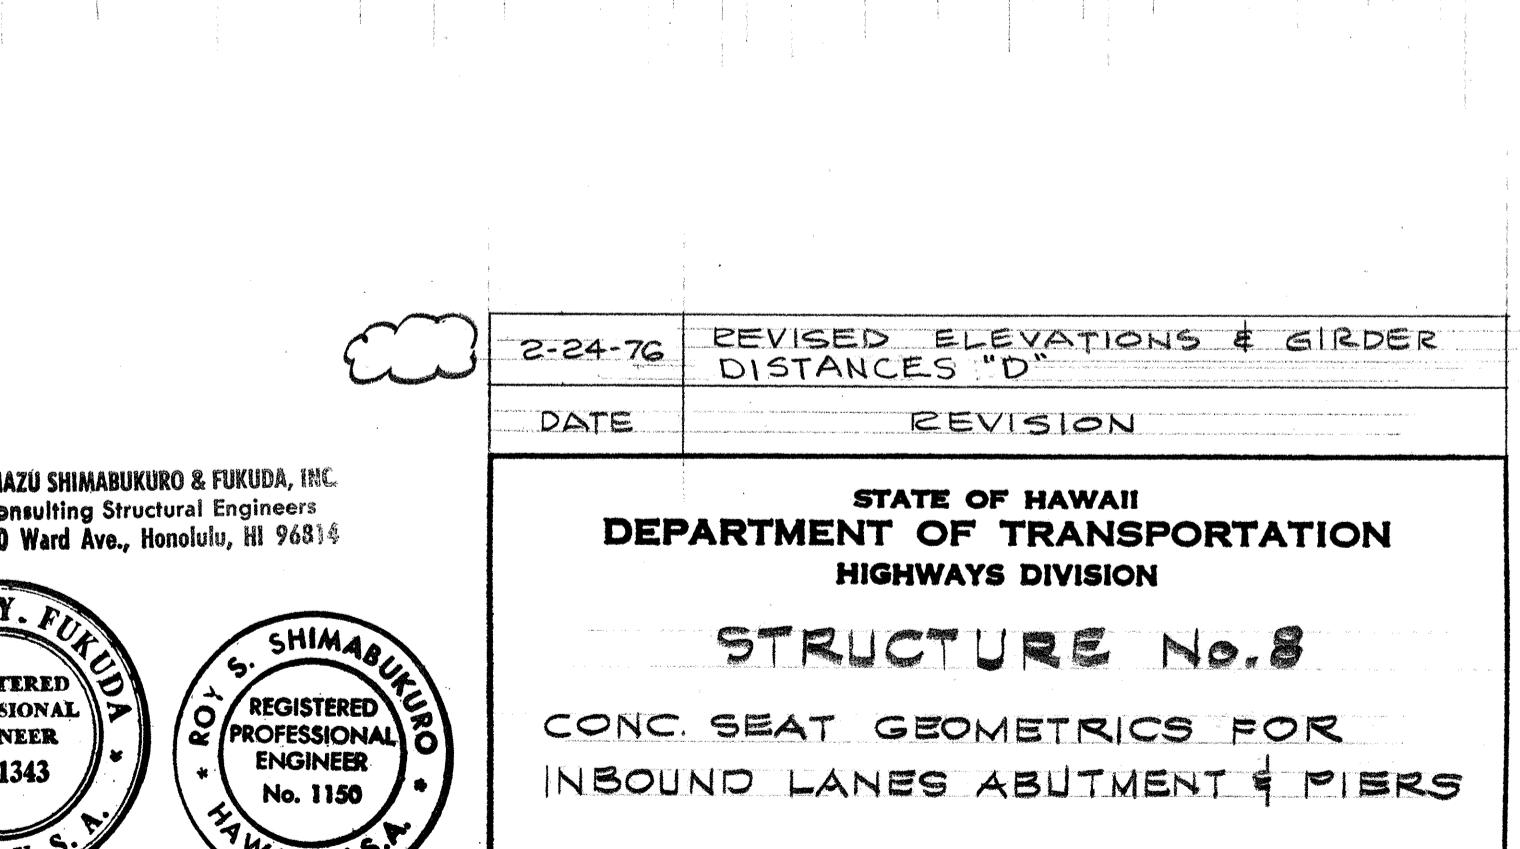
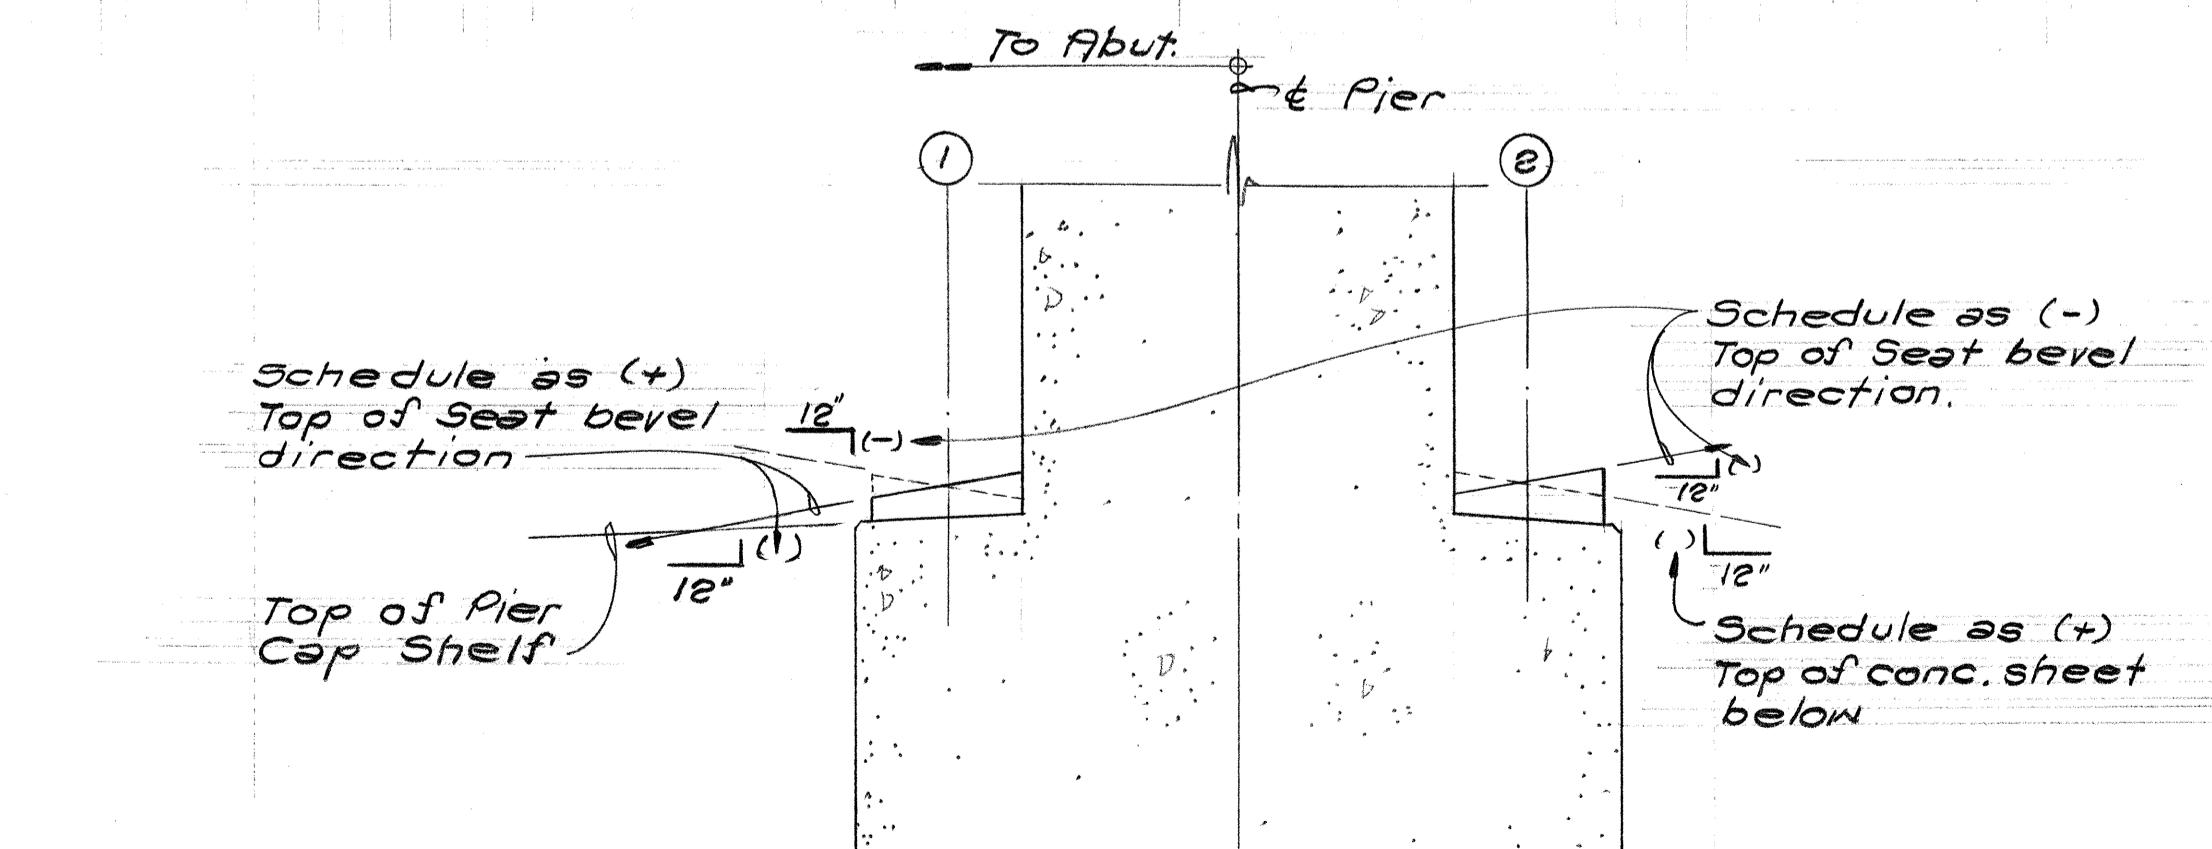
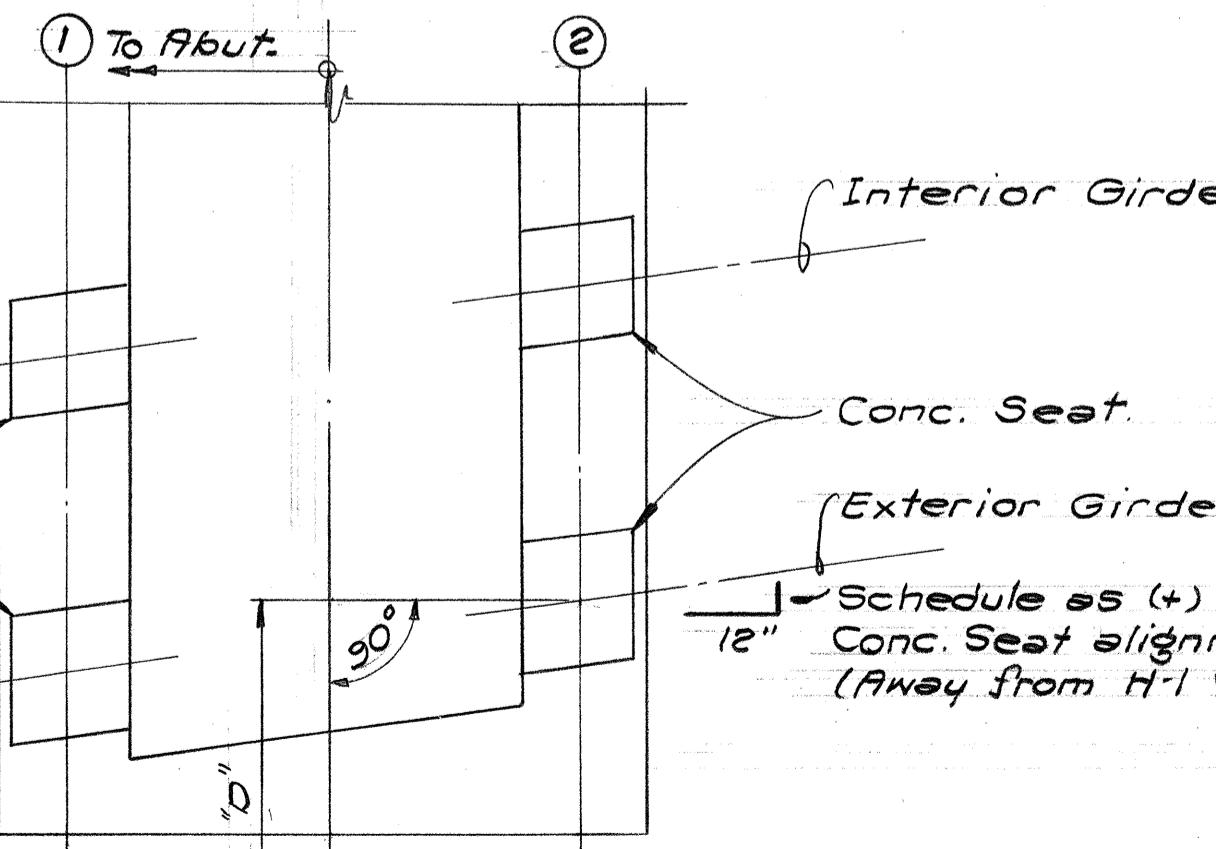
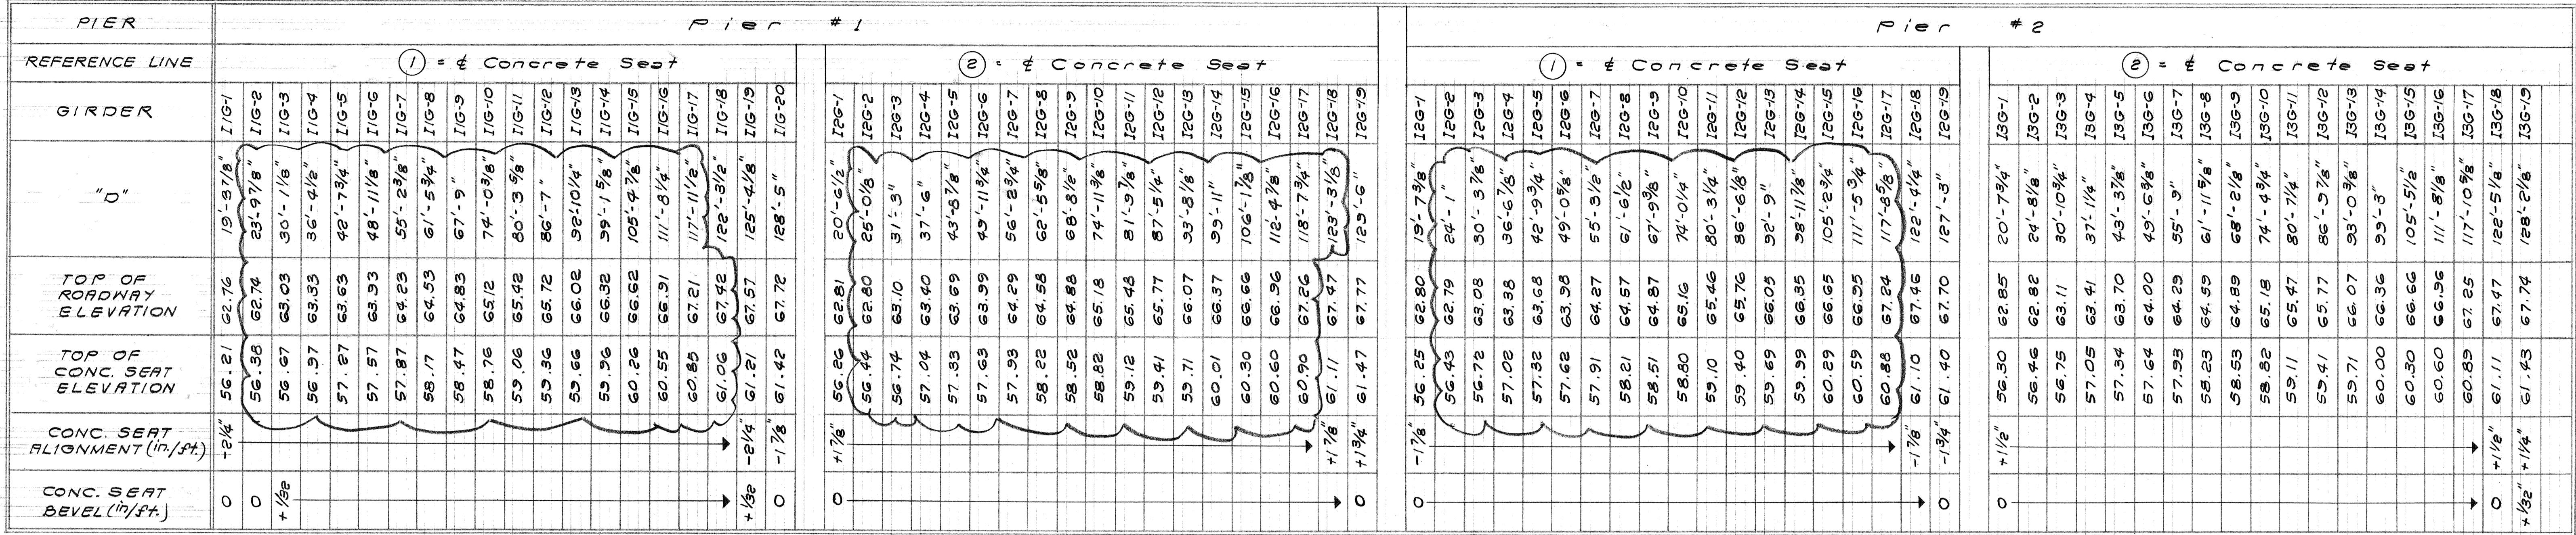


DIAGRAM SHOWING CONC. SEAT BEVEL DIRECTION
N.T.S.

This work was prepared by
me or under my supervision.
Howard Y. Fukuda
State of Hawaii
Department of Transportation
Highways Division
Structure No. 8
Conc. Seat Geometrics for
Inbound Lanes Abutment & Piers
Pearl Harbor Interchange
F.A.I. Proj. No. I-HI-1(73):15
Scale: As Shown Date: DEC. 7, 1973
Sheet No. 5-700 of 106 Sheets

GEOMETRICS FOR OUTBOUND LANES ABUTMENT & PIERS

D. ROAD IST. NO.	STATE	FED. AID PROJ. NO.	FISCAL YEAR	SHEET NO.	TOTAL SHEETS
HAWAII	HAW.	I-HI-1(73):15	1974	287	369

PIER		REFERENCE LINE		GIRDER		REFERENCE LINE		GIRDER		REFERENCE LINE		GIRDER		REFERENCE LINE		GIRDER		REFERENCE LINE		GIRDER												
TOP OF ROADWAY ELEVATION	0"	TOP OF CONC. SEAT ALIGNMENT (in./ft.)		TOP OF ROADWAY ELEVATION	0"	TOP OF CONC. SEAT ALIGNMENT (in./ft.)		TOP OF ROADWAY ELEVATION	0"	TOP OF CONC. SEAT ALIGNMENT (in./ft.)		TOP OF ROADWAY ELEVATION	0"	TOP OF CONC. SEAT ALIGNMENT (in./ft.)		TOP OF ROADWAY ELEVATION	0"	TOP OF CONC. SEAT ALIGNMENT (in./ft.)		TOP OF ROADWAY ELEVATION	0"	TOP OF CONC. SEAT ALIGNMENT (in./ft.)										
CONC. SEAT BEVEL (in./ft.)		CONC. SEAT BEVEL (in./ft.)		CONC. SEAT BEVEL (in./ft.)		CONC. SEAT BEVEL (in./ft.)		CONC. SEAT BEVEL (in./ft.)		CONC. SEAT BEVEL (in./ft.)		CONC. SEAT BEVEL (in./ft.)		CONC. SEAT BEVEL (in./ft.)		CONC. SEAT BEVEL (in./ft.)		CONC. SEAT BEVEL (in./ft.)		CONC. SEAT BEVEL (in./ft.)		CONC. SEAT BEVEL (in./ft.)										
57.32	63.62	20'-2 3/8"	03G-1	57.18	63.64	19'-5 3/4"	09G-1	57.07	63.43	24'-1 3/4"	04G-2	56.91	63.27	24'-6 5/8"	04G-2	56.61	62.97	30'-8 3/8"	04G-3	56.48	62.84	36'-10 5/8"	04G-4									
57.04	63.40	24'-7 1/2"	03G-2	57.04	63.11	30'-9 3/4"	03G-3	56.75	63.11	30'-9 3/4"	03G-4	56.45	62.81	37'-0"	03G-4	56.16	62.52	43'-2 1/4"	03G-5	55.86	62.22	49'-4 1/2"	03G-6									
57.75	63.11	30'-9 3/4"	03G-2	57.75	63.11	30'-9 3/4"	03G-3	56.45	62.81	37'-0"	03G-4	56.16	62.52	43'-2 1/4"	03G-5	55.86	62.22	49'-4 1/2"	03G-6	55.57	61.93	55'-6 3/4"	03G-7									
58.0	63.40	24'-7 1/2"	03G-2	58.0	63.11	30'-9 3/4"	03G-3	57.75	63.11	30'-9 3/4"	03G-4	56.45	62.81	37'-0"	03G-5	56.16	62.52	43'-2 1/4"	03G-6	55.86	62.22	49'-4 1/2"	03G-7									
58.75	63.11	30'-9 3/4"	03G-2	58.75	63.11	30'-9 3/4"	03G-3	56.45	62.81	37'-0"	03G-4	56.16	62.52	43'-2 1/4"	03G-5	55.86	62.22	49'-4 1/2"	03G-6	55.27	61.63	61'-9"	03G-8									
59.45	62.81	37'-0"	03G-4	59.45	62.81	37'-0"	03G-4	58.0	63.40	24'-7 1/2"	03G-2	57.75	63.11	30'-9 3/4"	03G-3	56.45	62.81	37'-0"	03G-4	56.16	62.52	43'-2 1/4"	03G-5	55.86	62.22	49'-4 1/2"	03G-6					
59.6	62.52	43'-2 1/4"	03G-5	59.6	62.22	49'-4 1/2"	03G-6	58.45	62.81	37'-0"	03G-4	57.75	63.11	30'-9 3/4"	03G-3	56.45	62.81	37'-0"	03G-4	56.16	62.52	43'-2 1/4"	03G-5	55.86	62.22	49'-4 1/2"	03G-6					
59.88	61.84	67'-1 1/4"	03G-9	59.88	61.84	67'-1 1/4"	03G-9	59.27	59.15	105'-0 3/4"	03G-10	59.0	59.57	105'-0 3/4"	03G-10	58.75	60.75	80'-3 3/4"	03G-11	58.0	60.45	86'-4 1/2"	03G-12	57.50	59.86	98'-10 1/2"	03G-13					
59.68	61.04	74'-1 1/2"	03G-10	59.68	61.04	74'-1 1/2"	03G-10	59.39	60.75	80'-3 3/4"	03G-11	59.0	60.45	86'-4 1/2"	03G-12	58.0	60.16	92'-8 1/2"	03G-13	57.49	60.45	94'-2 1/2"	03G-14	57.0	60.16	97'-5 3/8"	03G-15					
59.50	59.86	98'-10 1/2"	03G-12	59.50	59.86	98'-10 1/2"	03G-12	59.21	59.57	105'-0 3/4"	03G-13	58.9	59.21	105'-0 3/4"	03G-13	58.0	59.0	112'-10 1/2"	03G-14	57.50	59.0	112'-10 1/2"	03G-15	57.0	59.0	112'-10 1/2"	03G-16					
59.57	59.57	105'-0 3/4"	03G-13	59.57	59.57	105'-0 3/4"	03G-13	59.00	59.36	109'-4 1/2"	03G-16	58.75	59.00	112'-10 1/2"	03G-17	58.0	58.26	58.62	124'-10 1/2"	03G-18	57.50	58.26	58.45	128'-4 1/2"	03G-19	57.0	58.07	129'-9 3/4"	03G-20			
59.79	59.57	105'-0 3/4"	03G-13	59.79	59.57	105'-0 3/4"	03G-13	59.00	59.36	109'-4 1/2"	03G-16	58.75	59.00	112'-10 1/2"	03G-17	58.0	58.26	58.62	124'-10 1/2"	03G-18	57.50	58.26	58.45	128'-4 1/2"	03G-19	57.0	58.07	129'-9 3/4"	03G-20			
59.81	59.63	53.99	117'-0 1/2"	03G-18	59.81	59.63	53.99	117'-0 1/2"	03G-18	59.54	59.54	53.99	117'-0 1/2"	03G-18	59.0	-1 1/4"	52.58	+2 1/2"	52.55	52.55	58.91	118'-9 1/2"	03G-17	58.50	-1 1/4"	52.58	+2 1/2"	52.55	52.55	58.91	118'-9 1/2"	03G-20
59.82	59.82	52.58	55.13	59.09	59.09	119'-10 1/2"	03G-18	59.54	59.54	53.99	117'-0 1/2"	03G-18	59.0	-1 1/4"	52.58	+2 1/2"	52.55	52.55	58.91	118'-9 1/2"	03G-17	58.50	-1 1/4"	52.58	+2 1/2"	52.55	52.55	58.91	118'-9 1/2"	03G-20		
24-76 REVISED ELEVATIONS & GIRDER DISTANCES "D"

U SHIMABUKURO & FUKUDA, INC.
Consulting Structural Engineers
2 Ward Ave., Honolulu, HI 96814

A circular registration stamp. The outer ring contains the text "SHIMABUKURO" at the top and "HAWAII, U.S.A." at the bottom. The inner circle contains "ROY S." at the top, "REGISTERED" on the left, "PROFESSIONAL" on the right, "ENGINEER" below it, and "No. 1150" at the bottom.

*This work was prepared by
or under my supervision.*

**STATE OF HAWAII
DEPARTMENT OF TRANSPORTATION
HIGHWAYS DIVISION**

**STATE OF HAWAII
DEPARTMENT OF TRANSPORTATION
HIGHWAYS DIVISION**

**STATE OF HAWAII
DEPARTMENT OF TRANSPORTATION
HIGHWAYS DIVISION**

HIGHWAYS DIVISION

U.S. AIR FORCE

DNC. SEAT GEOMETRICS FOR THE POSITIONING OF BACKS + SEATS

BOUND LANES ABUTMENT PLATES

PEARL HARBOR INTERCHANGE

F.A.I. Proj. No. 1-H1-1(73):15


Scale: As Shown Date: DEC. 7, 1973

SHEET No.5-71 OF 106 SHEETS


287 R

ESTR

FED. ROAD DIST. NO.	STATE	FED. AID PROJ. NO.	FISCAL YEAR	SHEET NO.	TOTAL SHEETS
HAWAII	HAW.	I-HI-1(73)-15	1974	288	369

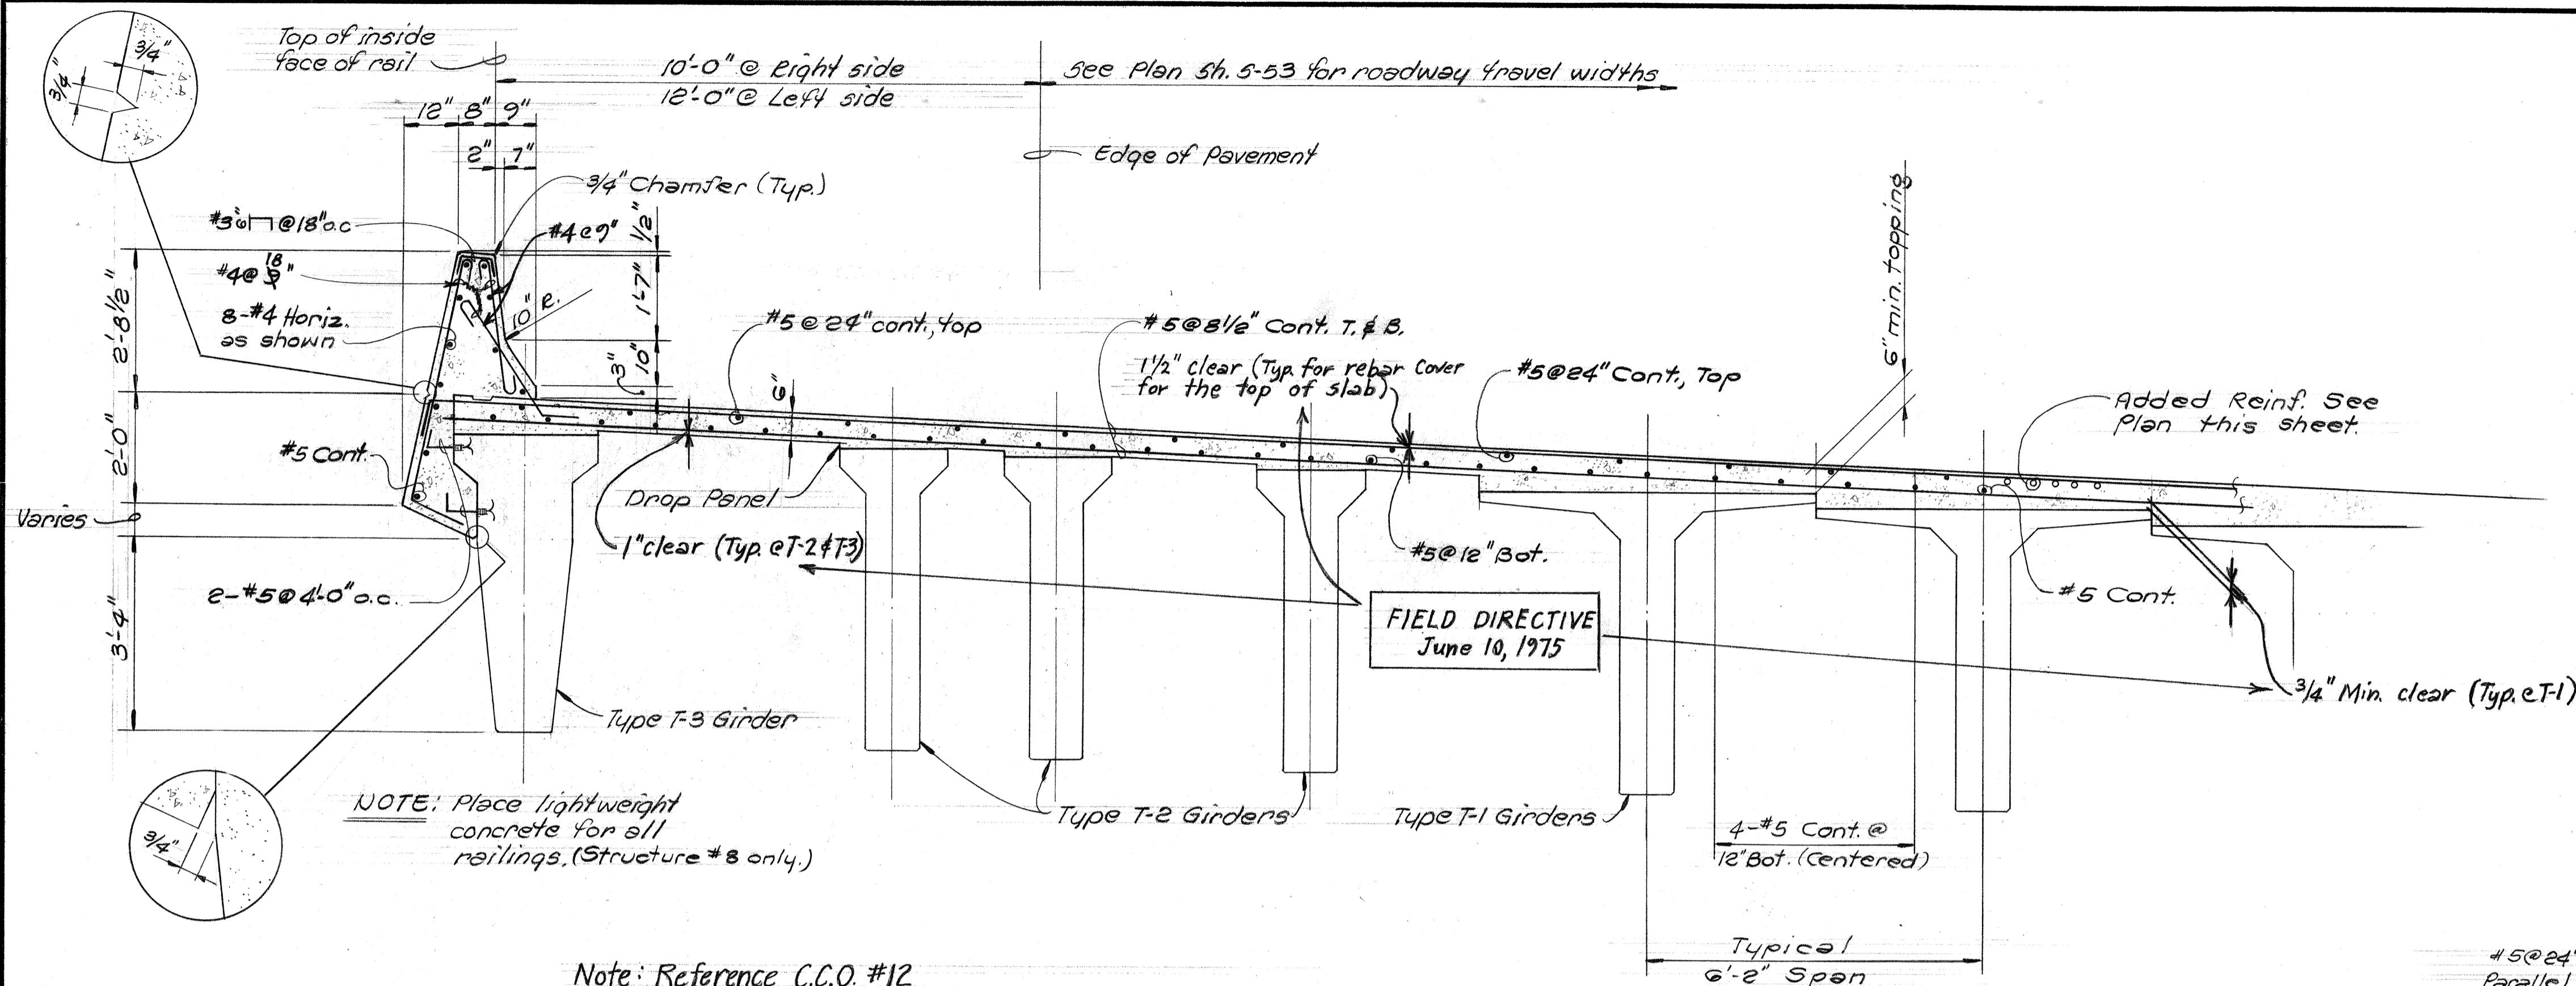


TY P I C A L D E C K R E I N F.

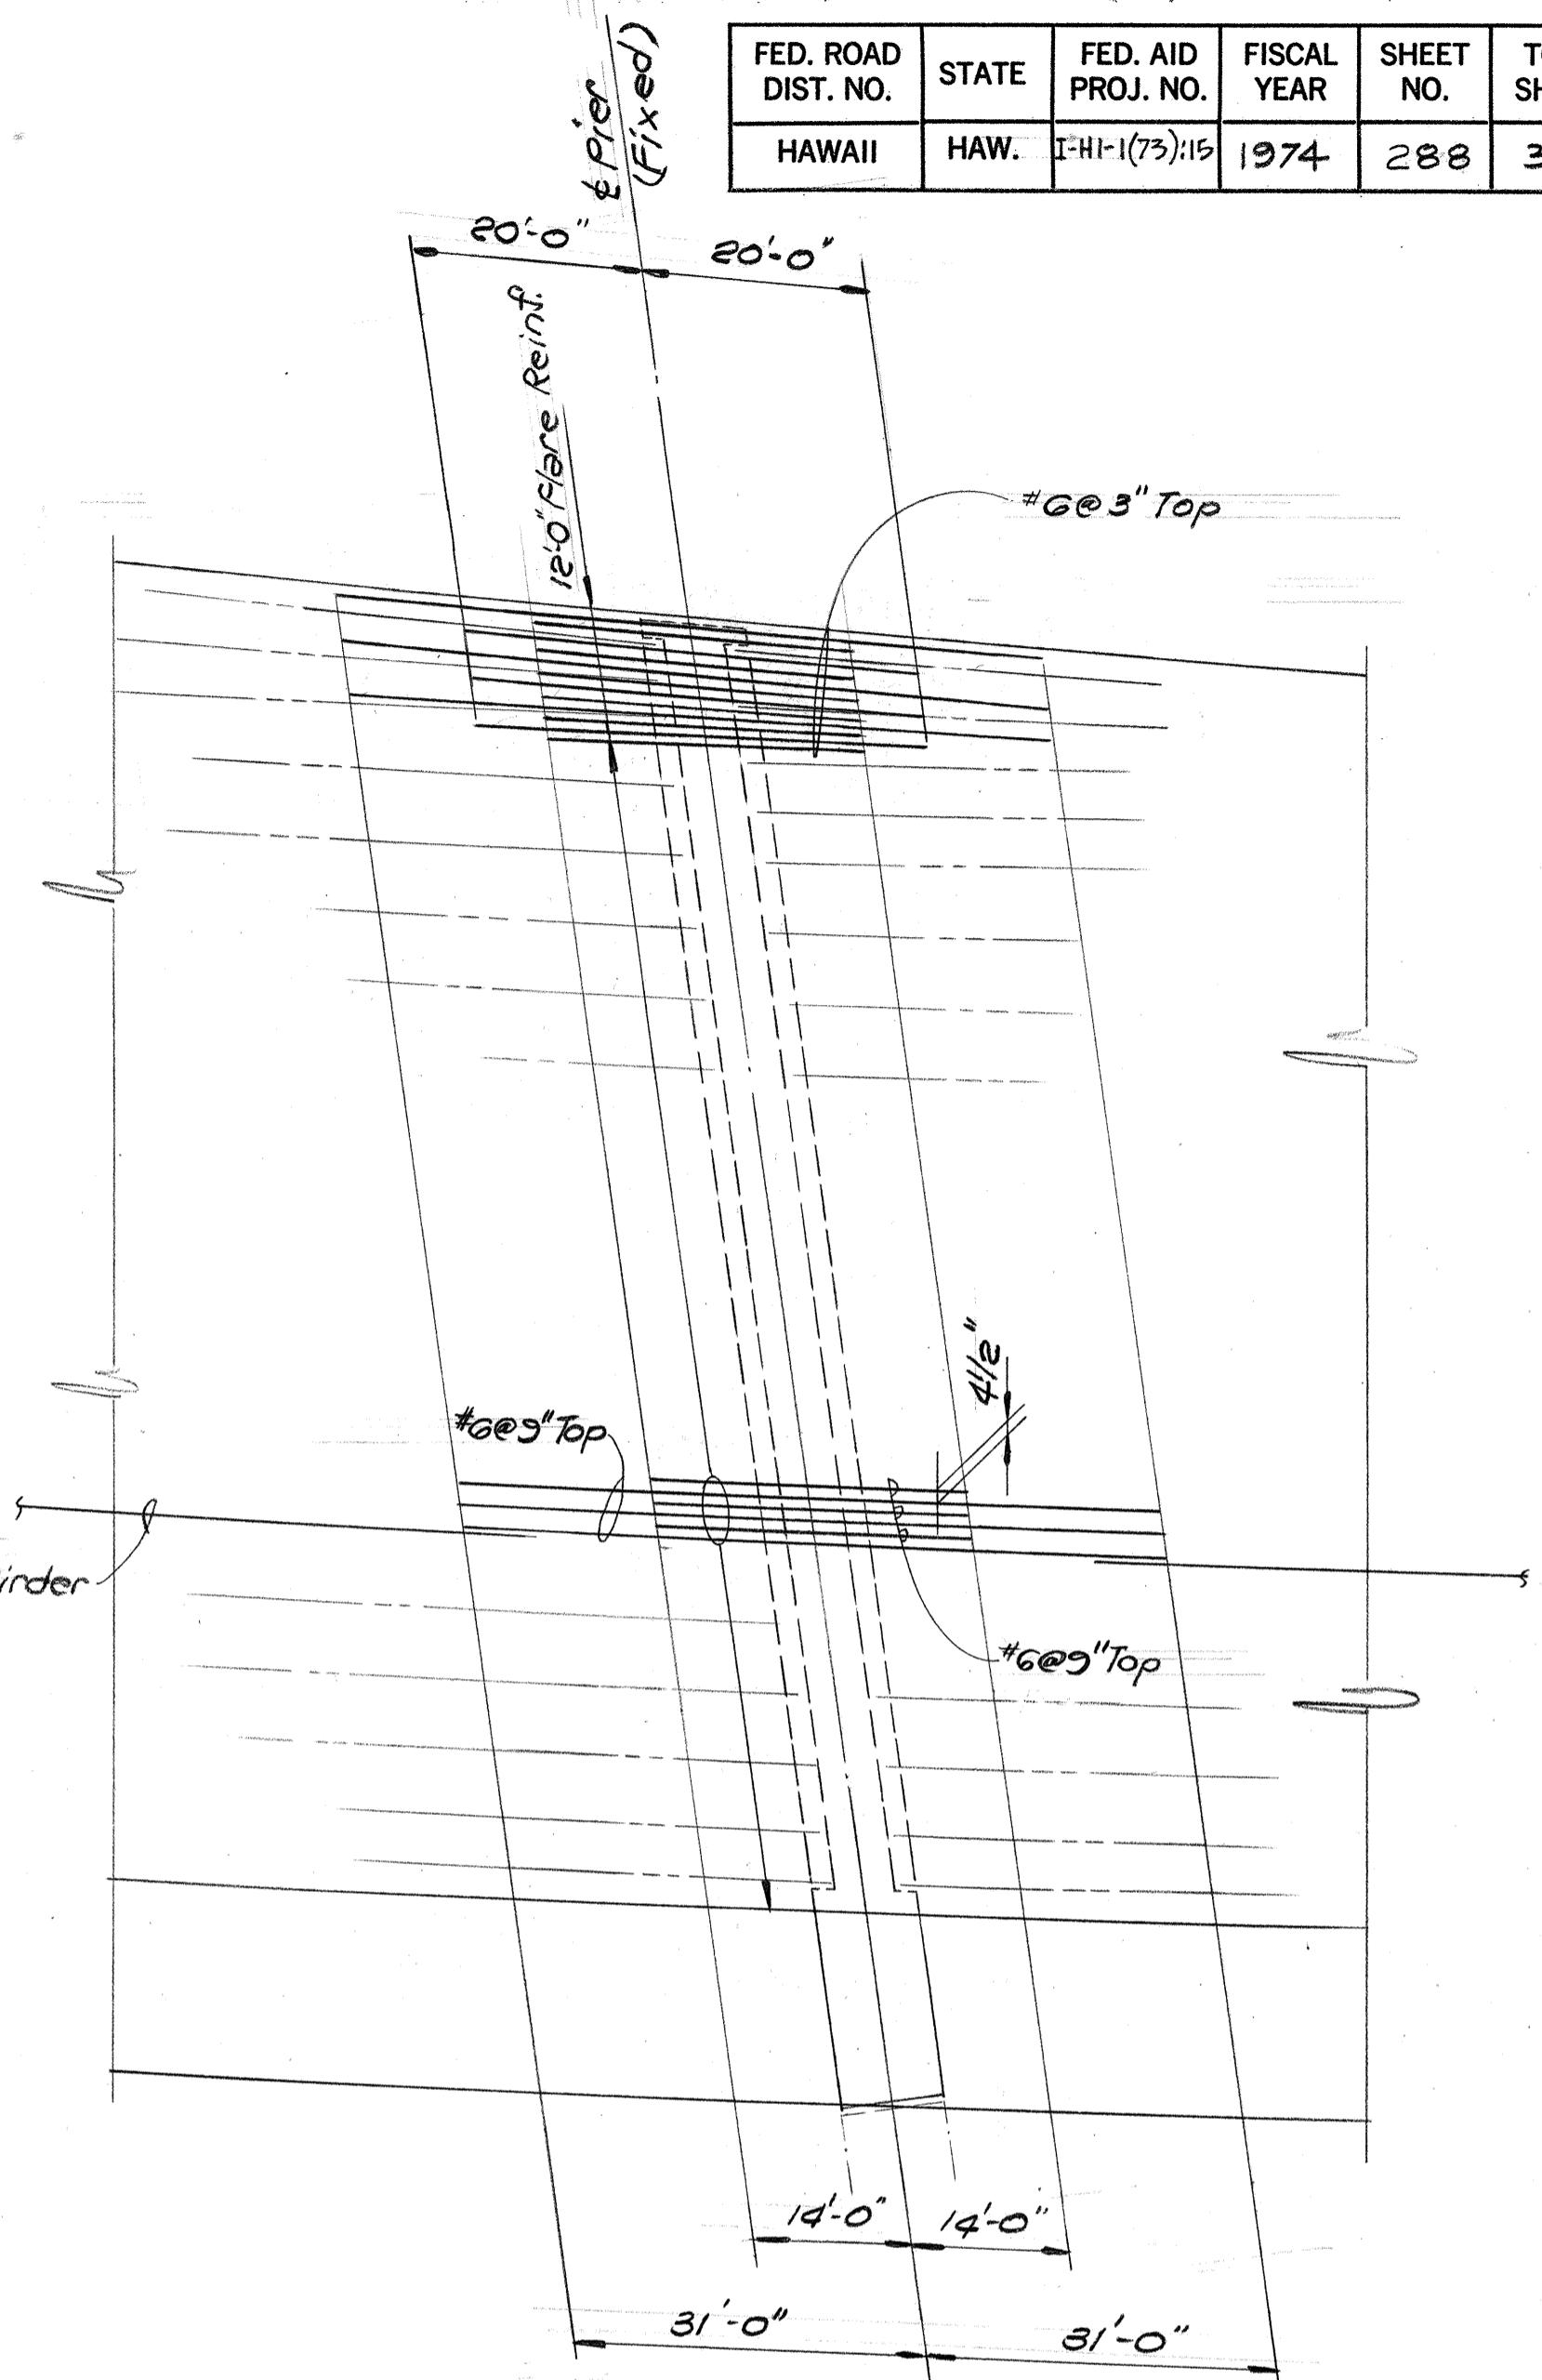

PARTIAL DECK PLAN (ADDED BARS OVER PIER #1 & #3)

1/8" = 1'-0"

ORIGINAL	SURVEY PLOTTED BY	DATE
PLAN	"	"
NOTE BOOK	DRAWN BY	"
QUANTITIES BY	"	"
CHECKED BY	"	"

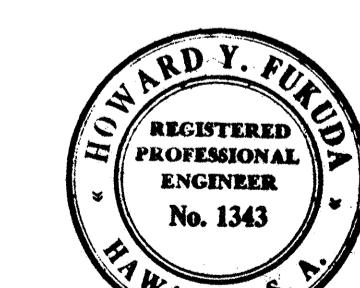

THIS WORK WAS PREPARED BY ME
OR UNDER MY SUPERVISION


STATE OF HAWAII
DEPARTMENT OF TRANSPORTATION
HIGHWAYS DIVISION

STRUCTURE No. 8

TYPICAL DECK SECTION
DECK PLAN SHOWING ADDED BARS
DIAPHRAGM DETAILS
PEARL HARBOR INTERCHANGE
F.A.I. Proj. No. I-HI-1 (73)-15

Scale: As Shown Date: DEC. 7 1973
SHEET NO. 5-72 OF 106 SHEETS

FED. ROAD DIST. NO.	STATE	FED. AID PROJ. NO.	FISCAL YEAR	SHEET NO.	TOTAL SHEETS
HAWAII	HAW.	I-HI-1(78)-15	1974	289	369

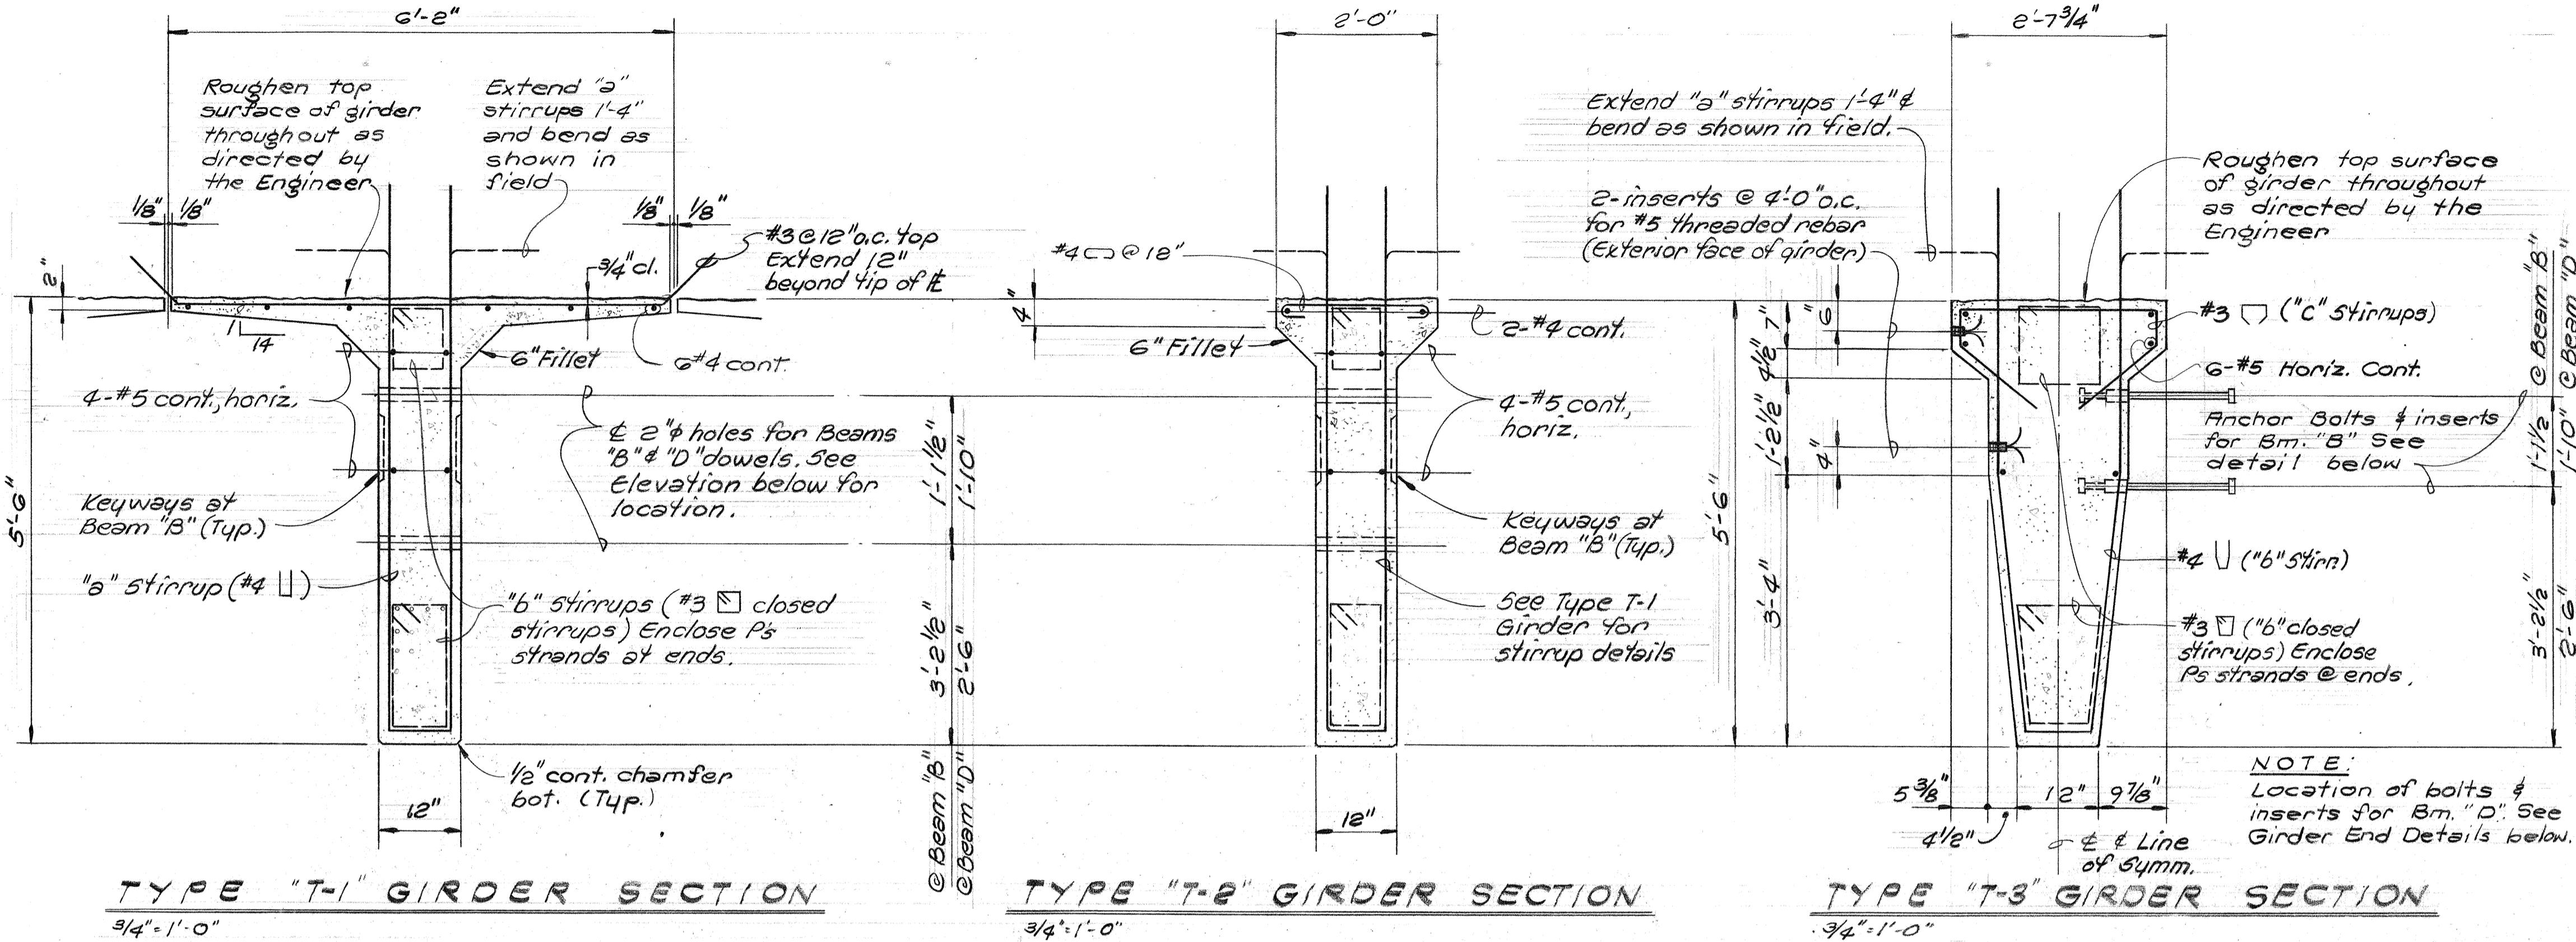


Girder Type	Initial Design Camber	Eccentricity of Prestress Force		Working Prestr. Force			
		e_s	e_m	e_h	P_s	P_h	
"T-1"	$\frac{5}{8}$ " ↑		$5\frac{1}{2}$ "	$10\frac{1}{2}$ "	61"	494 k	188 k
"T-2"	$\frac{5}{8}$ " ↑		$4\frac{1}{4}$ "	8"	63"	353 k	165 k
"T-3"	$\frac{1}{2}$ " ↑		$5\frac{1}{4}$ "	$11\frac{1}{4}$ "	61"	470 k	236

CAMBER NOTES:



- Initial design camber is for the condition immediately after removal of the girder from the casting bed.
- The camber shall be measured from a straight line connecting the ends of the girders.
- Contractor shall submit camber calculations with the shop drawings.

SPECIAL NOTES:


- Concrete compressive strength at 28 days = 6000 psi.
- Concrete strength at stress transfer = 4000 psi.
- Prestressing steel shall be 270 k.s.i. ultimate strength, 7 wire stress relieved strands.
- Unless approved otherwise by the Engineer, forms must be removed and the girder inspected before the strands are cut.
- Clearance for strands
 - Strands may be bundled in groups consisting of 3 vertical & 2 horizontal, separated at ends
 - Minimum "s" between groups or individual strands is 2"
 - "s" is measured between centers of adjacent strands.
- All girders shall be aged at least 7 days from stress transfer before deck slab can be poured.
- Approval of Engineer is required for deviation.
- See Standard details for flanges at diaphragm.

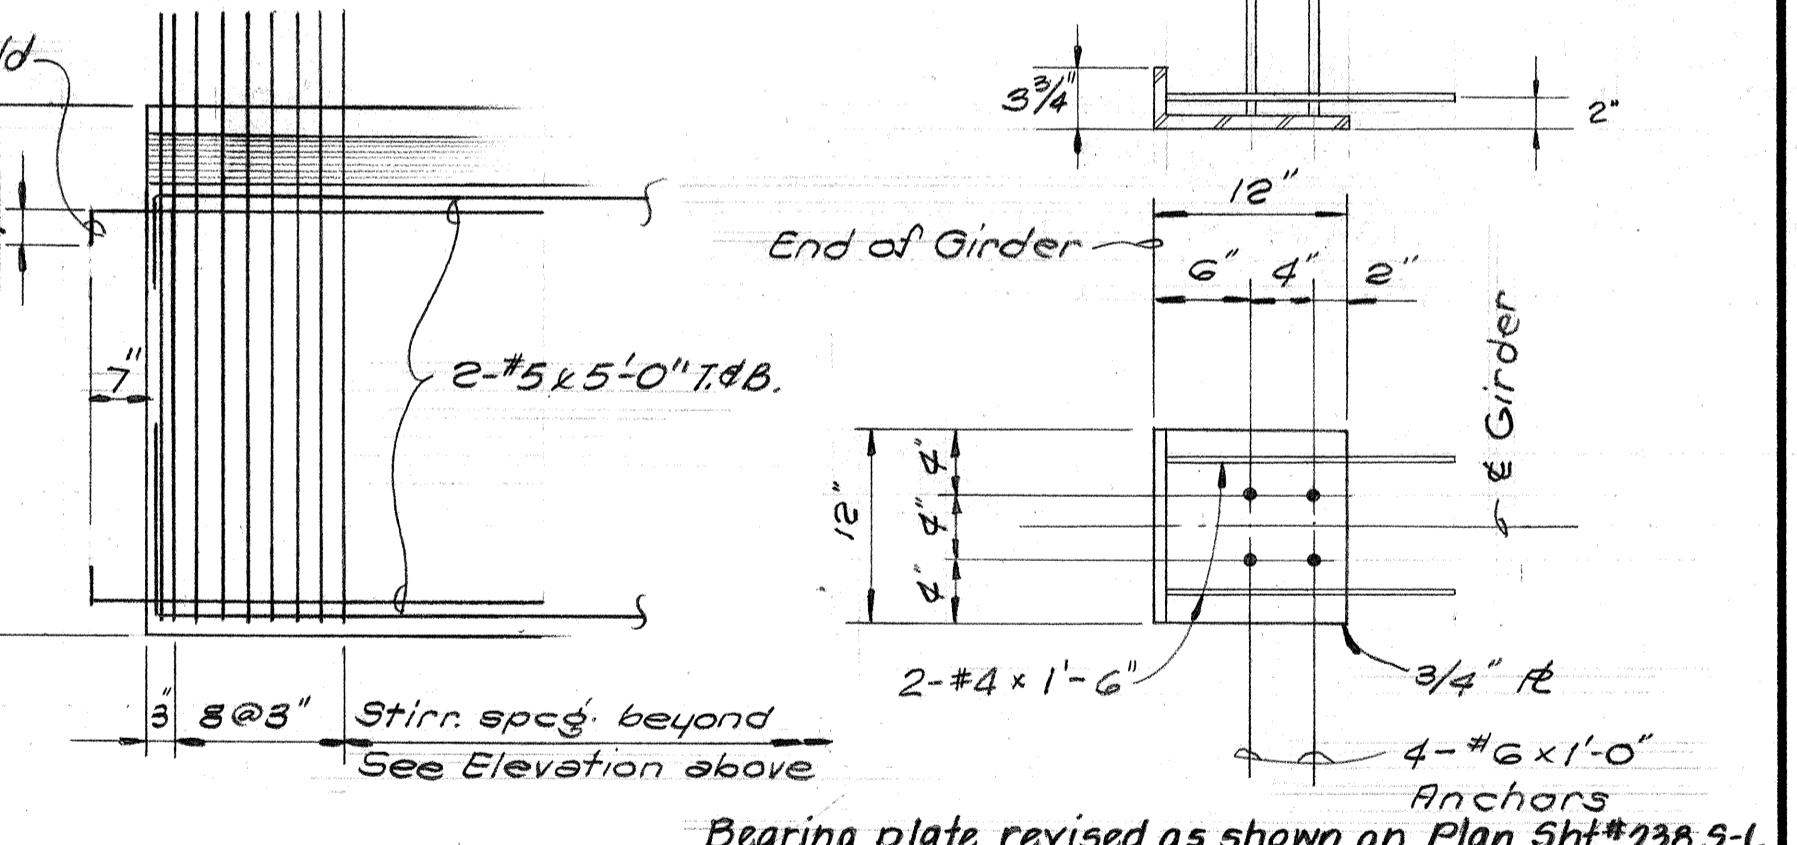

TYPICAL FIXED PIER GIRDERS

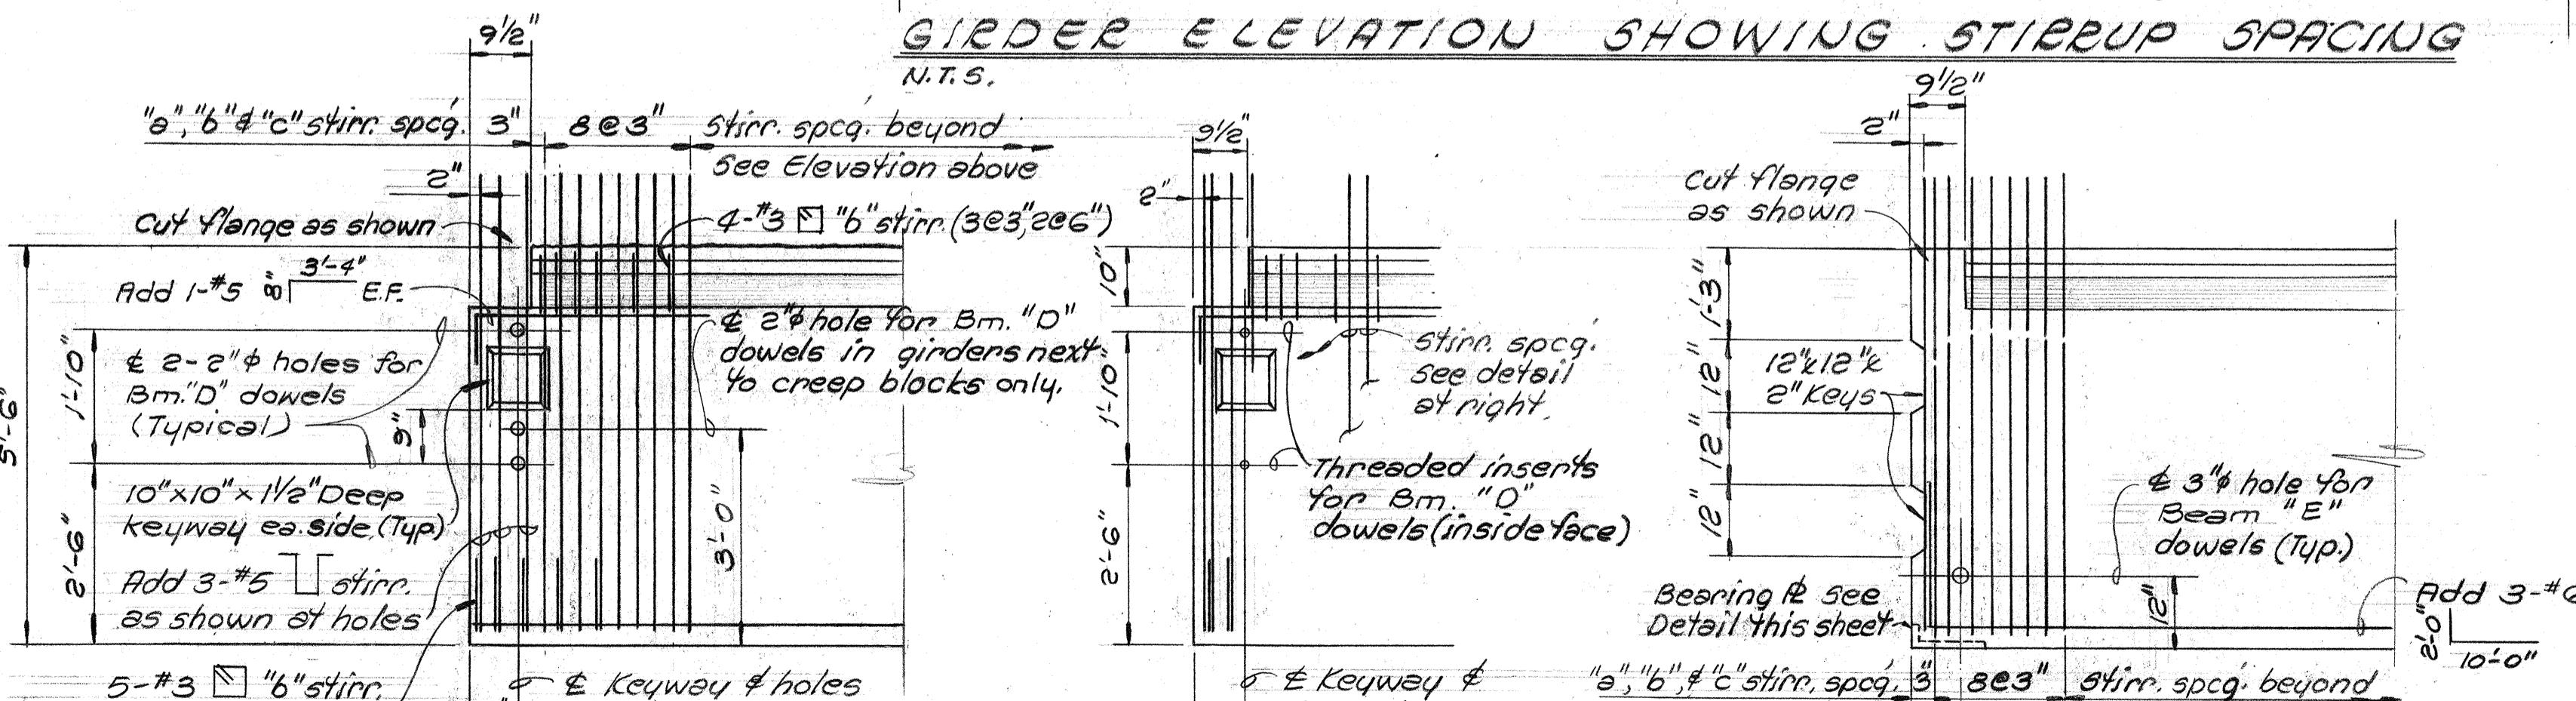
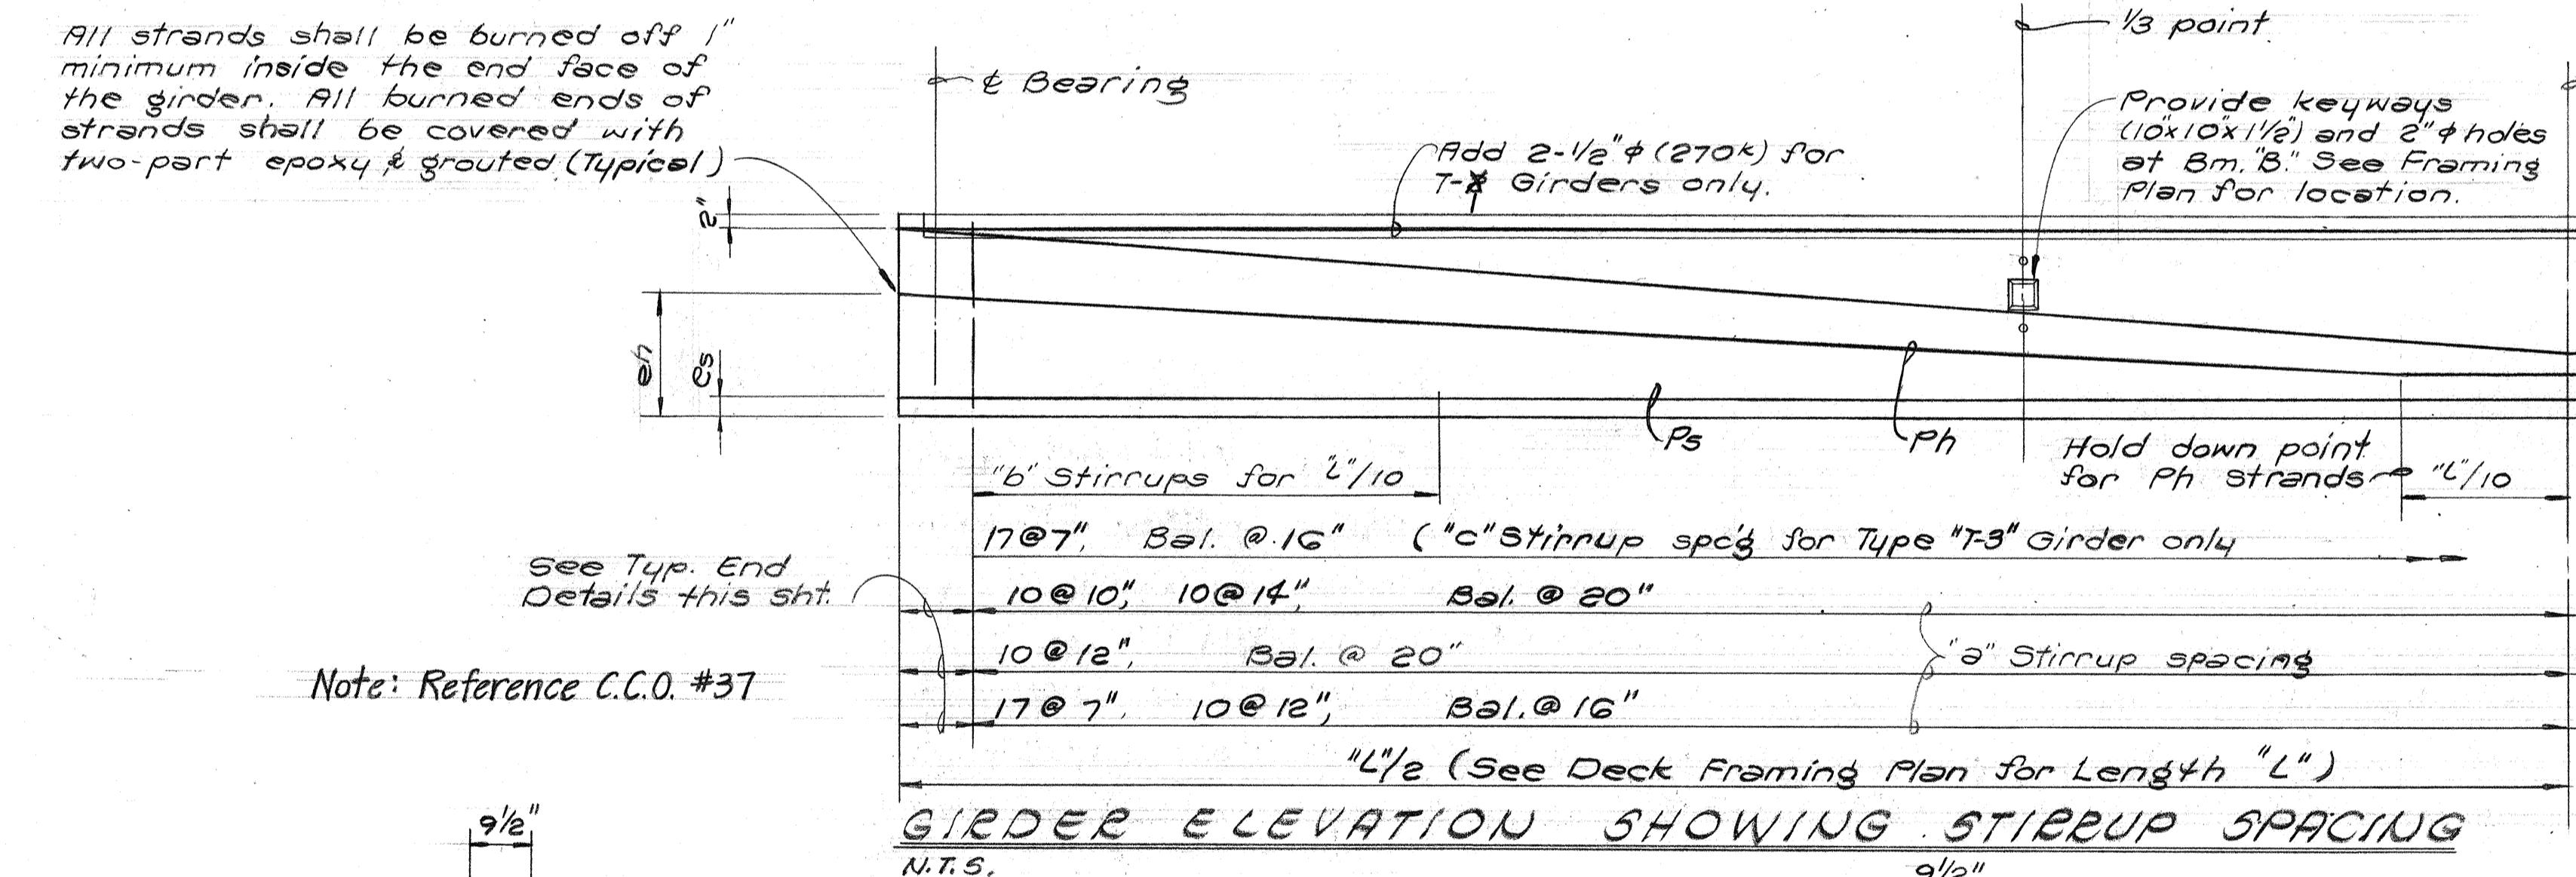


TYPICAL GIRDER END DETAILS @ PIERS (Scale: 1/8"=1'-0")

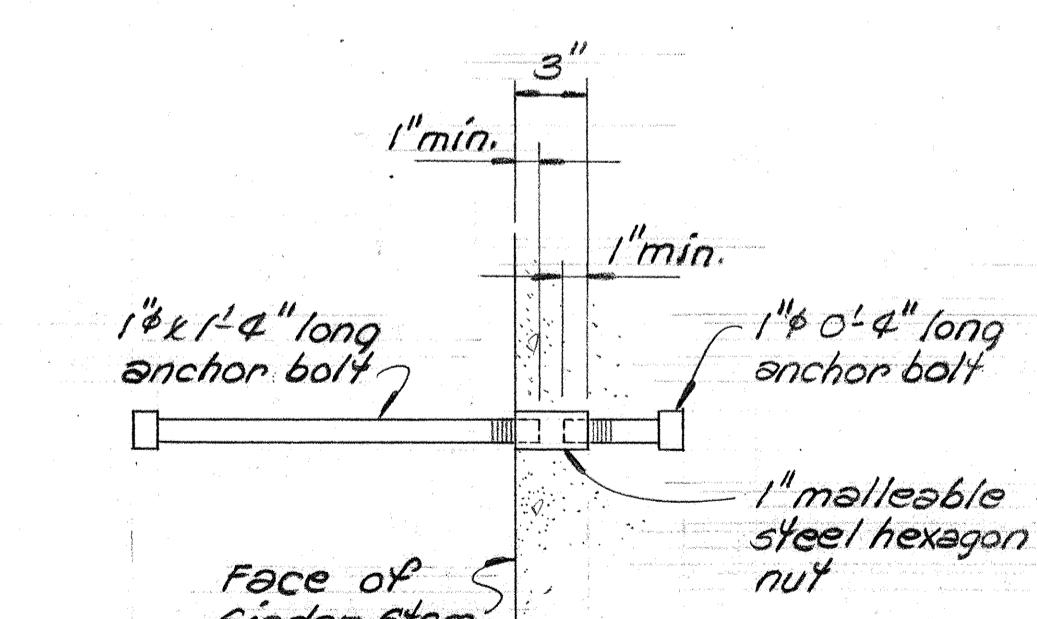

INSERT DETAIL FOR T-3

TYP. GIRDER END DETAIL AT ABUT.

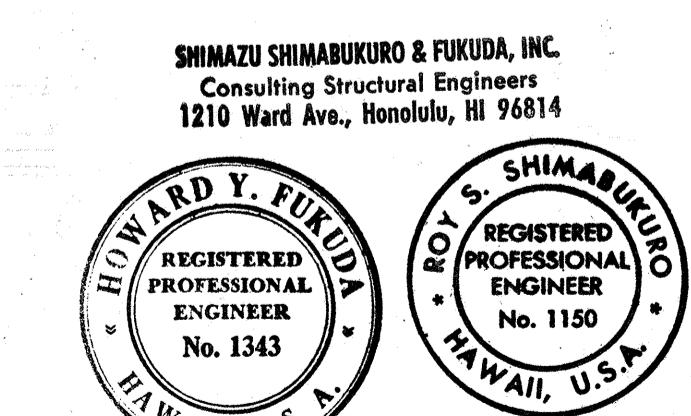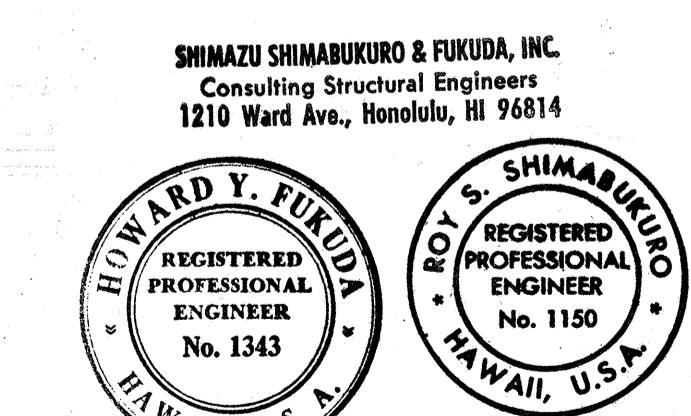

THIS WORK WAS PREPARED BY ME
OR UNDER MY SUPERVISION


STATE OF HAWAII
DEPARTMENT OF TRANSPORTATION
HIGHWAYS DIVISION

STRUCTURE No. 8
PRESTRESSED GIRDER
DETAILS


PEARL HARBOR INTERCHANGE
F.A.I. Proj. No. I-HI-1 (78)-15

Scale: As Shown Date: DEC. 7, 1973
SHEET NO. 6-73 OF 106 SHEETS

D. ROAD LST. NO.	STATE	FED. AID PROJ. NO.	FISCAL YEAR	SHEET NO.	TOTAL SHEETS
HAWAII	HAW.	I-HI-1(73)15	1974	290	369

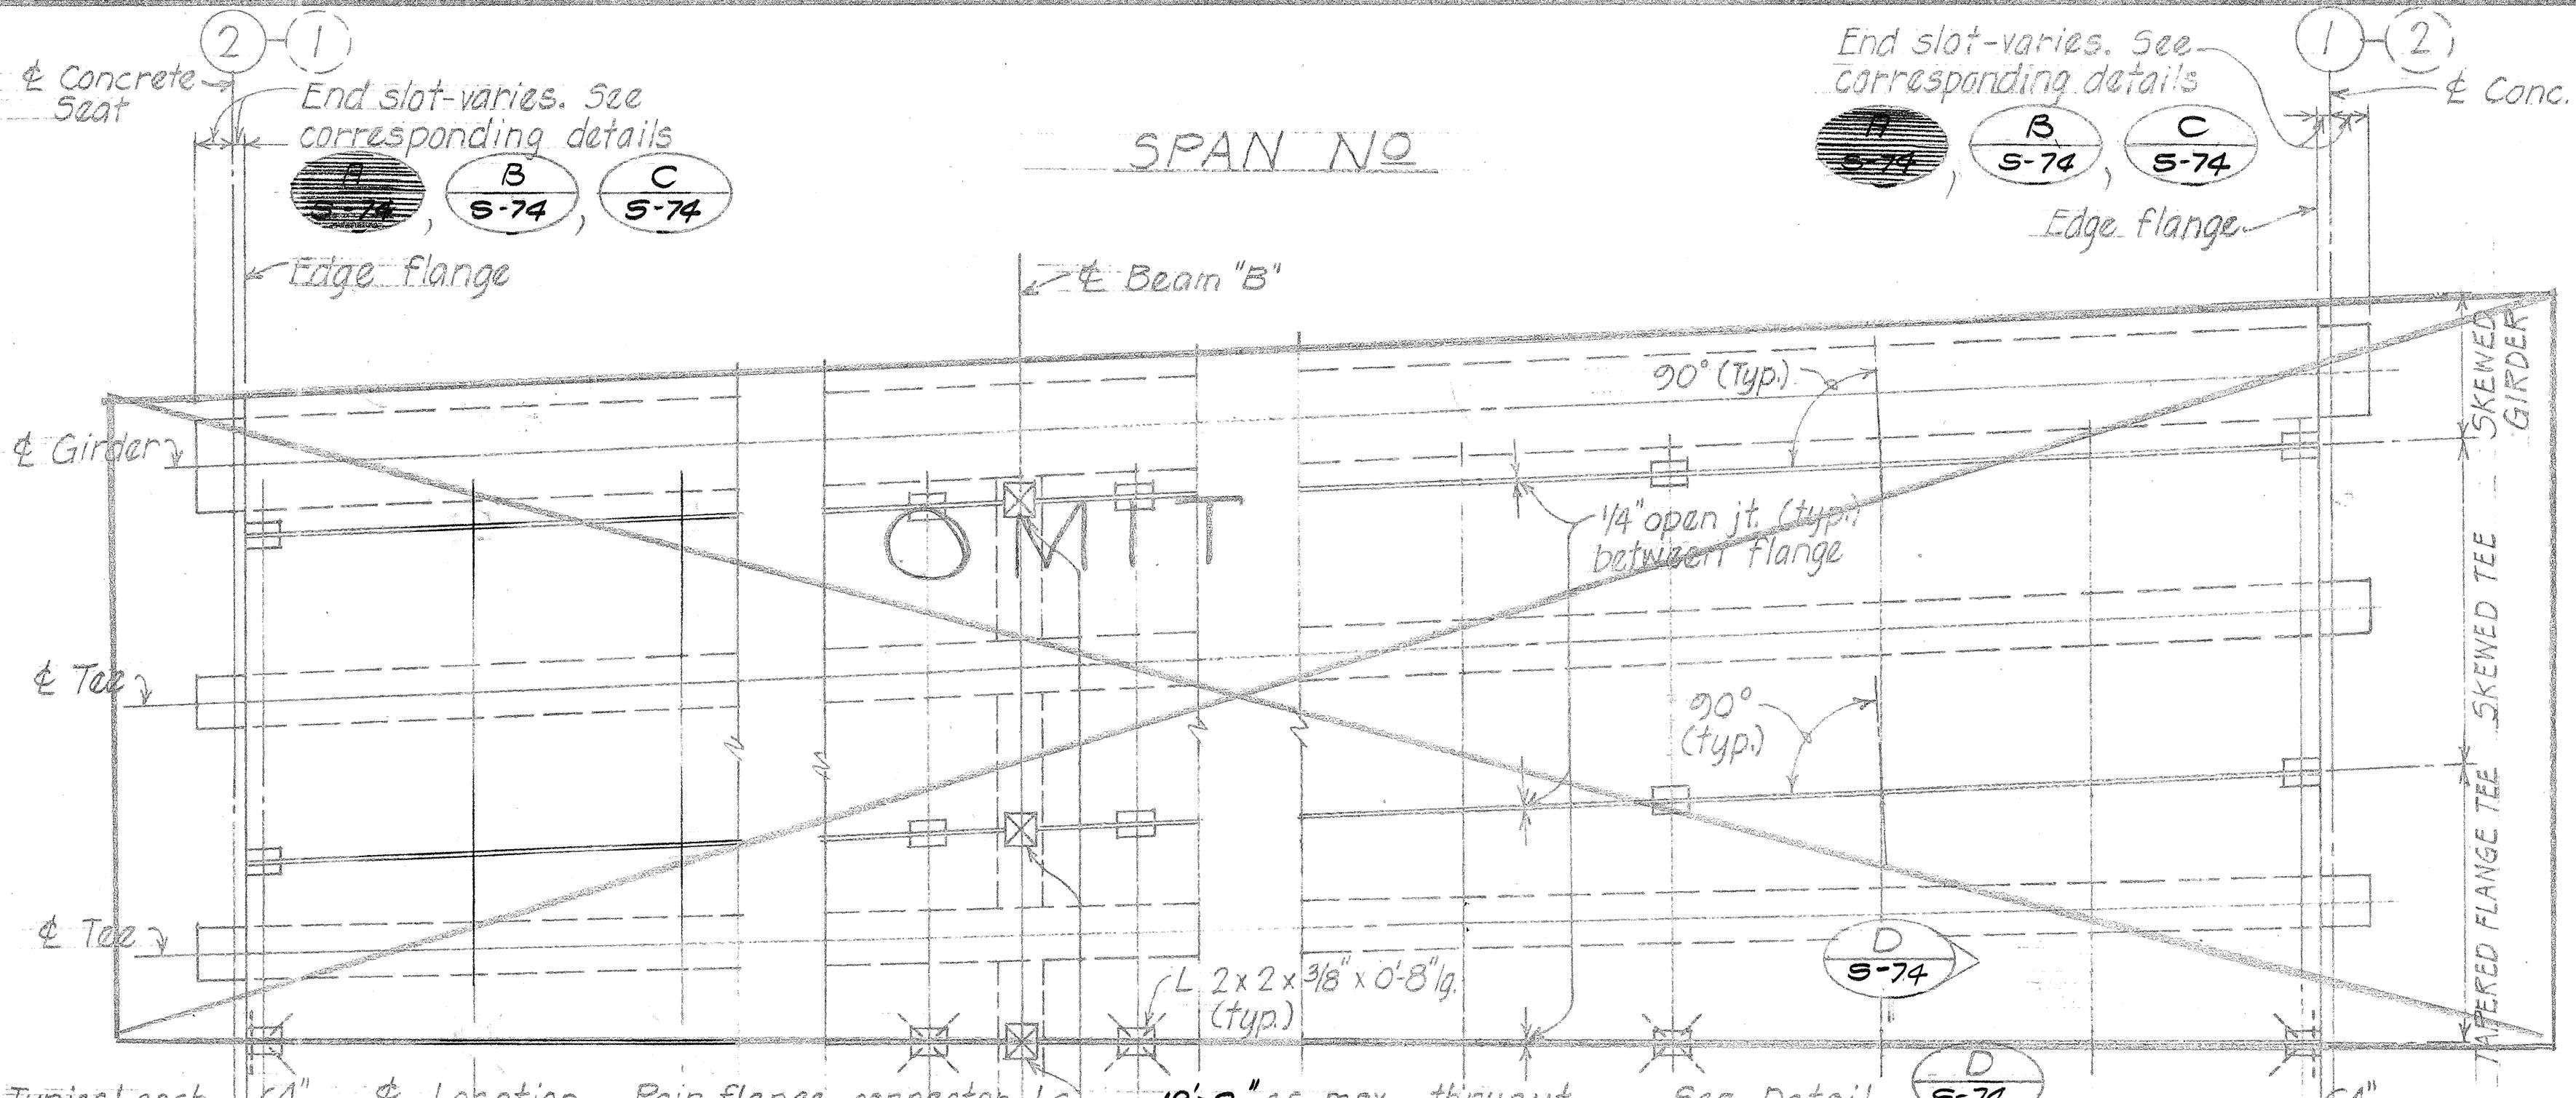

Typical each 14" E Location - Pair flange connector Ls. 12'-0" o.c. max. thruout. See Data
joint

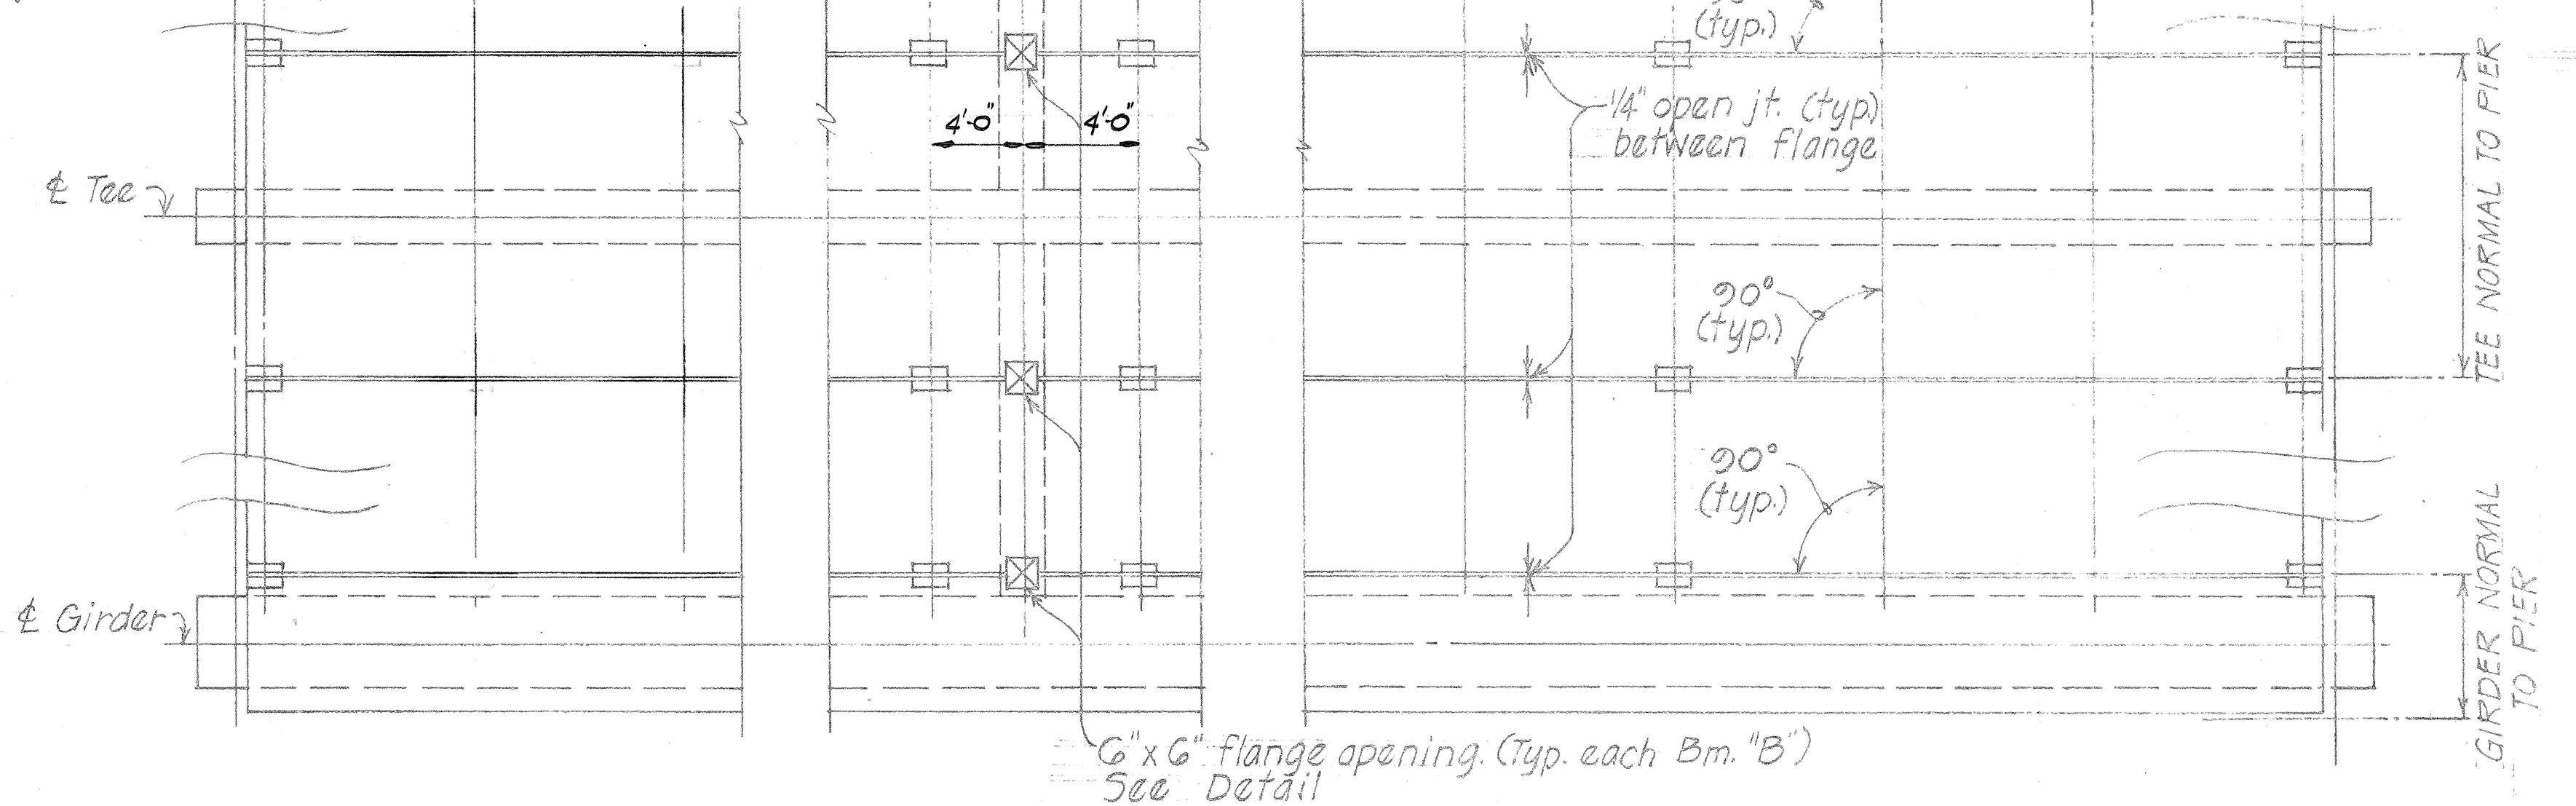


END AT SUPPORT

AT BEAM "B"

END AT SUPPORT

DETAIL FOR VARIOUS LOCATIONS EACH SPAN

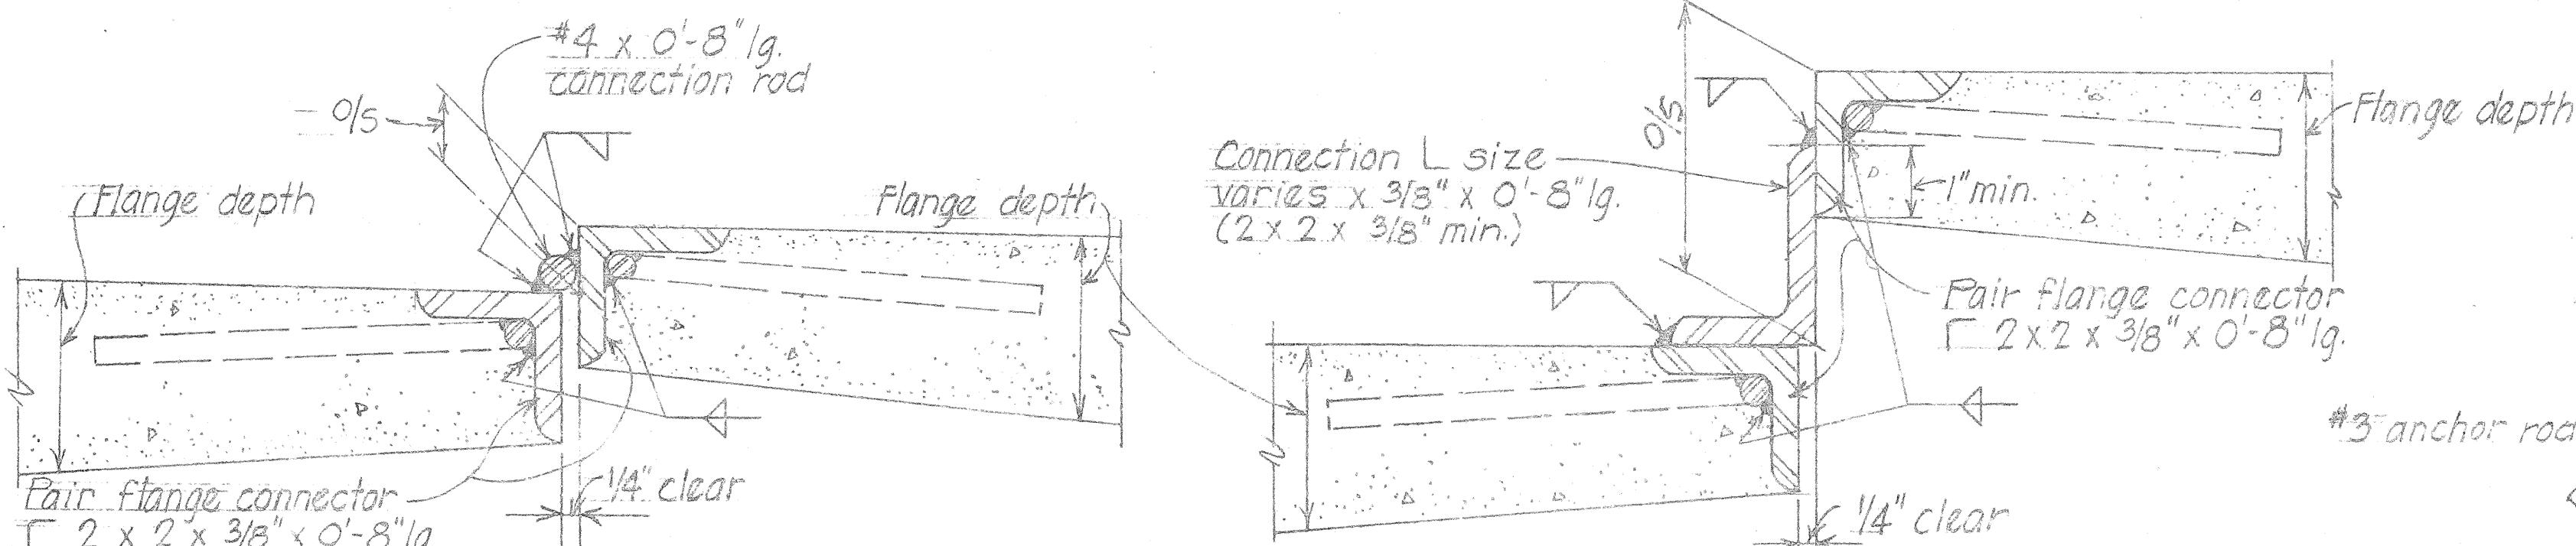


WHERE L 0/S ≥ 2"


TYPICAL DETAIL



74 Scale: 6" = 1'-0"

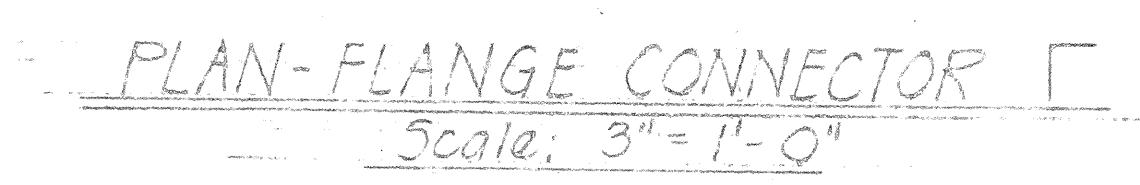

Scale: 3" = 1'-0"

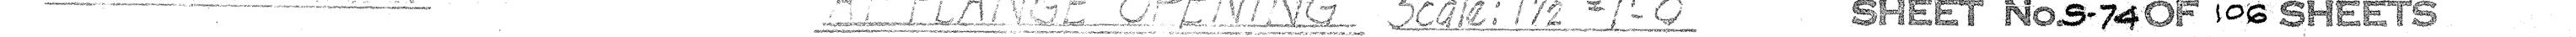

TYPICAL ADDED REINFORCEMENT
AT FLANGE OPENING scale: $1\frac{1}{2}'' = 1'-0''$

Scale : As Shown Date : DEC. 7, 1973
SHEET NO. 5-74 OF 106 SHEETS

**STATE OF HAWAII
DEPARTMENT OF TRANSPORTATION
HIGHWAYS DIVISION**

STRUCTURE No. 8

PRESTRESSED TEE DETAILS


PEARL HARBOR IN EXCHANGE
F.A.I. Proj. No. 1-HI-1(73):15

Style: As Shown Date: DEC. 7, 1971
SHEET No 63 OF 106 SHEETS

390 R



FED. ROAD DIST. NO.	STATE	FED. AID PROJ. NO.	FISCAL YEAR	SHEET NO.	TOTAL SHEETS
HAWAII	HAW.	I-HI-(78):15	1974	291	369

AT DECK EXPANSION JOINTS

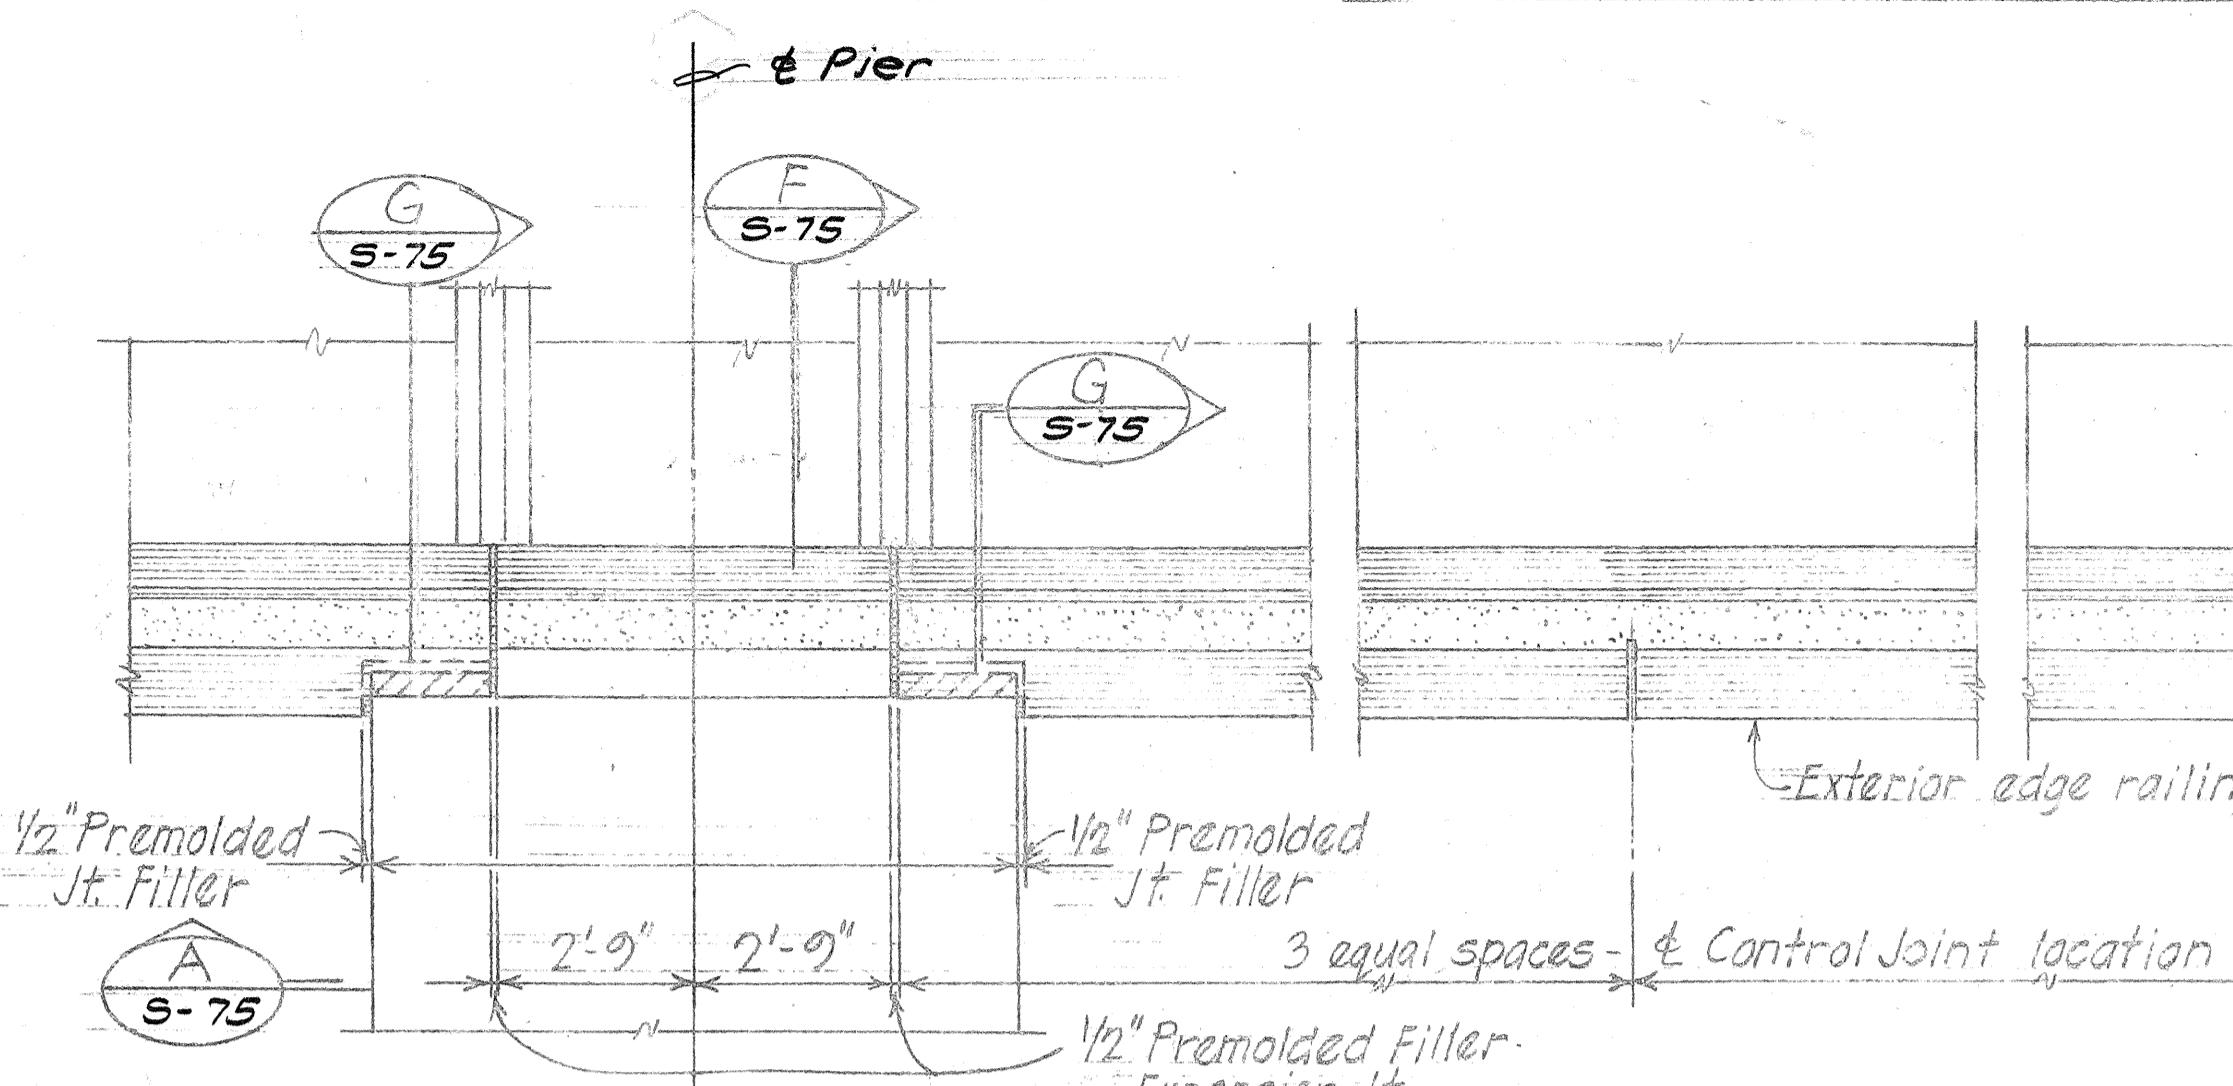


INTERMEDIATE CONTROL JOINT

CONTINUOUS DECK OVER PIER

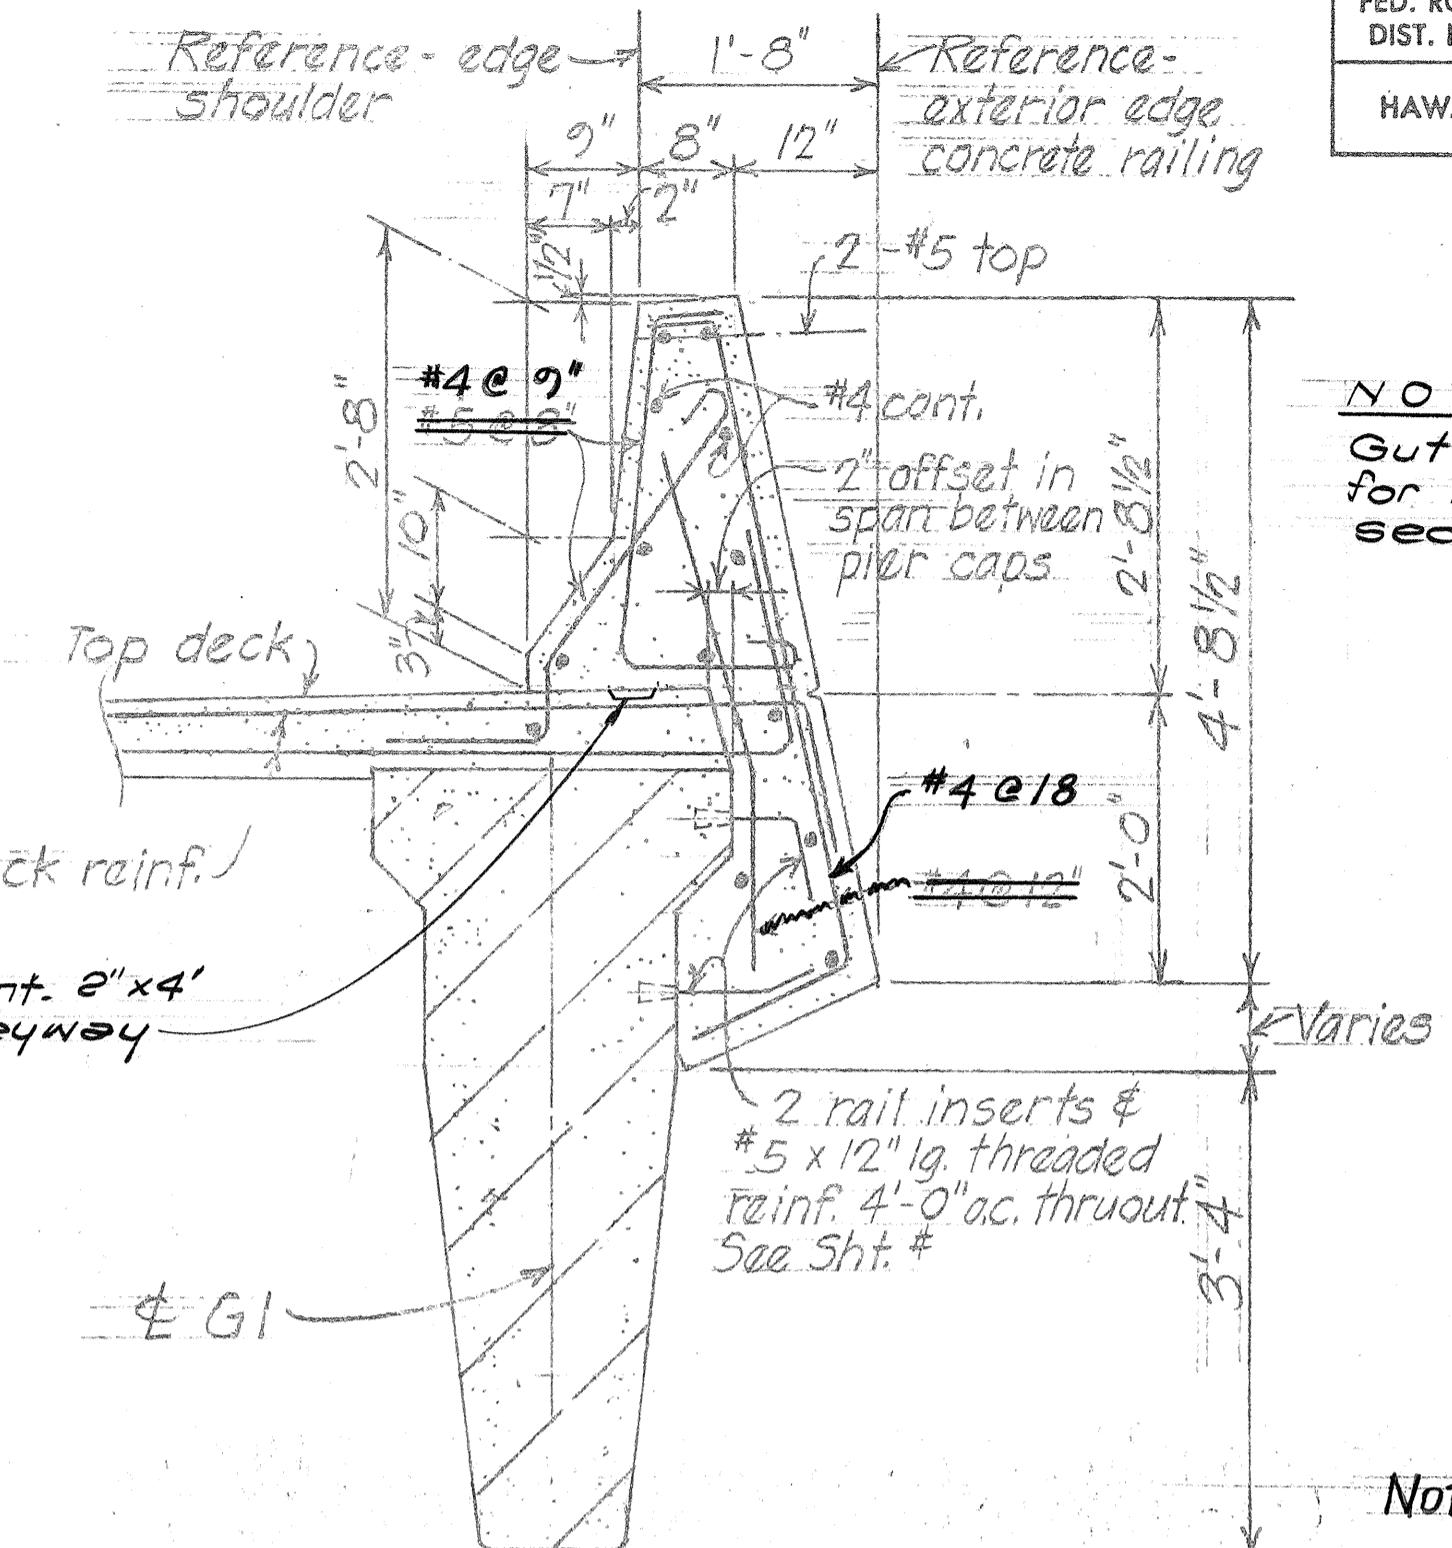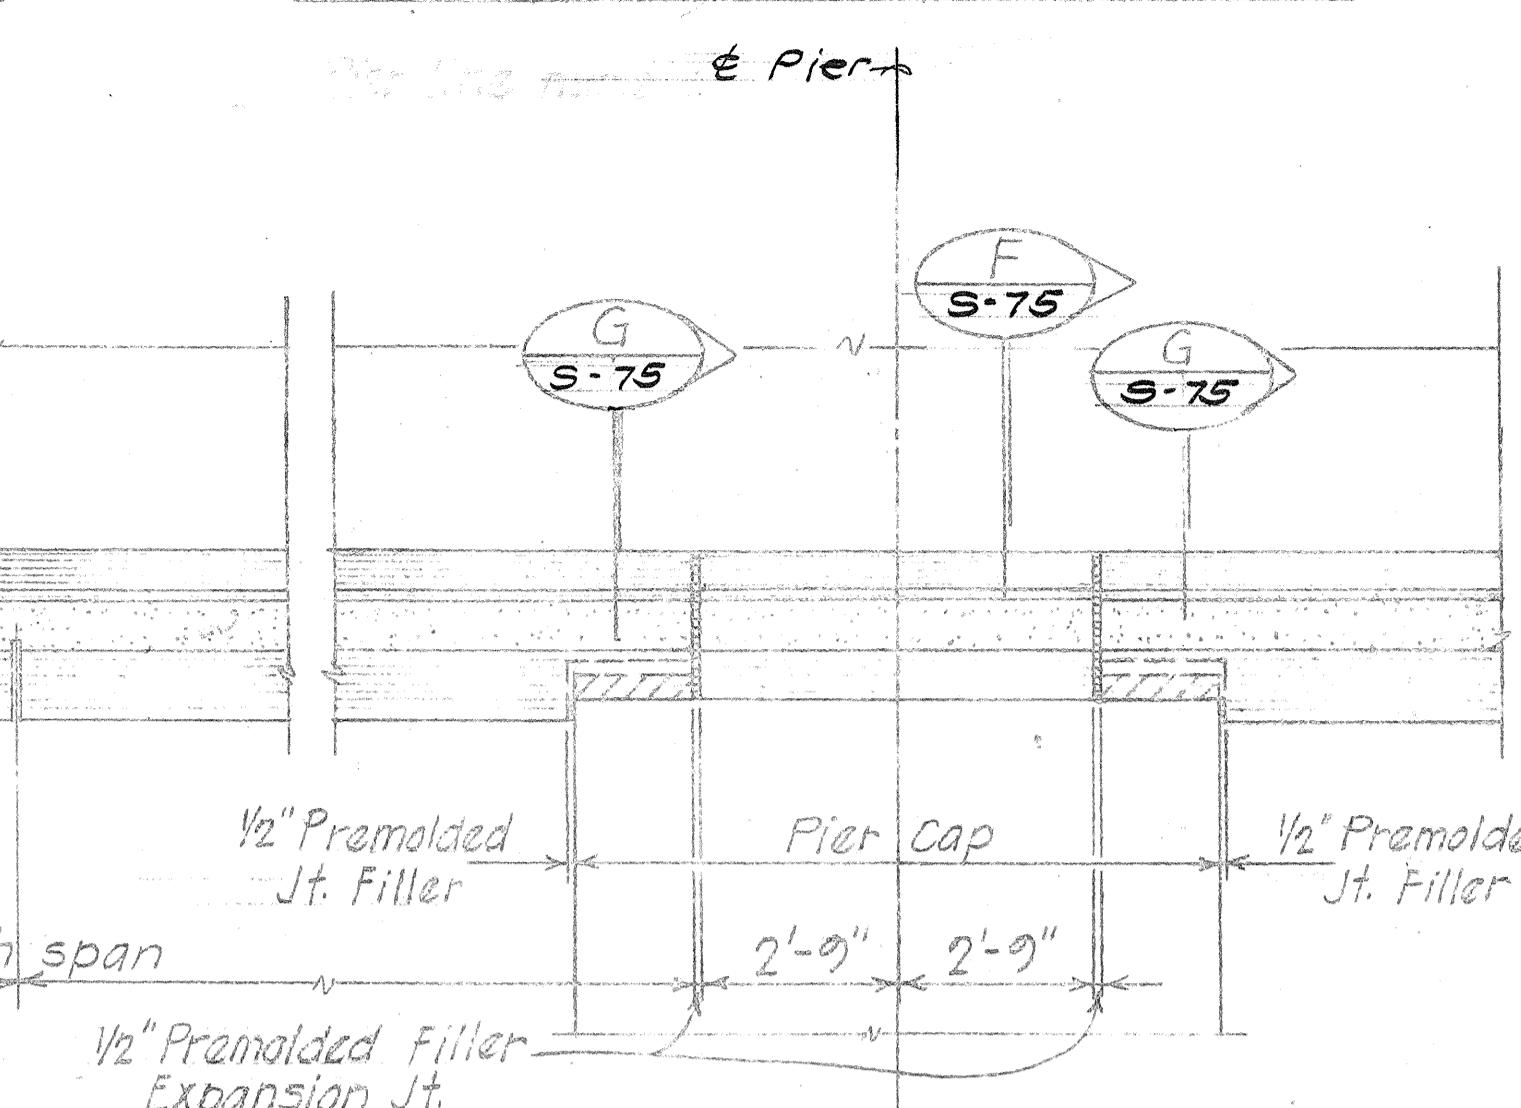


NOTE:
Gutter at left railing
for H-1 Inbound. See
section B/S-76

PART PLAN - LEFT RAILING

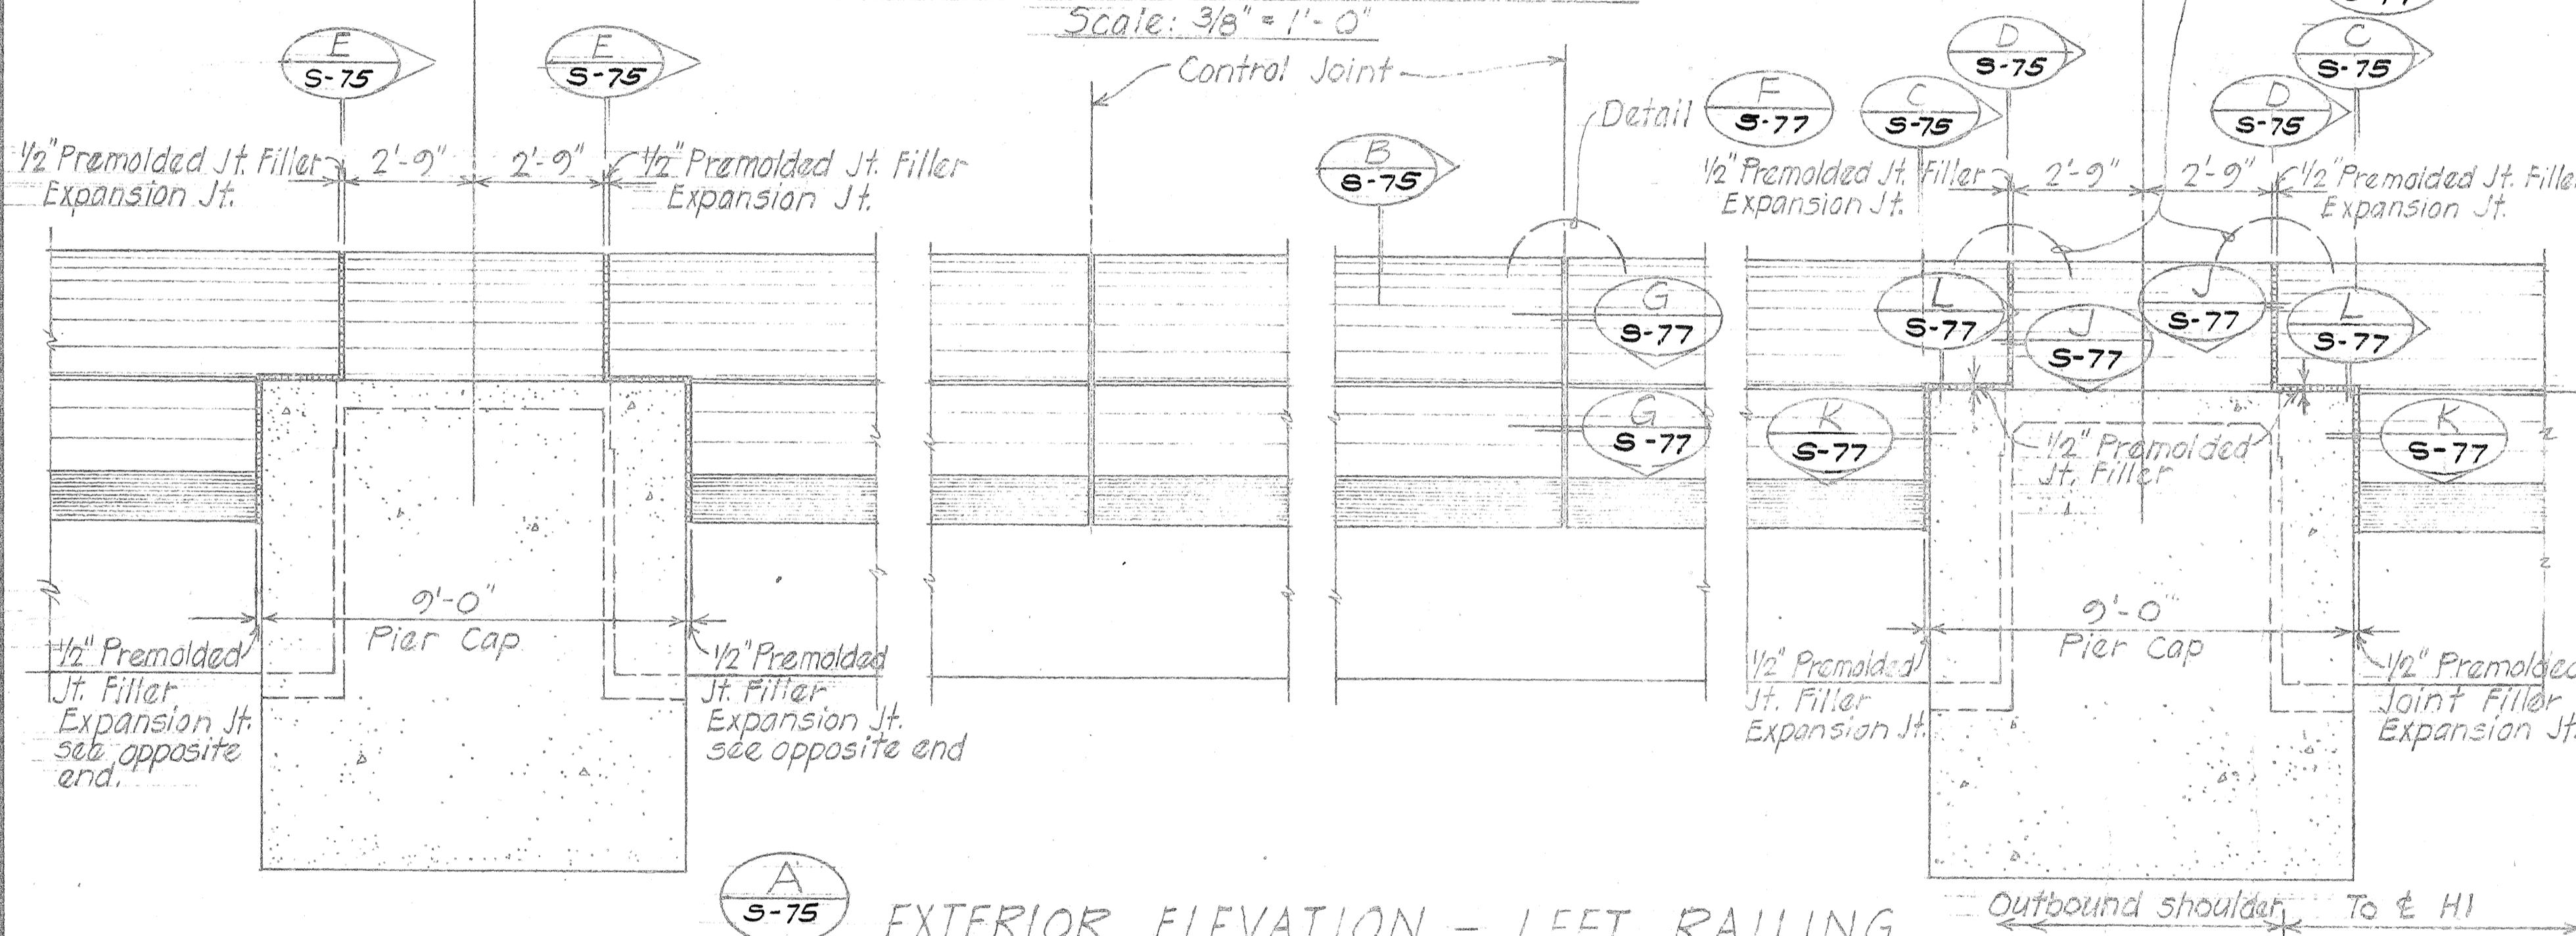

EXTERIOR ELEVATION - LEFT RAILING

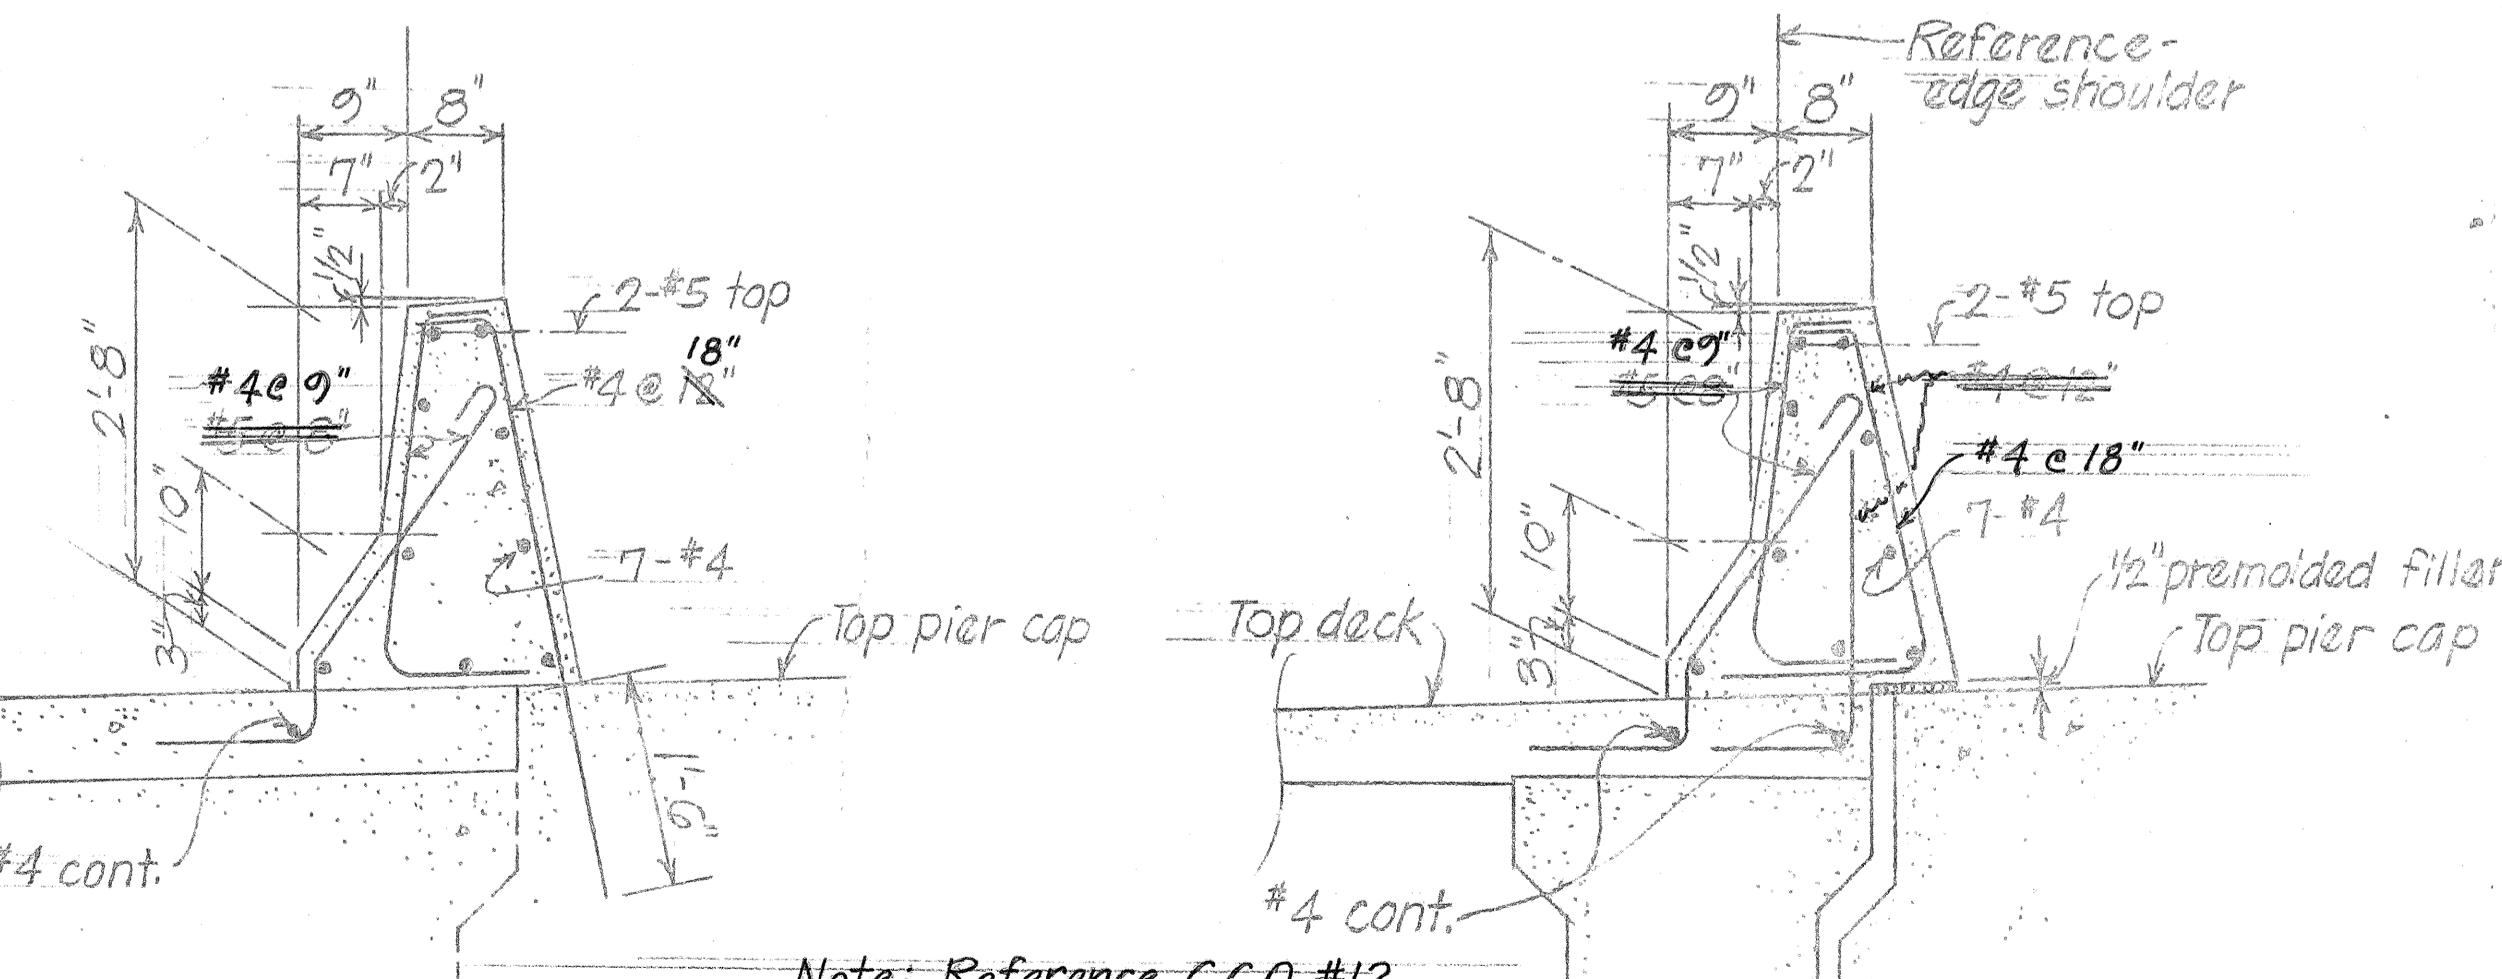

TYPICAL SECTION F S-75

Scale: 3/4" = 1'-0"

TYPICAL SECTION G S-75

Scale: 3/4" = 1'-0"

TYPICAL SECTION E S-75


Scale: 1/2" = 1'-0"

TYPICAL SECTION B S-75

Scale: 3/4" = 1'-0"



outbound shoulder To E HI

outbound shoulder To E HI

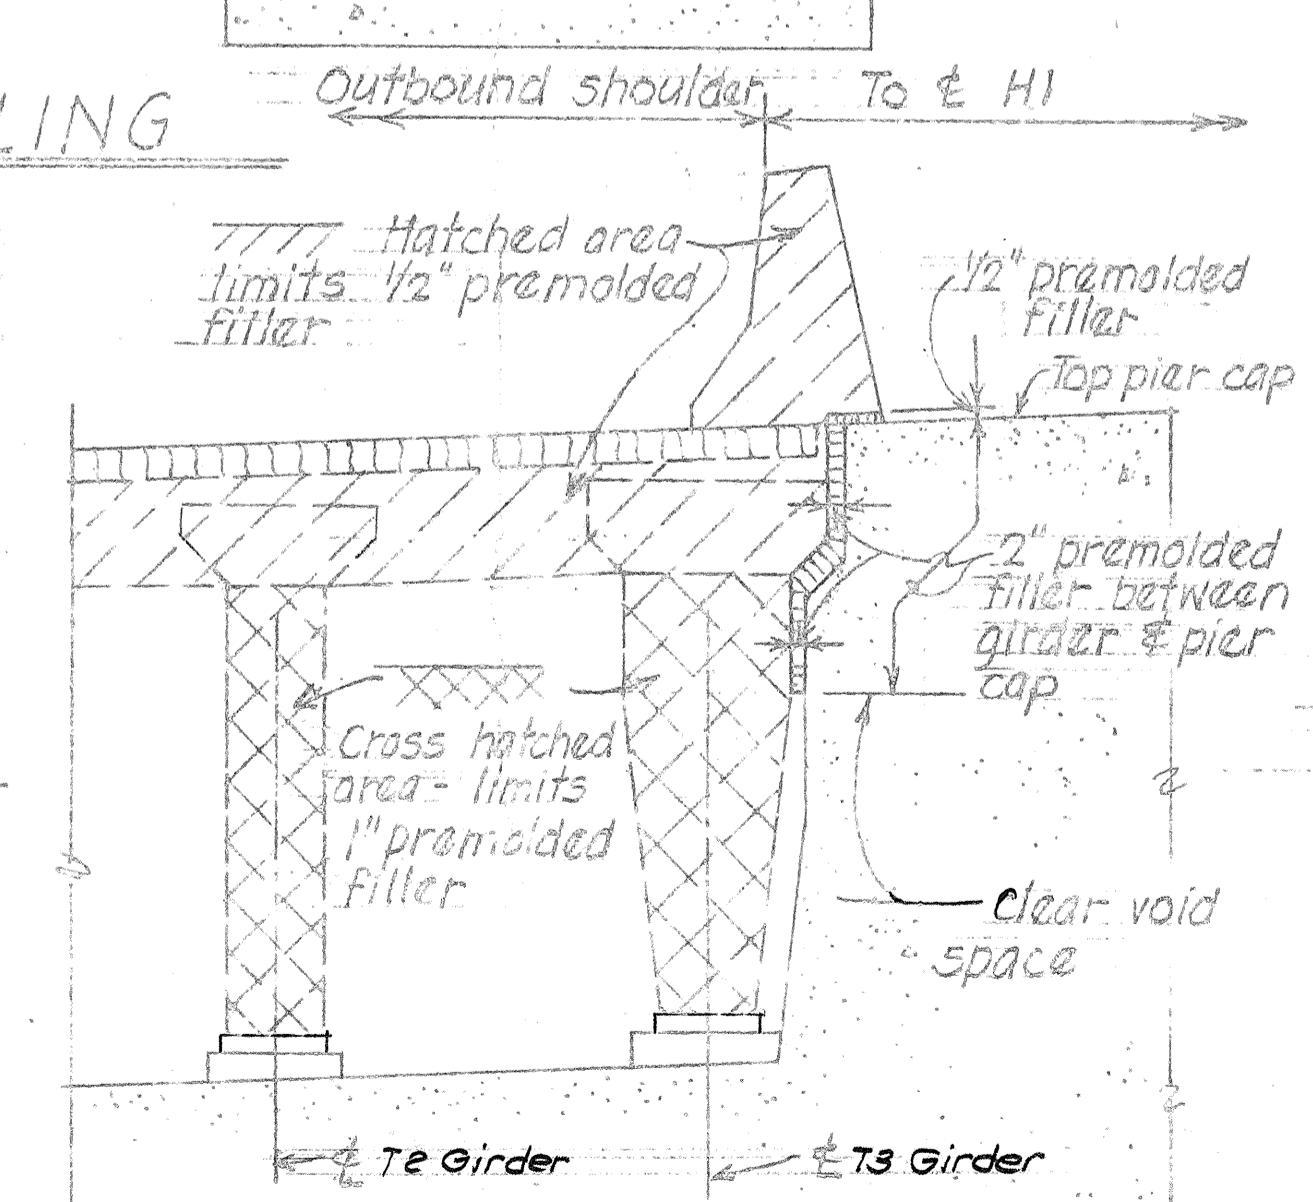

TYPICAL SECTION C S-75

Scale: 1/2" = 1'-0"

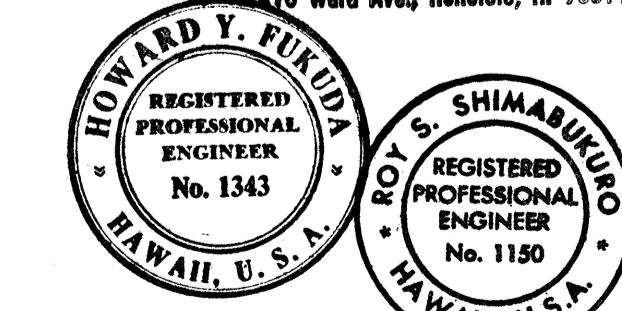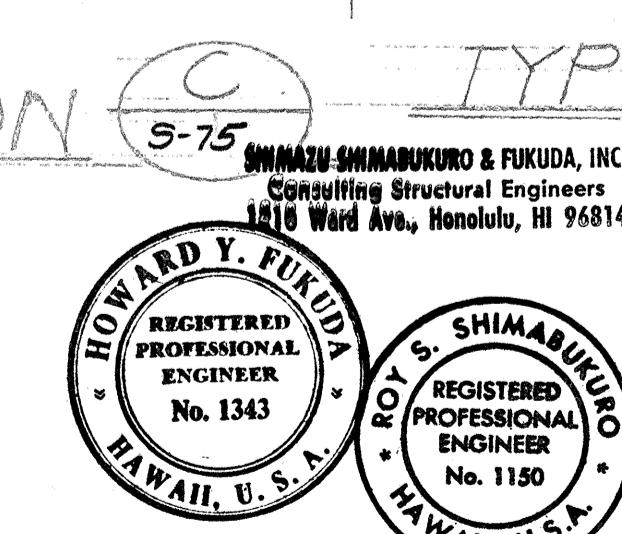

STATE OF HAWAII
DEPARTMENT OF TRANSPORTATION
HIGHWAYS DIVISION



STRUCTURE No. 8

CONCRETE RAIL DETAIL

PEARL HARBOR INTERCHANGE
F.A.I. Proj. No. I-HI-1 (78):15


Scale: As Shown Date DEC. 7, 1973
SHEET No. S-75 OF 106 SHEETS

ED. ROAD DIST. NO.	STATE	FED. AID PROJ. NO.	FISCAL YEAR	SHEET NO.	TOTAL SHEETS
HAWAII	HAW.	I-HI-1(73):15	1974	293	369

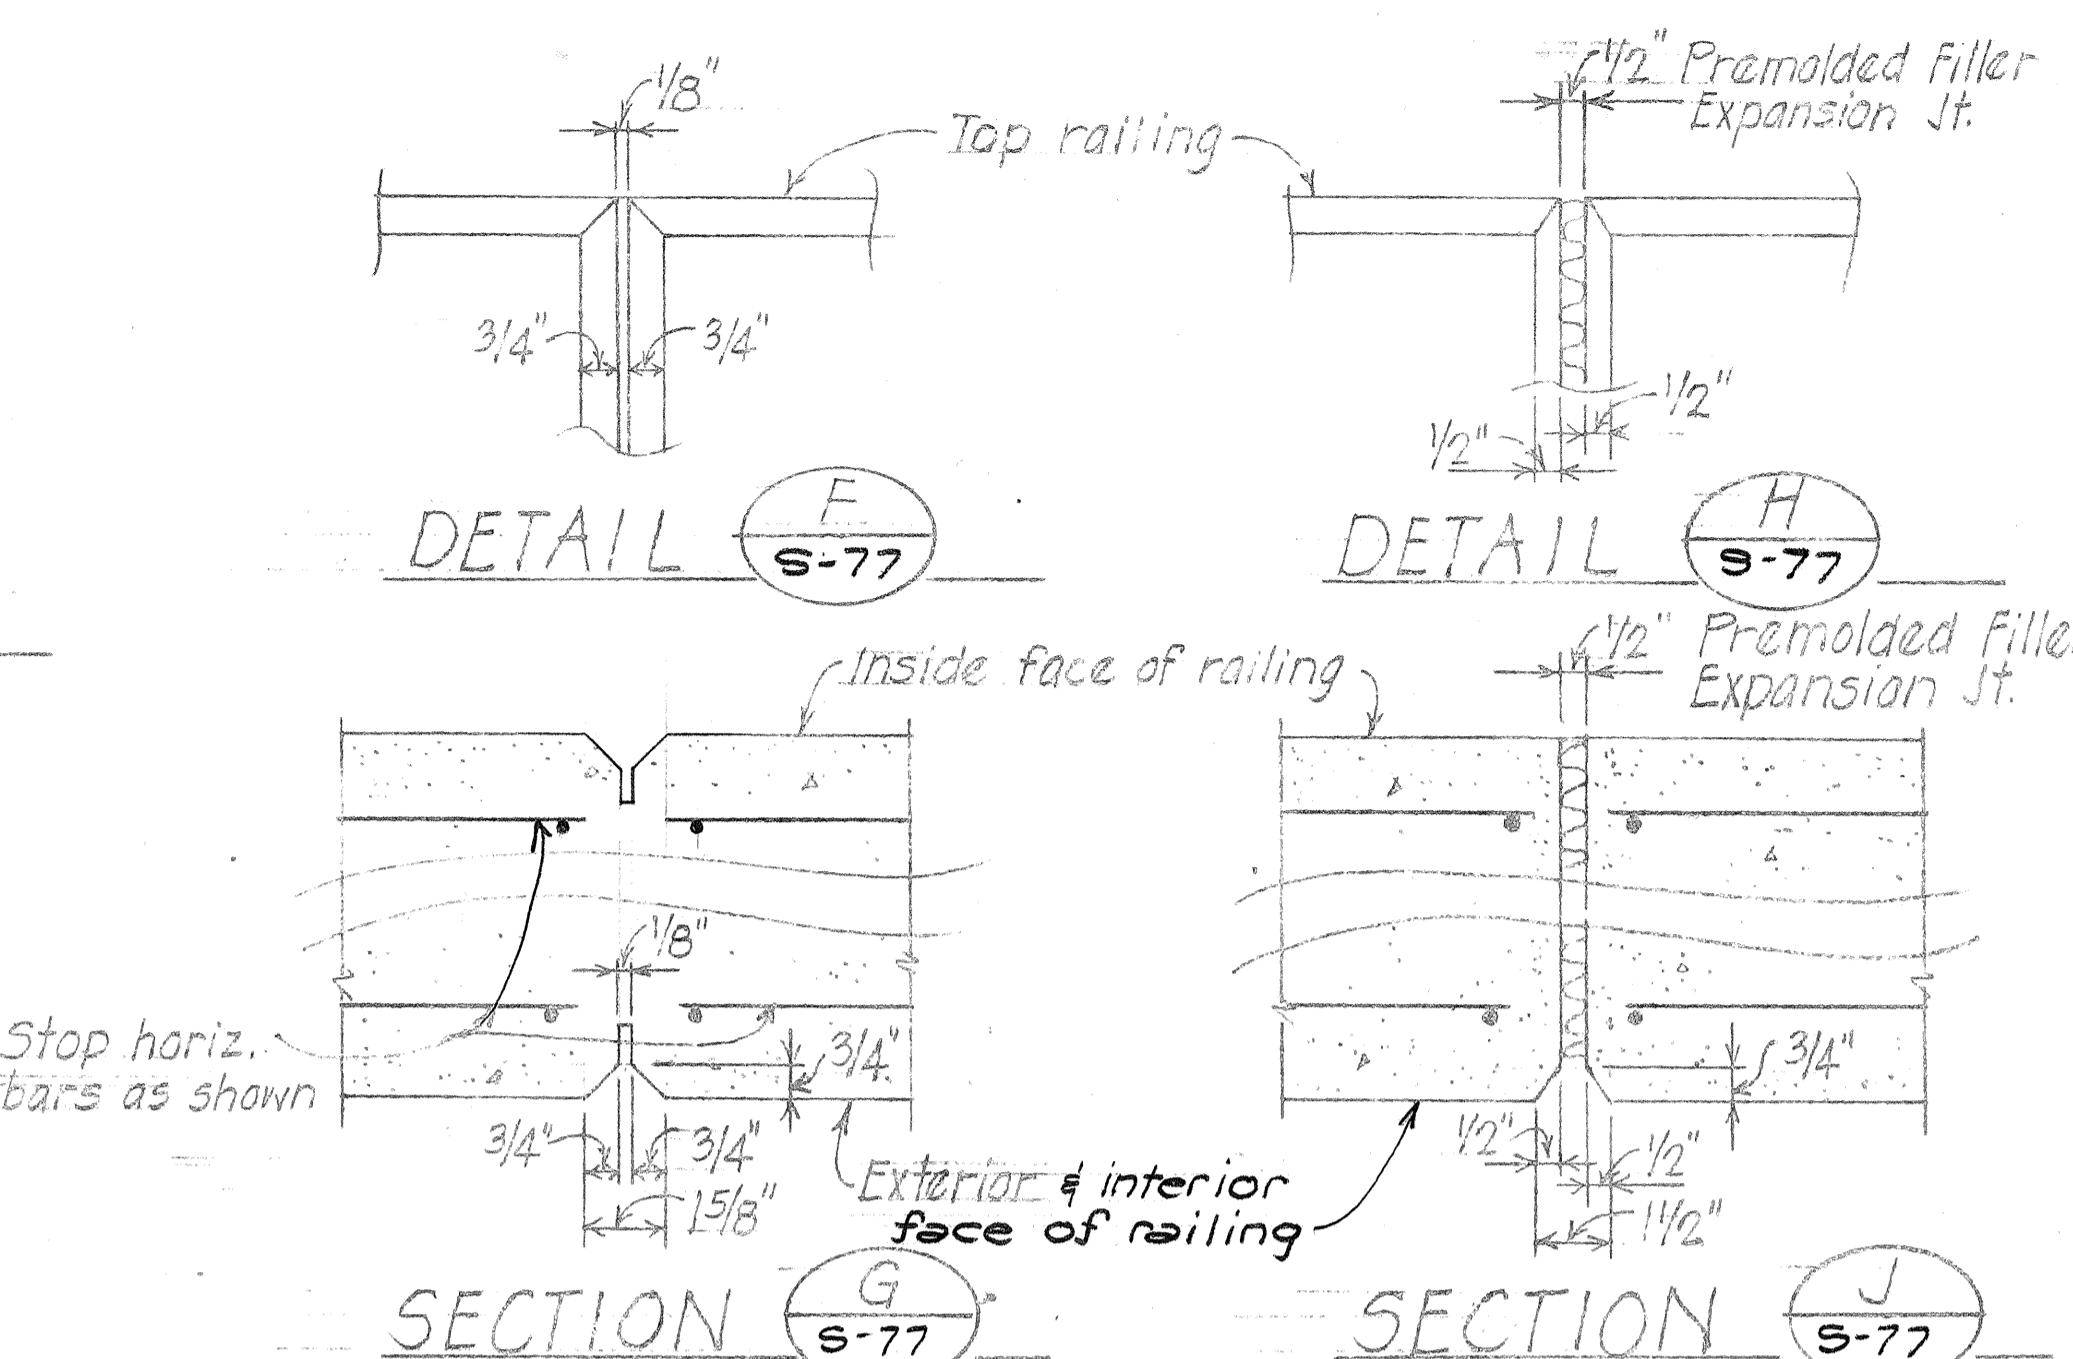
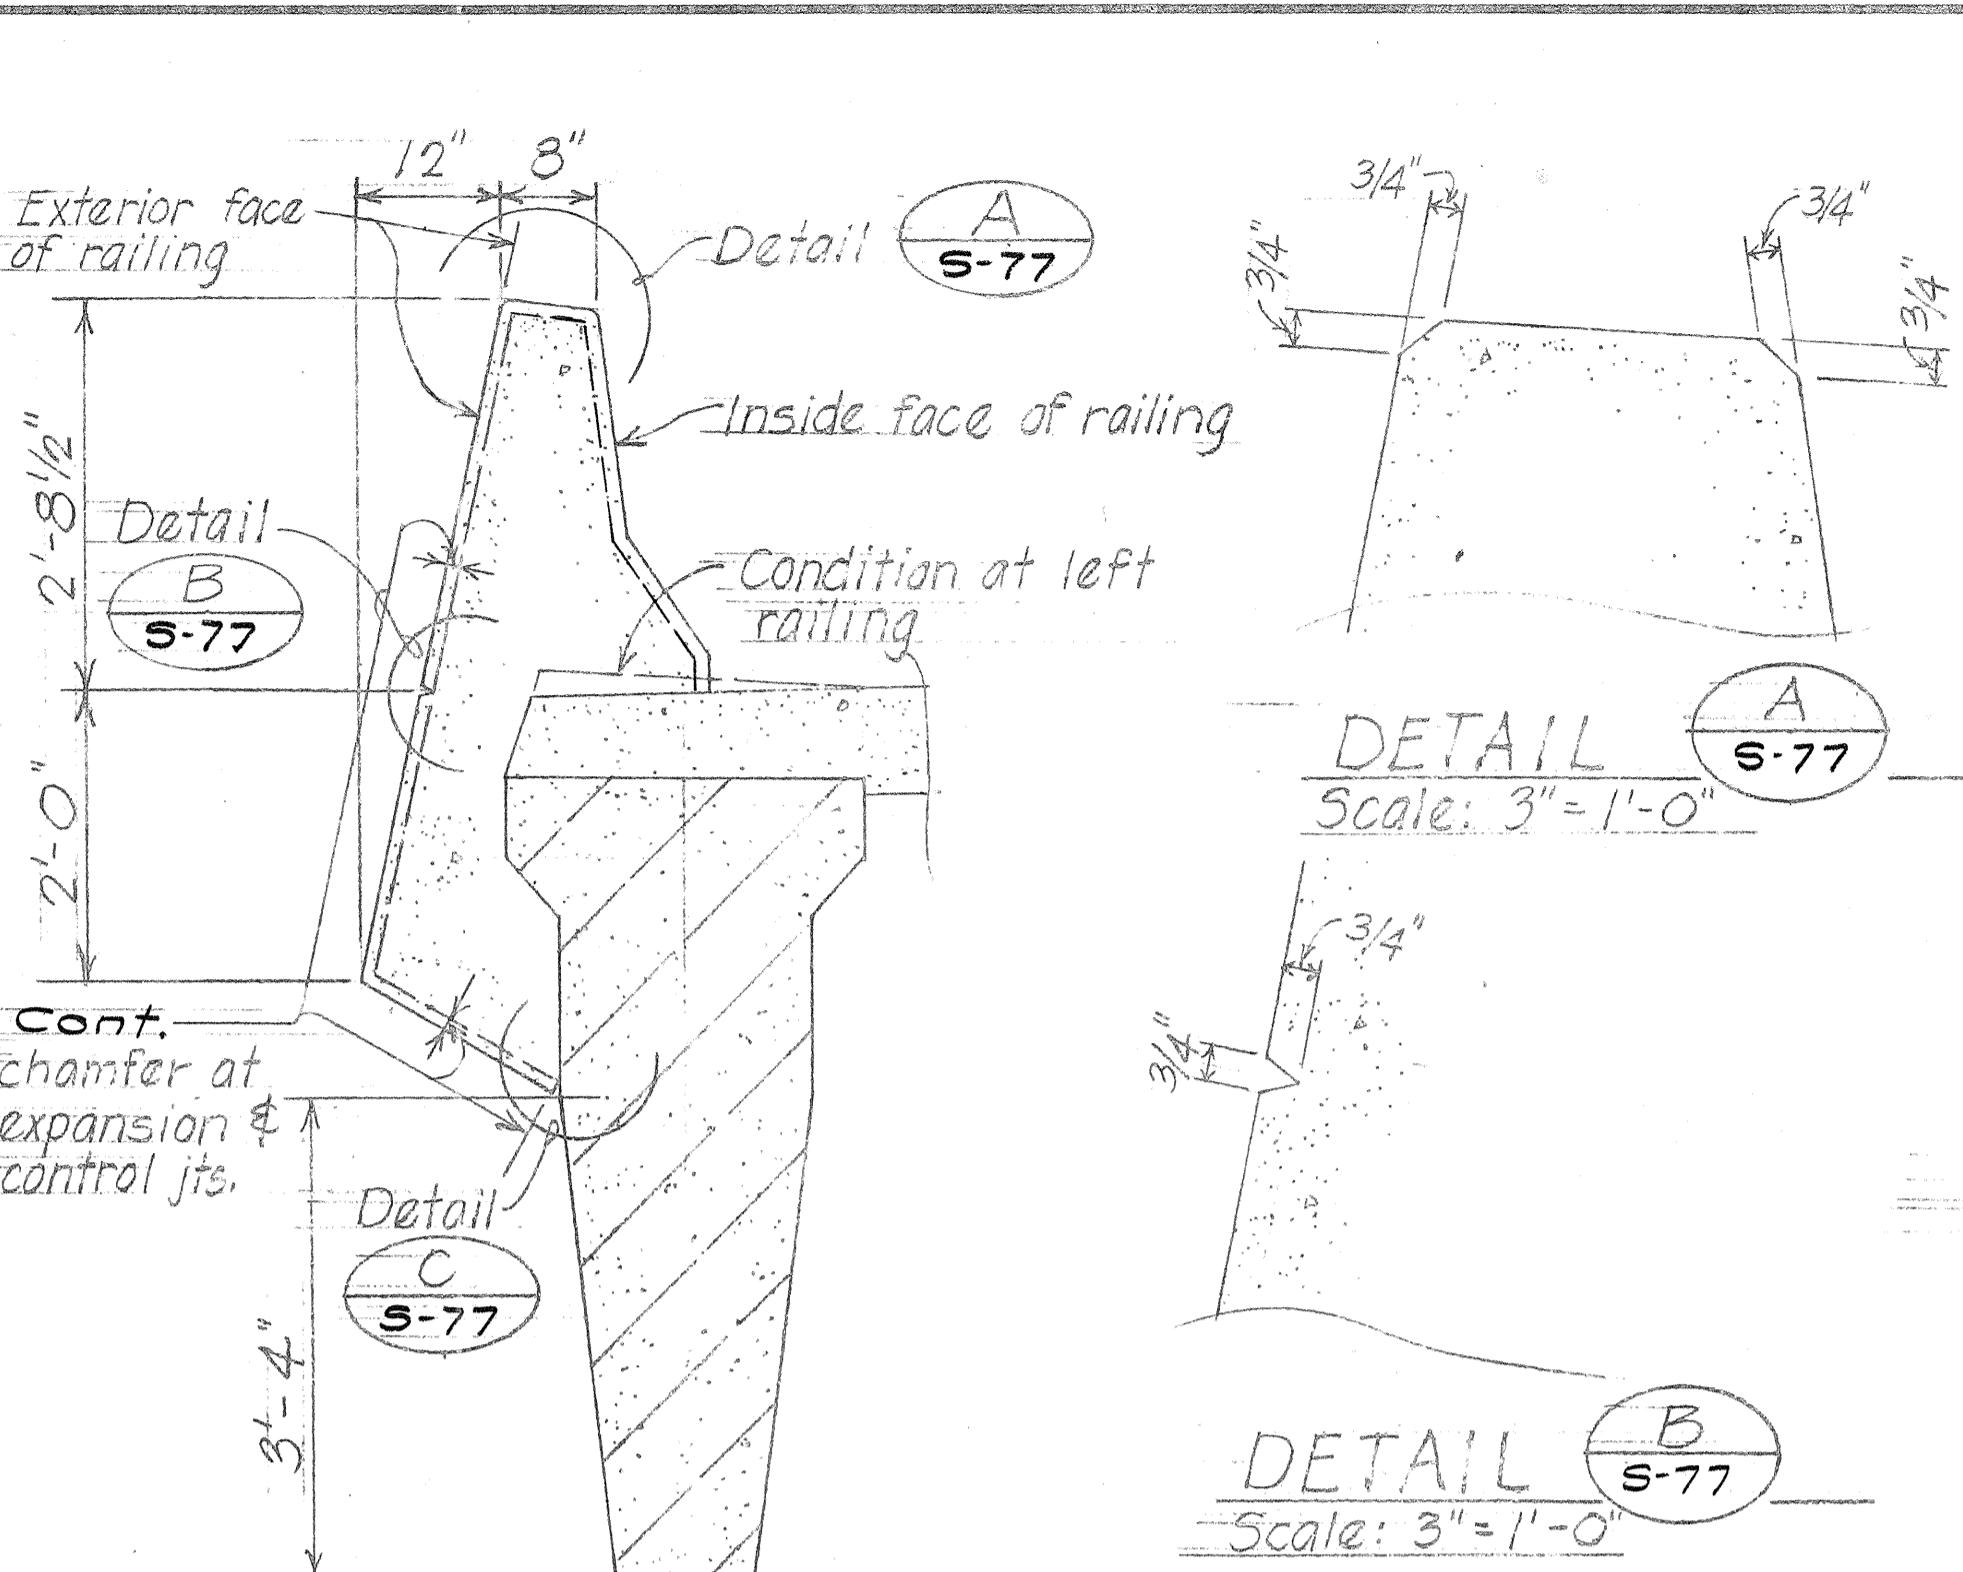


TYPICAL RAILING SECTION


Scale: 3/4" = 1'

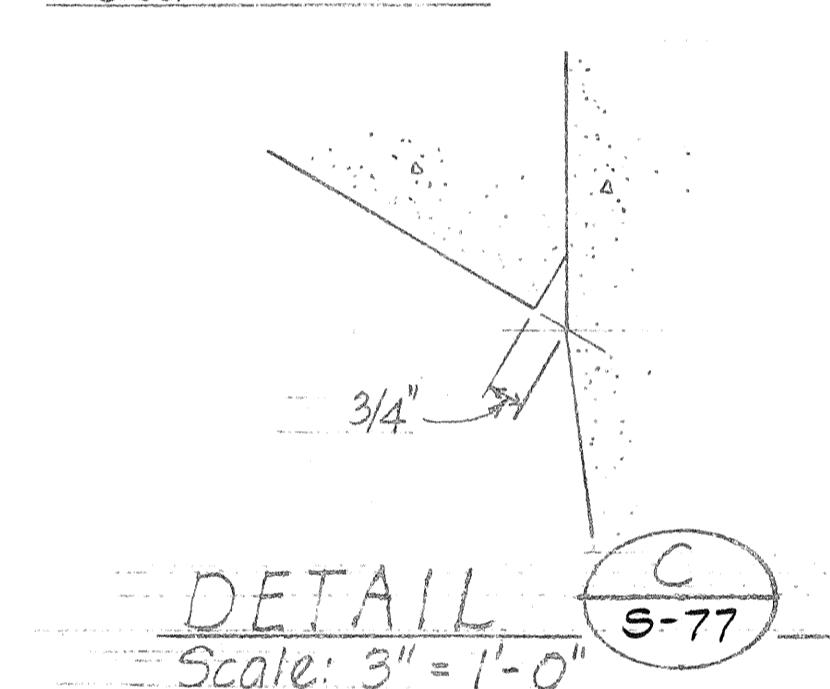

TYPICAL CONCRETE RAILING FASCIA DETAILS & FINISH

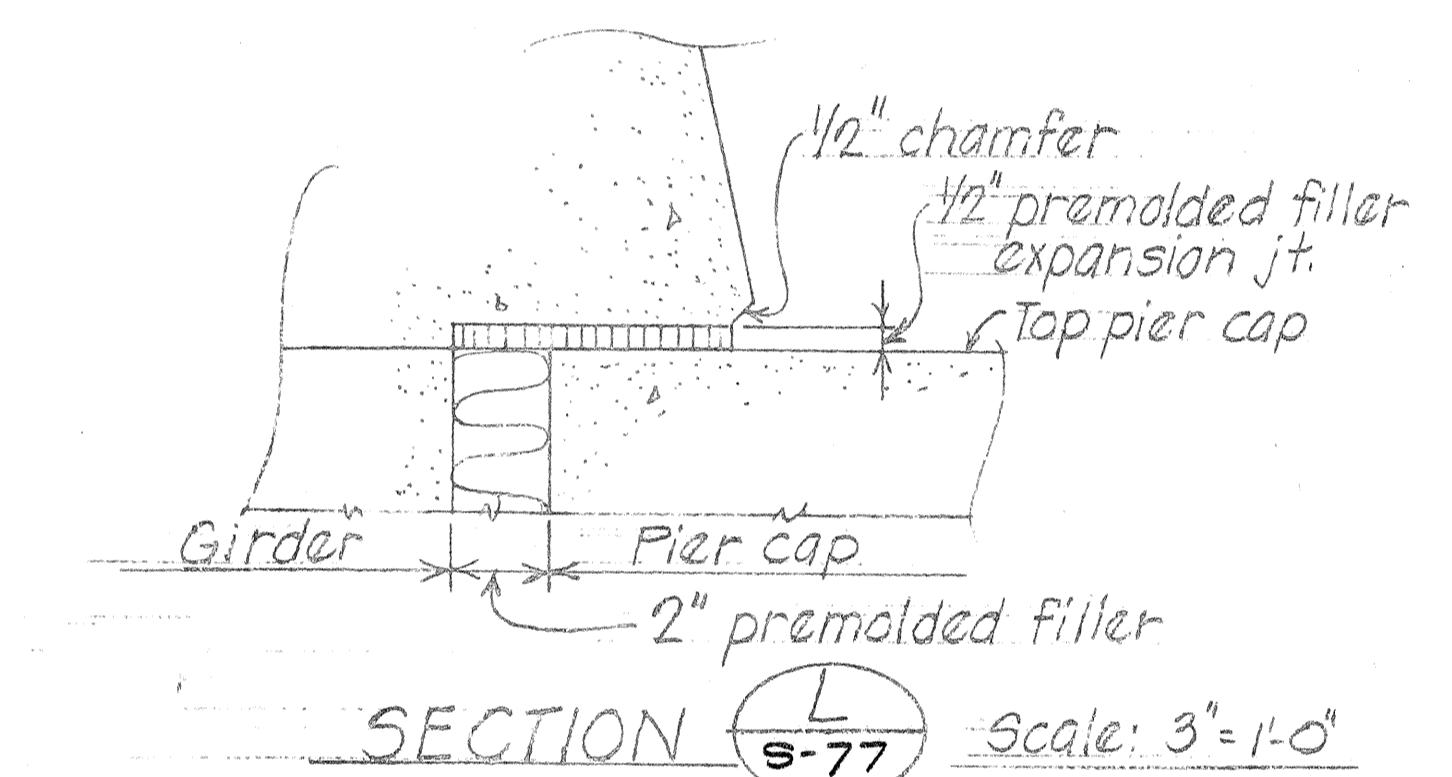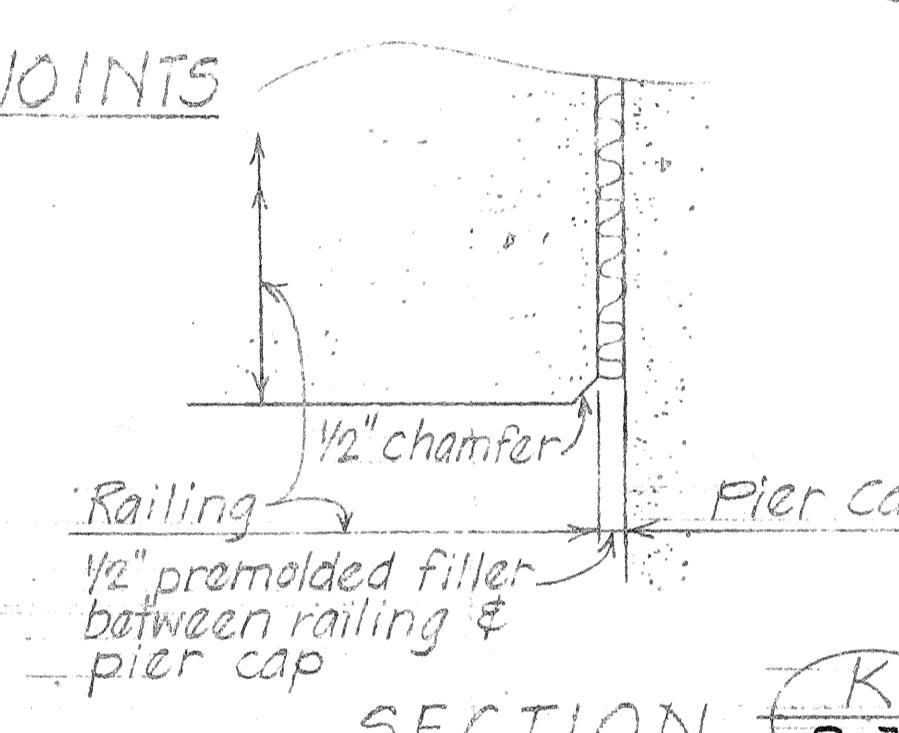

ORIGINAL PLAN	SURVEY PLOTTED BY DRAWN BY TRACED BY DESIGNED BY	DATE
NOTE BOOK	QUANTITIES BY	
No.	CHECKED BY	

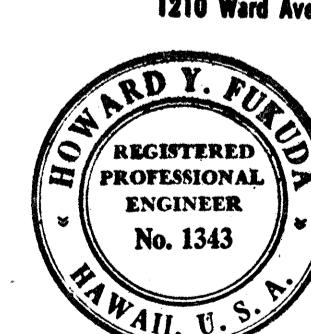

This work was prepared by
me or under my supervision.



**STATE OF HAWAII
DEPARTMENT OF TRANSPORTATION
HIGHWAYS DIVISION**




STRUCTURE No. 8

TYPICAL CONCRETE RAILING DETAILS & FINISH

PEARL HARBOR INTERCHANGE
F.A.I. Proj. No. 1-HI-1 (73) : 15

As Shown Date: DEC. 7, 1973

FED. ROAD DIST. NO.	STATE	FED. AID PROJ. NO.	FISCAL YEAR	SHEET NO.	TOTAL SHEETS
HAWAII	HAW.	I-HI-(73)-15	1974	294	369

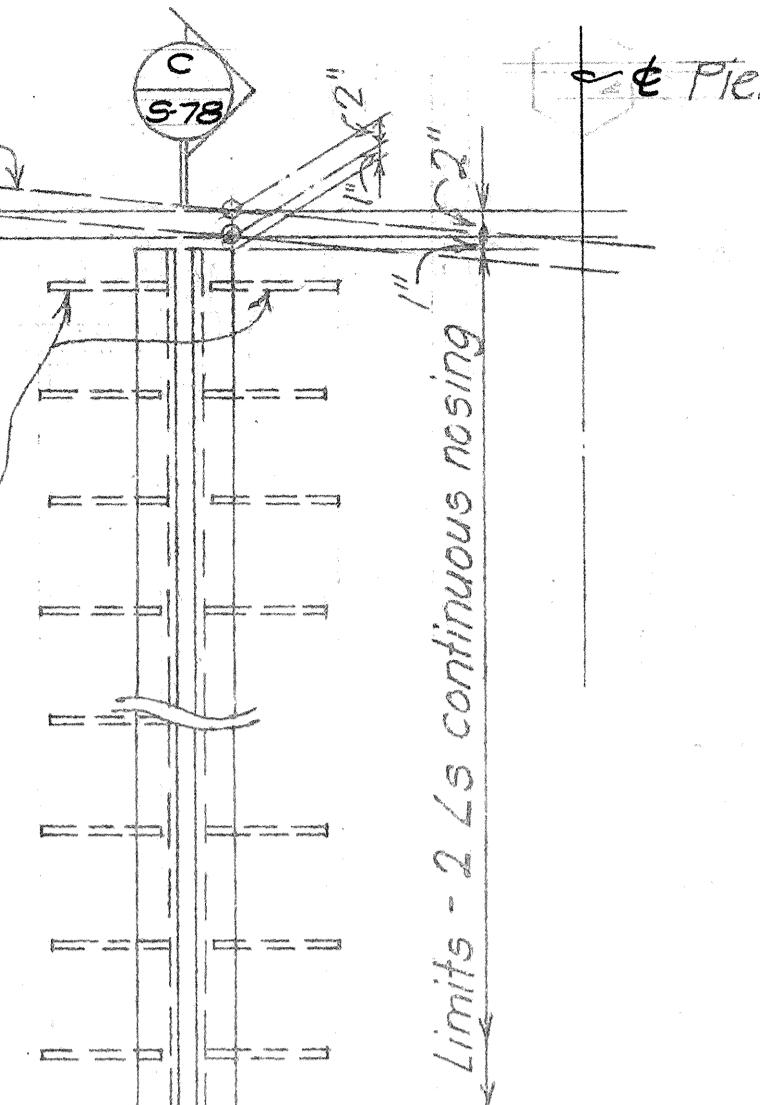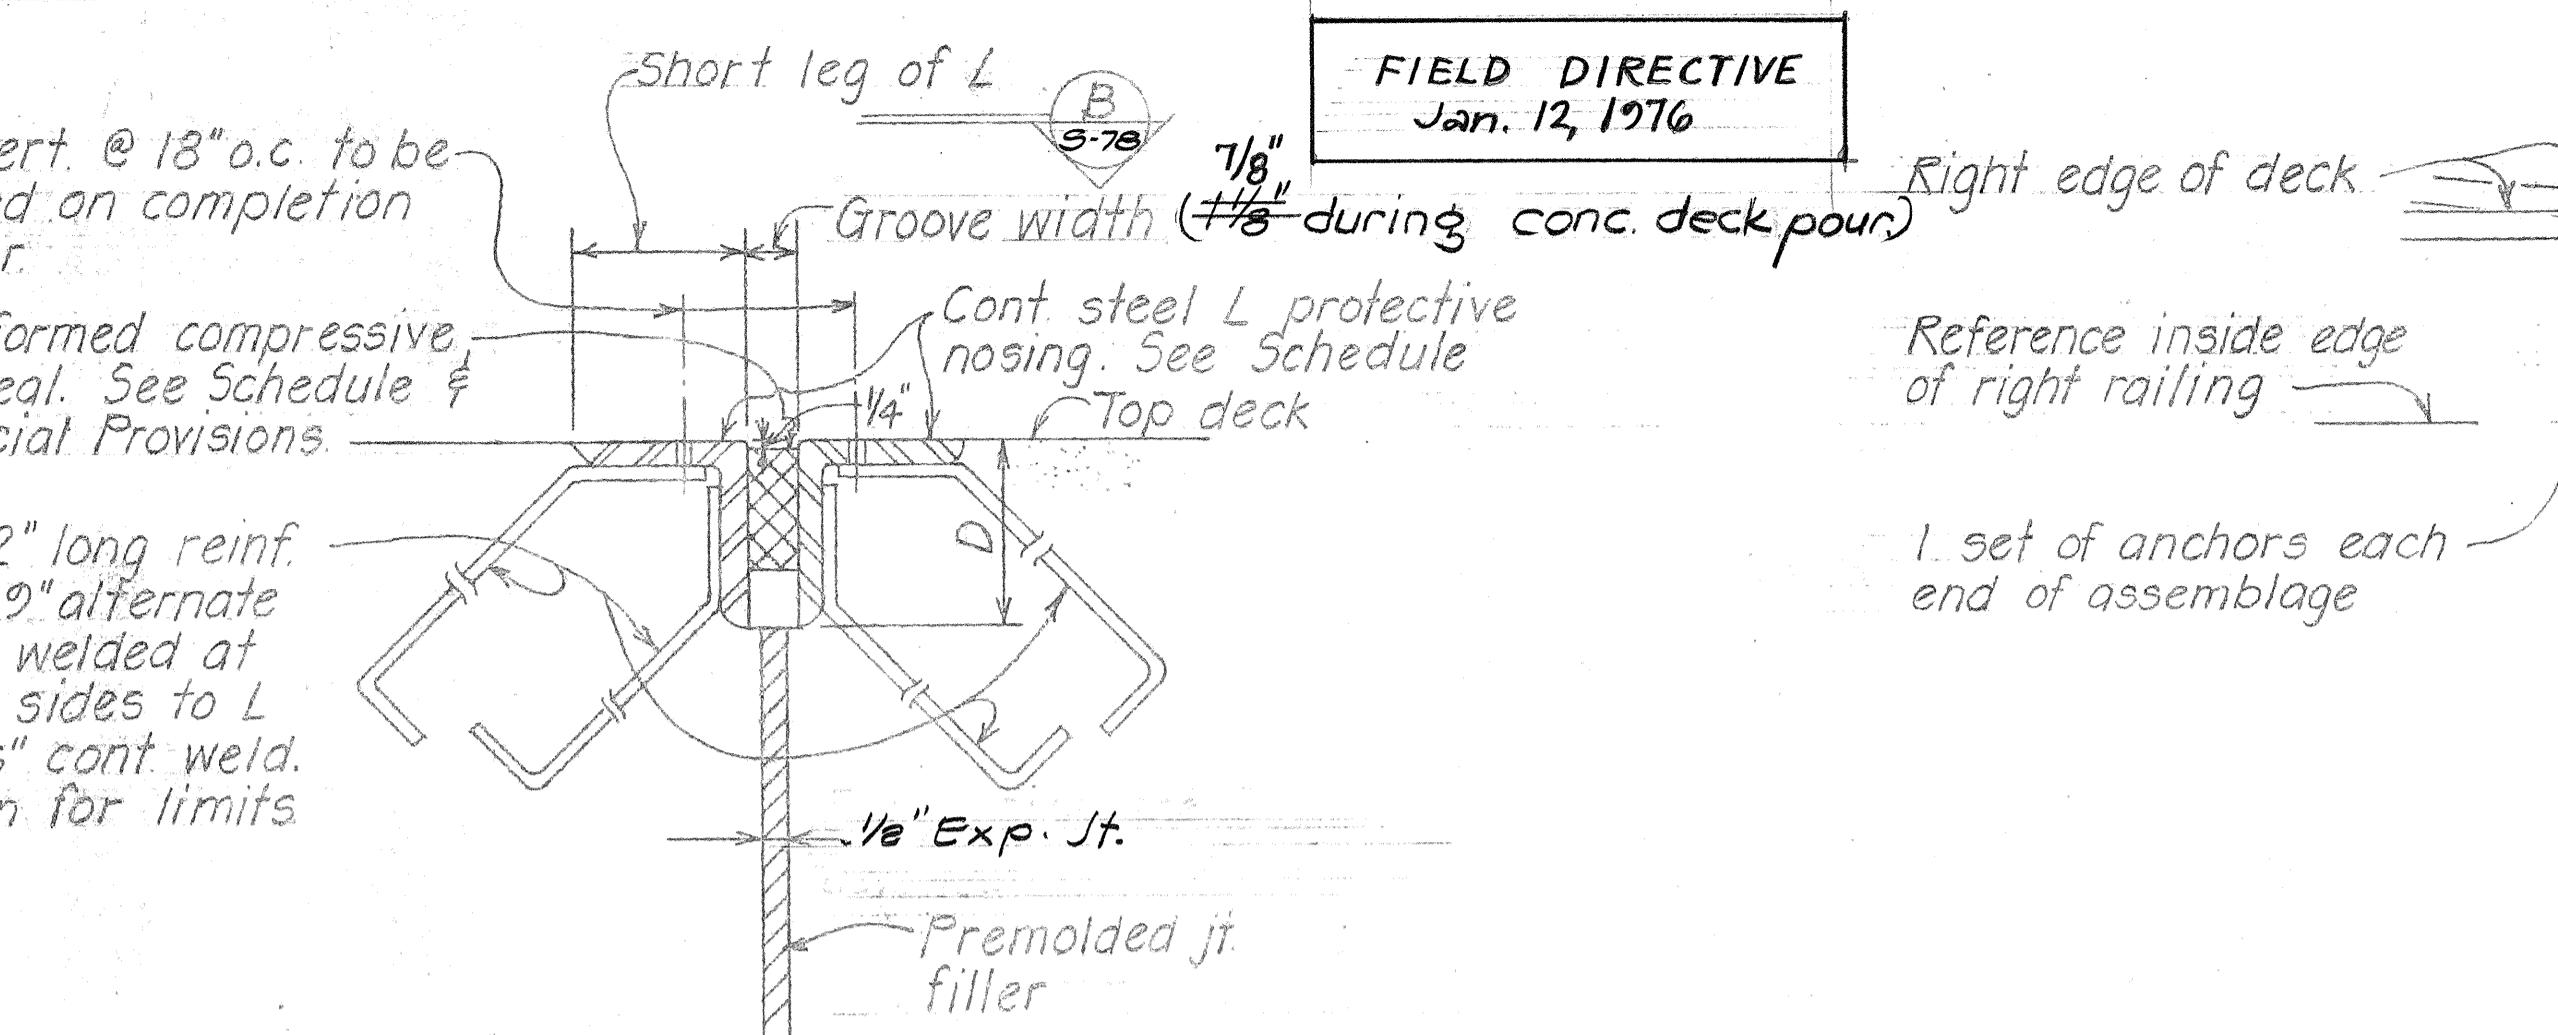
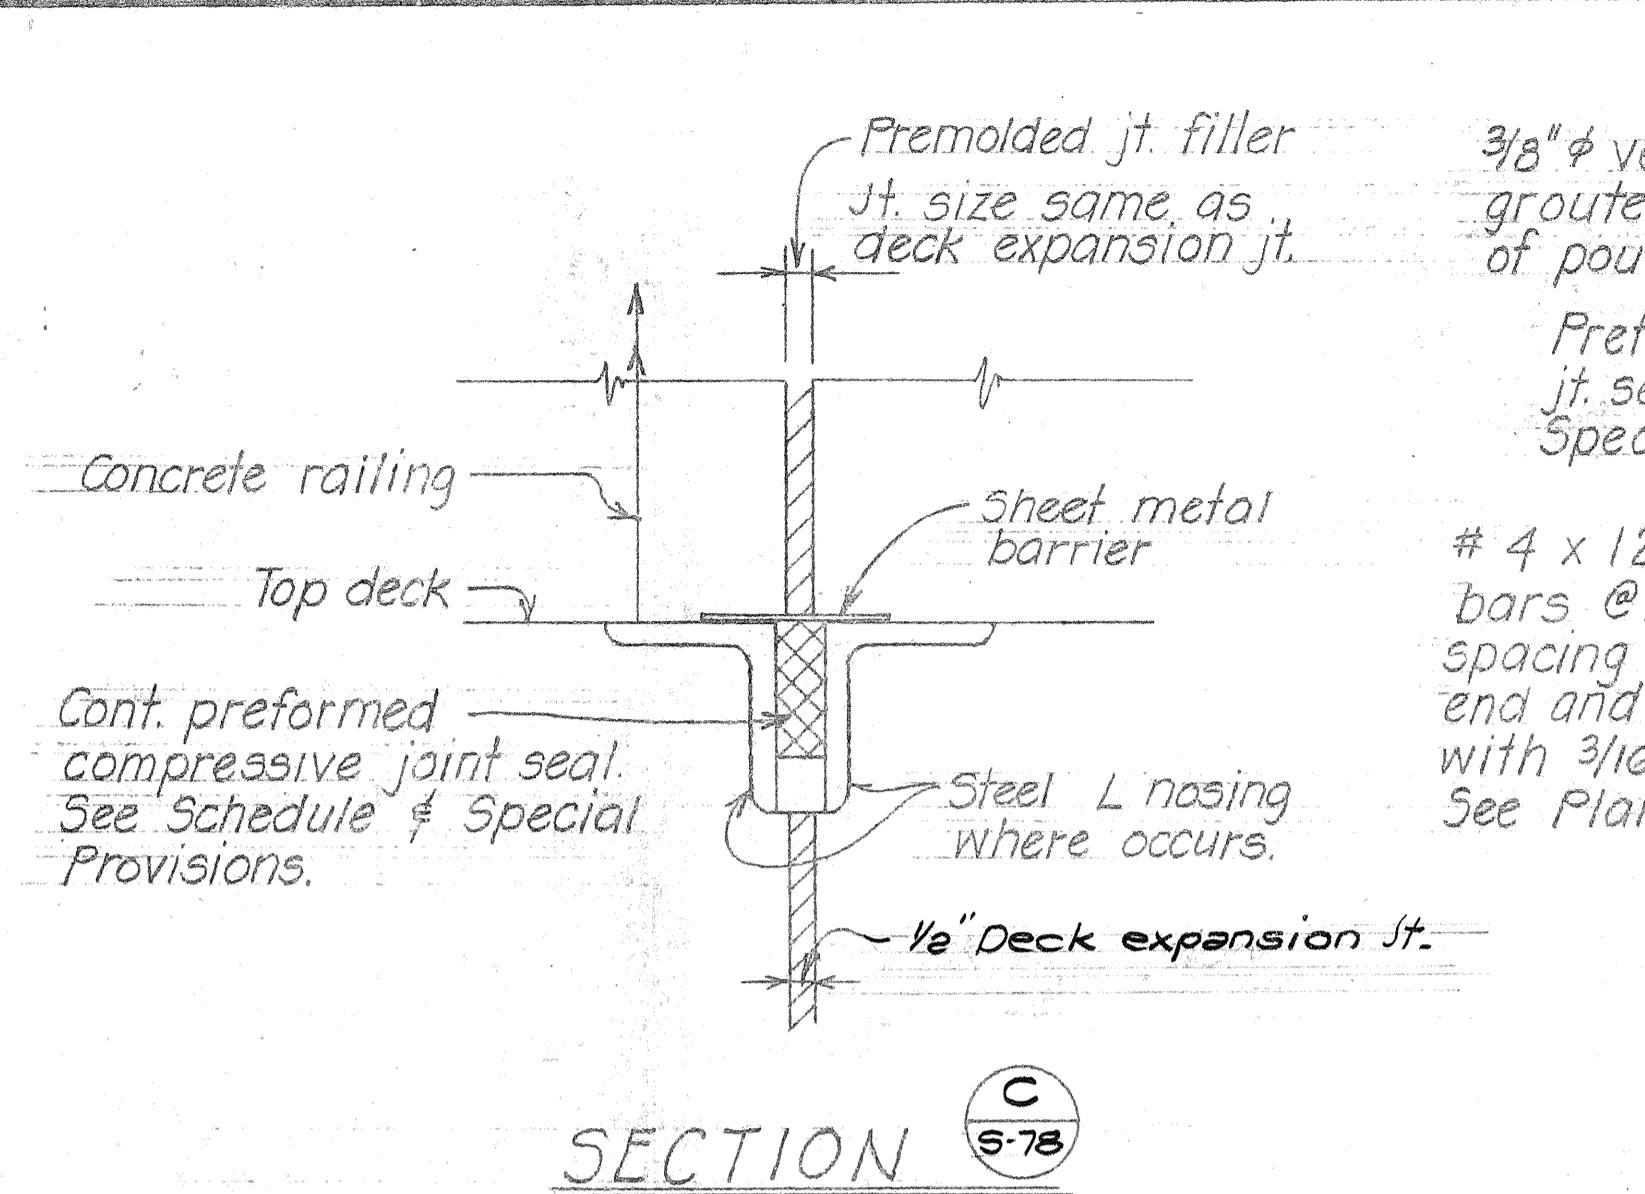


SECTION C
S-78

AT STEEL ANGLE PROTECTIVE NOSING

TYPICAL SECTION A
S-78

Scale: 3" = 1'-0"

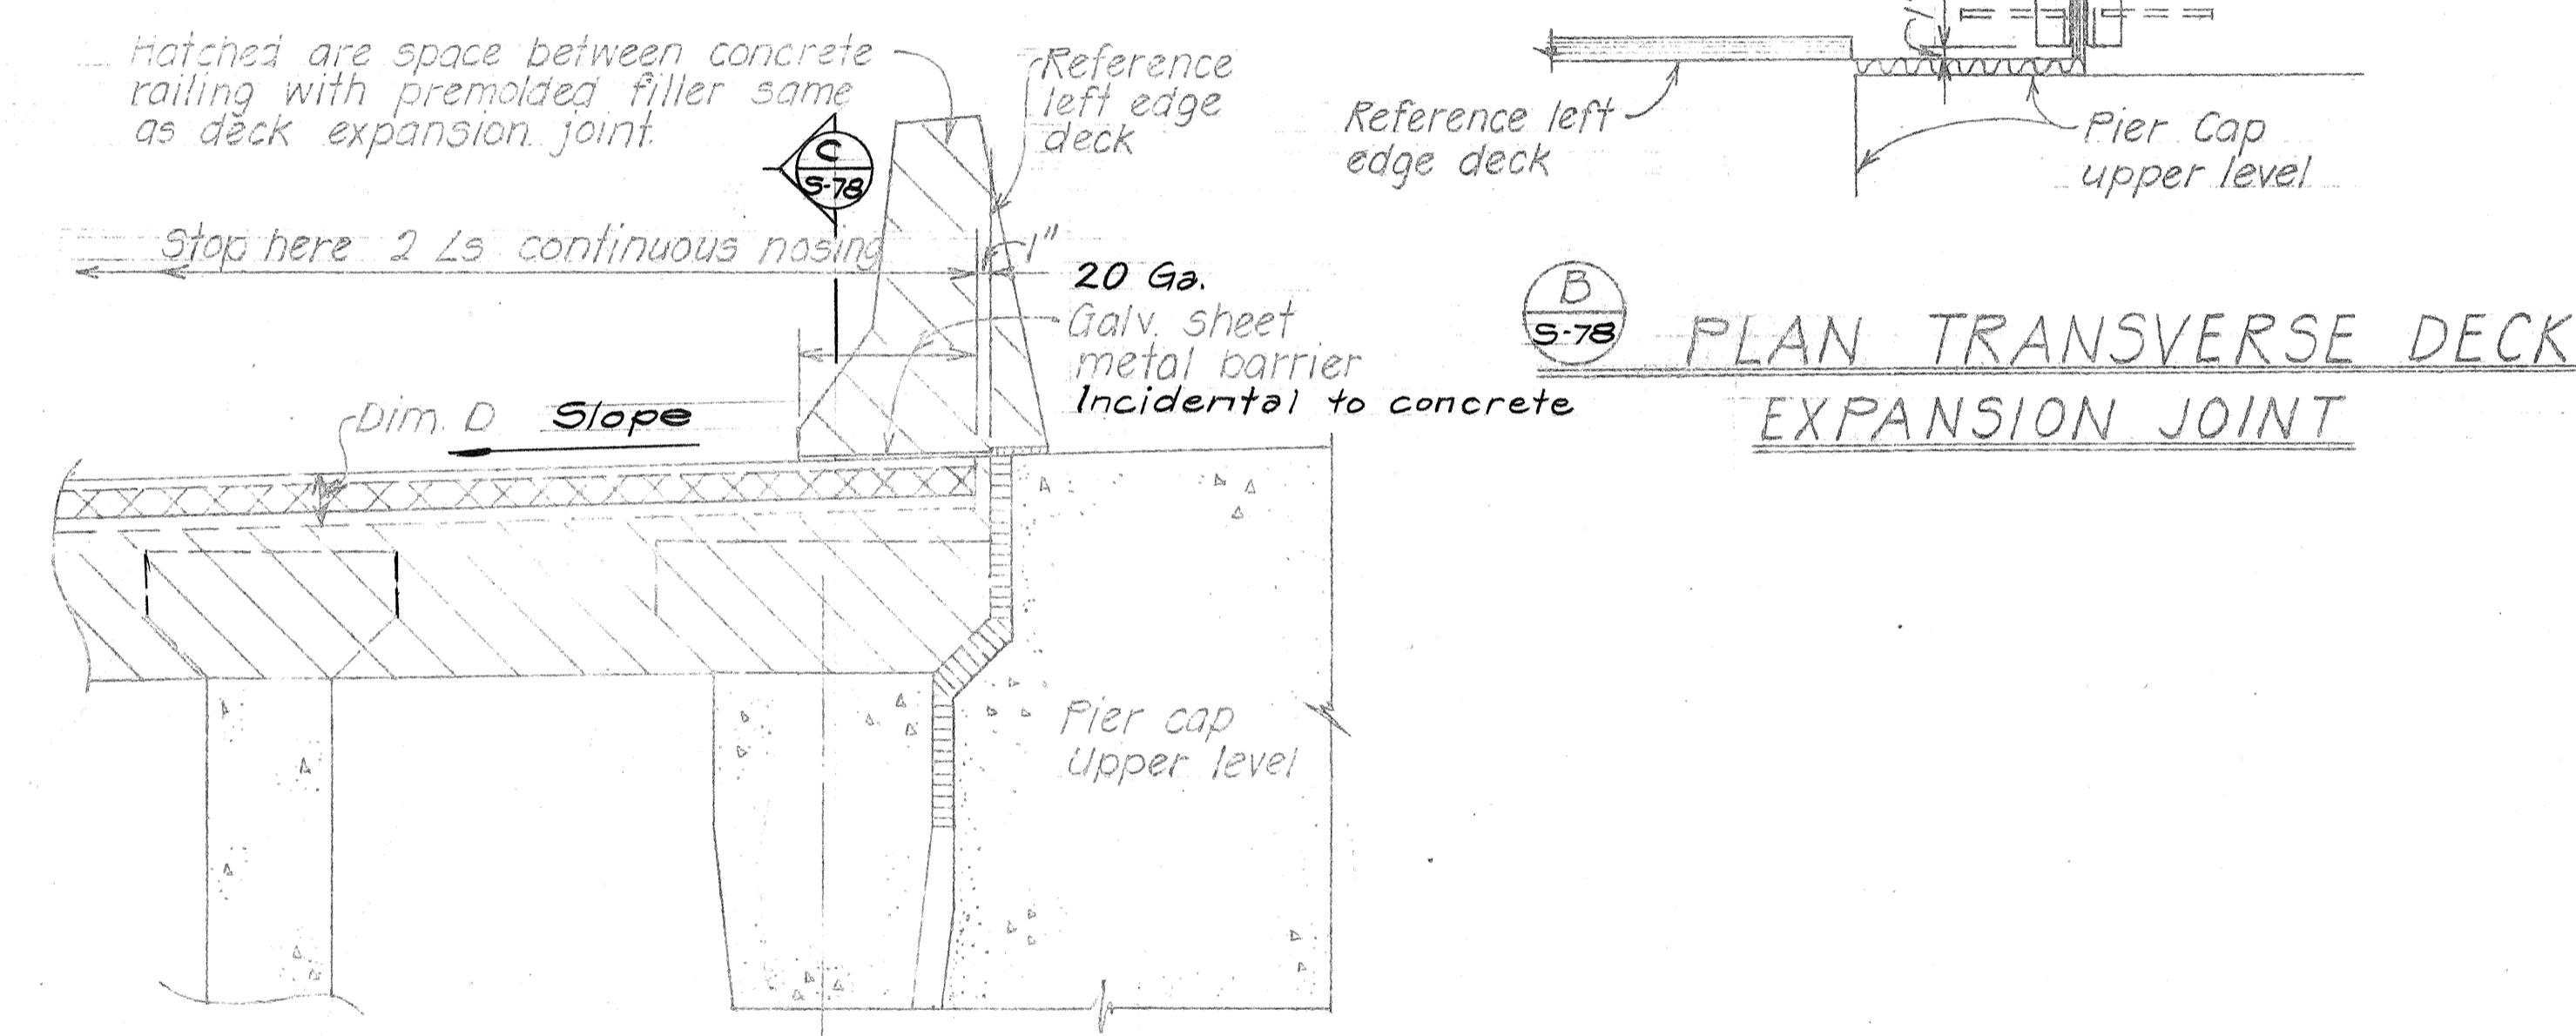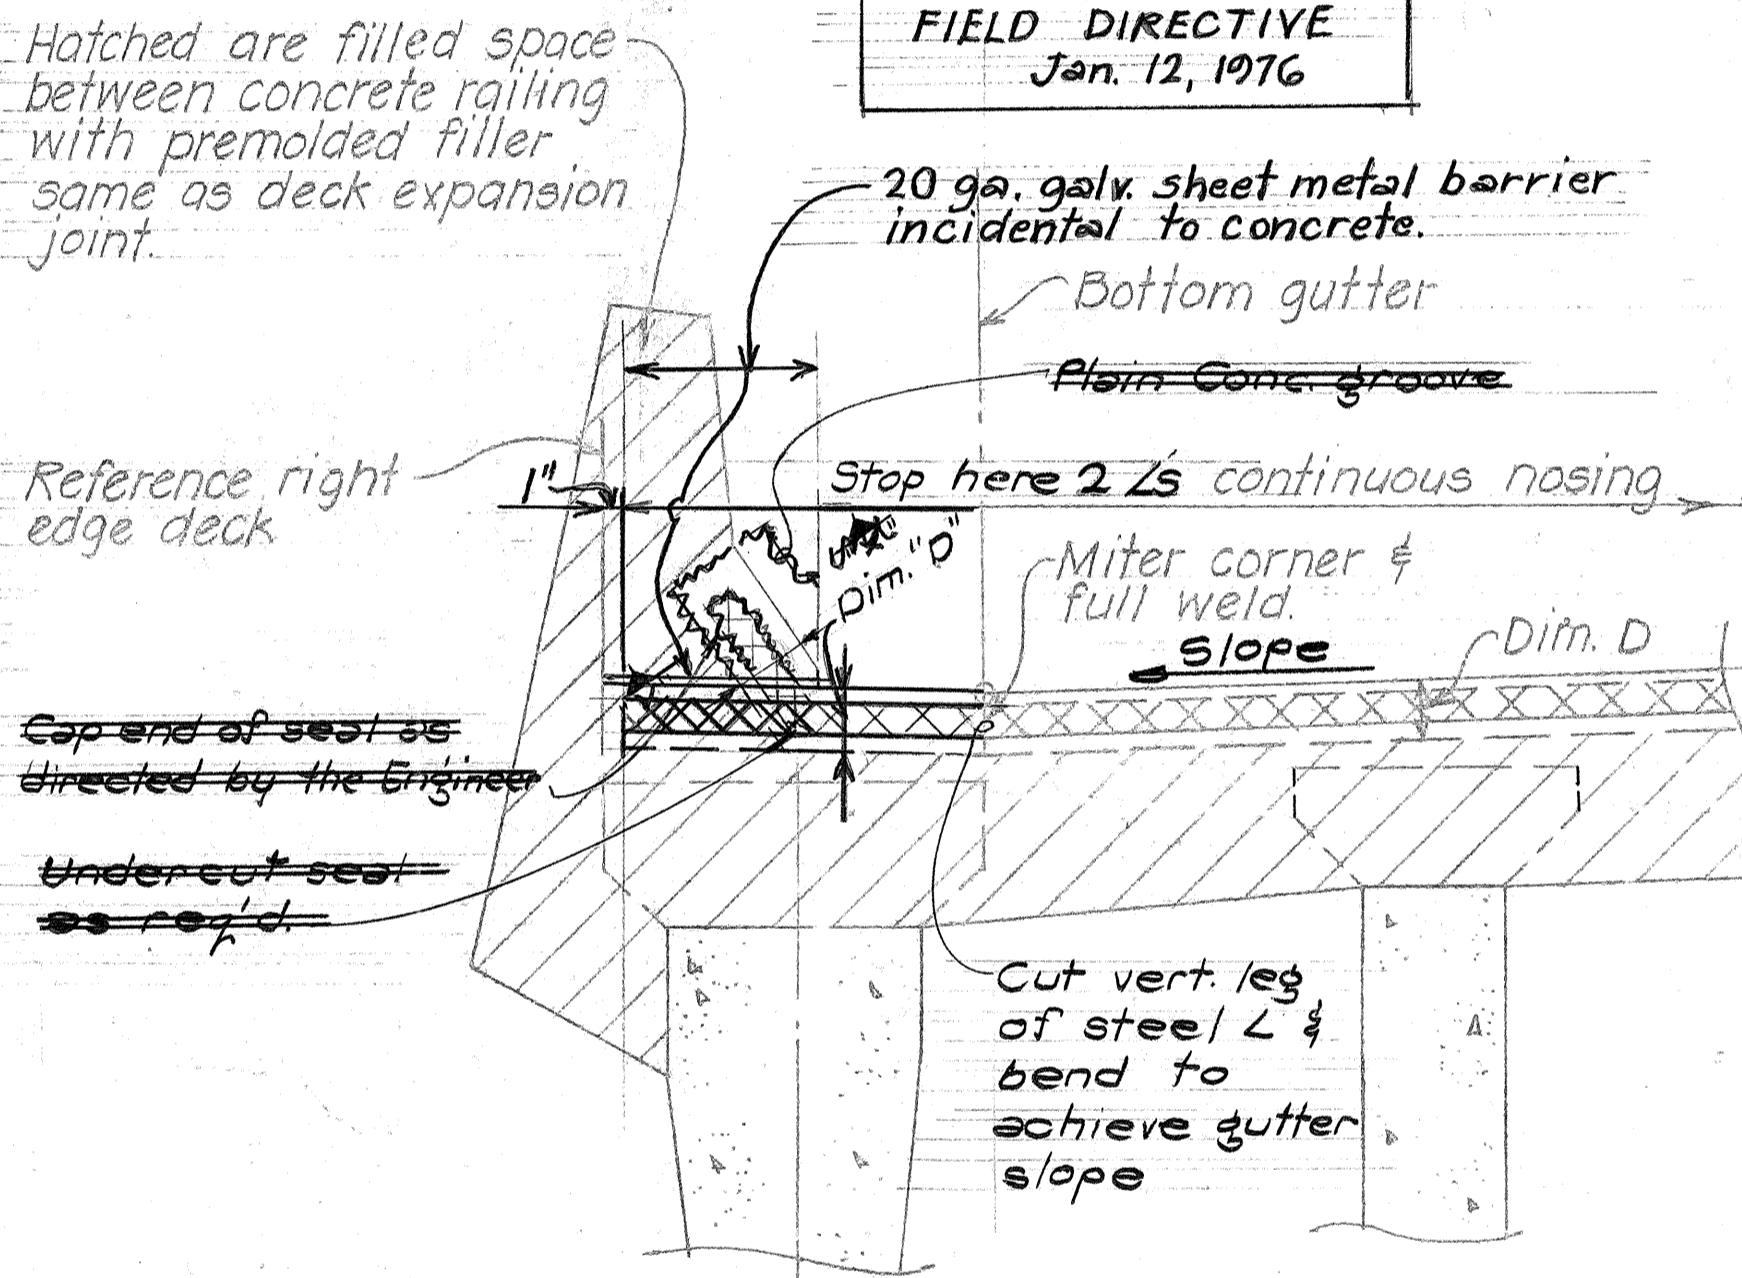


PLAN TRANSVERSE DECK EXPANSION JOINT

AT CONCRETE RAILING W/GUTTER


AT CONCRETE RAILING W/o GUTTER

SECTION C
S-78

EXPANSION JOINT SEALER SCHEDULE					
Joint Seal Size	Type A - Joint Sealer (Dimensions and Tolerances)		Steel Angle Protective Nosing	Groove Dim. D	
	Thickness J	Thickness H			
	T	t			
(3)	2 +3/16 -0	2 1/16 ± 1/8	1/8 - 1/64	+ 1/32 3/32 - 1/64	4" x 3 1/2" x 1/2"
					4"

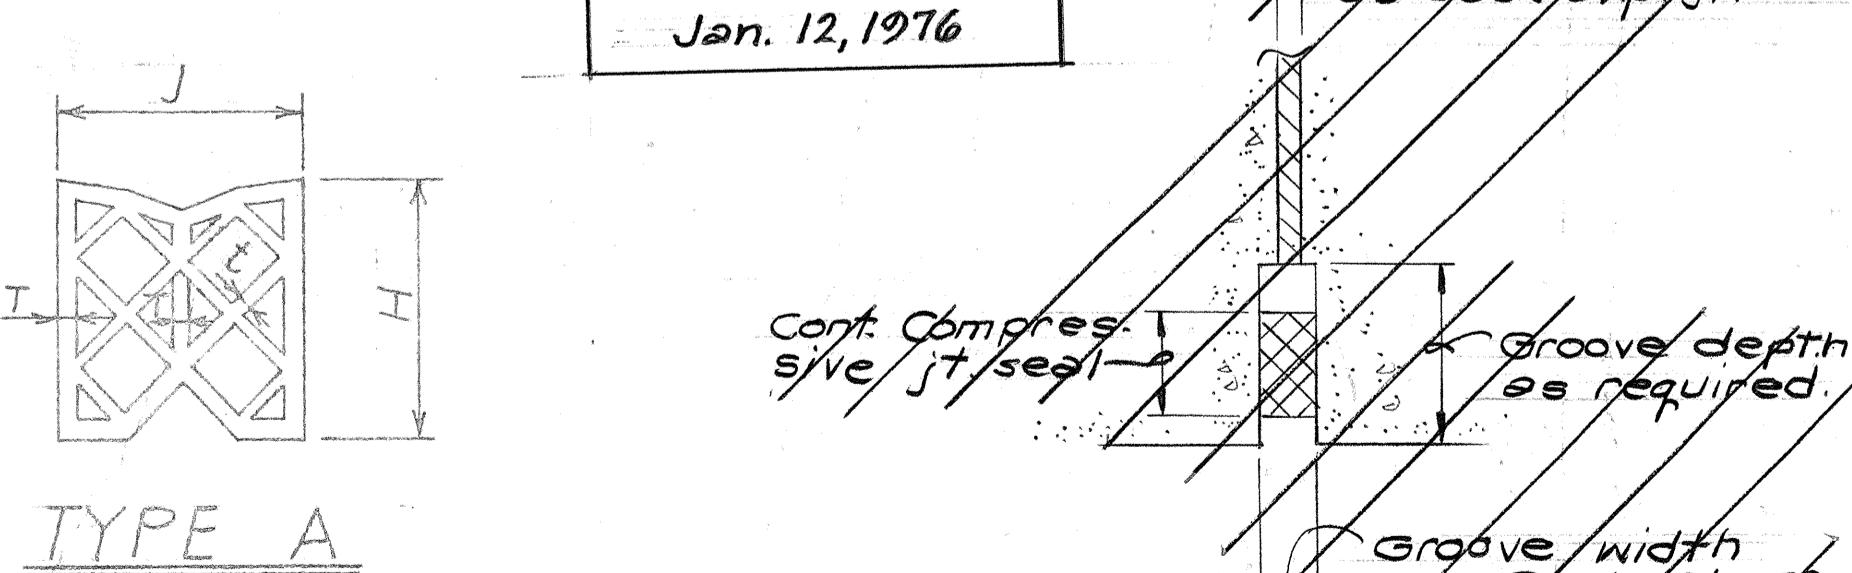

SECTION "X-X"

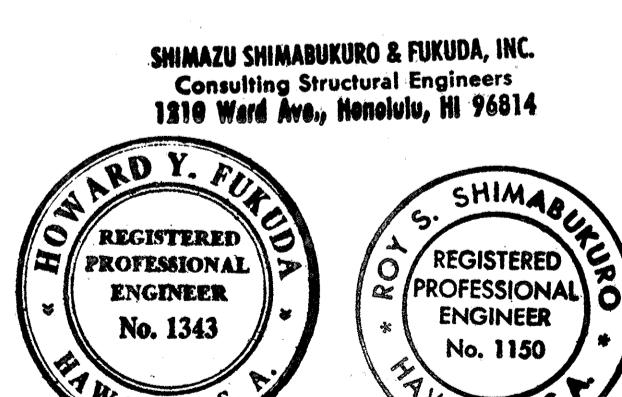

This work was prepared by
me or under my supervision


STATE OF HAWAII
DEPARTMENT OF TRANSPORTATION
HIGHWAYS DIVISION
STRUCTURE No. 8
PIER EXPANSION JOINT DETAIL
PEARL HARBOR INTERCHANGE
F.A.I. Proj. No. I-HI-1 (73)-15
Scale: As Shown Date DEC. 7, 1973
SHEET NO. 5-78 OF 106 SHEETS

ED. ROAD DIST. NO.	STATE	FED. AID PROJ. NO.	FISCAL YEAR	SHEET NO.	TOTAL SHEETS
HAWAII	HAW.	I-H-1(73)15	1974	295	369

GENERAL NOTES


- Grates, frames, bolts, etc.
shall be hot dip galvanized
after fabrication. See Specs.

All structural steel shall
conform to A.S.T.M. A 36

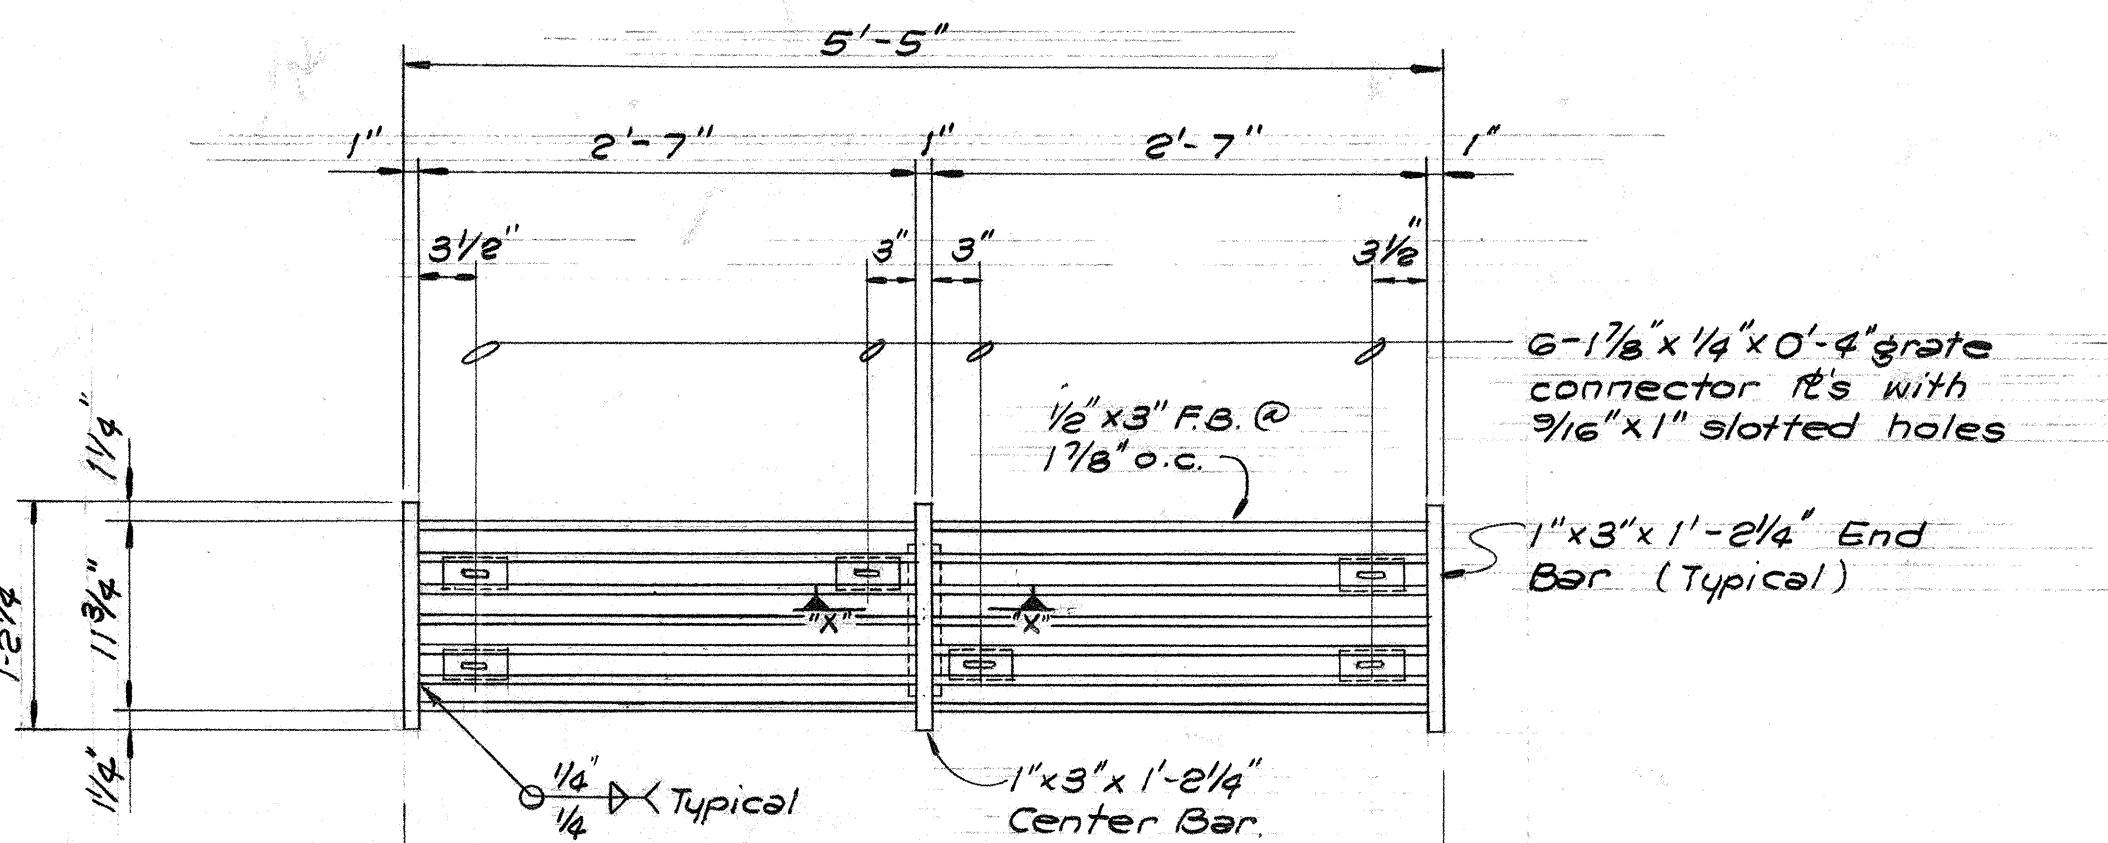


GRATING PLAN

I'' z I' - O

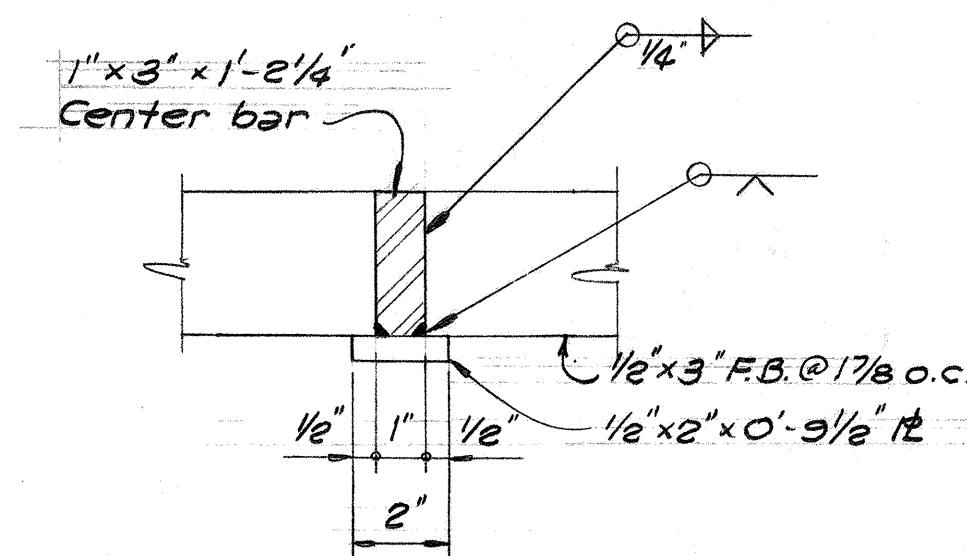


SECTION "X" - "X"

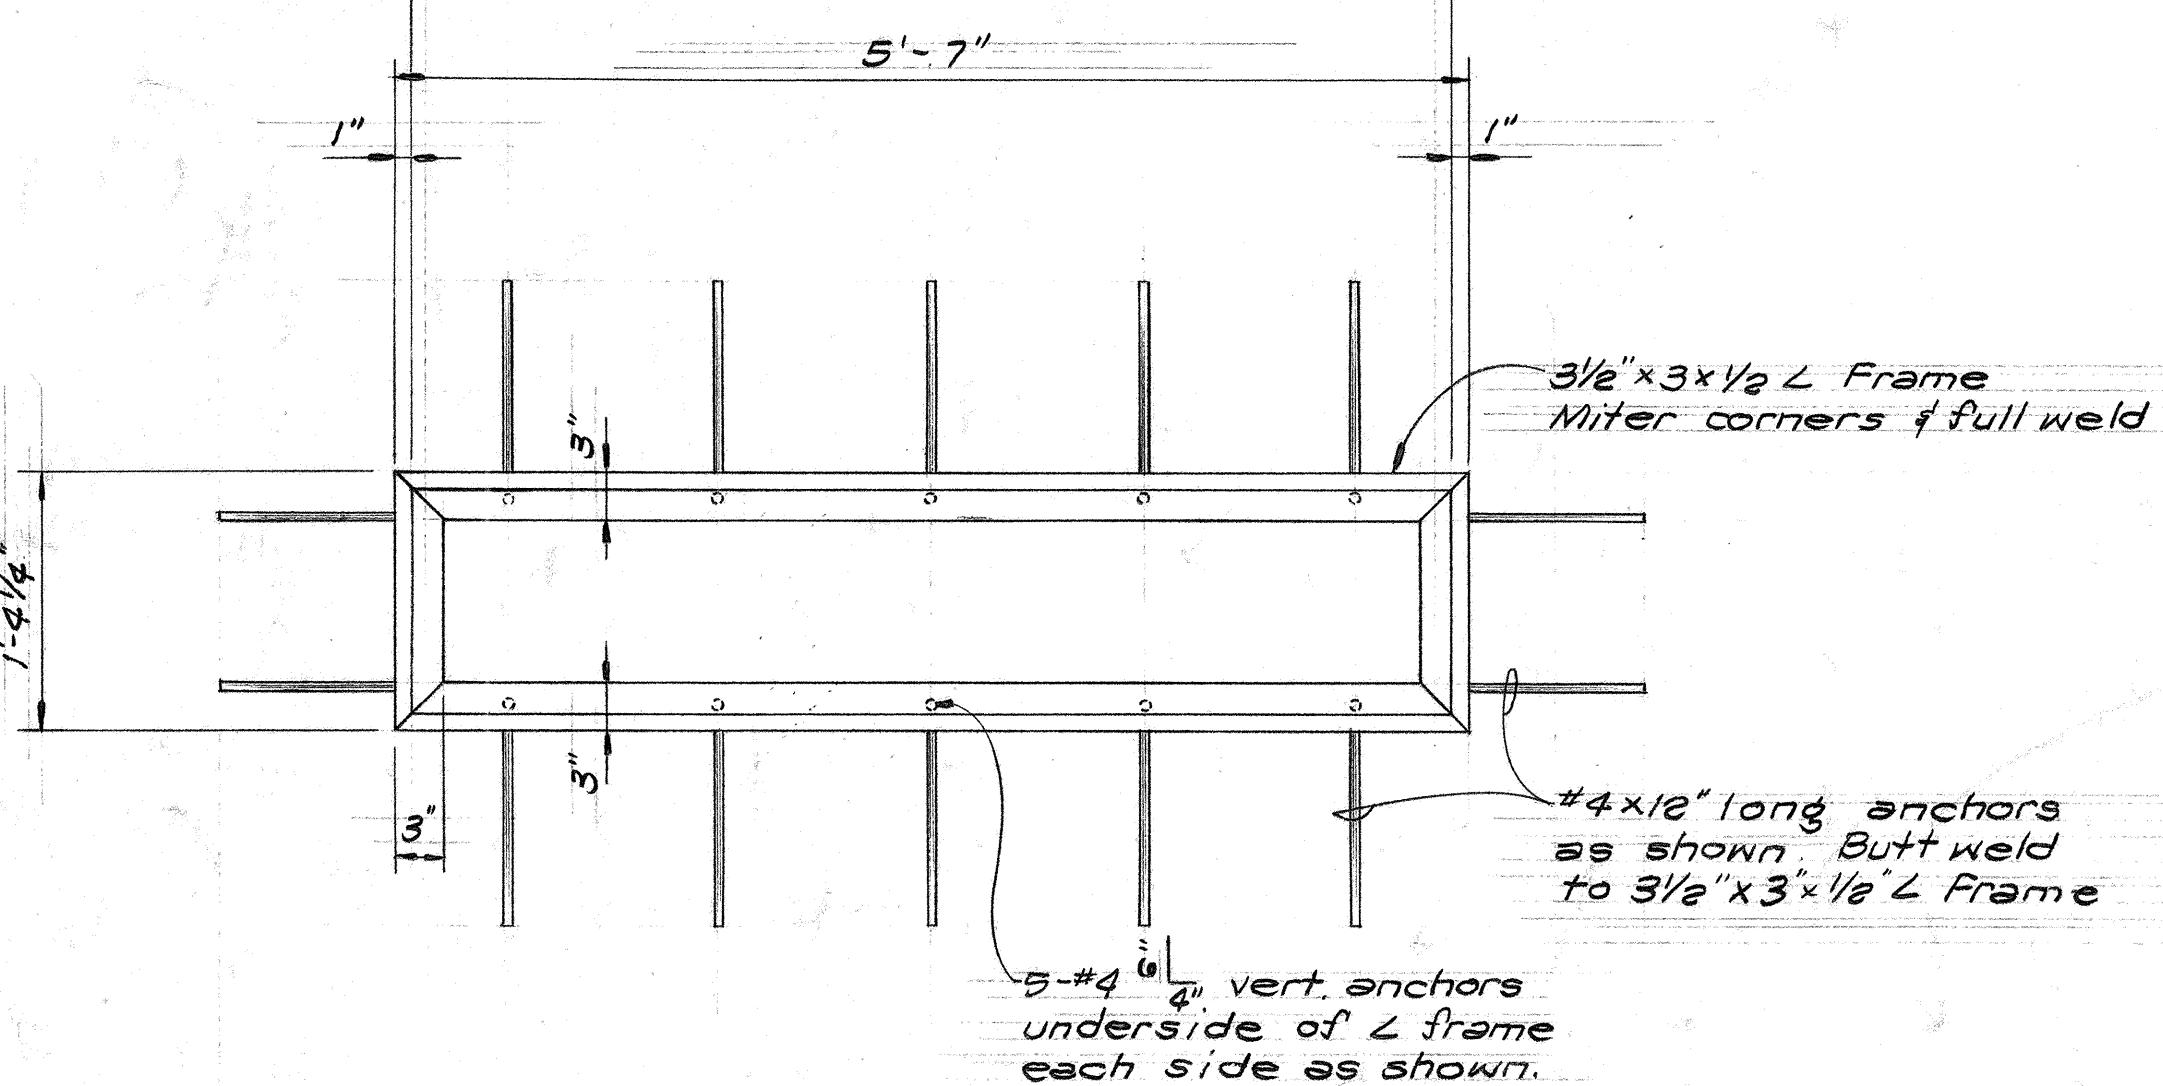


FRAME PLAN

$T'' = T' - \sigma''$

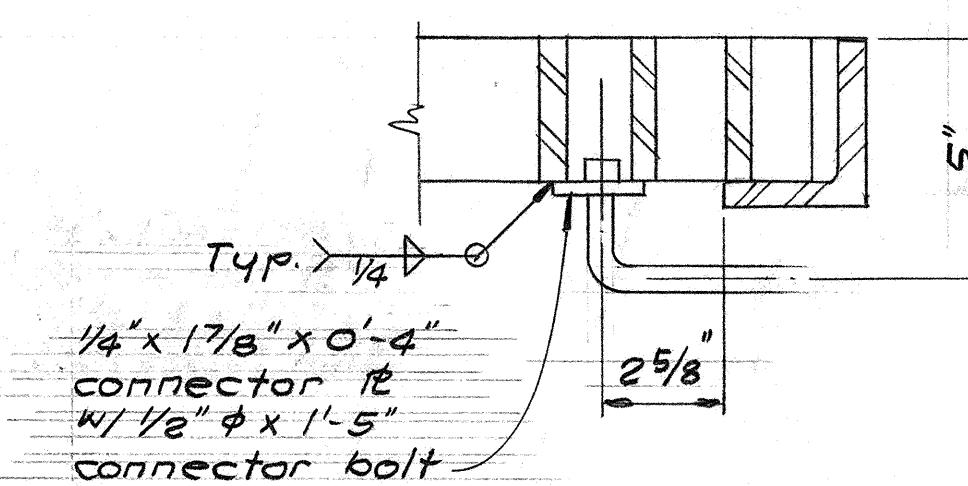


SECTION "Y-Y"

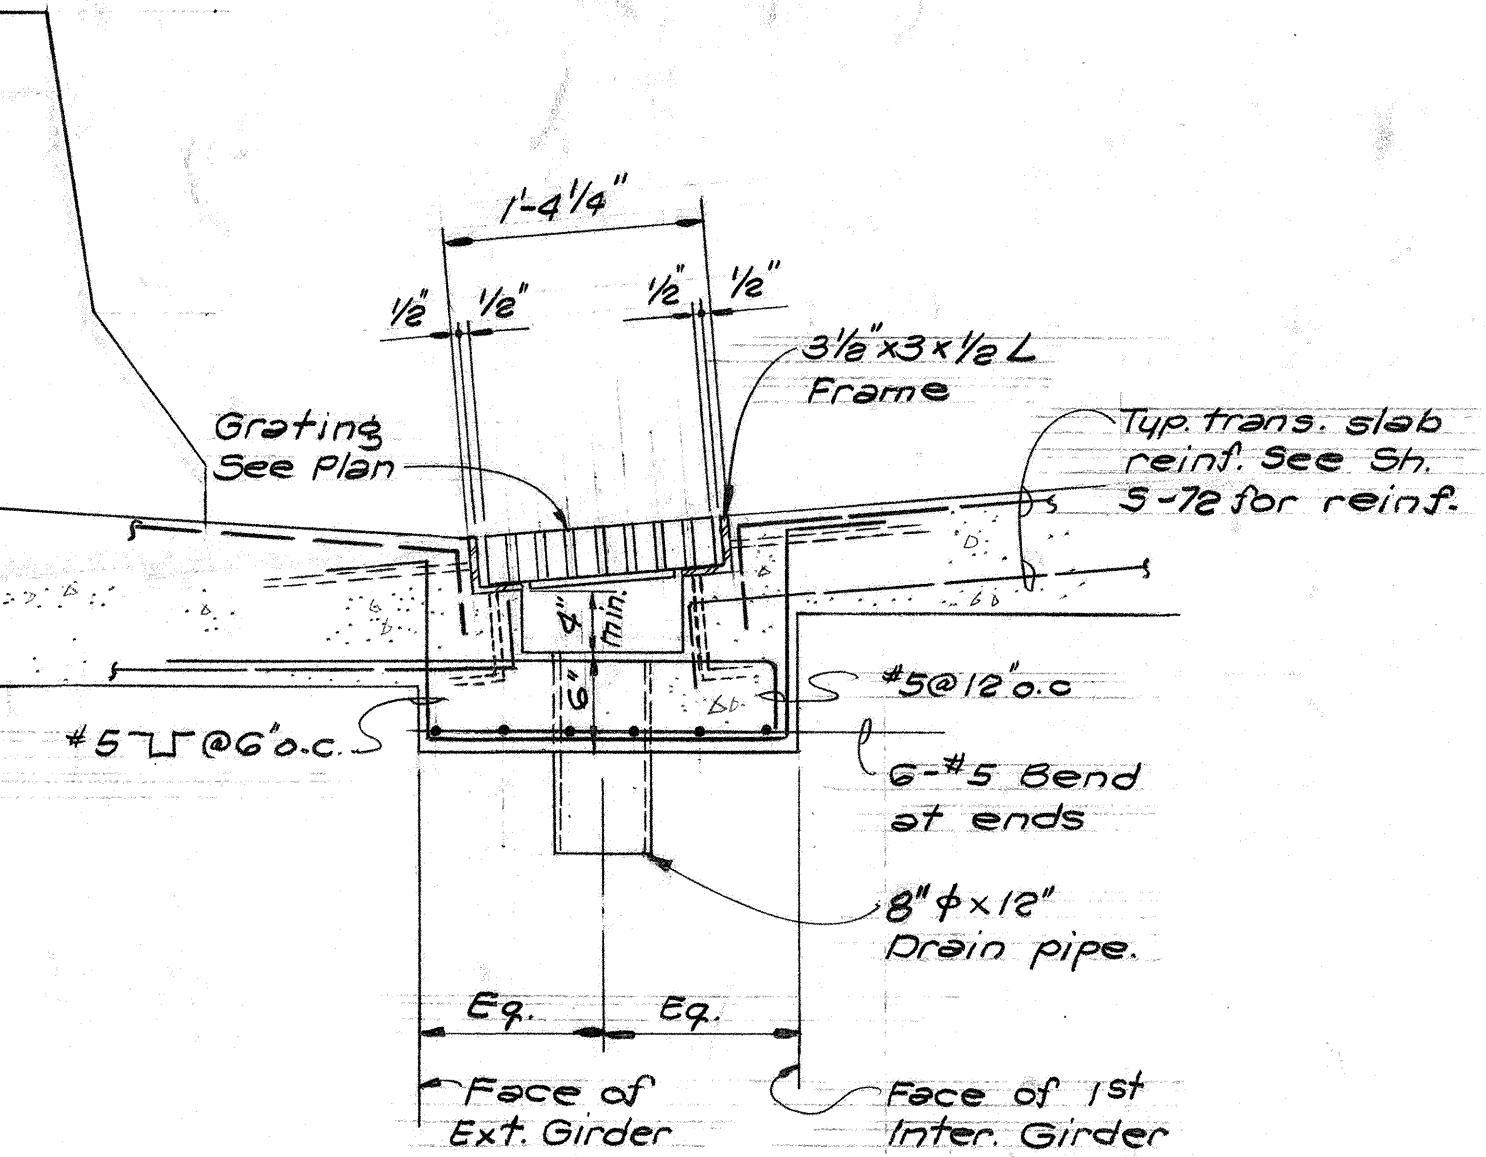

TYPIICAL CROSS SECTION

$$f'' = f' - \theta$$

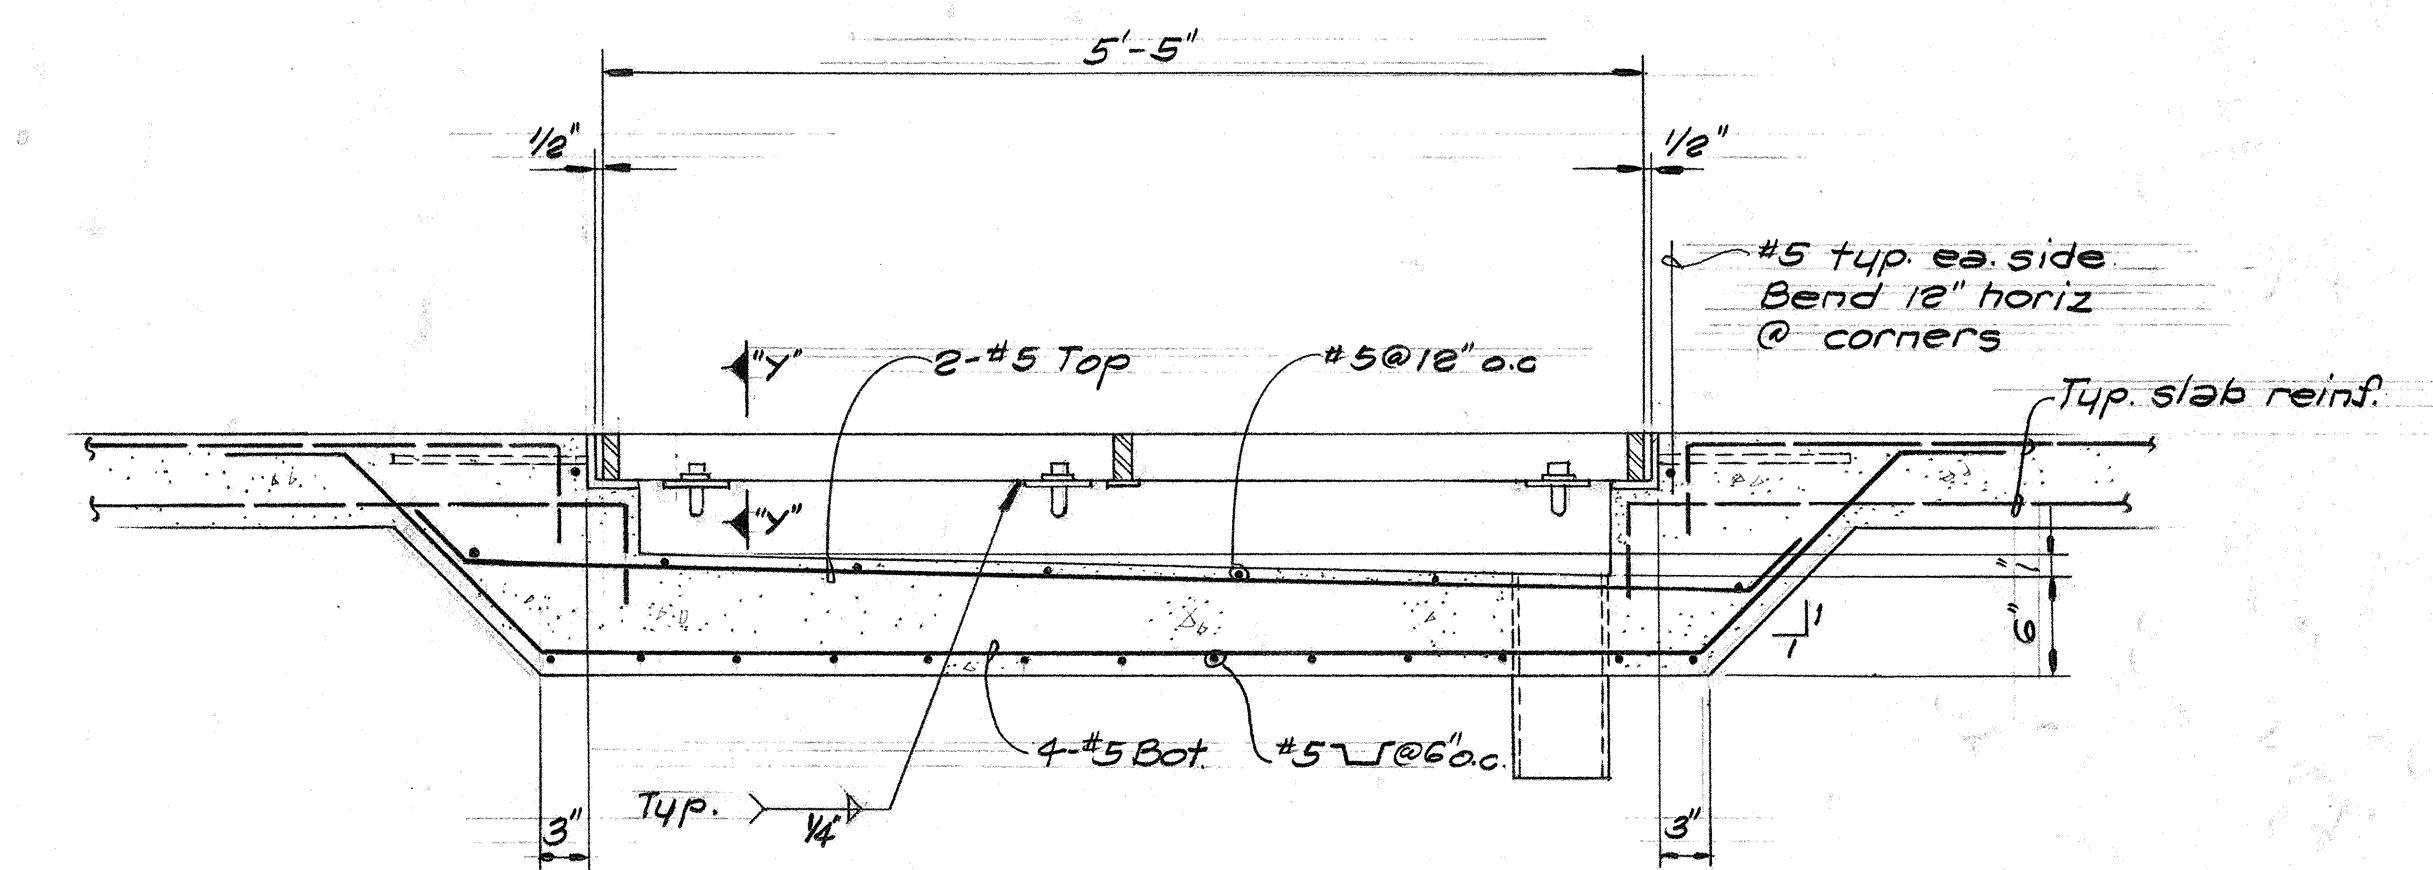


TYPICAL LONGITUDINAL SECTION

1" = 1"

ORIGINAL PLAN	SURVEY PLOTTED BY DRAWN BY TRACED BY	DATE " " "
NOTE BOOK	DESIGNED BY QUANTITIES BY CHECKED BY	" " "
No.		

SHIMAZU SHIMABUKURO & FUKUDA, INC.
Consulting Structural Engineers
1210 Ward Ave., Honolulu, HI 96814

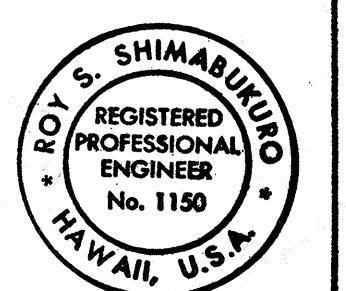

This Work was prepared by
me or under my supervision.

**STATE OF HAWAII
DEPARTMENT OF TRANSPORTATION
HIGHWAYS DIVISION**

STRUCTURE E No. 8

DECK DRAINAGE DRAINS

PEARL HARBOR INTERCHANGE


PEARL HARBOR INTERCHANGE
F.A.I. Proj. No. 1-H1 - 1 (73) : 15

SHEET No 5-79 OF 106 SHEETS



SHEET NO. 9-9 OF 100 SHEETS

SET NO. S-79 OF 106 SHEETS

FED. ROAD DIST. NO.	STATE	FED. AID PROJ. NO.	FISCAL YEAR	SHEET NO.	TOTAL SHEETS
HAWAII	HAW.	I-HI-(73)15	1974	296	369

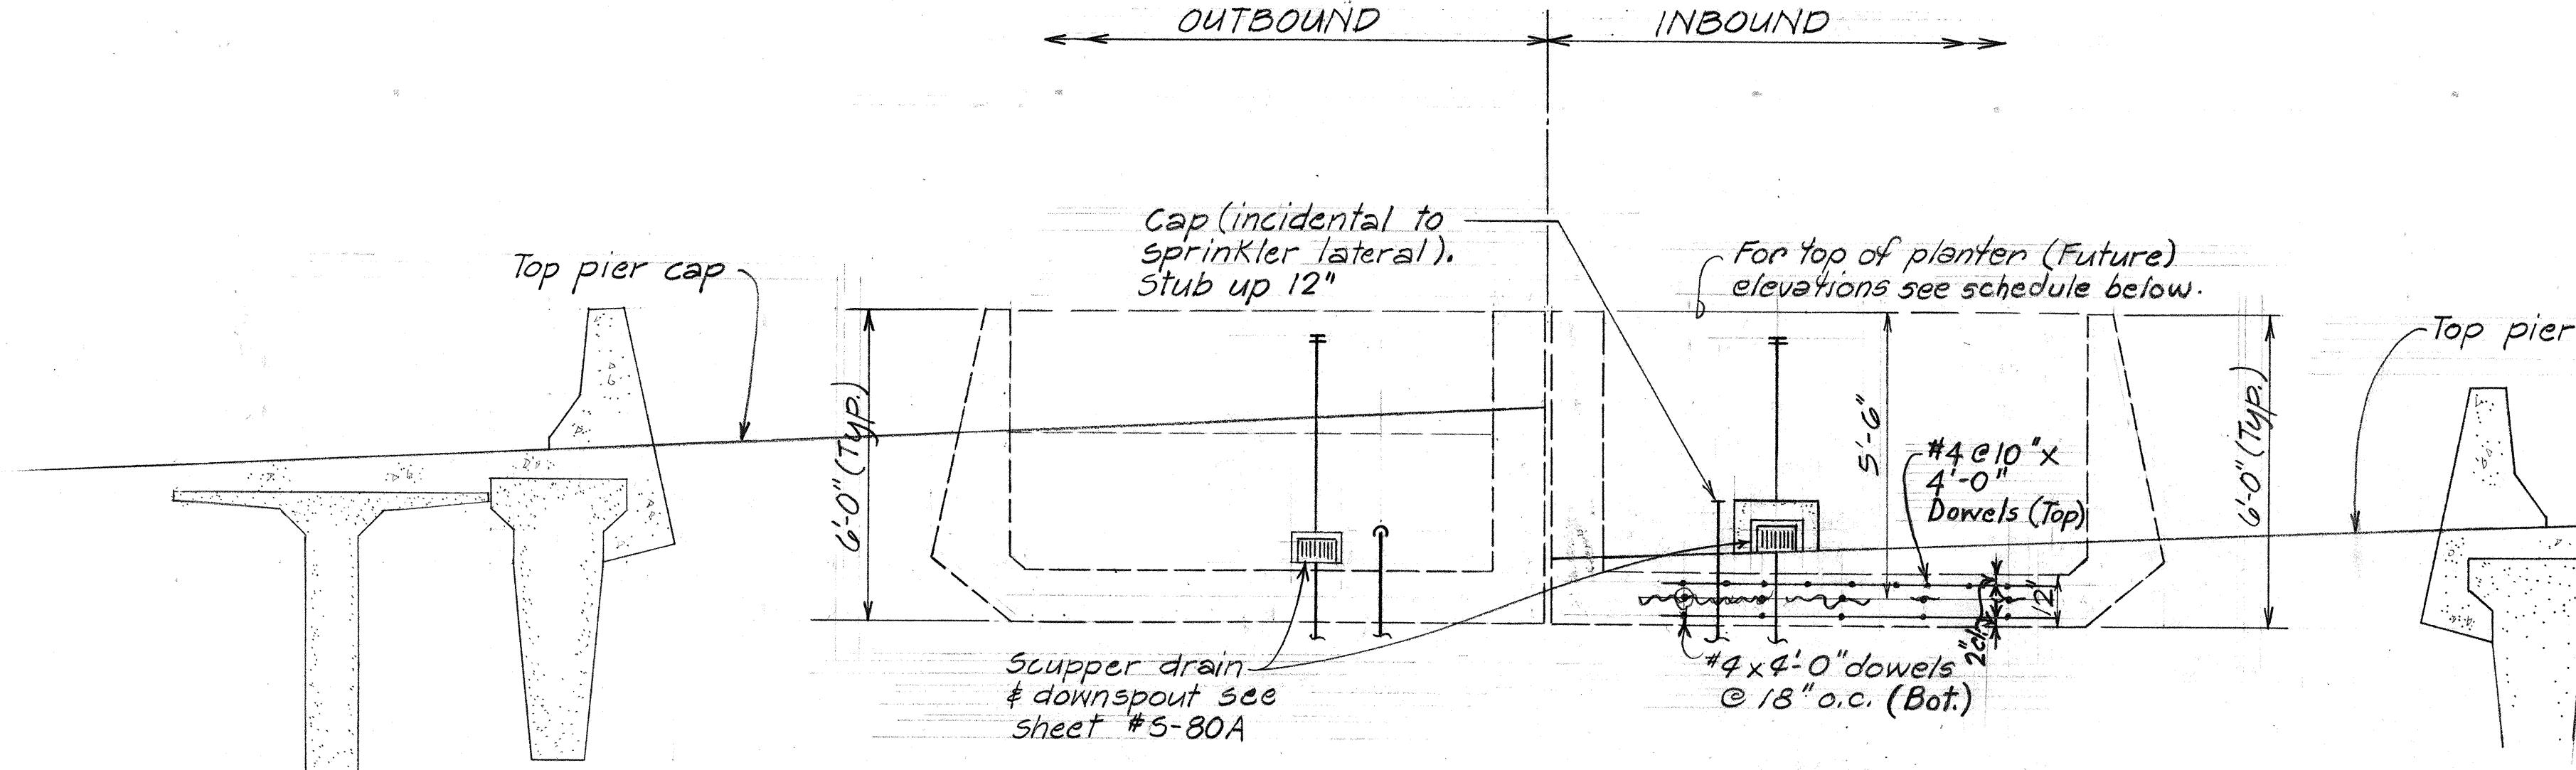

Note: Reference C.C.O. #64

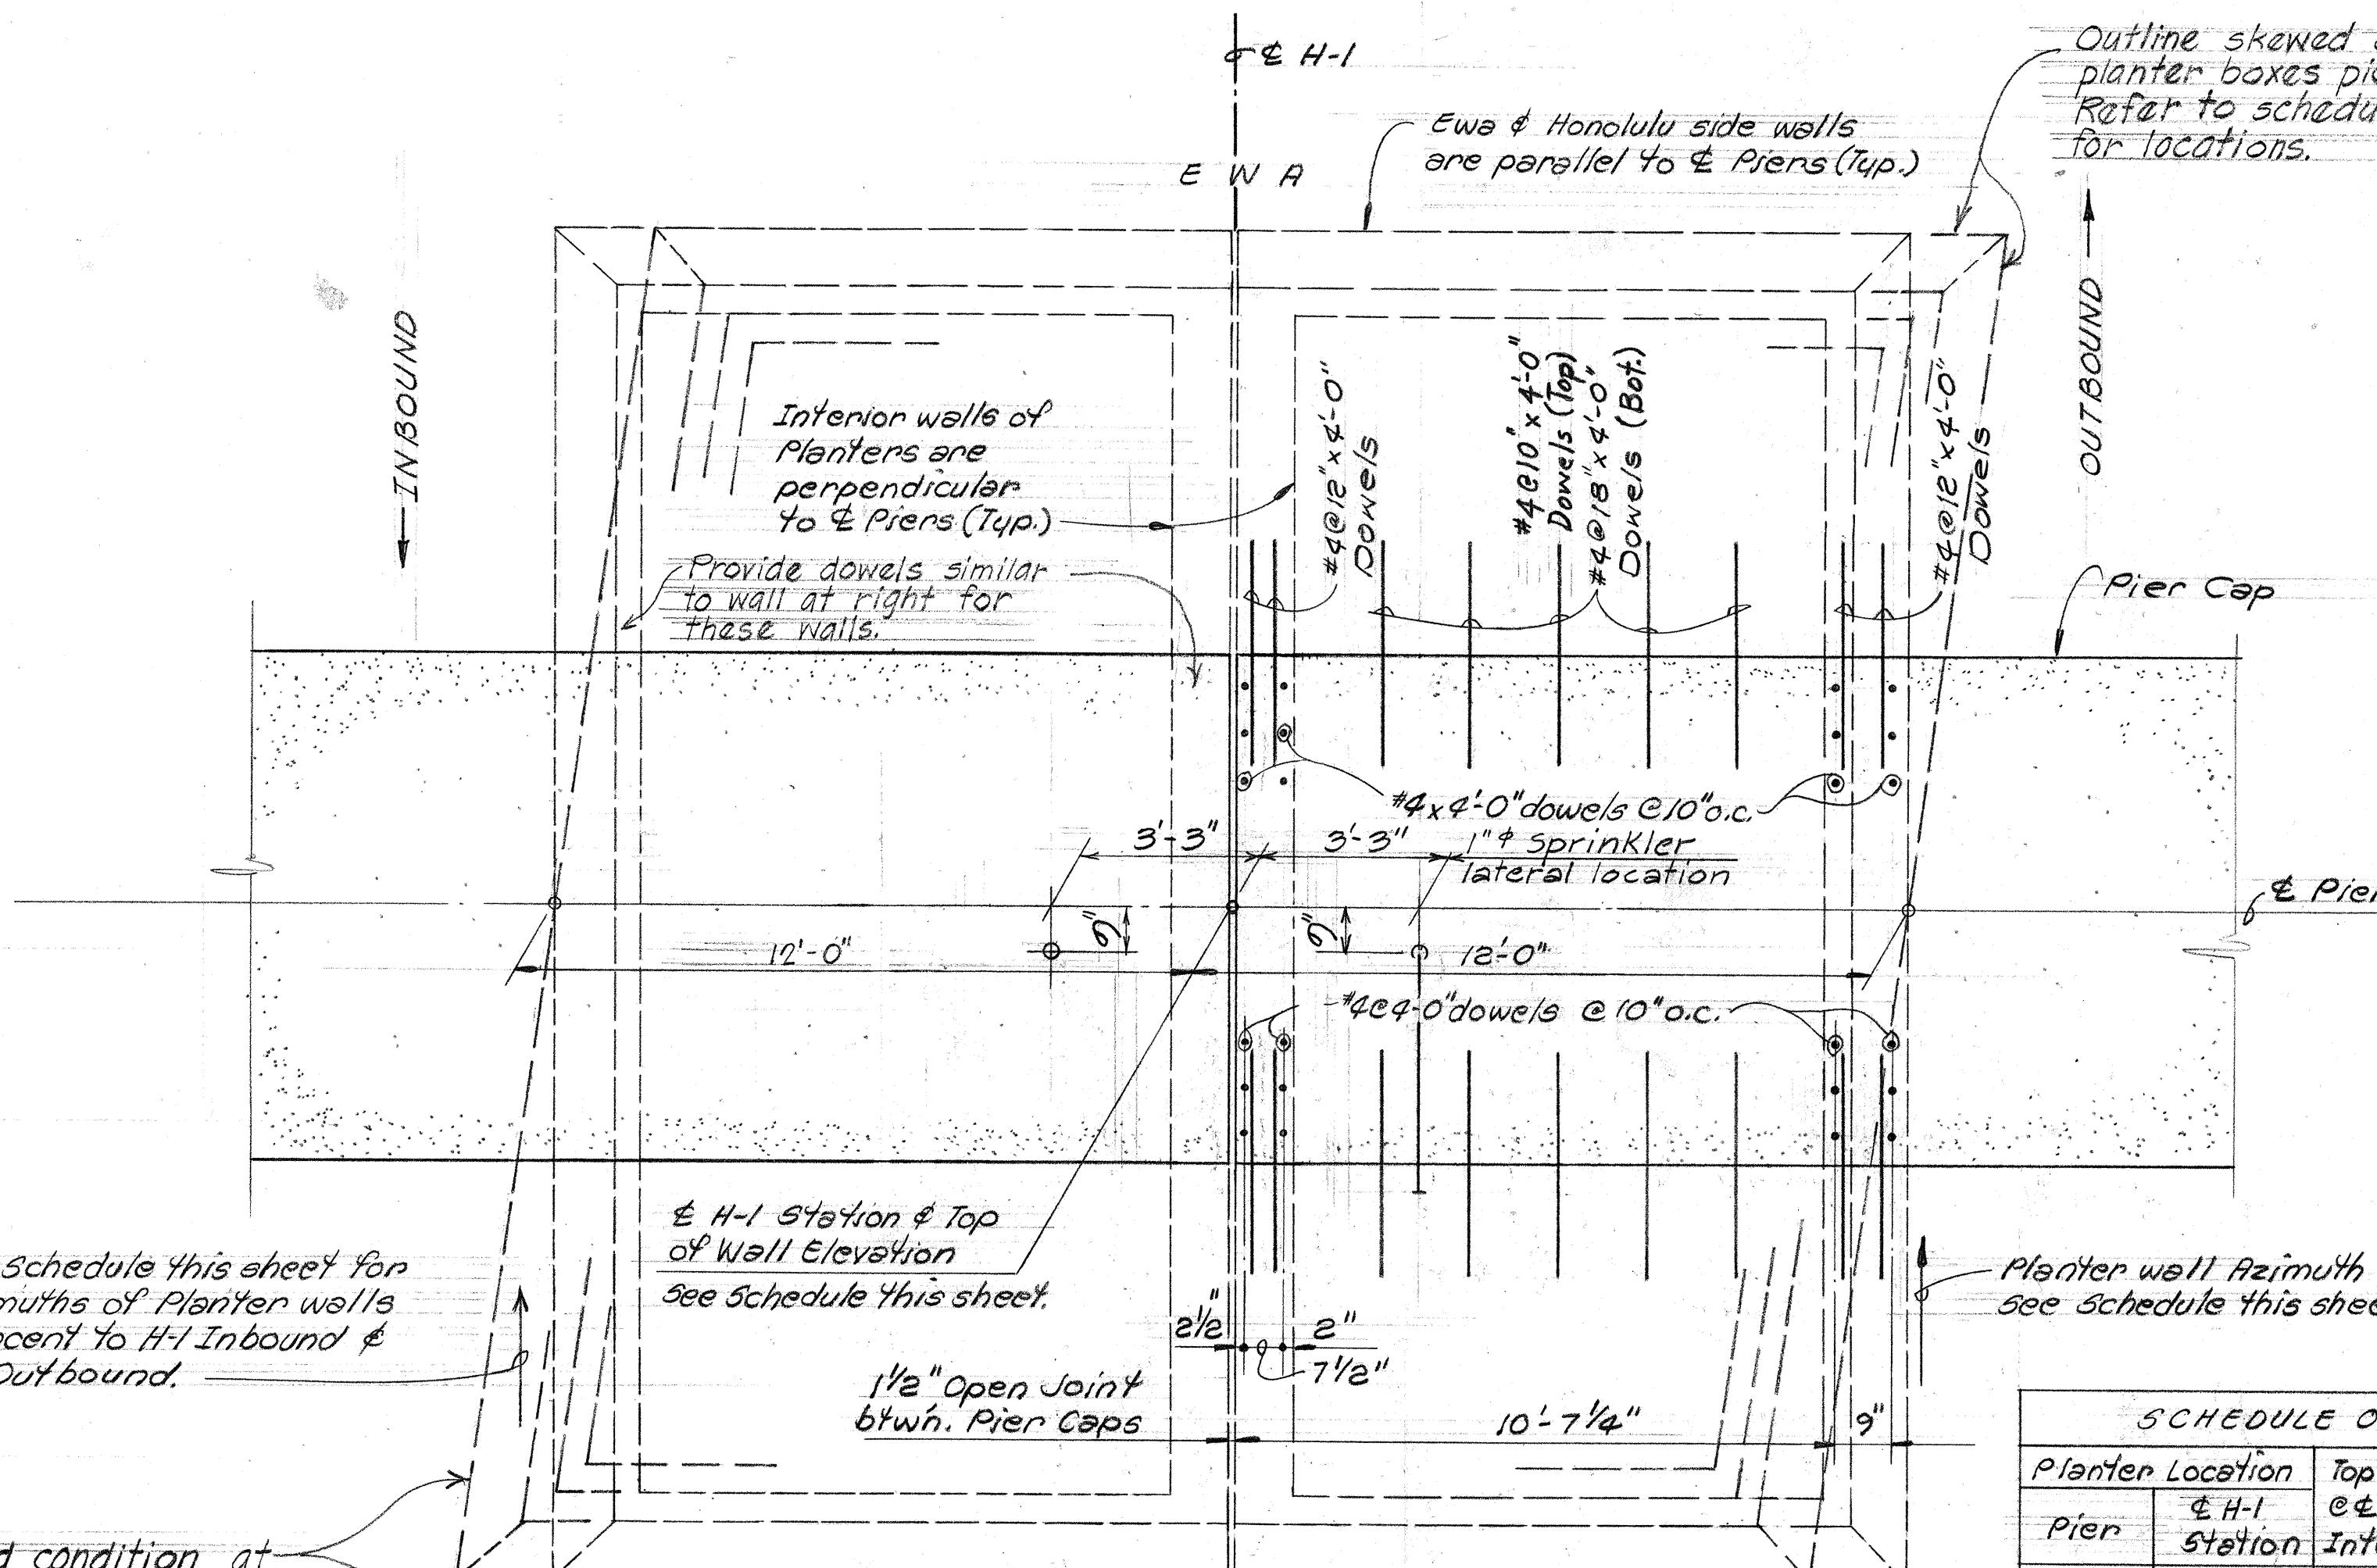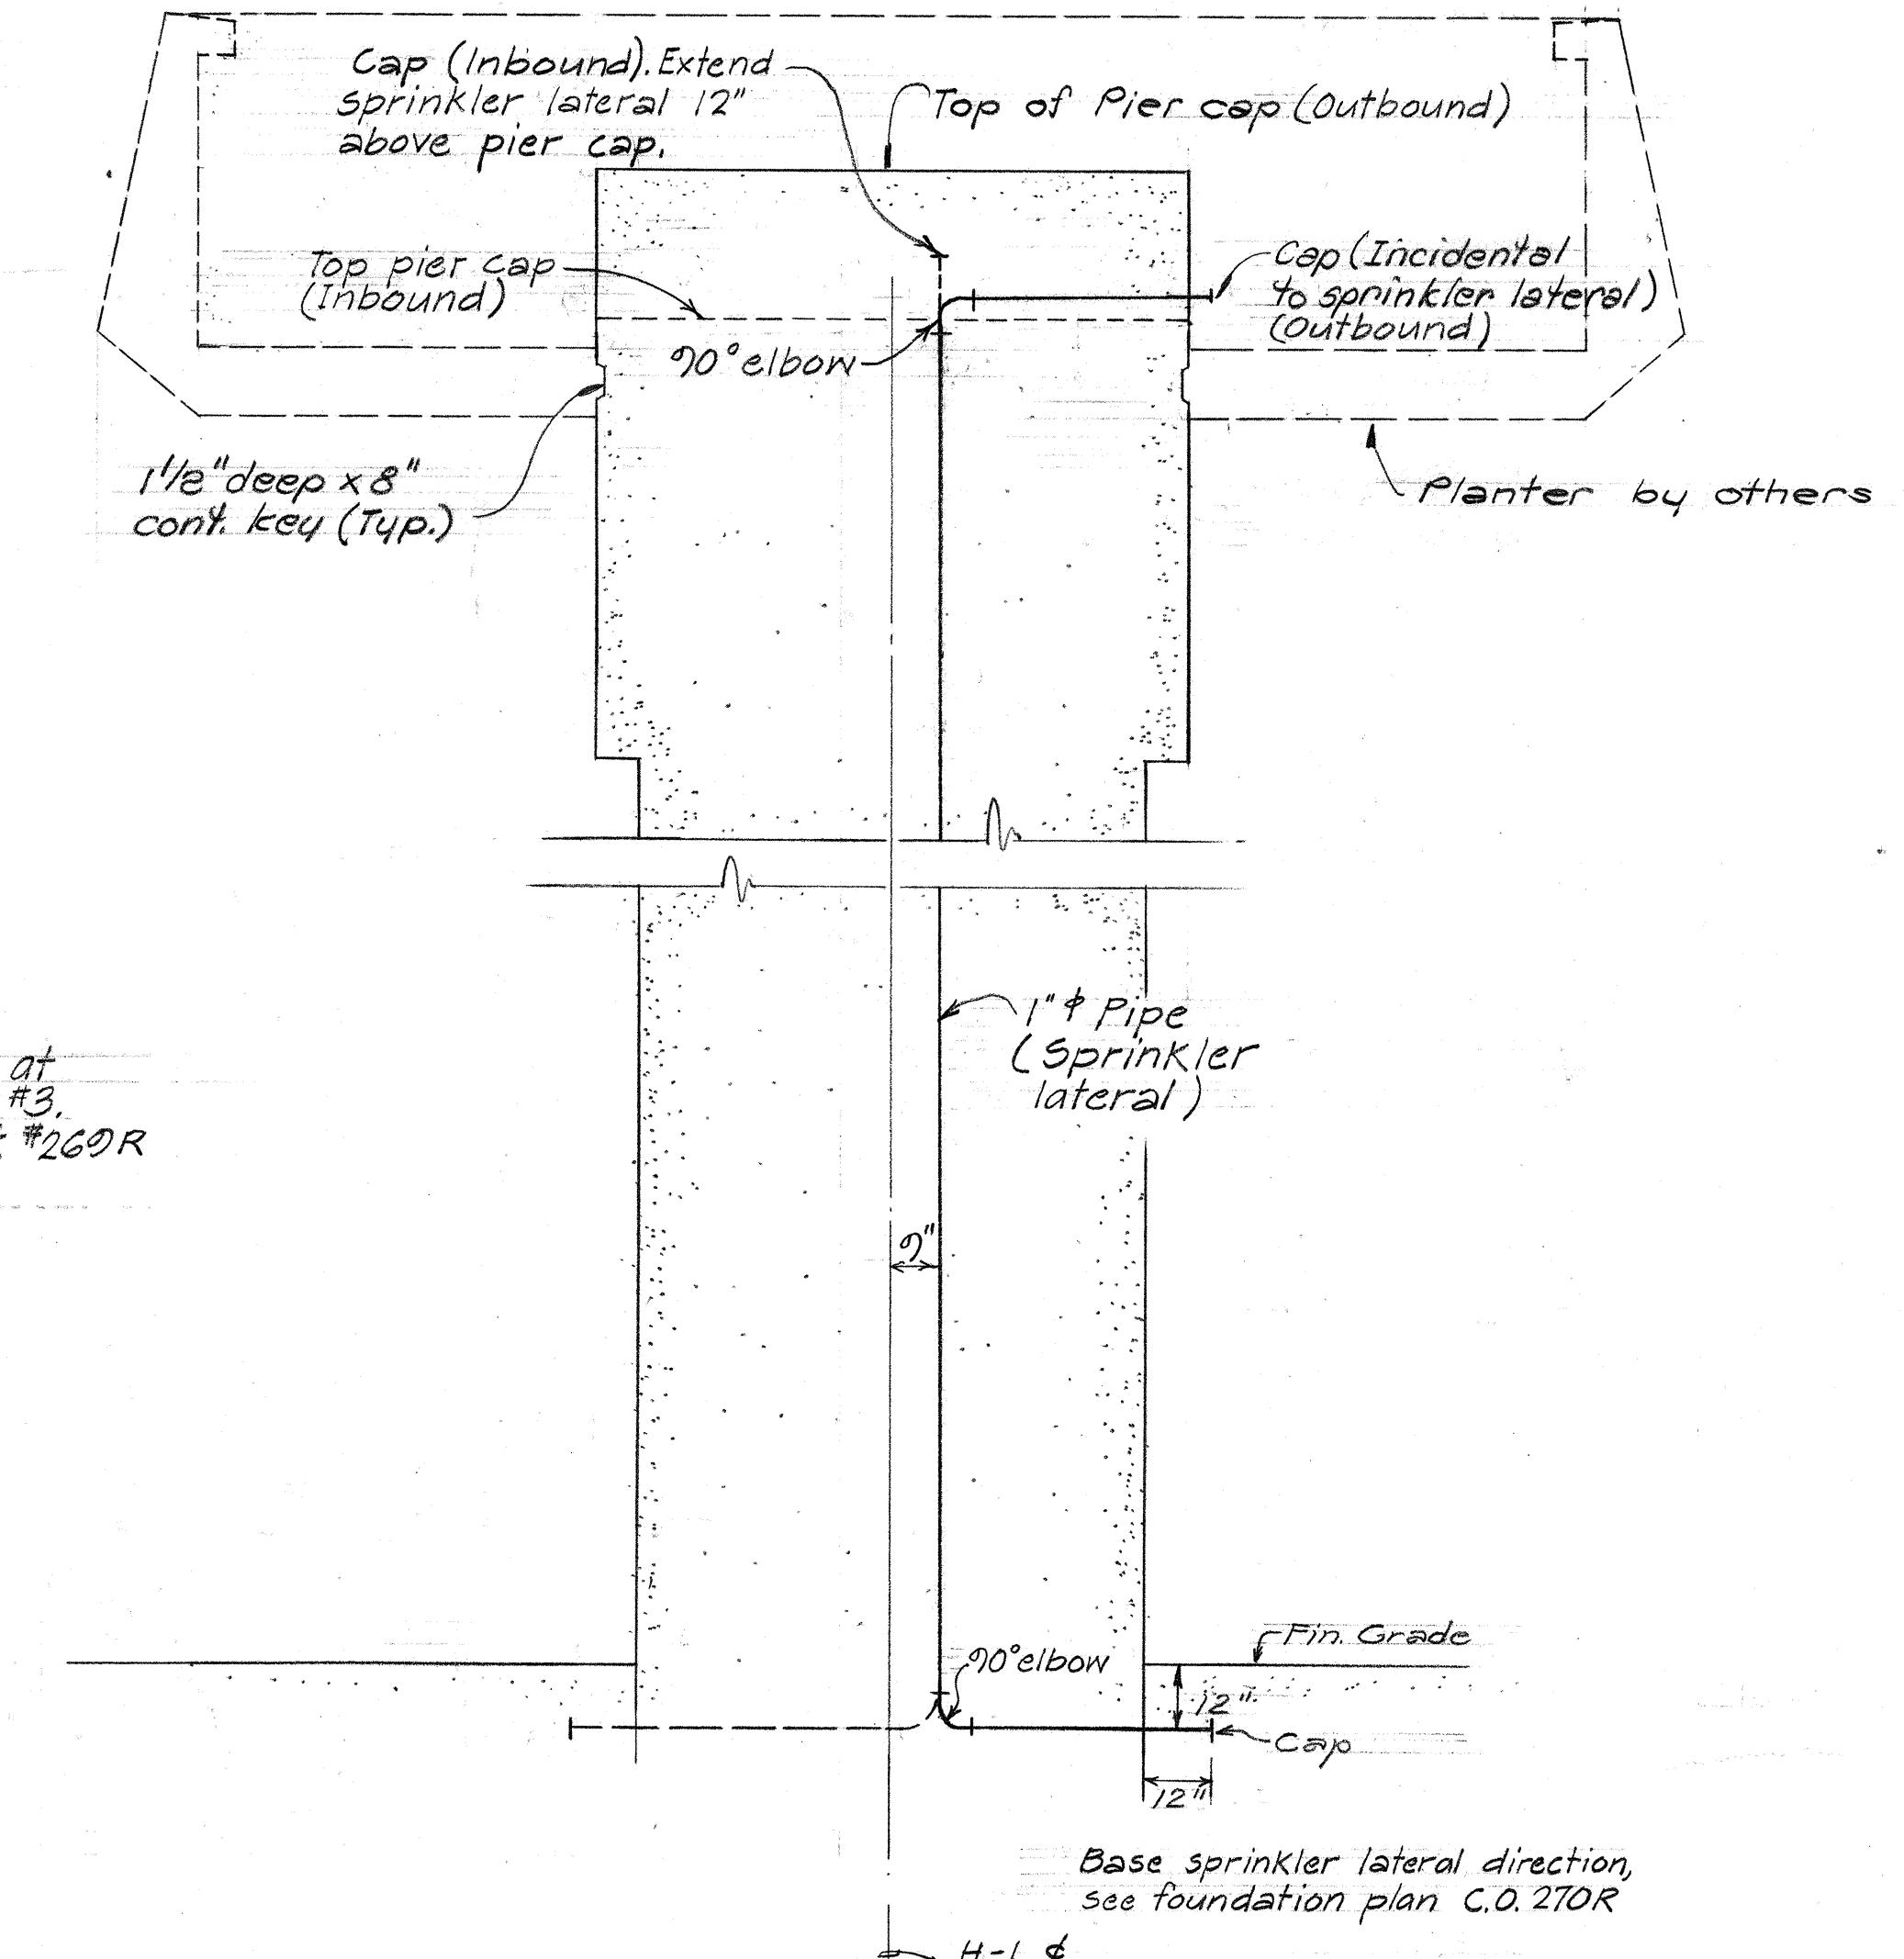

Note: Reference C.C.O. #64

PLAN - PLANTER BOX PIER #4 AS SHOWN

PLANTER BOX PIER #1, #2, #3 SIMILAR EXCEPT AS OTHERWISE NOTED



Scale: 3/8" = 1'-0"

SPRINKLER LINE LAYOUT FOR FUTURE PLANTER N.T.S.

Note: E 3 Denotes changes to C.O. 296R

SCHEDULE OF ELEVATIONS & AZIMUTHS			
Pier	E H-1 Station	Top of Planter Elev.	Wall Azimuths
#1	112+47	66.28	126°59'00" 127°13'11"
#2	113+45	66.34	125°06'44" 125°20'51"
#3	114+00	66.29	123°17'08" 123°32'44"
#4	115+30	66.16	121°42'00" 121°42'00"

SHIMAZU SHIMABUKURO & FUKUDA, INC.
Consulting Structural Engineers
1210 Ward Ave., Honolulu, HI 96810

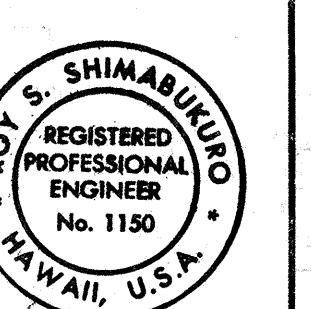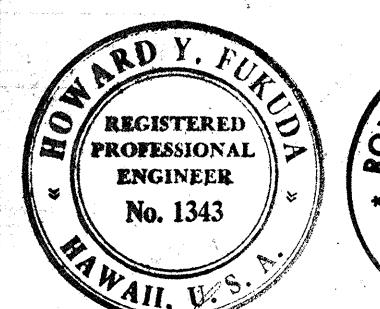

4/25/75 REVISE SPRINKLER LATERAL & PLANTER BOX FLOOR DRAIN.
6/3/74 ADDED SCHEDULE OF ELEVATIONS & AZIMUTHS

DATE REVISION

STATE OF HAWAII
DEPARTMENT OF TRANSPORTATION
HIGHWAYS DIVISION

STRUCTURE No. 8
SPRINKLER LINE & REBAR
POWEL LAYOUT FOR FUTURE
PLANTER BOX

PEARL HARBOR INTERCHANGE
F.A.I. Proj. No. I-HI-1(73)-15

THIS WORK WAS PREPARED BY ME
OR UNDER MY SUPERVISION

Scale: As shown Date: DEC. 7, 1973
SHEET NO. 5-800 OF 106 SHEETS

C0 296R

