Success Succes S	DEX TO DRAWINGS
SHEET NO.	DESCRIPTION
	TITLE SHEET
The control of the co	PLAN AND PROFILE
	DRAINAGE DETAILS
4-5	STANDARD DETAILS
	•
Media francia de la fire prima en empresa de sua madrimo de en distribución por la sustama secuminada en, in asparan	
And the second second of the State Control of the second control of the second control of the second	



STATE

TRANSPORTATION HIGHWAYS DIVISION


HONOLULU, HAWAII

"AS BUILT"


IMPROVEMENTS DRAINAGE ON

KAMEHAMEHA HIGHWAY (Waimano Home Road To Waiawa Stream) Project No. 99C-01-72

> DISTRICT OF EWA ISLAND OF OAHU

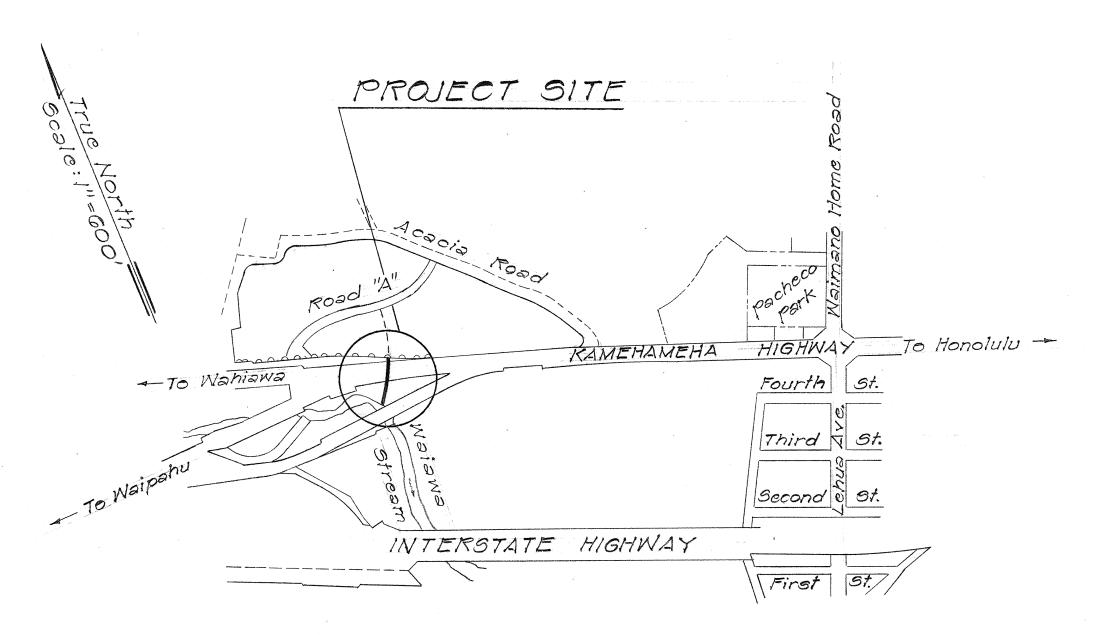

LOCATION MAP

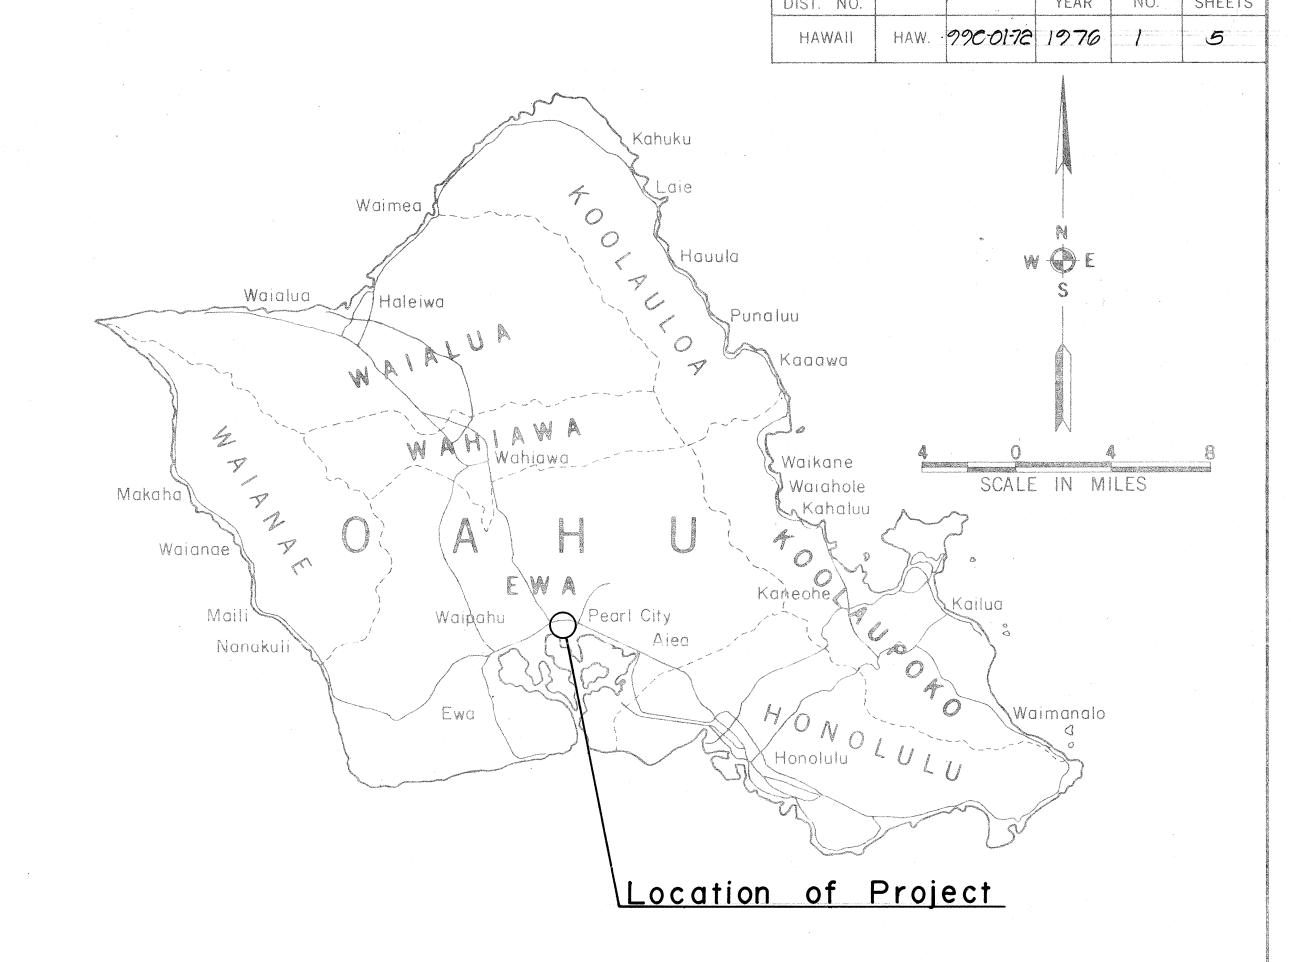

NOTE:

ALL CHANGES MADE DURING CONSTRUCTION HAVE BEEN INCORPORATED ON THESE PLANS IN RED EXCEPT CHANGES IN THE ORIGINAL THEORETICAL QUANTITIES.

9-16-77

DEPARTMENT OF TRANSPORTATION STATE OF HAWAII APPROVED:

FOR DIR. OF TRANSPORTATION