IN	DEX TO DRAWINGS
SHEET NO.	DESCRIPTION
1	Title Sheet
2	Legend & Const. notes
3-4	Plan, Traffic Signal System,
	Signing, Pavement Markings
	and Details
5-6	Typical Details - Traffic Signal
	System
7	Typical Details - Pullboxes
8 -11	Standard Details
	•
•	



STATE OF HAWAII

DEPARTMENT OF TRANSPORTATION HIGHWAYS DIVISION

HONOLULU, HAWAII

"AS BUILT"

PLANS FOR

CONSTRUCTION OF


TRAFFIC SIGNAL IMPROVEMENTS

Kamehameha Highway and Waipahu Street


FEDERAL AID PROJ. NO. HHS-099-1(5)

SCALE: PLAN I in. = 20 Ft.

DISTRICT OF EWA ISLAND OF OAHU

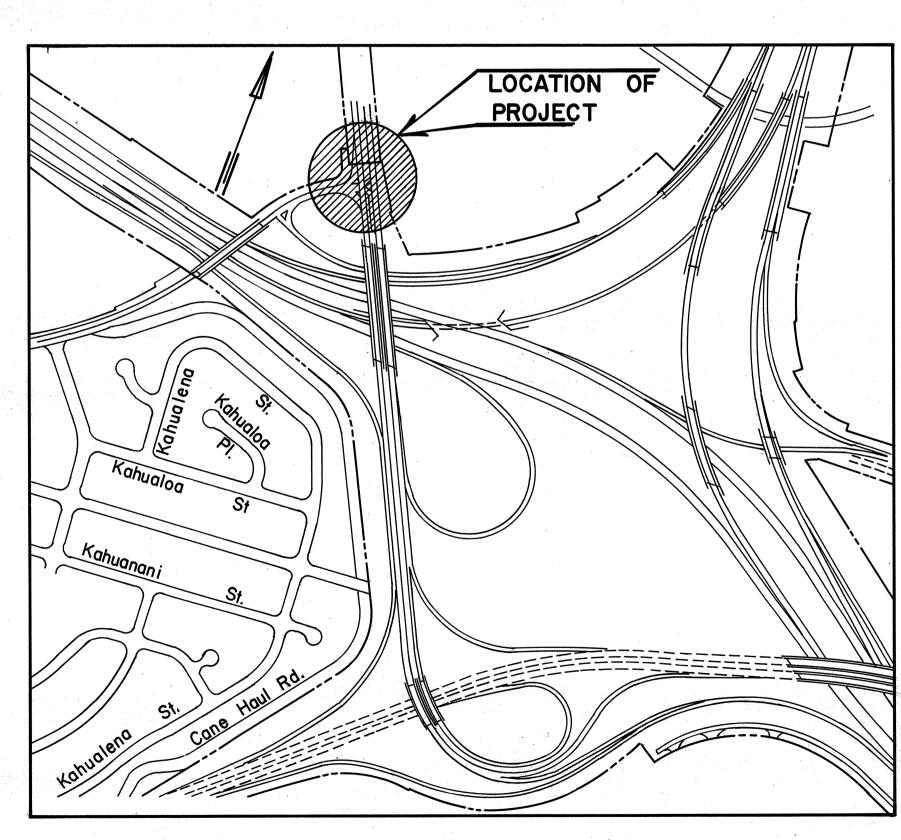

GENERAL LAYOUT PLAN GRAPHIC SCALE IN FEET

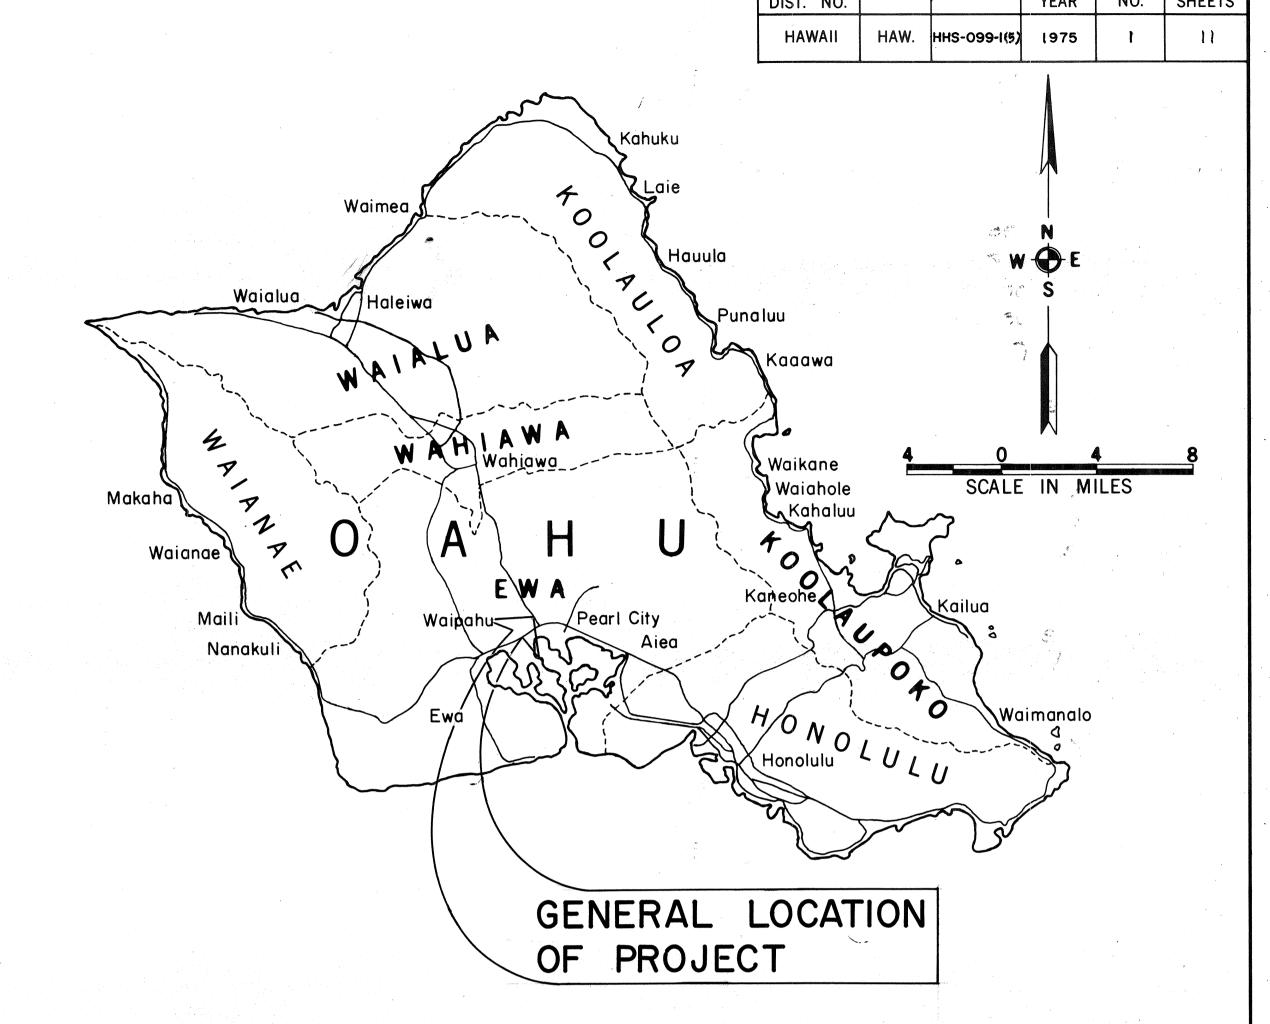

NOTE:

ALL CHANGES MADE DURING CONSTRUCTION HAVE BEEN INCORPORATED ON THESE PLANS EXCEPT CHANGES IN THE ORIGINAL THEORE-TICAL QUANTITIES.

PROJECT ENGINEER

8-23-77 DATE

> DEPARTMENT OF TRANSPORTATION FEDERAL HIGHWAY ADMINSTRATION DIVISION ENGINEER DATE

DEPARTMENT OF TRANSPORTATION STATE OF HAWAII 10-6-15

CLASSIFICATION

CURRANT ADT (1975) - - - - - - - - - - - - 21,000

FUTURE ADT (1995) - - - - - - - 18,000