



FED. ROAD DIST. NO.	STATE	PROJ. NO.	FISCAL YEAR	SHEET NO.	TOTAL SHEETS
HAWAII	HAW.	90BC-01-76M	1976	2	10

NOTES:


1. The depth of excavation for reconstruction shall be the reconstructed thickness minus the overlay thickness as designated on the plans. The excavated areas shall be reconstructed with Plant Mix Asphalt Treated Base Course prior to resurfacing. The reconstructed thickness shall be 12 inches.

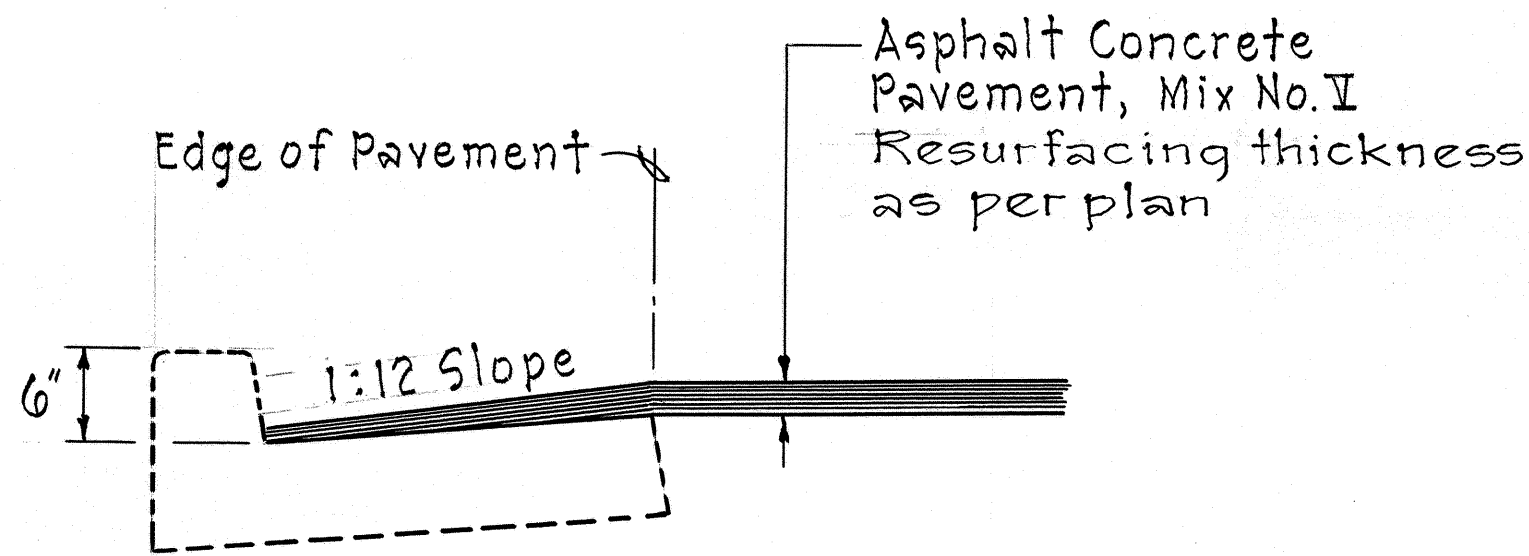


CURB AND GUTTER SECTION

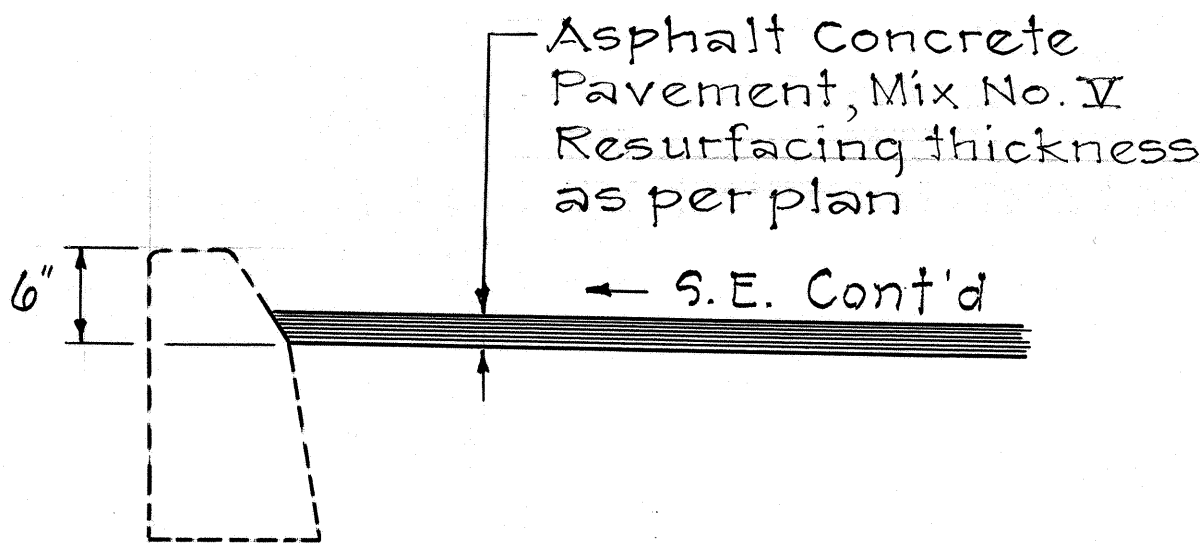


MEDIAN CURB SECTION

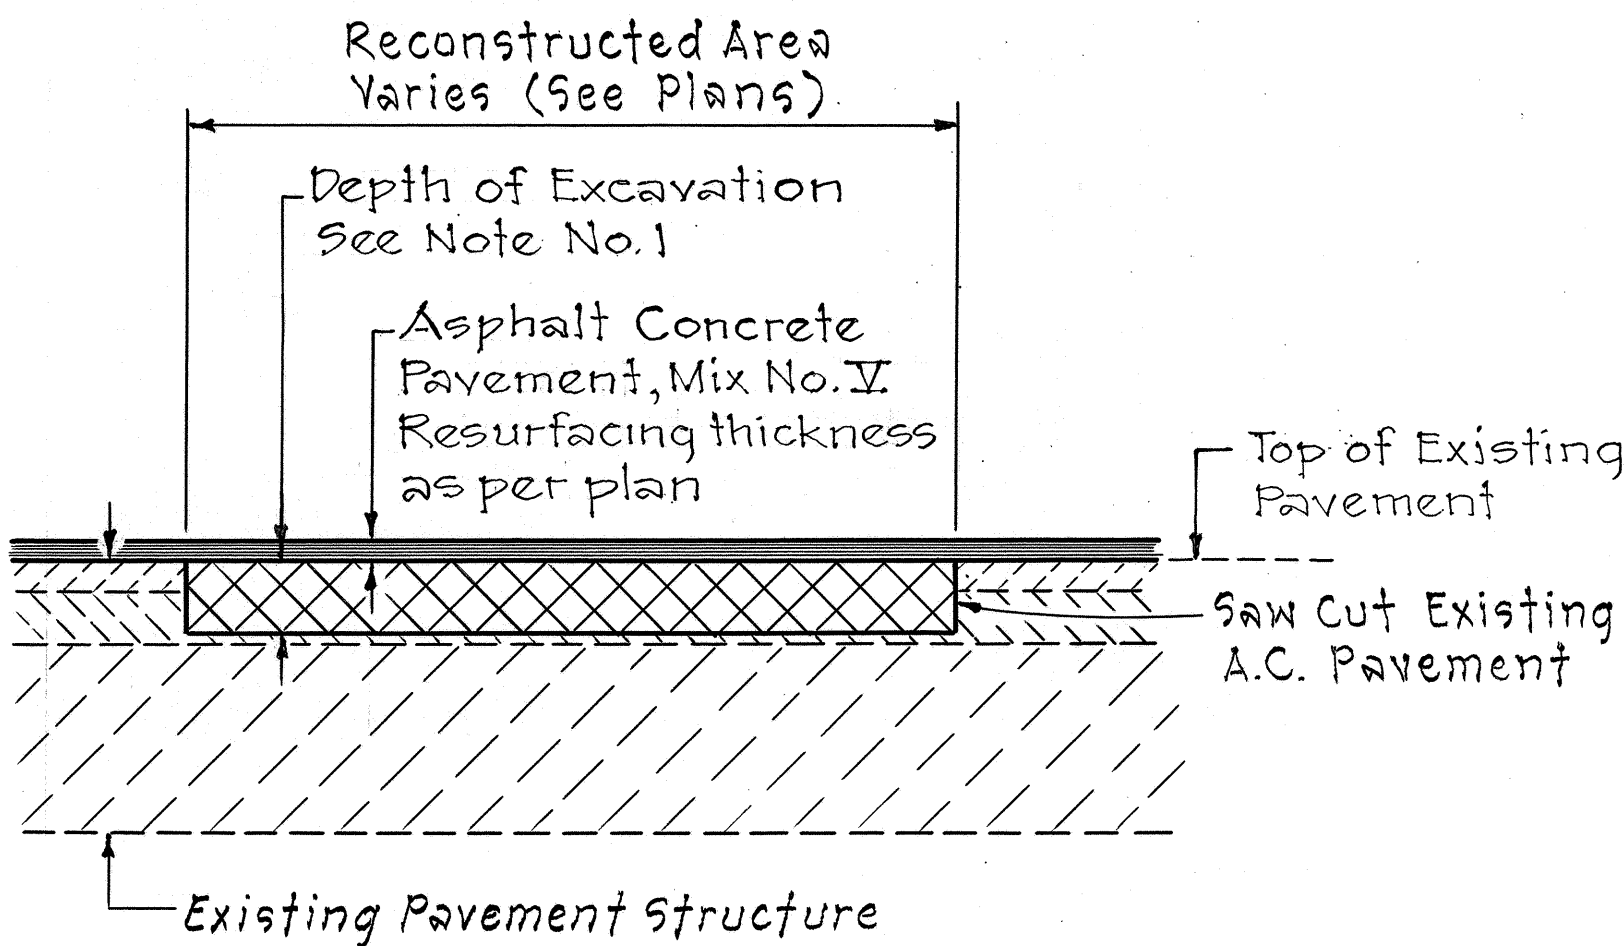


RECONSTRUCTED PAVEMENT SECTION

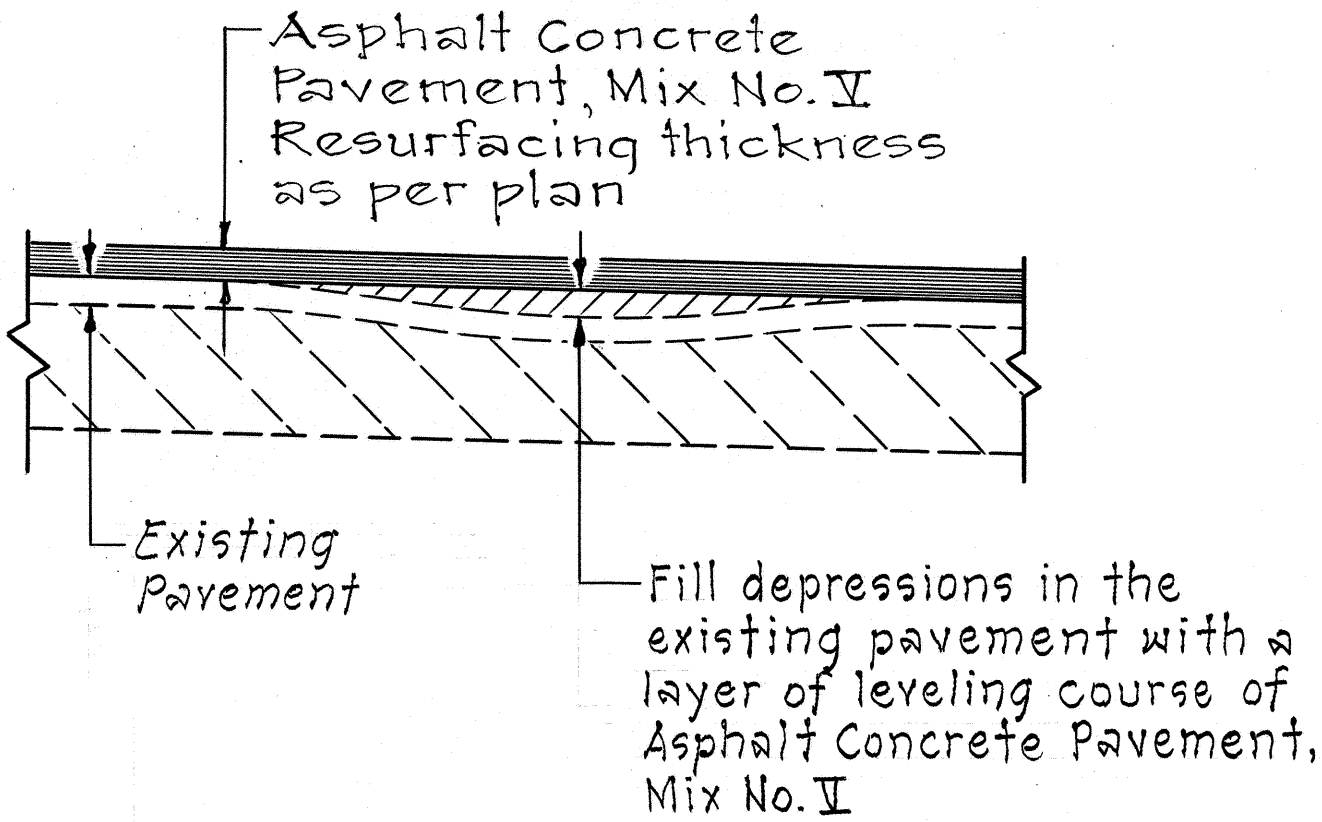

LEVELING COURSE DETAIL

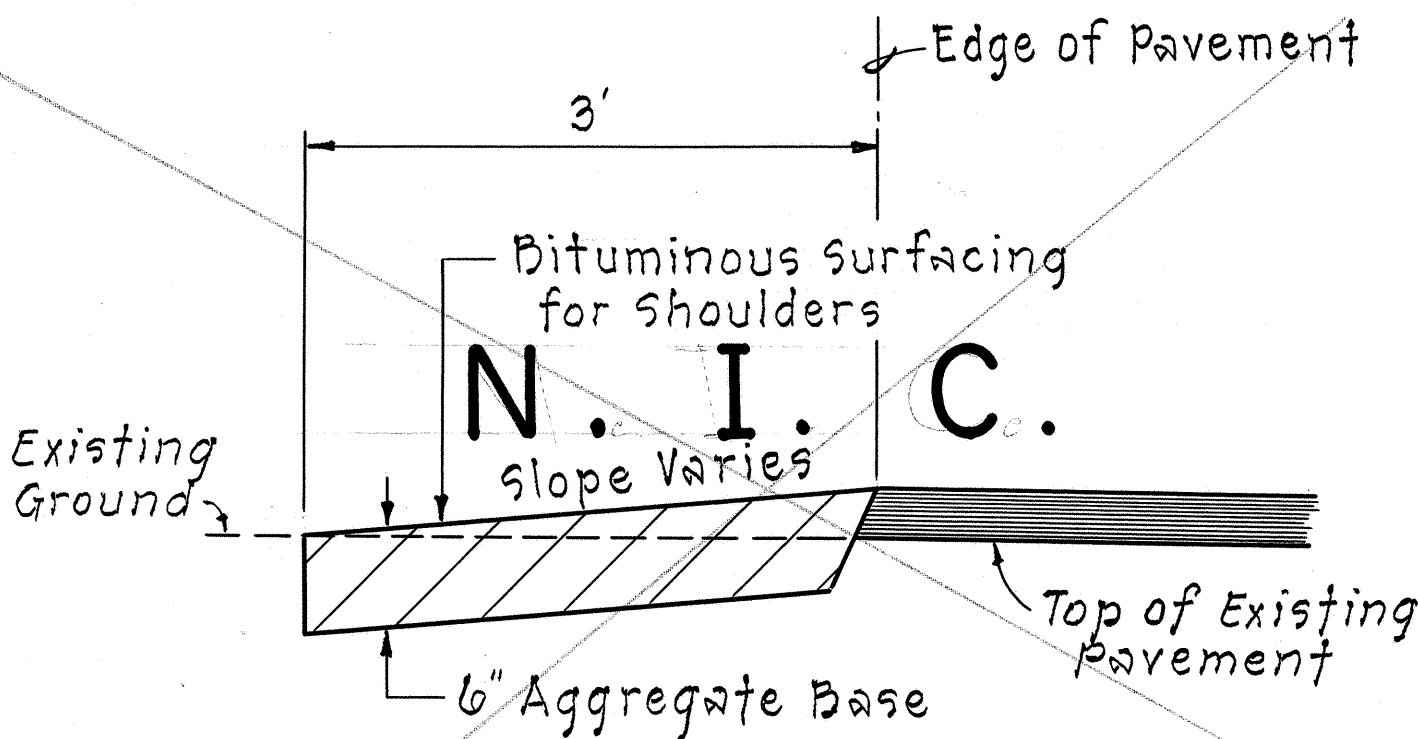

BITUMINOUS SHOULDER SECTION

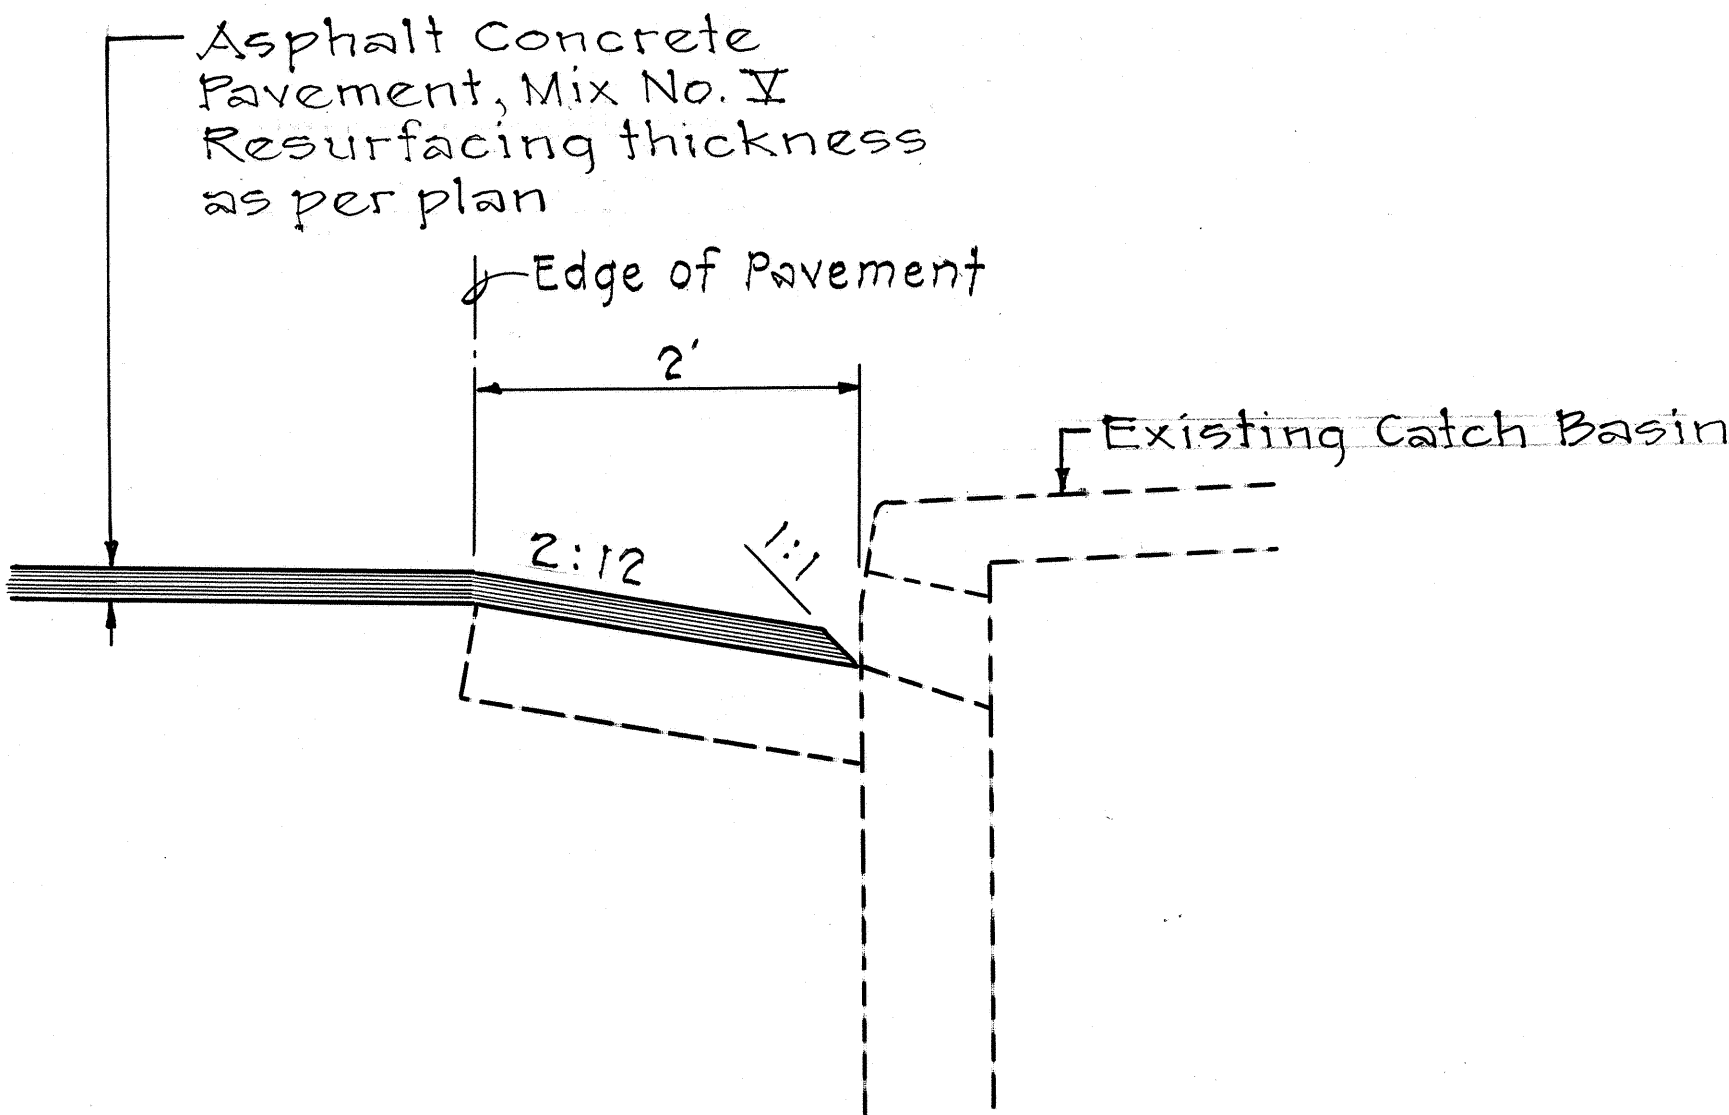

CATCH BASIN SECTION

STATE OF HAWAII
DEPARTMENT OF TRANSPORTATION
HIGHWAYS DIVISION

TYPICAL SECTIONS
KAMEHAMEHA HIGHWAY RESURFACING
HALAWA STREAM TO HEKAHA STREET
PROJECT NO. 90BC-01-76M
Not to Scale
SHEET No. 1 OF 1 SHEETS

SURVEY PLOTTED BY	DATE
DRAWN BY	
DESIGNED BY	
NOTED BY	
CHECKED BY	
ORIGINAL PLAN	
NOTE BOOK	
No.	