


| FED. ROAD DIST. NO. | STATE | PROJ. NO.  | FISCAL YEAR | SHEET NO. | TOTAL SHEETS |
|---------------------|-------|------------|-------------|-----------|--------------|
| HAWAII              | HAW.  | 20A-01-77M | 1977        | 3R S-1    | 17           |

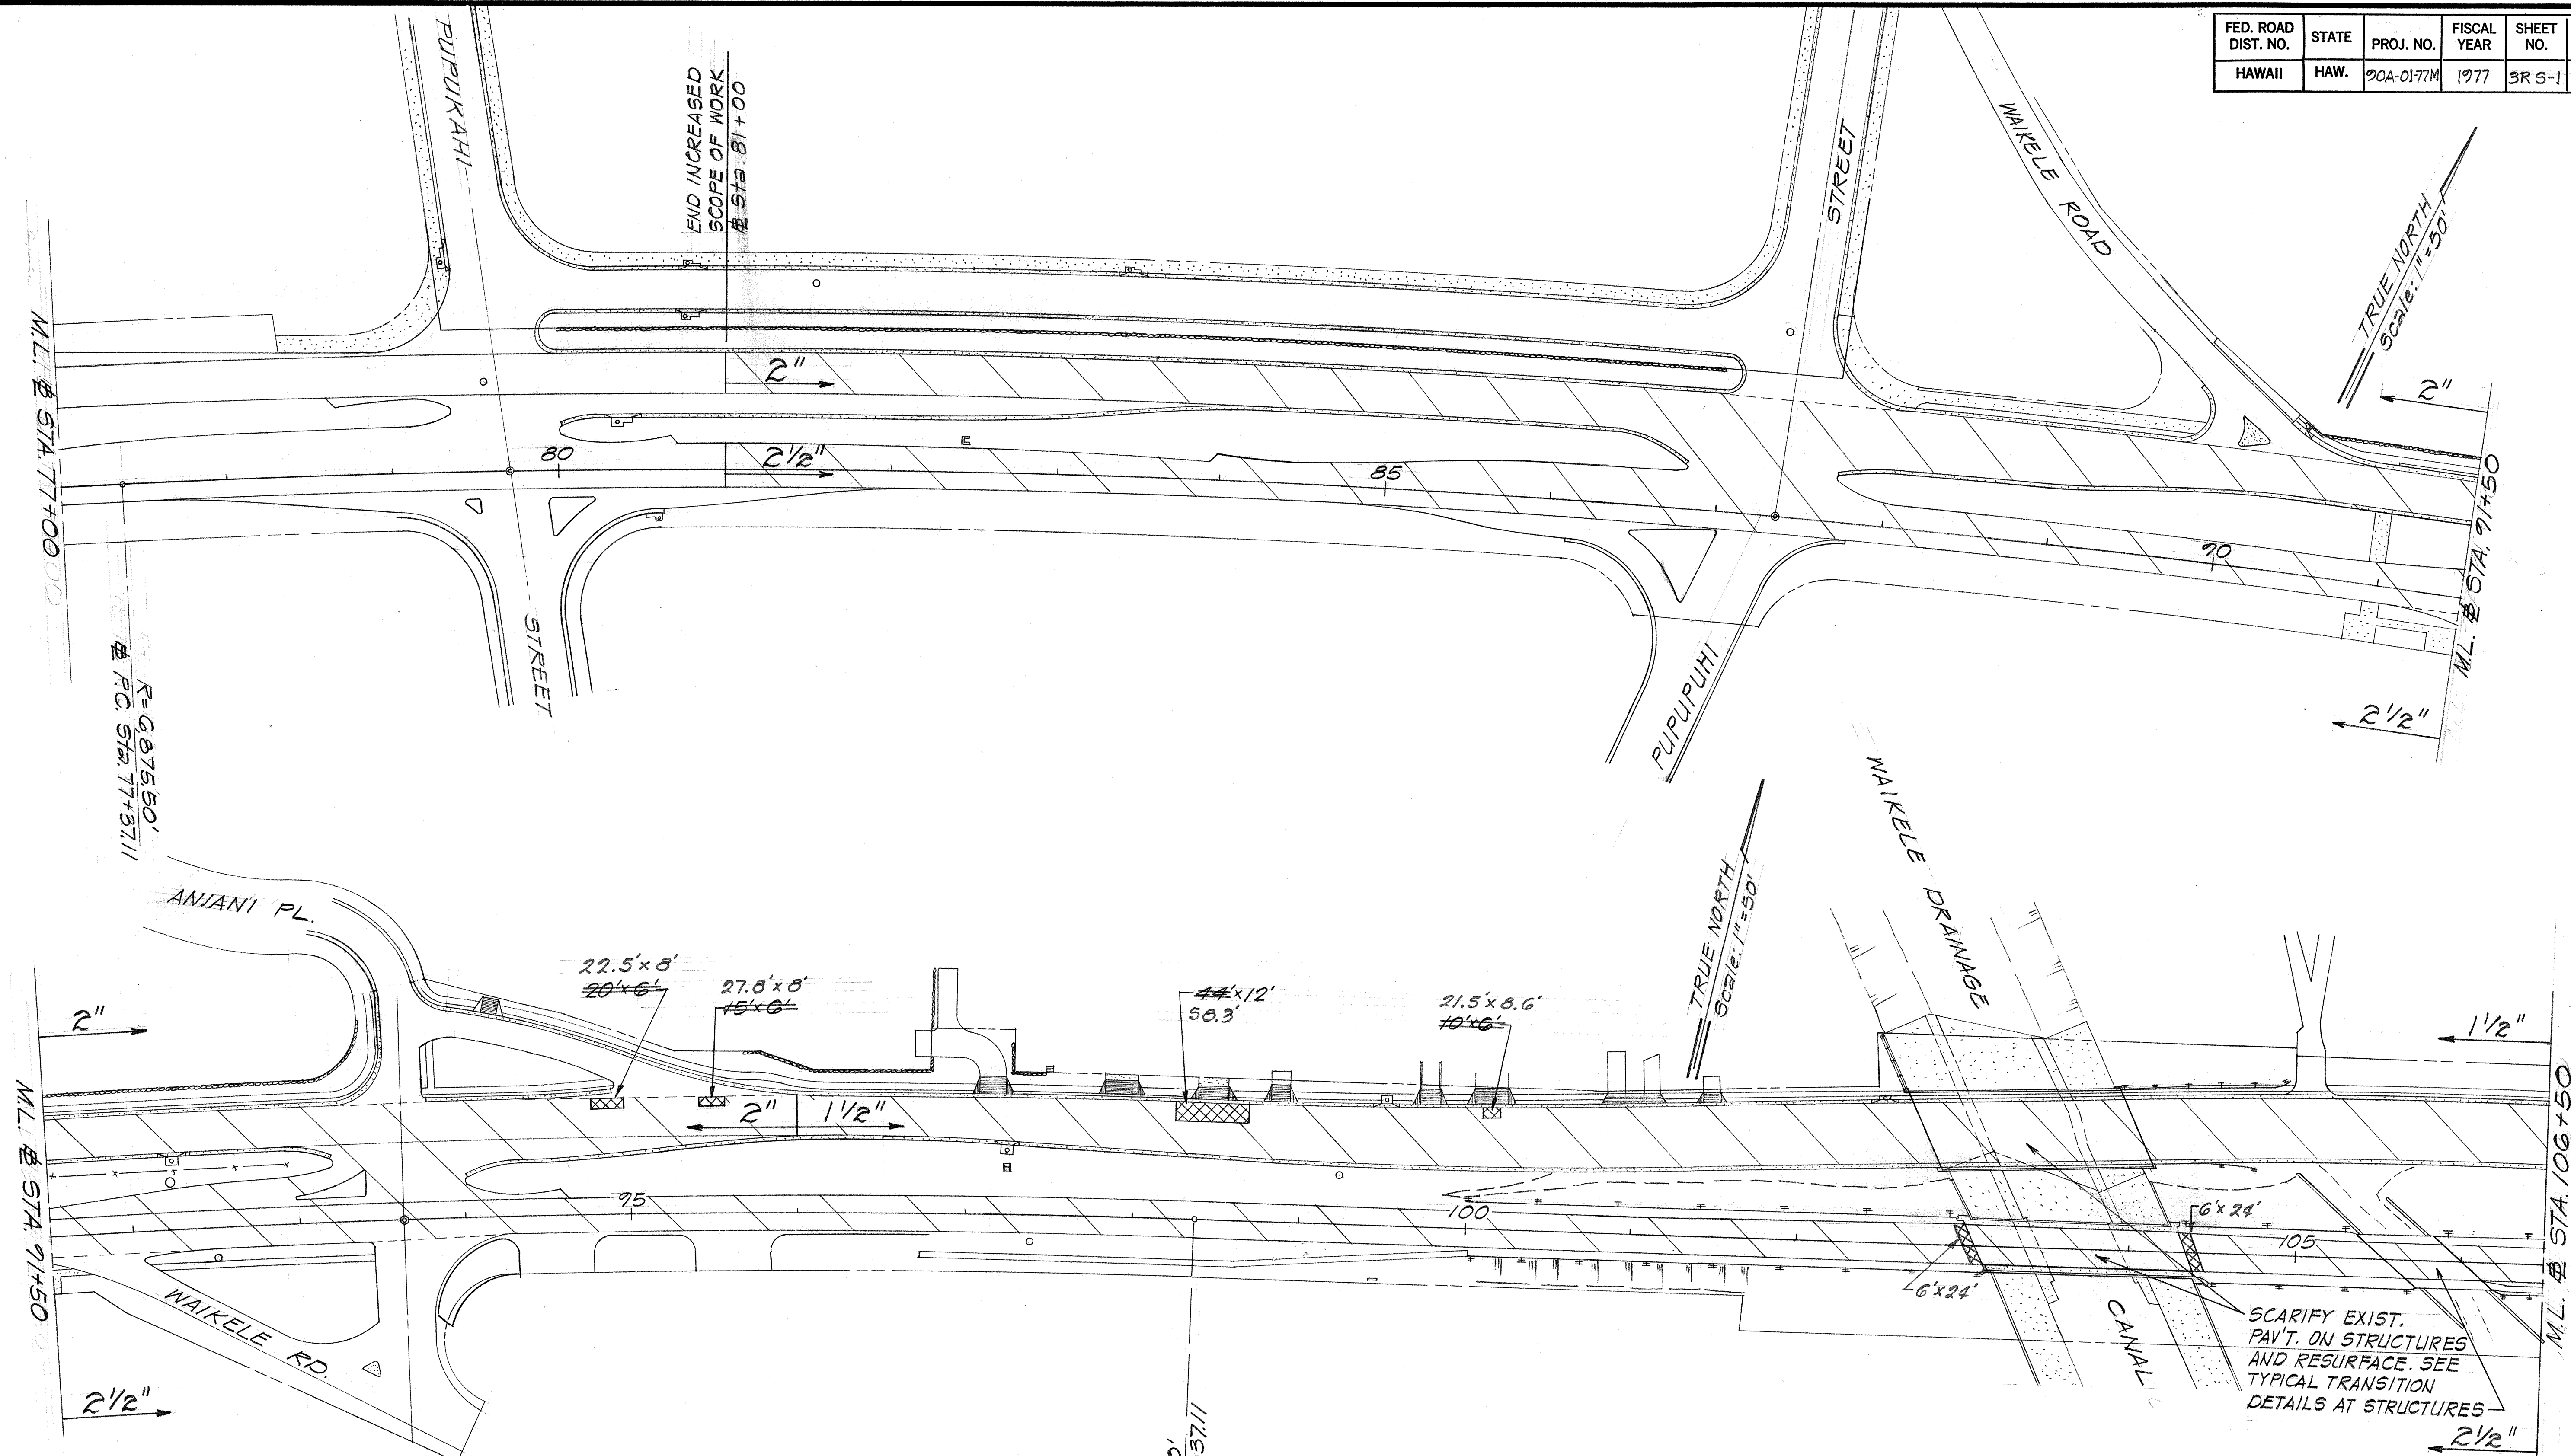

|                   |      |
|-------------------|------|
| ORIGINAL PLAN     | DATE |
| NO.               |      |
| SURVEY PLOTTED BY |      |
| DRAWN BY          |      |
| DESIGNED BY       |      |
| QUANTITIES BY     |      |
| CHECKED BY        |      |

INCREASED SCOPE OF WORK FROM STA. 115+00 BACK TO STA. 81+00 IN ACCORDANCE WITH SUBSECTION 104.09, AVAILABILITY OF FUNDS.

|        |                                                    |
|--------|----------------------------------------------------|
| 7-1-77 | Increased scope of work Sta. 106+50 to Sta. 81+00. |
| DATE   | REVISION                                           |

STATE OF HAWAII  
DEPARTMENT OF TRANSPORTATION  
HIGHWAYS DIVISION



ROADWAY PLANS

FARRINGTON HWY. RESURFACING  
PROJECT NO. 20A-01-77M

Scale: 1"=50' Date: June, 1977

SHEET NO. 1 OF 5 SHEETS

| FED. ROAD DIST. NO. | STATE | PROJ. NO.  | FISCAL YEAR | SHEET NO. | TOTAL SHEETS |
|---------------------|-------|------------|-------------|-----------|--------------|
| HAWAII              | HAW.  | 20A-01-77M | 1977        | 4         | 17           |

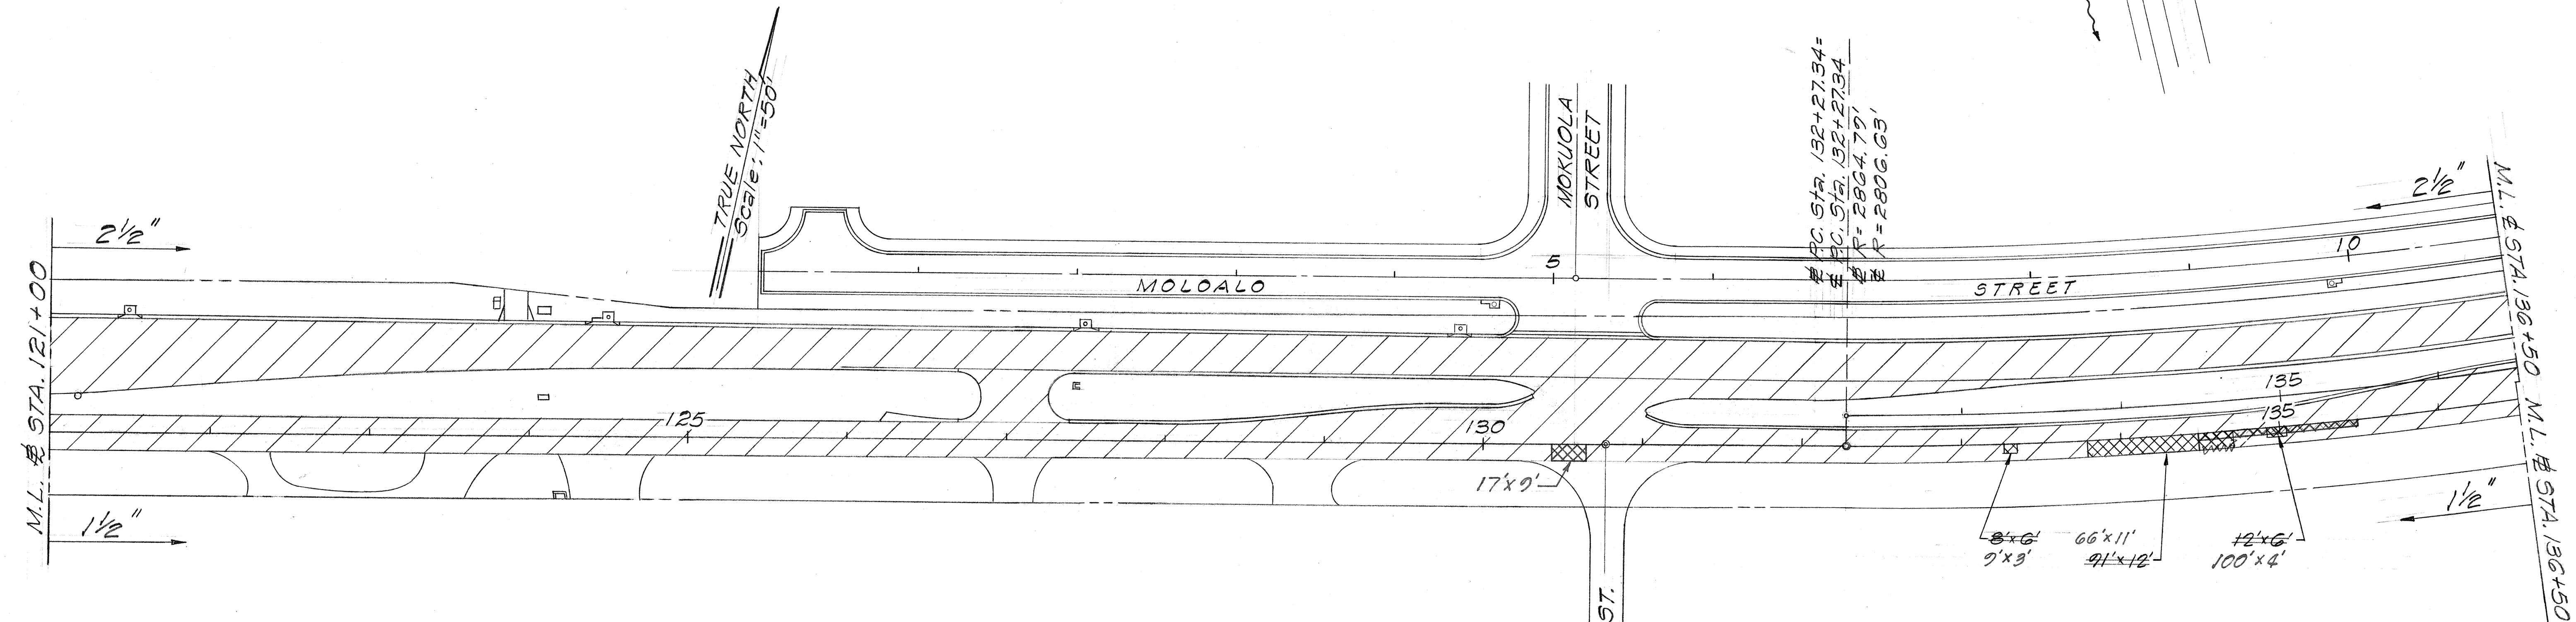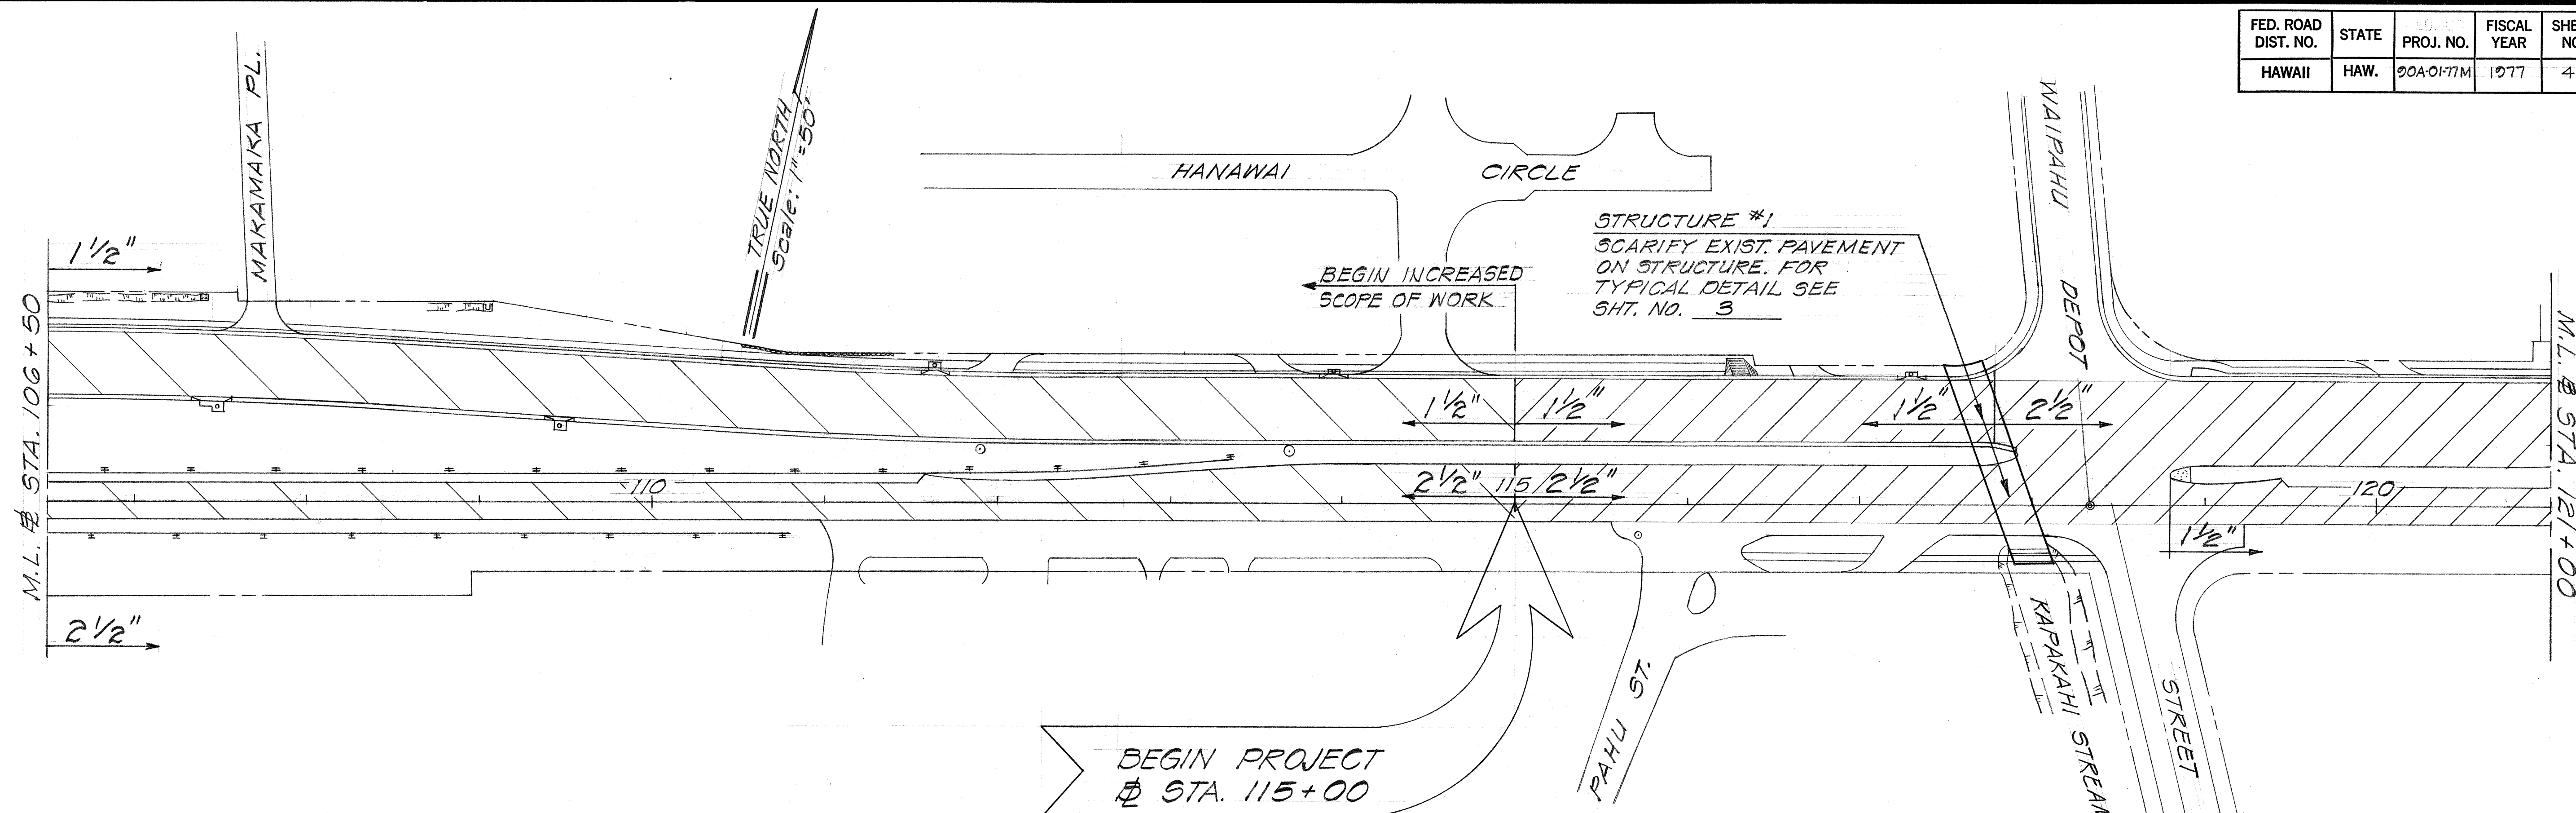

|               |      |
|---------------|------|
| ORIGINAL PLAN | DATE |
| DESIGNED BY   |      |
| TRACED BY     |      |
| NOTED BY      |      |
| CHECKED BY    |      |

|        |                                                     |
|--------|-----------------------------------------------------|
| 7-1-77 | Increased scope of work Sta. 115+00 to Sta. 106+50. |
| DATE   | REVISION                                            |

STATE OF HAWAII  
DEPARTMENT OF TRANSPORTATION  
HIGHWAYS DIVISION


ROADWAY PLANS

FARRINGTON HWY. RESURFACING  
PROJECT NO. 20A-01-77M

Scale: 1"=50' Date: April, 1977

SHEET NO. 13 OF 5 SHEETS

| FED. ROAD DIST. NO. | STATE | PROJ. NO.  | FISCAL YEAR | SHEET NO. | TOTAL SHEETS |
|---------------------|-------|------------|-------------|-----------|--------------|
| HAWAII              | HAW.  | 20A-01-77M | 1977        | 5         | 17           |

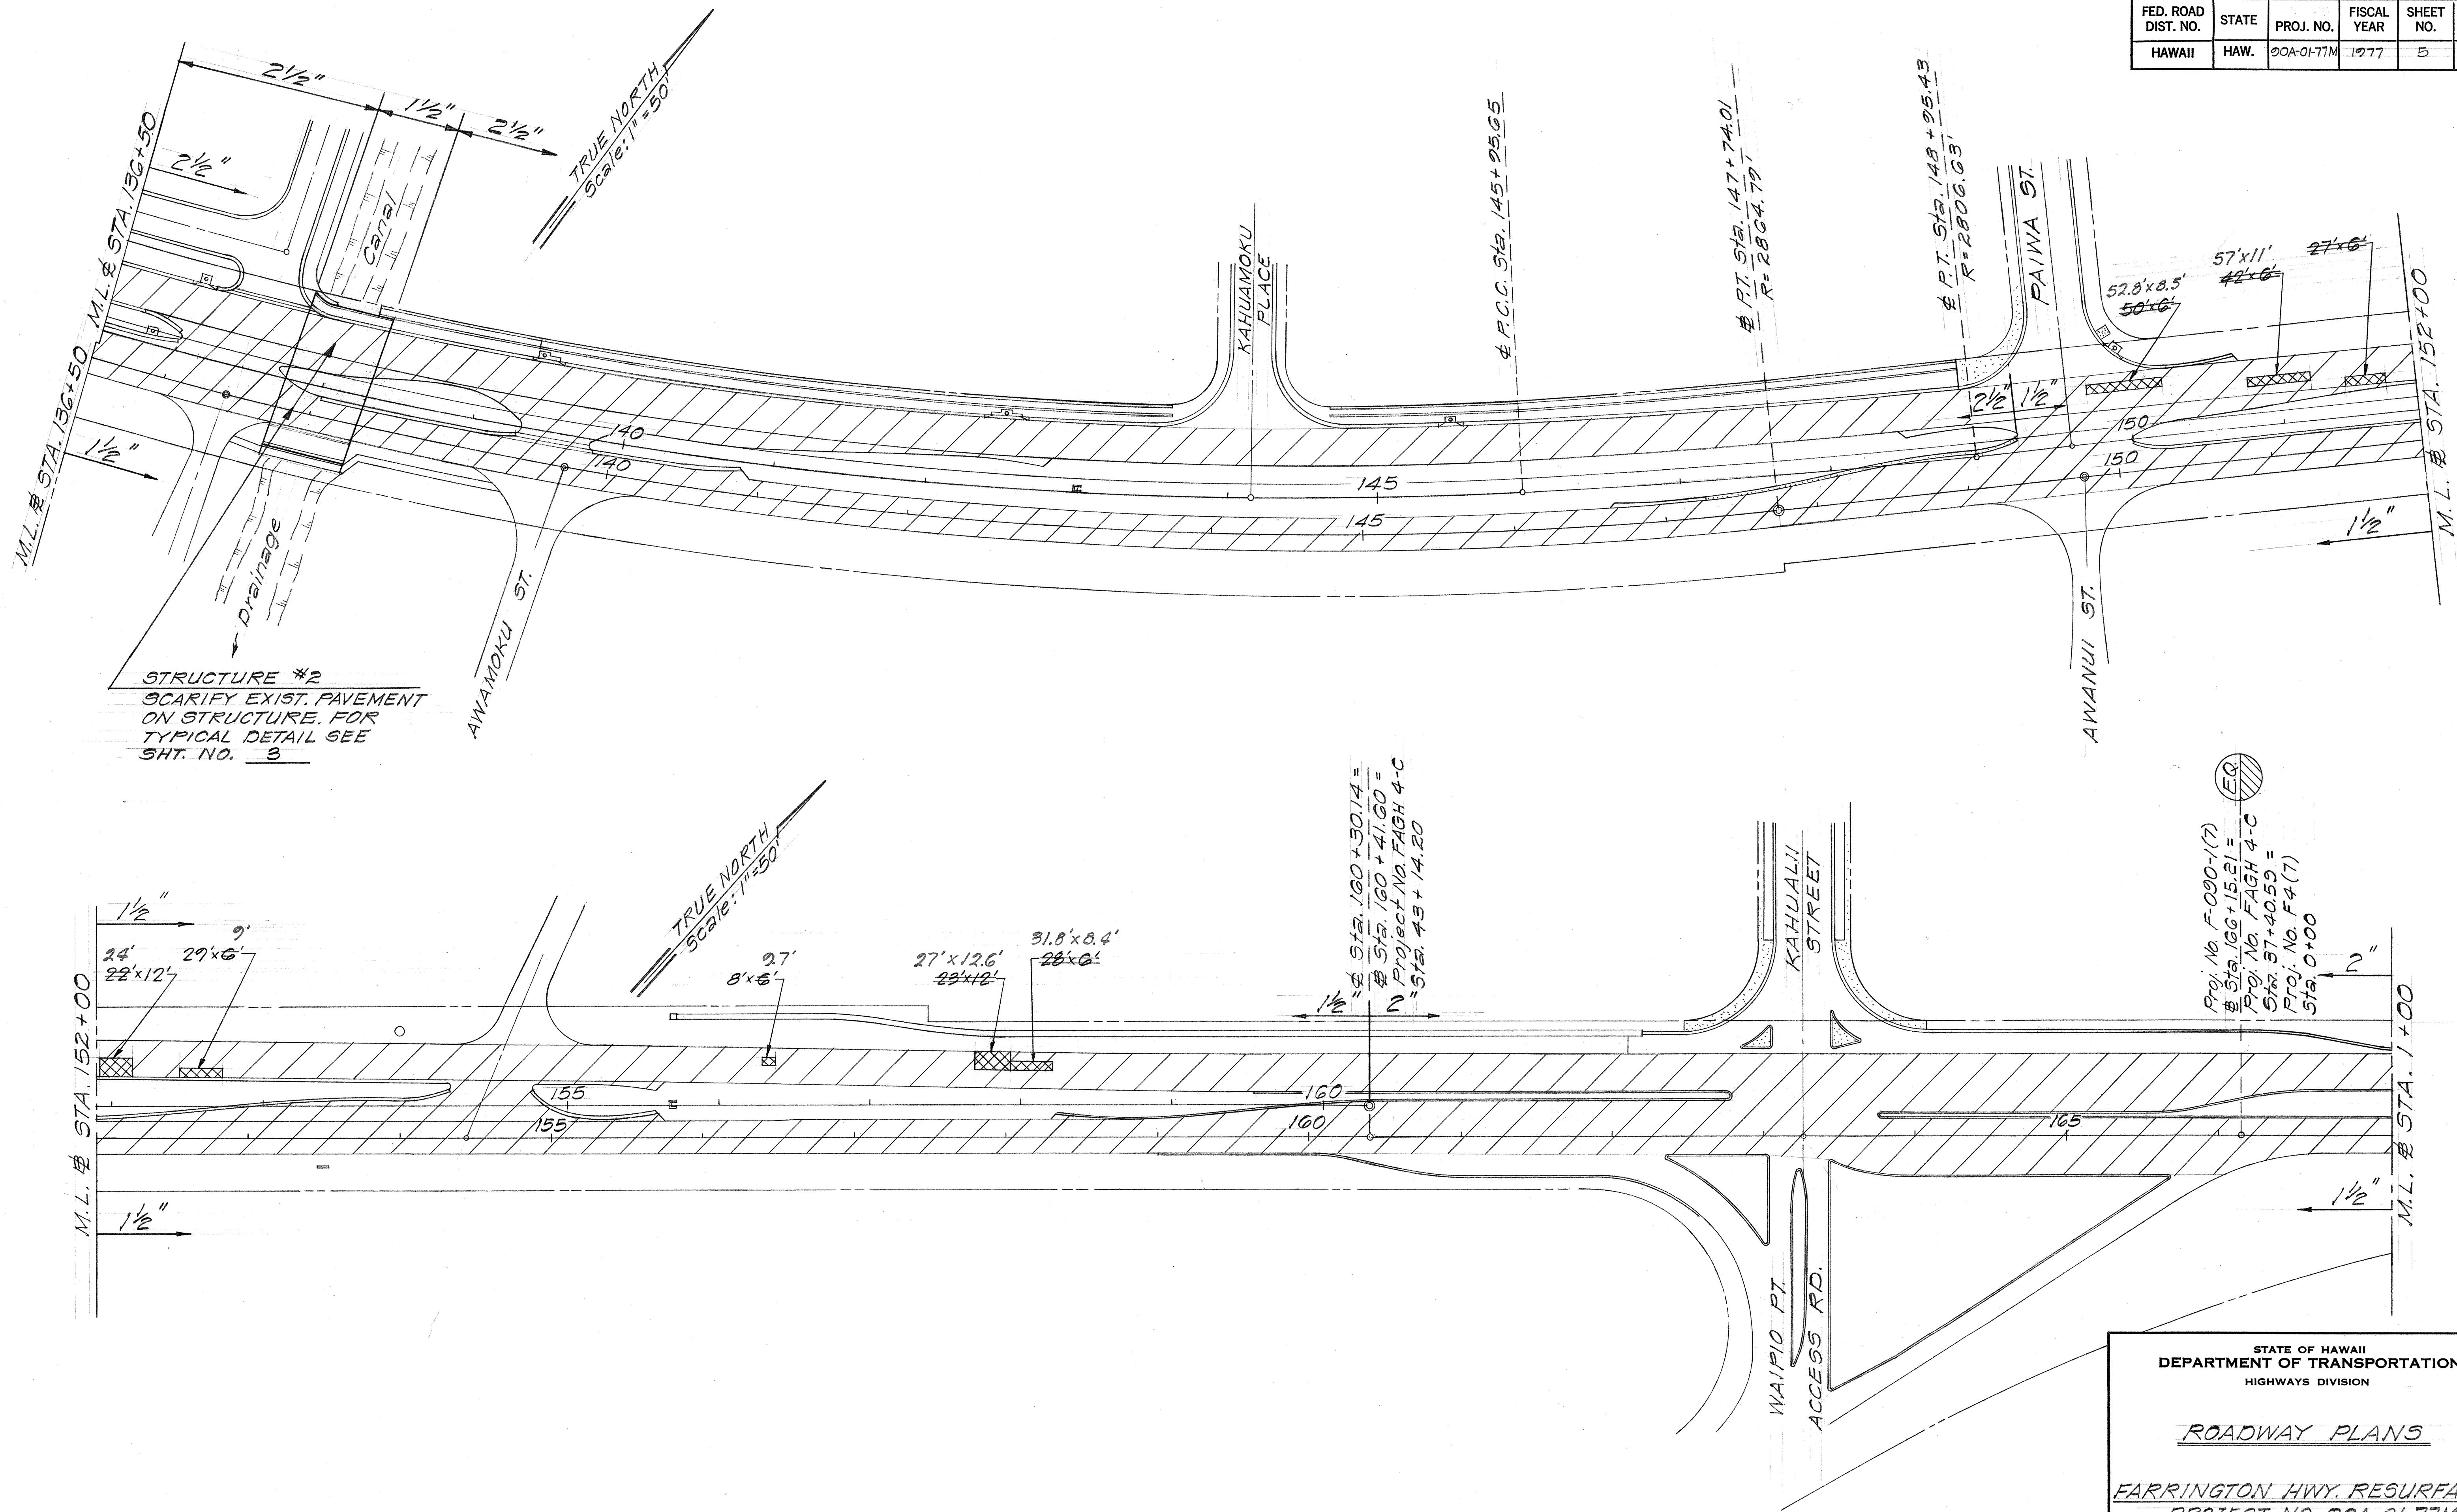

|               |                   |      |
|---------------|-------------------|------|
| ORIGINAL PLAN | SURVEY PLOTTED BY | DATE |
| NO. 1         | DRAWN BY          |      |
| NO. 2         | DESIGNED BY       |      |
| NO. 3         | CHECKED BY        |      |

STATE OF HAWAII  
DEPARTMENT OF TRANSPORTATION  
HIGHWAYS DIVISION


ROADWAY PLANS

FARRINGTON HWY. RESURFACING  
PROJECT NO. 20A-01-77M

Scale: 1"=50' Date: April, 1977

SHEET NO. 2 OF 5 SHEETS

| FED. ROAD DIST. NO. | STATE | PROJ. NO.  | FISCAL YEAR | SHEET NO. | TOTAL SHEETS |
|---------------------|-------|------------|-------------|-----------|--------------|
| HAWAII              | HAW.  | 20A-01-77M | 1977        | 6         | 17           |

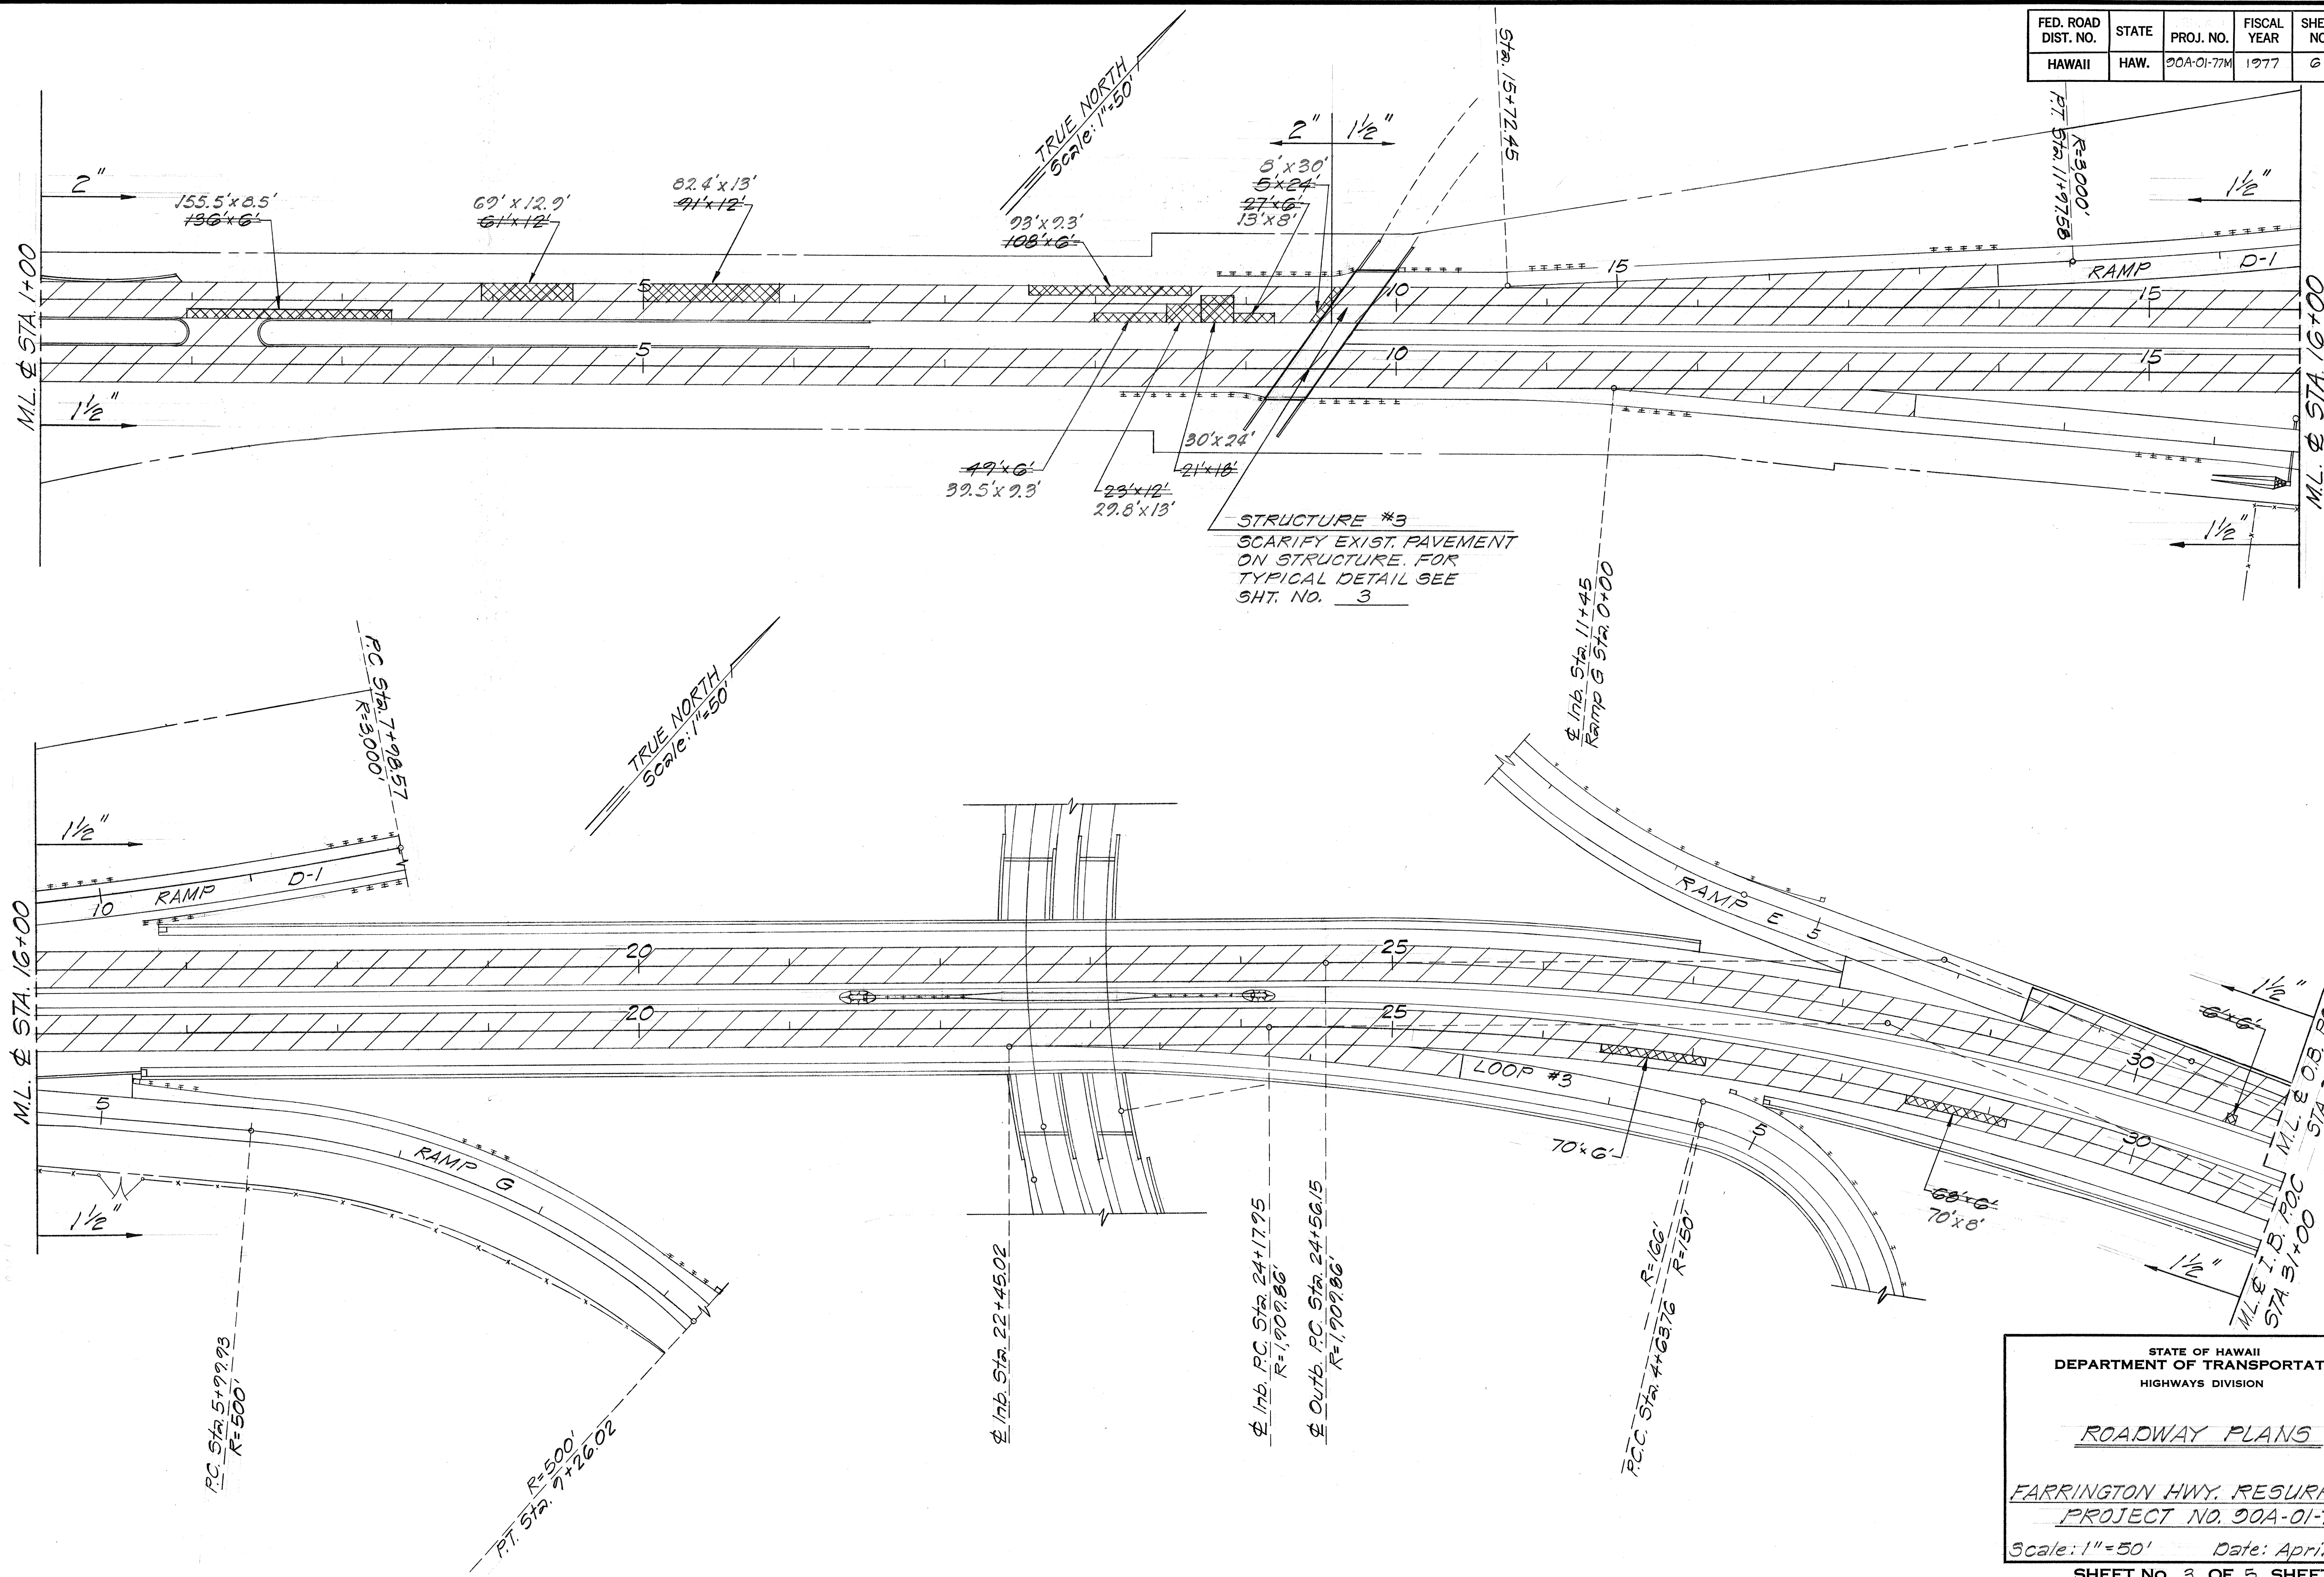

|               |             |
|---------------|-------------|
| ORIGINAL PLAN | DATE        |
| NOTED BY      | DESIGNED BY |
| QUANTITIES BY | CHECKED BY  |
| NO.           |             |

STATE OF HAWAII  
DEPARTMENT OF TRANSPORTATION  
HIGHWAYS DIVISION

ROADWAY PLANS

FARRINGTON HWY. RESURFACING  
PROJECT NO. 20A-01-77M


Scale: 1"=50' Date: April, 1977

SHEET NO. 3 OF 5 SHEETS



| FED. ROAD DIST. NO. | STATE | PROJ. NO.  | FISCAL YEAR | SHEET NO. | TOTAL SHEETS |
|---------------------|-------|------------|-------------|-----------|--------------|
| HAWAII              | HAW.  | 00A-01-77M | 1977        | 8         | 17           |

TRUE NORTH  
Scale: 1"=50'

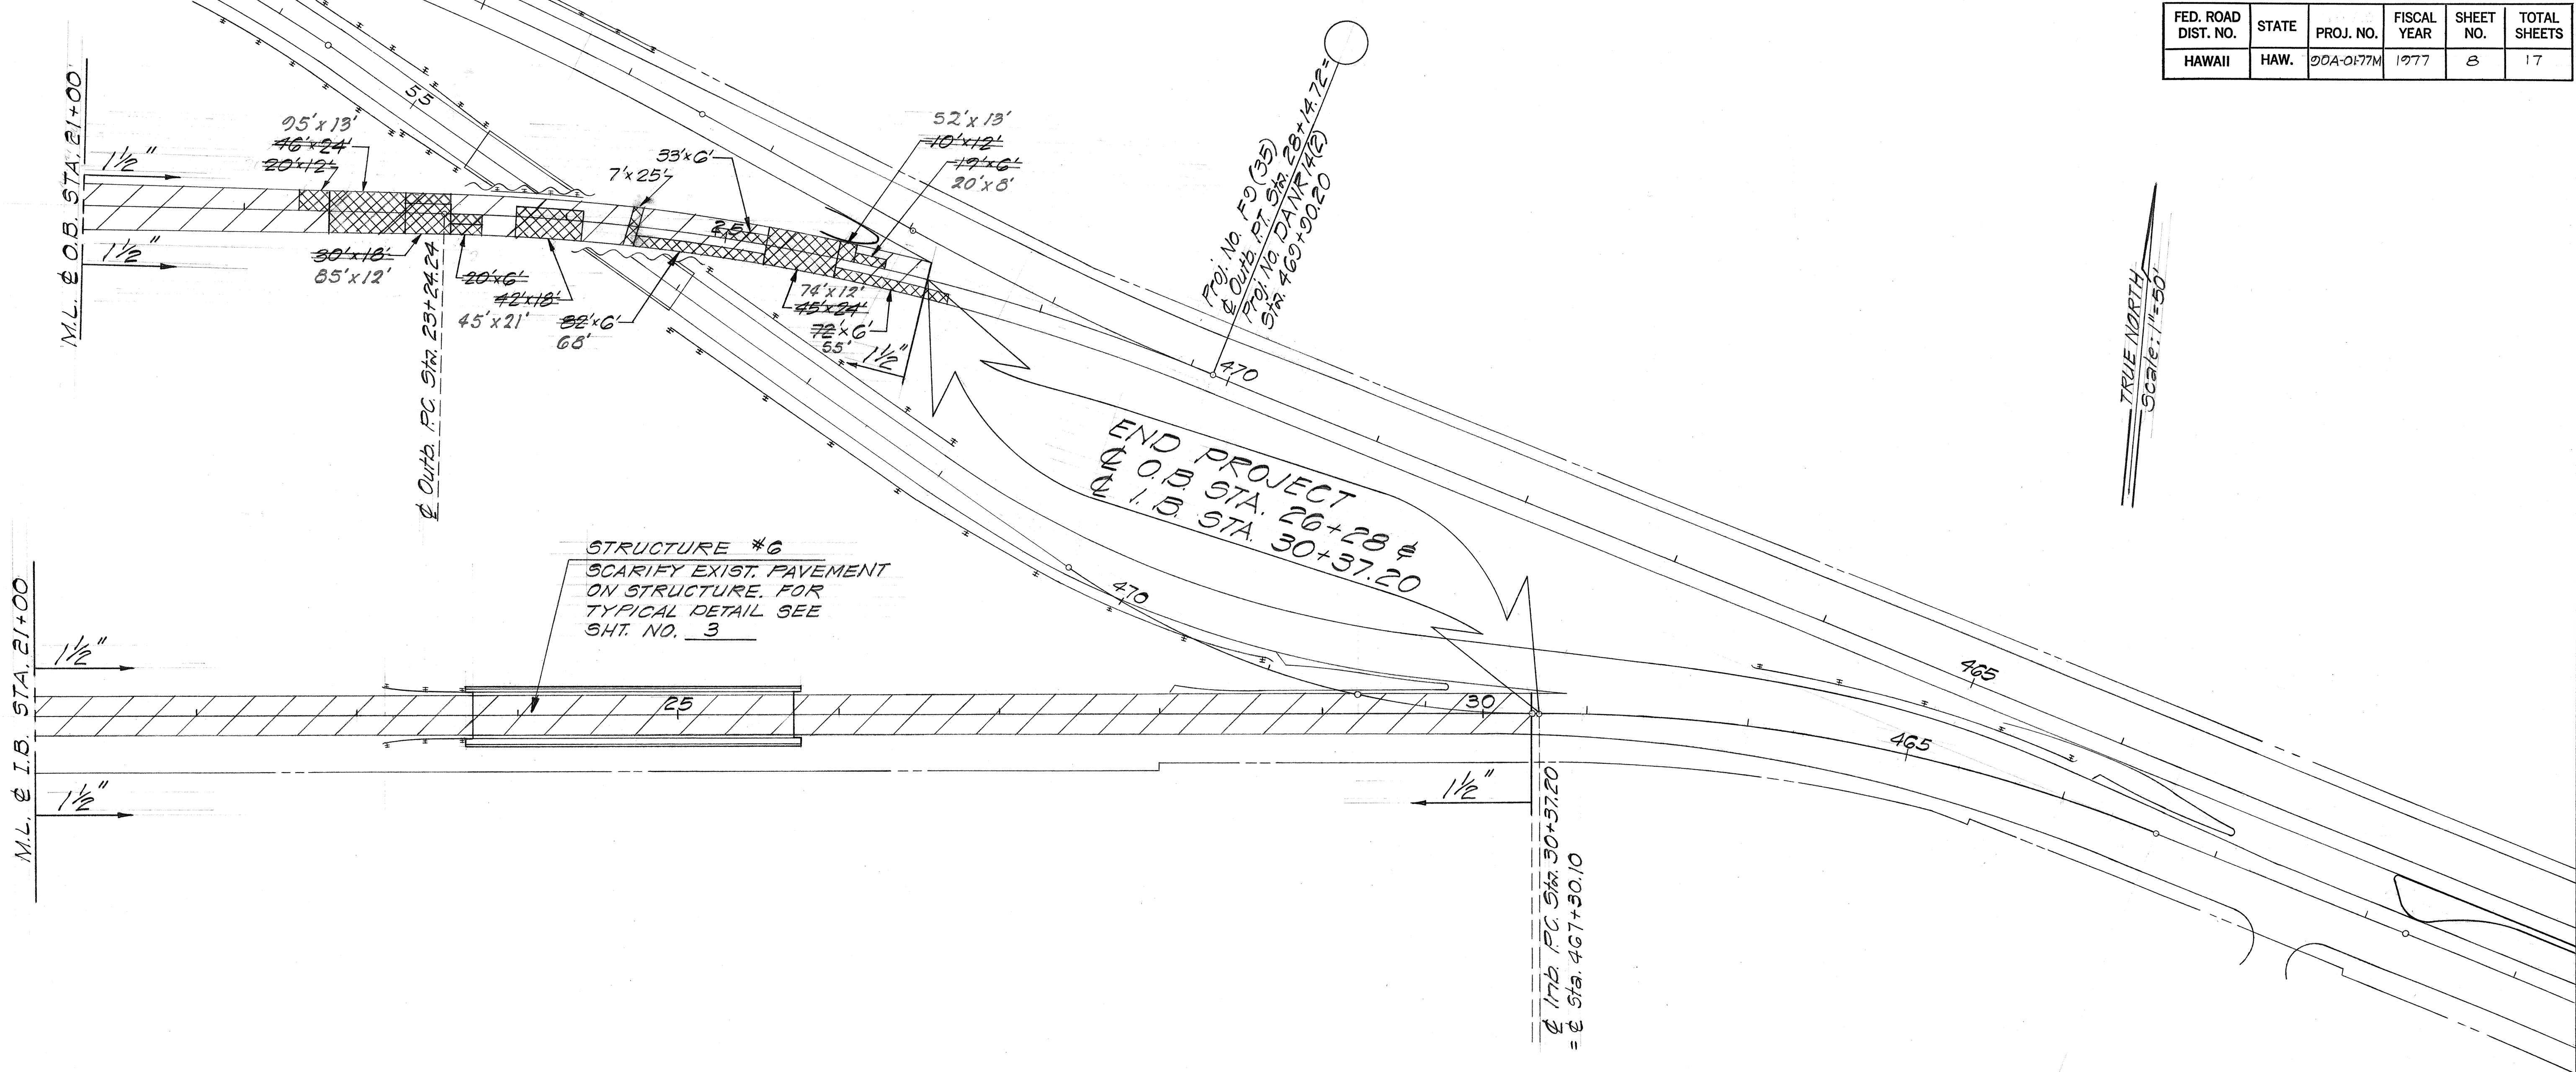

|               |                   |      |
|---------------|-------------------|------|
| ORIGINAL PLAN | SURVEY PLOTTED BY | DATE |
| NOTE BOOK     | DRAWN BY          |      |
| No.           | DESIGNED BY       |      |
|               | QUANTITIES BY     |      |
|               | CHECKED BY        |      |

STATE OF HAWAII  
DEPARTMENT OF TRANSPORTATION  
HIGHWAYS DIVISION

ROADWAY PLANS

FARRINGTON HWY. RESURFACING  
PROJECT NO. 00A-01-77M

Scale: 1"=50' Date: April, 1977

SHEET NO. 5 OF 5 SHEETS