




FED. ROAD DIST. NO.	STATE	PROJ. NO.	FISCAL YEAR	SHEET NO.	TOTAL SHEETS
HAWAII	HAW.	20A-01-77M	1977	2	17

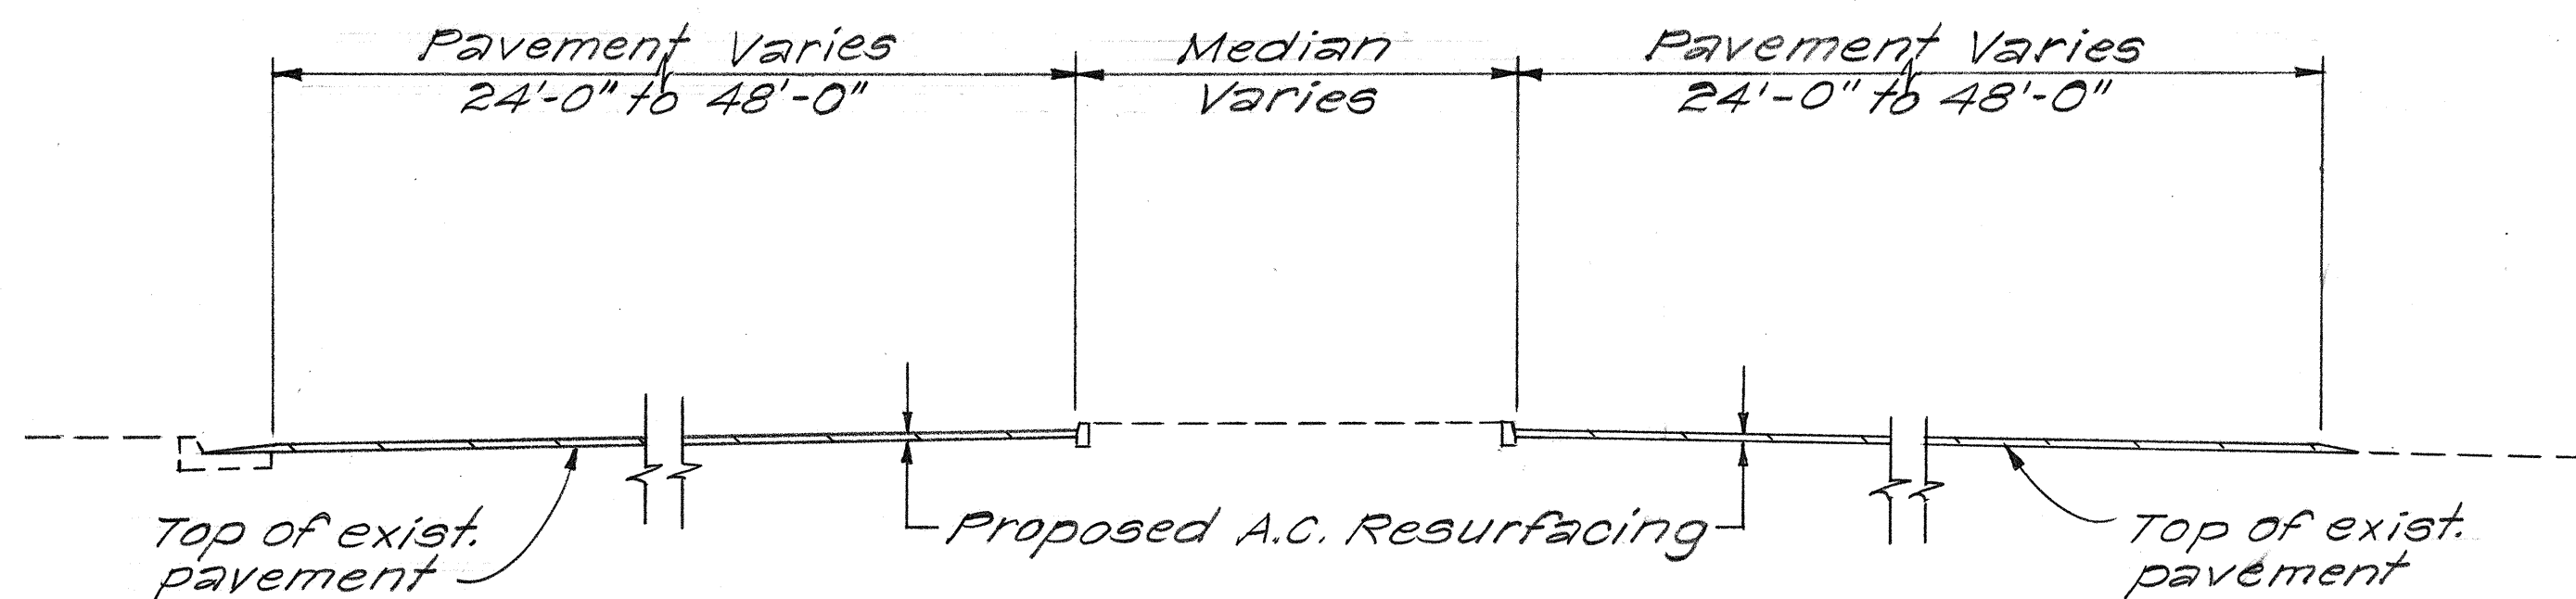


TYPICAL SECTION
 Farrington Highway # Sta. 115+00 to Sta. 8+00± (Vicinity of Waipahu High School)
 Scale: 3/16" = 1'-0"

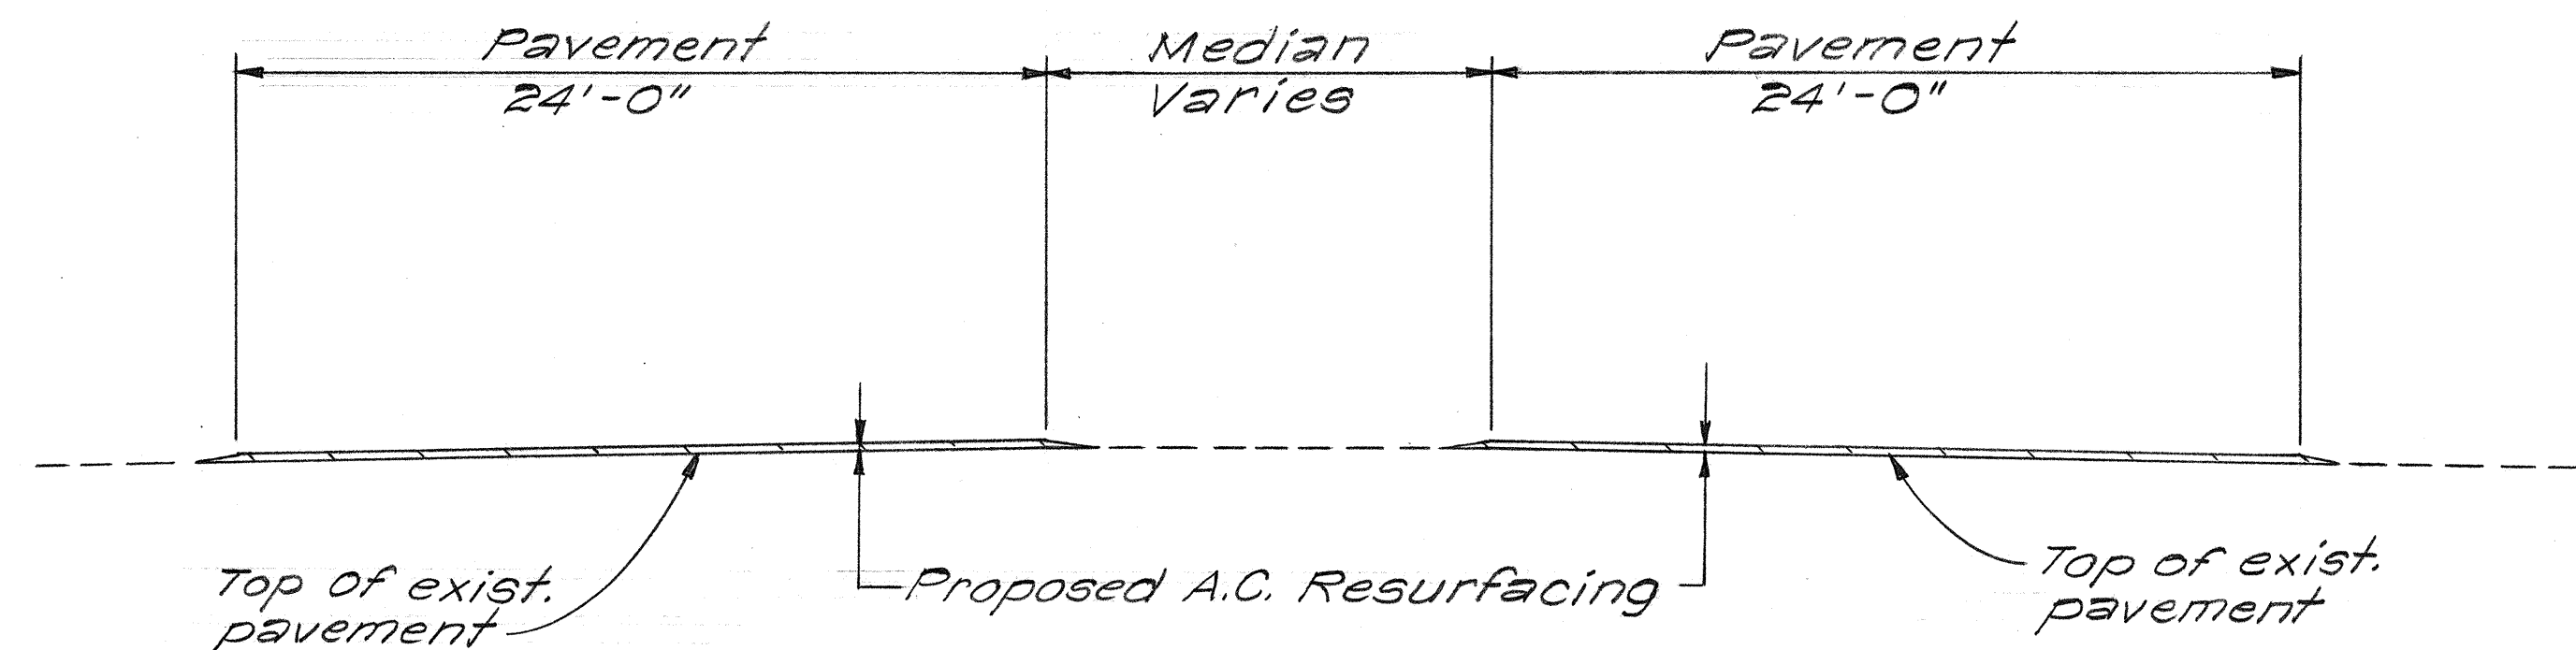


TYPICAL SECTION
 Farrington Highway # Sta. 8+00± to Kamehameha Hwy.
 Scale: 3/16" = 1'-0"

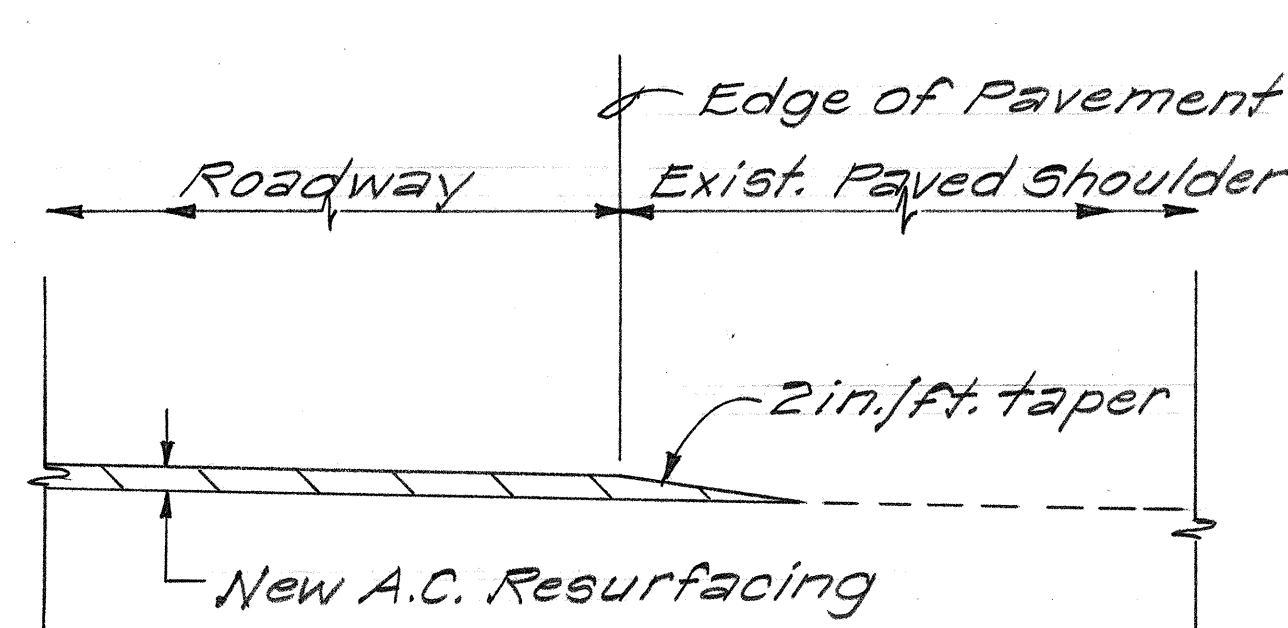

TYPICAL SECTION AT A.C. PAVED SHOULDER
 Scale: 1" = 1'-0"

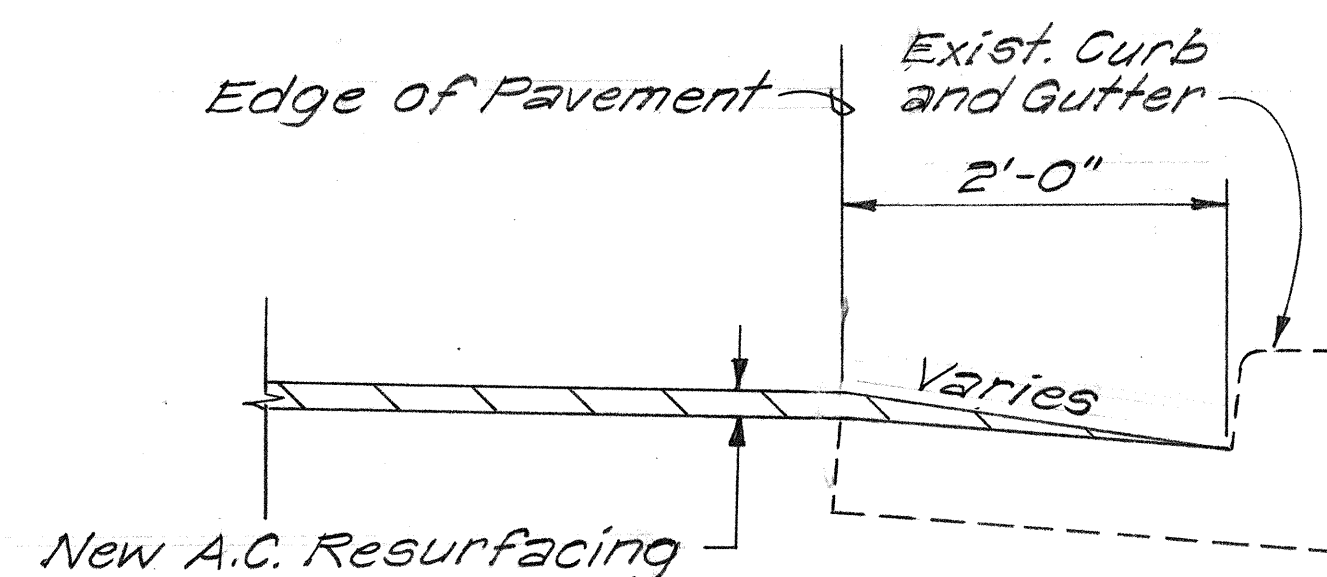


TYPICAL SECTION AT CURB AND GUTTER
 Scale: 1" = 1'-0"

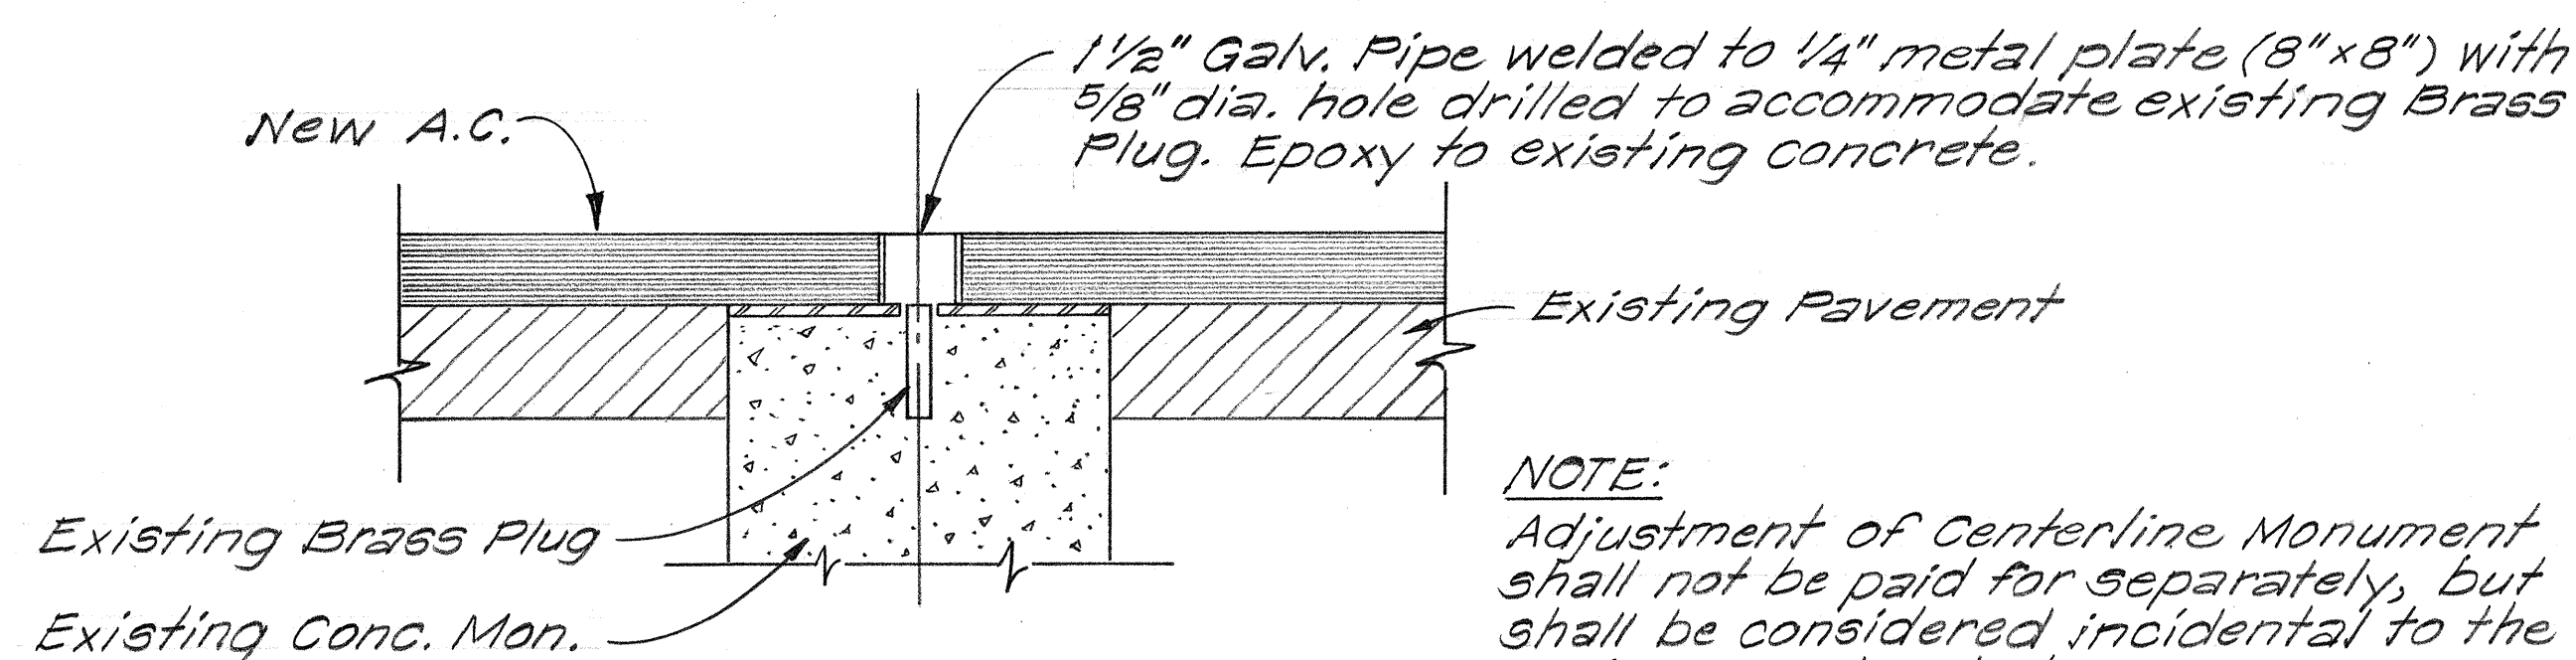


ADJUSTED CENTERLINE MONUMENT
 Scale: 3" = 1'-0"


NOTE:
 Adjustment of Centerline Monument shall not be paid for separately, but shall be considered incidental to the various contract items.

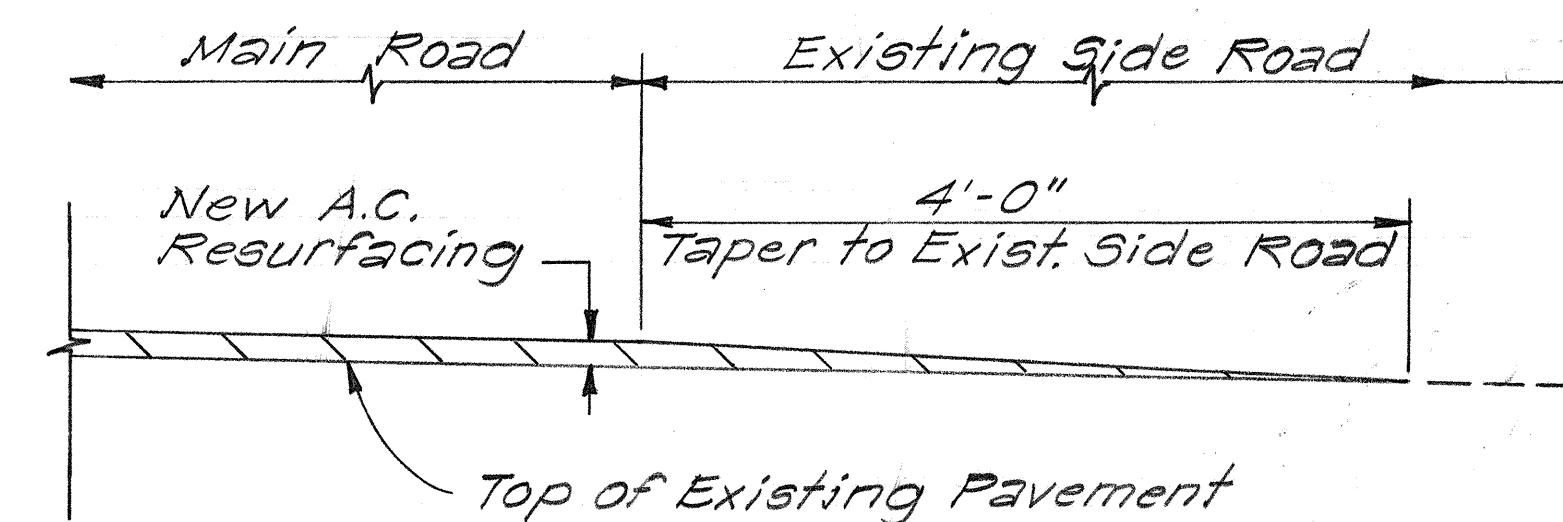

TYPICAL SECTION - SIDE ROAD CONNECTION
 Scale: 1" = 1'-0"

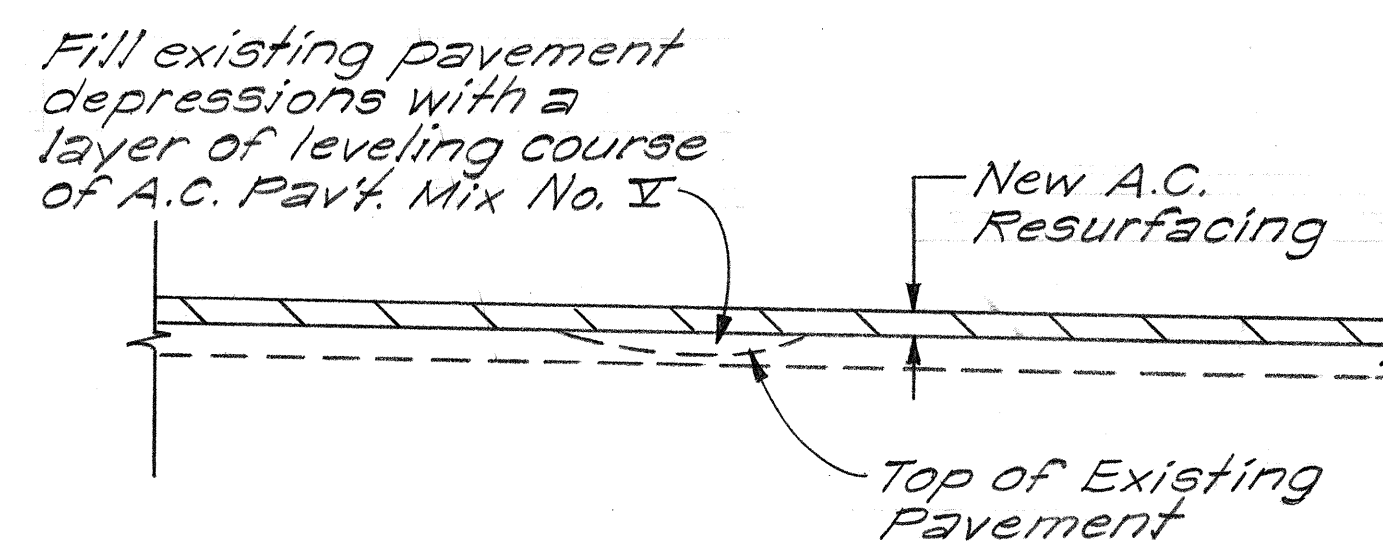

LEVELING COURSE DETAIL
 Scale: 1" = 1'-0"

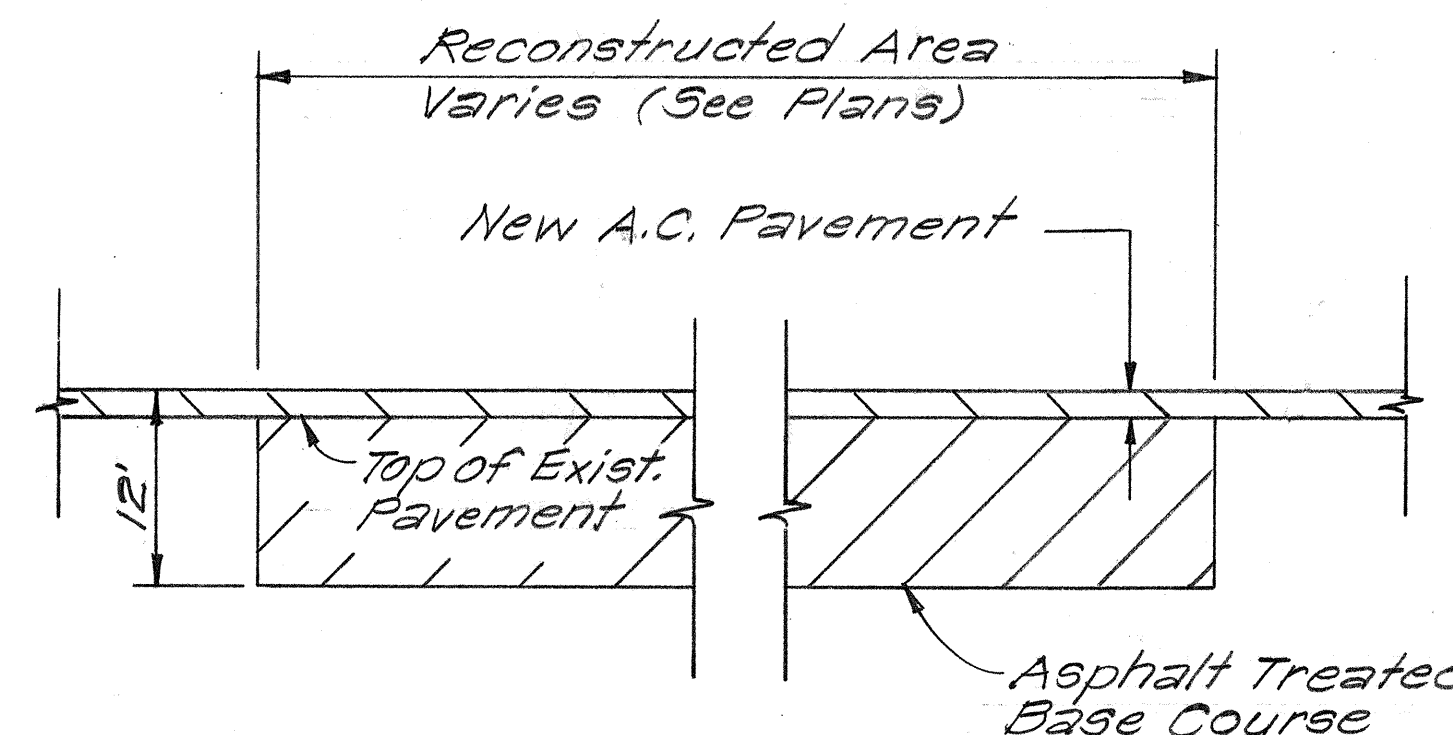

TYPICAL SECTION - RECONSTRUCTED AREA
 Scale: 1" = 1'-0"

GENERAL NOTES

- Only the hatched area shown on the plan sheets shall be resurfaced.
- Provide smooth transition at connections to existing pavement.
- Ruts on the existing roadway pavement shall be filled with a thin layer of leveling course Mix No. I prior to resurfacing. This leveling course will be considered as A.C. Pavement Mix No. I and paid for under Item No. 401.05.
- The exact limits of the reconstructed areas shall be determined in the field by the Engineer.
- The bidders attention is directed to Sub-section 104-09, Availability of funds of the Special Provisions.
- The A.C. overlay thickness shall be as shown on the plans, unless otherwise directed by the Engineer.
- Frame and cover of existing C & C Monuments shall be raised to new grade. This work shall be considered incidental to the various contract items and no separate payment shall be made thereof.
- Existing Centerline Monuments shall be adjusted as shown on this sheet.
- At the Waiawa Interchange ramps, provide 20' taper to the existing pavement and at the beginning and end of project, provide 50' taper to the existing pavement.

DATE	____
SURVEY PLOTTED BY	____
DRAWN BY	____
DESIGNED BY	____
CHECKED BY	____
NOTE BOOK	____
No.	____

STATE OF HAWAII
DEPARTMENT OF TRANSPORTATION
HIGHWAYS DIVISION

TYPICAL SECTIONS
AND
GENERAL NOTES

FARRINGTON HWY. RESURFACING
PROJECT NO. 20A-01-77M

Scale: As Noted Date: April, 1977

SHEET NO. 1 OF 1 SHEETS