


FED. ROAD DIST. NO.	STATE	FED. AID PROJ. NO.	FISCAL YEAR	SHEET NO.	TOTAL SHEETS
HAWAII	HAW.	HHS-010-1(20) F-099-1(6)	1977	7	17

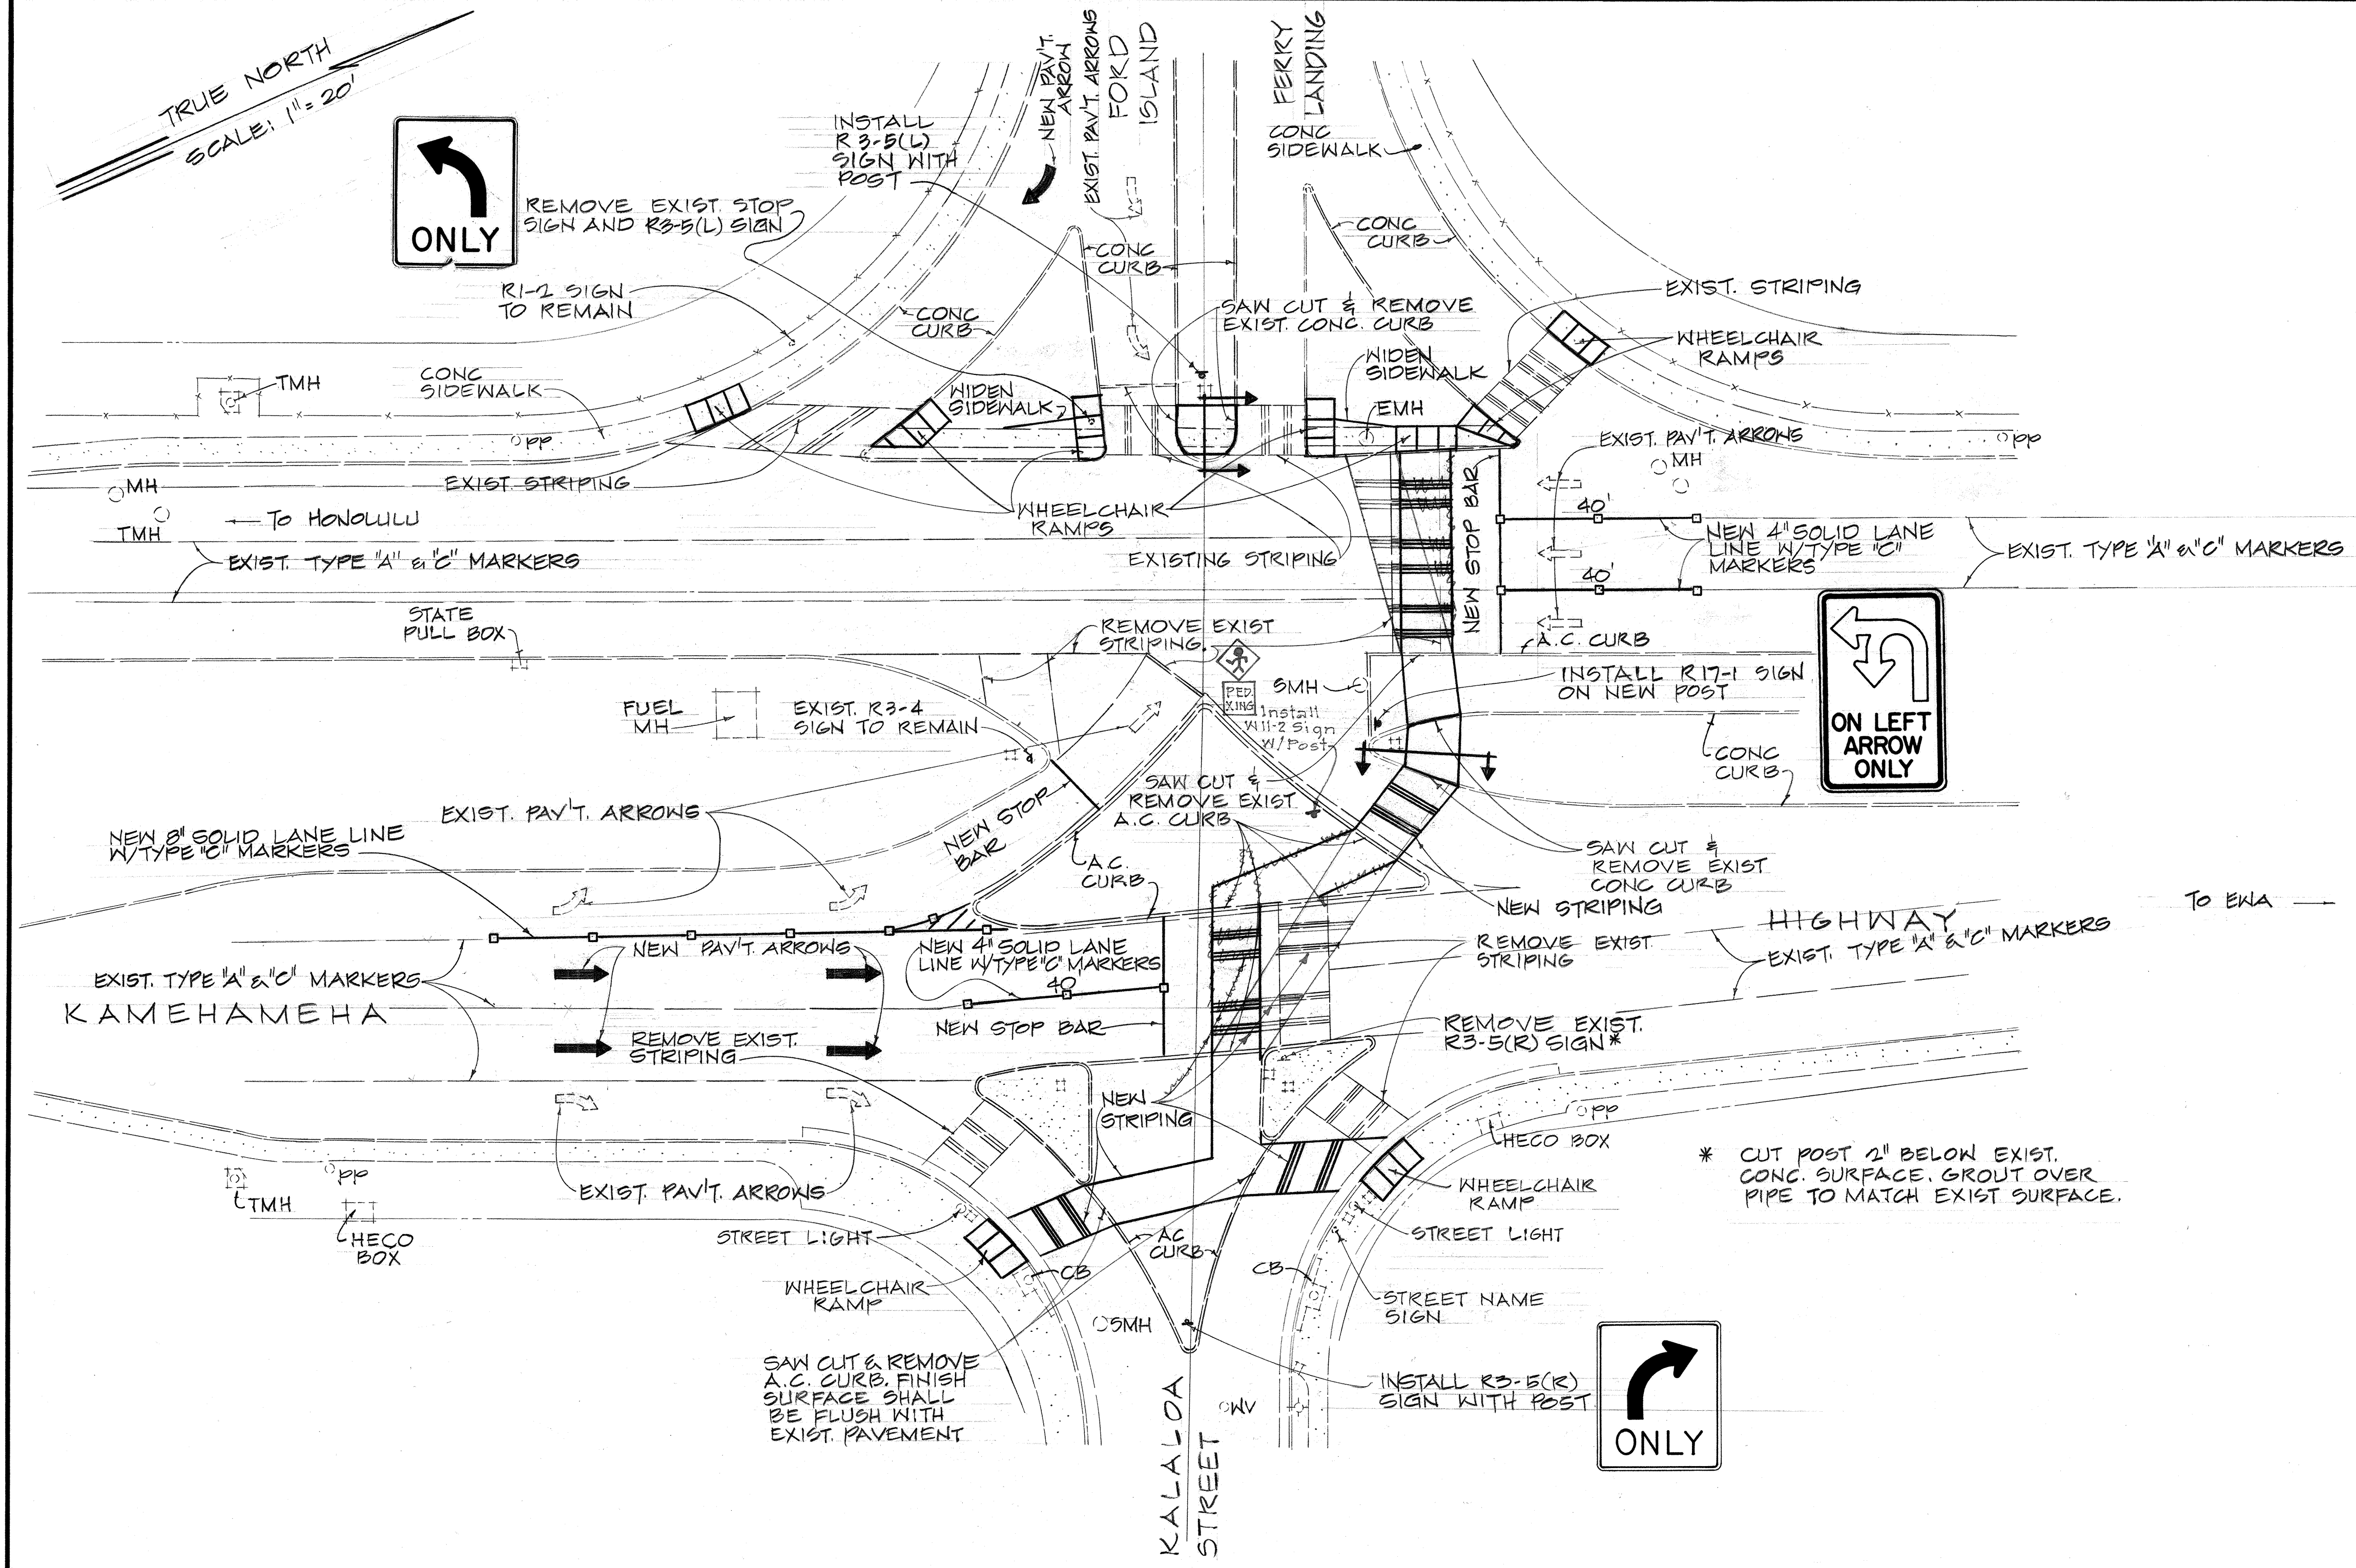

1 1/2" AC (NO. 5 MIX) SURFACING, 1/2" ABOVE ROADWAY W/ 1/2" R ROUNDING

4" CLASS B CONCRETE SURFACING

EXISTING CURB

EXIST. AC PAVEMENT

4" BED COURSE MATERIAL

NEW CONC CURBS TO MATCH EXIST. CURBS

CROSSWALK

SECTION

SCALE: 1" = 5'

NOTES:

1- PROVIDE SMOOTH, NEAT JOINT BETWEEN NEW AND EXISTING CURBS.

2- COST OF MEDIAN MODIFICATION AND SIDEWALK WIDENING, ARE INCIDENTAL TO WHEELCHAIR RAMP.

3- SAW CUTTING AND REMOVAL OF A.C. CURB INCIDENTAL TO WHEELCHAIR RAMP.



STATE OF HAWAII

DEPARTMENT OF TRANSPORTATION

HIGHWAYS DIVISION

KAMEHAMEHA HIGHWAY

TRAFFIC SIGNALS AT

FORD ISLAND FERRY GATE

FED. AID PROJ. NO. F-099-1(6)

STRIPING PLAN &

MISC. DETAILS

SCALE: AS SHOWN

DATE: AUG. 5, 1977

SHEET NO. 1 OF 1 SHEETS

THIS WORK WAS PREPARED BY ME OR UNDER MY SUPERVISION

Theodore S. Kawahara

Signature

DATE	_____
SURVEY PLOTTED BY	_____
DRAWN BY	_____
TRACED BY	_____
QUANTITIES BY	_____
CHECKED BY	_____
NOTE BOOK	_____
NO.	_____