


INDEX TO DRAWINGS	
SHEET NO.	DESCRIPTION
1	TITLE SHEET
2	LEGEND AND NOTES
3	PLAN - NEW LEFT TURN LANE STRIPING AND SIGNING
4	TRAFFIC SIGNALS PLAN HHS-078-1(20)
5	CROSS SECTIONS
6	TRAFFIC SIGNALS PLAN F-099-1(6)
7	STRIPING PLAN AND MISC. DETAILS F-099-1(6)
8	MISCELLANEOUS CROSSWALK AND STRIPING DETAILS
9-17	STANDARD DETAILS

STATE OF HAWAII
DEPARTMENT OF TRANSPORTATION
LAND TRANSPORTATION FACILITIES DIVISION
HONOLULU, HAWAII

"AS BUILT"
PLANS FOR
MOANALUA ROAD
TRAFFIC SIGNALS AT AIEA INTERCHANGE
FEDERAL AID PROJ. NO. HHS-078-1(20)
KAMEHAMEHA HIGHWAY
TRAFFIC SIGNALS AT FORD ISLAND FERRY GATE
FEDERAL AID PROJ. NO. F - 099 - 1(6)
DISTRICT OF EWA
ISLAND OF OAHU

FED. ROAD DIST. NO.	STATE	FED. AID PROJ. NO.	FISCAL YEAR	SHEET NO.	TOTAL SHEETS
HAWAII	HAW.	HHS-078-1(20) F-099-1(6)	1977	1	17

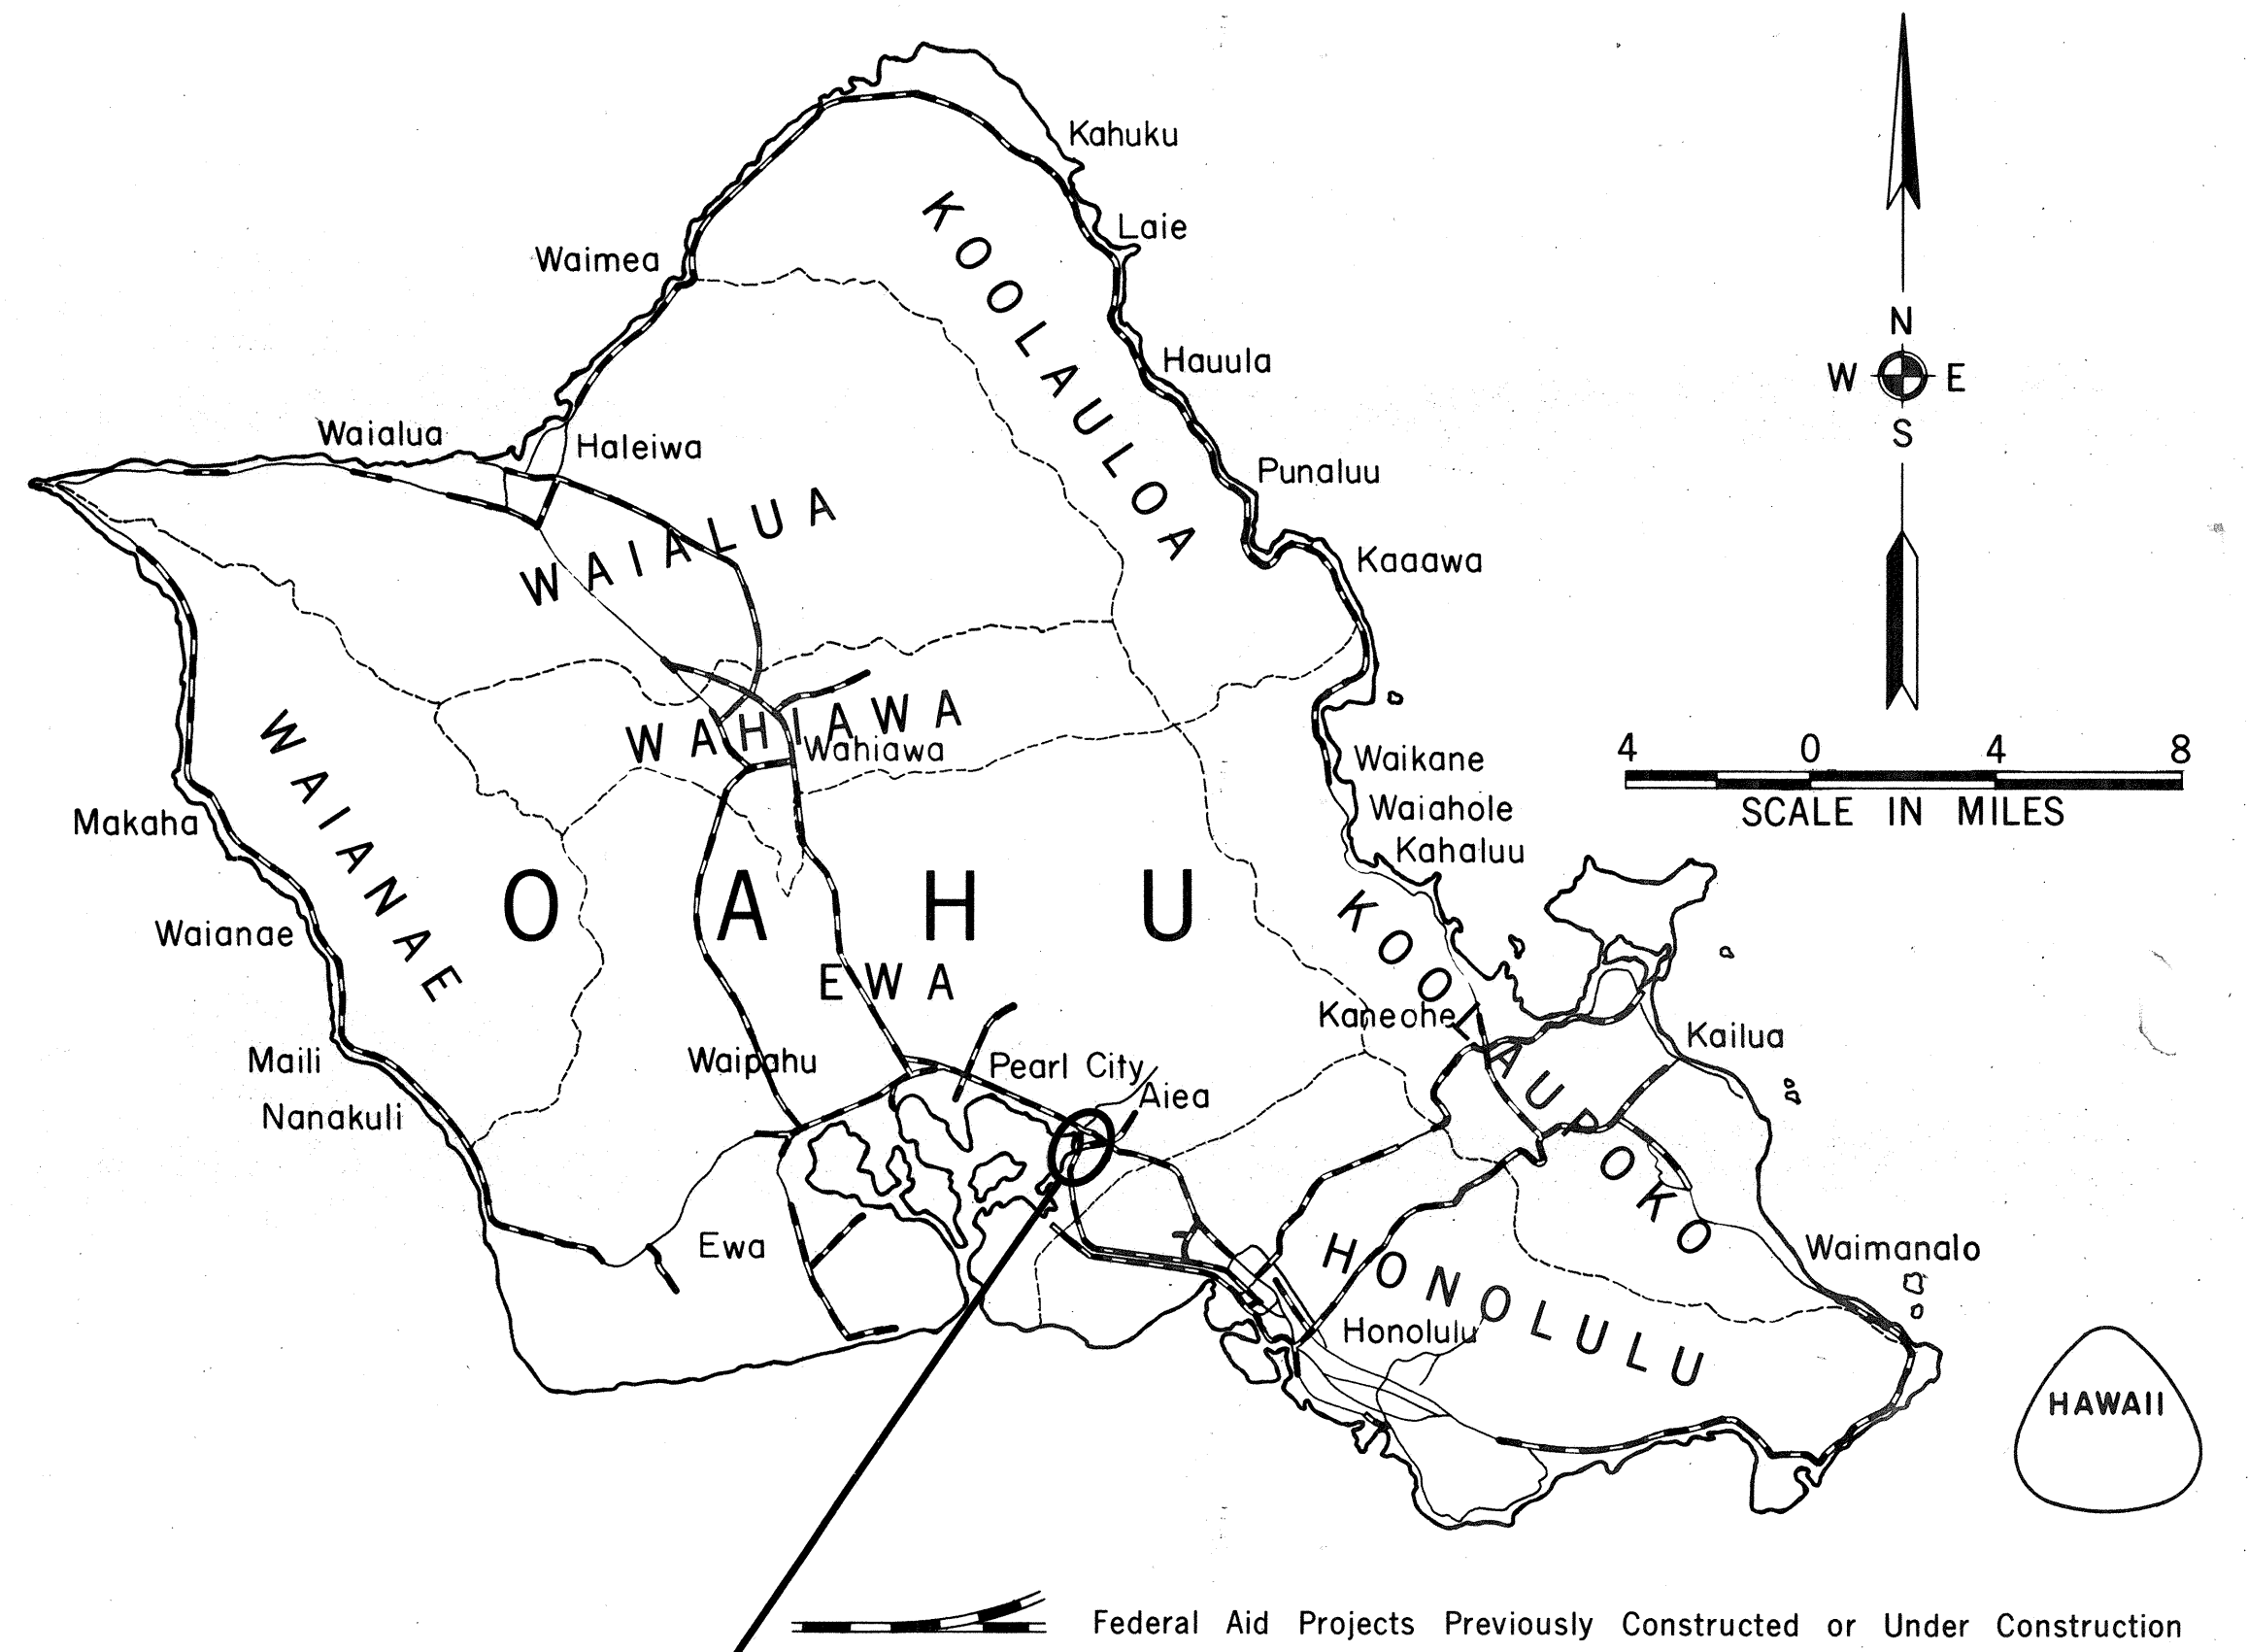

LOCATION OF PROJECTS

NOTE:
ALL CHANGES MADE DURING CONSTRUCTION HAVE BEEN INCORPORATED ON THESE PLANS IN RED EXCEPT CHANGES IN THE ORIGINAL THEORETICAL QUANTITIES.

Robert Y. Omai
RESIDENT ENGINEER
3/7/79
DATE

DESIGN CLASSIFICATION	
ADT (1976)	22,780
ADT (1996)	18,650
DHV	1,680
D	80/20
T	1.5 %
T ₂₄	2.5 %
V	25 MPH

MOANALUA RD. - AIEA INTERCHANGE

DESIGN CLASSIFICATION	
ADT (1976)	46,200
ADT (1996)	20,400
DHV	1,840
D	75/25
T	5.5 %
T ₂₄	6.5 %
V	35 MPH

KAMEHAMEHA HWY. - FORD ISLAND FERRY GATE

DEPARTMENT OF TRANSPORTATION
FEDERAL HIGHWAY ADMINISTRATION
APPROVED:
[Signature]
DIVISION ADMINISTRATOR
9-19-77
DATE

DEPARTMENT OF TRANSPORTATION
STATE OF HAWAII
APPROVED:
R. Higashimura
DIR. OF TRANSPORTATION
9/16/77
DATE

