
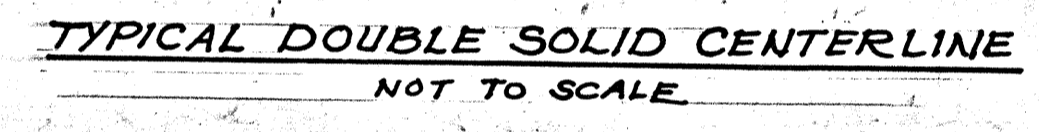


- NOTES:**
- INSTALL ST. NAME SIGN AS SHOWN ON PLAN.
 - LOCATION OF "STOP" SIGN:
 - INSTALL "STOP" SIGN AT CURB RETURN TANGENT POINT.
 - INSTALL "STOP" SIGN ON METAL ST. LIGHT STANDARD, IF A LIGHT STANDARD IS LOCATED WITHIN 10' OF CURB RETURN.
 - INSTALL "STOP" SIGN ON FRONT OF UTILITY POLE, IF A UTILITY POLE IS LOCATED WITHIN 10' OF CURB RETURN.

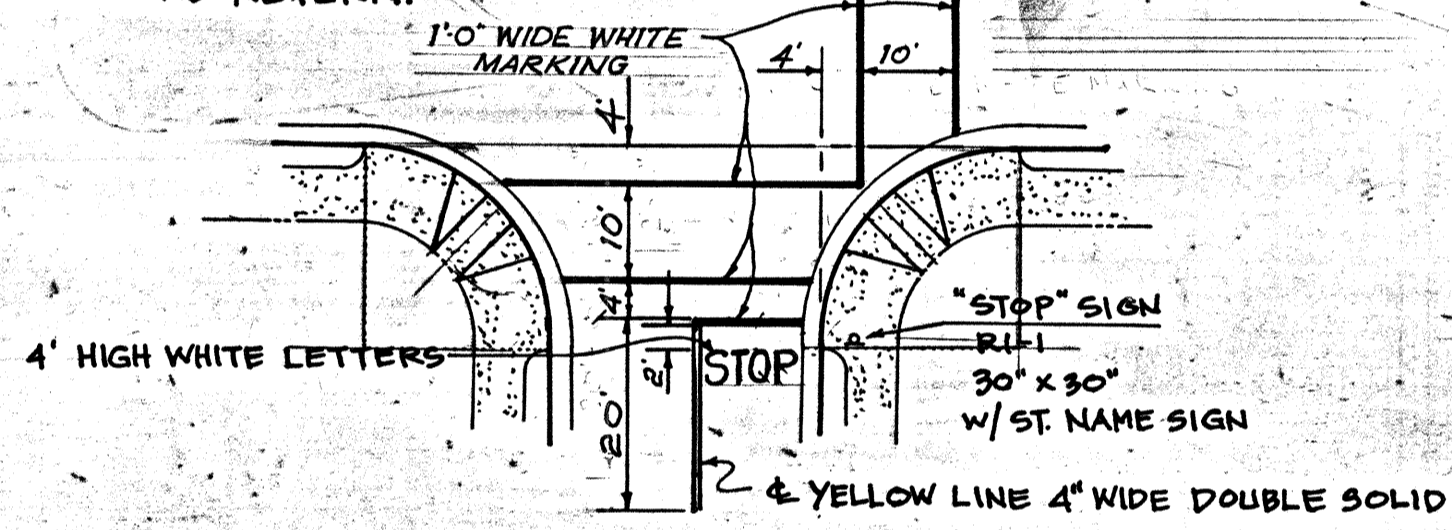

SIGNING AND STRIPING PLAN
Scale: 1" = 60'

REVISION	DATE	DESCRIPTION	APPROVED
THIS WORK WAS PREPARED BY ME OR UNDER MY SUPERVISION			
WILLIAM HEE & ASSOCIATES, INC. ENGINEERS SURVEYORS PLANNERS SUITE 1, BUILDING 1 1020 AUAHI STREET HONOLULU, HAWAII			
GENTRY WAIPIO WAIPIO, EWA, OAHU, HAWAII			
SIGNING AND STRIPING PLAN ROADS: WAIPIO UKA ST., LELEPUA PL., LUMINULA ST.			
APPROVED: _____ Date _____			
Director of Engineering _____ Date _____			