	INDEX TO DRAWINGS
SHEET NO.	DESCRIPTION
. 1	TITLE SHEET
. 2	TRAFFIC SIGNAL PLAN
3	STRIPING PLAN AND DETAIL
4	MISCELLANEOUS DETAILS
5-6	TYPICAL DETAILS OF WHEEL CHAIR RAMPS
7-18	STANDARD DETAILS
,	



## STATE OF HAWAII

## DEPARTMENT OF TRANSPORTATION HIGHWAYS DIVISION


HONOLULU, HAWAII


"AS BUILT "

PLANS FOR

KAMEHAMEHA HIGHWAY
TRAFFIC SIGNALS AT PUU MOMI STREET
PROJECT NO. 99D-02-79

DISTRICT OF EWA ISLAND OF OAHU

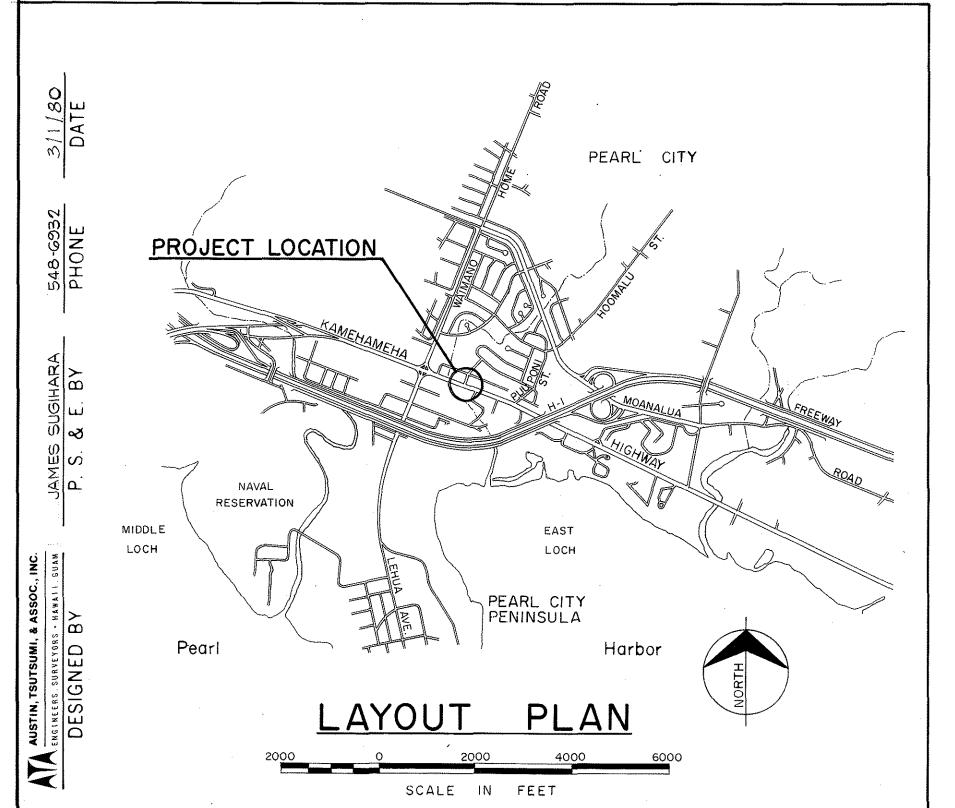

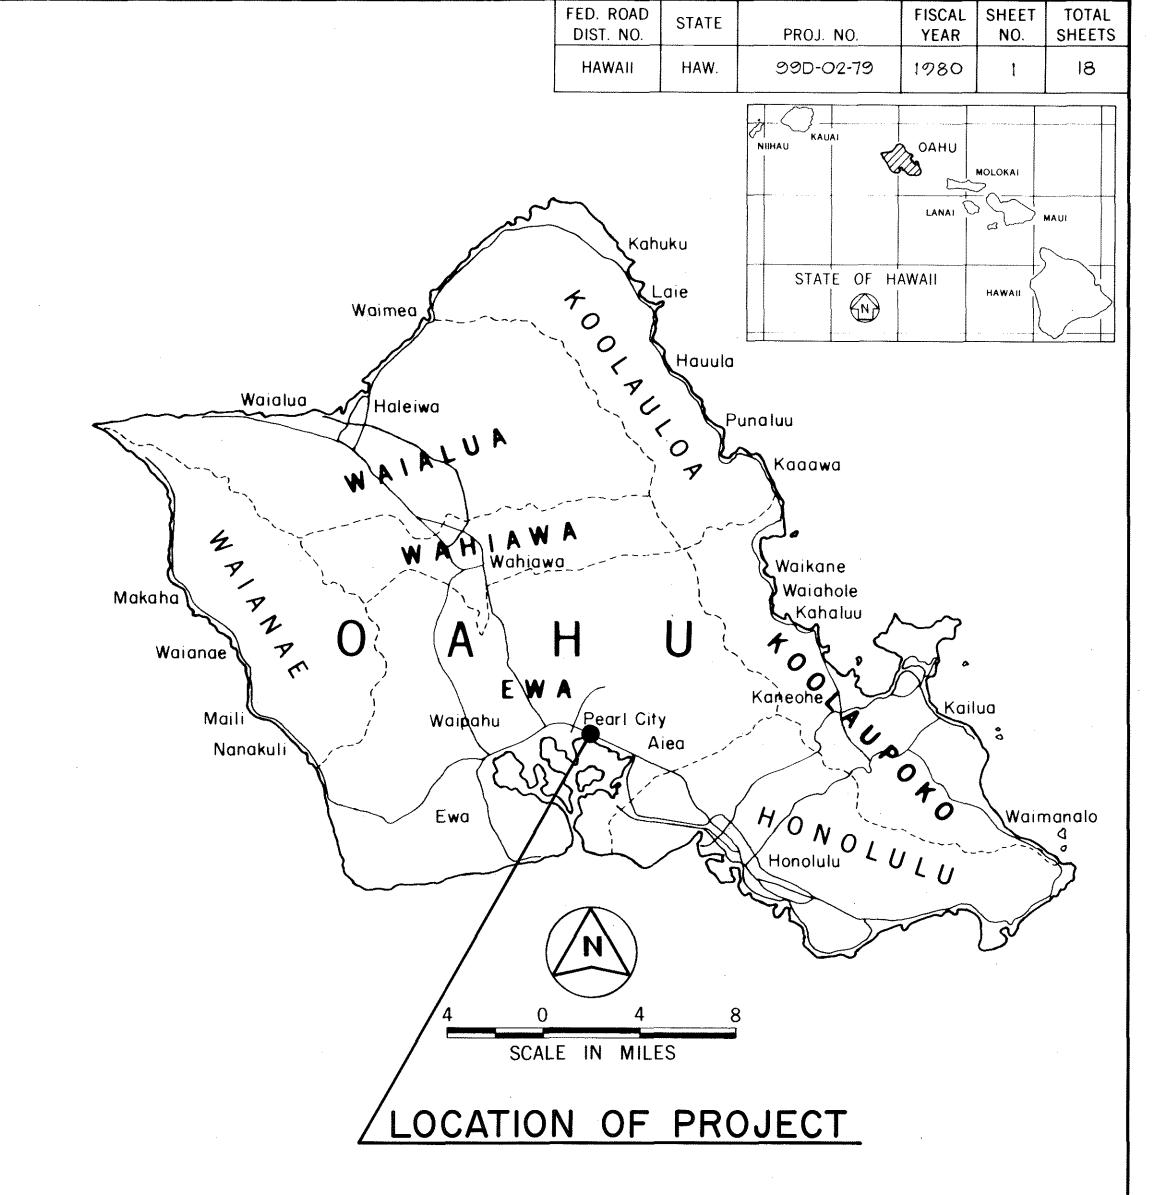

ALL CHANGES MADE DURING CONSTRUCTION HAVE BEEN INCORPORATED ON THESE PLANS EXCEPT CHANGES IN THE ORIGINAL THEORETICAL QUANTITIES.

RESIDENT ENGINEER DATE

DEPARTMENT OF TRANSPORTATION
STATE OF HAWAII

APPROVED:

James R. Carras 3/1/60

July Dir. OF TRANSPORTATION DATE