



DATE	DESIGNED BY	CHECKED BY
1/13/81	REVISIONS	
ORIGINAL PLAN	NOTE BOOK	
QUANTITIES BY		
NO.		

JOB. NO. 2401.1E

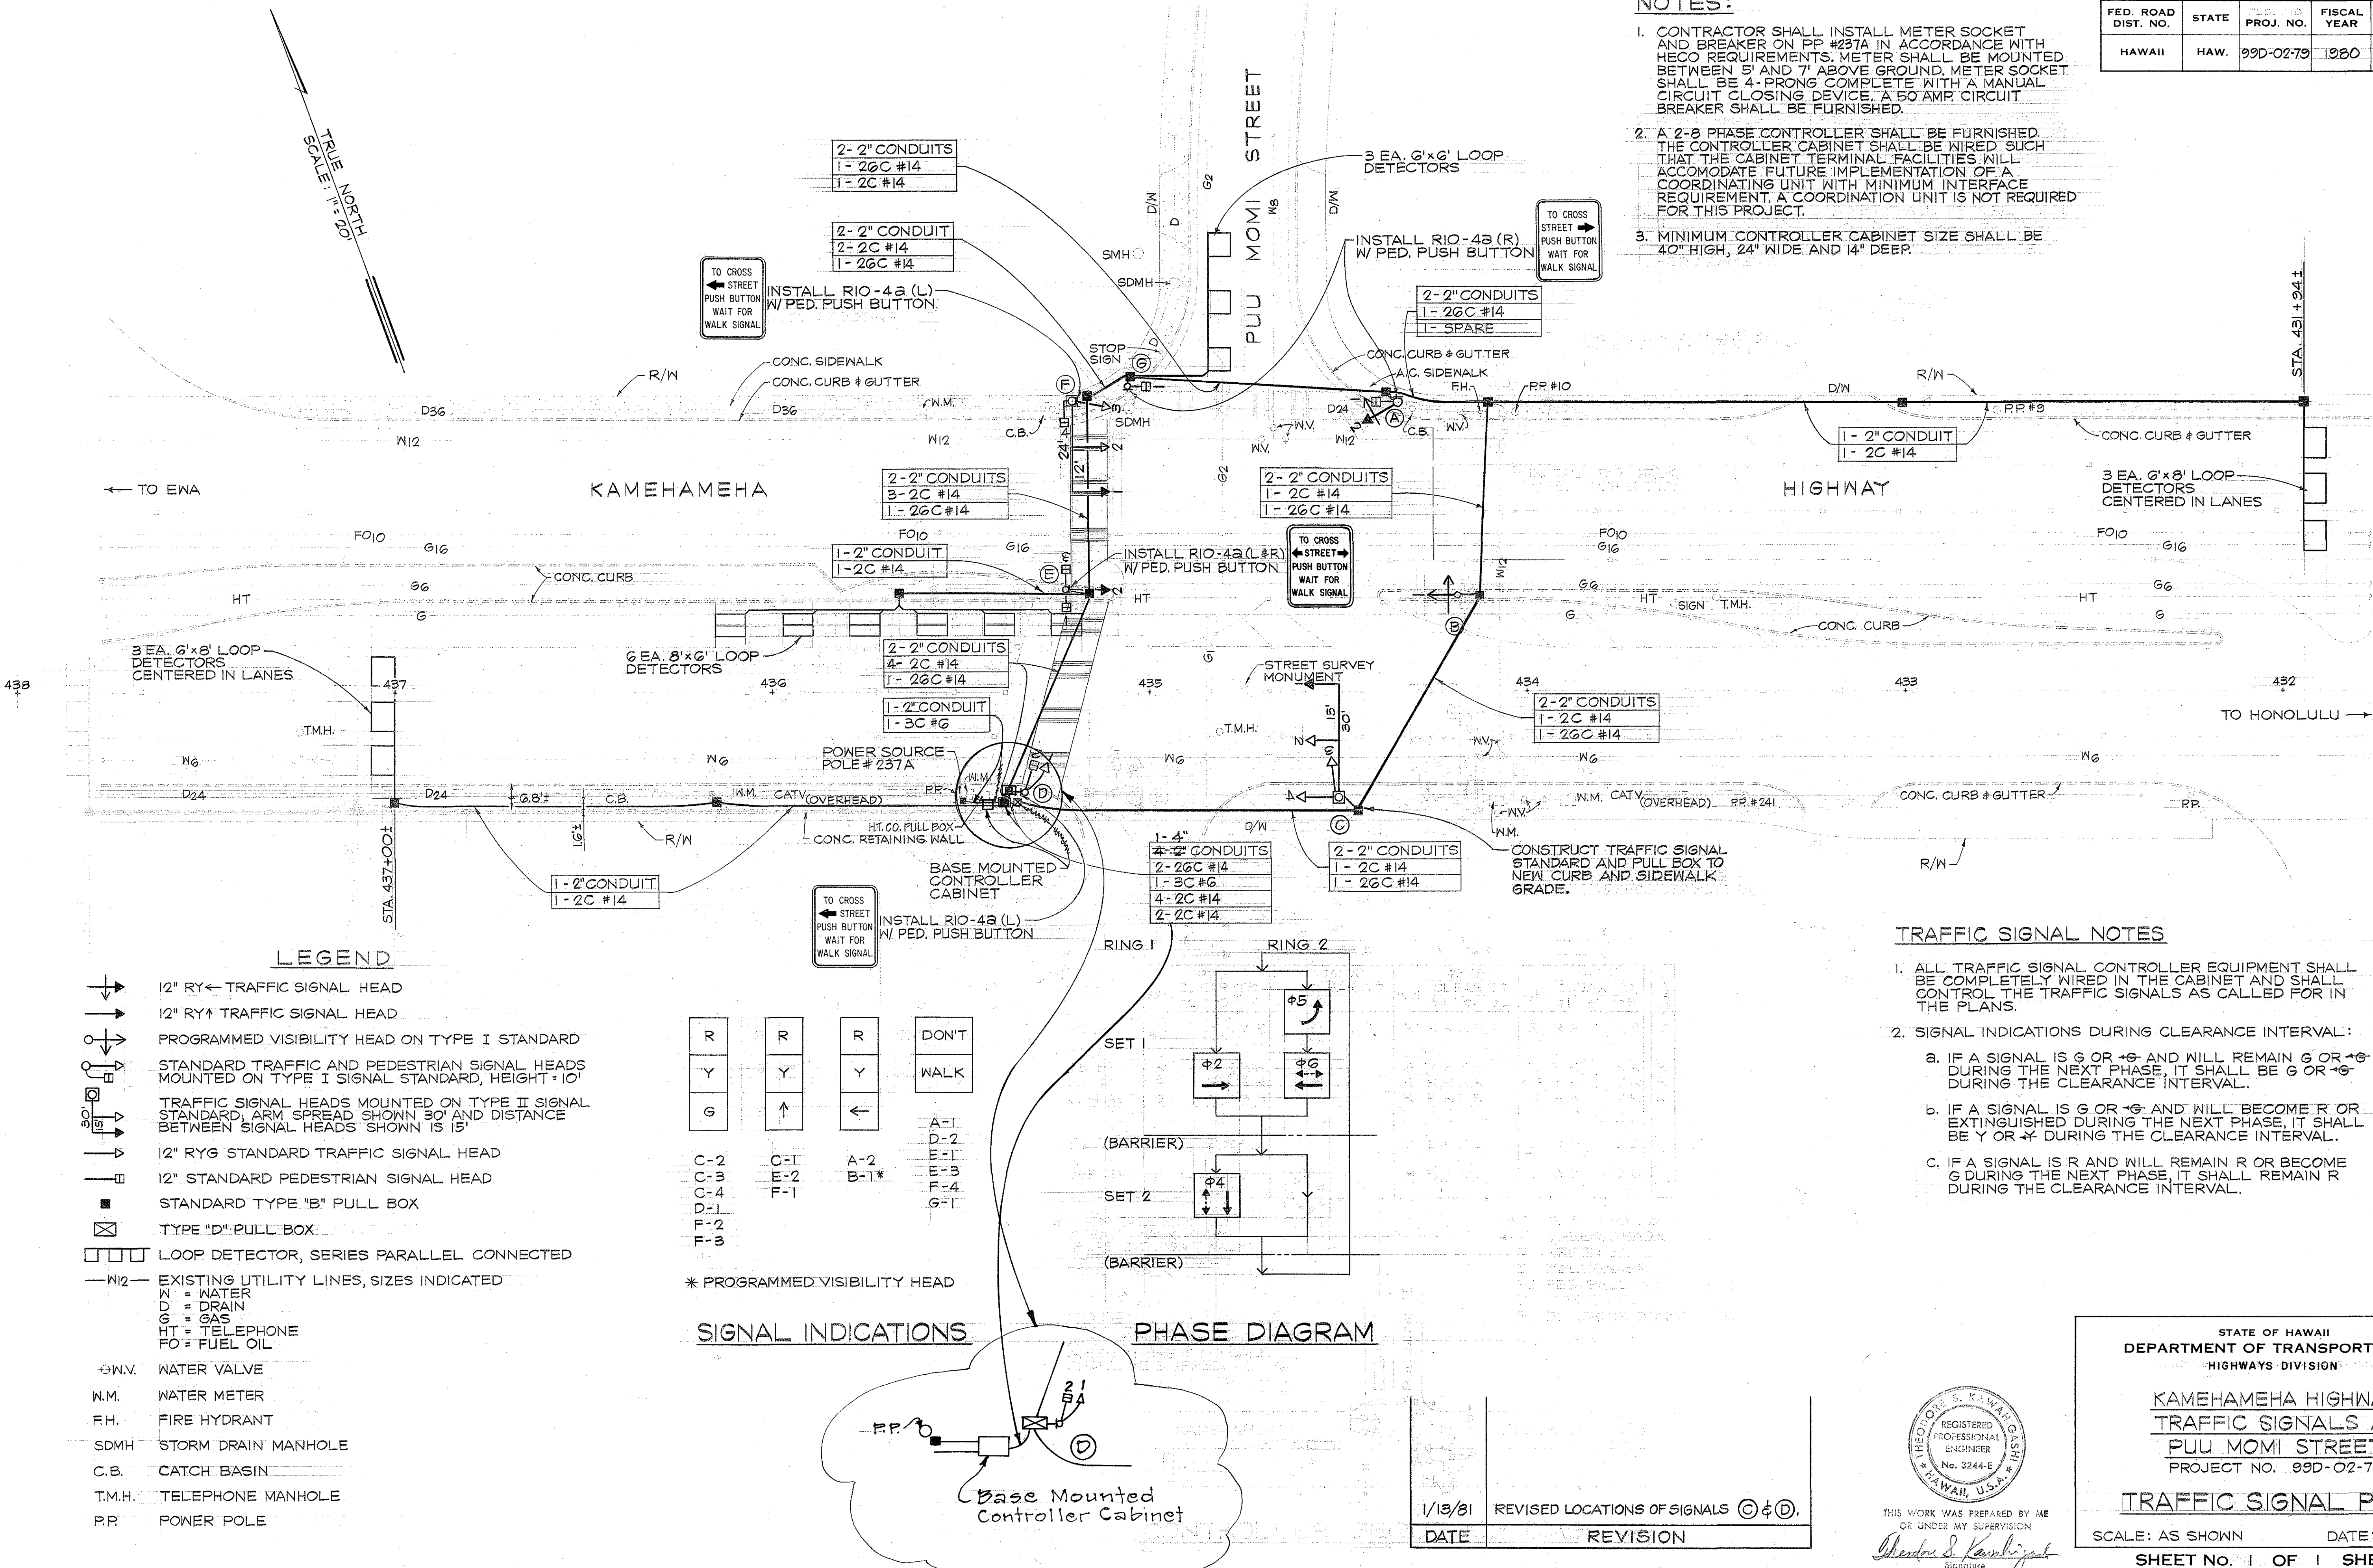

FED. ROAD DIST. NO.	STATE	FED. PROJ. NO.	FISCAL YEAR	SHEET NO.	TOTAL SHEETS
HAWAII	HAW.	99D-02-79	1980	2	18

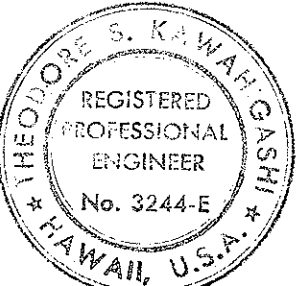

THIS WORK WAS PREPARED BY ME OR UNDER MY SUPERVISION
 Theodore S. Kawahigashi
 Signature

STATE OF HAWAII
 DEPARTMENT OF TRANSPORTATION
 HIGHWAYS DIVISION

KAMEHAMEHA HIGHWAY
 TRAFFIC SIGNALS AT
 PUU MOMI STREET
 PROJECT NO. 99D-02-79

TRAFFIC SIGNAL PLAN

SCALE: AS SHOWN DATE: 6-6-79
 SHEET NO. 1 OF 1 SHEETS

1/13/81	REVISED LOCATIONS OF SIGNALS ② & ③.
DATE	REVISION

C.O. 2