


FED. ROAD DIST. NO.	STATE	PROJ. NO.	FISCAL YEAR	SHEET NO.	TOTAL SHEETS
HAWAII	HAW.	99D-01-79	1980	4	19

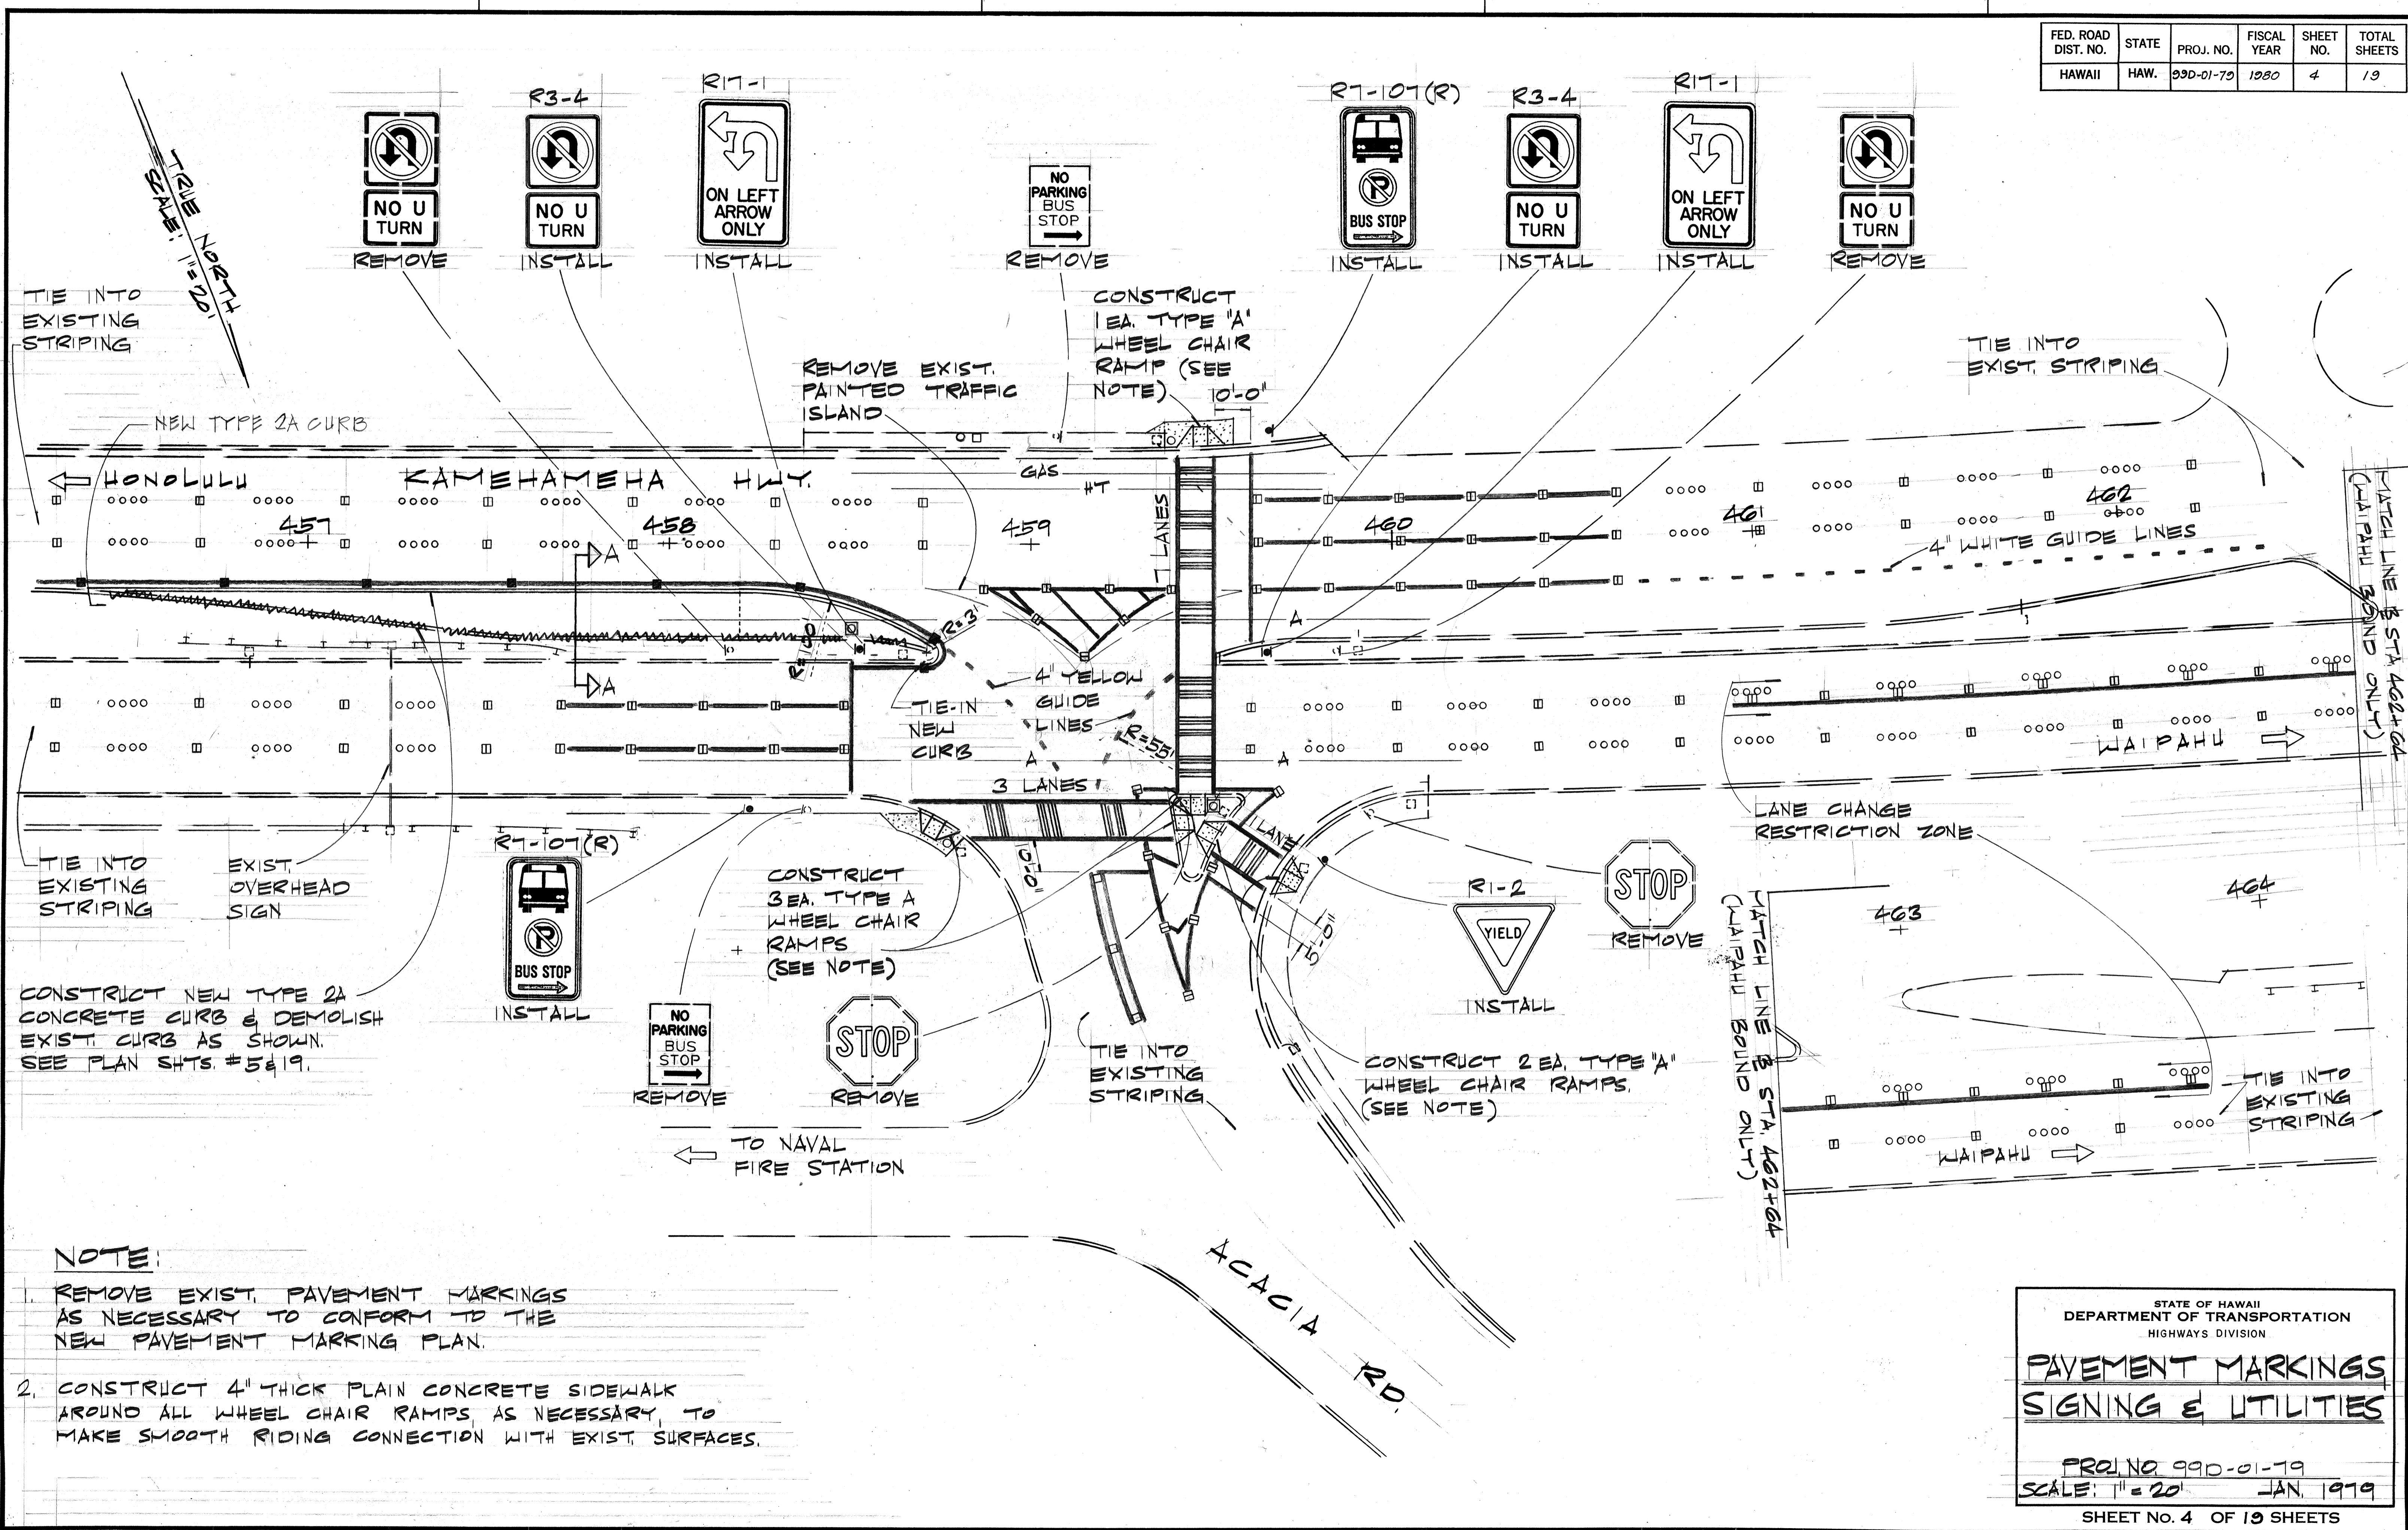

SCALE: 1" = 20'
TIE INTO EXISTING STRIPING

TIE INTO EXIST. STRIPING

MATCH LINE @ STA 464+64
(WAIPAHU BOUND ONLY)

MATCH LINE @ STA 462+64
(WAIPAHU BOUND ONLY)

TIE INTO EXISTING STRIPING

TIE INTO EXISTING STRIPING

CONSTRUCT NEW TYPE 2A CONCRETE CURB & DEMOLISH EXIST. CURB AS SHOWN. SEE PLAN SHTS. # 5 & 19.

REMOVE EXIST. PAINTED TRAFFIC ISLAND

CONSTRUCT 1 EA. TYPE 'A' WHEEL CHAIR RAMP (SEE NOTE)

CONSTRUCT 3 EA. TYPE 'A' WHEEL CHAIR RAMP (SEE NOTE)

CONSTRUCT 2 EA. TYPE 'A' WHEEL CHAIR RAMP (SEE NOTE)

LANE CHANGE RESTRICTION ZONE

TO NAVAL FIRE STATION

ACACIA RD.

NOTE:

- REMOVE EXIST. PAVEMENT MARKINGS AS NECESSARY TO CONFORM TO THE NEW PAVEMENT MARKING PLAN.
- CONSTRUCT 4" THICK PLAIN CONCRETE SIDEWALK AROUND ALL WHEEL CHAIR RAMP AS NECESSARY, TO MAKE SMOOTH RIDING CONNECTION WITH EXIST. SURFACES.

SURVEY PLOTTED BY	DATE
DRAWN BY	
DESIGNED BY	
QUANTITIES BY	
CHECKED BY	
ORIGINAL PLAN	No.
NOTE BOOK	

STATE OF HAWAII
DEPARTMENT OF TRANSPORTATION
HIGHWAYS DIVISION

**PAVEMENT MARKINGS
SIGNING & UTILITIES**

PROJ. NO. 99D-01-79
SCALE: 1" = 20' JAN. 1979
SHEET No. 4 OF 19 SHEETS