, ·	INDEX TO DRAWINGS
SHEET NO.	DESCRIPTION
i	TITLE SHEET
2	SIGNING, PAVEMENT MARKING AND CONSTRUCTION PLAN AND DETAILS
3	TRAFFIC SIGNAL PLAN
4 - 5	TYPICAL DETAILS OF WHEELCHAIR RAMP
6 - 14	STANDARD DETAILS
:	



STATE OF HAWAII


DEPARTMENT OF TRANSPORTATION HIGHWAYS DIVISION


"AS BUILT"
PLANS FOR

KAMEHAMEHA HIGHWAY
TRAFFIC SIGNALS AT HEKAHA STREET

DISTRICT OF EWA

PROJECT NO. 99D-01-81

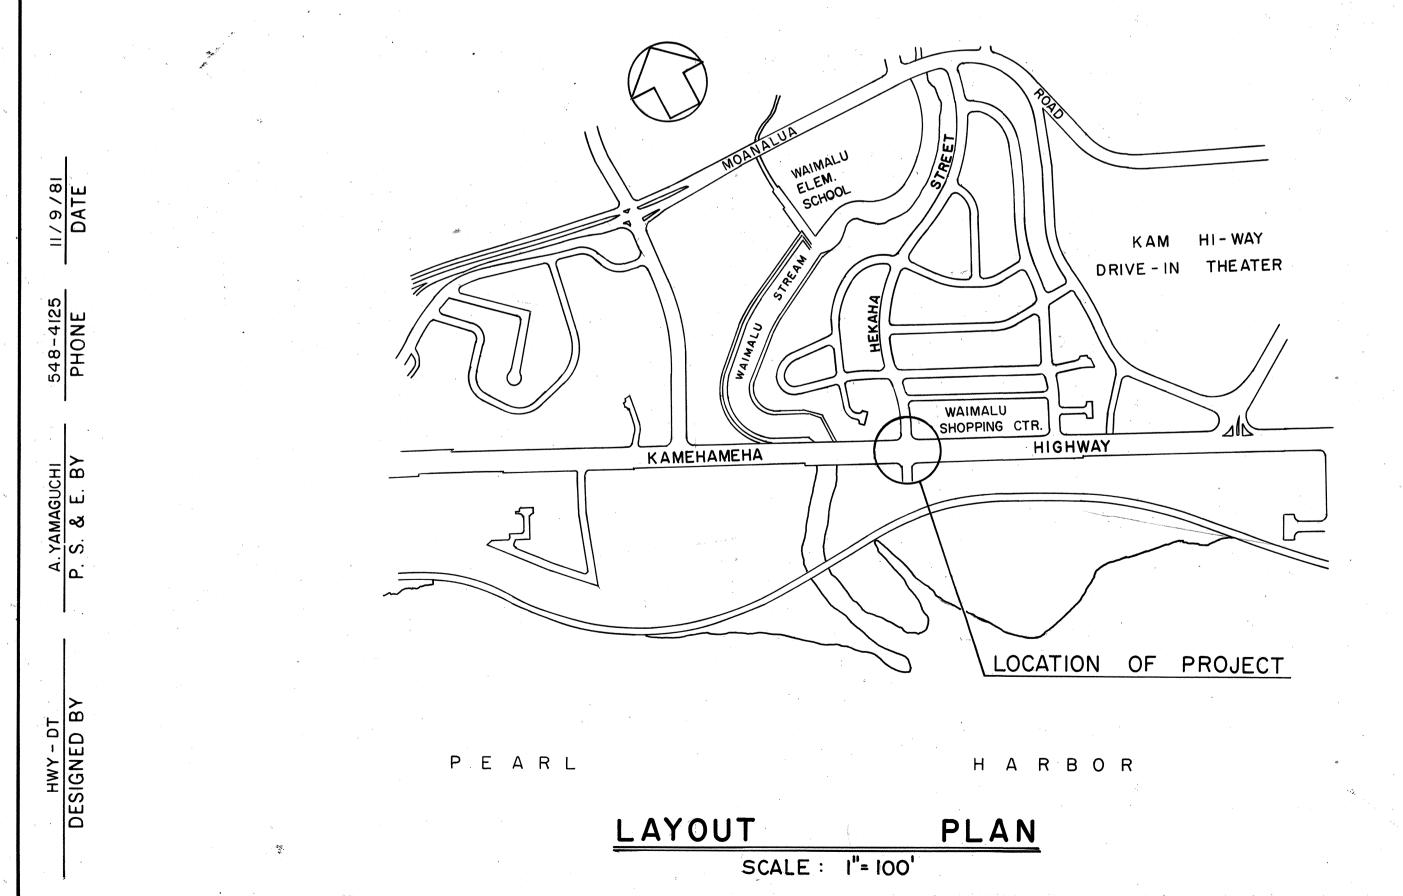

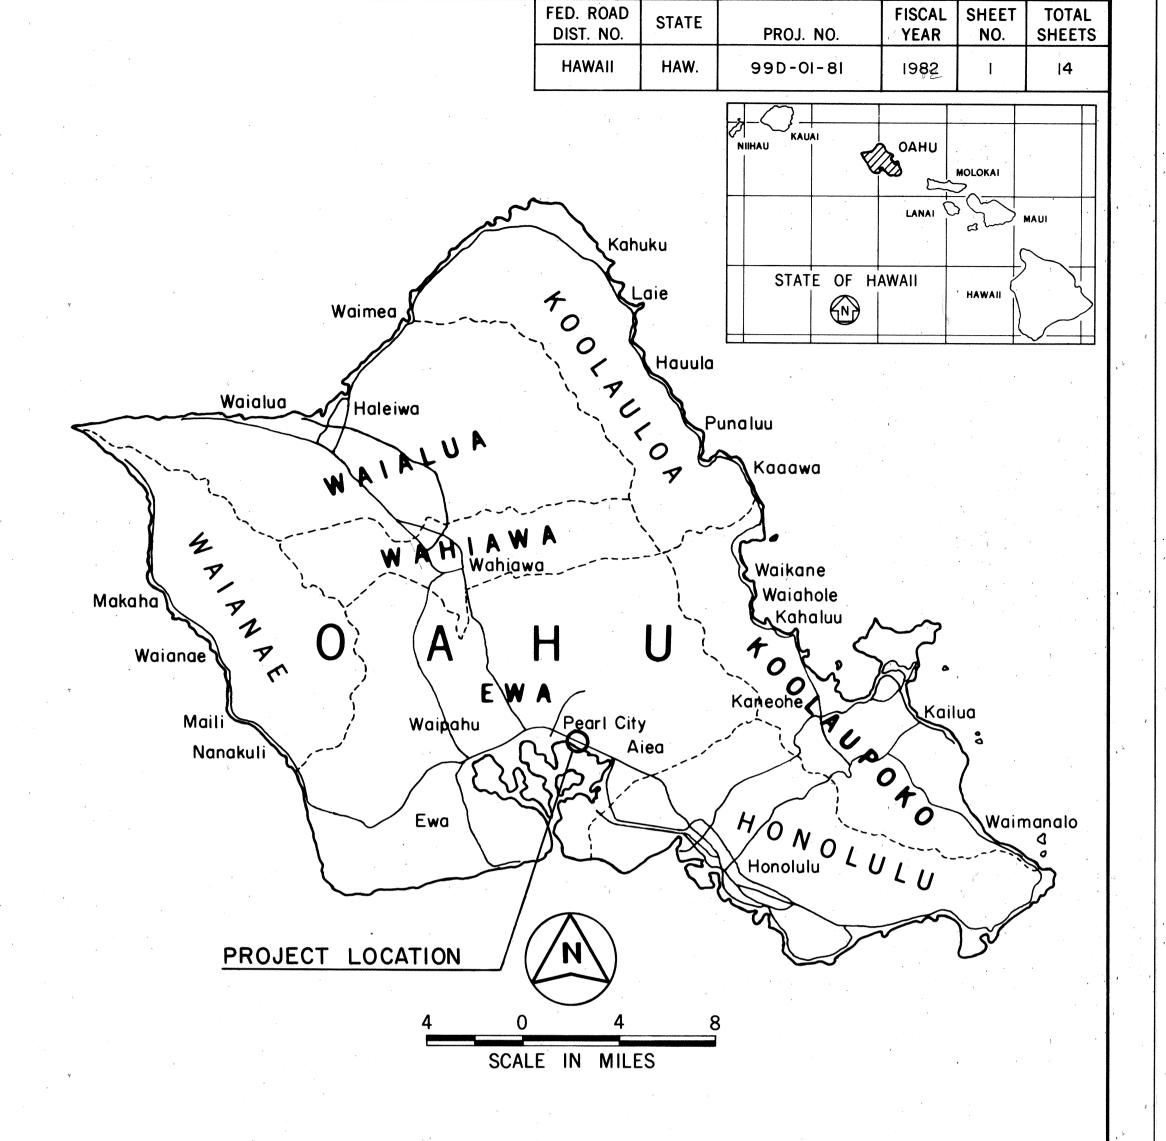

ALL CHANGES MADE DURING CONSTRUCTION HAVE BEEN INCORPORATED ON THESE PLANS IN RED EXCEPT CHANGES IN THE ORIGINAL THEORETICAL QUANTITIES. FOR ACTUAL QUANTITIES, REFER TO PROJECT LEDGER AND/OR COMPUTATION BOOK.

Michael Diniegee RESIDENT ENGINEER

DEPARTMENT OF TRANSPORTATION
STATE OF HAWAII

APPROVED:

James K. Carras 1/9/8/
JOIR. OF TRANSPORTATION DATE