	INDEX TO DRAWINGS
SHEET NO.	DESCRIPTION
	TITLE SHEET
2	PLAN, PROFILE AND DETAILS
3-12	STANDARD DETAILS
•	



STATE OF HAWAII




DEPARTMENT OF TRANSPORTATION HIGHWAYS DIVISION

HONOLULU, HAWAII
"AS BUILT"

PLANS FOR

KAMEHAMEHA HIGHWAY ROADSIDE IMPROVEMENTS VICINITY OF AIEA KAI SUBDIVISION PROJECT NO. 998-01-82

DISTRICT OF EWA

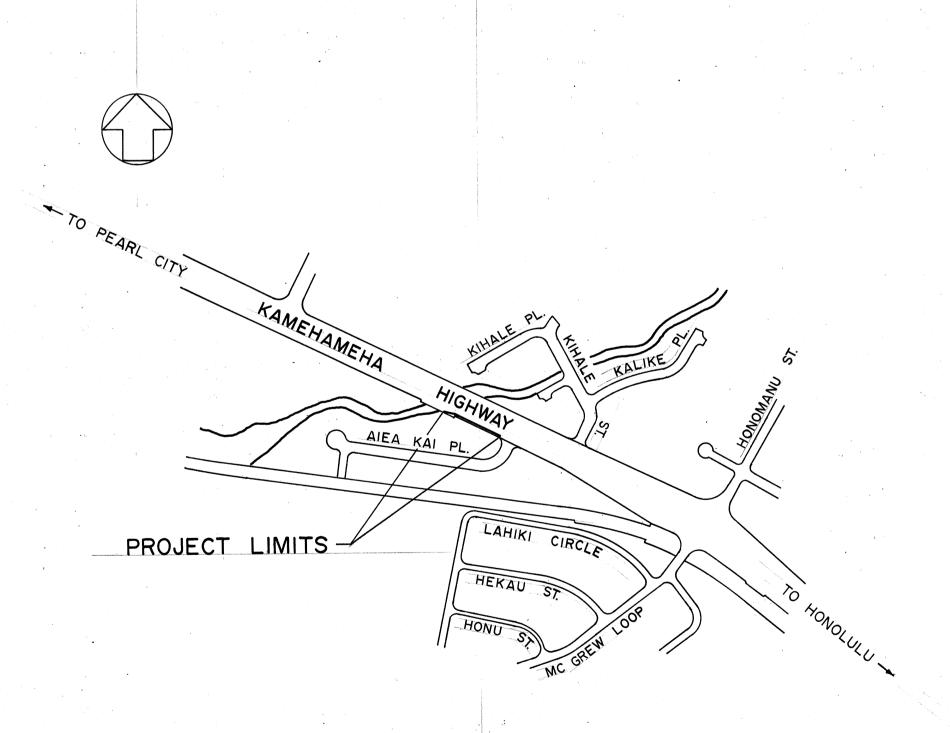


LAYOUT PLAN

O 4 8 12 16

SCALE IN HUNDRED FEET

FED. ROAD DIST. NO. STATE PROJ. NO. FISCAL SHEET TOTAL SHEETS

HAWAII HAW. 99B - 01 - 82 1982 1 12

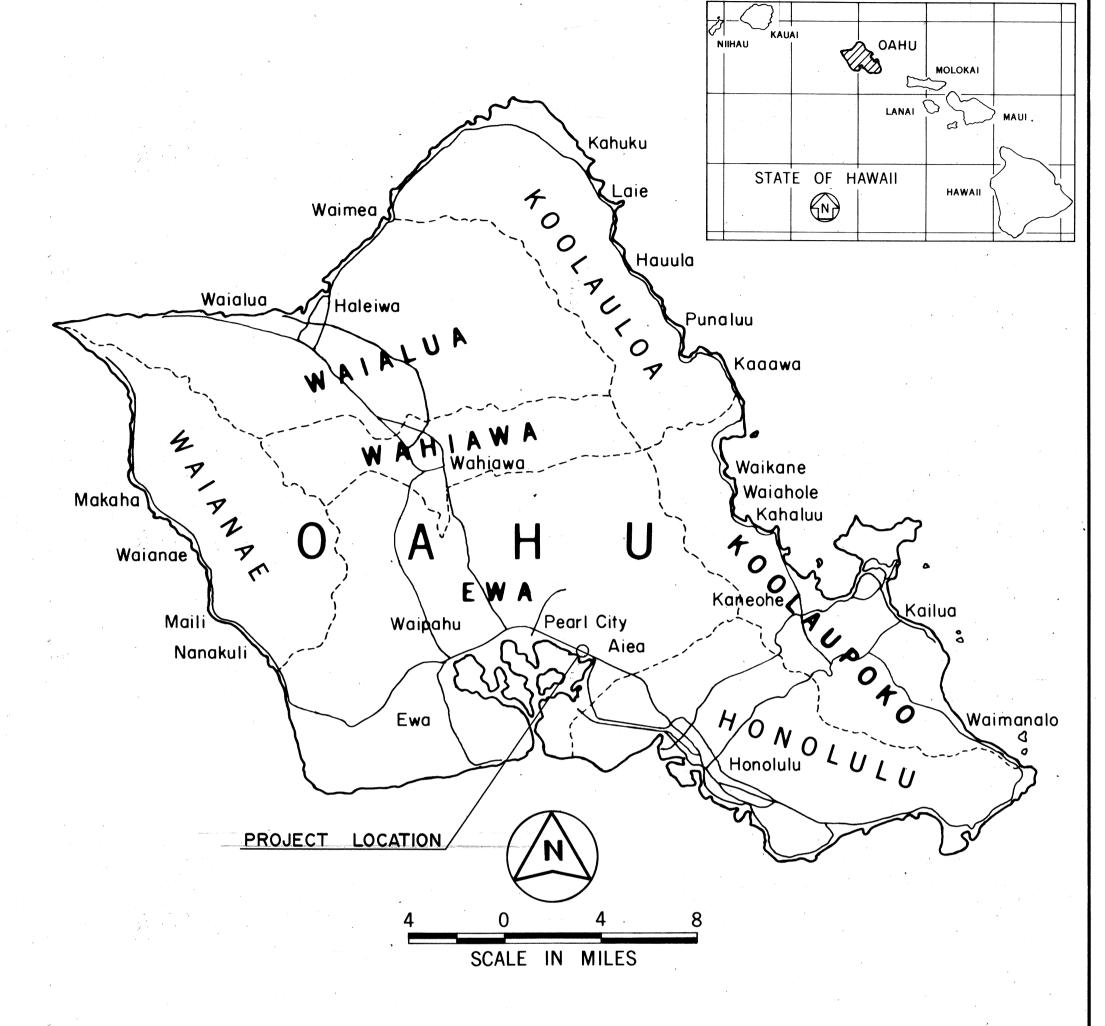

ALL CHANGES MADE DURING CONSTRUCTION HAVE BEEN INCORPORATED ON THESE PLANS IN RED EXCEPT CHANGES IN THE ORIGINAL THEORETICAL QUANTITIES, FOR ACTUAL QUANTITIES, REFER TO PROJECT LEDGER AND/OR COMPUTATION BOOK.

Michael M. Diniga RESIDENT ENGINEER

10/6/82 DATE

DEPARTMENT OF TRANSPORTATION
STATE OF HAWAII

APPROVED:

Carras

Color TRANSPORTATION

DIR OF TRANSPORTATION

DATE