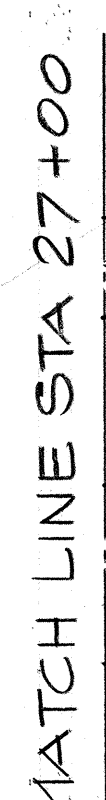


SYMBOLS		FED. ROAD DIST. NO.	STATE
	EXISTING HIGHWAY LUMINAIRE ON METAL STANDARD		
	NEW HIGHWAY LUMINAIRE ON METAL STANDARD		
	NEW PULLBOX TYPE B		
	NEW SERVICE EQUIPMENT		
	EXISTING MERCURY LUMINAIRE ON METAL STANDARD, REPLACE WITH NEW HIGH PRESSURE SODIUM LUMINAIRE		
	EXISTING STREET LIGHT PULLBOX		
	NEW UNDERGROUND WIRING IN UNDERGROUND CONDUIT		
	EXISTING UNDERGROUND WIRING IN UNDERGROUND CONDUIT TO REMAIN		
	EXISTING UNDERGROUND WIRING IN UNDERGROUND CONDUIT TO BE REMOVED		
	NEW UNDERGROUND STREET LIGHT WIRING		

MATCH LINE STA 13+00

- STREET LIGHTING PLAN
SCALE: 1" = 50'-0"

John R. Elliott
HAWAIIAN ELECTRIC COMPANY

3/19/80
DATE

THIS WORK WAS PREPARED BY
OR UNDER MY SUPERVISION

Robert & Leona

KAMEHAMEHA HIGHWAY STREET LIGHTS
MEHEULA PARKWAY TO LANIKUHANA AVENUE
PROJECT NO. 99G-02-79

SHEET No. 3 OF 7 SHEETS