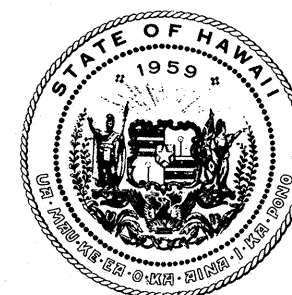


[illegible]

STATE OF HAWAII

DEPARTMENT OF TRANSPORTATION

HIGHWAYS DIVISION

"AS BUILT"

PLANS FOR

KAMEHAMEHA HIGHWAY STREET LIGHTS


MEHEULA PARKWAY TO LANIKUHANA AVENUE

PROJECT NO. 99C-02-79

DISTRICT OF WAHIAWA

ISLAND OF OAHU

FED. ROAD DIST. NO.	STATE	PROJ. NO.	FISCAL YEAR	SHEET NO.	TOTAL SHEET
HAWAII	HAW.	99C-02-79	1982	1	7

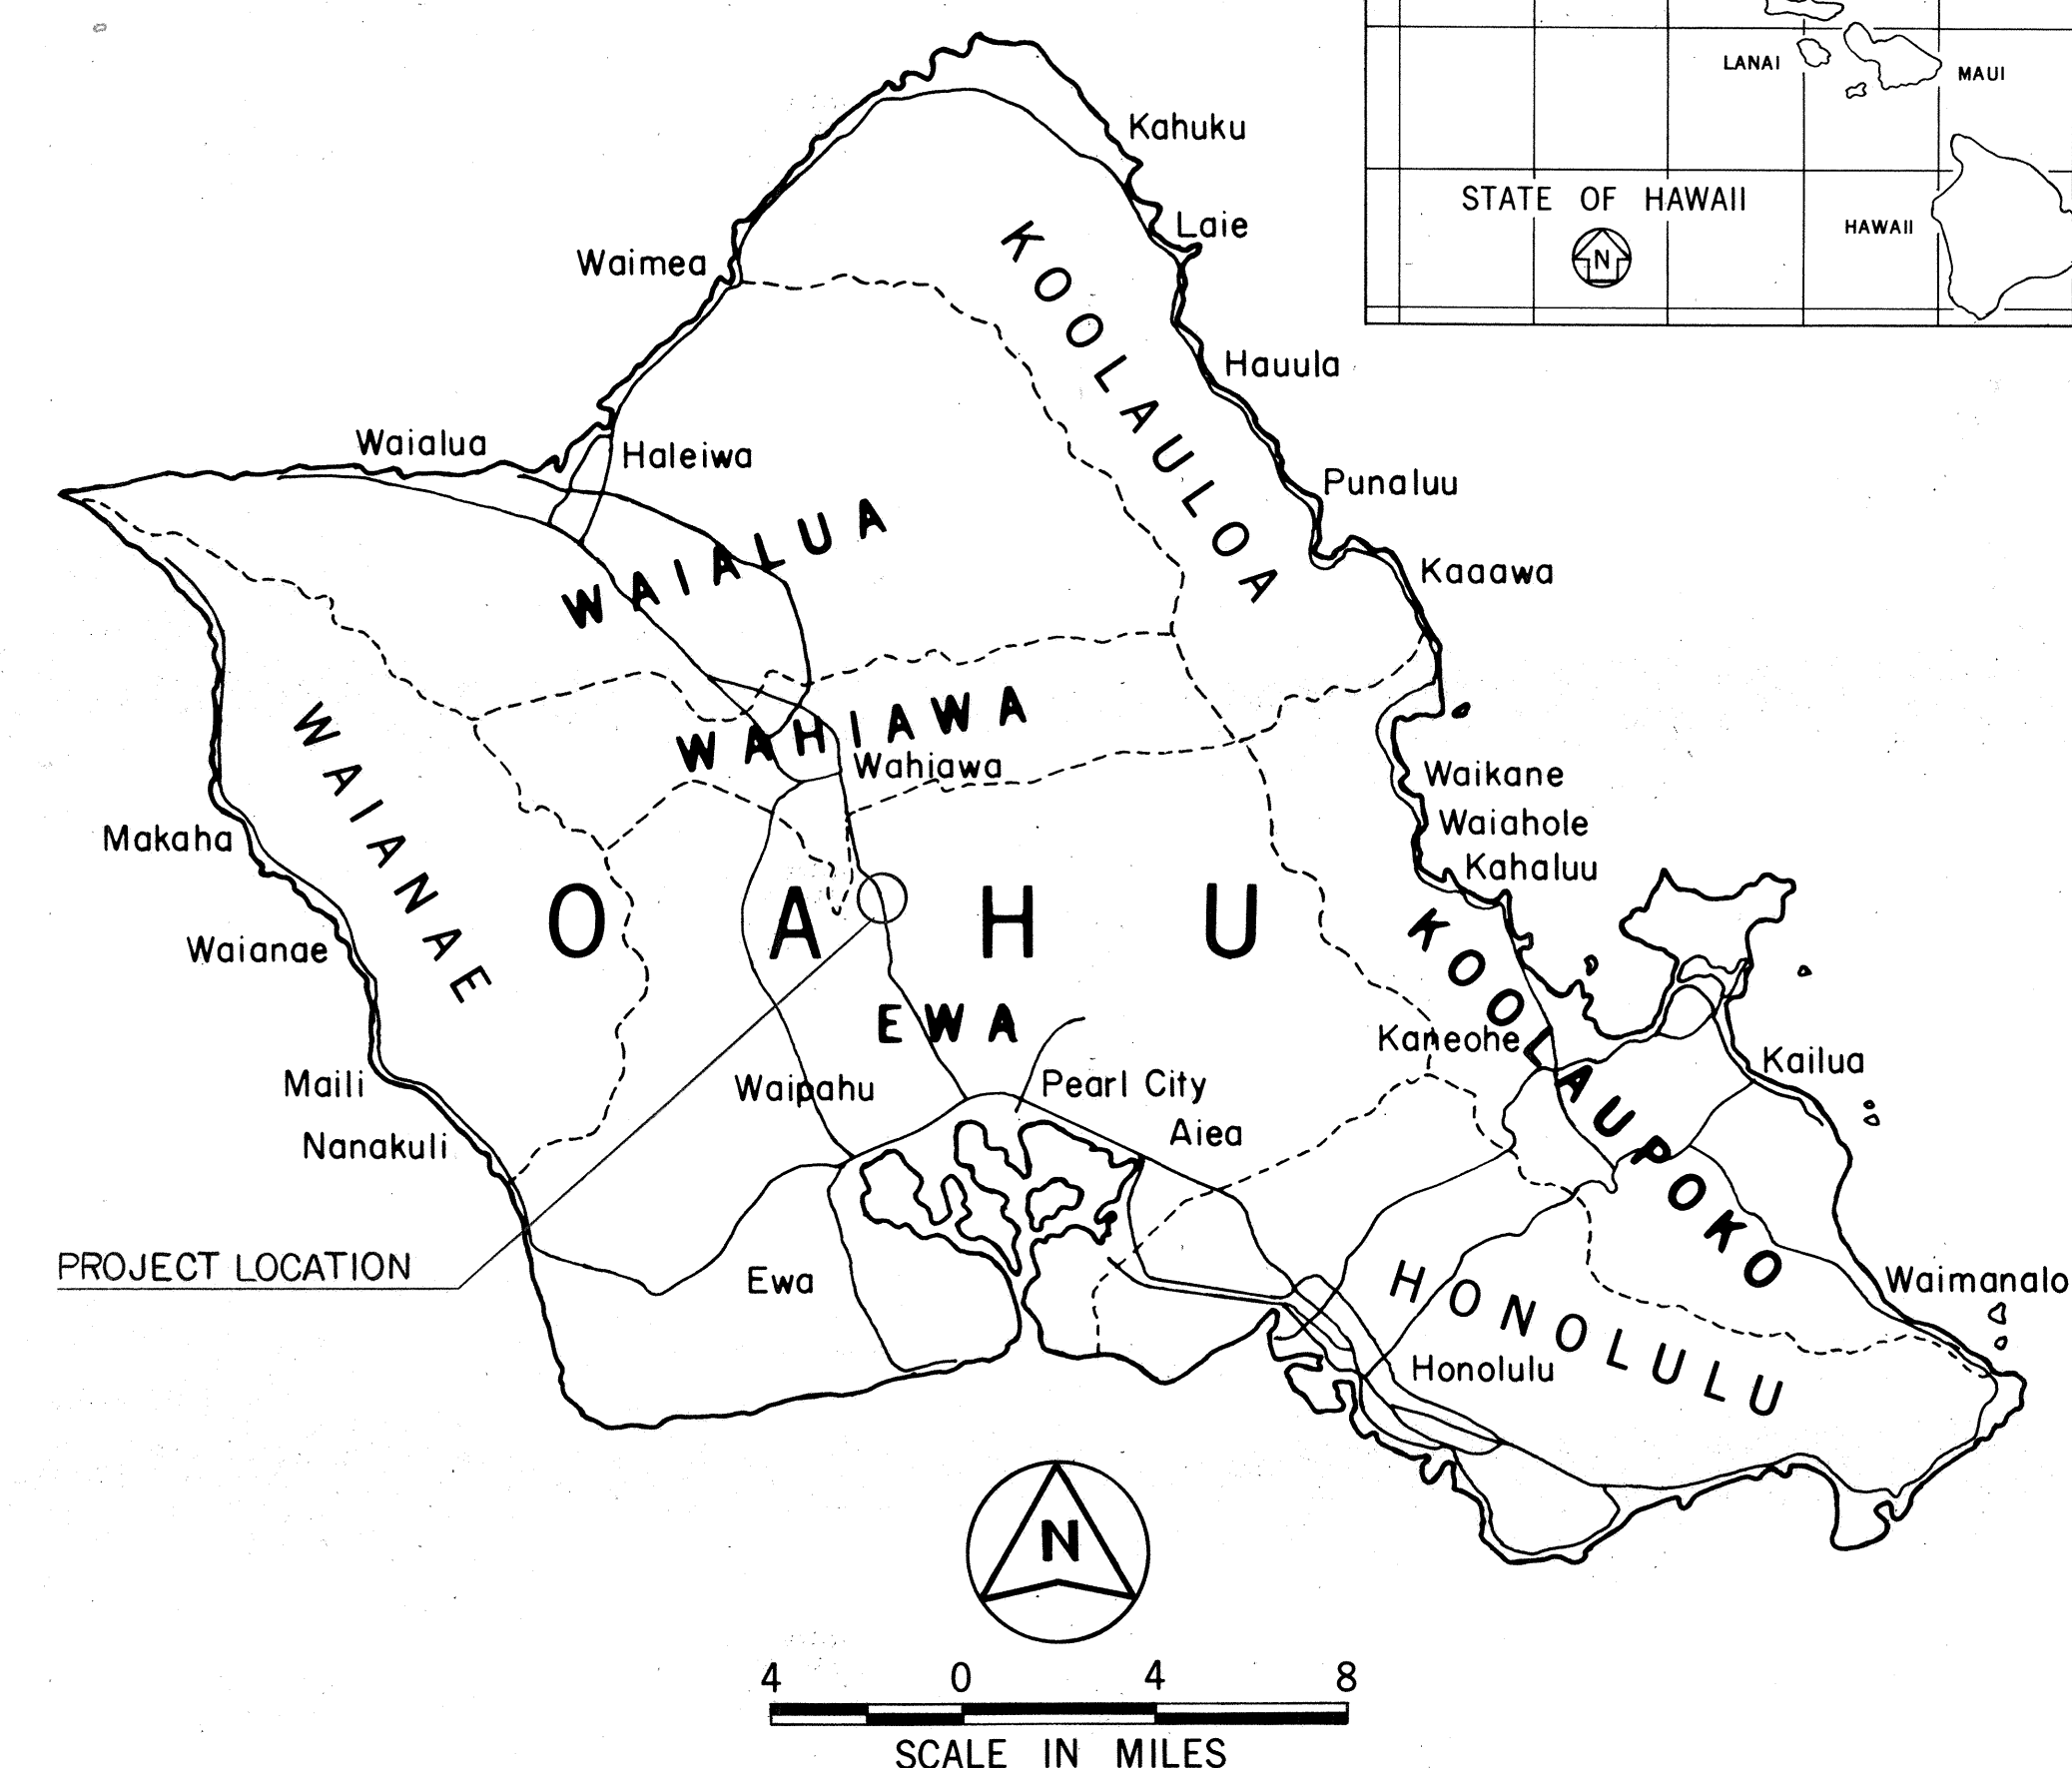

NO CHANGES WERE MADE DURING CONSTRUCTION  
ON THESE PLANS EXCEPT CHANGES IN THE  
ORIGINAL THEORETICAL QUANTITIES. FOR ACTUAL  
QUANTITIES, REFER TO PROJECT LEDGER AND/OR  
COMPUTATION BOOK.

Ronald N. Kan  
RESIDENT ENGINEER

4/20/83  
DATE

DEPARTMENT OF TRANSPORTATION STATE OF HAWAII	
APPROVED:	
<i>James R. Carras</i> _____ DIR. OF TRANSPORTATION	7/21/80 _____ DATE