

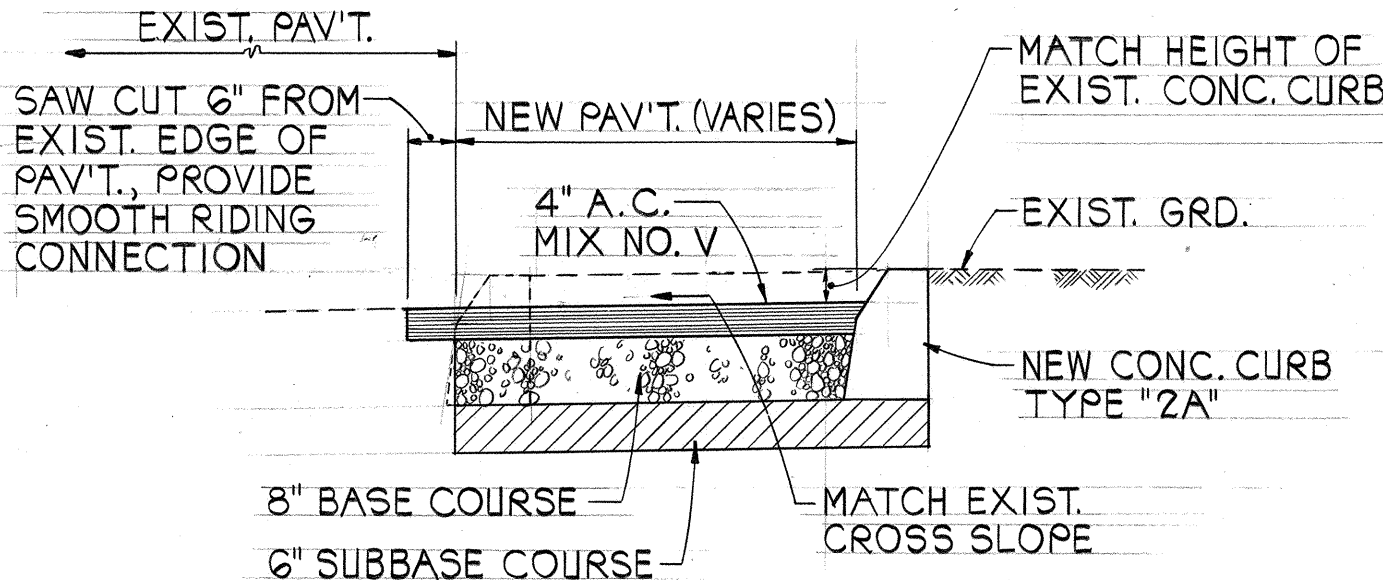
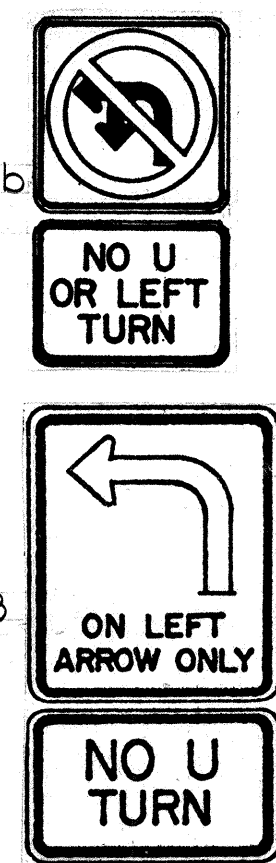


FED. ROAD DIST. NO.	STATE	PROJ. NO.	FISCAL YEAR	SHEET NO.	TOTAL SHEETS
HAWAII	HAW.	99D-01-82	1983	3	19

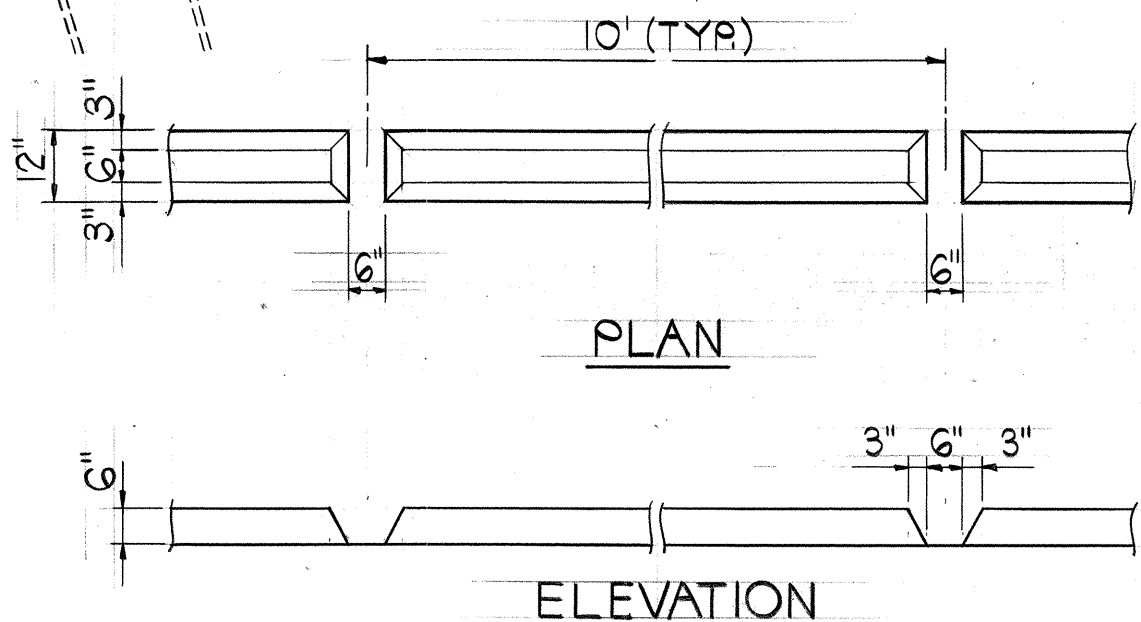

TYP. PAVEMENT SECTION
NOT TO SCALE

TRUE NORTH
SCALE: 1" = 20'

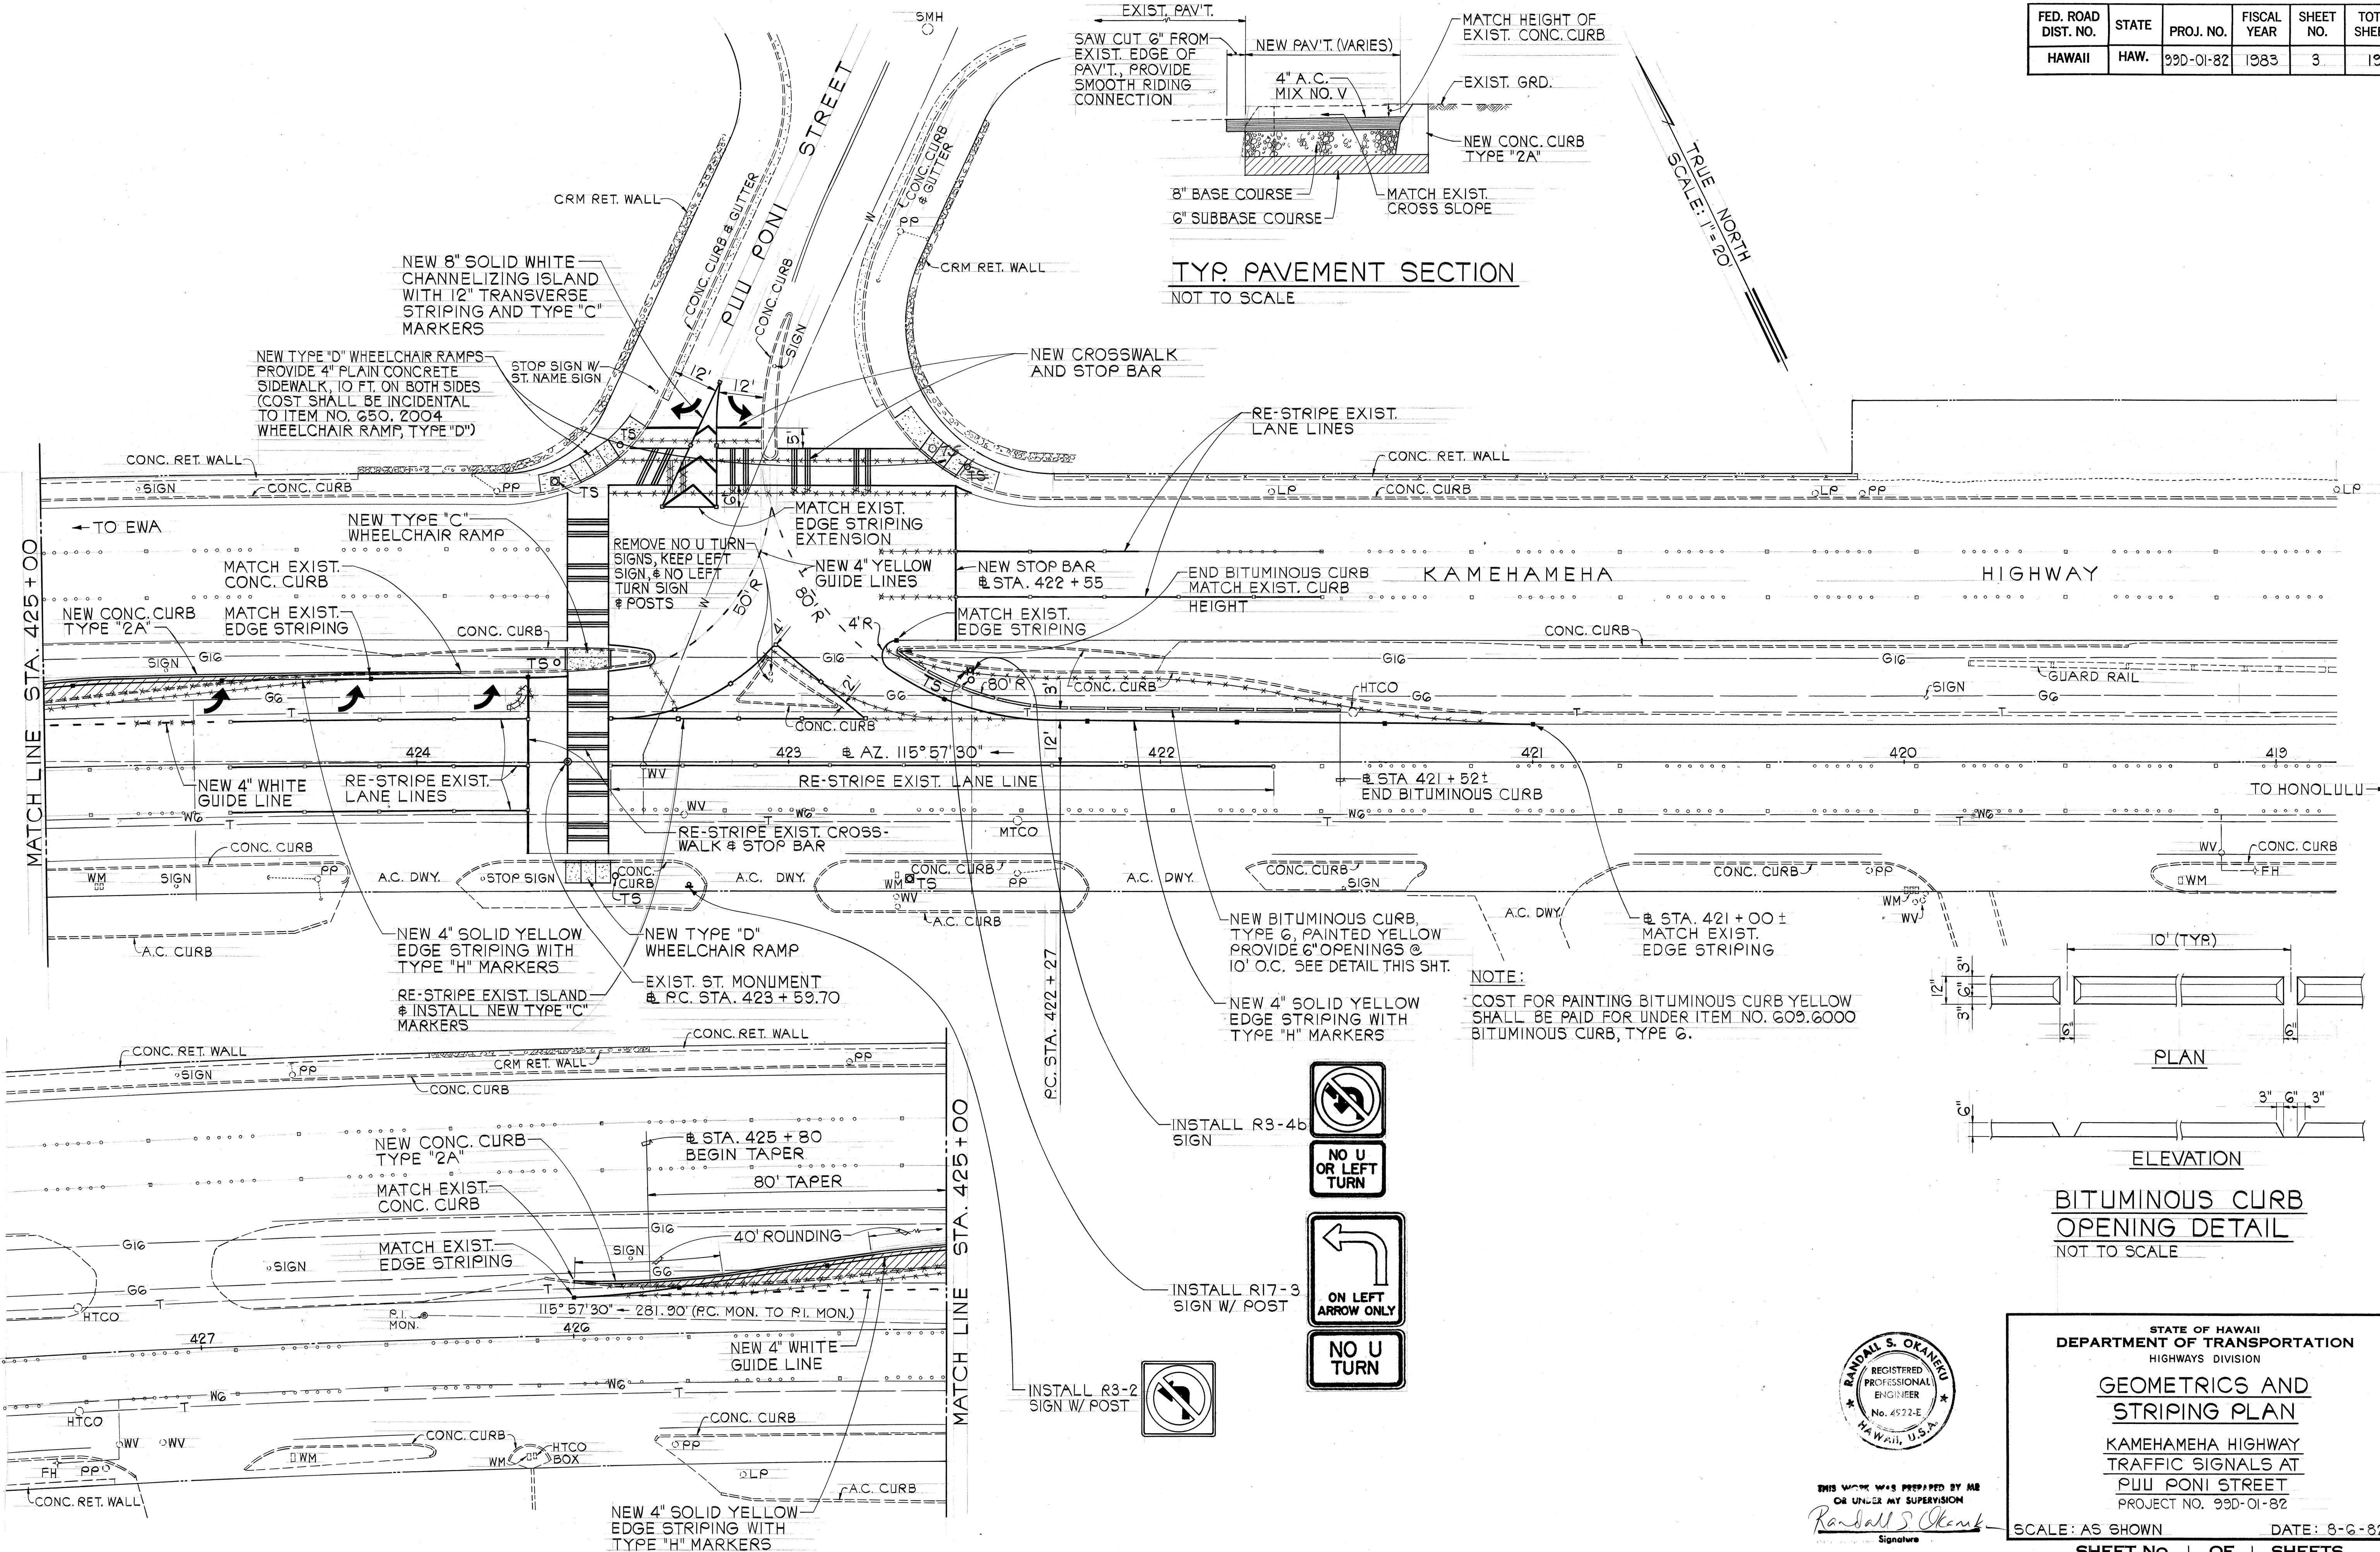

THIS WORK WAS PREPARED BY ME
OR UNDER MY SUPERVISION
Randall S. Okamoto
Signature

STATE OF HAWAII
DEPARTMENT OF TRANSPORTATION
HIGHWAYS DIVISION

GEOMETRICS AND STRIPING PLAN
KAMEHAMEHA HIGHWAY
TRAFFIC SIGNALS AT
PUU PONI STREET
PROJECT NO. 99D-01-82

SCALE: AS SHOWN
DATE: 8-6-82
SHEET NO. 1 OF 1 SHEETS

ORIGINAL PLAN	SURVEY PLOTTED BY	DATE
NOTE BOOK	DRAWN BY	
	DESIGNED BY	
	CHECKED BY	