	INDEX TO DRAWINGS
SHEET NO.	DESCRIPTION
i di l	TITLE SHEET
2	LEGEND AND NOTES
3	GEOMETRICS AND STRIPING PLAN
4	TRAFFIC SIGNAL PLAN
5-6	TYPICAL DETAILS OF WHEELCHAIR RAMPS
7-19	STANDARD DETAILS
1 33	



STATE OF HAWAII


DEPARTMENT OF TRANSPORTATION HIGHWAYS DIVISION

HONOLULU, HAWAII


"AS BUILT"
PLANS FOR

KAMEHAMEHA HIGHWAY TRAFFIC SIGNALS AT PUU PONI STREET PROJECT NO. 99D-01-82

DISTRICT OF EWA ISLAND OF OAHU

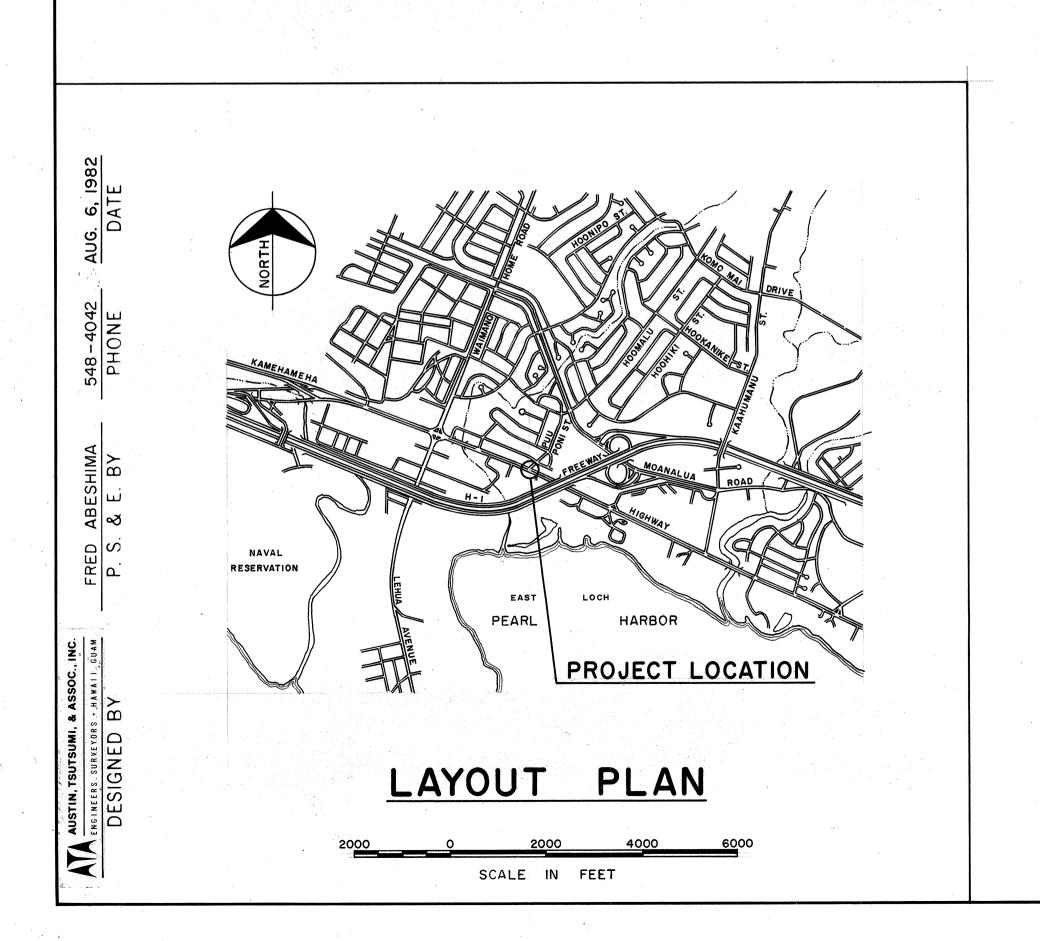



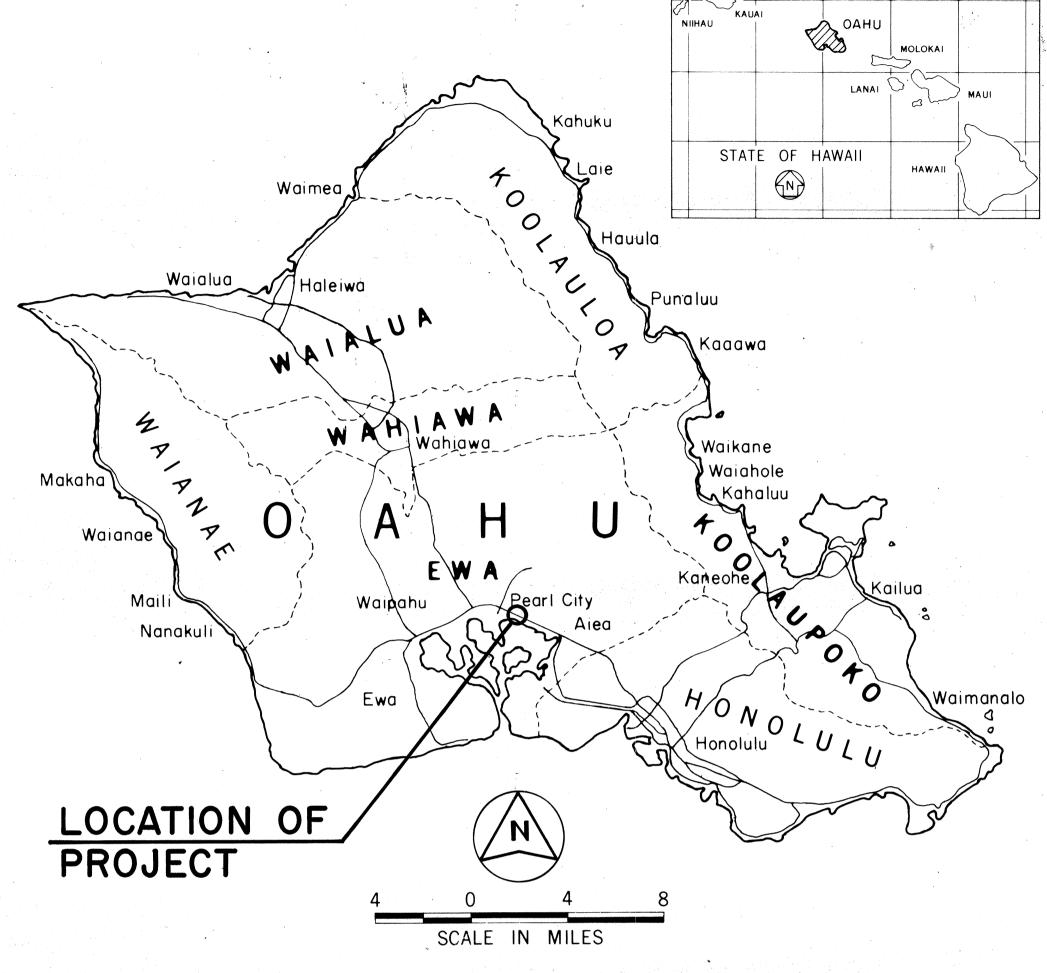

CHANGES MADE DURING CONSTRUCTION HAVE BEEN INCORPORATED ON THESE PLANS EXCEPT CHANGES IN THE ORIGINAL THEORETICAL QUANTITIES. FOR ACTUAL QUANTITIES, REFER TO PROJECT LEDGER AND/OR COMPUTATION BOOK.

RESIDENT ENGINEER

12-19-83 DATE

DEPARTMENT OF TRANSPORTATION
STATE OF HAWAII

ARPROVED:
DIR. OF TRANSPORTATION
DATE