



FED. ROAD DIST. NO.	STATE	PROJ. NO.	FISCAL YEAR	SHEET NO.	TOTAL SHEETS
HAWAII	HAW.	99C-01-83	1983	4	16

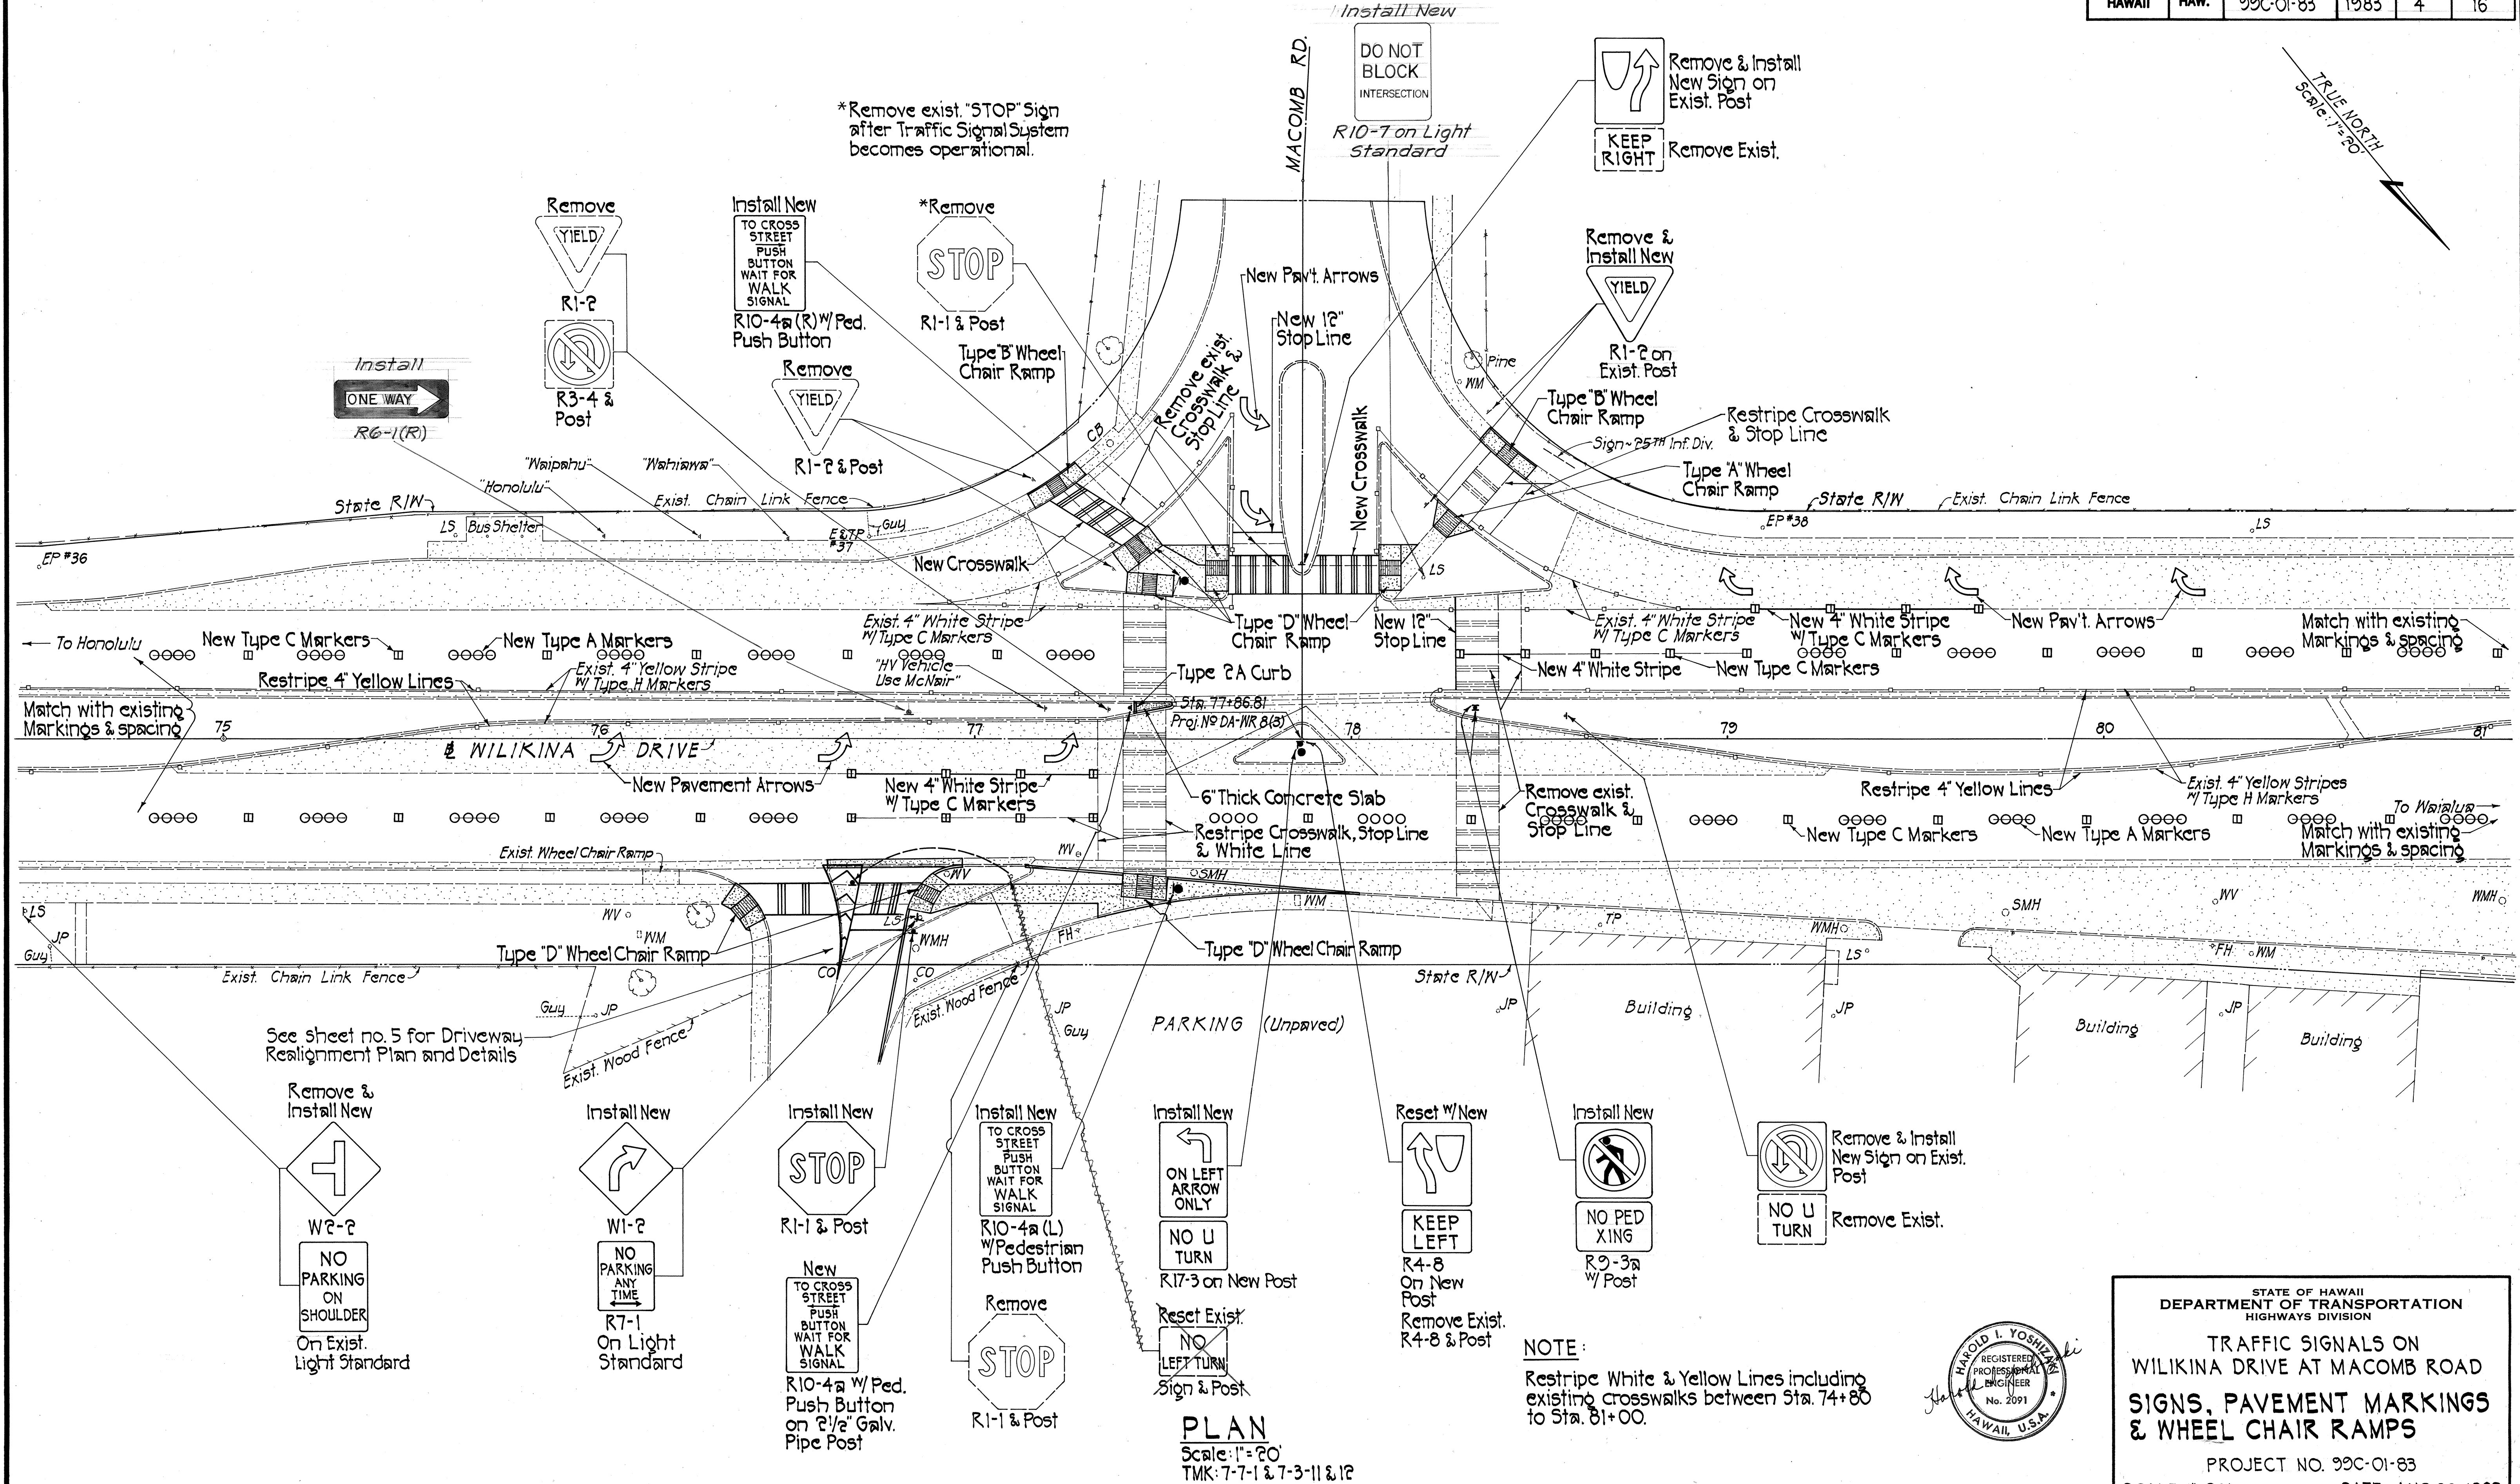

DATE	_____
DESIGNED BY	_____
CHECKED BY	_____
QUANTITIES BY	_____
NOTED BY	_____
ORIGINAL PLAN	_____

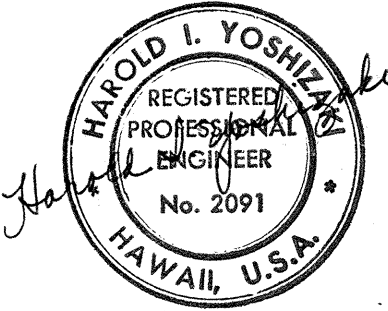

STATE OF HAWAII
DEPARTMENT OF TRANSPORTATION
HIGHWAYS DIVISION

TRAFFIC SIGNALS ON
WILIKINA DRIVE AT MACOMB ROAD
**SIGNS, PAVEMENT MARKINGS
& WHEEL CHAIR RAMP**

PROJECT NO. 99C-01-83
SCALE: 1"=20' DATE: AUG. 30, 1982

SHEET NO. 4 OF 16 SHEETS