	INDEX TO DRAWINGS
SHEET NO.	DESCRIPTION
1 .	TITLE SHEET
2	NOTES & LEGEND
3	TRAFFIC SIGNAL SYSTEM
4	SIGNS, PAVEMENT MARKINGS & WHEELCHAIR RAMPS
5	DRIVEWAY REALIGNMENT PLAN, SIGNS & MISC. DETAILS
6	TYPICAL DETAILS OF WHEELCHAIR RAMPS
7-16	STANDARD DETAILS
vi	
•	
·	
·	1
. '	\

D-4-8



STATE OF HAWAII


DEPARTMENT OF TRANSPORTATION


HIGHWAYS DIVISION

HONOLULU, HAWAII
"AS-BUILT"
PLANS FOR

ON WILIKINA DRIVE AT MACOMB ROAD PROJECT NO. 99C-01-83

DISTRICT OF WAHIAWA
ISLAND OF OAHU

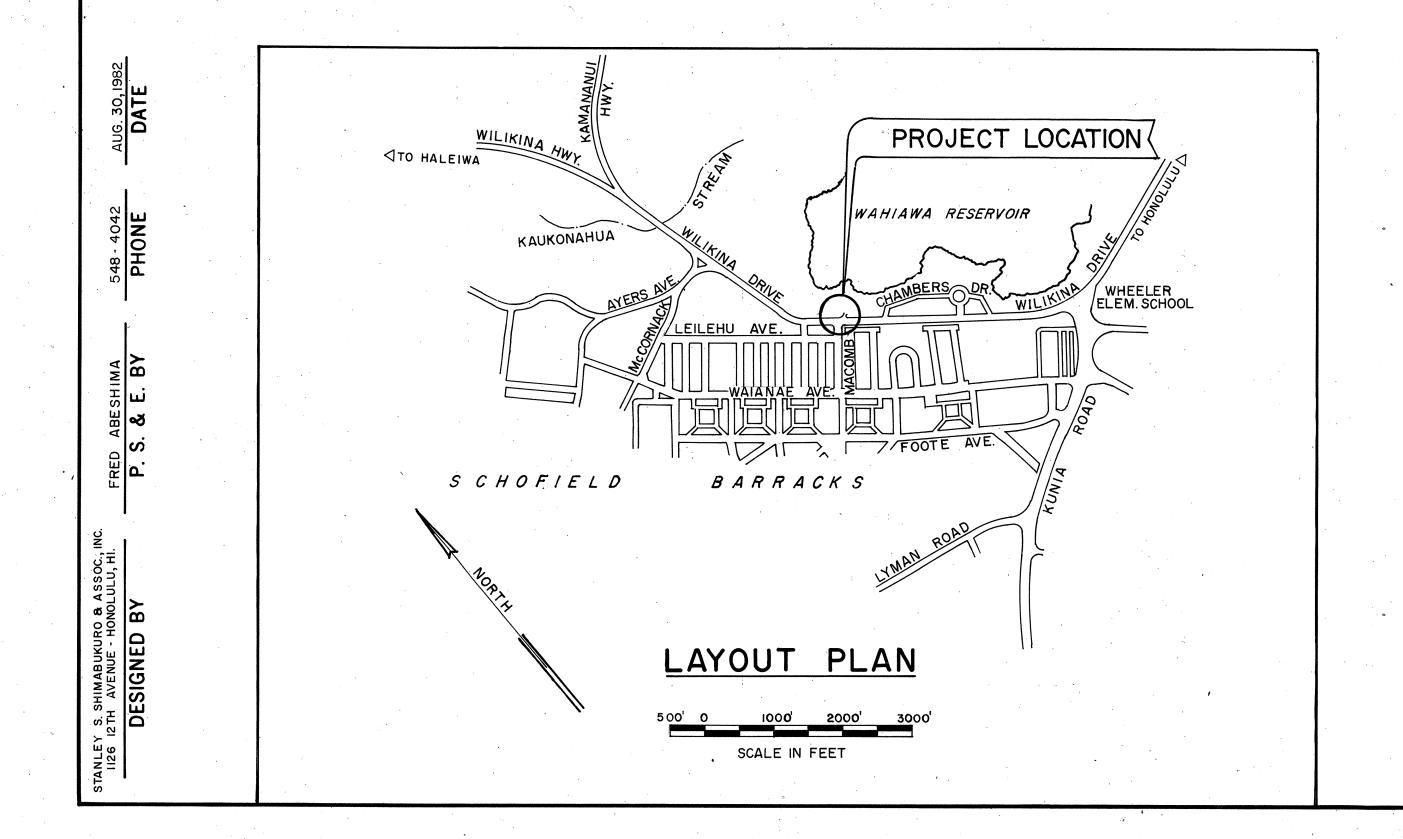

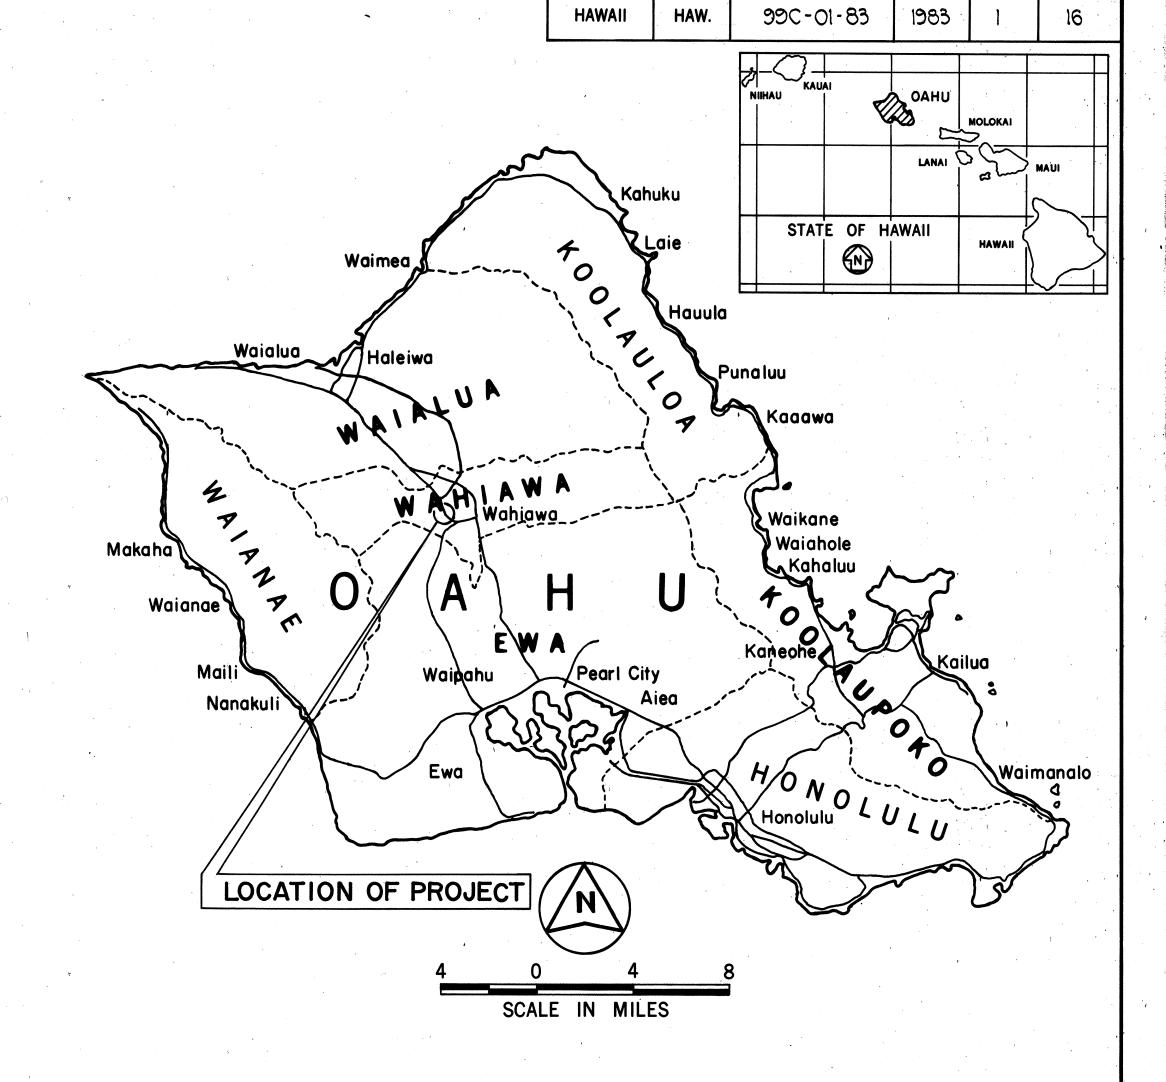

FED. ROAD DIST. NO.

PROJ. NO.

CHANGES MADE DURING CONSTRUCTION HAVE
BEEN INCORPORATED ON THESE PLANS EXCEPT
CHANGES IN THE ORIGINAL THEORETICAL
QUANTITIES. FOR ACTUAL QUANTITIES, REFER TO
PROJECT LEDGER AND/OR COMPUTATION BOOK.

RESIDENT ENGINEER

7/22/83 DATE

DEPARTMENT OF TRANSPORTATION
STATE OF HAWAII

APPROVED:

DIR. OF TRANSPORTATION

DATE