
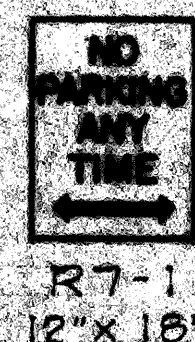
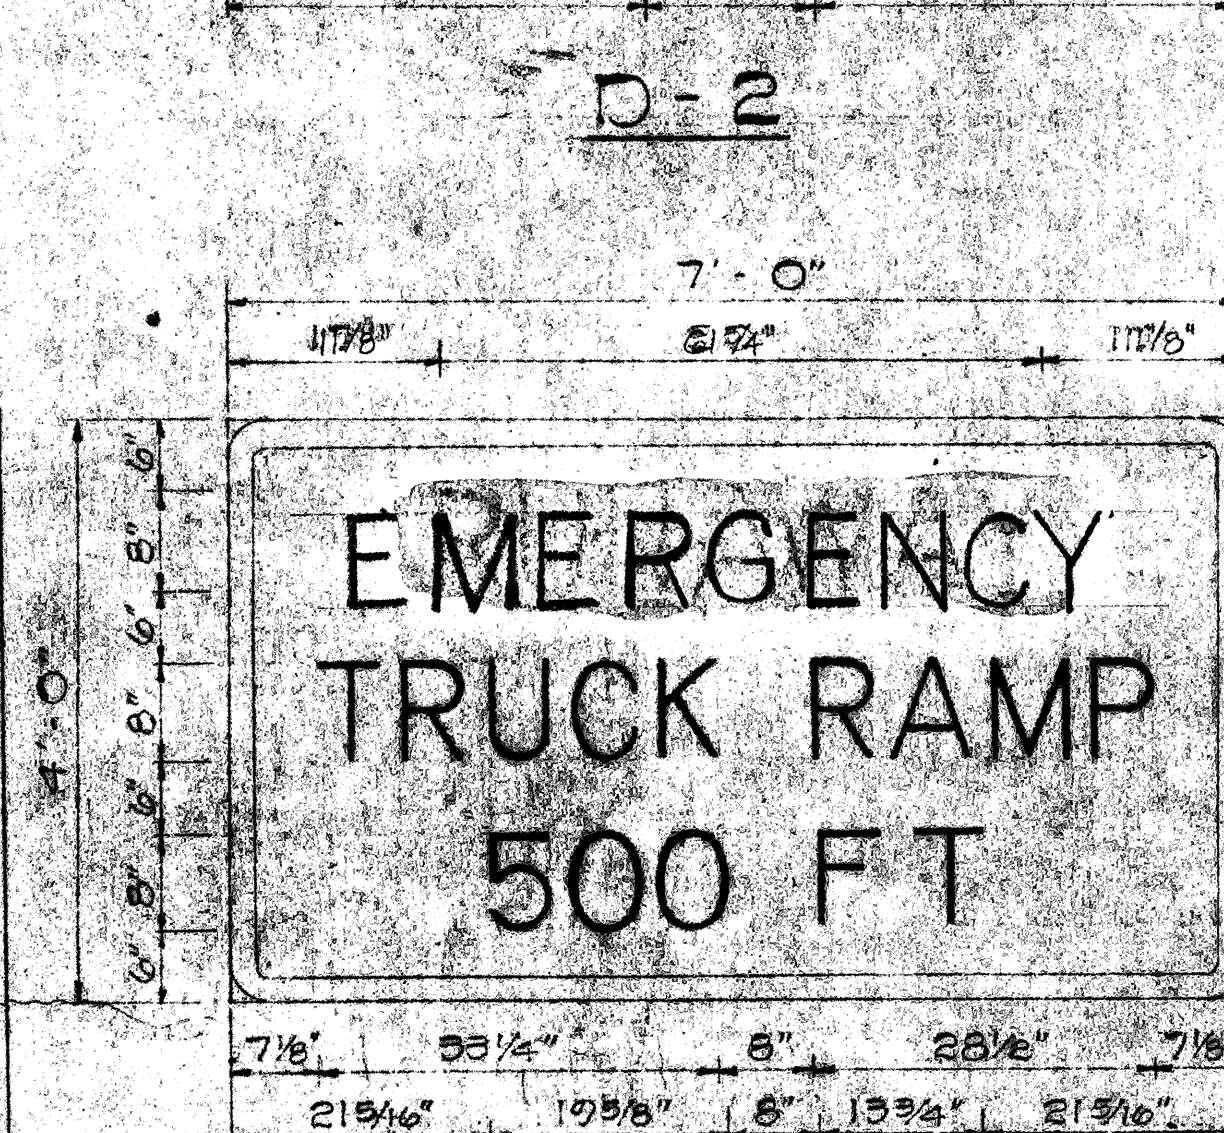


FED. ROAD DIST. NO.	STATE	FED. AID PROJ. NO.	FISCAL YEAR	SHEET NO.	TOTAL SHEETS
HAWAII	HAW.	065-1(3)	1974	7	11
		99A-01-83A	1984	11	11

NOTE:
Area outside corner radius need not be trimmed


GENERAL NOTES:

1. Sign letters shall be lettered in upper case according to "Standard Alphabets for Highway Signs", Federal Highway Administration, 1966. Use Series "D" letters and numerals.
2. Arrow shall conform with details as shown on plan.
3. Sign legend and border shall be black on reflectorized yellow background.
4. Sign panels shall be made from 0.100" thick sheet aluminum.
5. No splicing shall be allowed on the sign panel.

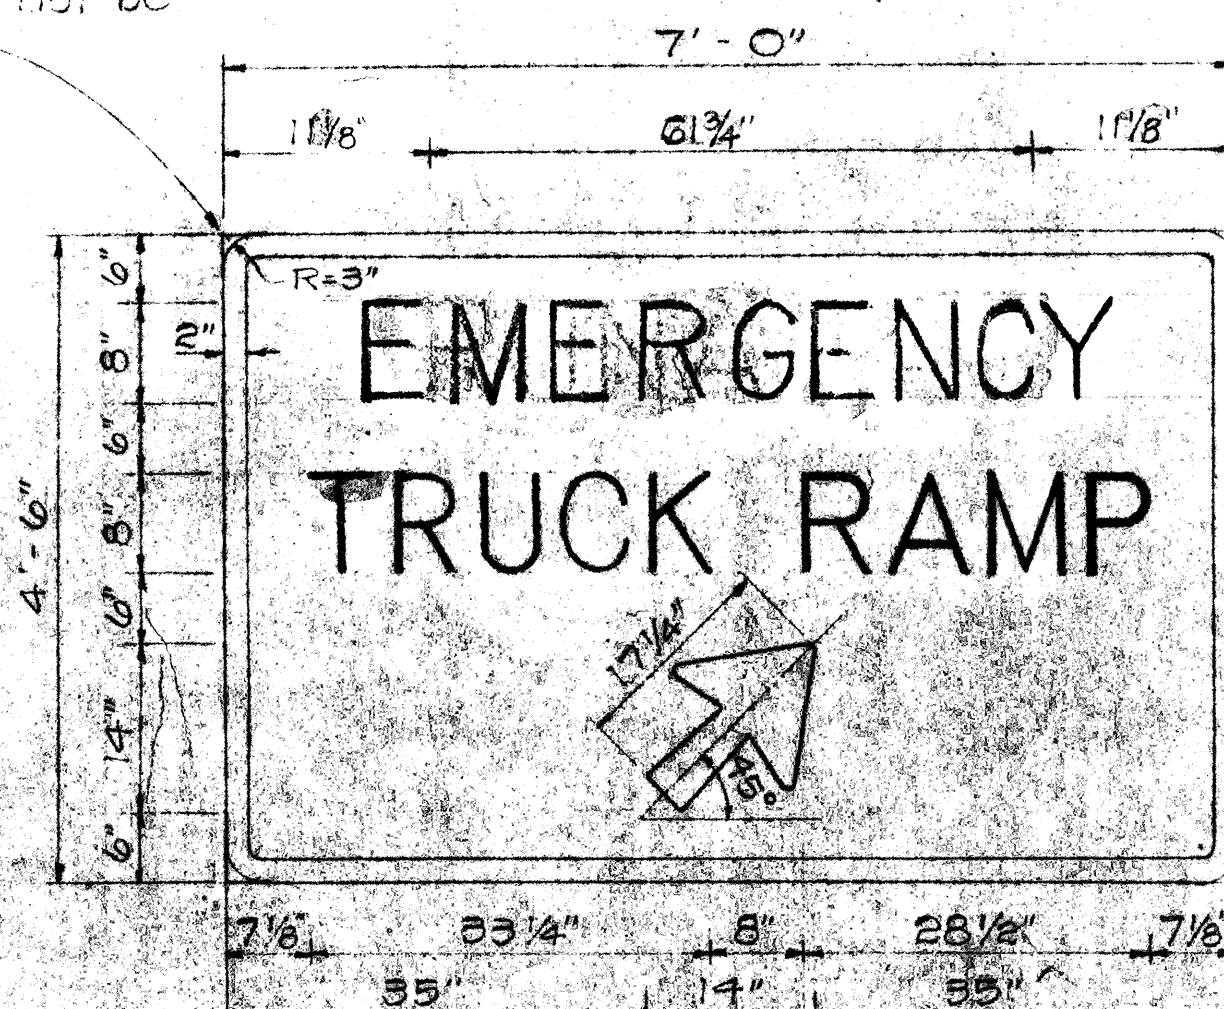


NOTES:


1. The shape, color, dimensions, symbols, wording, lettering and reflectorization of all signs shall be in accordance with "Manual on Uniform Traffic Control Devices for Streets and Highways," dated 1971 and the FHWA Manual, Standard Highway Signs, dated 1970 unless otherwise specified.
2. Regulatory Sign shall be reflectorized unless otherwise specified.
3. Regulatory Sign shall have 3/8" bolt holes drilled at appropriate locations, unless otherwise noted.
4. Sign shall be attached to post with 5/16" galvanized bolts with nuts and 7/8" x 7/8" x 120" stainless steel washers with neoprene rubber gaskets.

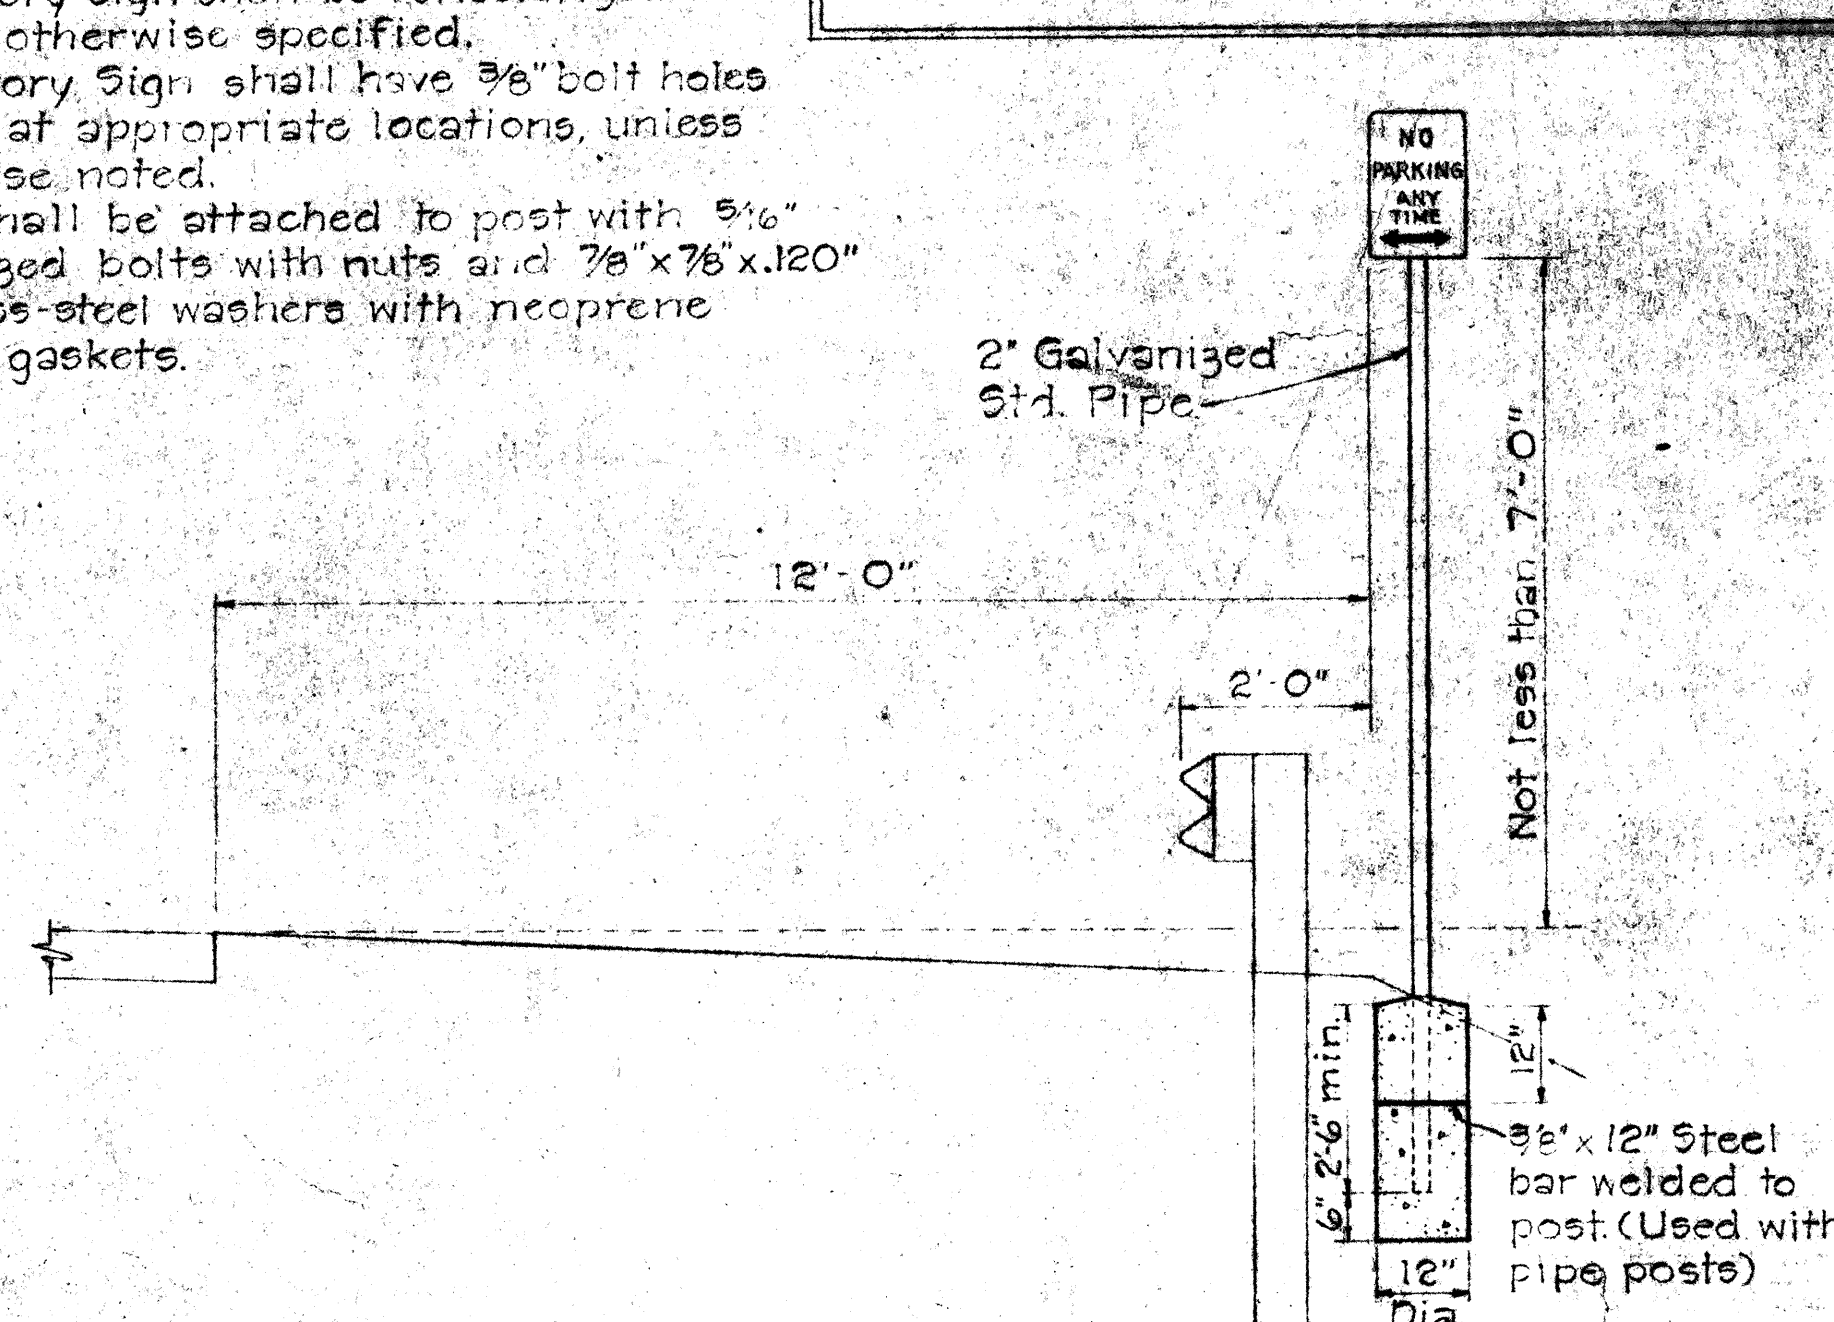

REGULATORY SIGN DETAILS

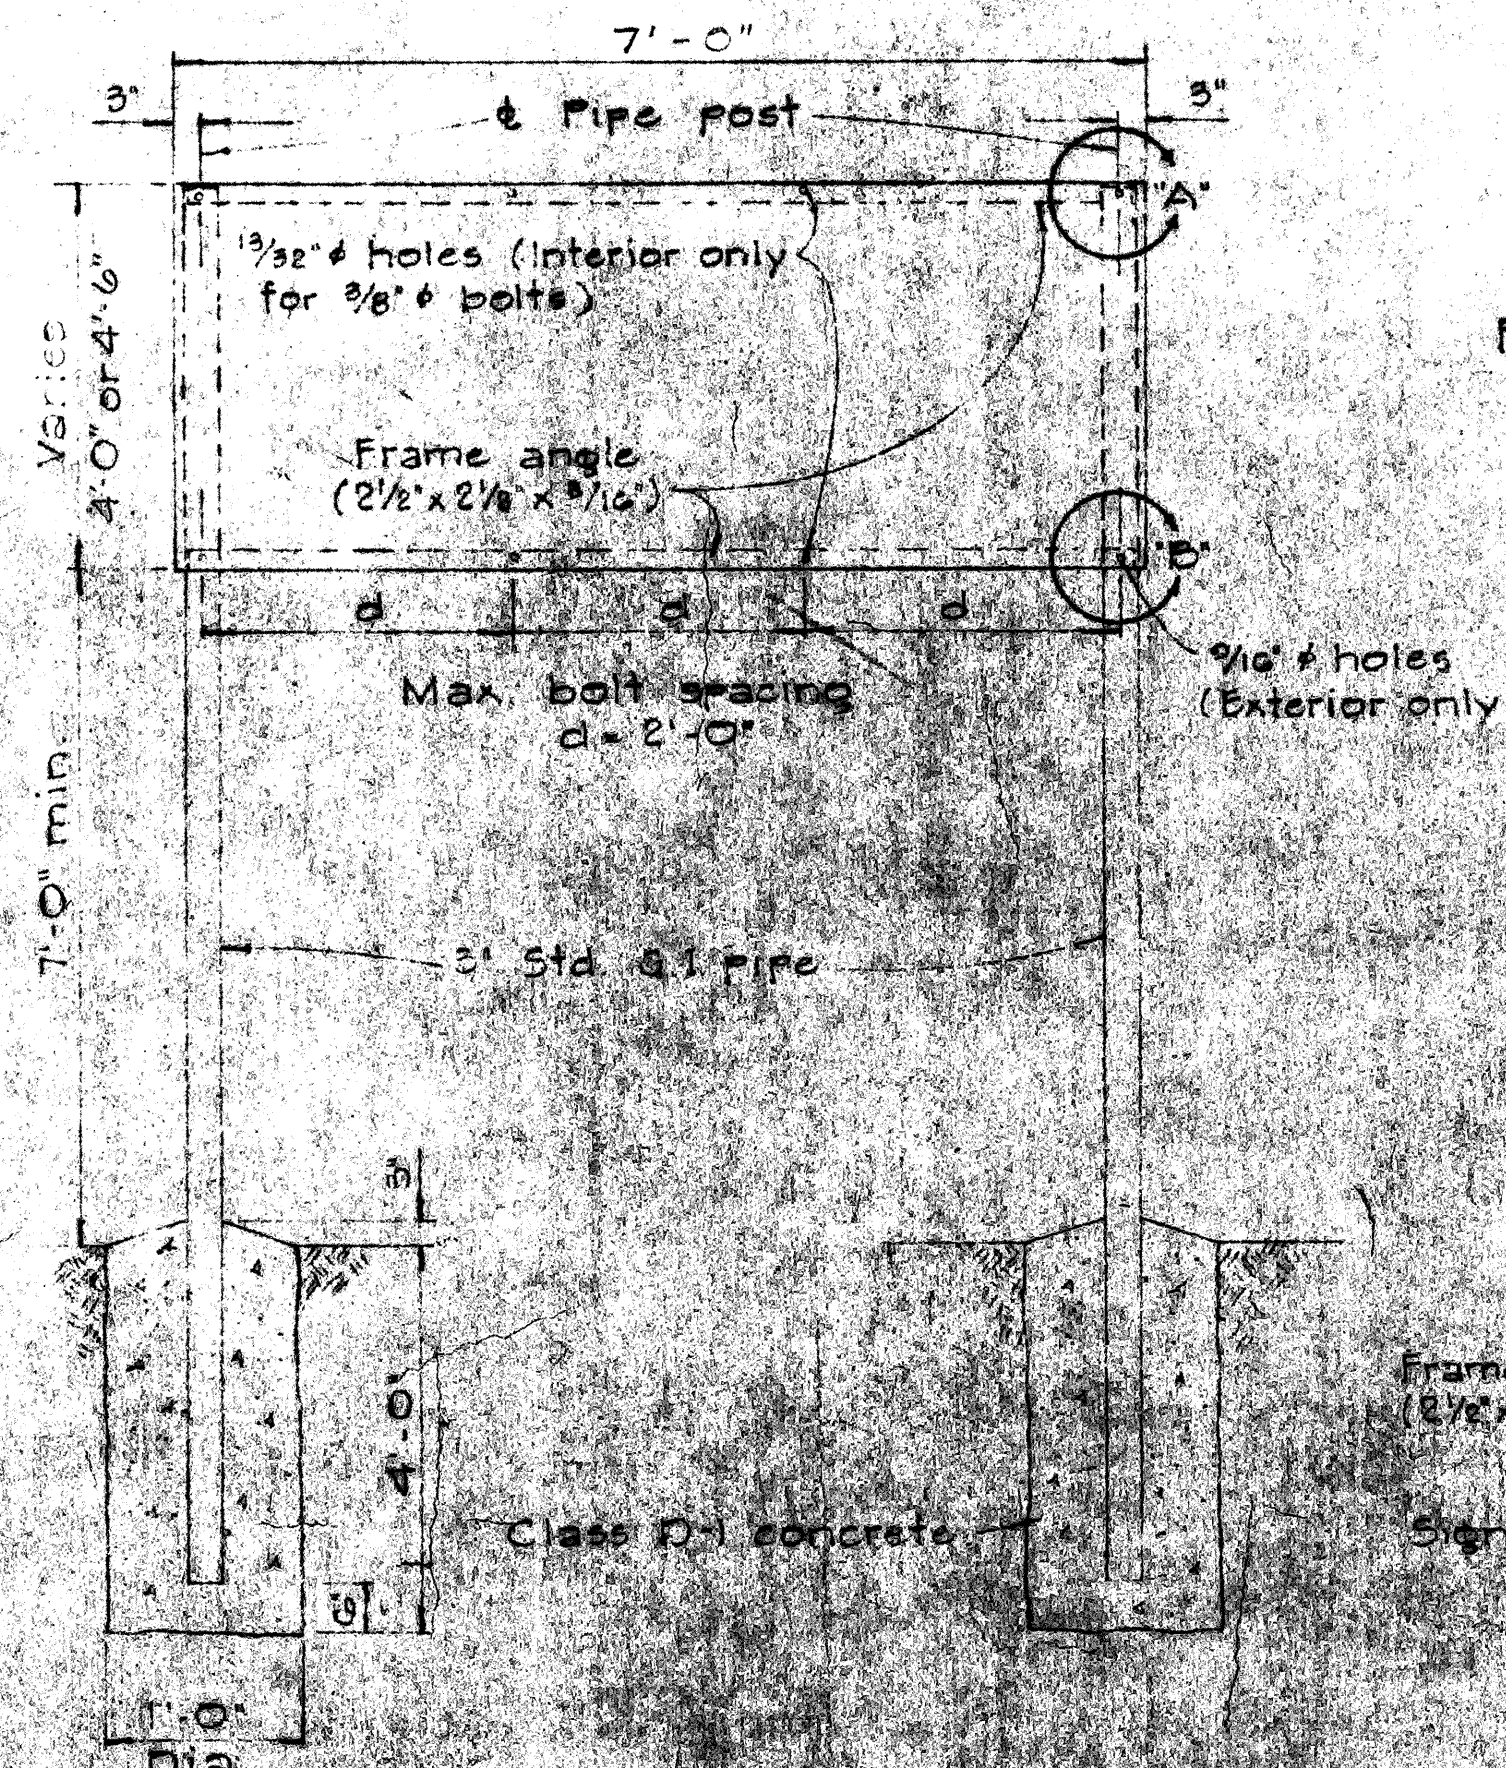


ELEVATION

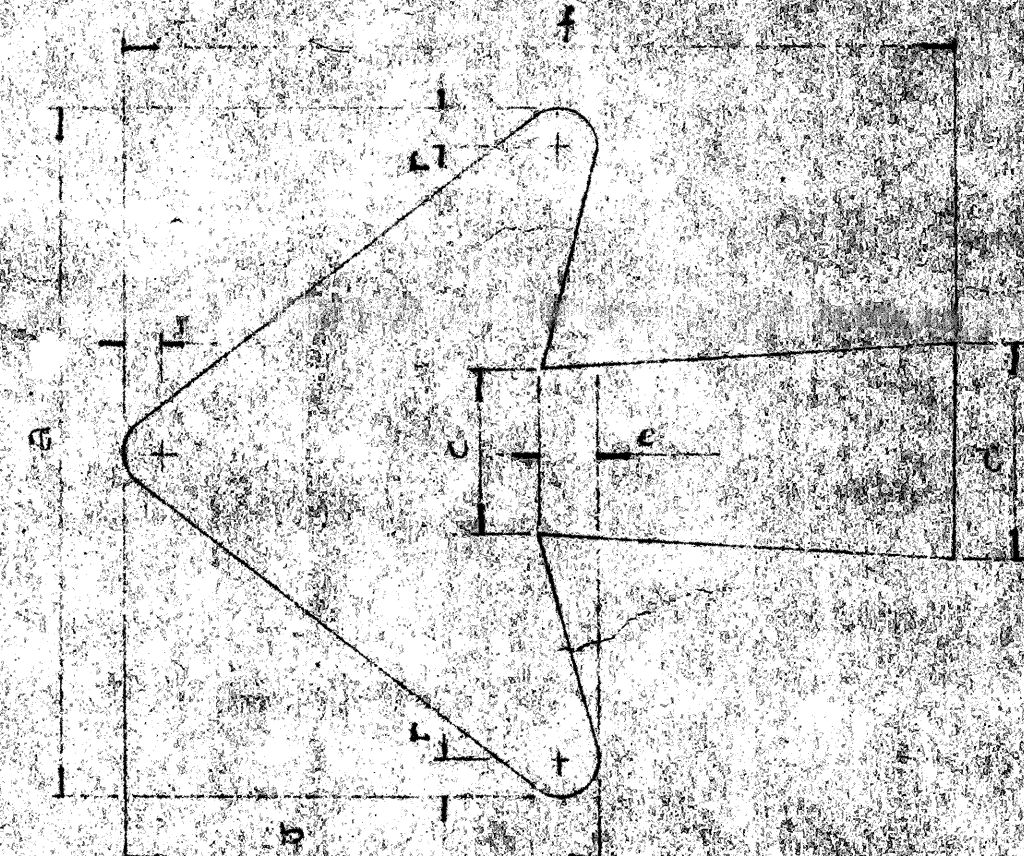


ARROW SIZE	ARROW DIMENSIONS IN INCHES						
	a	b	c	d	e	f	r
14 1/4 x 17 1/4	14 1/4	9 3/16	3 3/8	4 1/2	1 5/16	17 1/4	3/4

TYPICAL ARROW DETAILS


DIRECTIONAL SIGN DETAILS

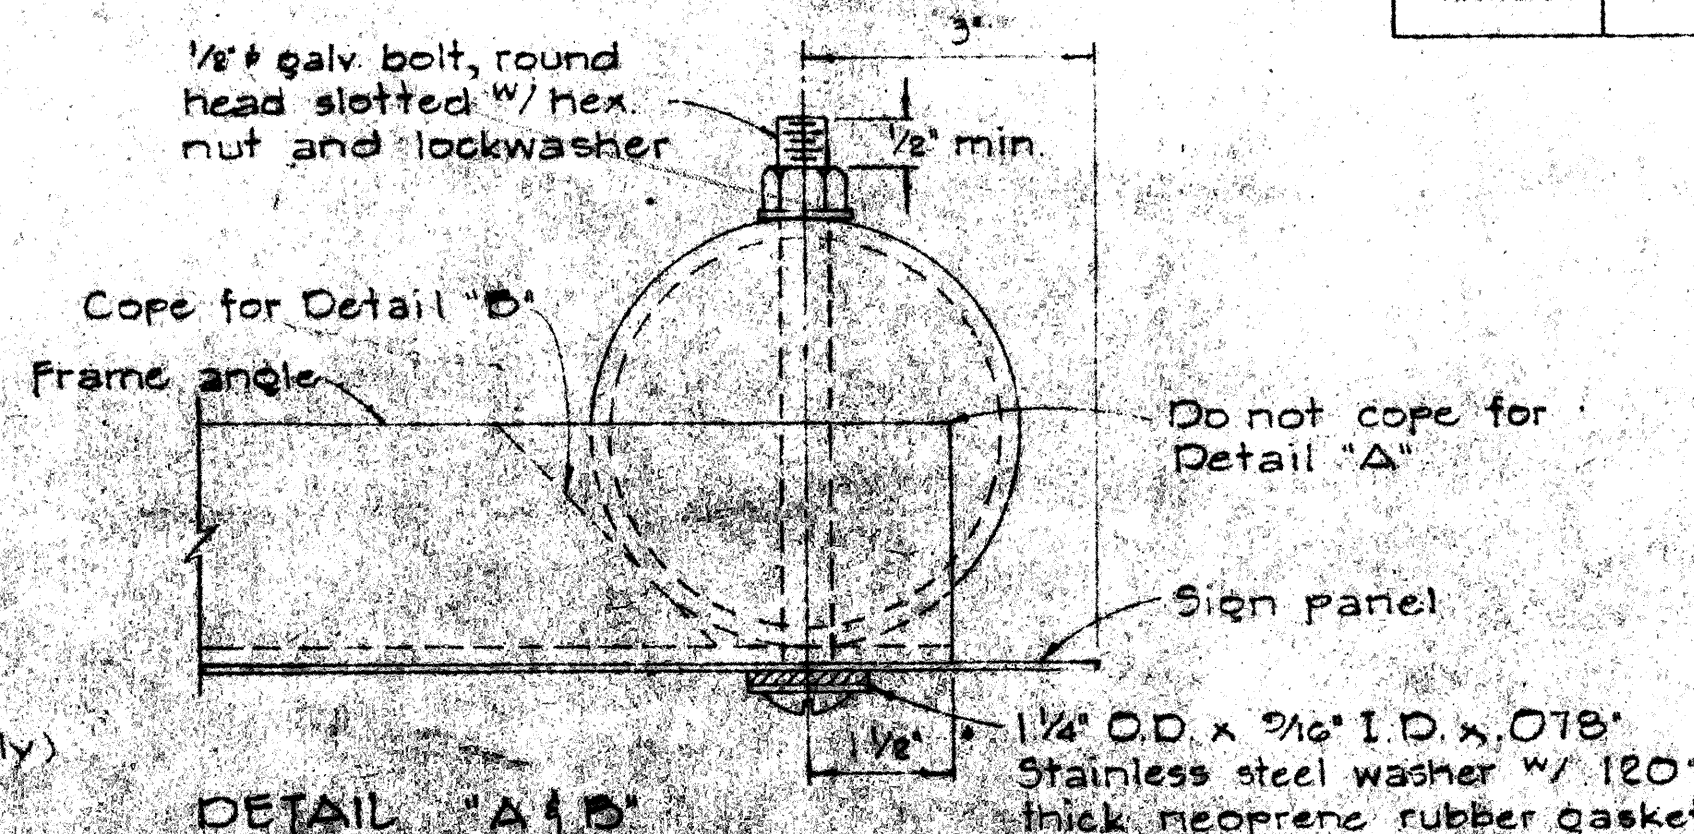

DETAIL "A & B"

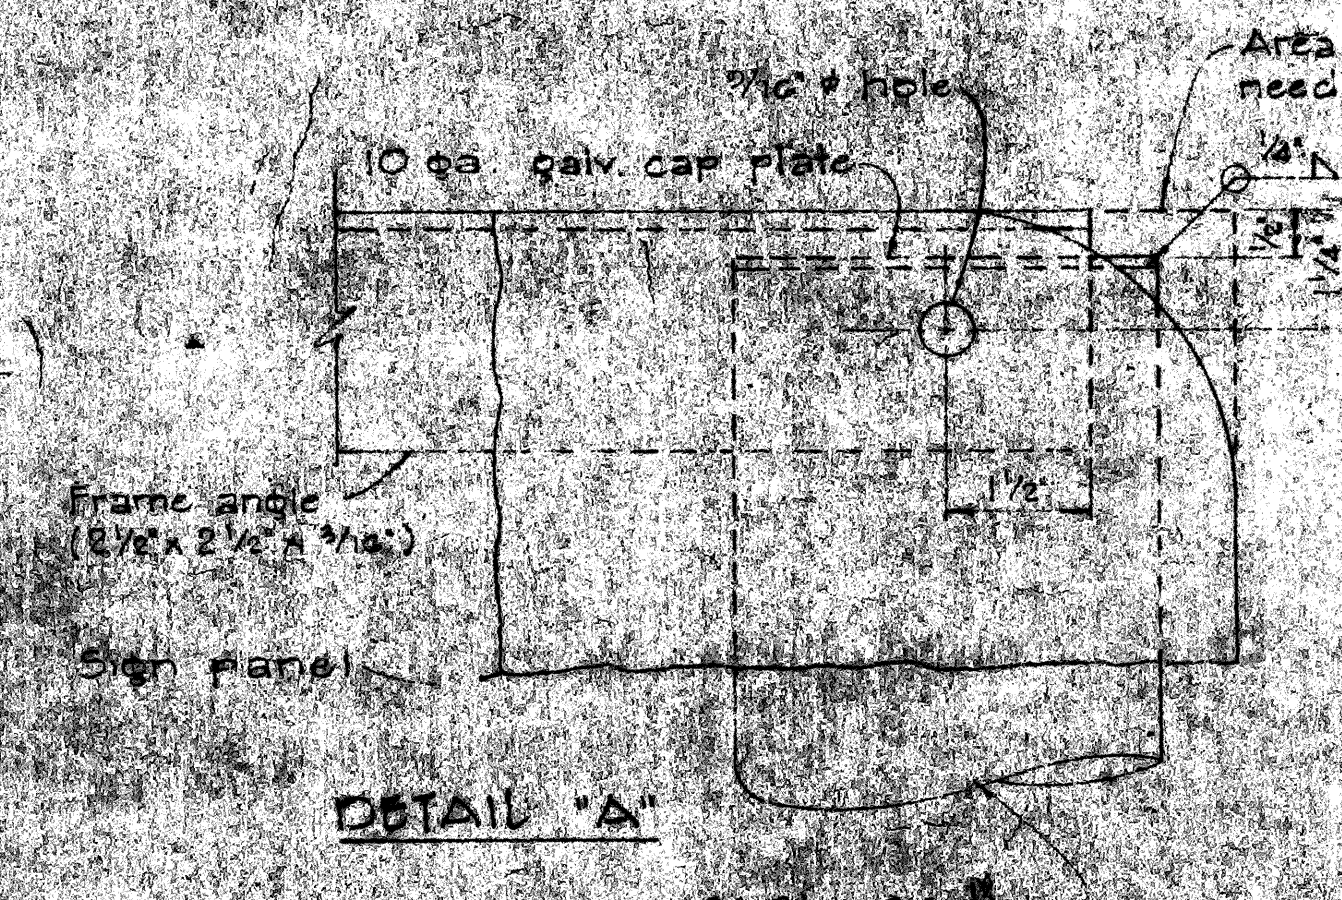


DETAIL "A"

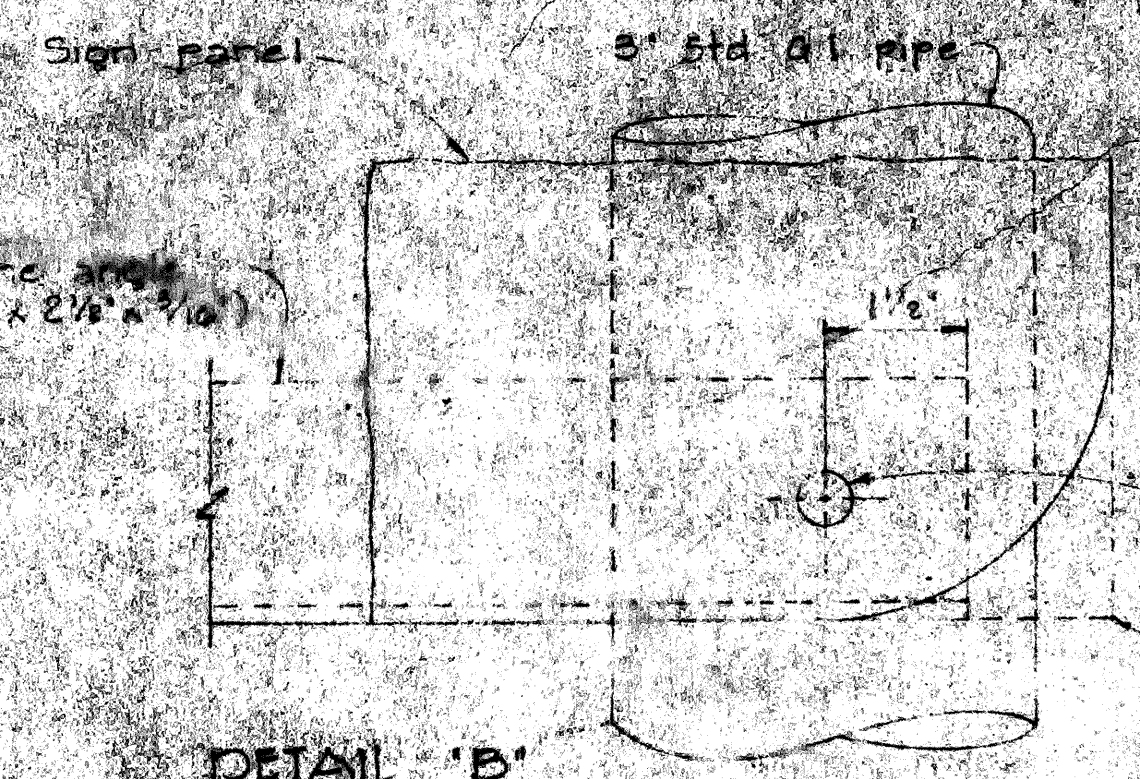

DETAIL "B"


ATTACHMENT OF SIGN PANEL TO FRAME

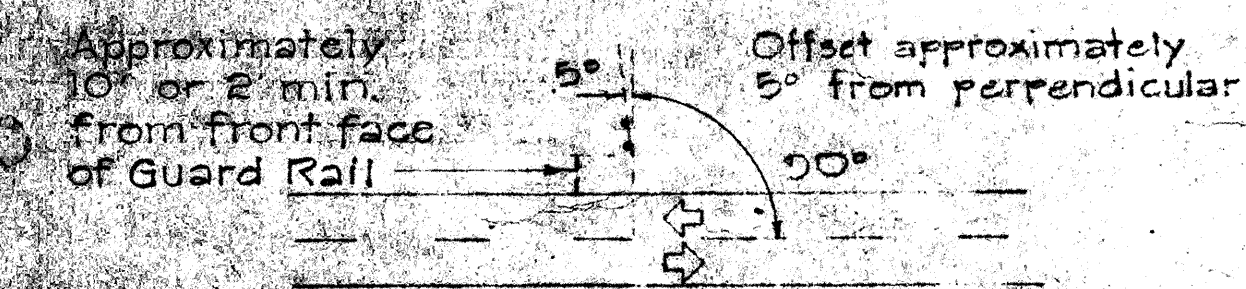

SIGN POSITION W/ RELATION TO DIRECTION OF TRAFFIC

KAMEHAMEHA HIGHWAY
EMERGENCY TRUCK TURNOUT
PROJECT NO. 99A-01-83A

STATE OF HAWAII
DEPARTMENT OF TRANSPORTATION
HIGHWAYS DIVISION
DIRECTIONAL AND REGULATORY
SIGN DETAILS
EMERGENCY TRUCK TURNOUT
ON KAMEHAMEHA HIGHWAY
PROJECT NO. 99A-01-83A
SCALE: NOT TO SCALE
SHEET No. 1 OF 1 SHEETS

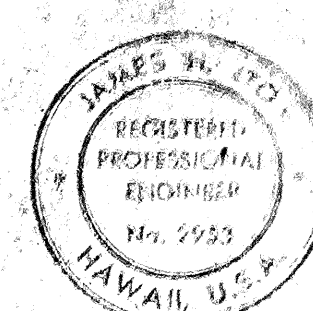

THIS WORK WAS PREPARED BY
ME OR UNDER MY SUPERVISION.

James H. To