




FED. ROAD DIST. NO.	STATE	FED. AID PROJ. NO.	FISCAL YEAR	SHEET NO.	TOTAL SHEETS
HAWAII	HAW.	99A-01-83A	1984	2	11

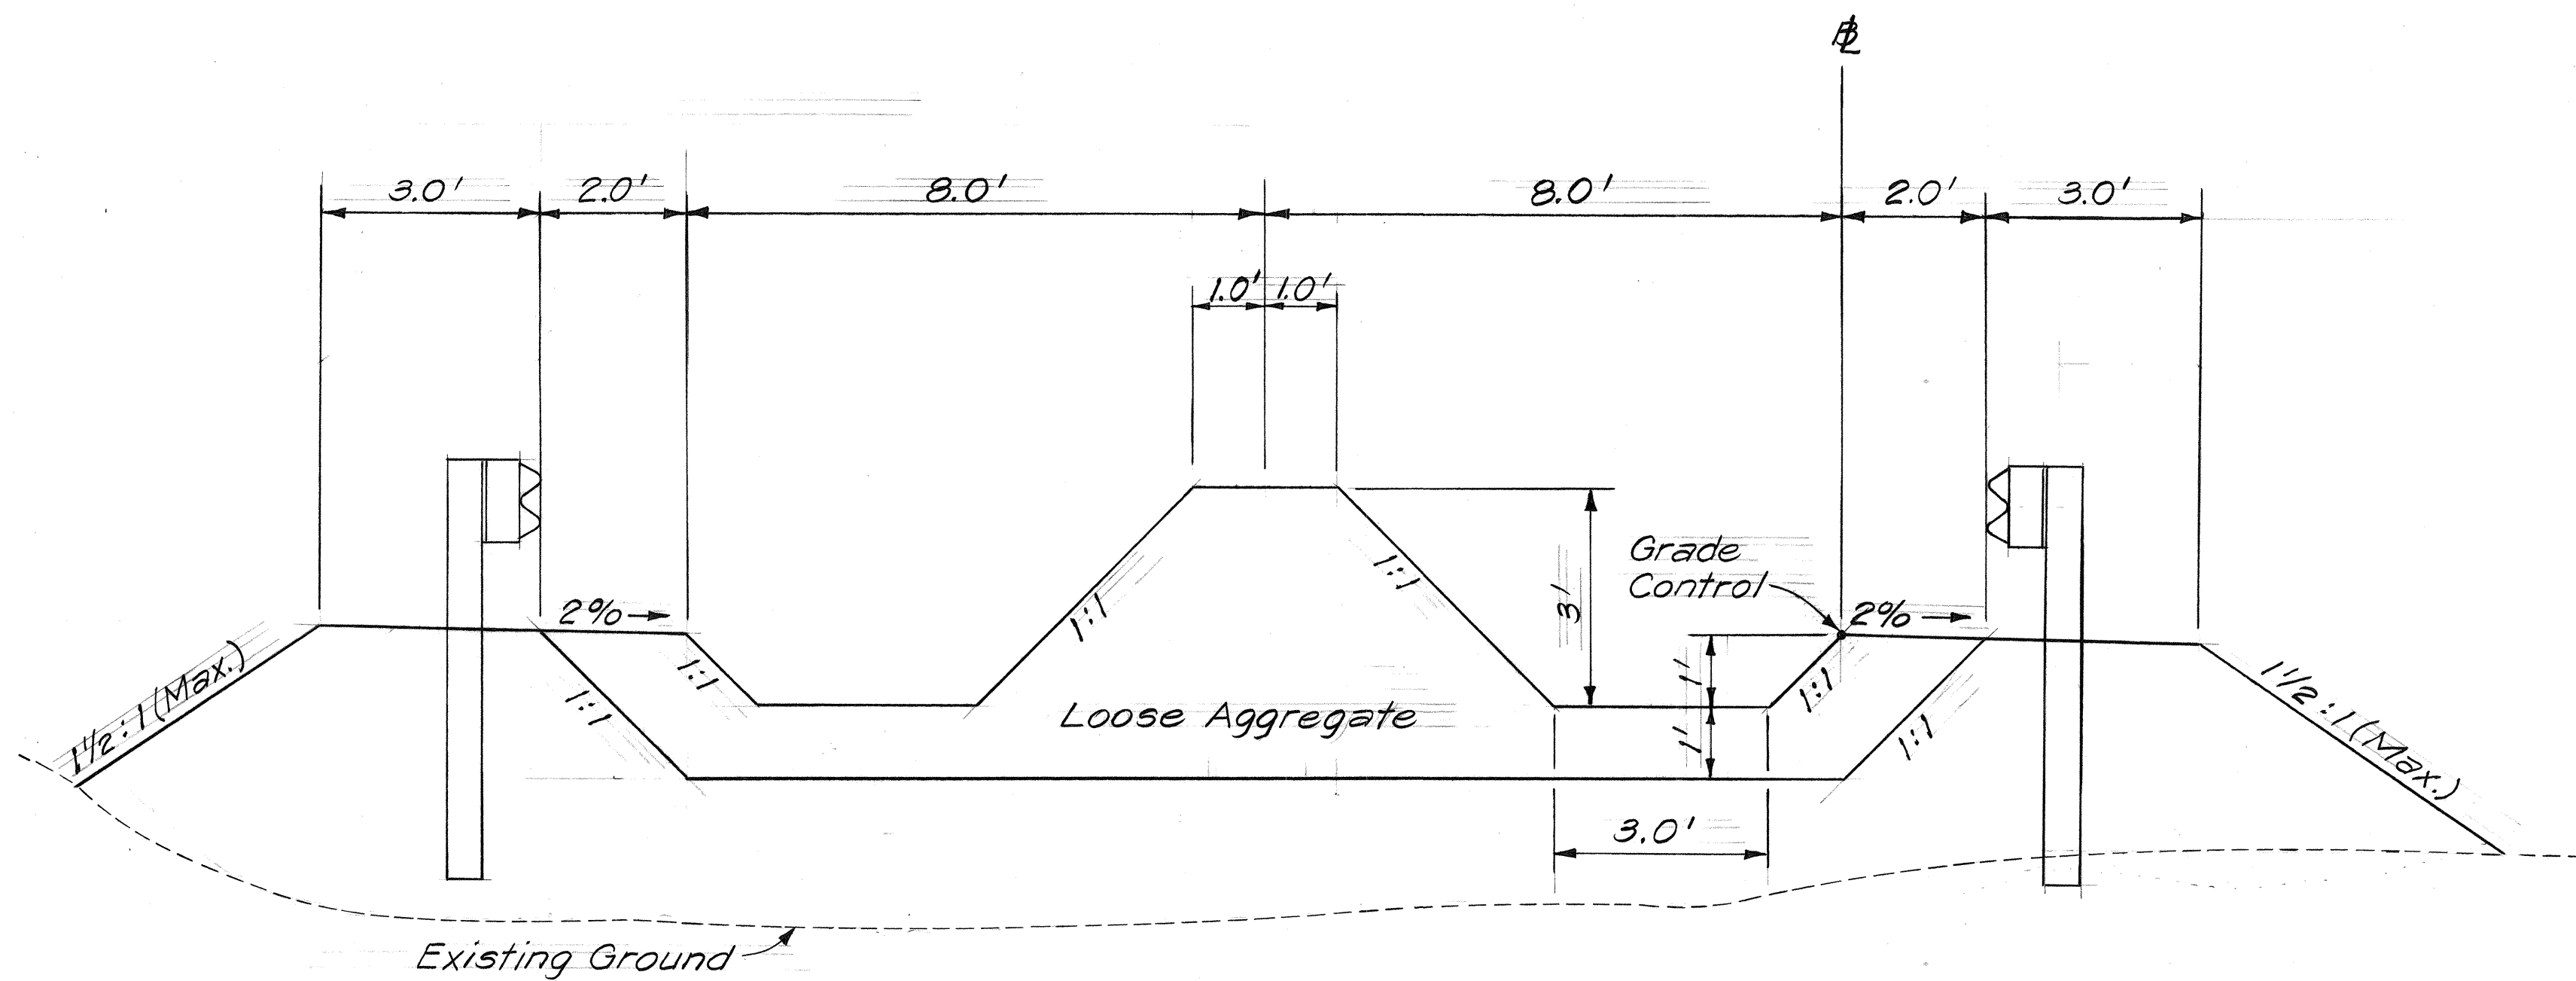


TYPICAL SECTION
STA. 5+00 TO STA. 12+30+
 Scale: 1/2" = 1'-0"

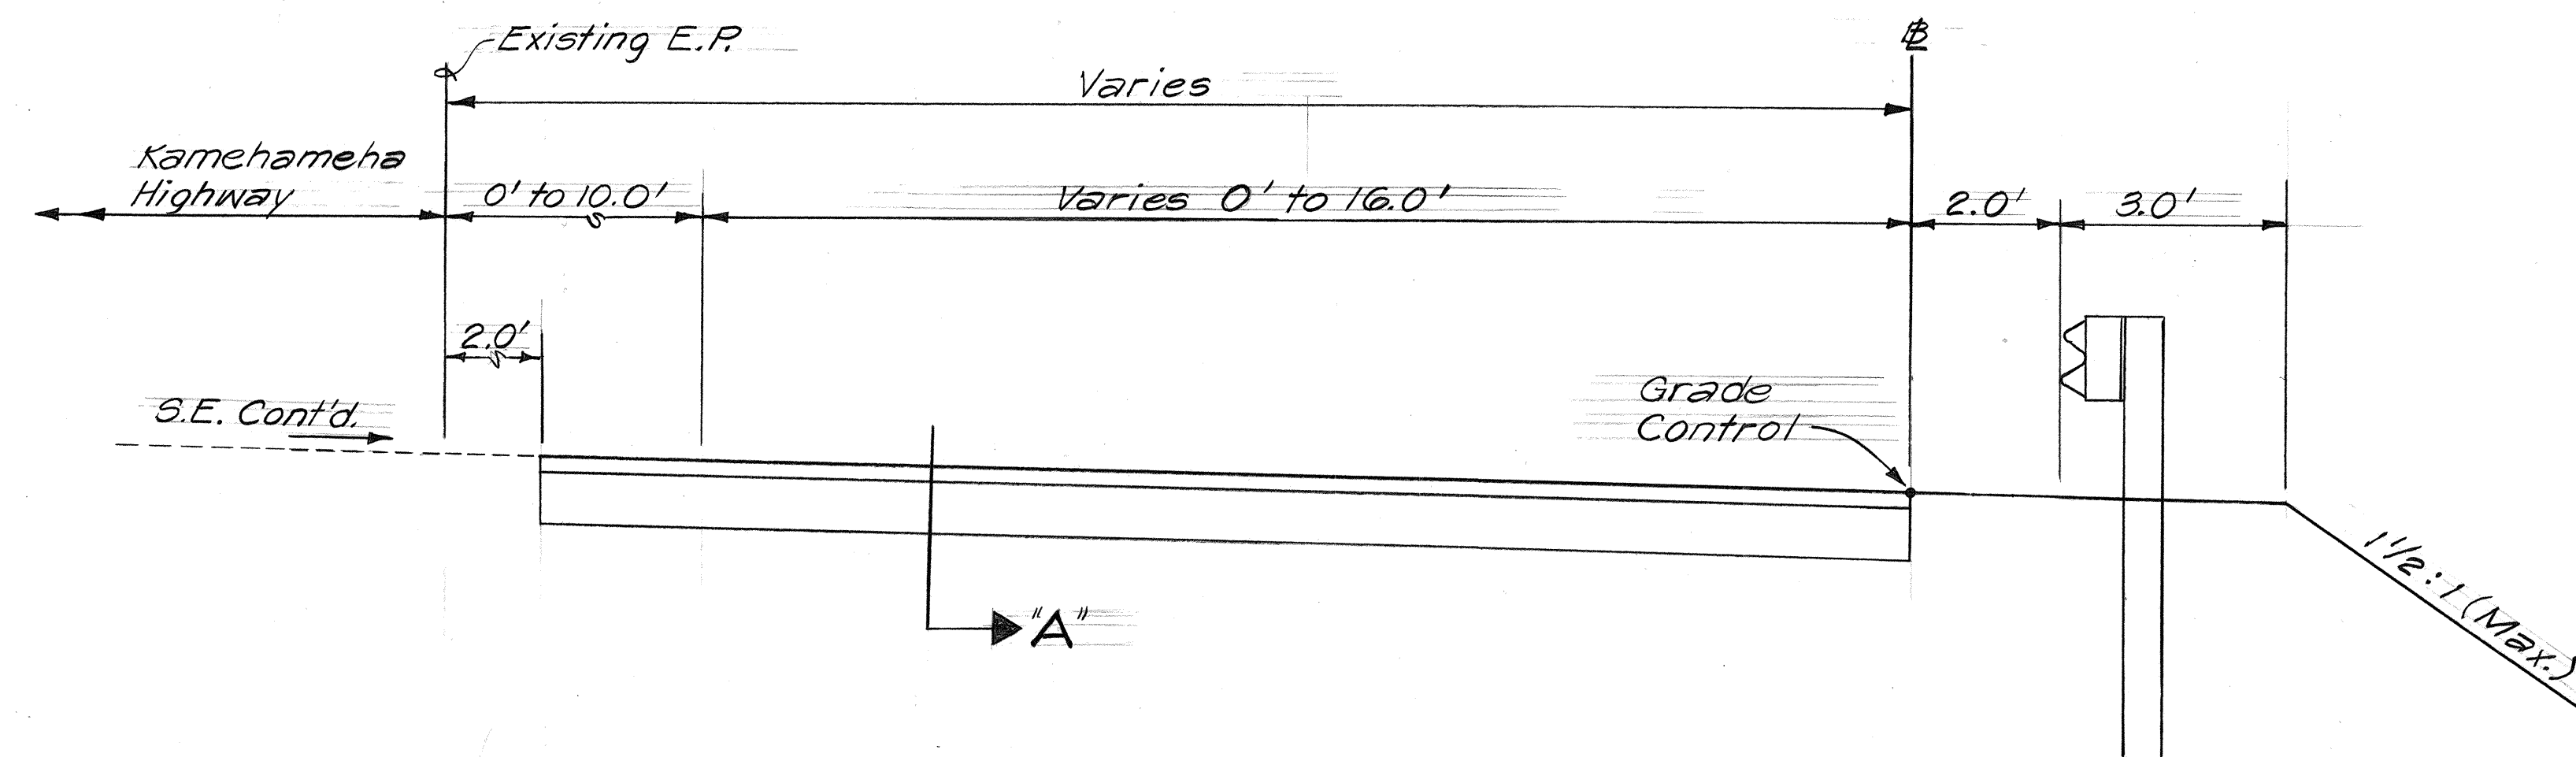

TYPICAL SECTION
STA. 0+00 TO STA. 3+35
 Scale: 1/2" = 1'-0"

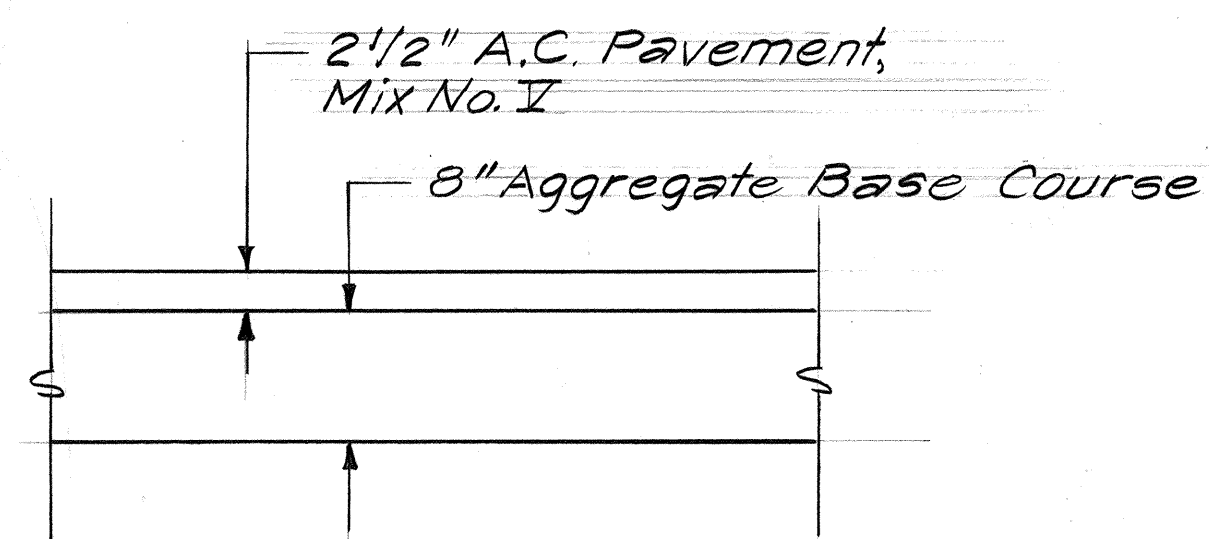

SECTION "A"
 Scale: 1" = 1'-0"

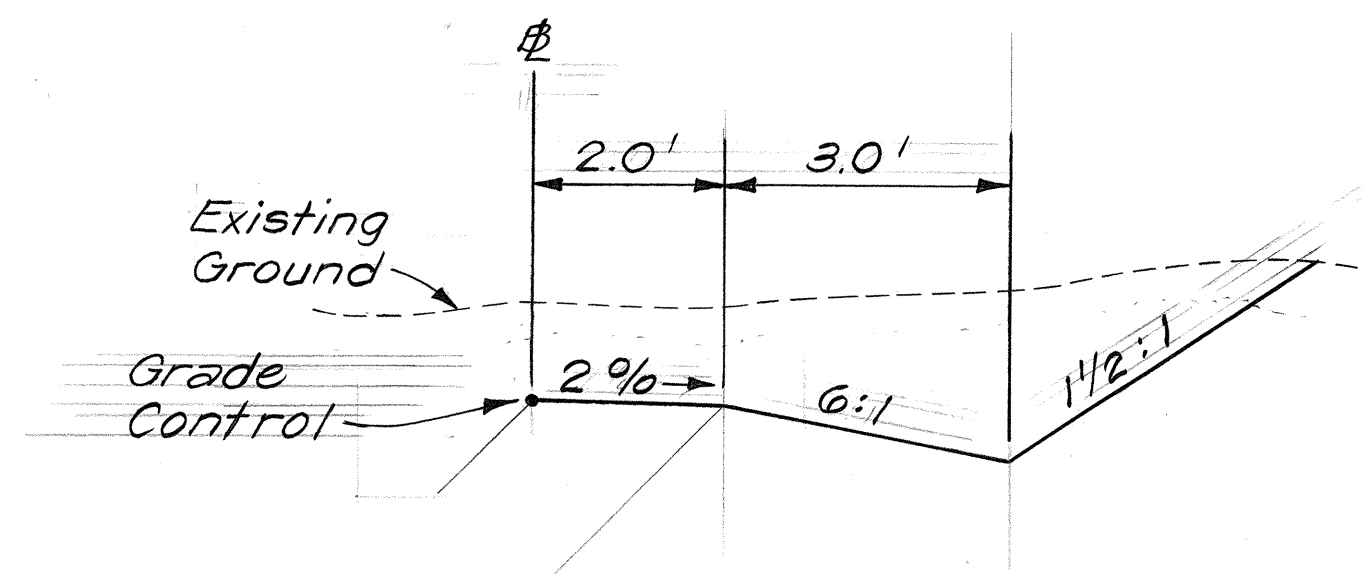

CUT SECTION
 Scale: 1/2" = 1'-0"

STATE OF HAWAII
 DEPARTMENT OF TRANSPORTATION
 LAND TRANSPORTATION FACILITIES DIVISION
TYPICAL SECTIONS
AND GENERAL NOTES
KAMEHAMEHA HIGHWAY
TRUCK TURNOUT AT WEED JUNCTION
PROJECT NO. 99A-01-83A
 Scale: As Noted Date: Oct. 1983
 SHEET NO. OF SHEETS