	INDEX TO DRAWINGS
SHEET NO.	DESCRIPTION
	TITLE SHEET
2	GENERAL NOTES
3-4	TYPICAL SECTIONS, MISC. RESURFACING DETAILS AND CURVE DATA SCHEDULE
5	TYPICAL PAVEMENT MARKING DETAILS
6-9	TRAFFIC STANDARD DETAILS
·	
*	



STATE OF HAWAII



## DEPARTMENT OF TRANSPORTATION HIGHWAYS DIVISION


HONOLULU, HAWAII

"AS - BUILT" PLANS FOR

## WILIKINA DRIVE RESURFACING

INTERSTATE ROUTE H-2 TOWARDS KAMANANUI ROAD PROJECT NO. 99C-01-84M

DISTRICT OF WAHIAWA
ISLAND OF OAHU

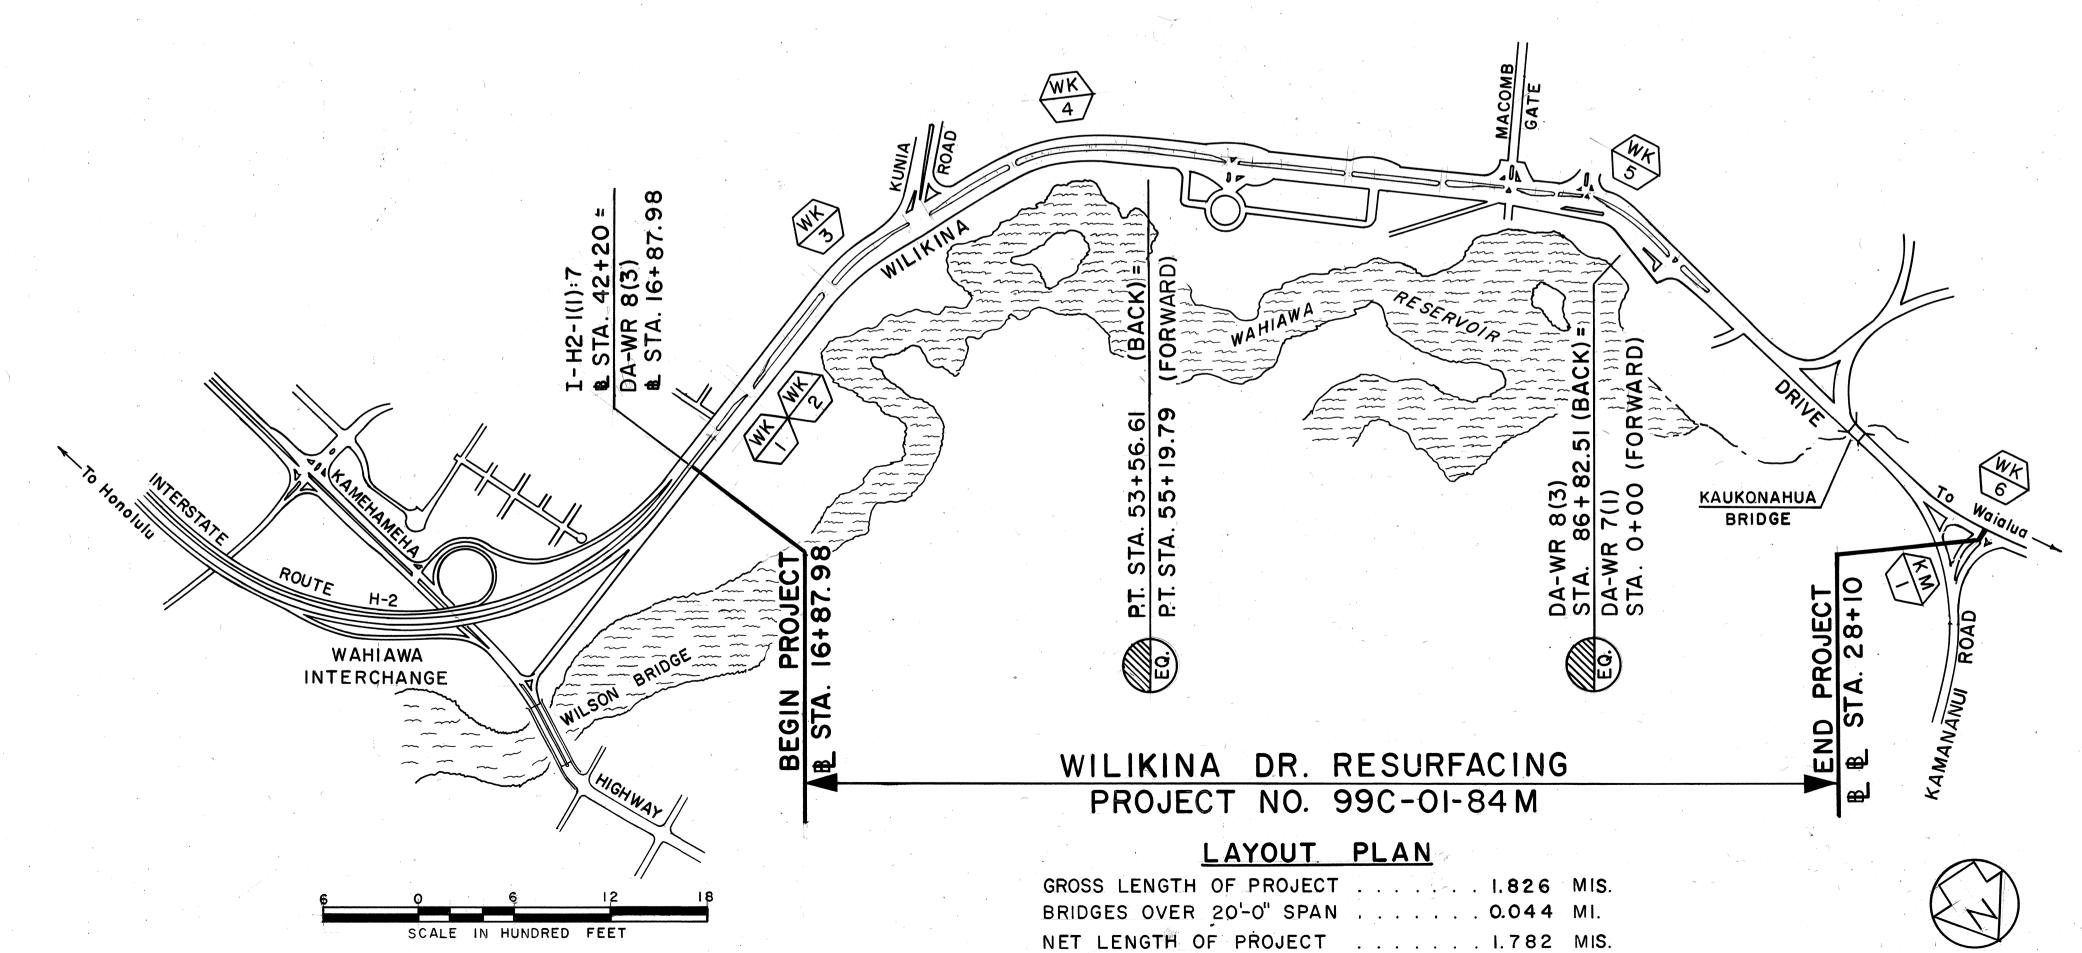

Waianae

Wainanae

Wainae

FED. ROAD DIST. NO.

PROJ. NO.

99C-01-84M

NO SIGNIFICANT CHANGES WERE MADE DURING CONSTRUCTION ON THESE PLANS EXCEPT CHANGES IN THE ORIGINAL THEORETICAL QUANTITIES. FOR ACTUAL QUANTITIES, REFER TO PROJECT LEDGER AND/OR COMPUTATION BOOK.

RESIDENT ENGINEER

10-18-85 DATE SHEET TOTAL NO. SHEETS

DEPARTMENT OF TRANSPORTATION STATE OF HAWAII
APPROVED:

JUIR. OF TRANSPORTATION

\_\_\_*5/23/89* DATE