
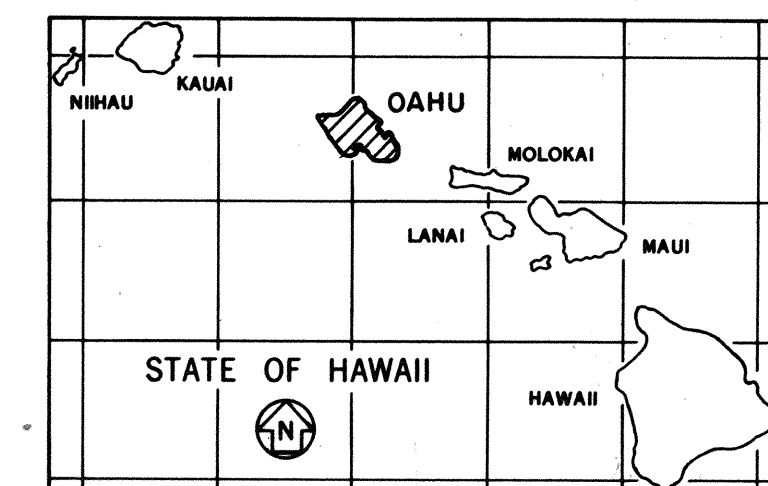
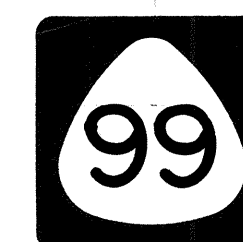


[illegible]


FED. ROAD DIST. NO.	STATE	PROJ. NO.	FISCAL YEAR	SHEET NO.	TOTAL SHEET
HAWAII	HAW.	99EF-01-87M	1987	1	18

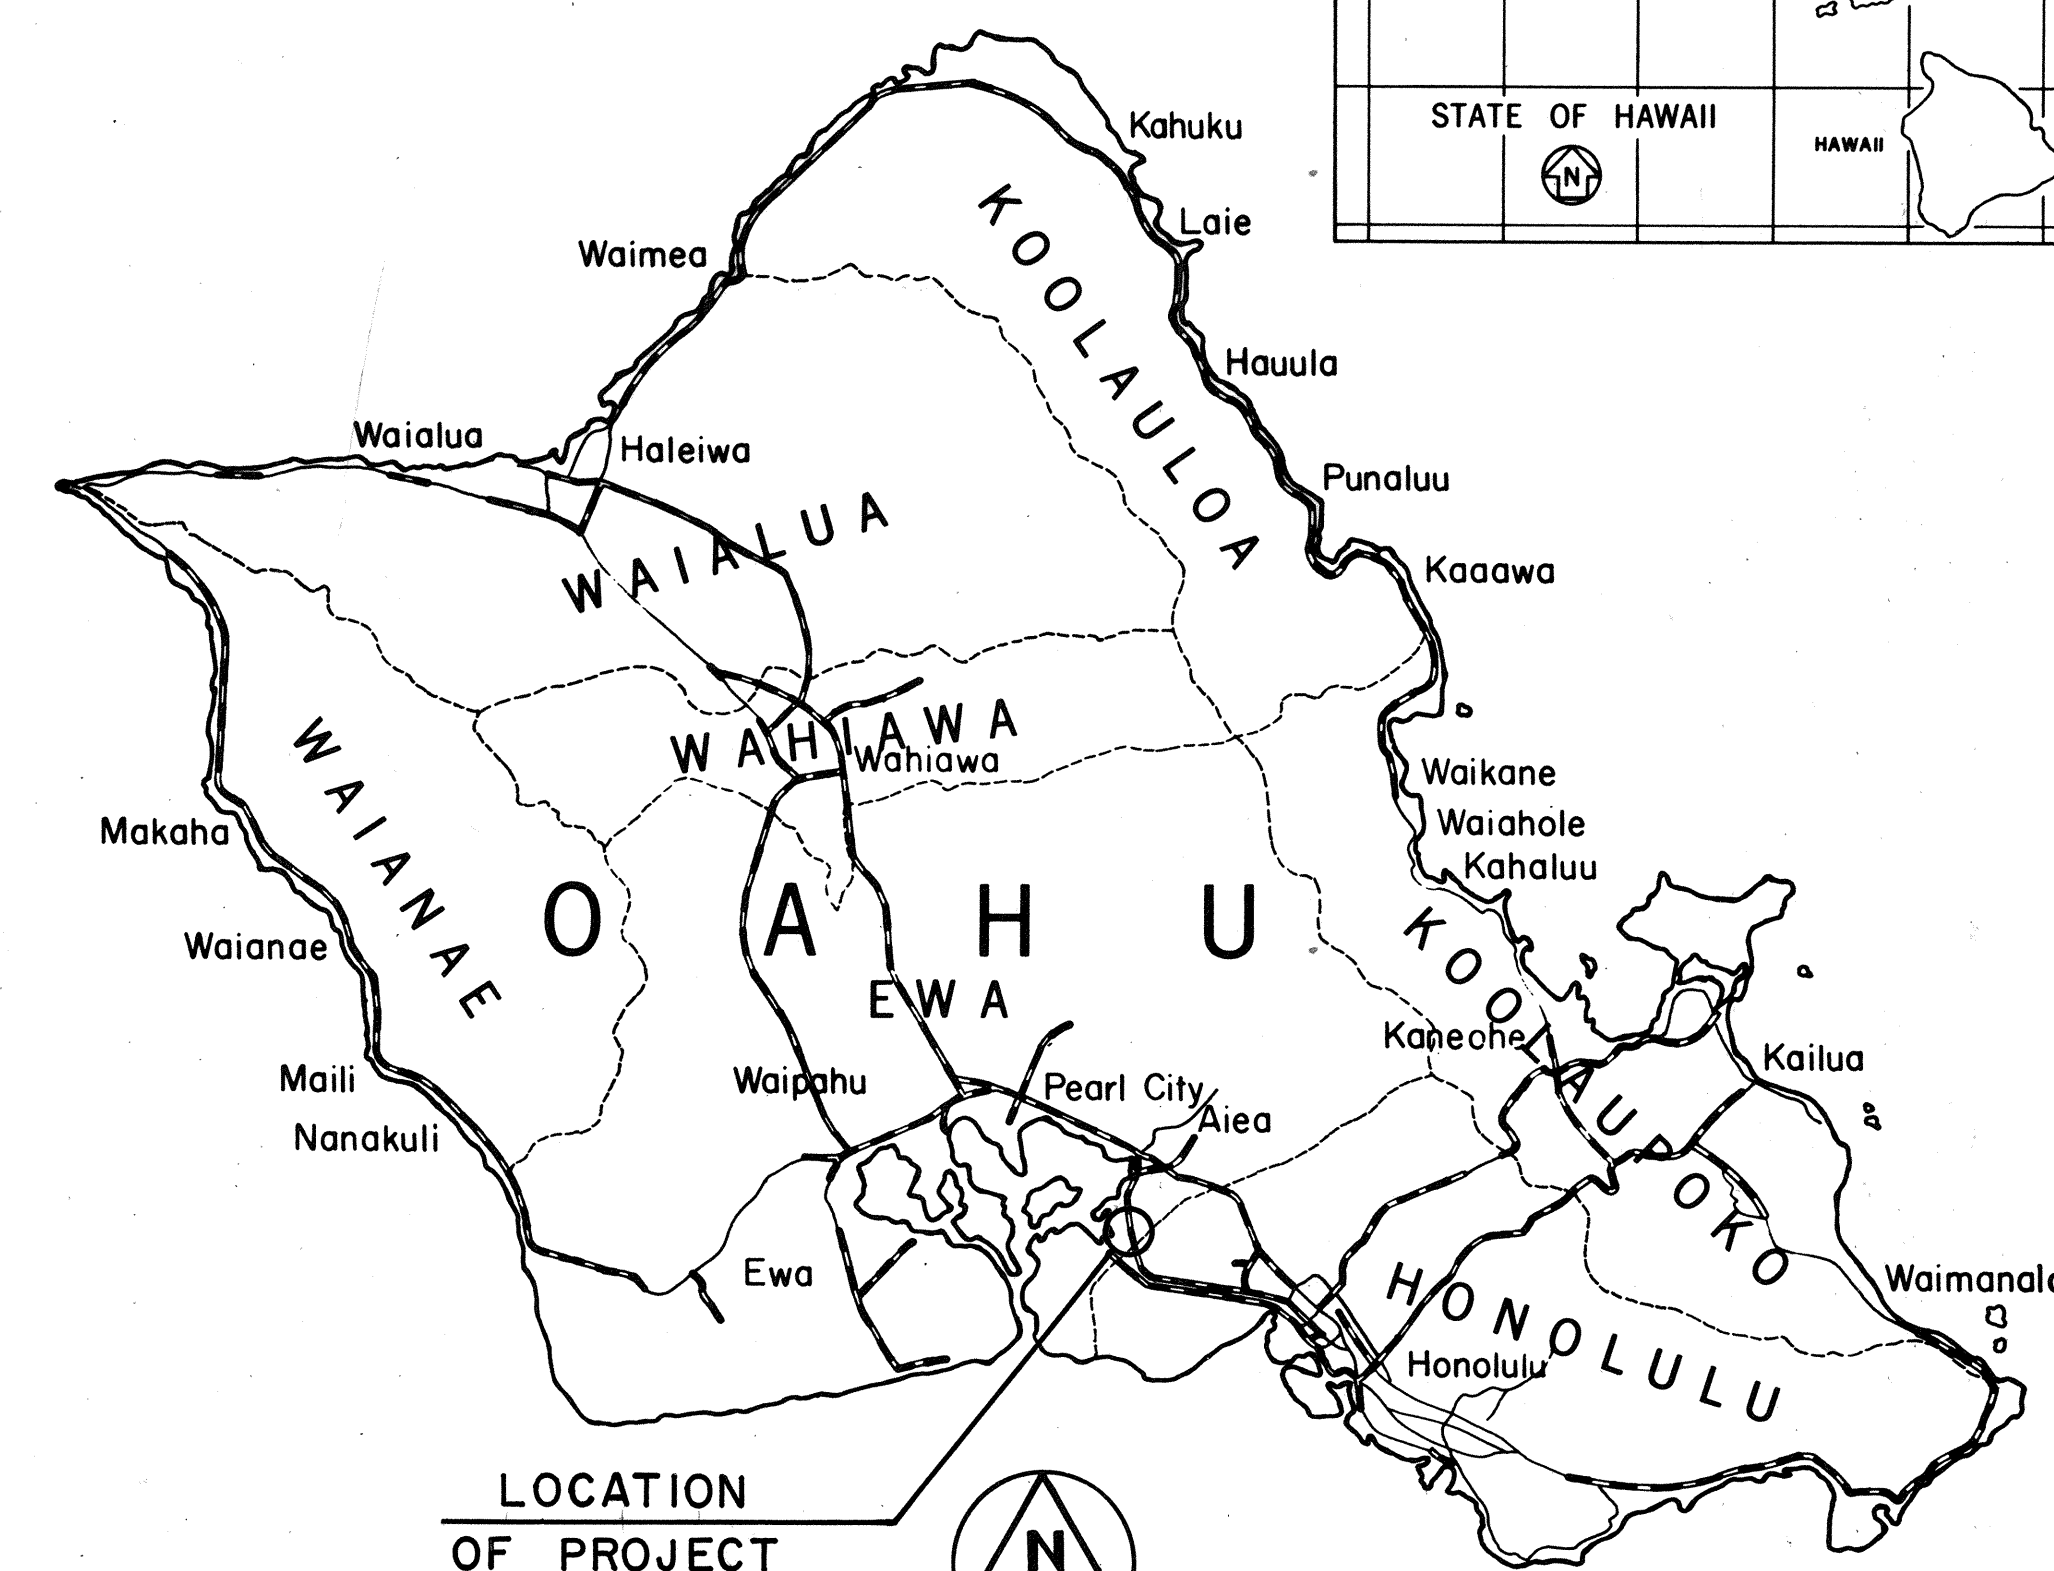


STATE OF HAWAII  
DEPARTMENT OF TRANSPORTATION  
HIGHWAYS DIVISION  
HONOLULU, HAWAII  
"AS-BUILT"  
PLANS FOR  
KAMEHAMEHA HIGHWAY RESURFACING  
CENTER DRIVE TO HALAWA STREAM  
PROJECT NO. 99EF - 01 - 87M

DISTRICTS OF HONOLULU & EWA  
ISLAND OF OAHU

LOCATION  
OF PROJECT

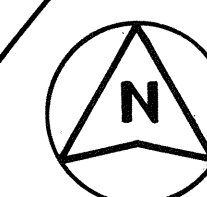

4 0 4  
SCALE IN MILES

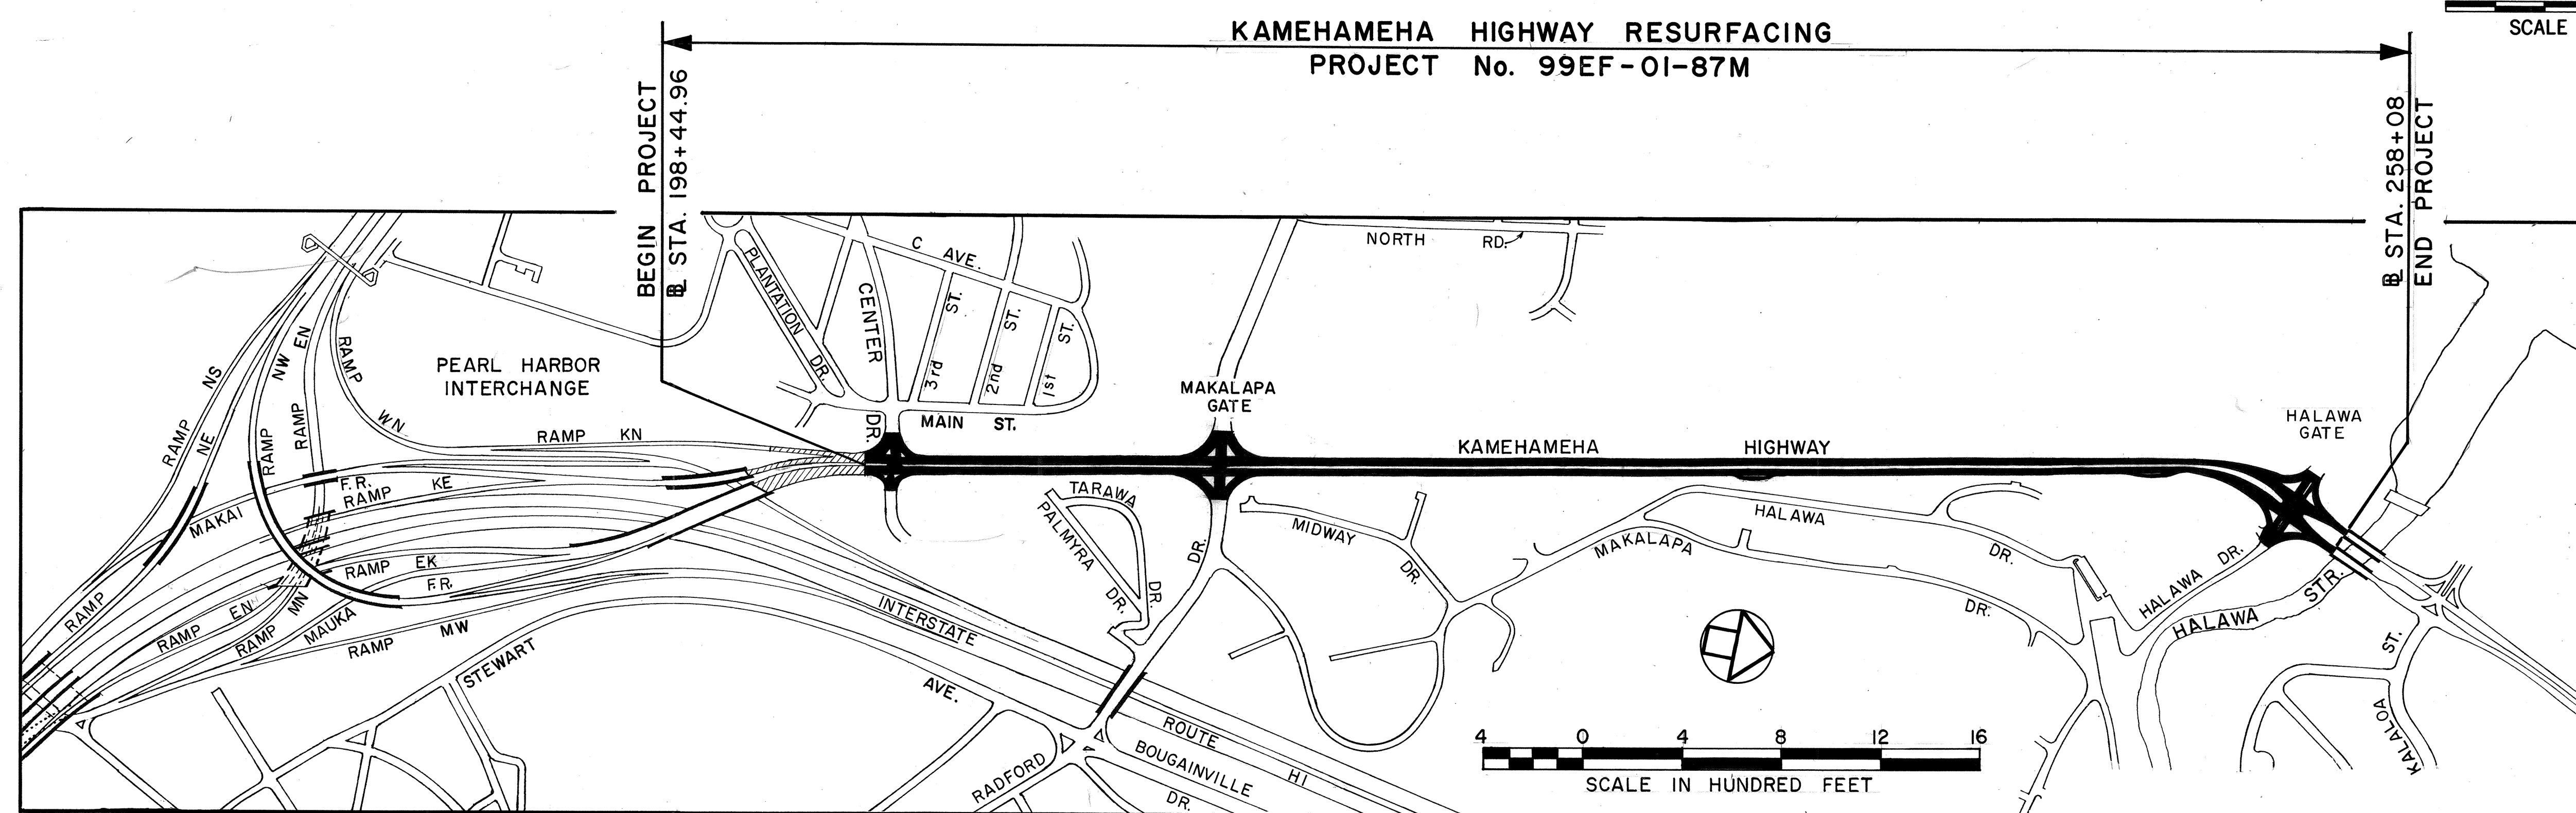

**NOTE:**  
CHANGES MADE DURING CONSTRUCTION  
HAVE BEEN INCORPORATED ON THESE  
PLANS EXCEPT CHANGES IN THE ORIGINAL  
THEORETICAL QUANTITIES. FOR ACTUAL  
QUANTITIES, REFER TO PROJECT LEDGER  
AND/OR COMPUTATION BOOK.

Richard Chang 6/9/88  
RESIDENT ENGINEER DATE

DEPARTMENT OF TRANSPORTATION STATE OF HAWAII	
APPROVED: <i>A. H. H. H. H.</i>	
for DIR. OF TRANSPORTATION	12/29/86 DATE

ALLAN T. NISHIMURA  
DESIGNED BY P. S. & E. BY  
548-7490 PHONE  
JULY, 1986 DATE

## LAYOUT PLAN

LENGTH OF PROJECT . . . . . 1230 MILES