	INDEX TO DRAWINGS
SHEET NO.	DESCRIPTION
	TITLE SHEET
2	STANDARD PLANS SUMMARY
3	GENERAL NOTES & LEGEND
4	TYPICAL SECTIONS
5-6	PLANS
7-8	DRAINAGE DETAILS
	į.
٠.	

STATE OF HAWAII


DEPARTMENT OF TRANSPORTATION
HIGHWAYS DIVISION
HONOLULU, HAWAII
"AS-BUILT"
PLANS FOR

KAMEHAMEHA HIGHWAY IMPROVEMENTS

MILILANI TOWN TO WAIKALANI DRIVE

PROJECT NO. 99C-01-87

DISTRICT OF EWA ISLAND OF OAHU

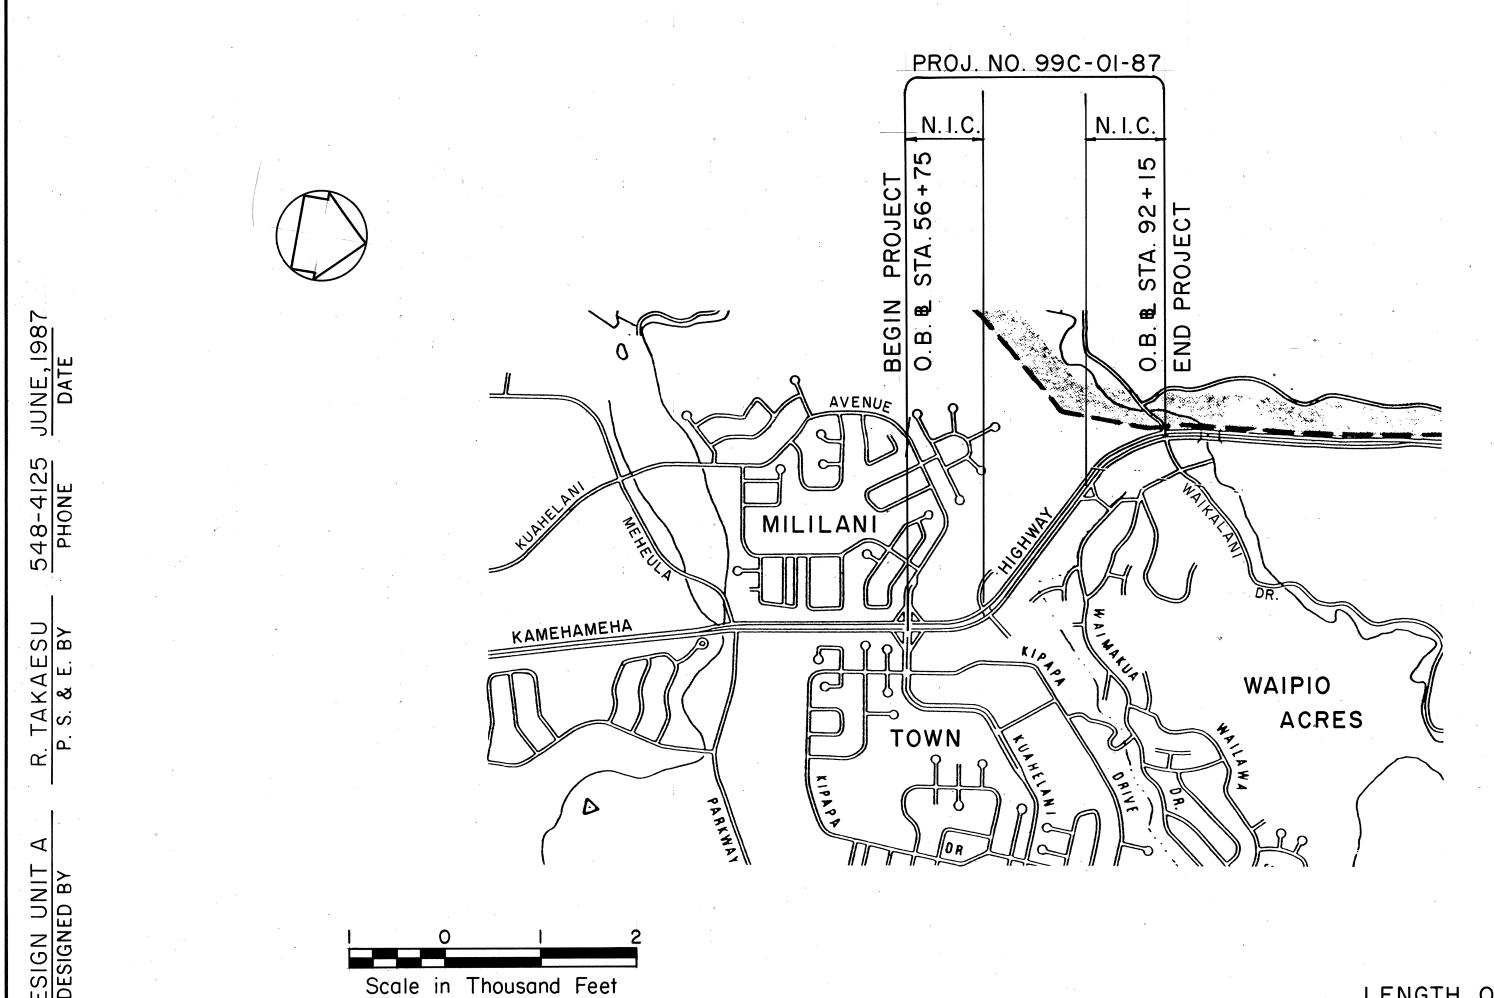

Waidadu Walande Walande Walande Walande Kahaluu Walande Kahalu

FED. ROAD DIST. NO. FISCAL SHEET YEAR NO.

PROJ. NO.

996-01-87

CHANGES MADE DURING CONSTRUCTION HAVE BEEN INCORPORATED ON THESE PLANS EXCEPT CHANGES IN THE ORIGINAL THEORETICAL QUANTITIES. FOR ACTUAL QUANTITIES, REFER TO PROJECT LEDGER AND/OR COMPUTATION BOOK.

Michael Luniège RESIDENT ENGINEER

//3//89 DATE

DEPARTMENT OF TRANSPORTATION STATE OF HAWAII

APPROVED:

R. OF TRANSPORTATION

LAYOUT PLAN

LENGTH OF PROJECT.... 0.276 MI.