	INDEX TO DRAWINGS
SHEET NO.	DESCRIPTION
t	TITLE SHEET
2_	STANDARD PLANS SUMMARY
3	TYPICAL SECTION, GENERAL
	NOTES AND LEGEND
4 - 5	PLANS
	· ·
-	
:	

STATE OF HAWAII


DEPARTMENT OF TRANSPORTATION HIGHWAYS DIVISION HONOLULU, HAWAII " AS-BUILT "


PLANS FOR

KAMEHAMEHA HIGHWAY WALKWAY

HAWAIIAN ELECTRIC PLANT TO NEAL BLAISDELL PARK PROJECT NO. 99D-01-87

> DISTRICT OF EWA ISLAND OF OAHU

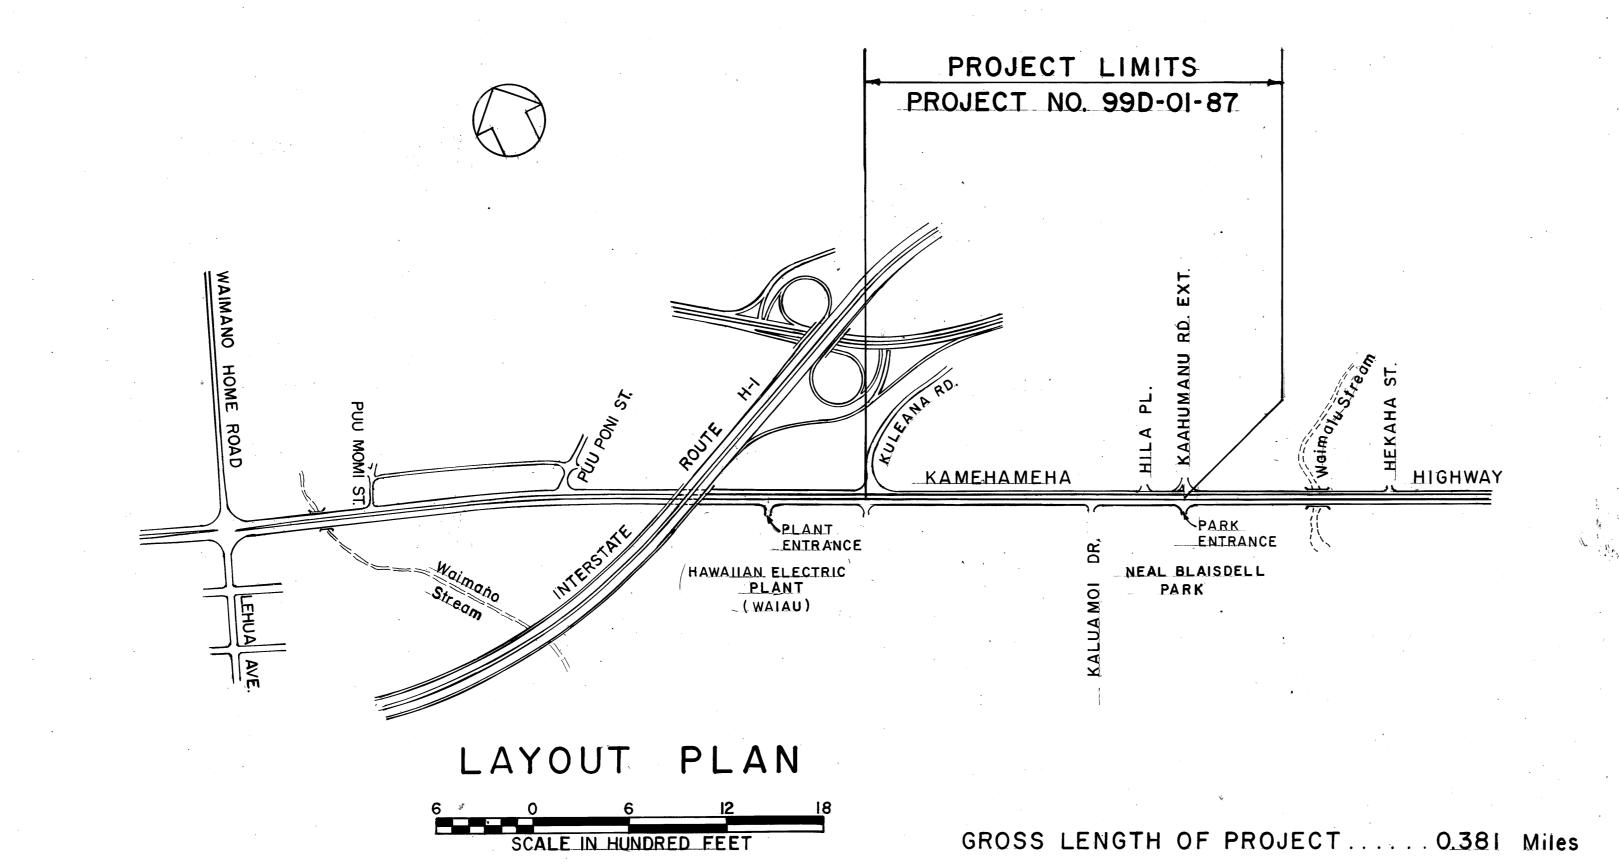

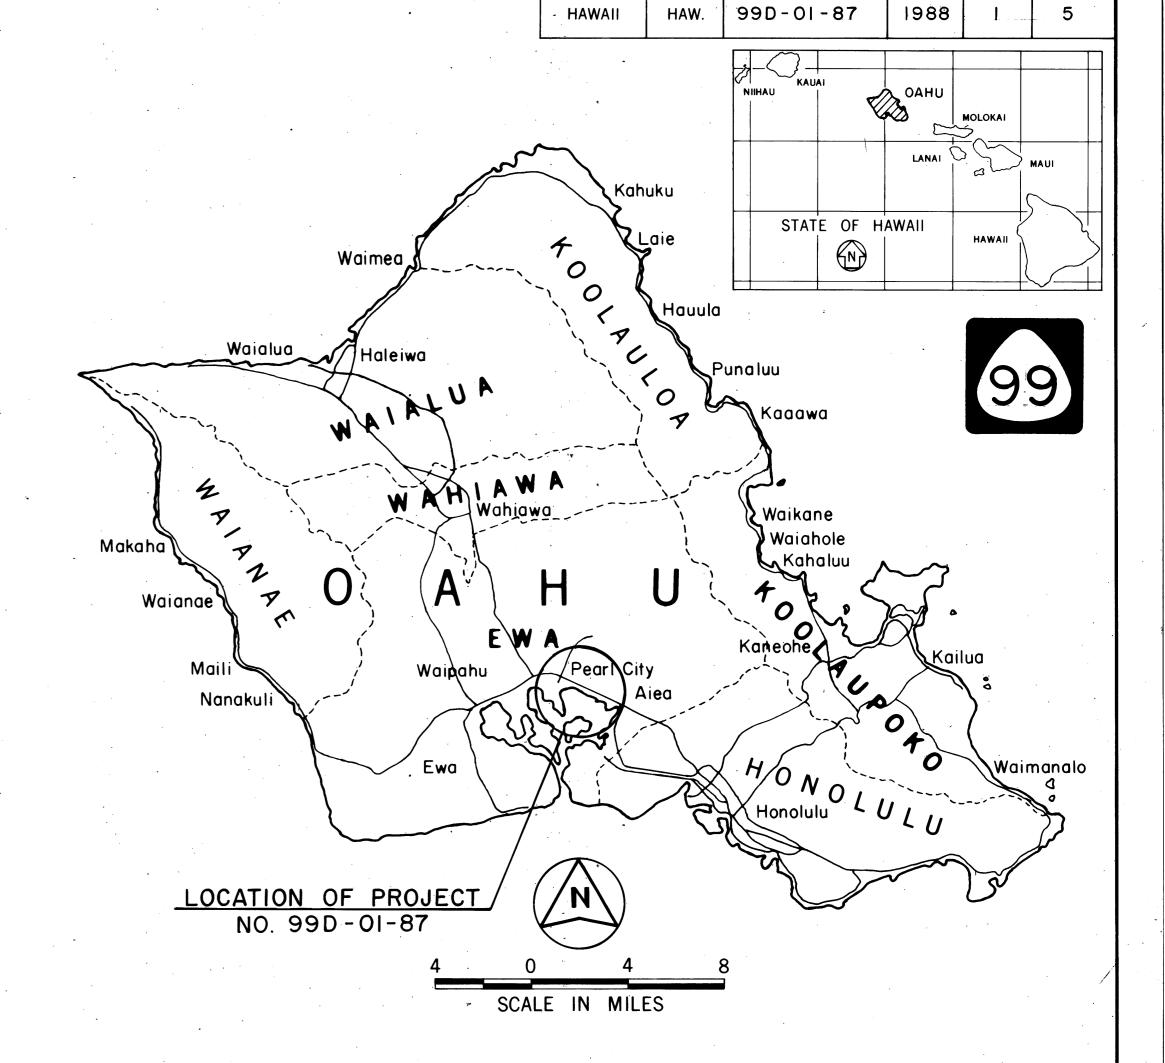

PROJ. NO.

CHANGES MADE DURING CONSTRUCTION HAVE BEEN INCORPORATED ON THESE PLANS EXCEPT CHANGES IN THE ORIGINAL THEORETICAL QUANTITIES, FOR ACTUAL QUANTITIES, REFER TO PROJECT LEDGER AND/OR COMPUTATION BOOK.

RESIDENT ENGINEER

DEPARTMENT OF TRANSPORTATION STATE OF HAWAII

D-8-7