


FED. ROAD DIST. NO.	STATE	FED. PROJ. NO.	FISCAL YEAR	SHEET NO.	TOTAL SHEETS
HAWAII	HAW.	99C-02-87	1988	5	5



* Remove existing sign & post after Traffic Signal System becomes operational.

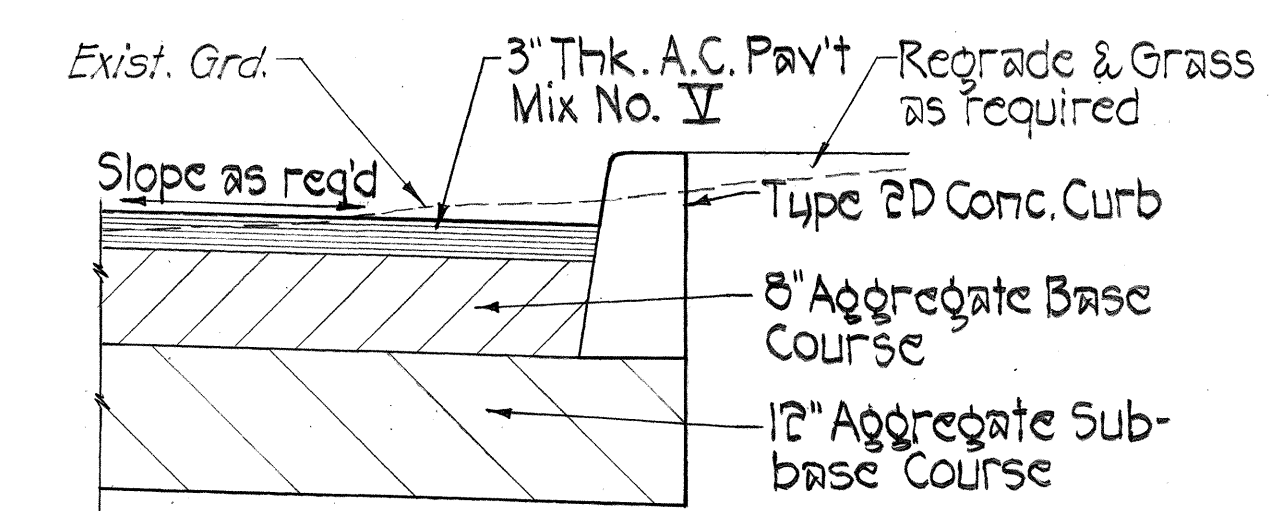

TYPICAL PAVEMENT SECTION
Not To Scale

NOTES:

1. Cut back of tree branches shall not be measured separately for payment but shall be considered incidental to various items of work.
2. Painting of Type 6 Curb with white traffic paint shall not be measured for payment separately but shall be considered incidental to Type 6 Curb.
3. Removal of pavement markers, striping, signs and posts shall not be measured for payment separately but shall be considered incidental to various items of work.

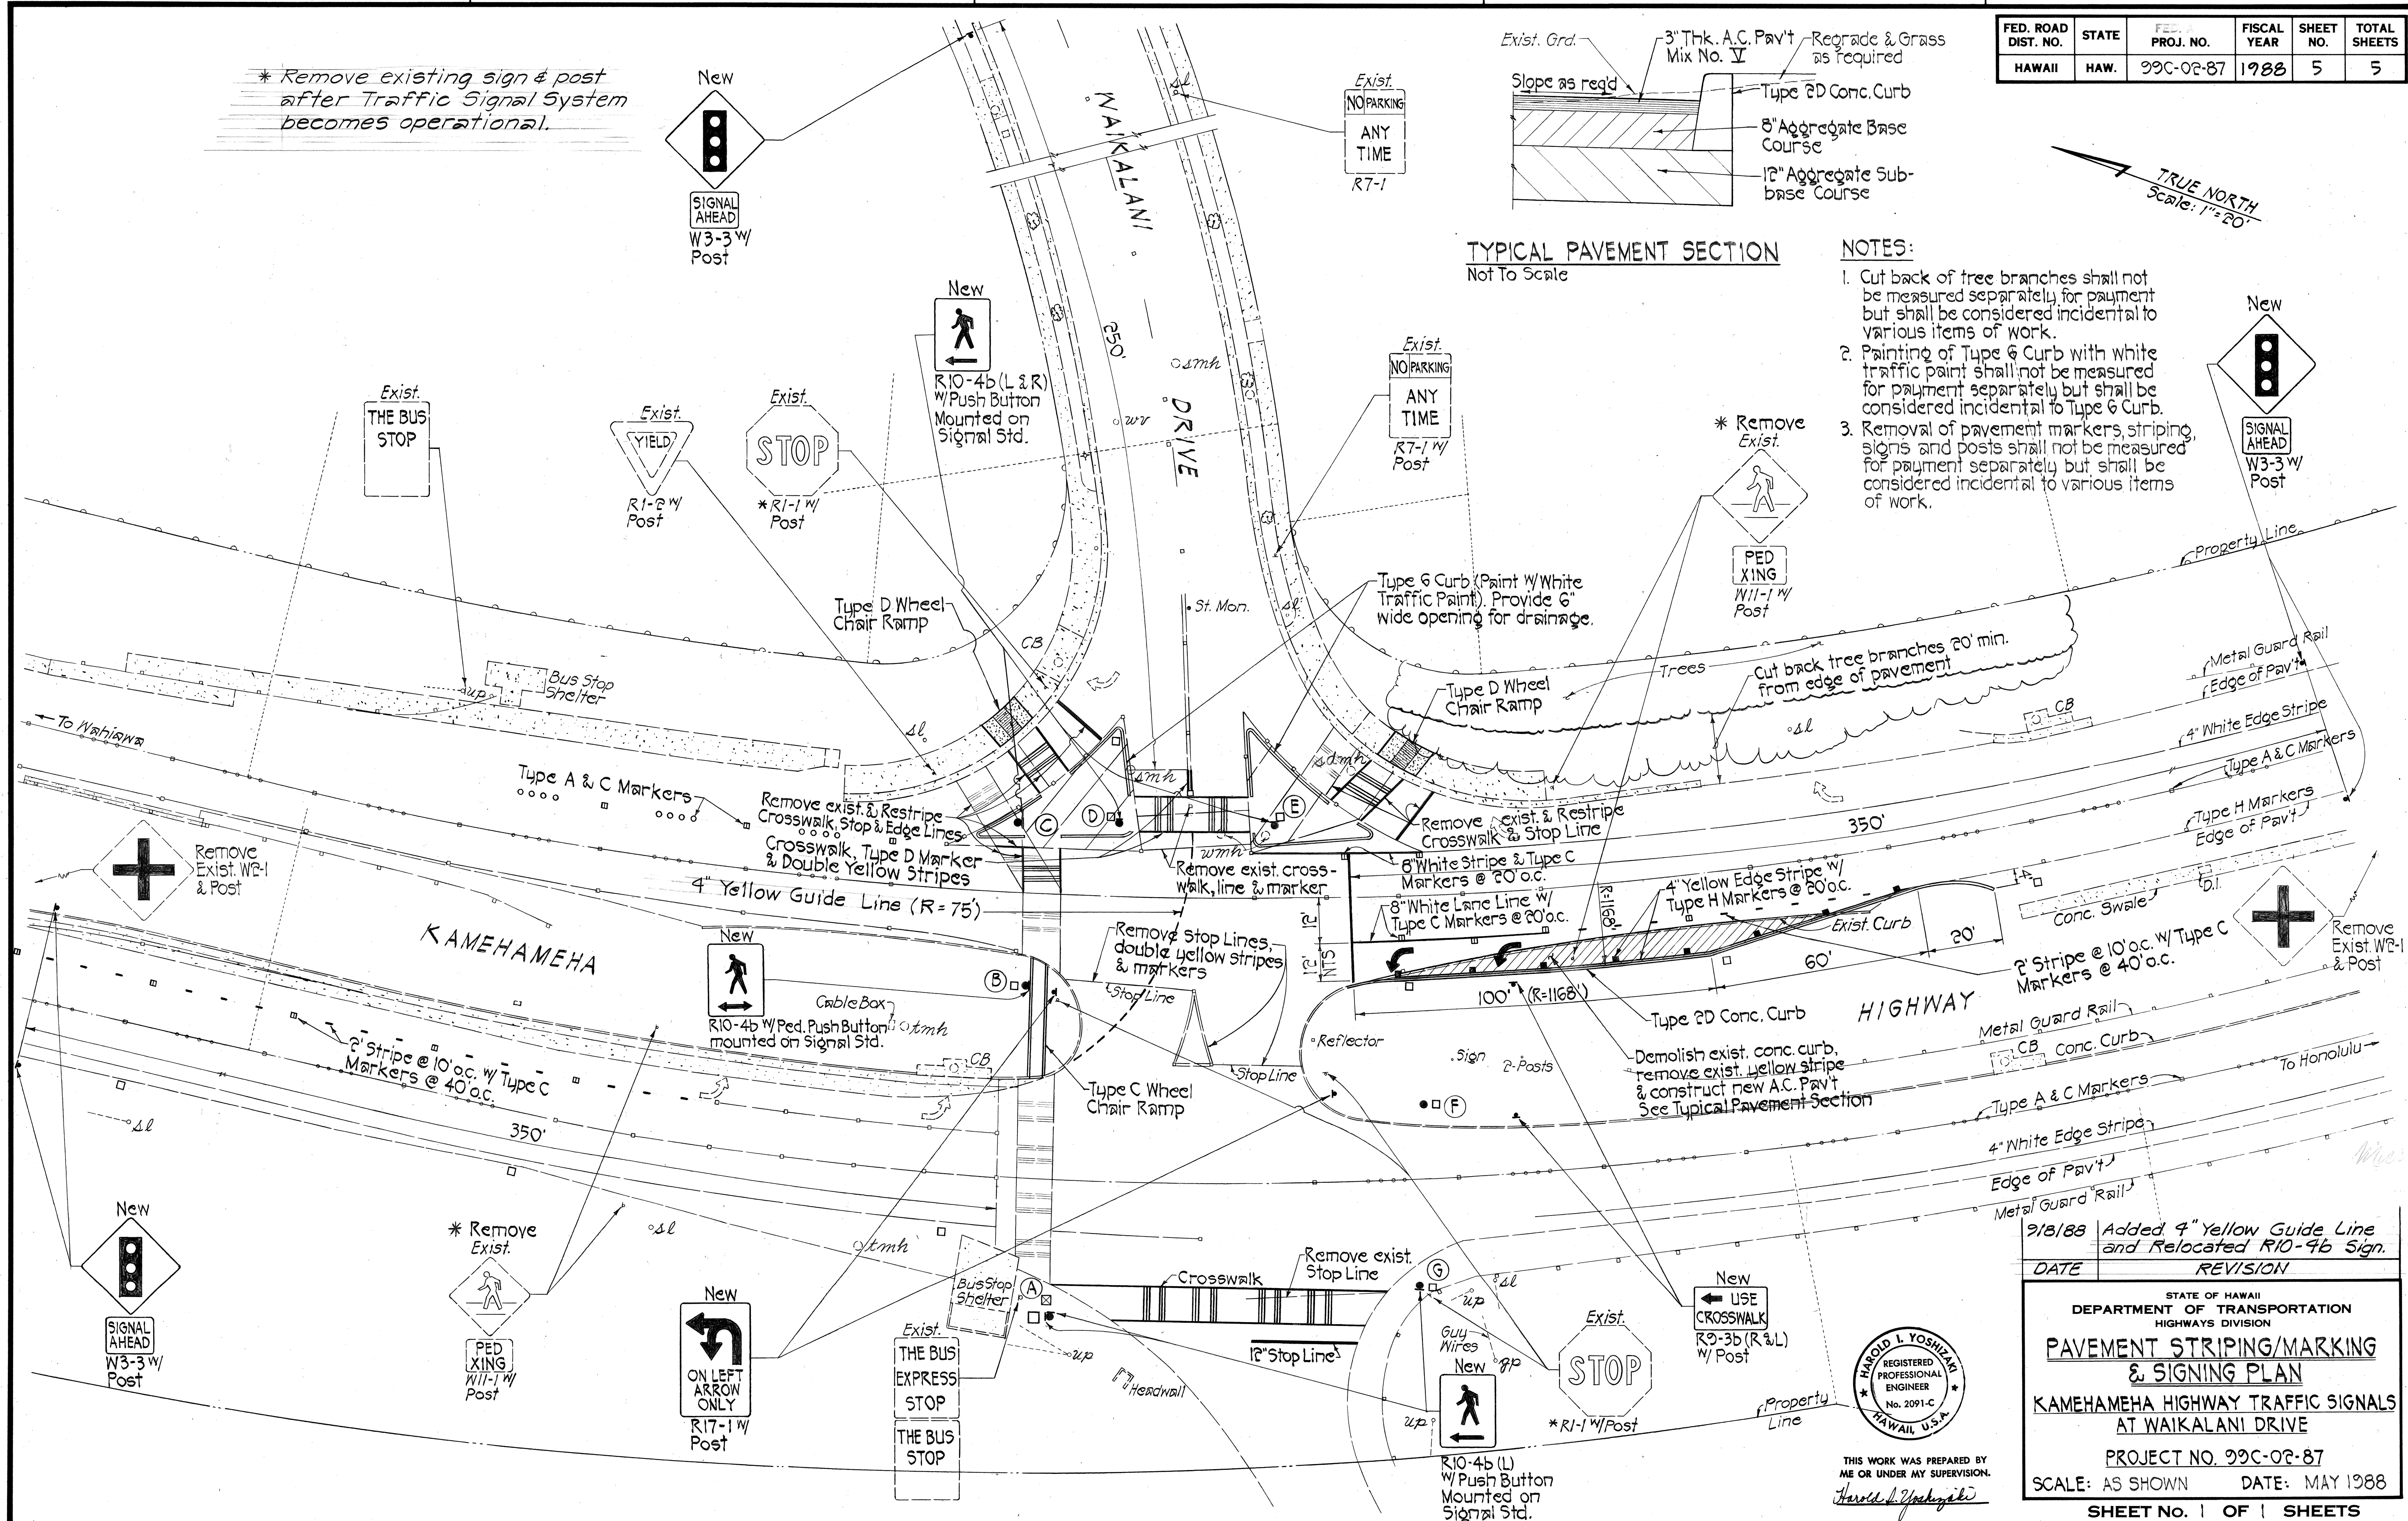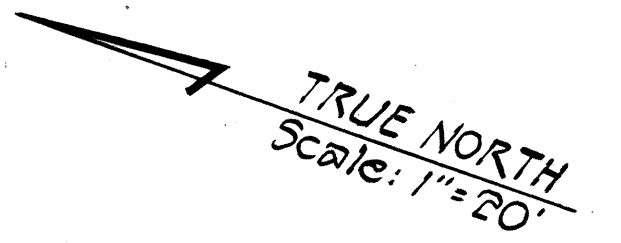

DATE	DESIGNED BY
	TRACED BY
	QUANTITIES BY
	CHECKED BY

DATE	REVISION
9/8/88	Added 9" Yellow Guide Line and Relocated R10-4b Sign.


STATE OF HAWAII
DEPARTMENT OF TRANSPORTATION
HIGHWAYS DIVISION

PAVEMENT STRIPING/MARKING & SIGNING PLAN

KAMEHAMEHA HIGHWAY TRAFFIC SIGNALS AT WAIKALANI DRIVE

PROJECT NO. 99C-02-87
SCALE: AS SHOWN DATE: MAY 1988

SHEET NO. 1 OF 5 SHEETS

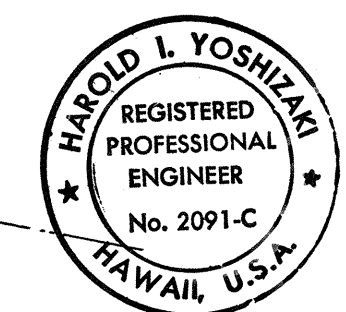

THIS WORK WAS PREPARED BY ME OR UNDER MY SUPERVISION.
Harold I. Yoshizaki