	INDEX TO DRAWINGS
SHEET NO.	DESCRIPTION
I	TITLE SHEET
2	SUMMARY SHEET
3 - 4	GENERAL NOTES & TYPICAL SECTIONS
5-6	PLAN
	8
	i
	f .

STATE OF HAWAII

DEPARTMENT OF TRANSPORTATION

HIGHWAYS DIVISION HONOLULU, HAWAII


"AS BUILT "


PLANS FOR

KAMEHAMEHA HIGHWAY SIDEWALK AND FENCE WAIHAU STREET TO WAIKALANI DRIVE PROJECT NO. 99C-03-89

KAMEHAMEHA HIGHWAY SIDEWALK KUAHELANI AVENUE TO KIPAPA STREET PROJECT NO. 99C-04-89

DISTRICT OF EWA ISLAND OF OAHU

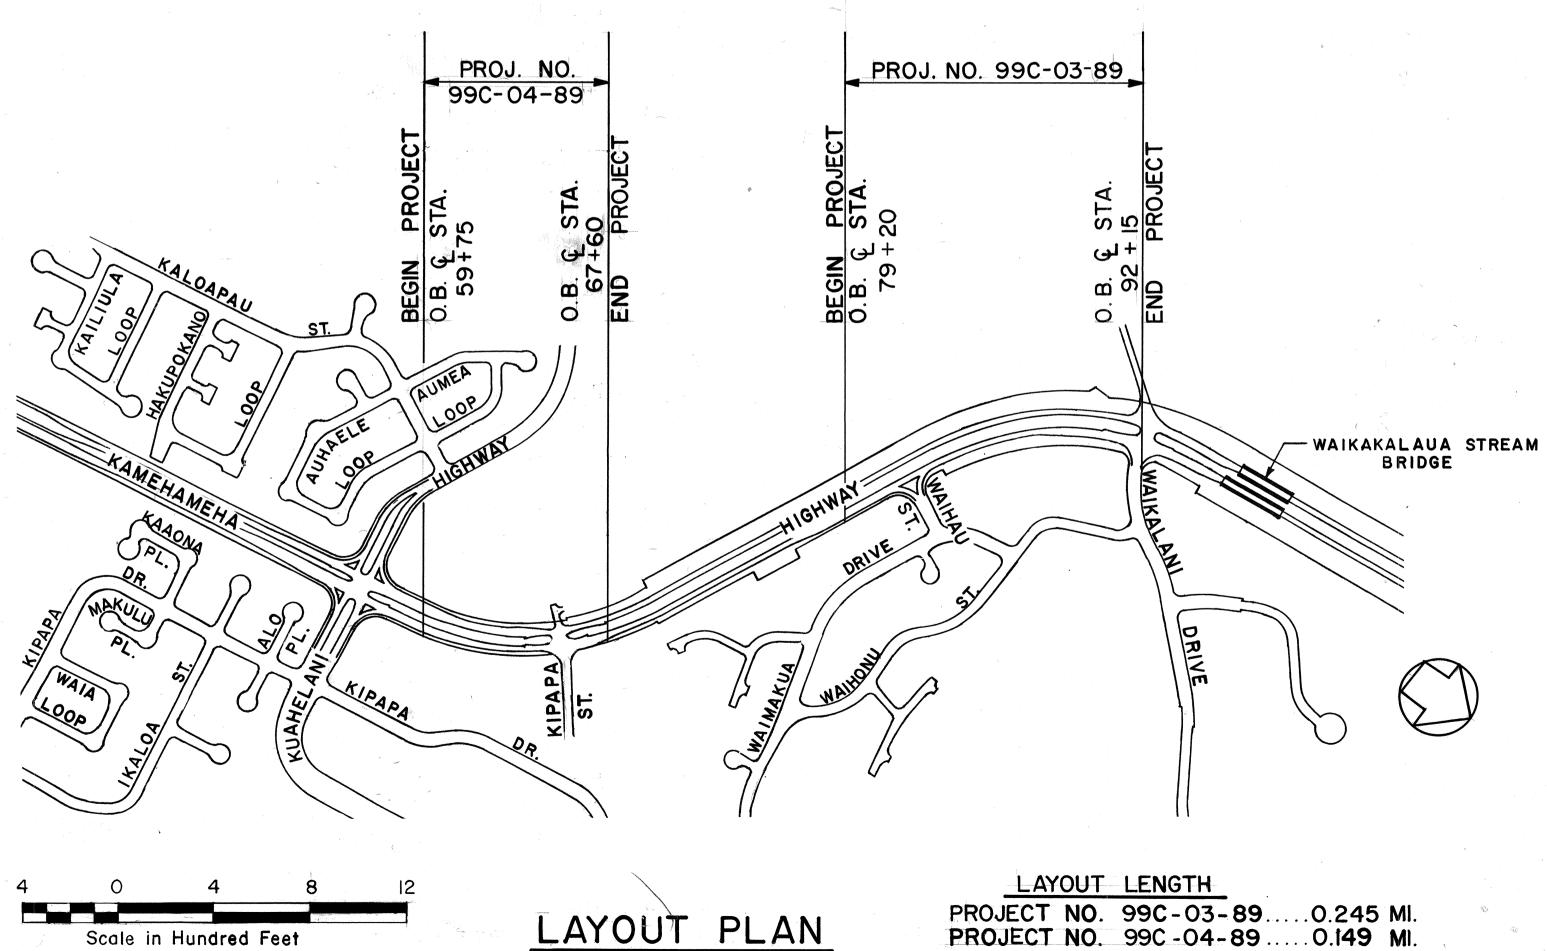

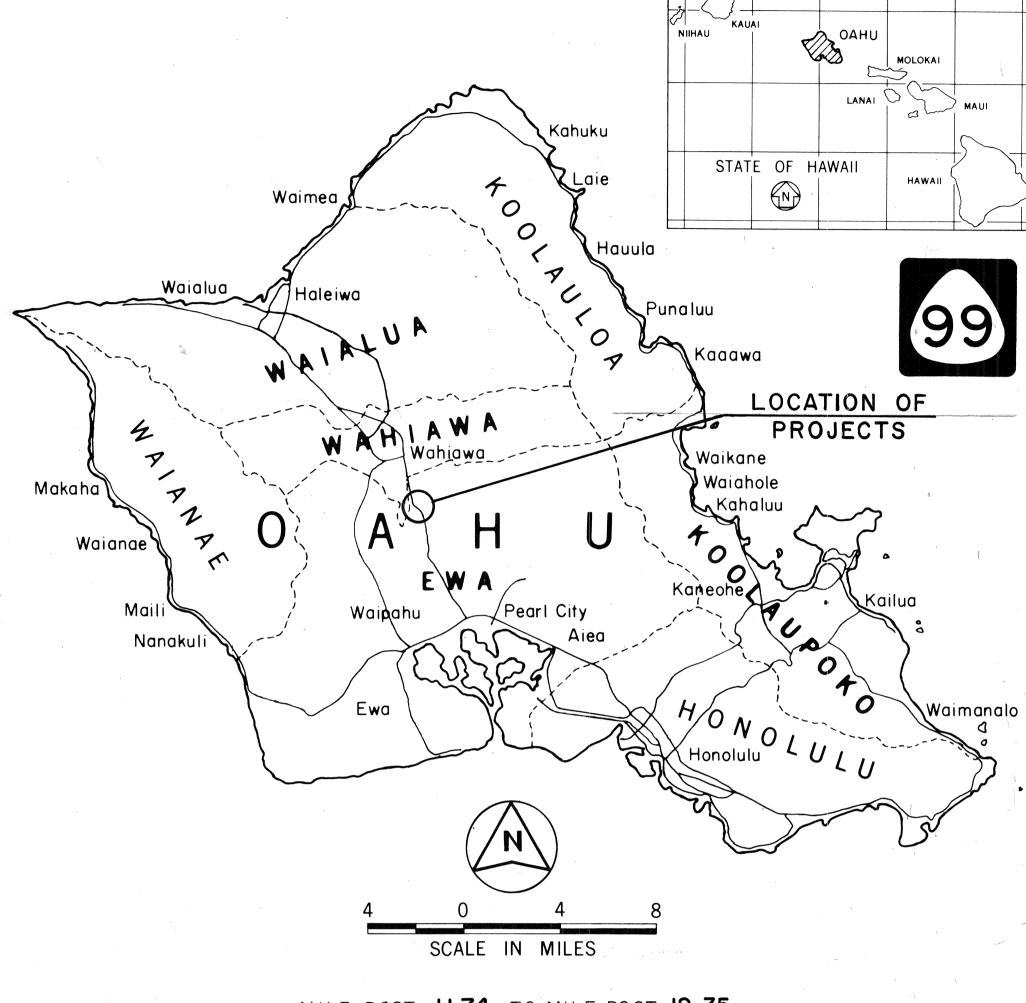

FED. ROAD DIST. NO.

STATE

PROJ. NO.

99C-03-89 99C-04-89 FISCAL SHEET TOTAL YEAR NO. SHEETS

1989

MILE POST 11.74 TO MILE POST 12.35

CHANGES MADE DURING CONSTRUCTION HAVE BEEN INCORPORATED ON THESE PLANS EXCEPT CHANGES IN THE ORIGINAL THEORETICAL QUANTITIES. FOR ACTUAL QUANTITIES, REFER TO PROJECT LEDGER AND/OR COMPUTATION BOOK.

Michael Diniga 6/14/91 RESIDENT ENGINEER DATE

DEPARTMENT OF TRANSPORTATION
STATE OF HAWAII

APPROVED:

LL. 4/4/9

DIR. OF TRANSPORTATION

DATE

DESIGN UNIT AR. TAKAESU548-4125DESIGNED BYP. S. & E. BYPHONE

JAN.1990 DATE