

FED. ROAD DIST. NO.	STATE	PROJ. NO.	FISCAL YEAR	SHEET NO.	TOTAL SHEETS
HAWAII	HAW.	99D-01-89	1990	5	16

LEGEND

- Limits of Resurfacing

Cold Planing Areas

○ ls

Existing Street Light Standard

○ ts

Existing Traffic Signal

⋈

Existing Traffic Sign

○ tp

Existing Telephone Pole

○-A

Existing Telephone Pole with Anchor

○ ep

Existing Electric Pole

○ tmh

Existing Telephone Manhole

□ ls pb

Existing Street Light Standard Pullbox

□ tp b

Existing Telephone Pullbox

□ ts pb

Existing Traffic Signal Pullbox

— e —

Existing Electrical Line

--- ts ---

Existing Traffic Signal Line

— t —

Existing Telephone Line

— g — 10 —

Existing Gas Line

□ cd I

Existing Concrete Drop Intake


□ □ □

Existing Loop Detector Sensing Unit

□ □

New Loop Detector Sensing Unit

CURVE DATA			
	①	②	③
Δ	80°39'40"	15°00'00"	54°28'37"
R	150.00'	150.00'	412.00'
T	127.35'	19.75'	212.09'
L	211.17'	39.27'	391.73'
S.E.	0.015 ft/ft	—	0.015 ft/ft

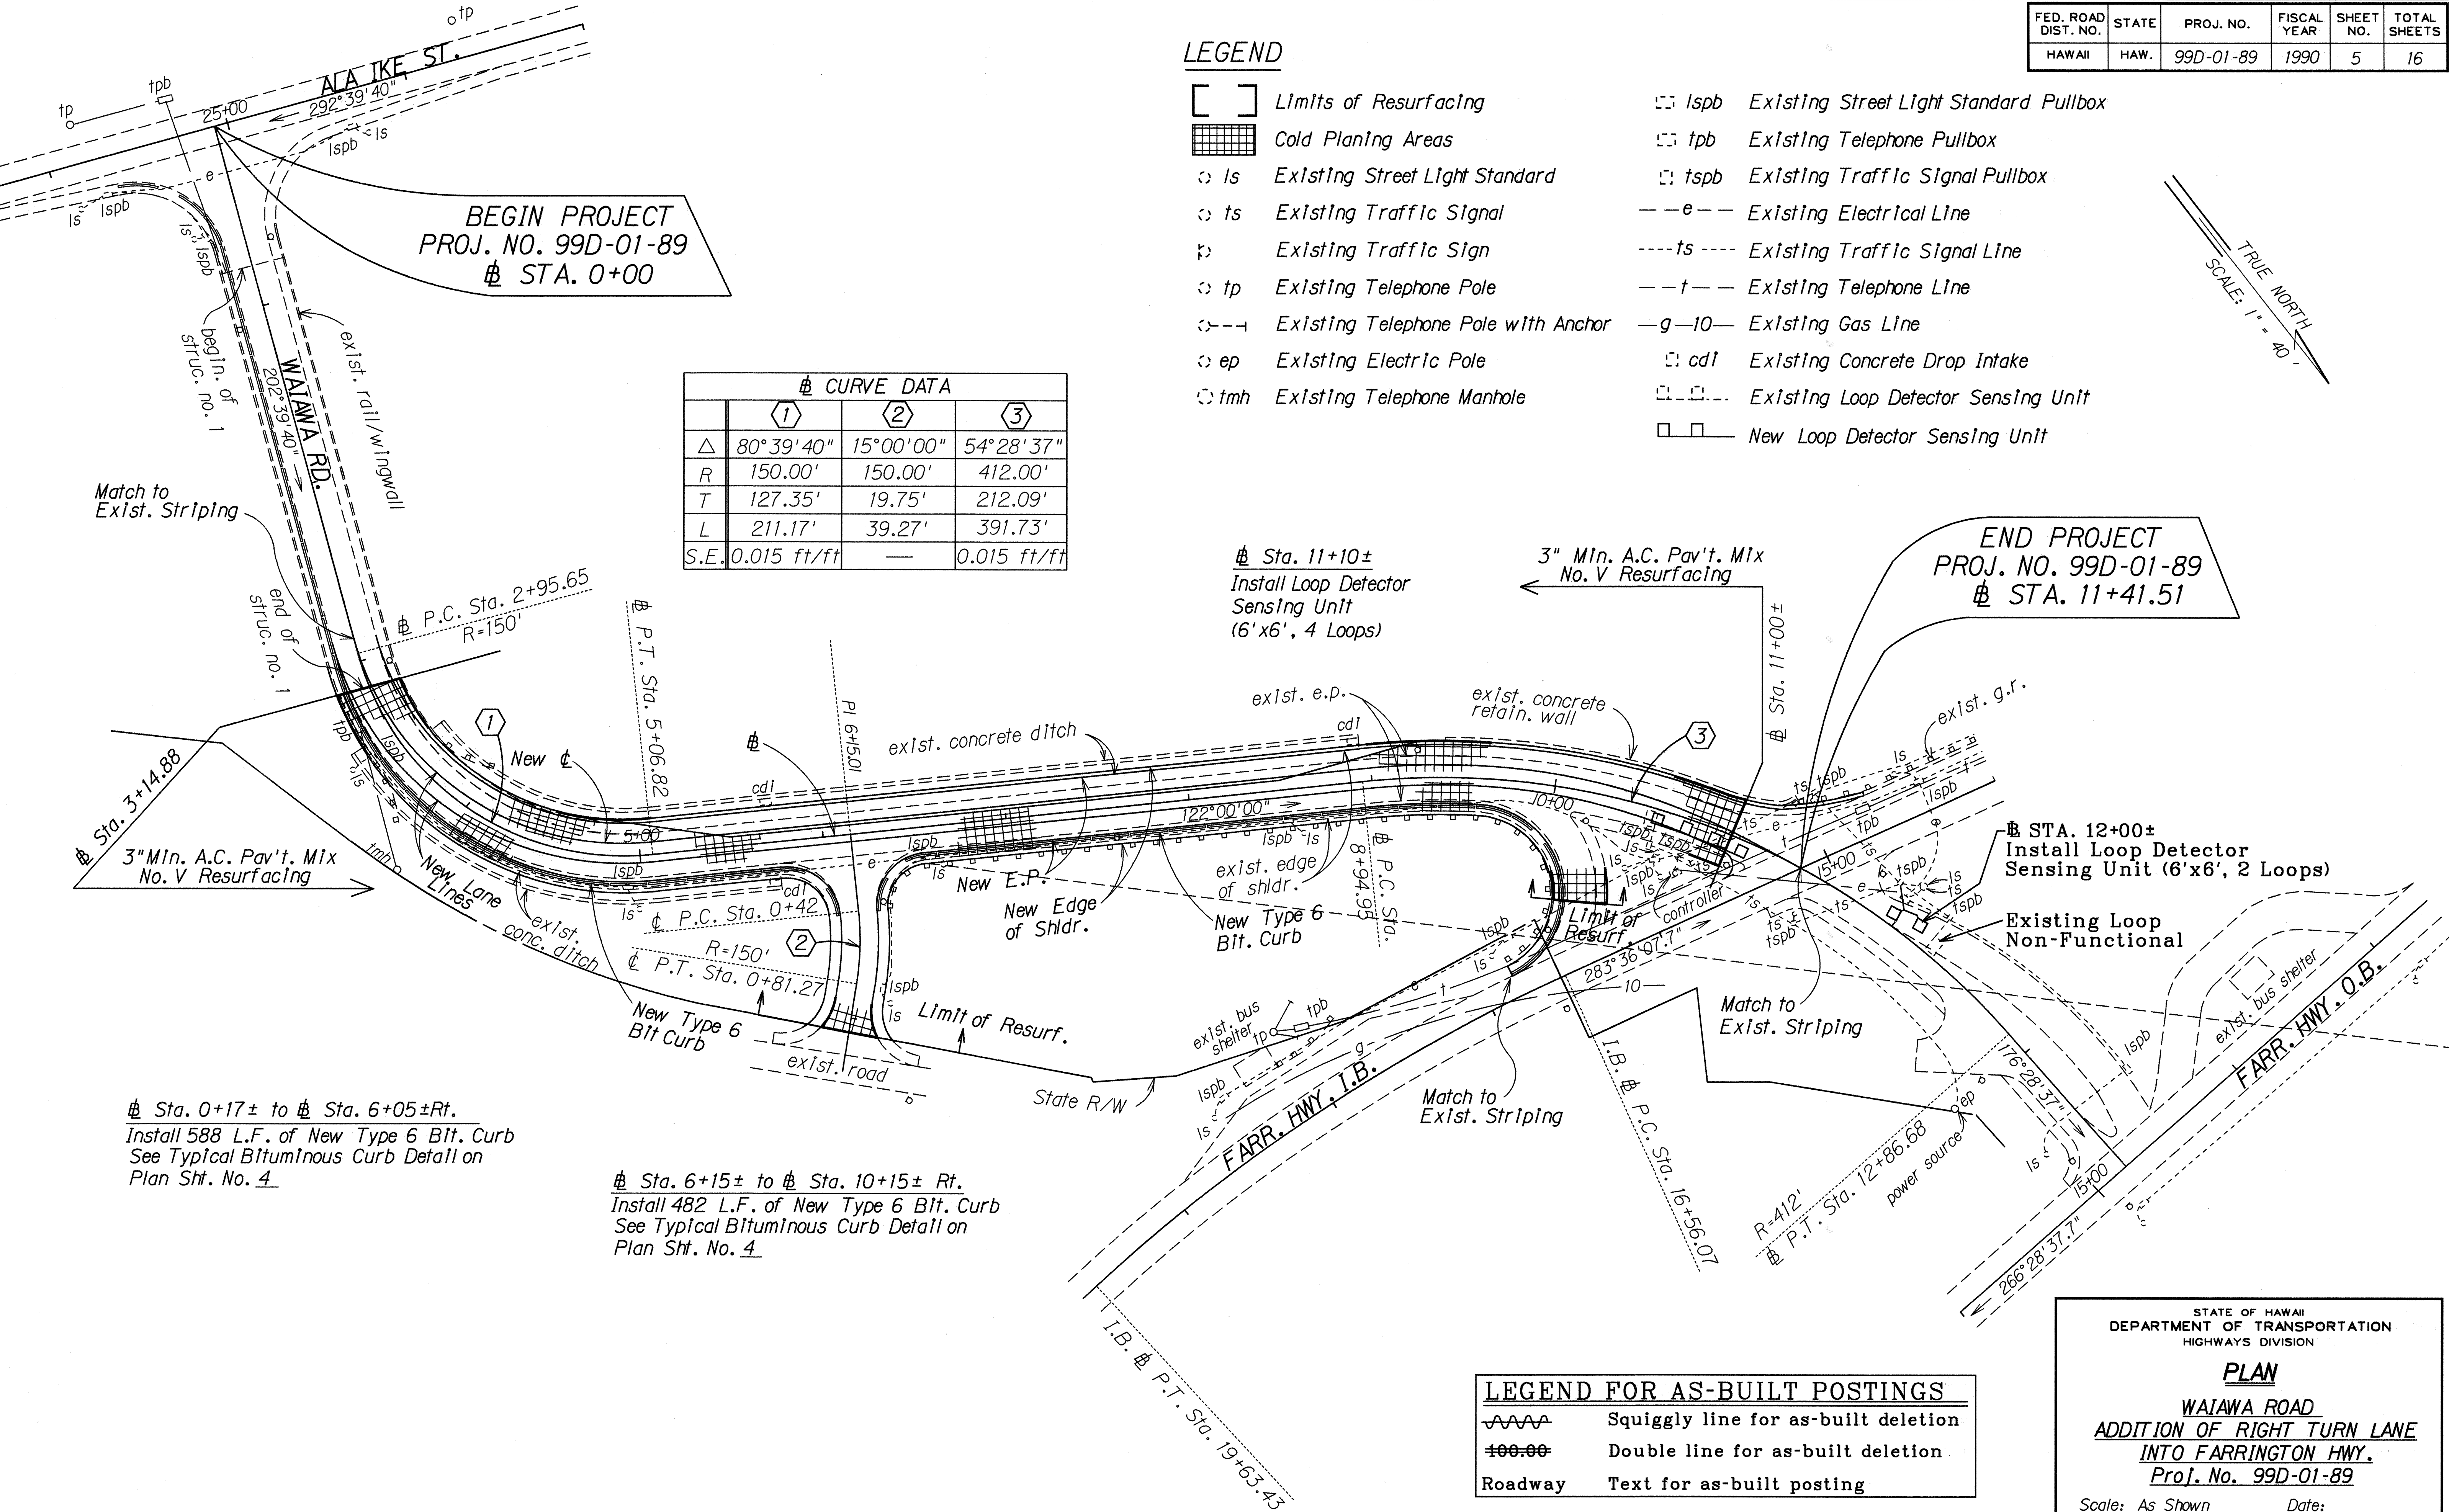

SURVEY PLOTTED BY	DATE
DRAWN BY	
CHECKED BY	
QUANTITIES BY	
NOTES BY	
CHECKED BY	

LEGEND FOR AS-BUILT POSTINGS

- ~~~~~

Squiggly line for as-built deletion
- ==

Double line for as-built deletion
- Roadway

Text for as-built posting

STATE OF HAWAII
DEPARTMENT OF TRANSPORTATION
HIGHWAYS DIVISION

PLAN

WAIAWA ROAD
ADDITION OF RIGHT TURN LANE
INTO FARRINGTON HWY.
Proj. No. 99D-01-89

Scale: As Shown Date:

SHEET No. 1 OF 1 SHEETS