| | INDEX TO DRAWINGS |
|-----------|-------------------------------|
| SHEET NO. | DESCRIPTION |
| 1 | TITLE SHEET |
| 2 | STANDARD PLANS SUMMARY |
| 3 | TYPICAL SECTIONS |
| 4 | GEN. NOTES & MISC. DETAILS |
| 5 | PLANS |
| 6-9 | SIGNING & PAVEMENT MARKING |
| | PLANS & DETAILS |
| ① 10-12 | DECK DRAIN AT STRUCTURE NO. I |
| 13-16 | EXISTING STRUCTURES |
| | · |
| | , |
| | |
| | |
| , | |
| | ê . |
| | · · |
| | |

Plan Sht. No. OloS-I is a supplementary sheet to this project. TOTAL SHEET COUNT AFTER "AS-BUILT" postings 17 Sheets.

STATE OF HAWAII

DEPARTMENT OF TRANSPORTATION

HIGHWAYS DIVISION HONOLULU, HAWAII

"AS-BUILT"

PLANS FOR


WAIAWA ROAD


ADDITION OF RIGHT TURN LANE INTO FARRINGTON HIGHWAY

PROJECT NO. 99D-01-89

ISLAND OF OAHU

DISTRICT OF EWA

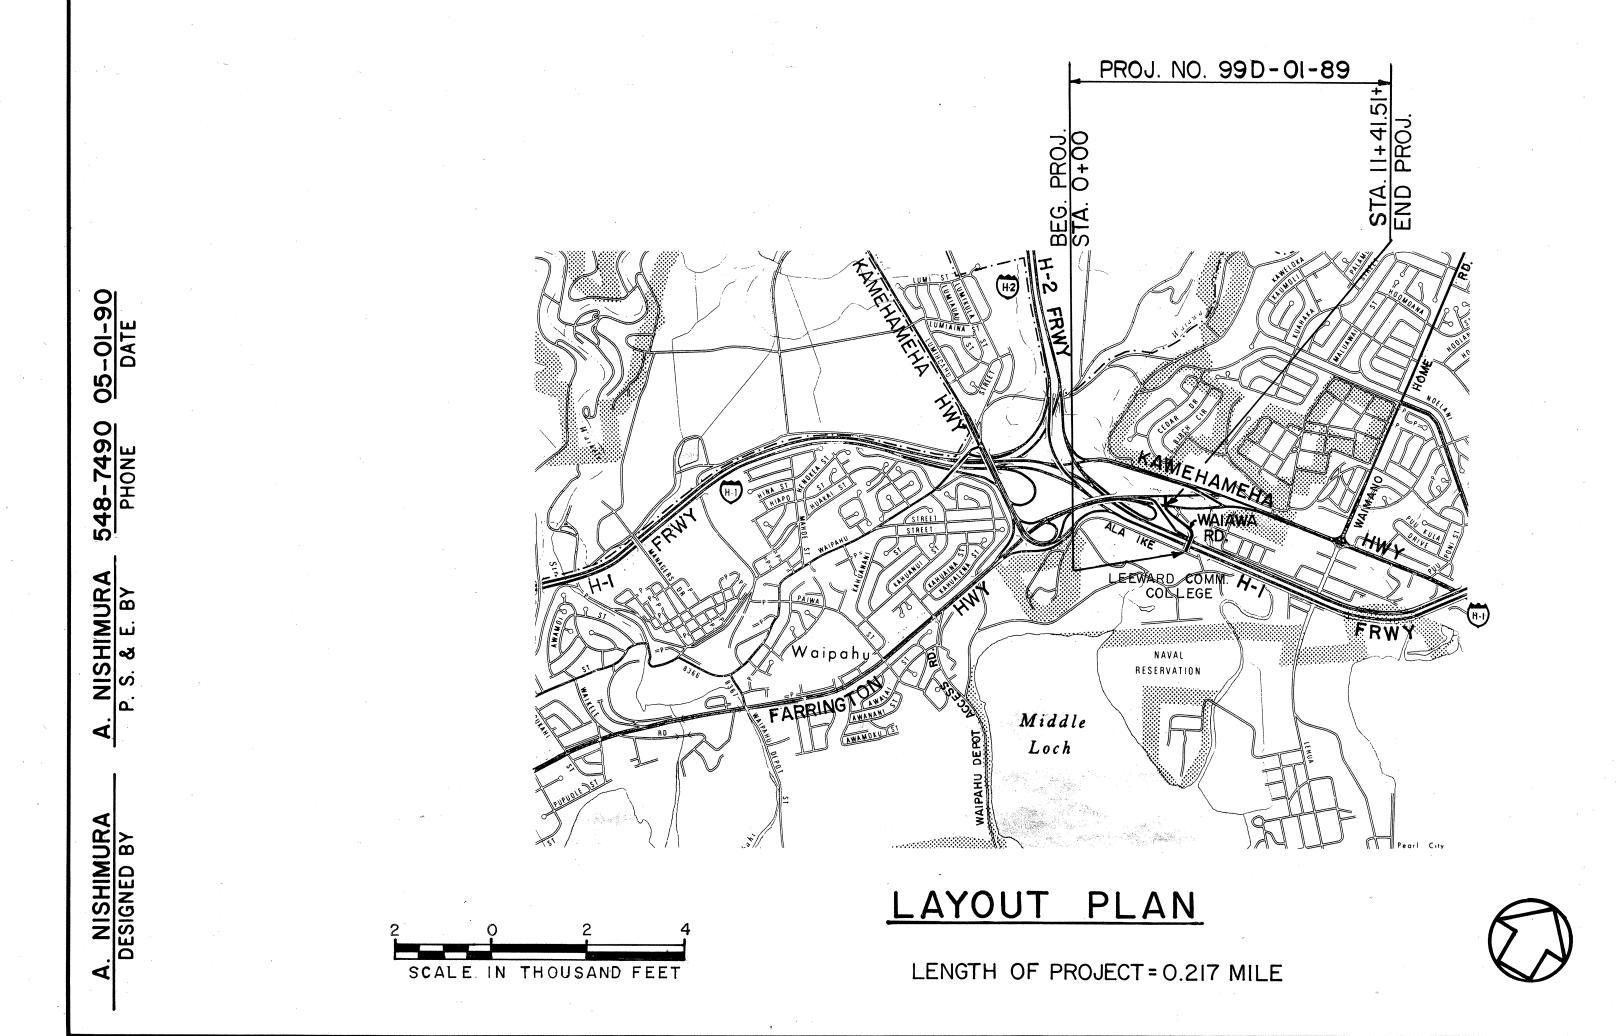

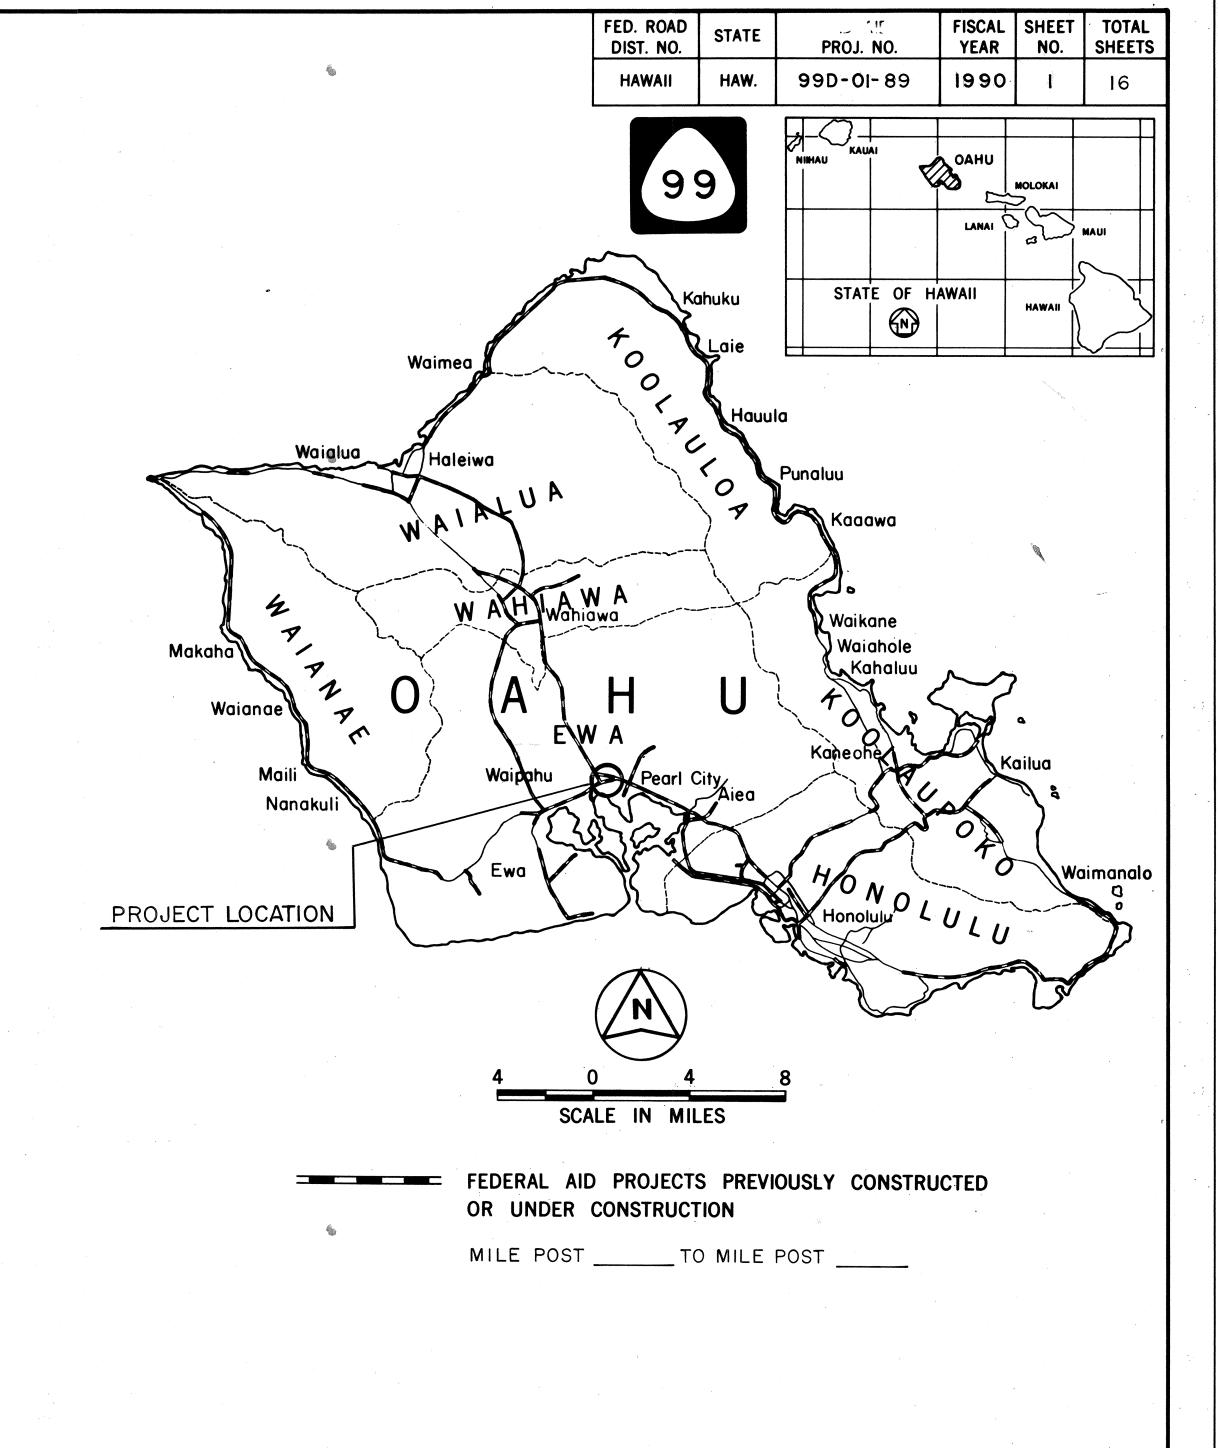

ALL CHANGES MADE DURING CONSTRUCTION HAVE BEEN NOTED IN RED ON THESE TRACINGS AND CHECKED BY

ENT ENGINEER D

DEPARTMENT OF TRANSPORTATION
STATE OF HAWAII

APPROVED:

Church C/1/90
DIR. OF TRANSPORTATION
DATE