


FED. ROAD DIST. NO.	STATE	PROJ. NO.	FISCAL YEAR	SHEET NO.	TOTAL SHEETS
HAWAII	HAW.	99E-01-91M	1991	5	33

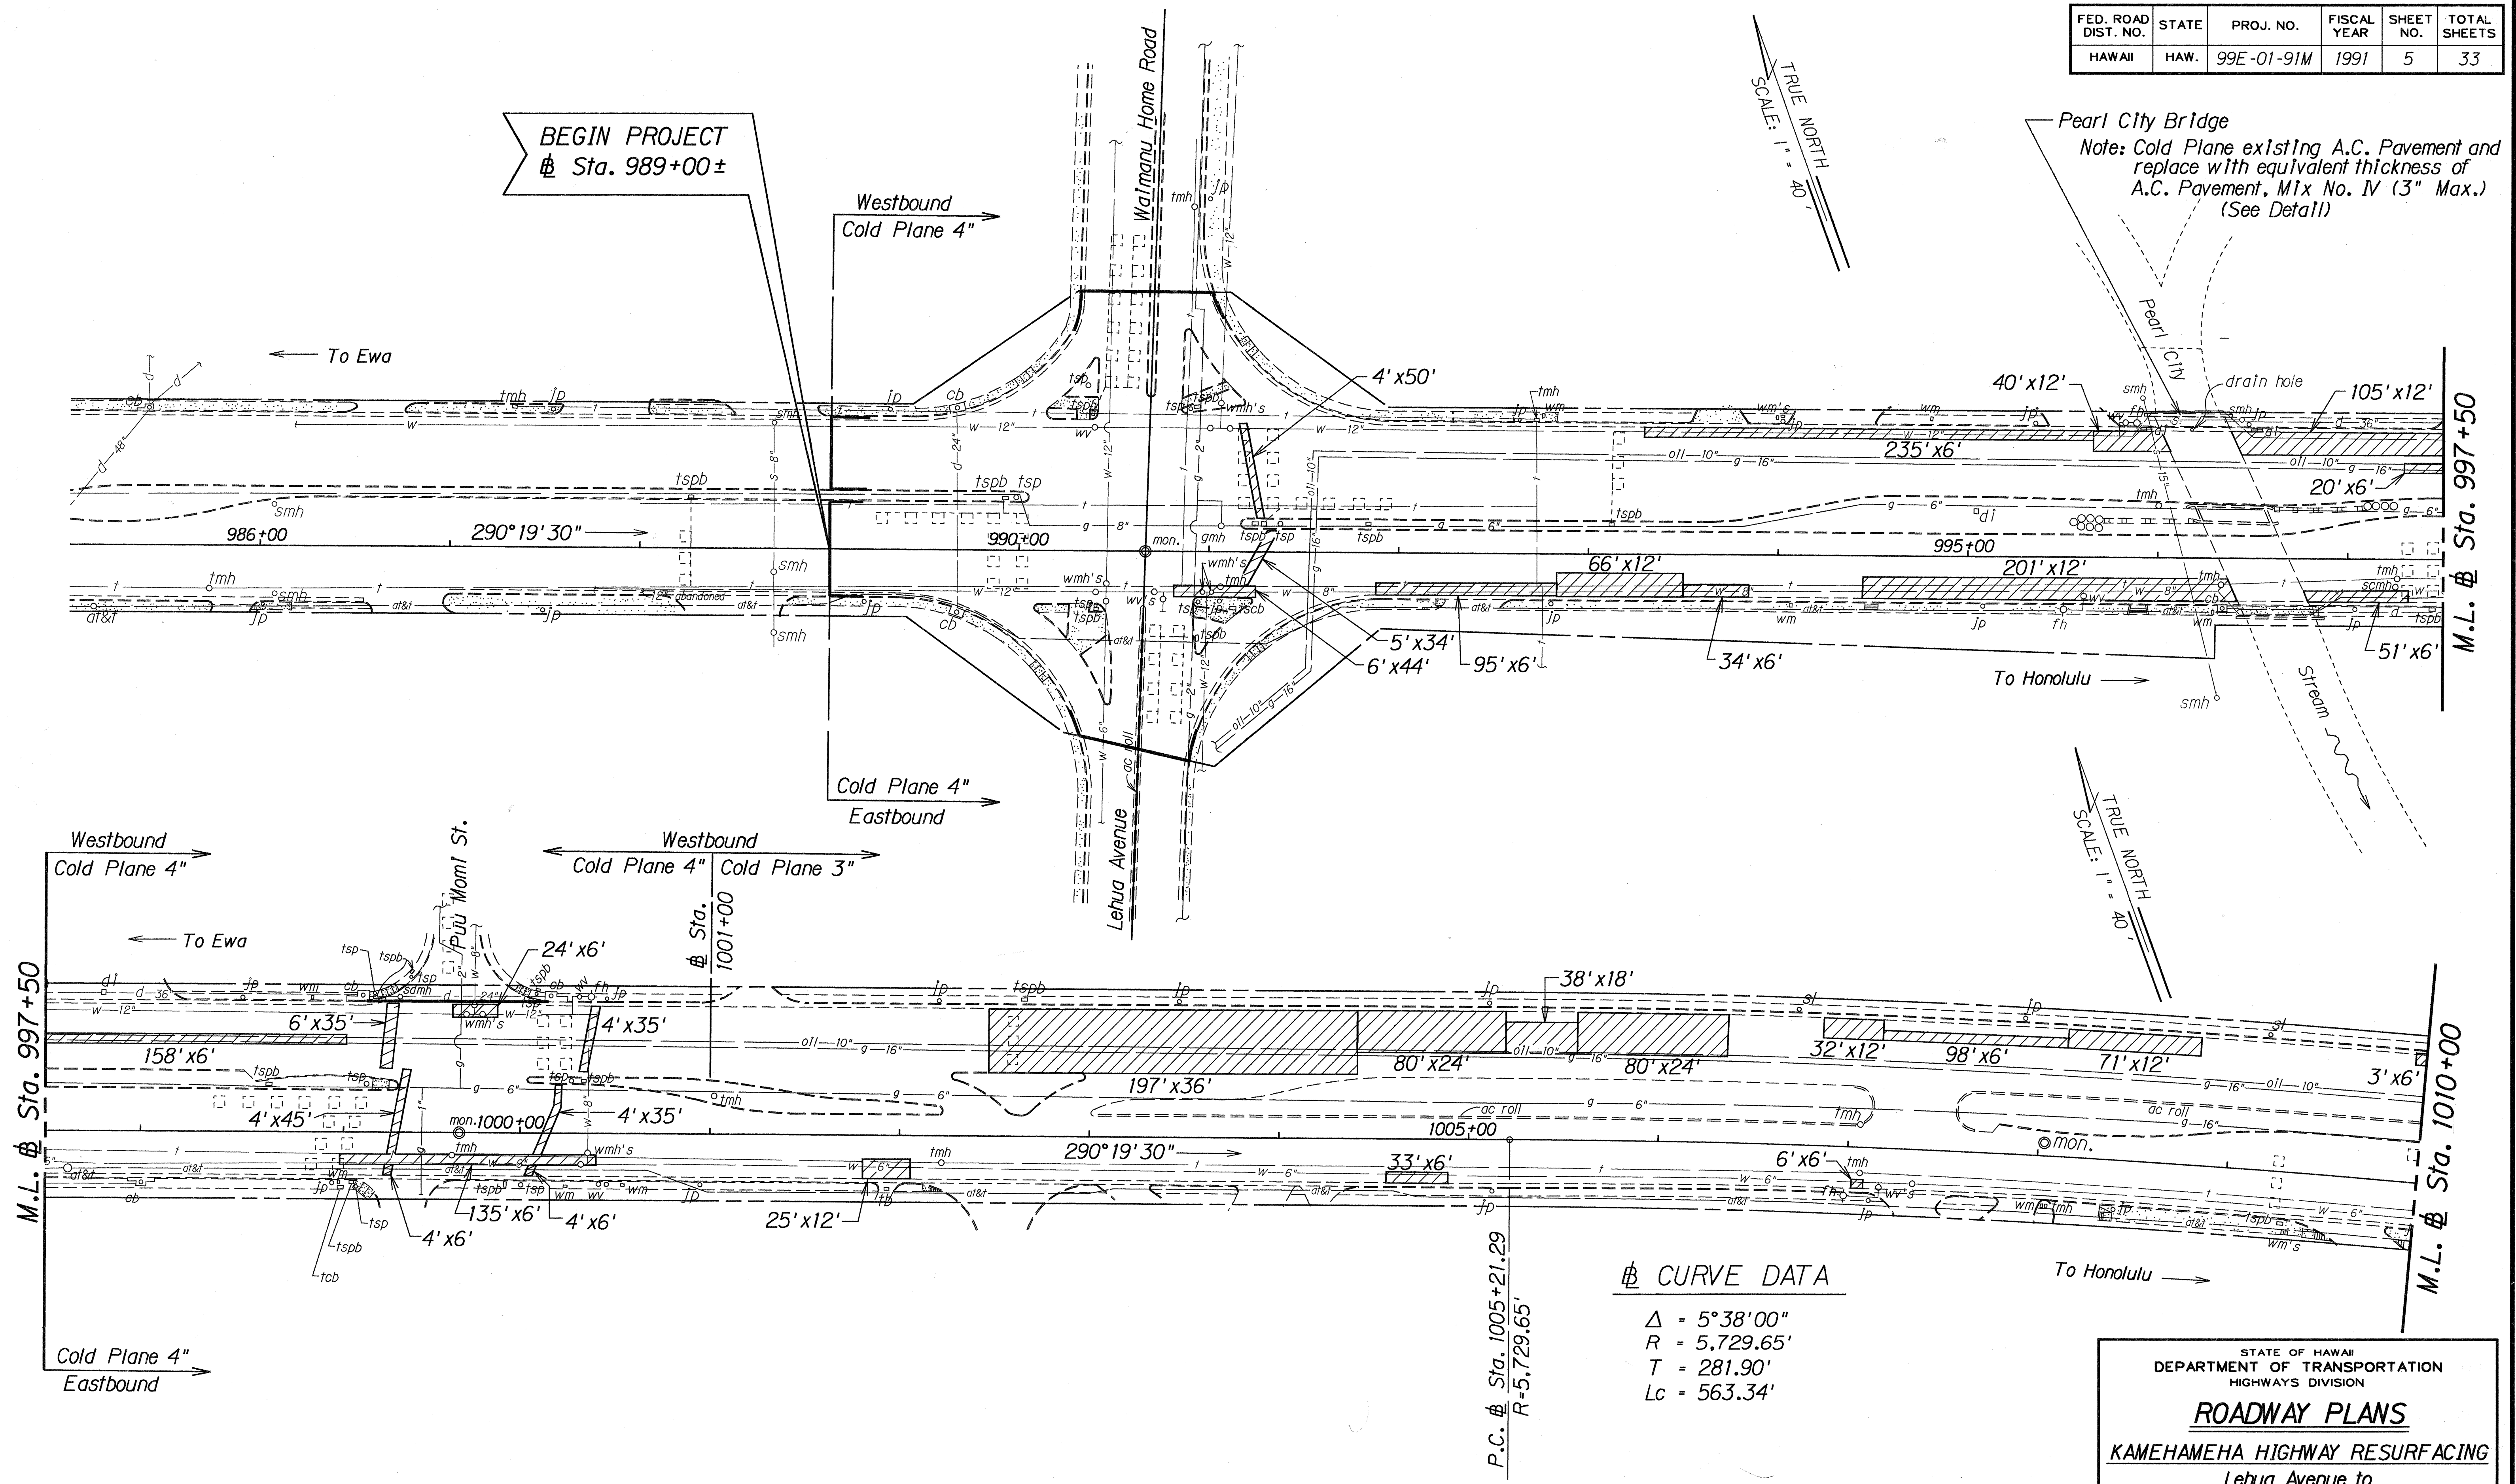

STATE OF HAWAII
DEPARTMENT OF TRANSPORTATION
HIGHWAYS DIVISION

ROADWAY PLANS

KAMEHAMEHA HIGHWAY RESURFACING


Lehua Avenue to
Vicinity of Honomanu Street

Project No. 99E-01-91M

Scale: 1" = 40' Date: April 11, 1991

SHEET No. 1 OF 7 SHEETS

FED. ROAD DIST. NO.	STATE	PROJ. NO.	FISCAL YEAR	SHEET NO.	TOTAL SHEETS
HAWAII	HAW.	99E-01-91M	1991	6	33

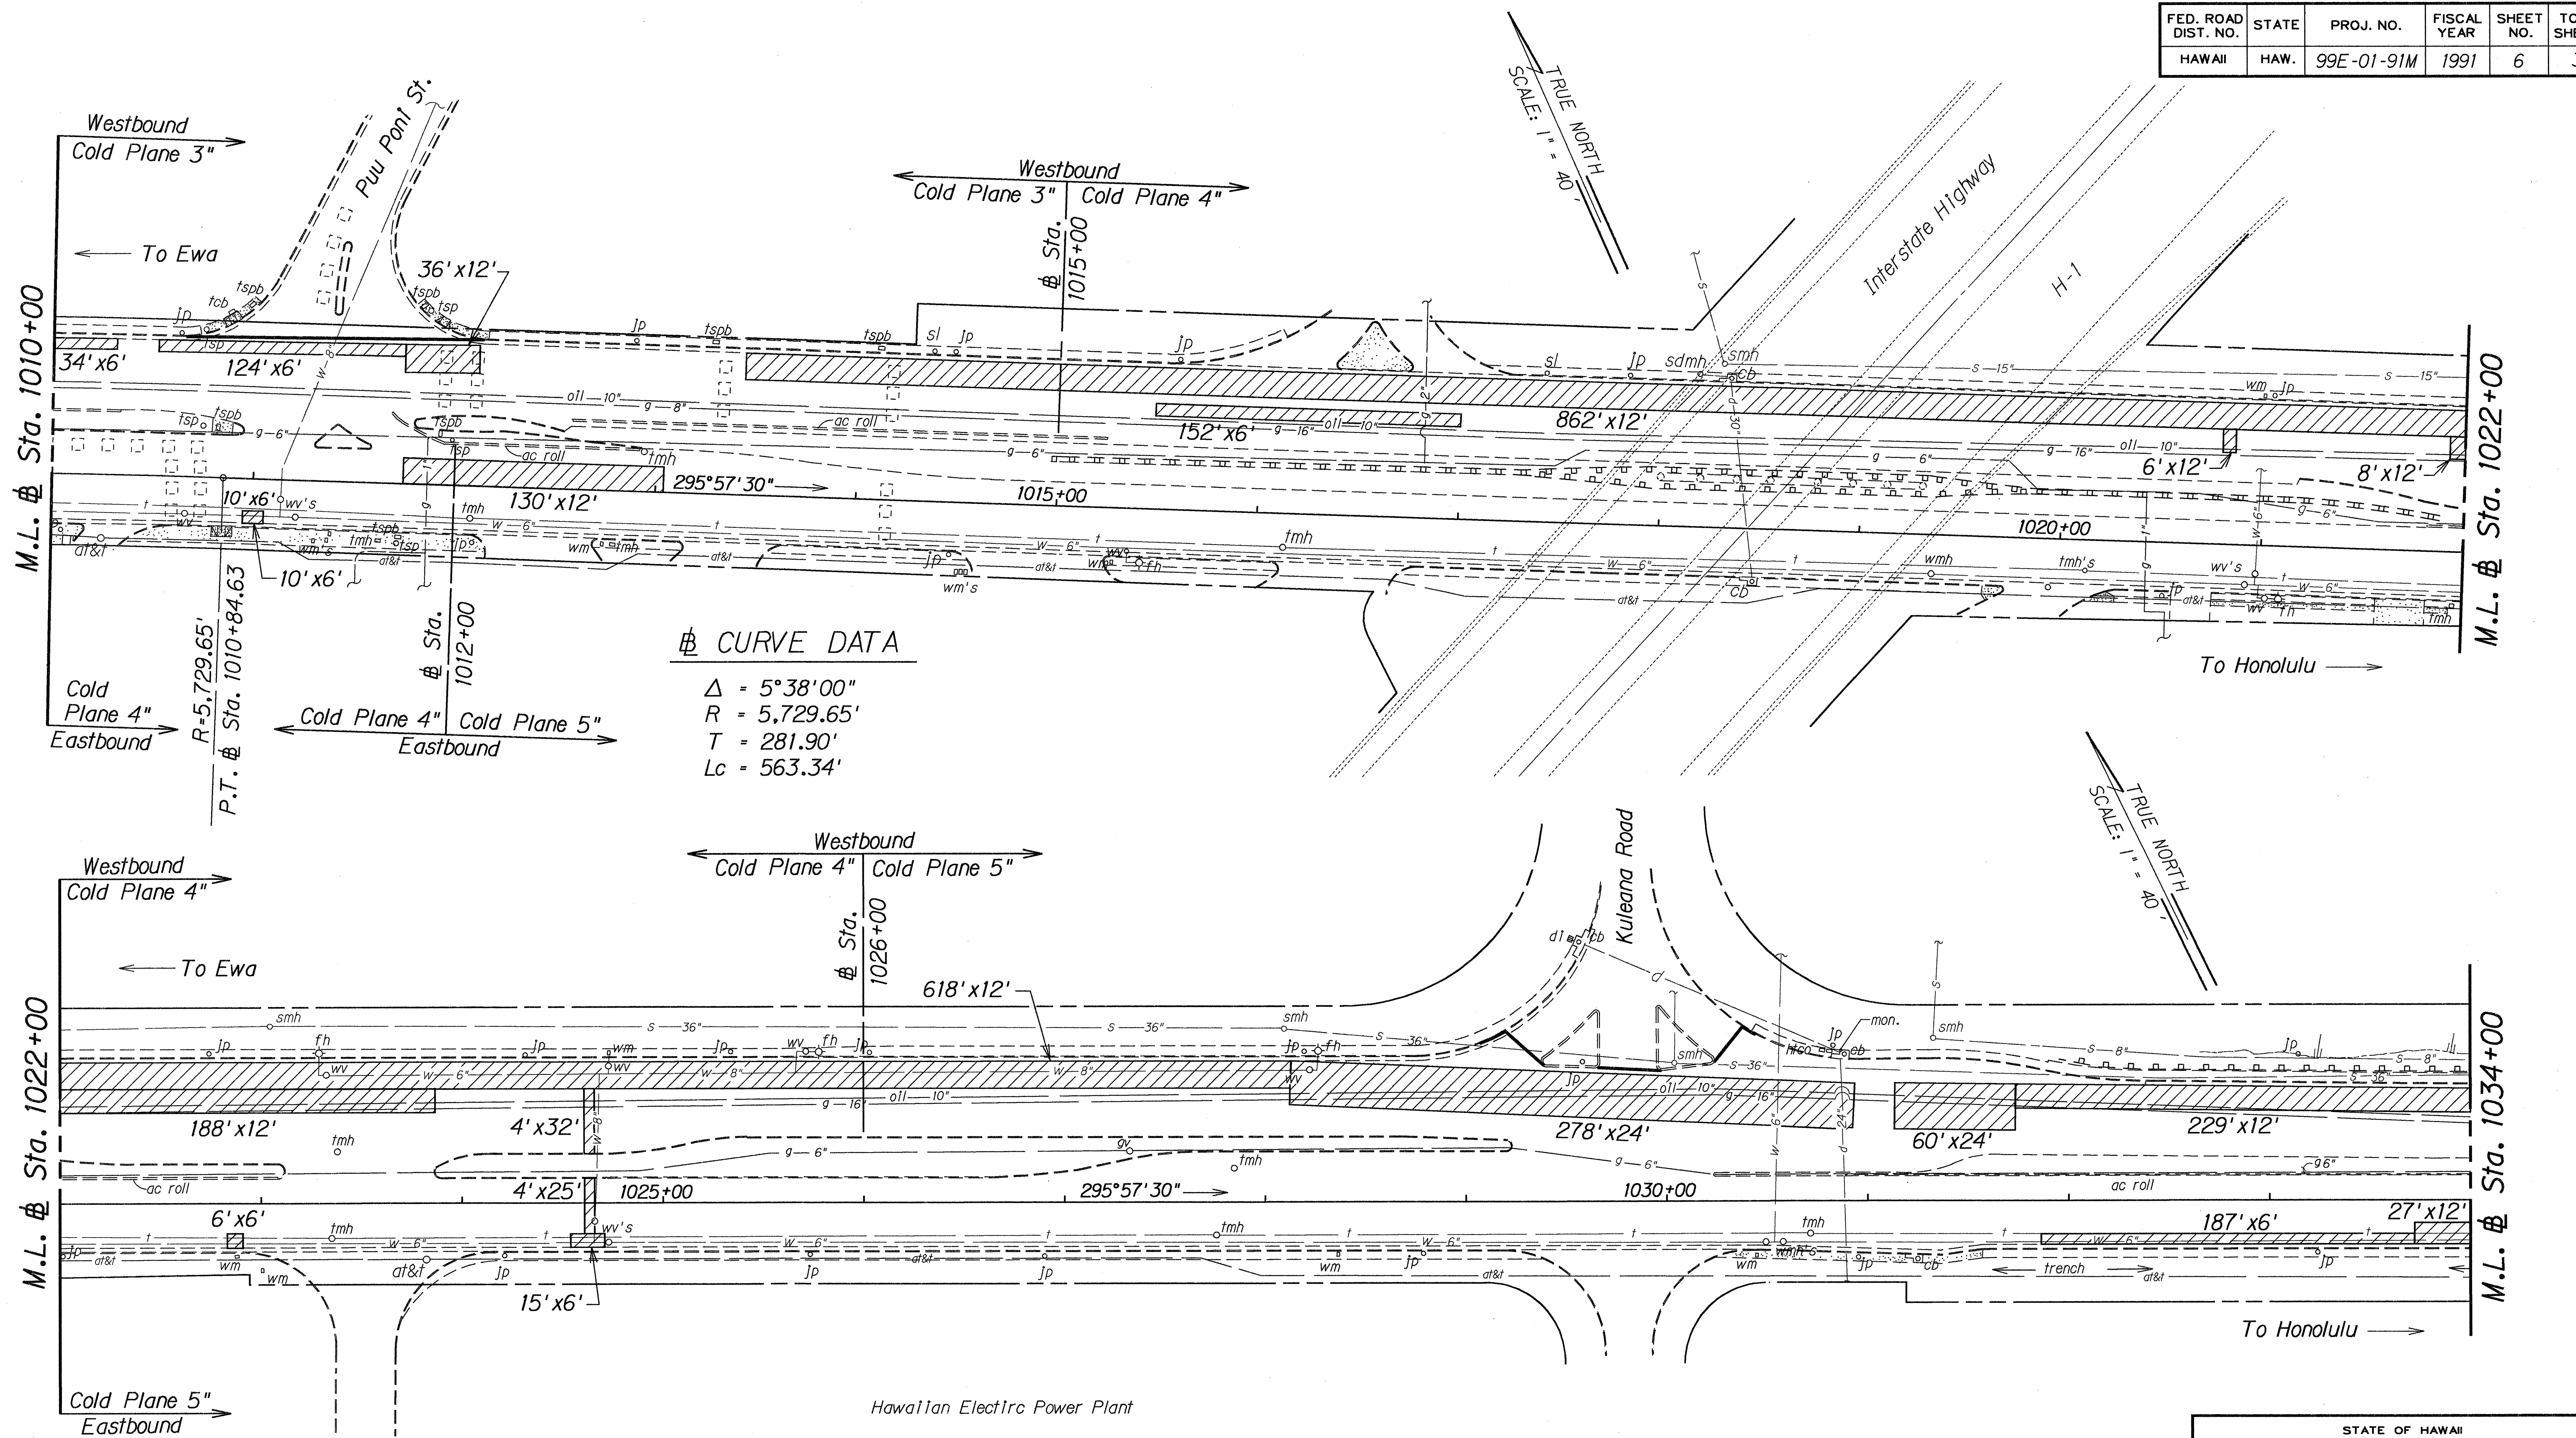

DATE	DESIGNED BY	CHECKED BY
PLANNED	TRACED BY	QUANTITIES BY
NOTE BOOK	DESIGNED BY	CHECKED BY
PLANNED	TRACED BY	QUANTITIES BY

STATE OF HAWAII
DEPARTMENT OF TRANSPORTATION
HIGHWAYS DIVISION


ROADWAY PLANS

KAMEHAMEHA HIGHWAY RESURFACING
Lehua Avenue to
Vicinity of Hanomani Street
Project No. 99E-01-91M

Scale: 1" = 40' Date: May, 1991

SHEET No. 2 OF 7 SHEETS

FED. ROAD DIST. NO.	STATE	PROJ. NO.	FISCAL YEAR	SHEET NO.	TOTAL SHEETS
HAWAII	HAW.	99E-01-91M	1991	7	33

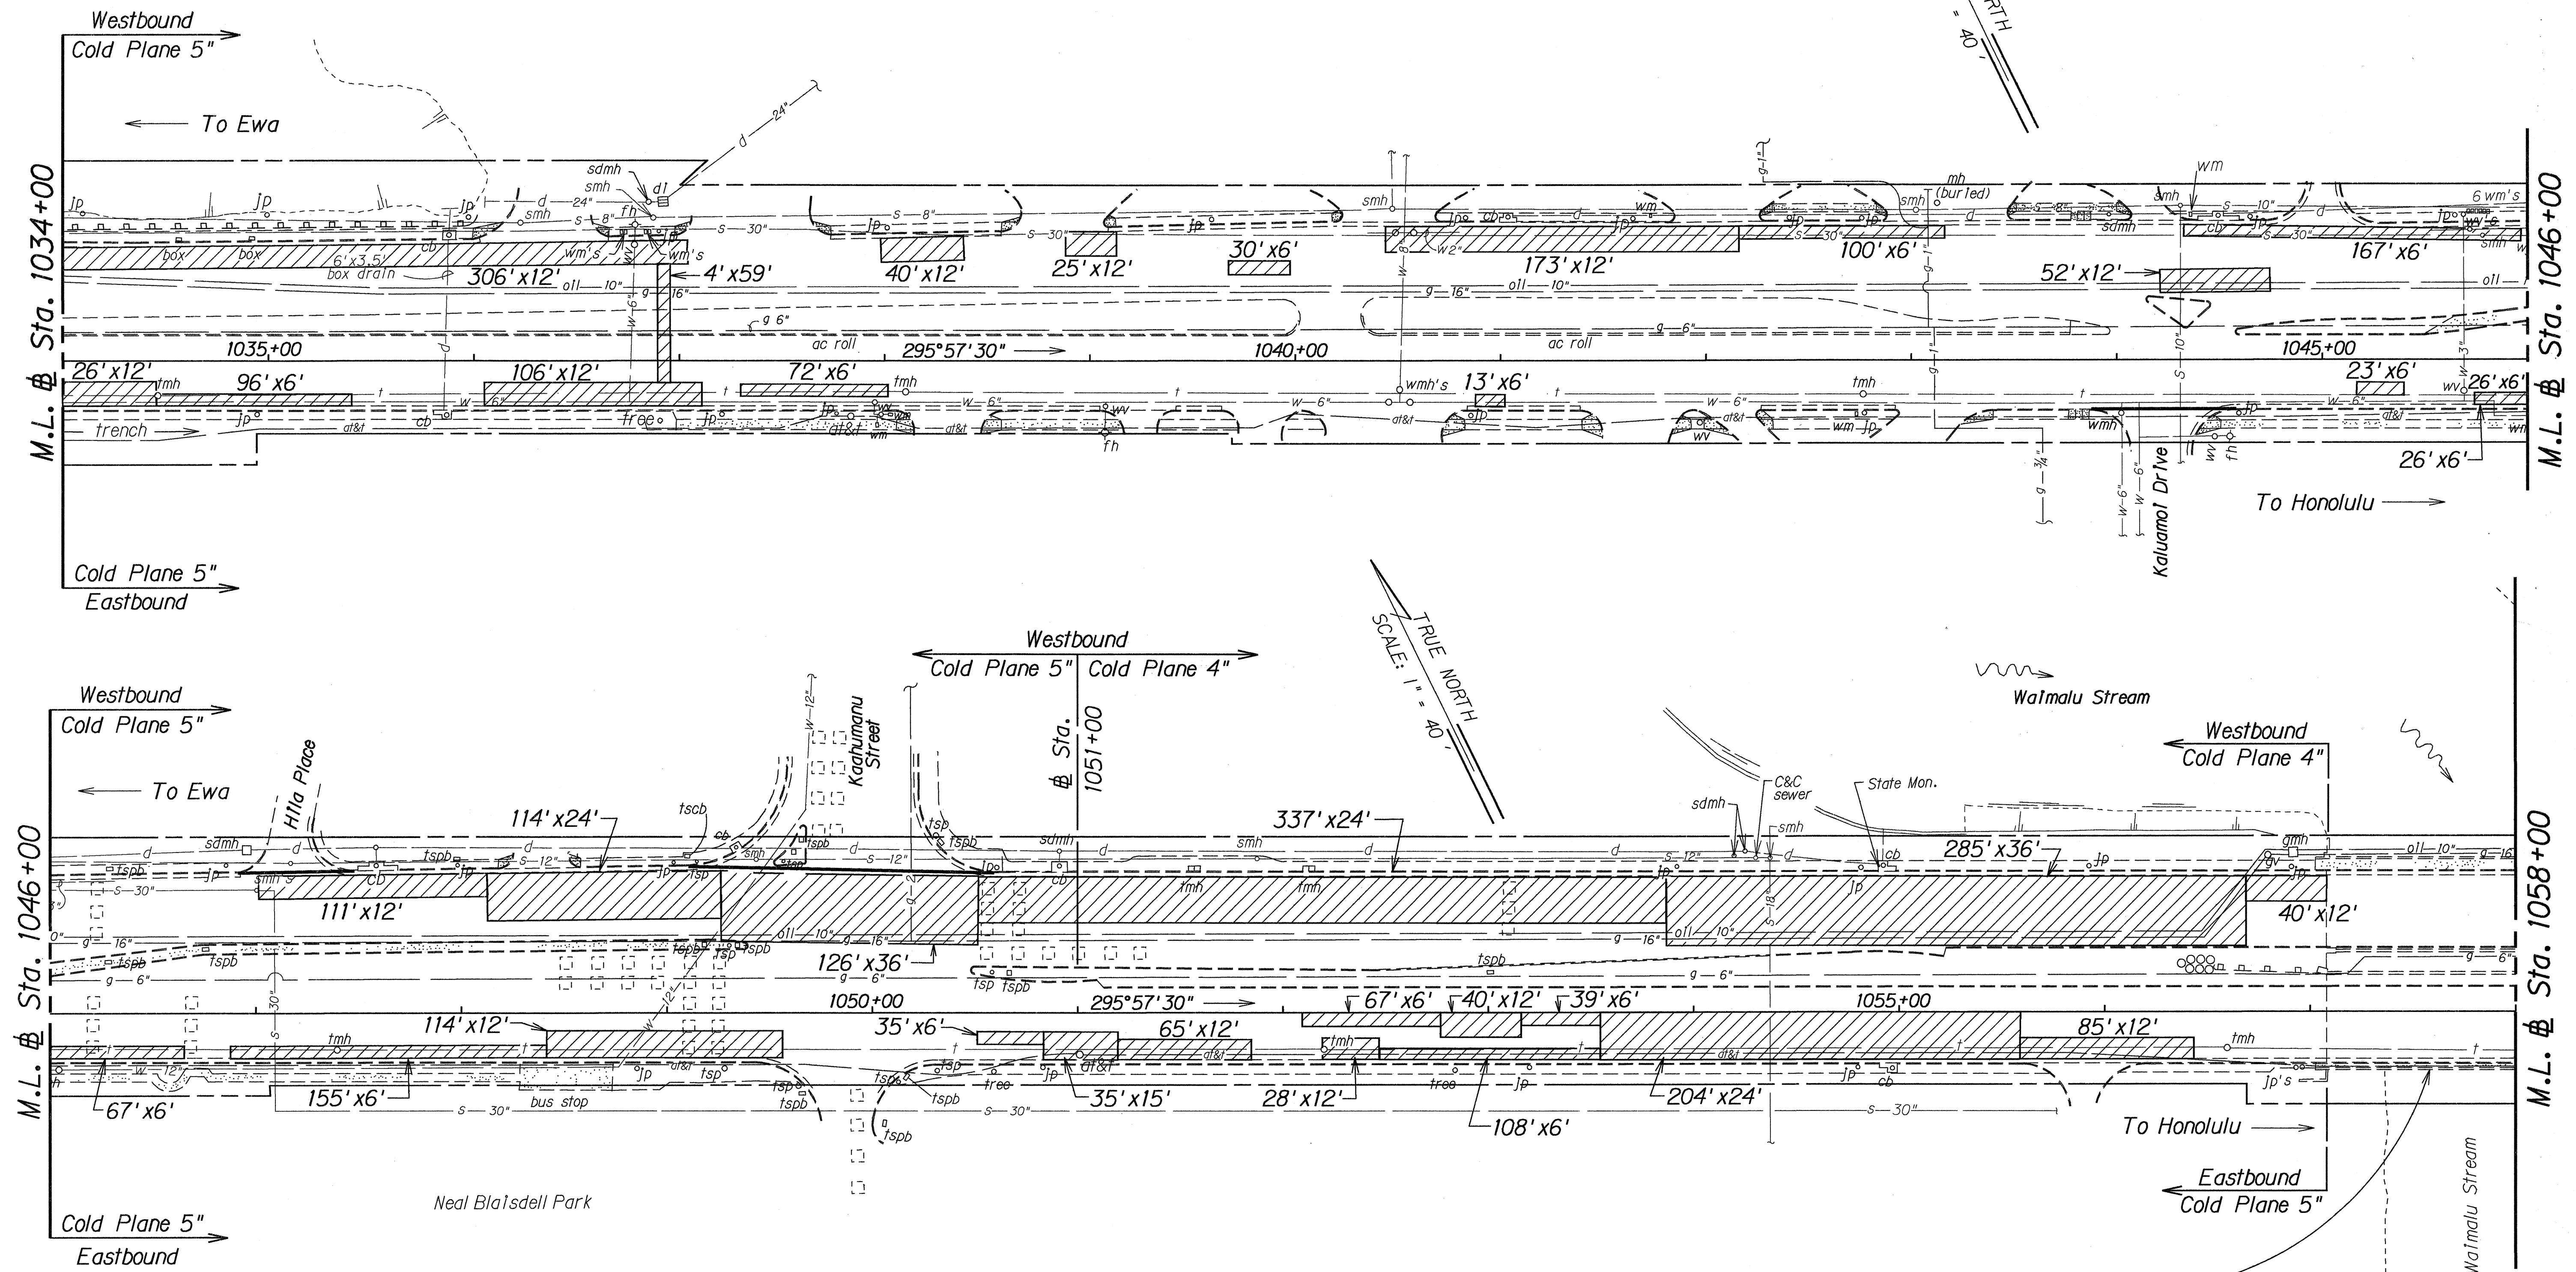

STATE OF HAWAII
DEPARTMENT OF TRANSPORTATION
HIGHWAYS DIVISION

ROADWAY PLANS

KAMEHAMEHA HIGHWAY RESURFACING

Lehua Avenue to
Vicinity of Honomanu Street


Project No. 99E-01-91M

Scale: 1" = 40' Date: May, 1991

SHEET No. 3 OF 7 SHEETS

DESIGNED BY	TRACED BY	DESIGNED BY	TRACED BY
NOTE BOOK	QUANTITIES BY	NOTE BOOK	QUANTITIES BY
CHECKED BY		CHECKED BY	

FED. ROAD DIST. NO.	STATE	PROJ. NO.	FISCAL YEAR	SHEET NO.	TOTAL SHEETS
HAWAII	HAW.	99E-01-91M	1991	8	33

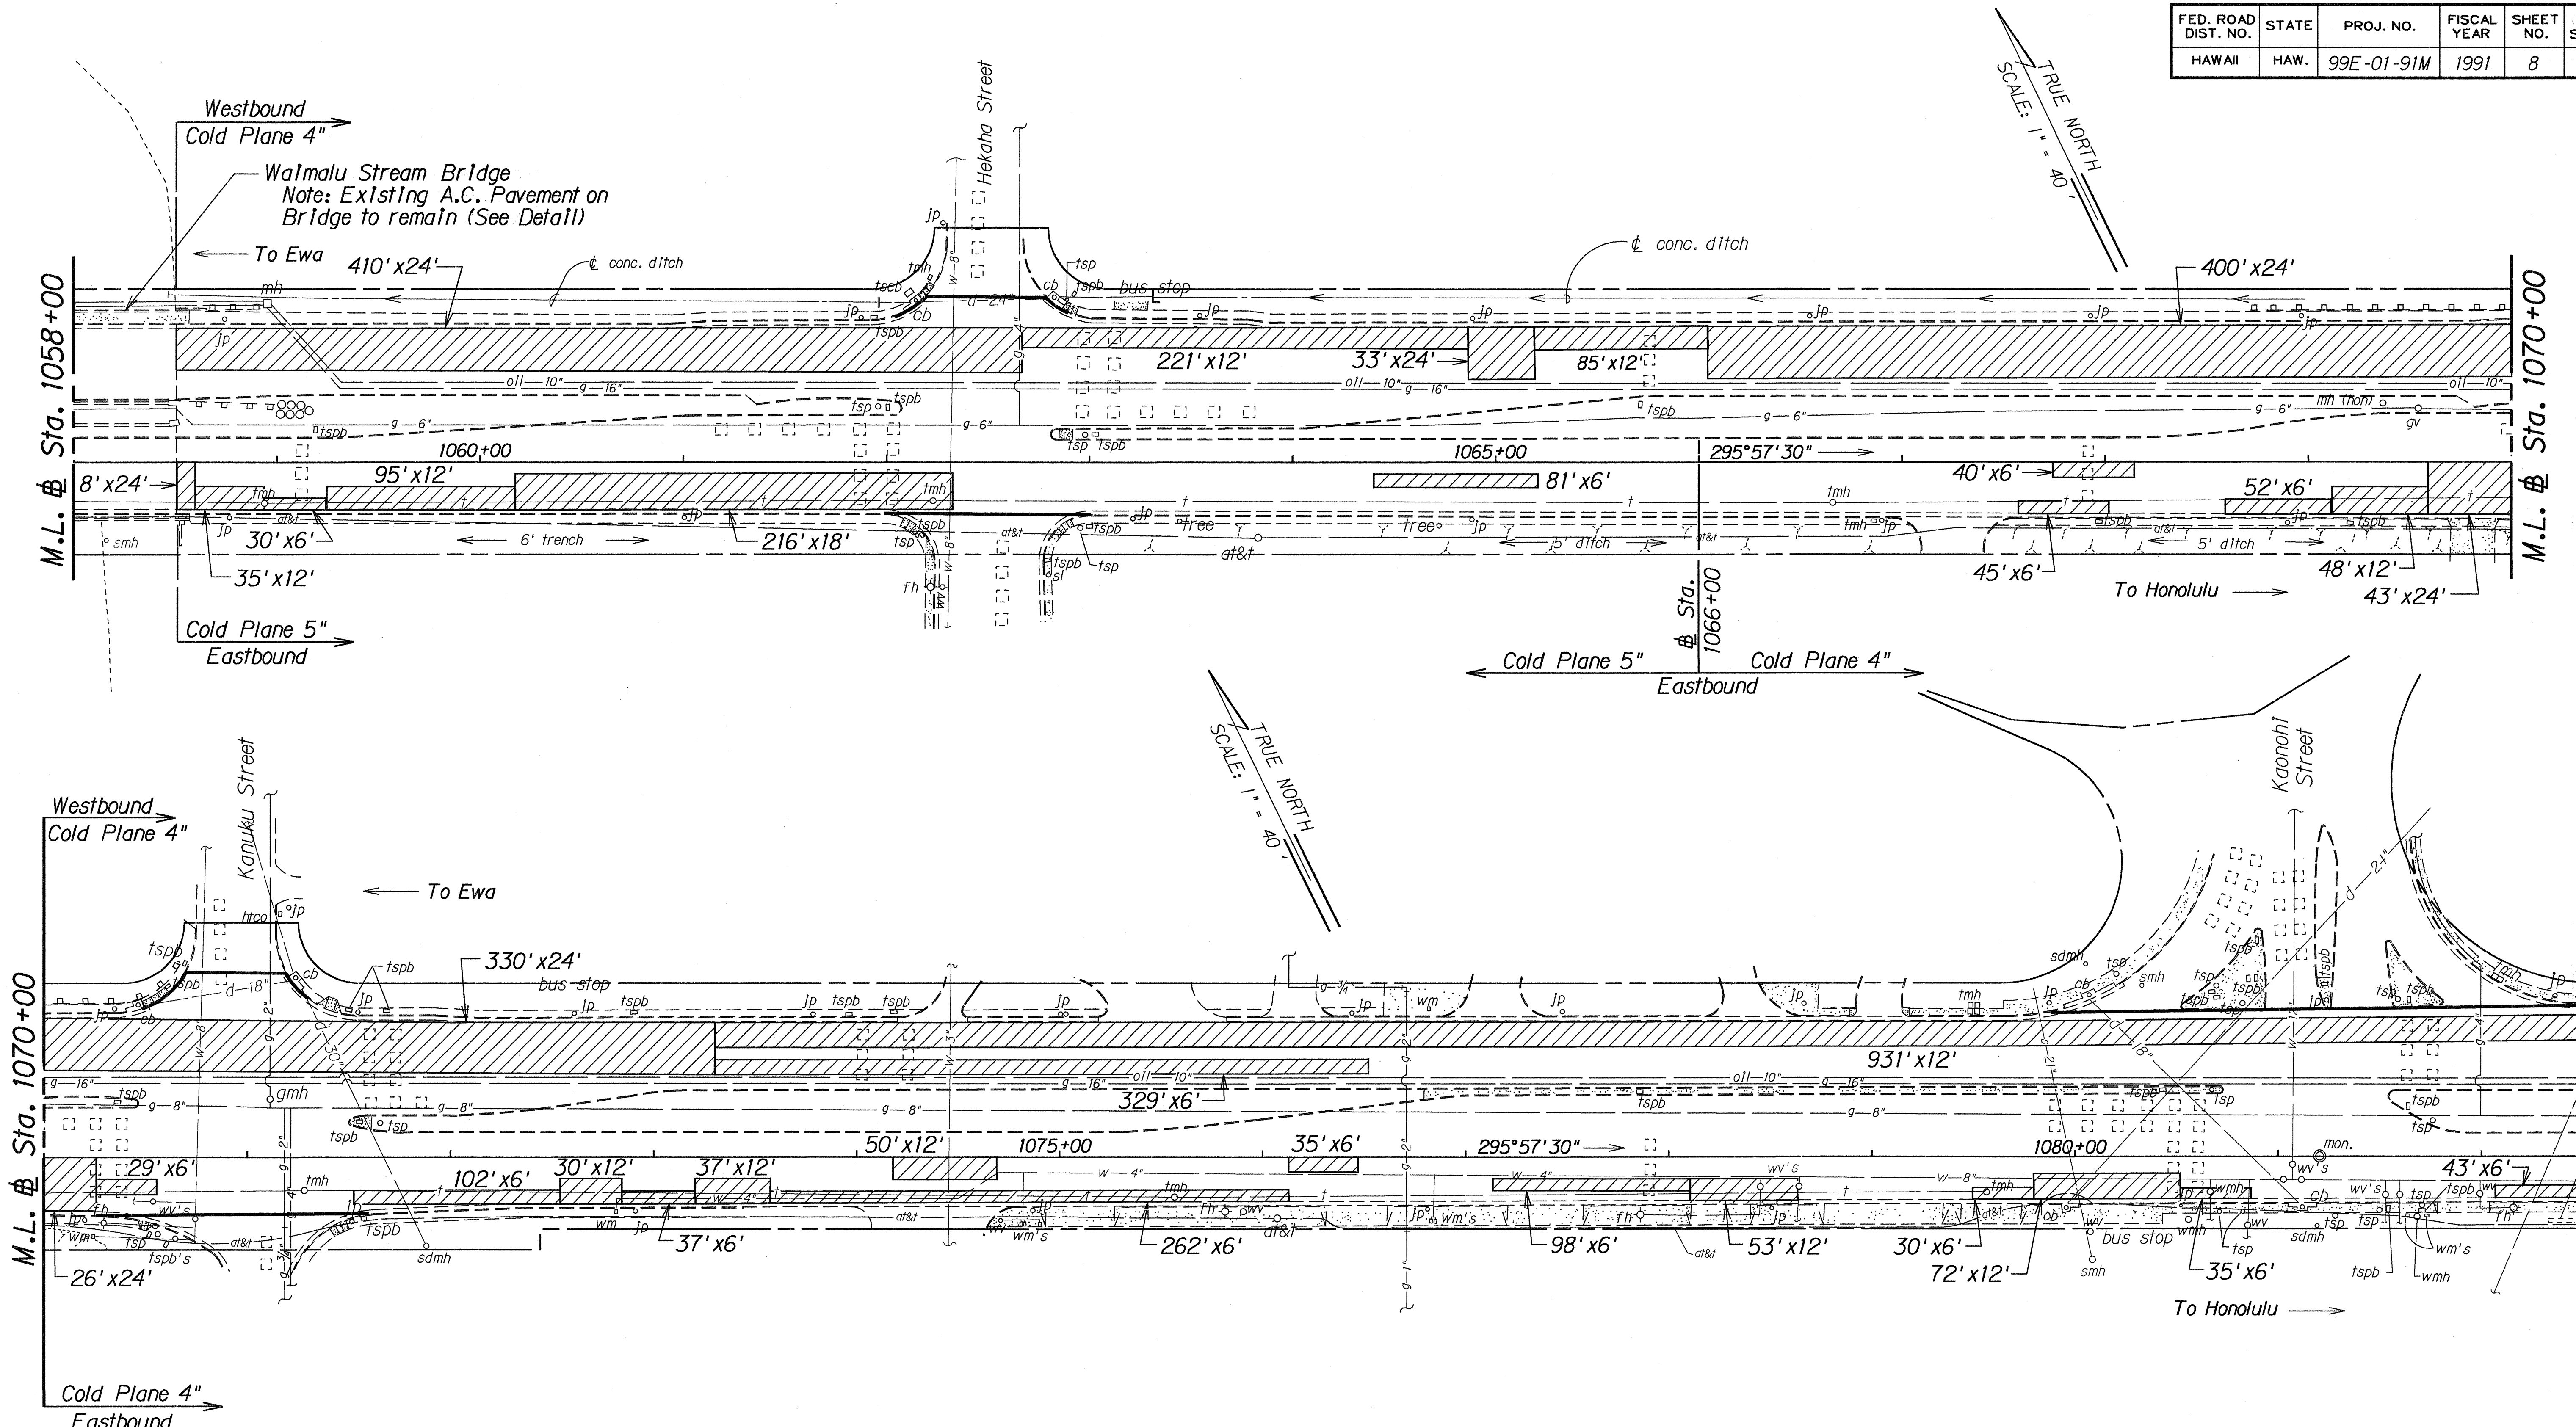

STATE OF HAWAII
DEPARTMENT OF TRANSPORTATION
HIGHWAYS DIVISION

ROADWAY PLANS


KAMEHAMEHA HIGHWAY RESURFACING
Lehua Avenue to
Vicinity of Honomanu Street
Project No. 99E-01-91M

Scale: 1" = 40' Date: May, 1991

SHEET No. 4 OF 7 SHEETS

DESIGNED BY	NOTED BY
DRAWN BY	CHECKED BY
TRACED BY	QUANTITIES BY
DATE	

FED. ROAD DIST. NO.	STATE	PROJ. NO.	FISCAL YEAR	SHEET NO.	TOTAL SHEETS
HAWAII	HAW.	99E-01-91M	1991	9	33

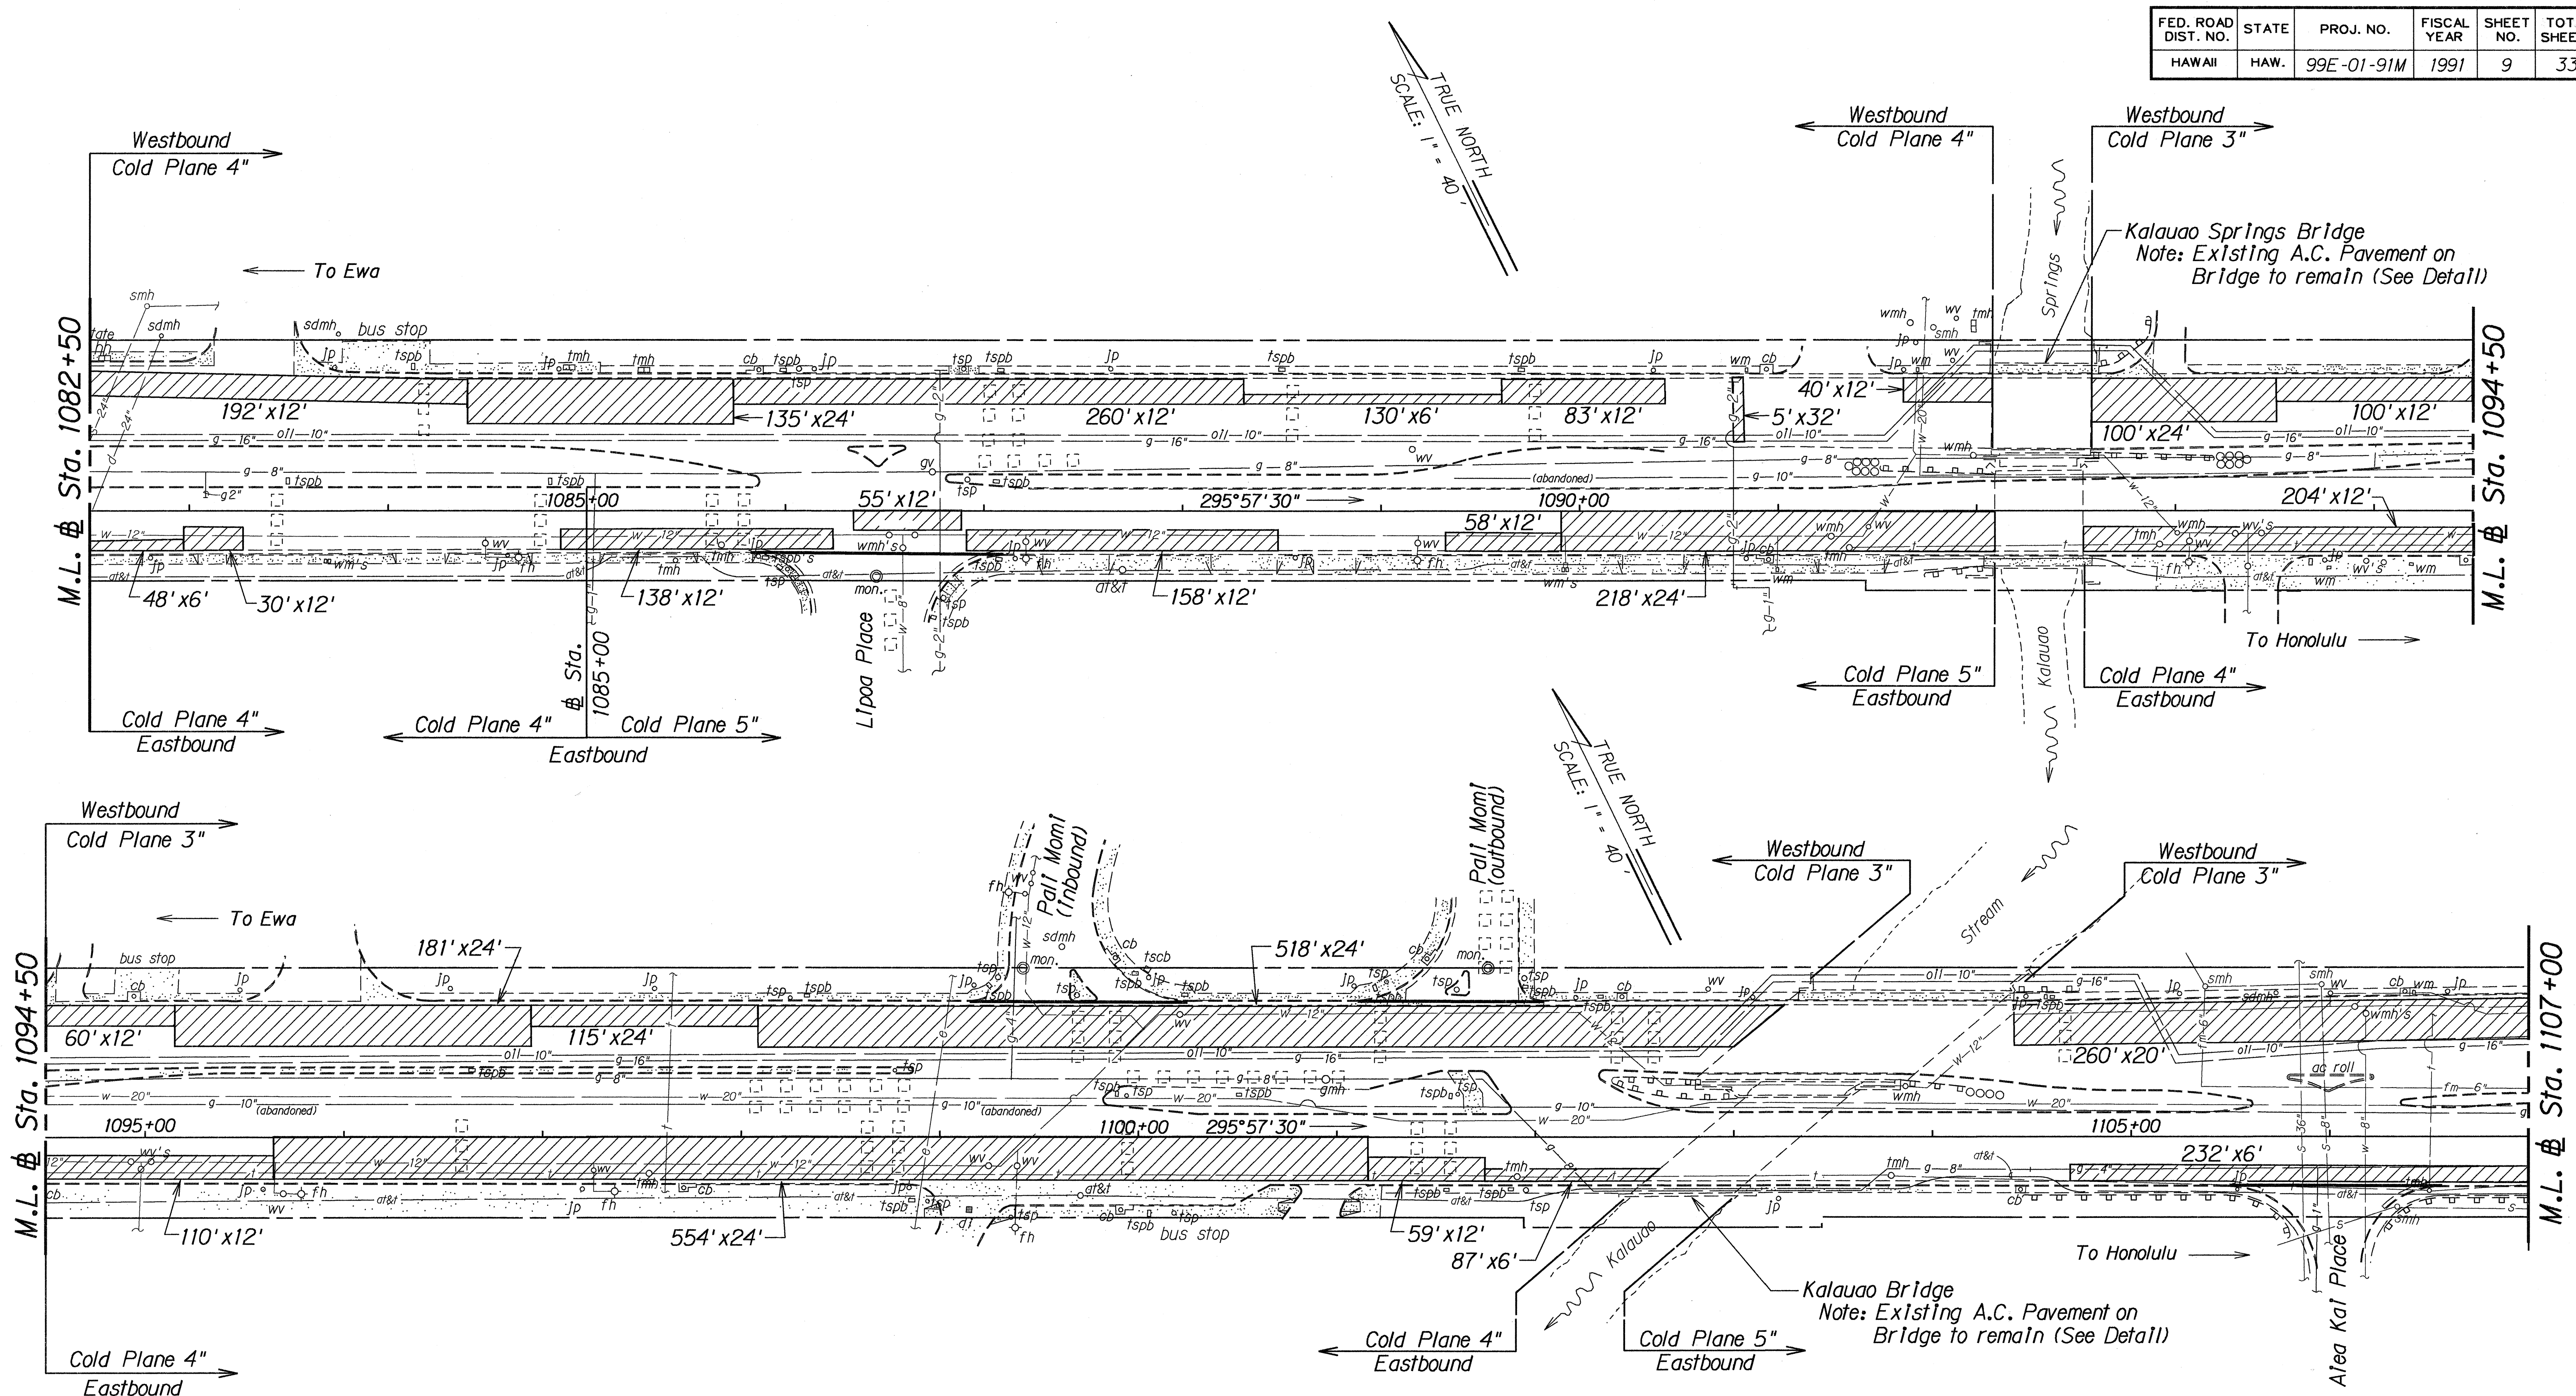

DESIGNED BY	TRACED BY	NOTED BY	CHECKED BY

STATE OF HAWAII
DEPARTMENT OF TRANSPORTATION
HIGHWAYS DIVISION

ROADWAY PLANS

KAMEHAMEHA HIGHWAY RESURFACING



Lehua Avenue to
Vicinity of Honomanu Street

Project No. 99E-01-91M

Scale: 1" = 40' Date: May, 1991

SHEET No. 5 OF 7 SHEETS

FED. ROAD DIST. NO.	STATE	PROJ. NO.	FISCAL YEAR	SHEET NO.	TOTAL SHEETS
HAWAII	HAW.	99E-01-91M	1991	10	33

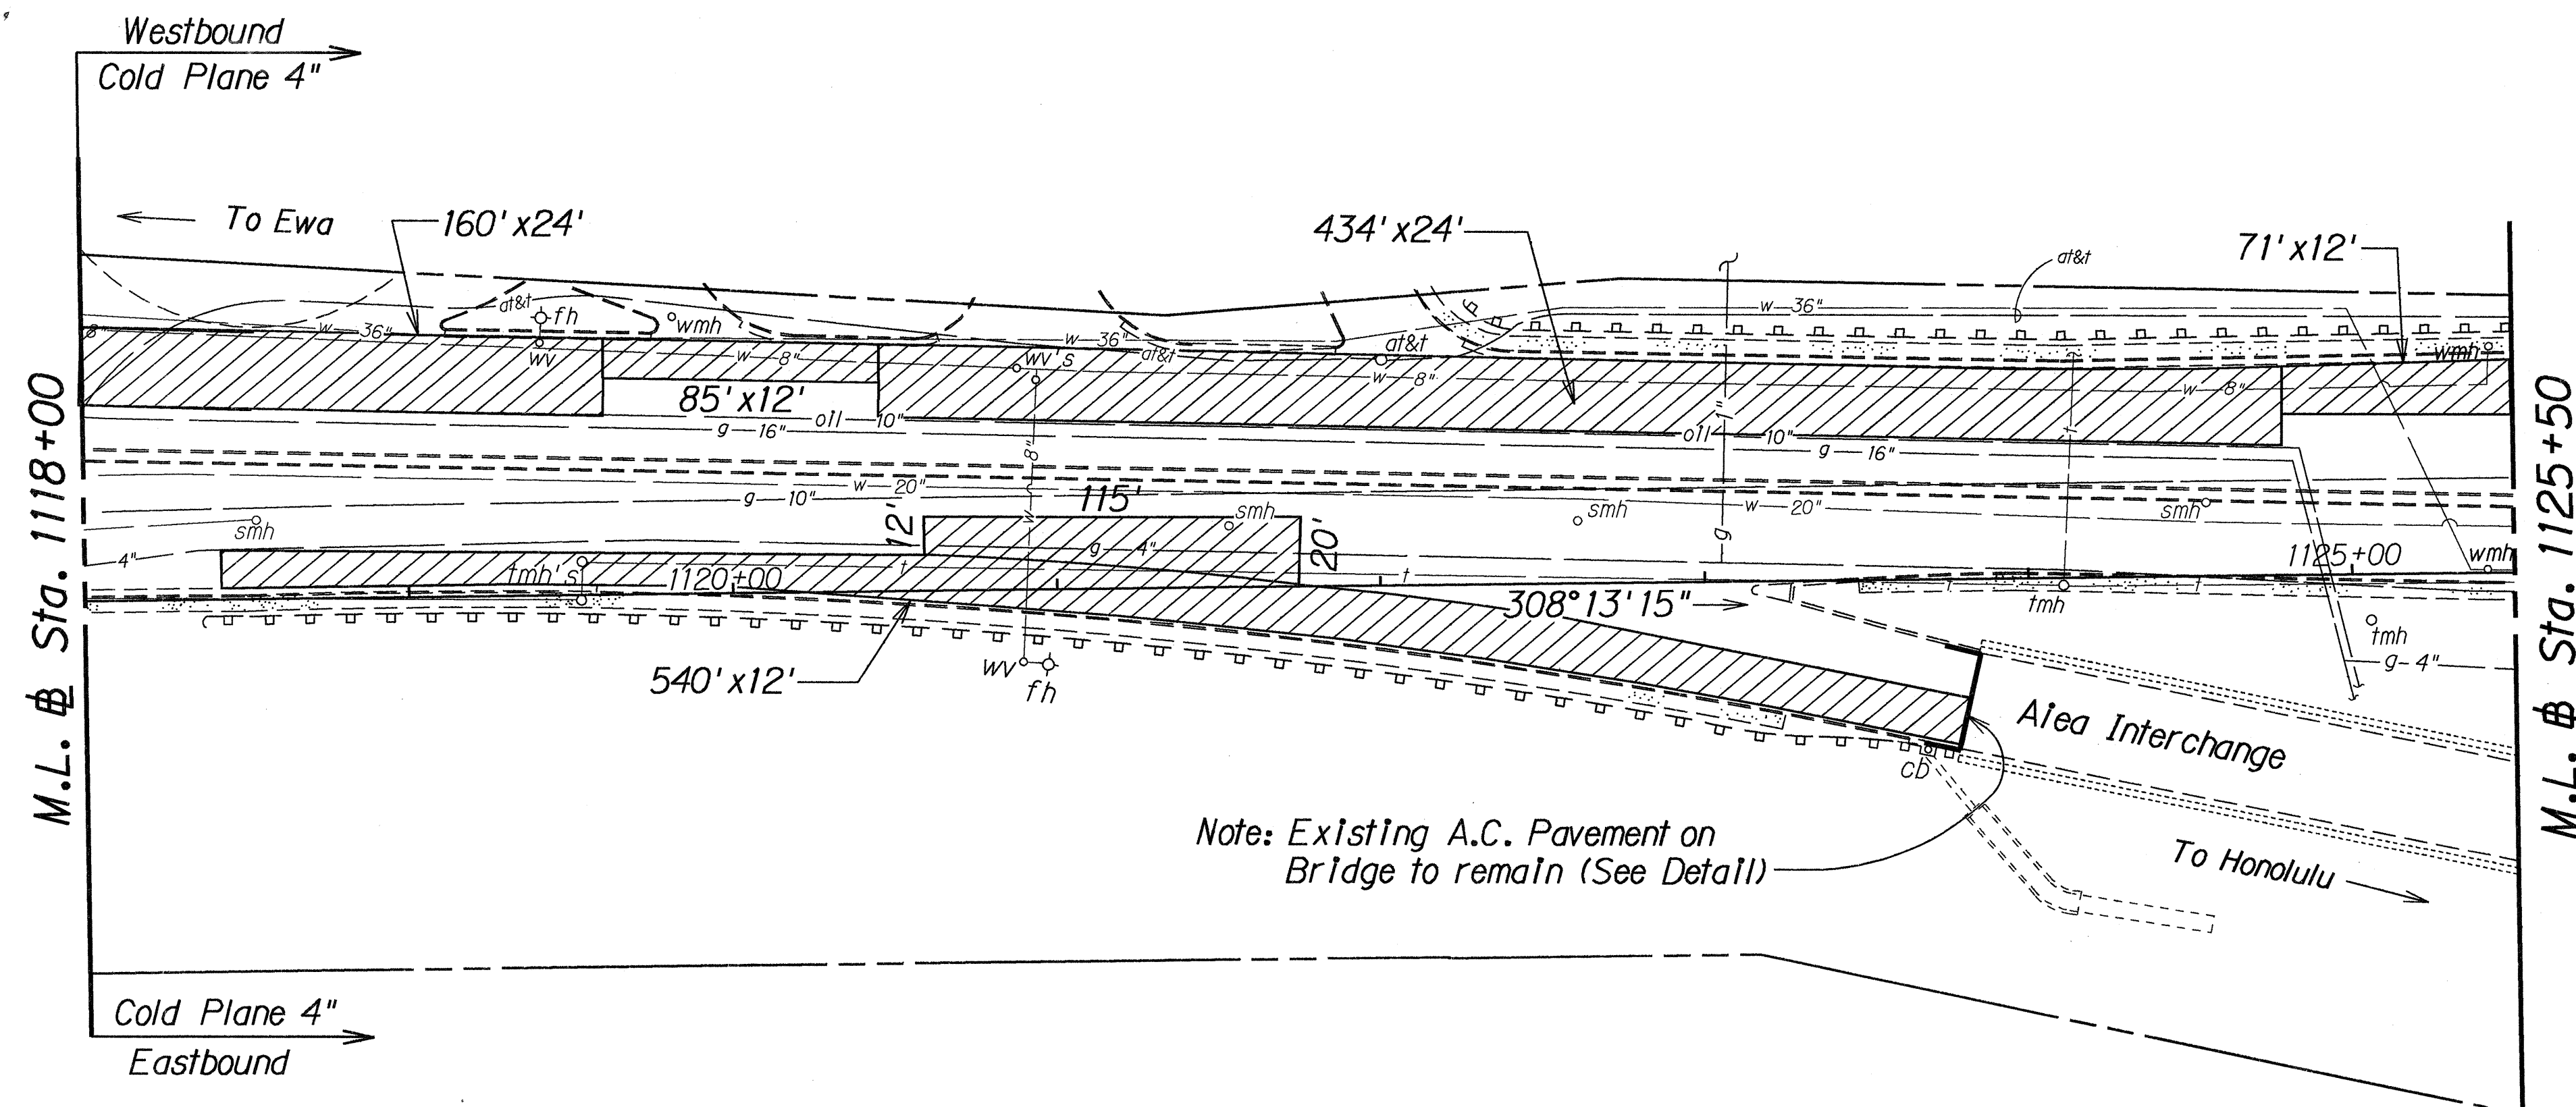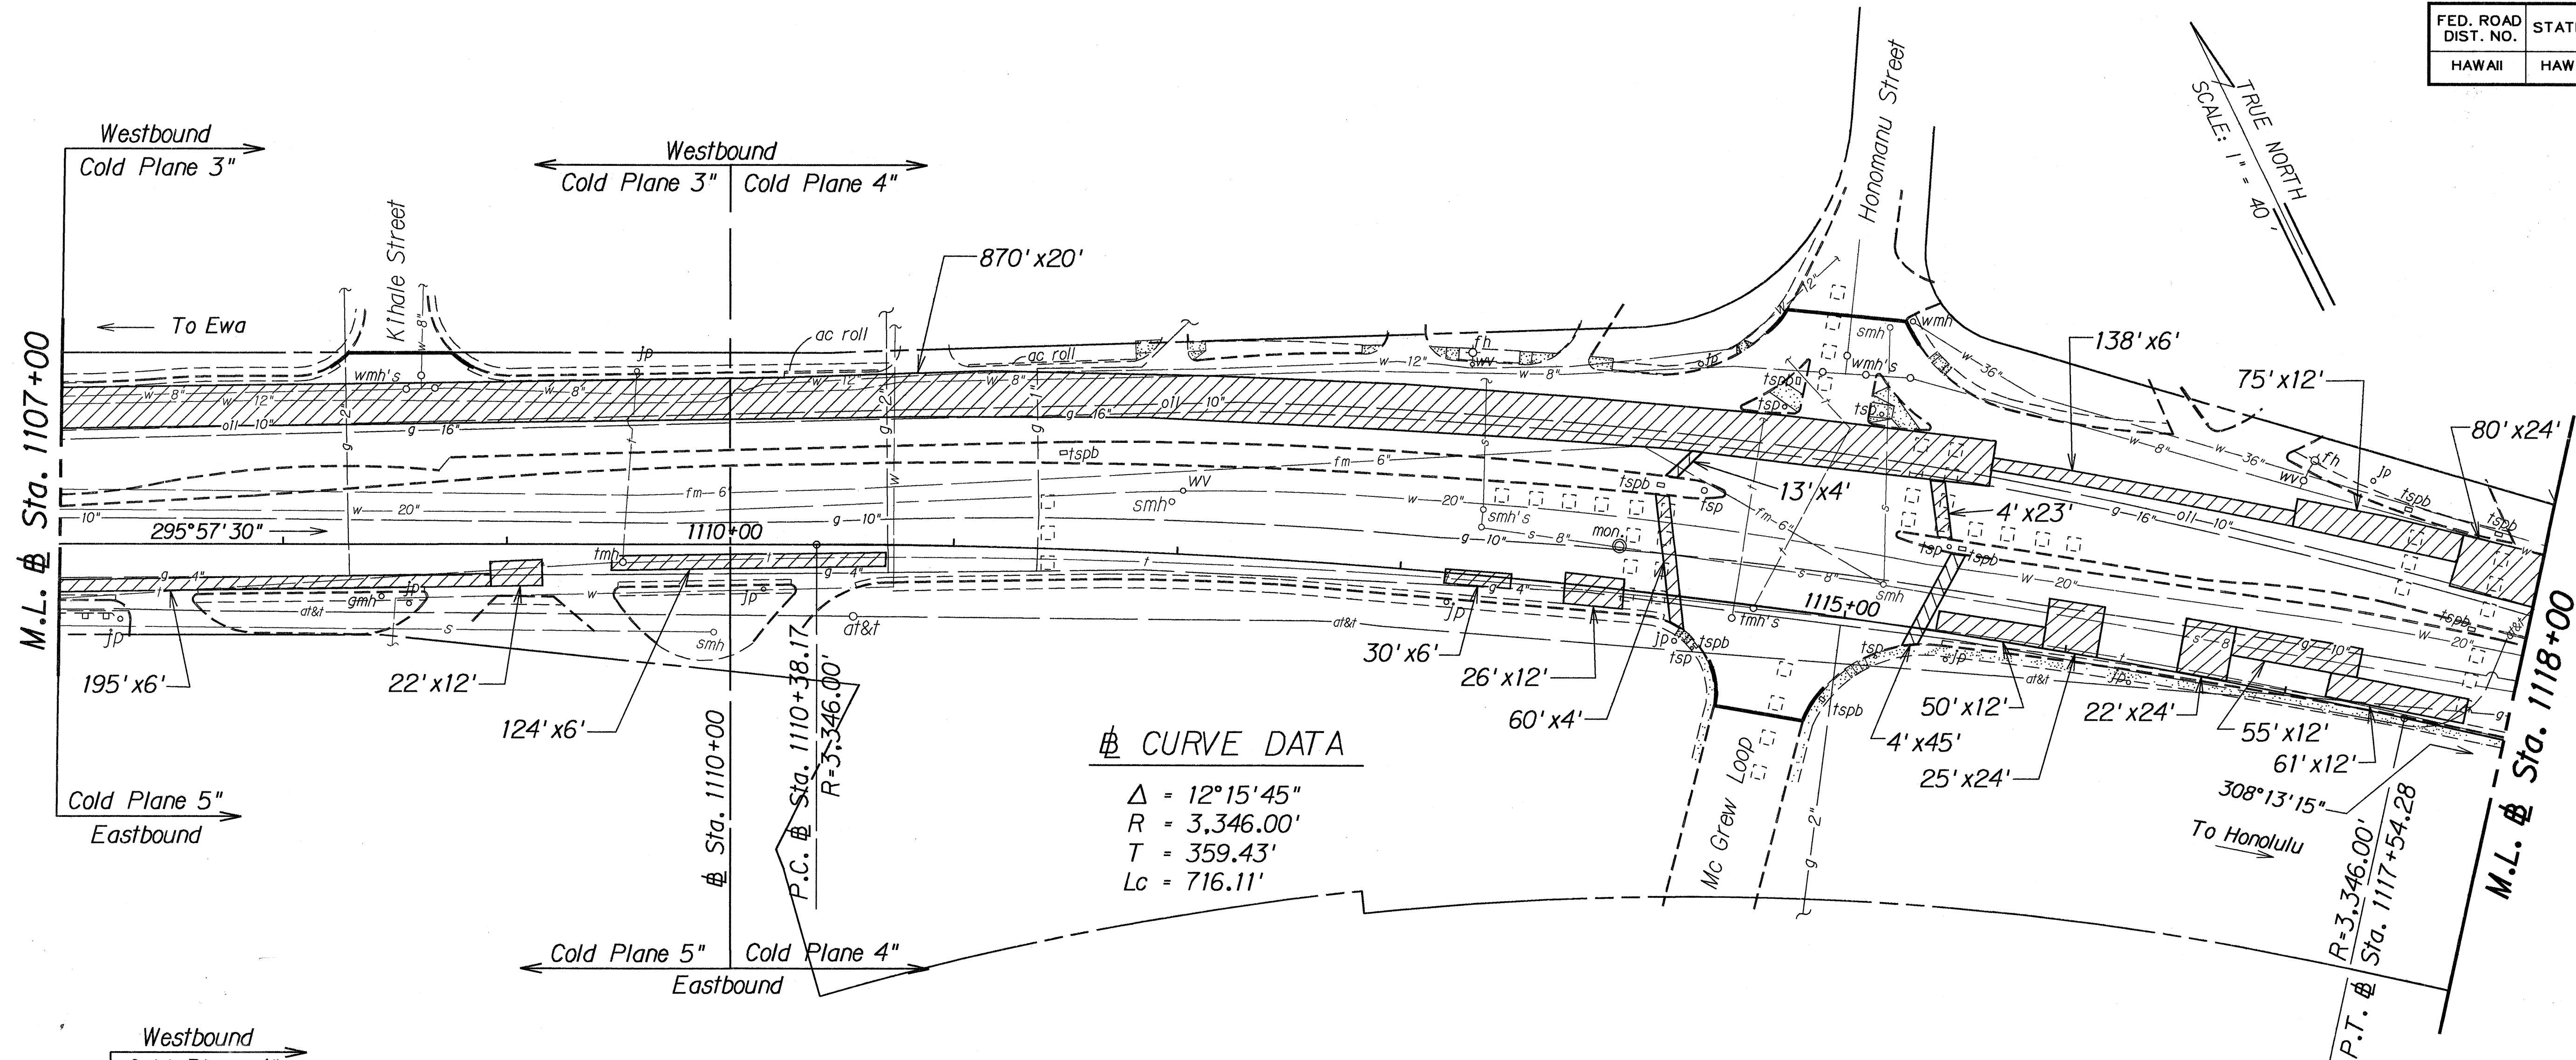

STATE OF HAWAII
DEPARTMENT OF TRANSPORTATION
HIGHWAYS DIVISION


ROADWAY PLANS

KAMEHAMEHA HIGHWAY RESURFACING
Lehua Avenue to
Vicinity of Honomanu Street
Project No. 99E-01-91M

Scale: 1" = 40' Date: May, 1991

SHEET No. 6 OF 7 SHEETS

FED. ROAD DIST. NO.	STATE	PROJ. NO.	FISCAL YEAR	SHEET NO.	TOTAL SHEETS
HAWAII	HAW.	99E-01-91M	1991	11	33

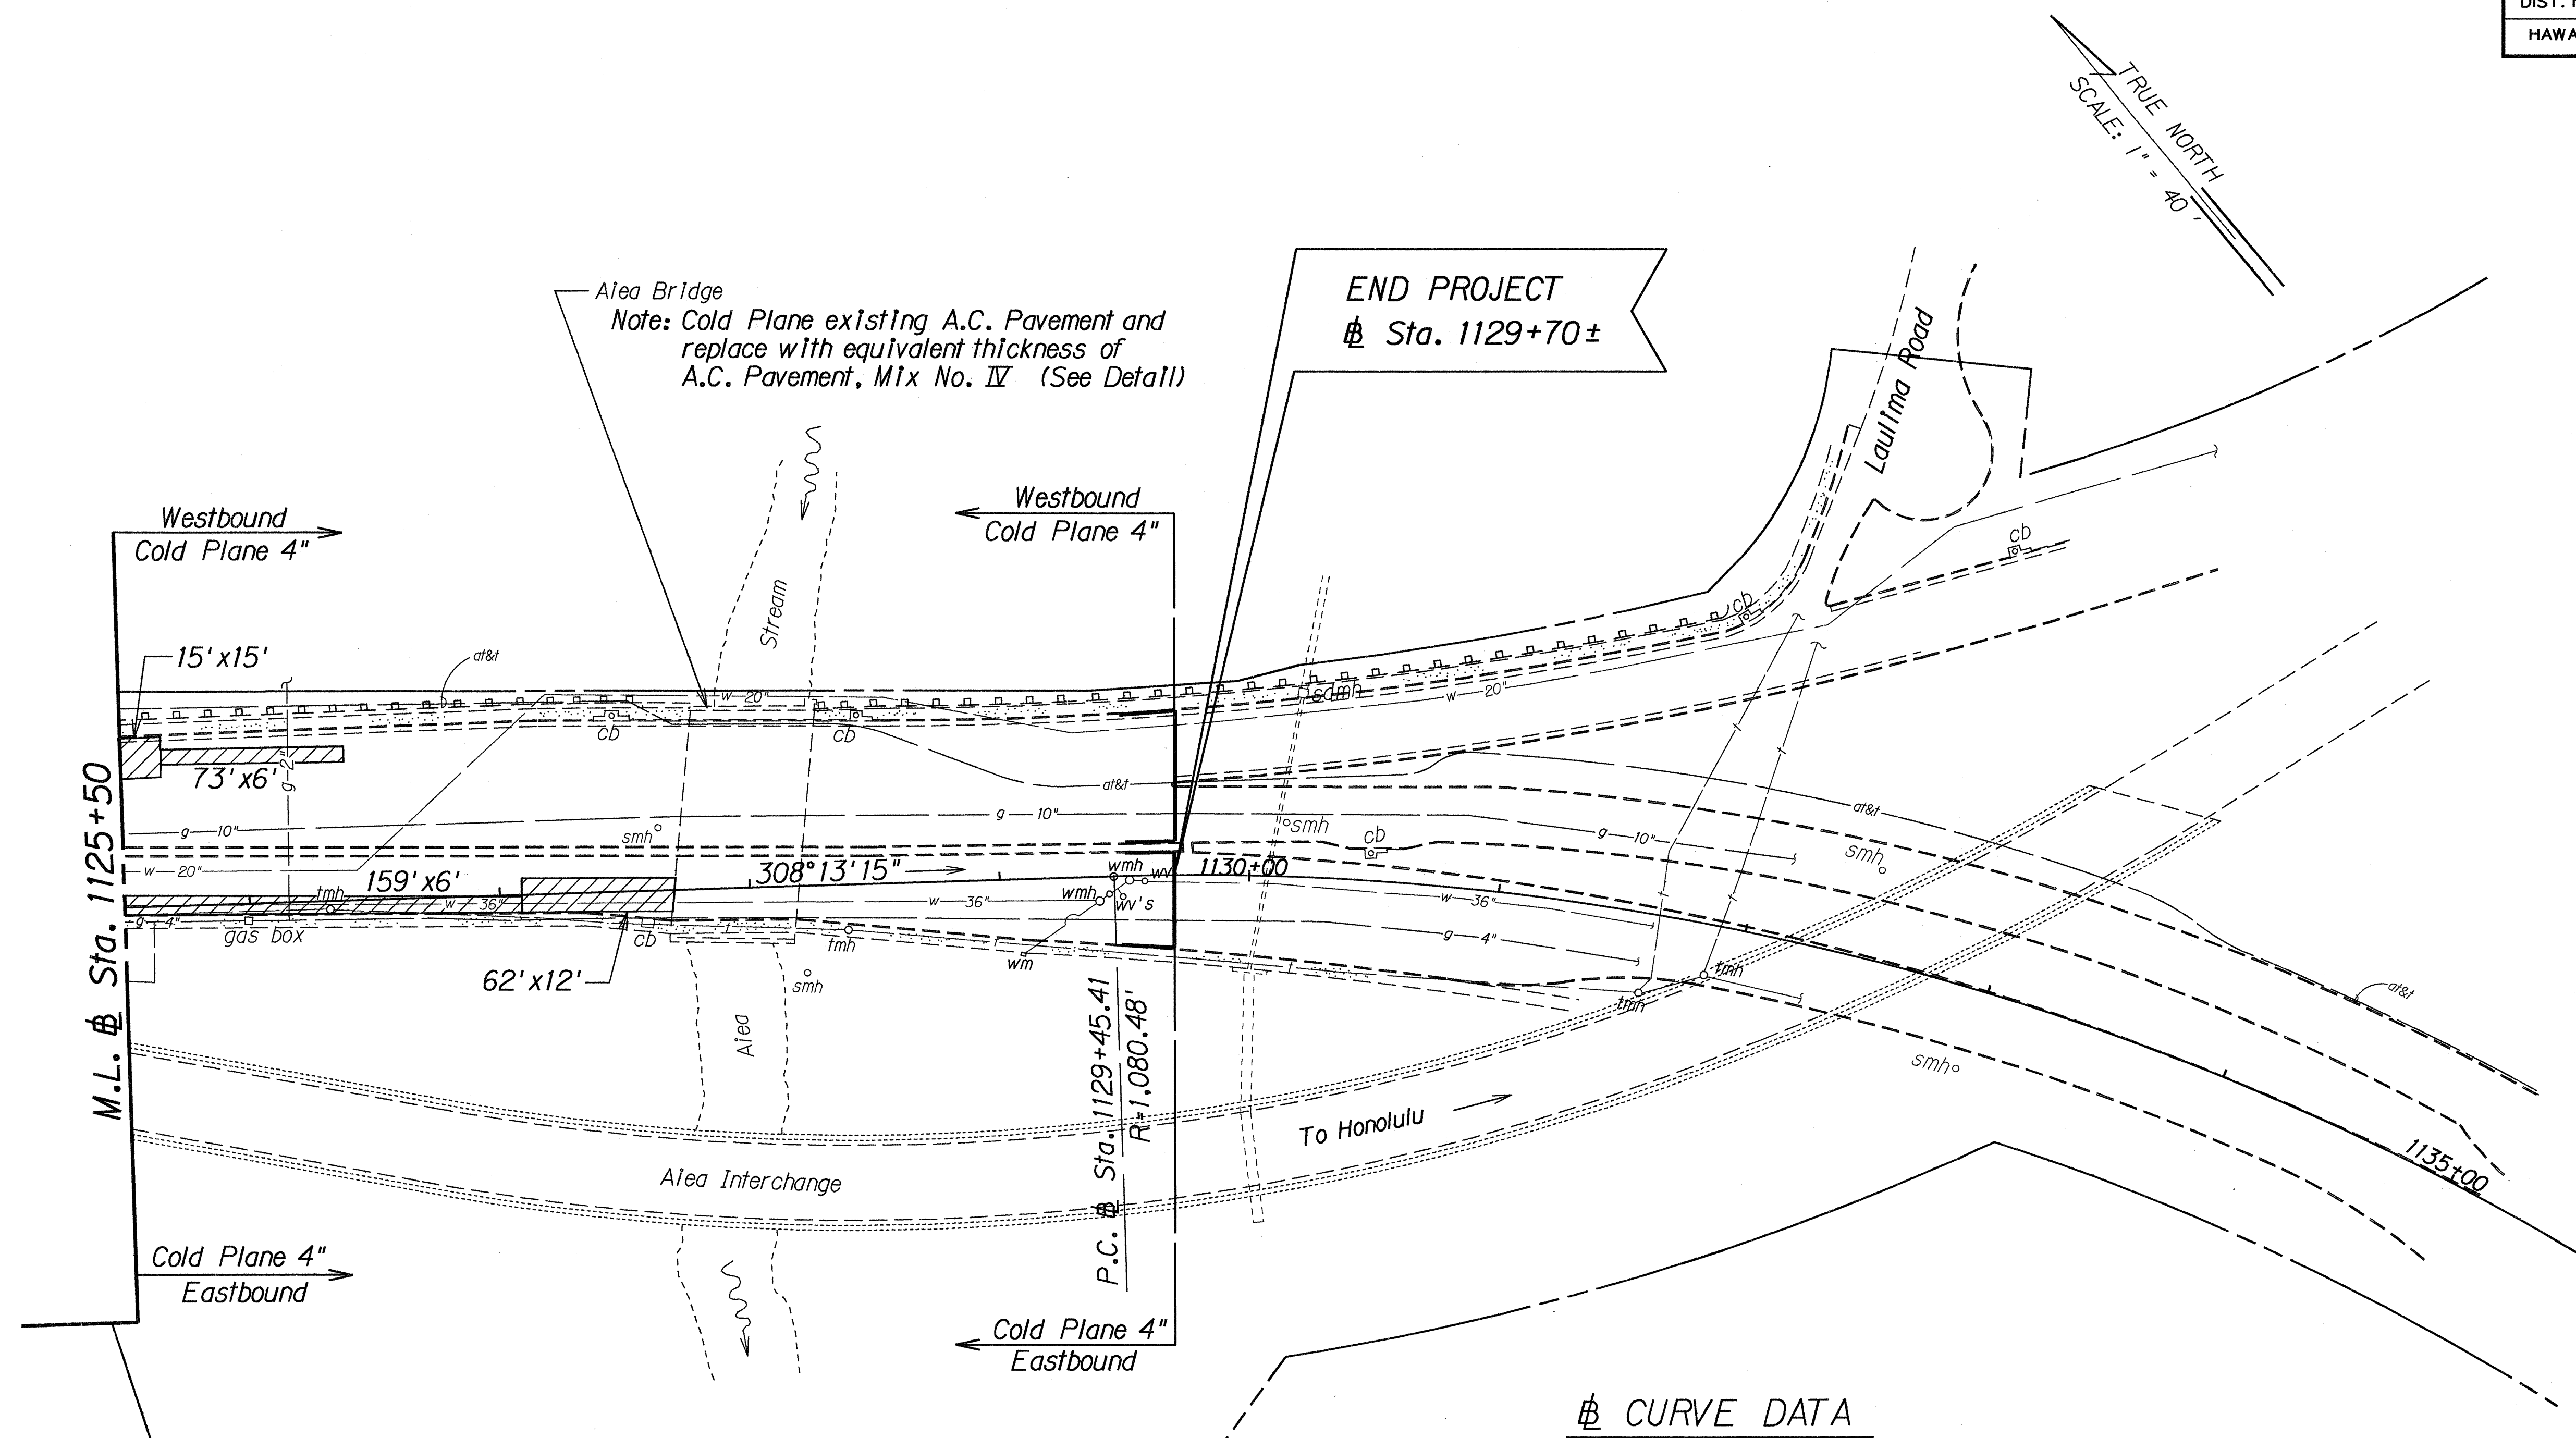

⌘ CURVE DATA

$\Delta = 80^\circ 53' 30''$
 $R = 1,080.48'$
 $T = 921.05'$
 $L_c = 1,525.45'$

DATE	_____
DESIGNED BY	_____
TRACED BY	_____
NOTE BOOK	_____
QUANTITIES BY	_____
CHECKED BY	_____

STATE OF HAWAII
DEPARTMENT OF TRANSPORTATION
HIGHWAYS DIVISION

ROADWAY PLANS

KAMEHAMEHA HIGHWAY RESURFACING
Lehua Avenue to
Vicinity of Honomanu Street
Project No. 99E-01-91M

Scale: 1" = 40' Date: May, 1991

SHEET No. 7 OF 7 SHEETS