

STATE OF HAWAII
DEPARTMENT OF TRANSPORTATION
HIGHWAYS DIVISION


KAMEHAMEHA HIGHWAY WIDENING

PROJ. NO. 99C-01-90

SCALE : AS NOTED DATE : JAN. 1990

SHEET No. 1 OF 1 SHEETS

THIS WORK WAS PREPARED BY
ME OR UNDER MY SUPERVISION
Bernard J. Keane
Signature

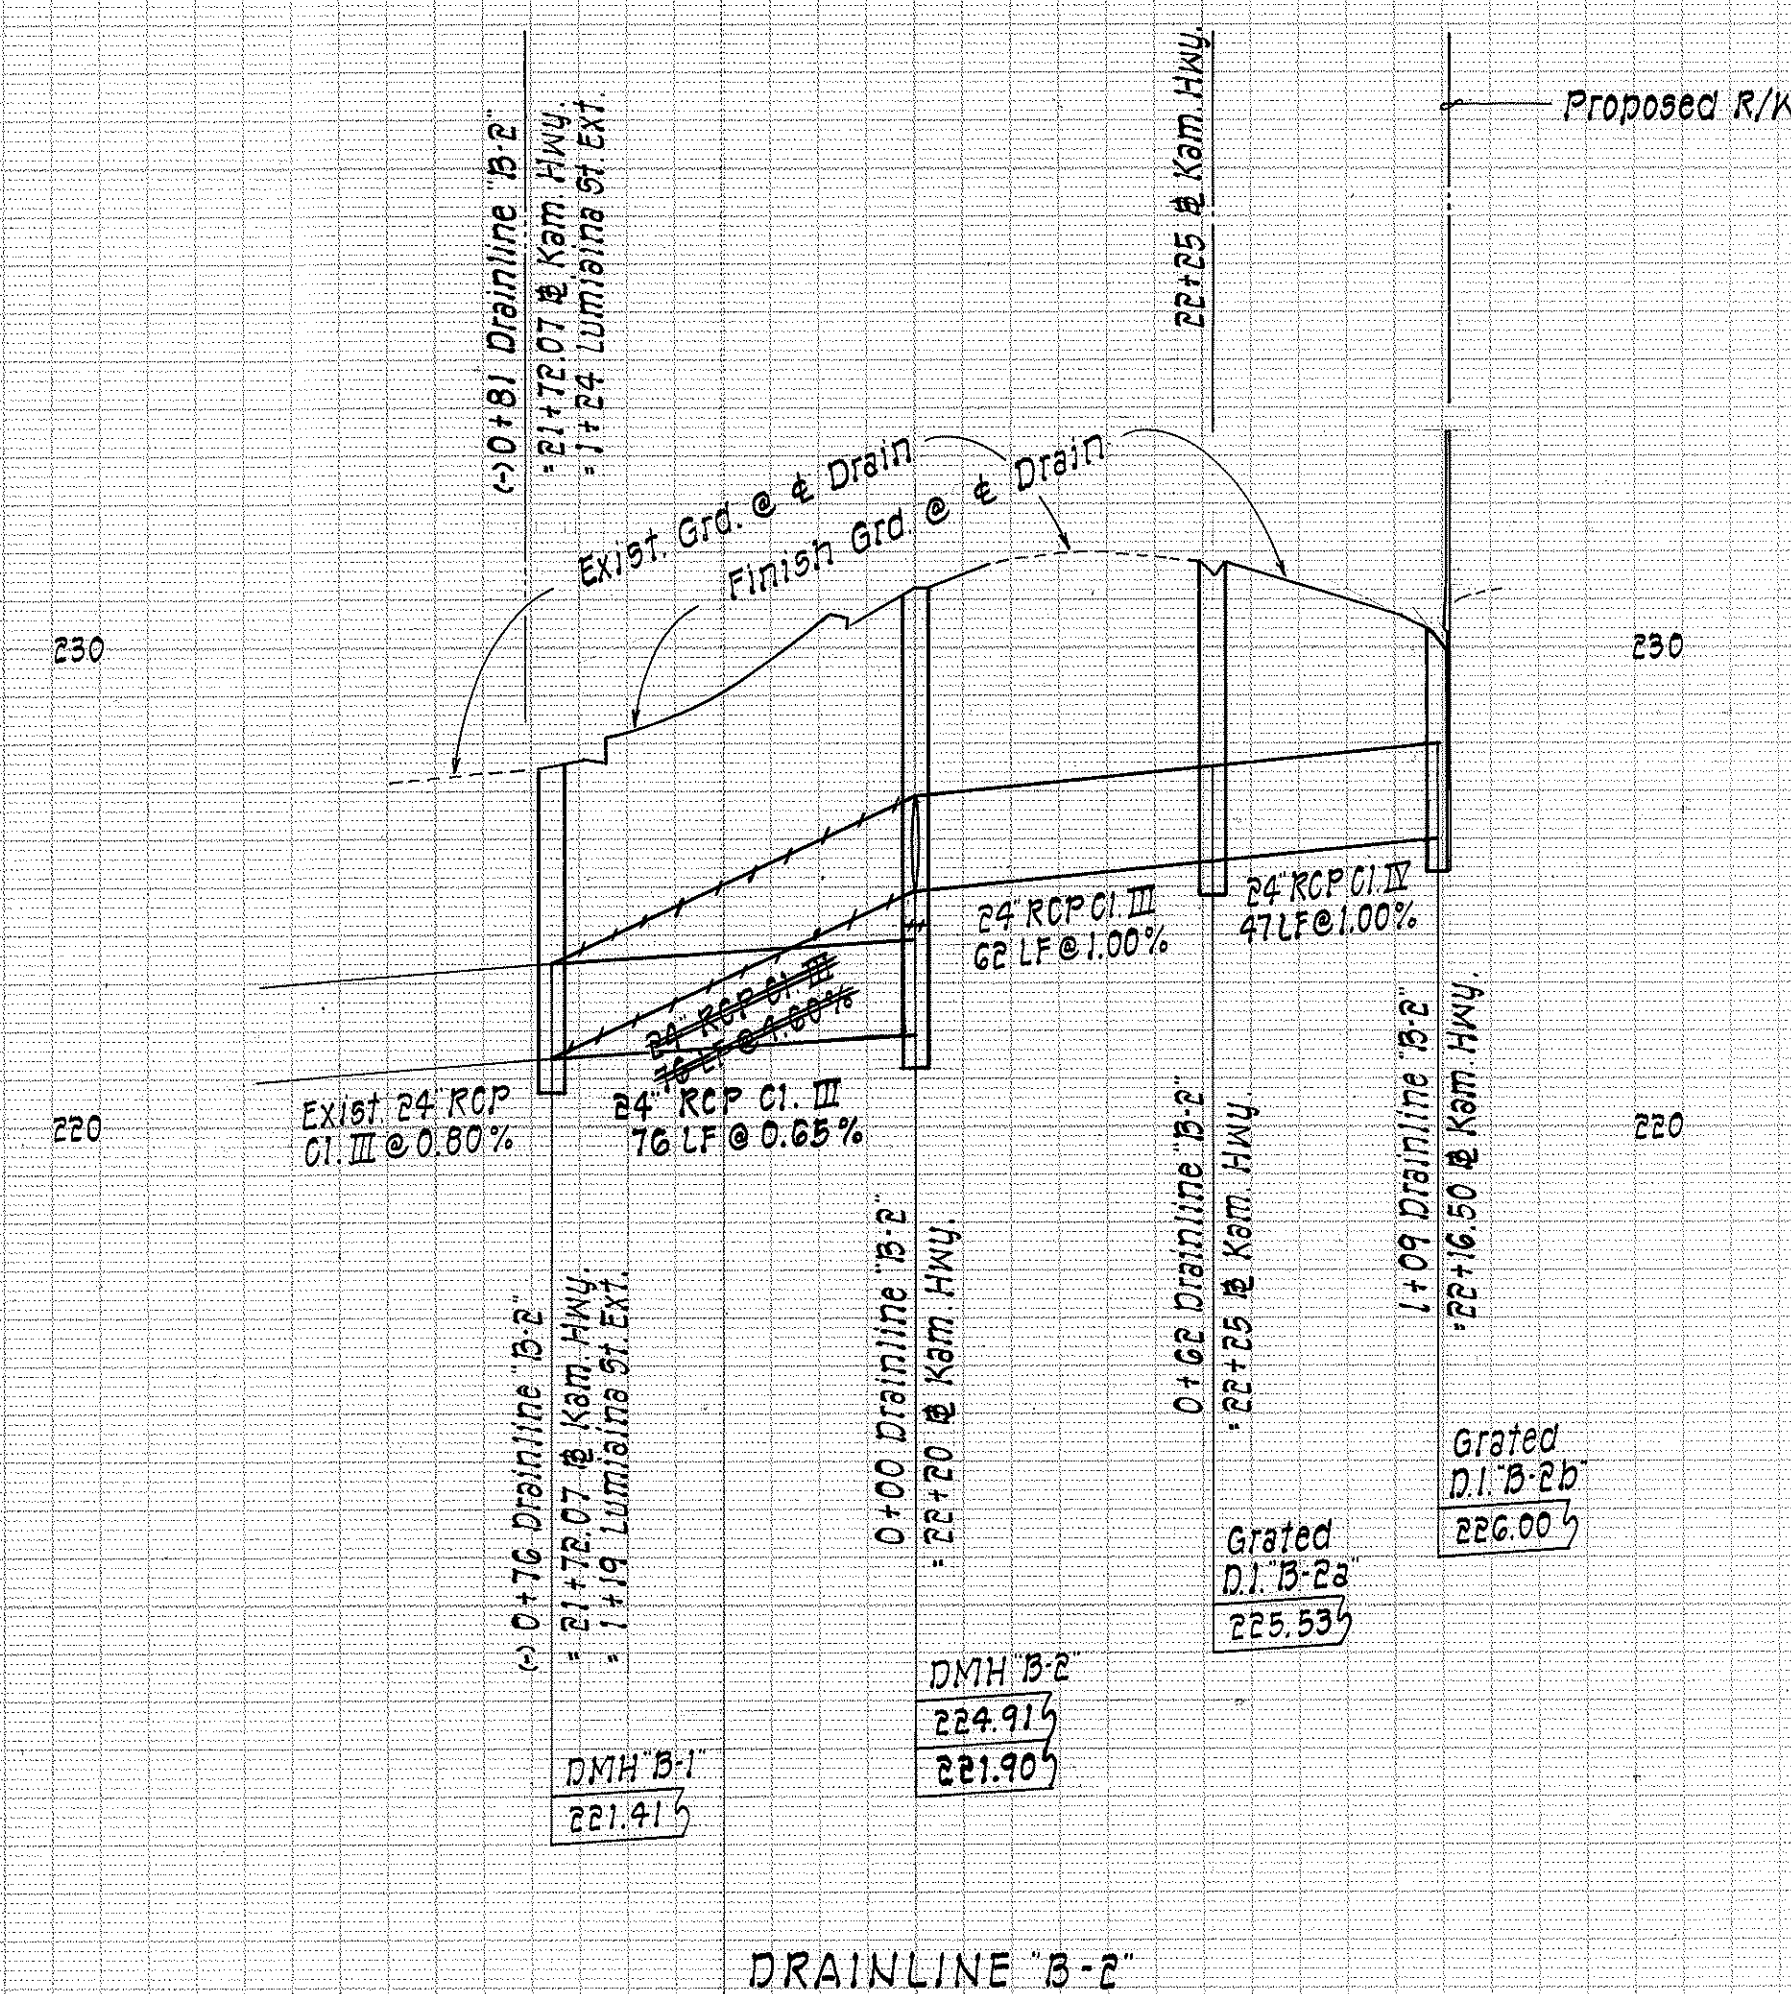

Scales: Hor. 1" = 40'
Vert 1" = 4'

THIS WORK WAS PREPARED BY
ME OR UNDER MY SUPERVISION
Bernard J. Keane
Signature

RECORD DRAWINGS

22

ORIGINAL PLAN	SURVEY PLOTTED BY _____ DATE _____
NOTE BOOK	DRAWN BY _____
	TRACED BY _____
	DESIGNED BY _____
	QUANTITIES BY _____
No. _____	CHECKED BY _____