


84732


FINAL	DATE
SURVEY	BY
PLOTTED	
NOTE BOOK	
NO.	

ORIGINAL	DATE
SURVEY	BY
PLOTTED	
NOTE BOOK	
NO.	

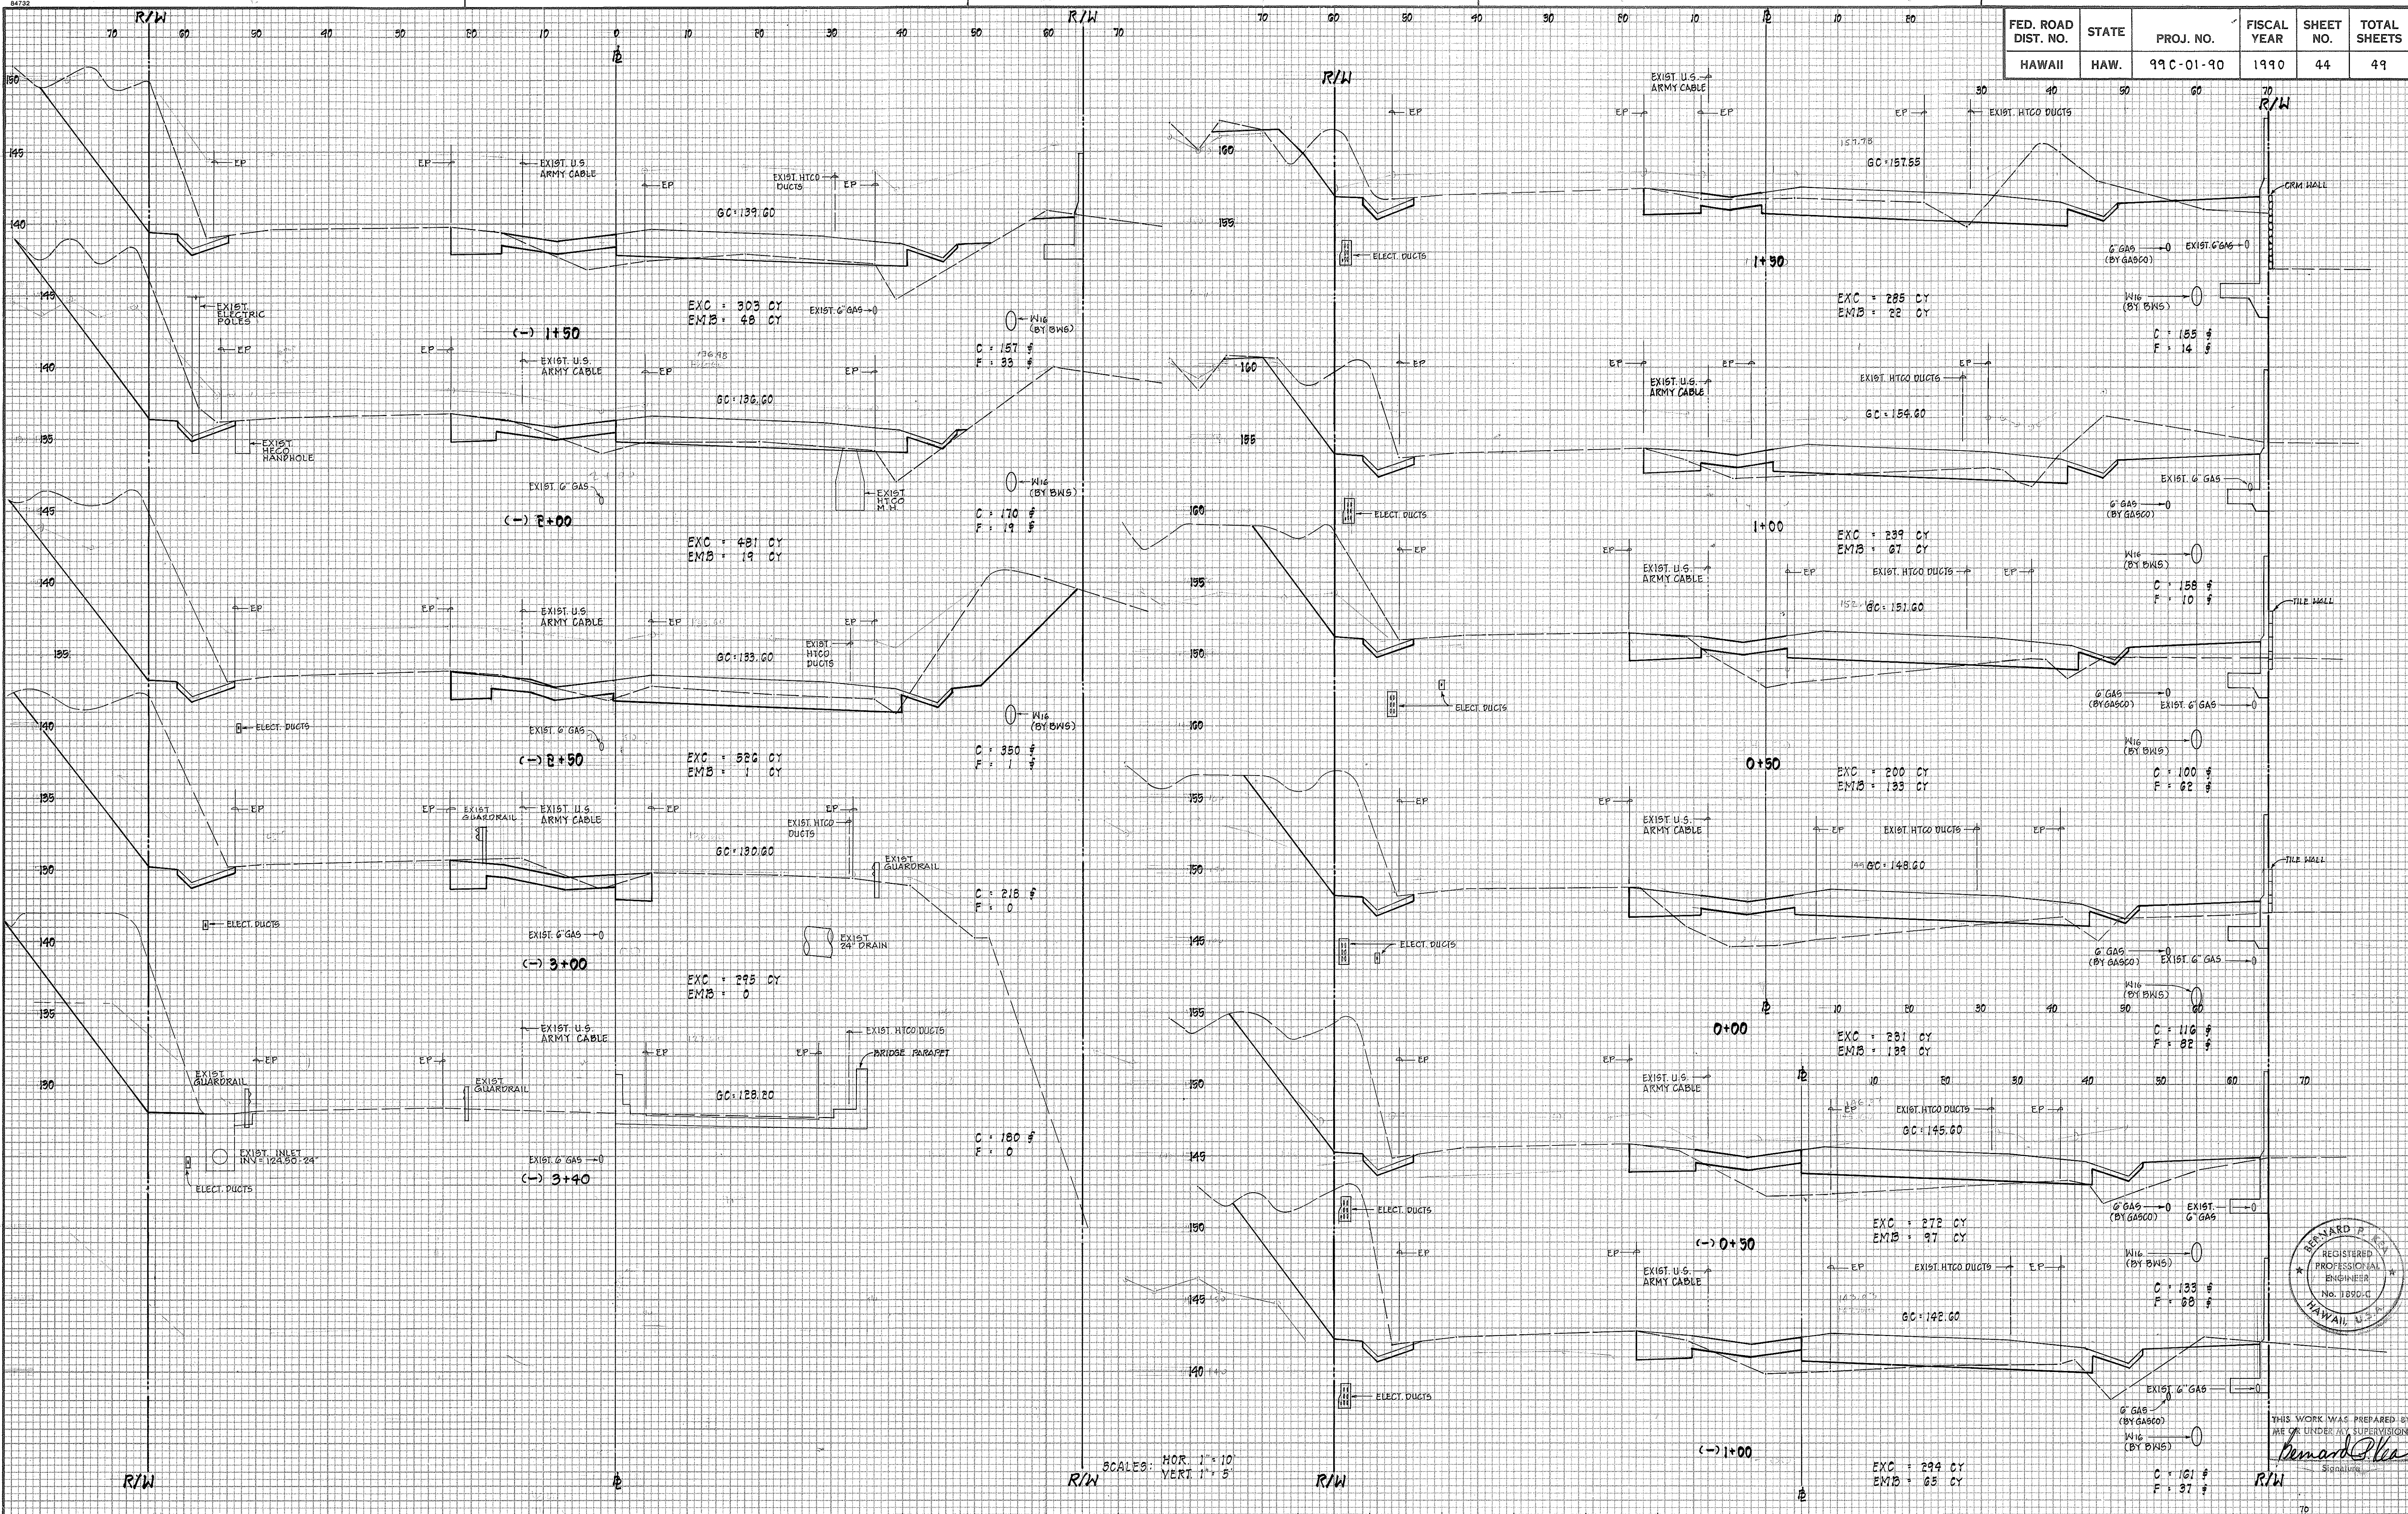


FINAL SURVEY	SURVEYED _____	BY _____	DATE _____
	PLOTTED _____		
	TEMPLATE _____		
	AREAS _____		
NOTE BOOK	AREAS CHECKED _____		
NO _____			

ORIGINAL SURVEY		BY _____	DATE _____
NOTE BOOK			
SURVEYED _____			
PLOTTED _____			
TEMPLATE _____			
AREAS _____			
AREAS CHECKED _____			
NO _____			

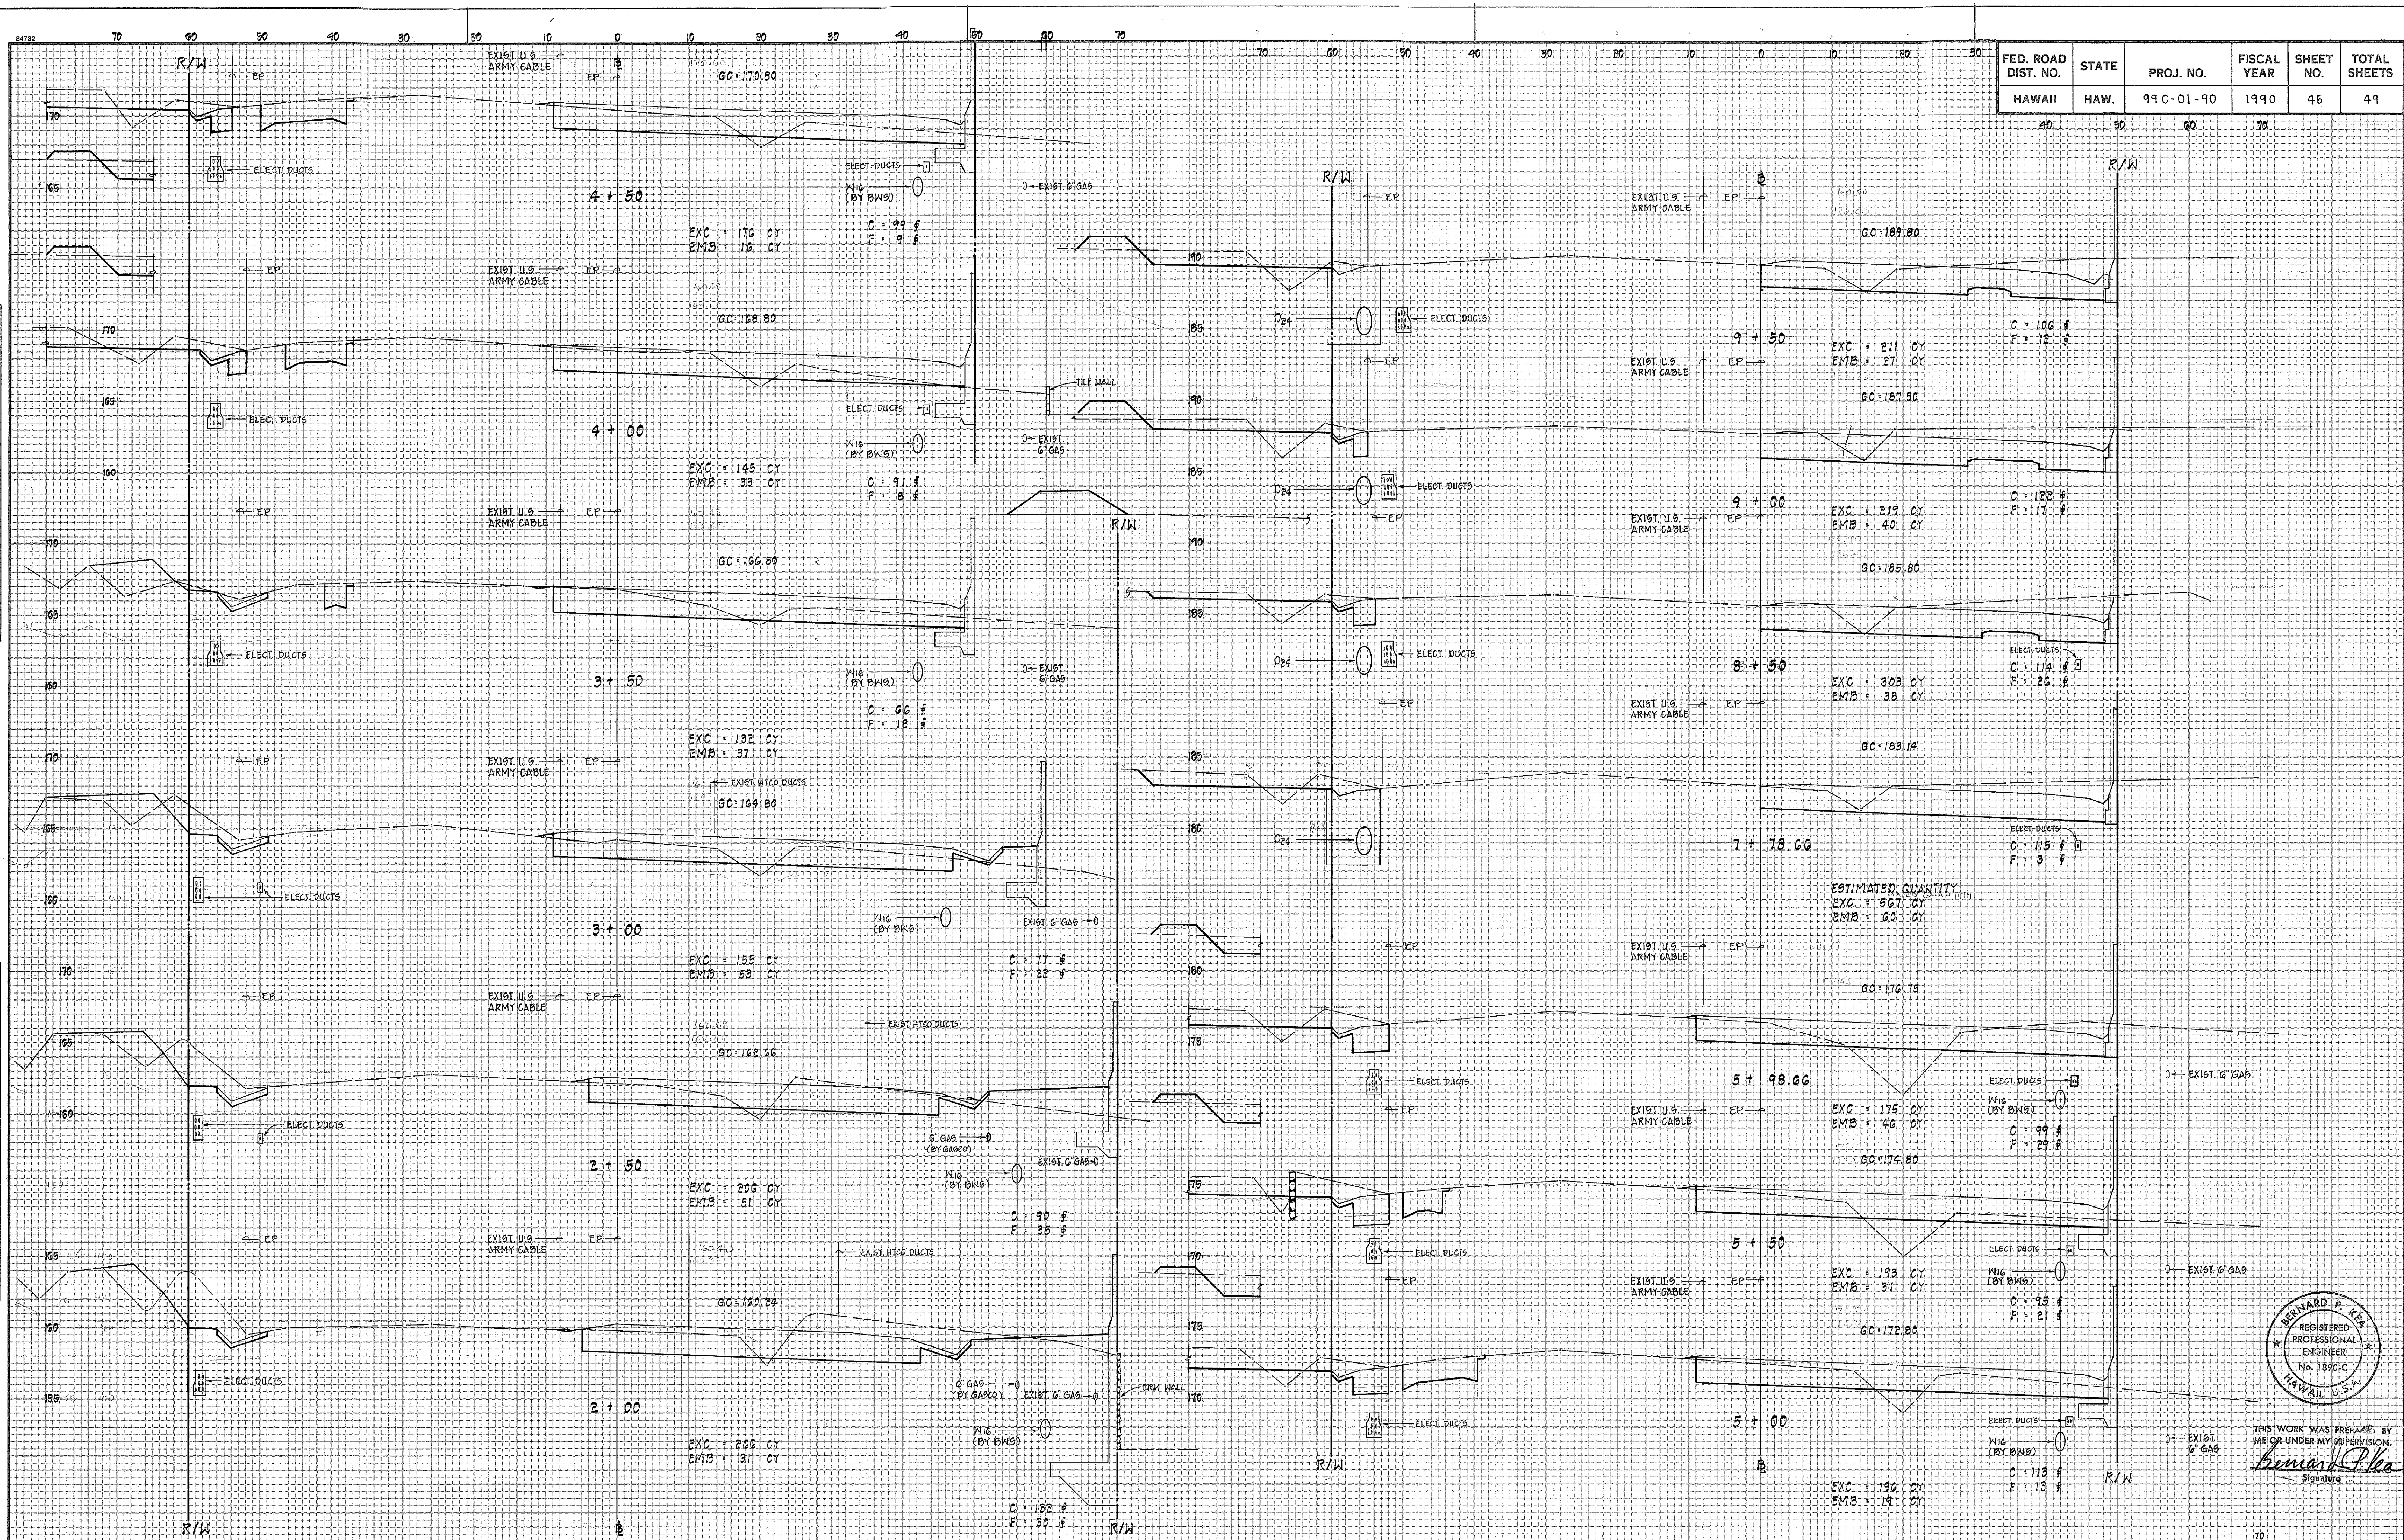

WORK WAS PREPARED BY
OR UNDER MY SUPERVISION
Edward P. Keane
Signature

FED. ROAD DIST. NO.	STATE	PROJ. NO.	FISCAL YEAR	SHEET NO.	TOTAL SHEETS
HAWAII	HAW.	99C-01-90	1990	46	49

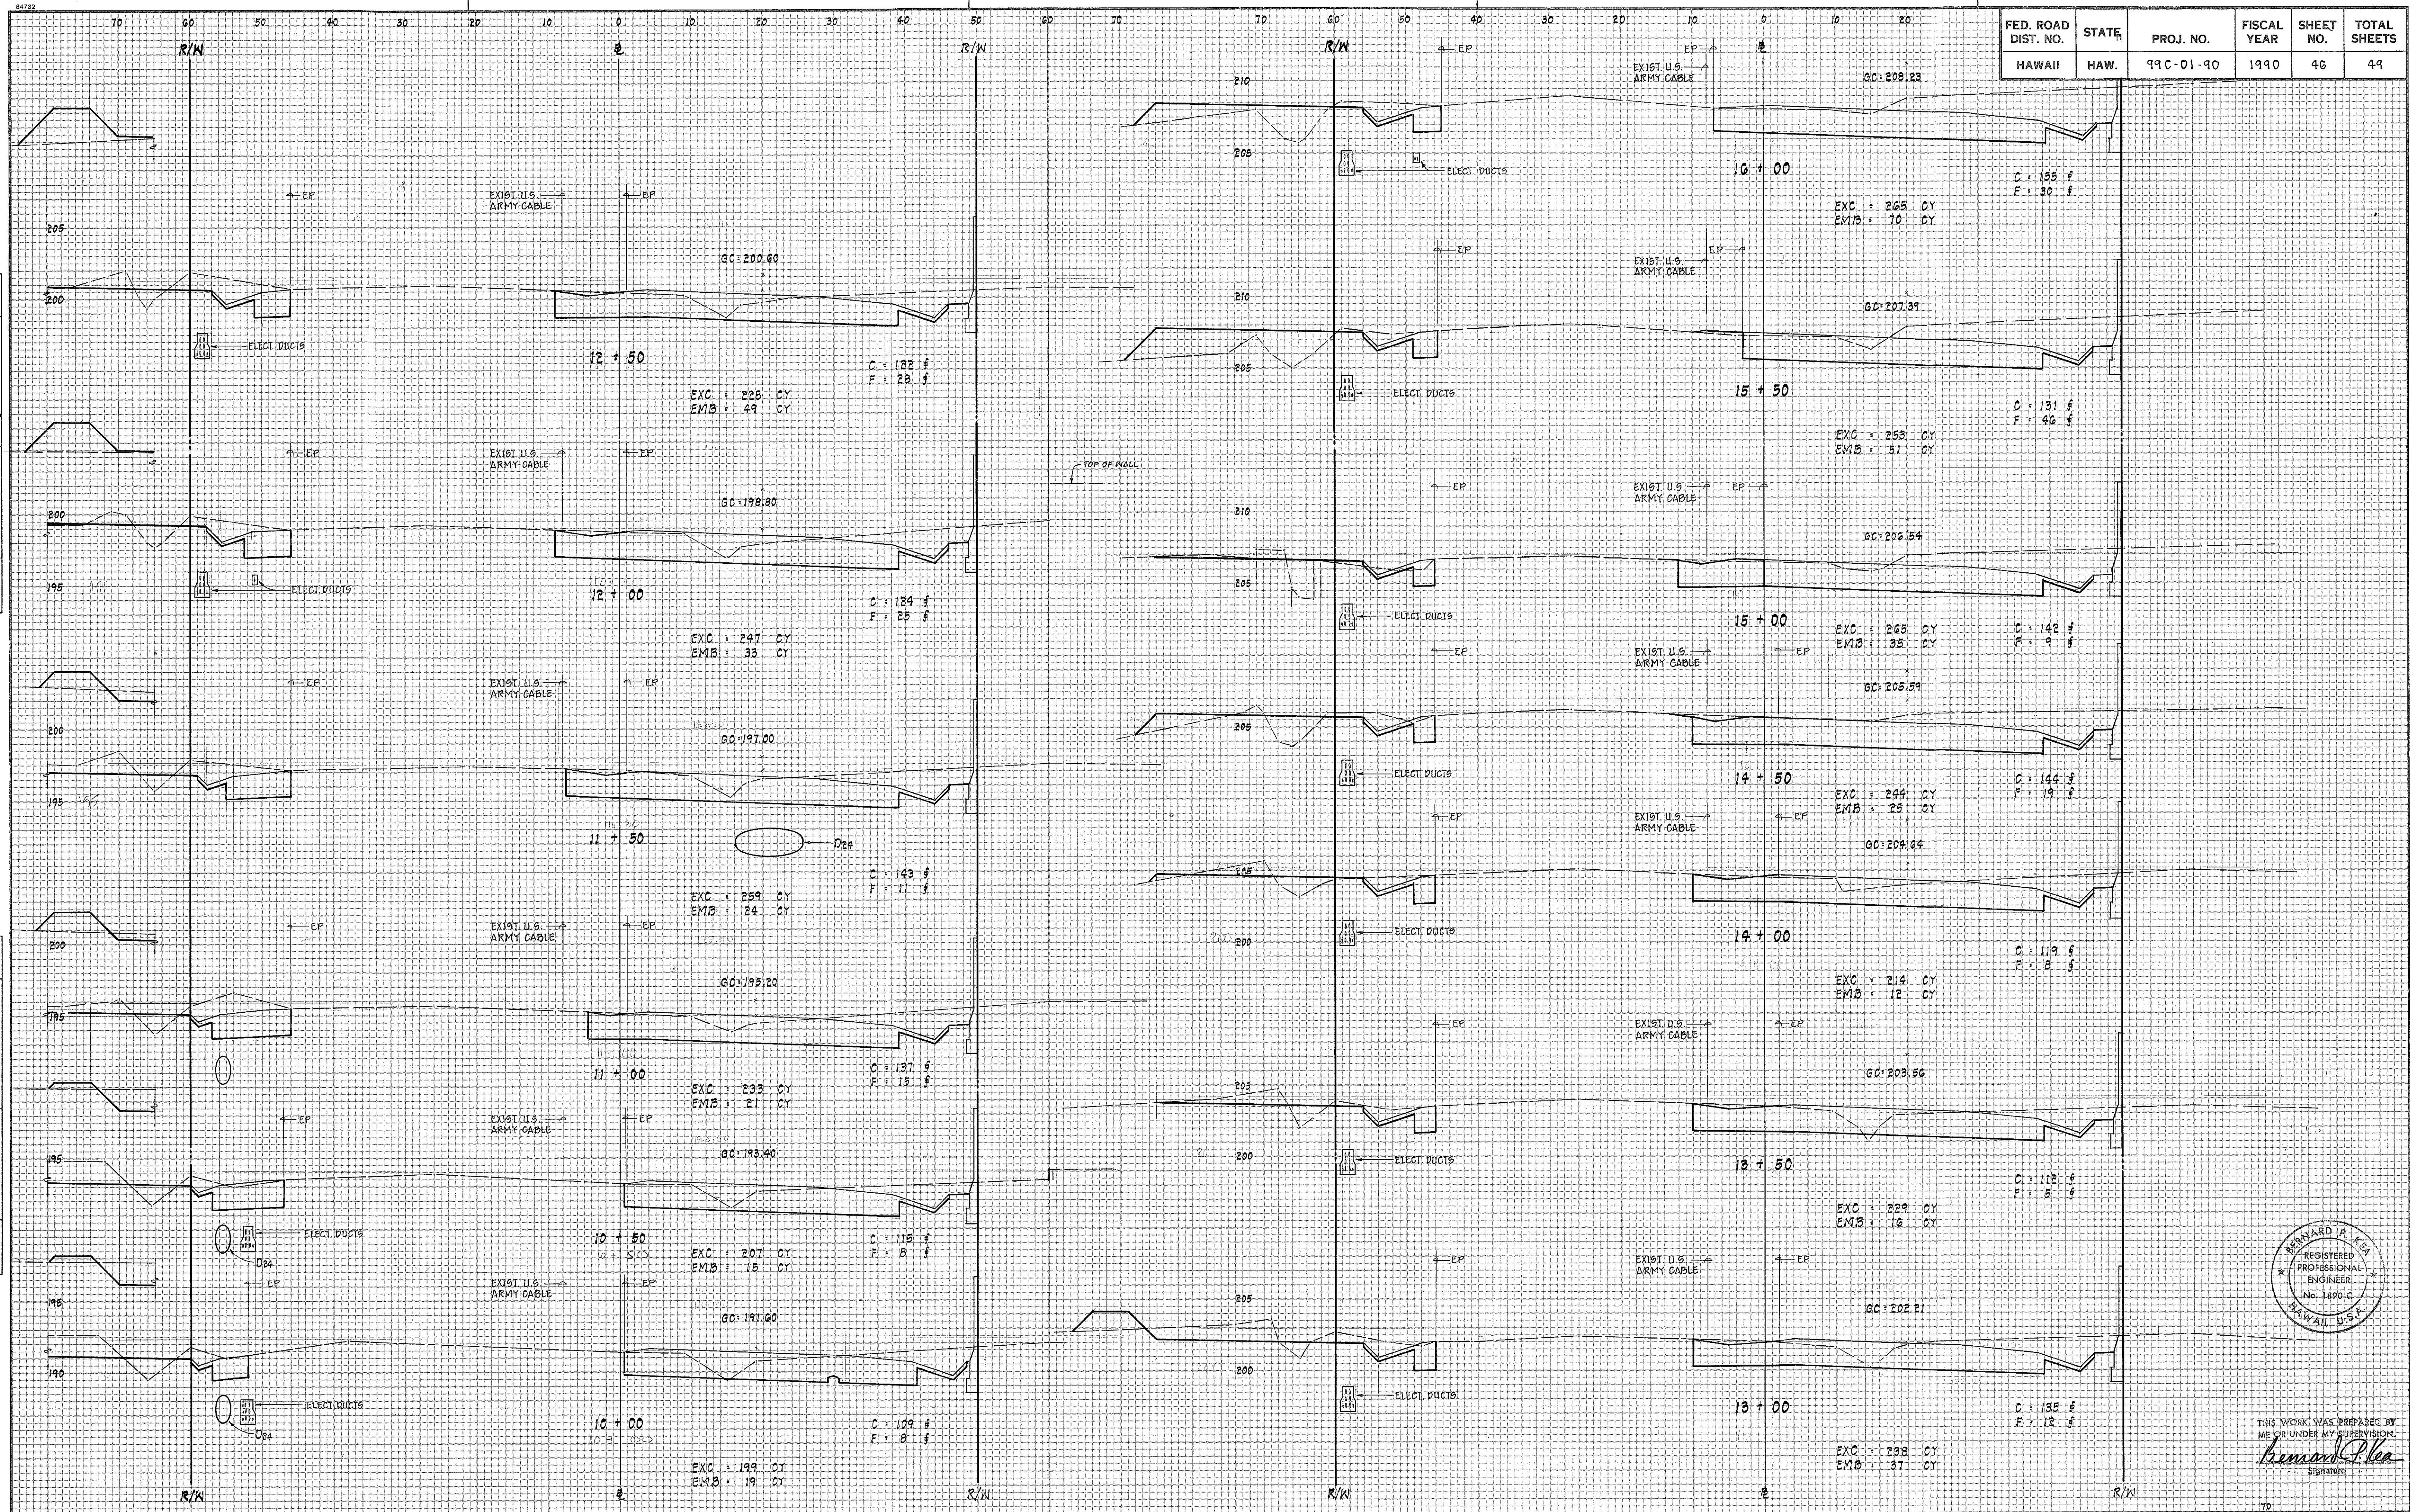


THIS WORK WAS PREPARED BY
ME OR UNDER MY SUPERVISION
Bernard P. Kea
Signature

DATE	
BY	
SURVEYED	
TEMPLATE	
NOTE BOOK	
NO.	
AREAS CHECKED	


DATE	
BY	
SURVEYED	
TEMPLATE	
NOTE BOOK	
NO.	
AREAS CHECKED	

FED. ROAD DIST. NO.	STATE	PROJ. NO.	FISCAL YEAR	SHEET NO.	TOTAL SHEETS
HAWAII	HAW.	99C-01-90	1990	47	49

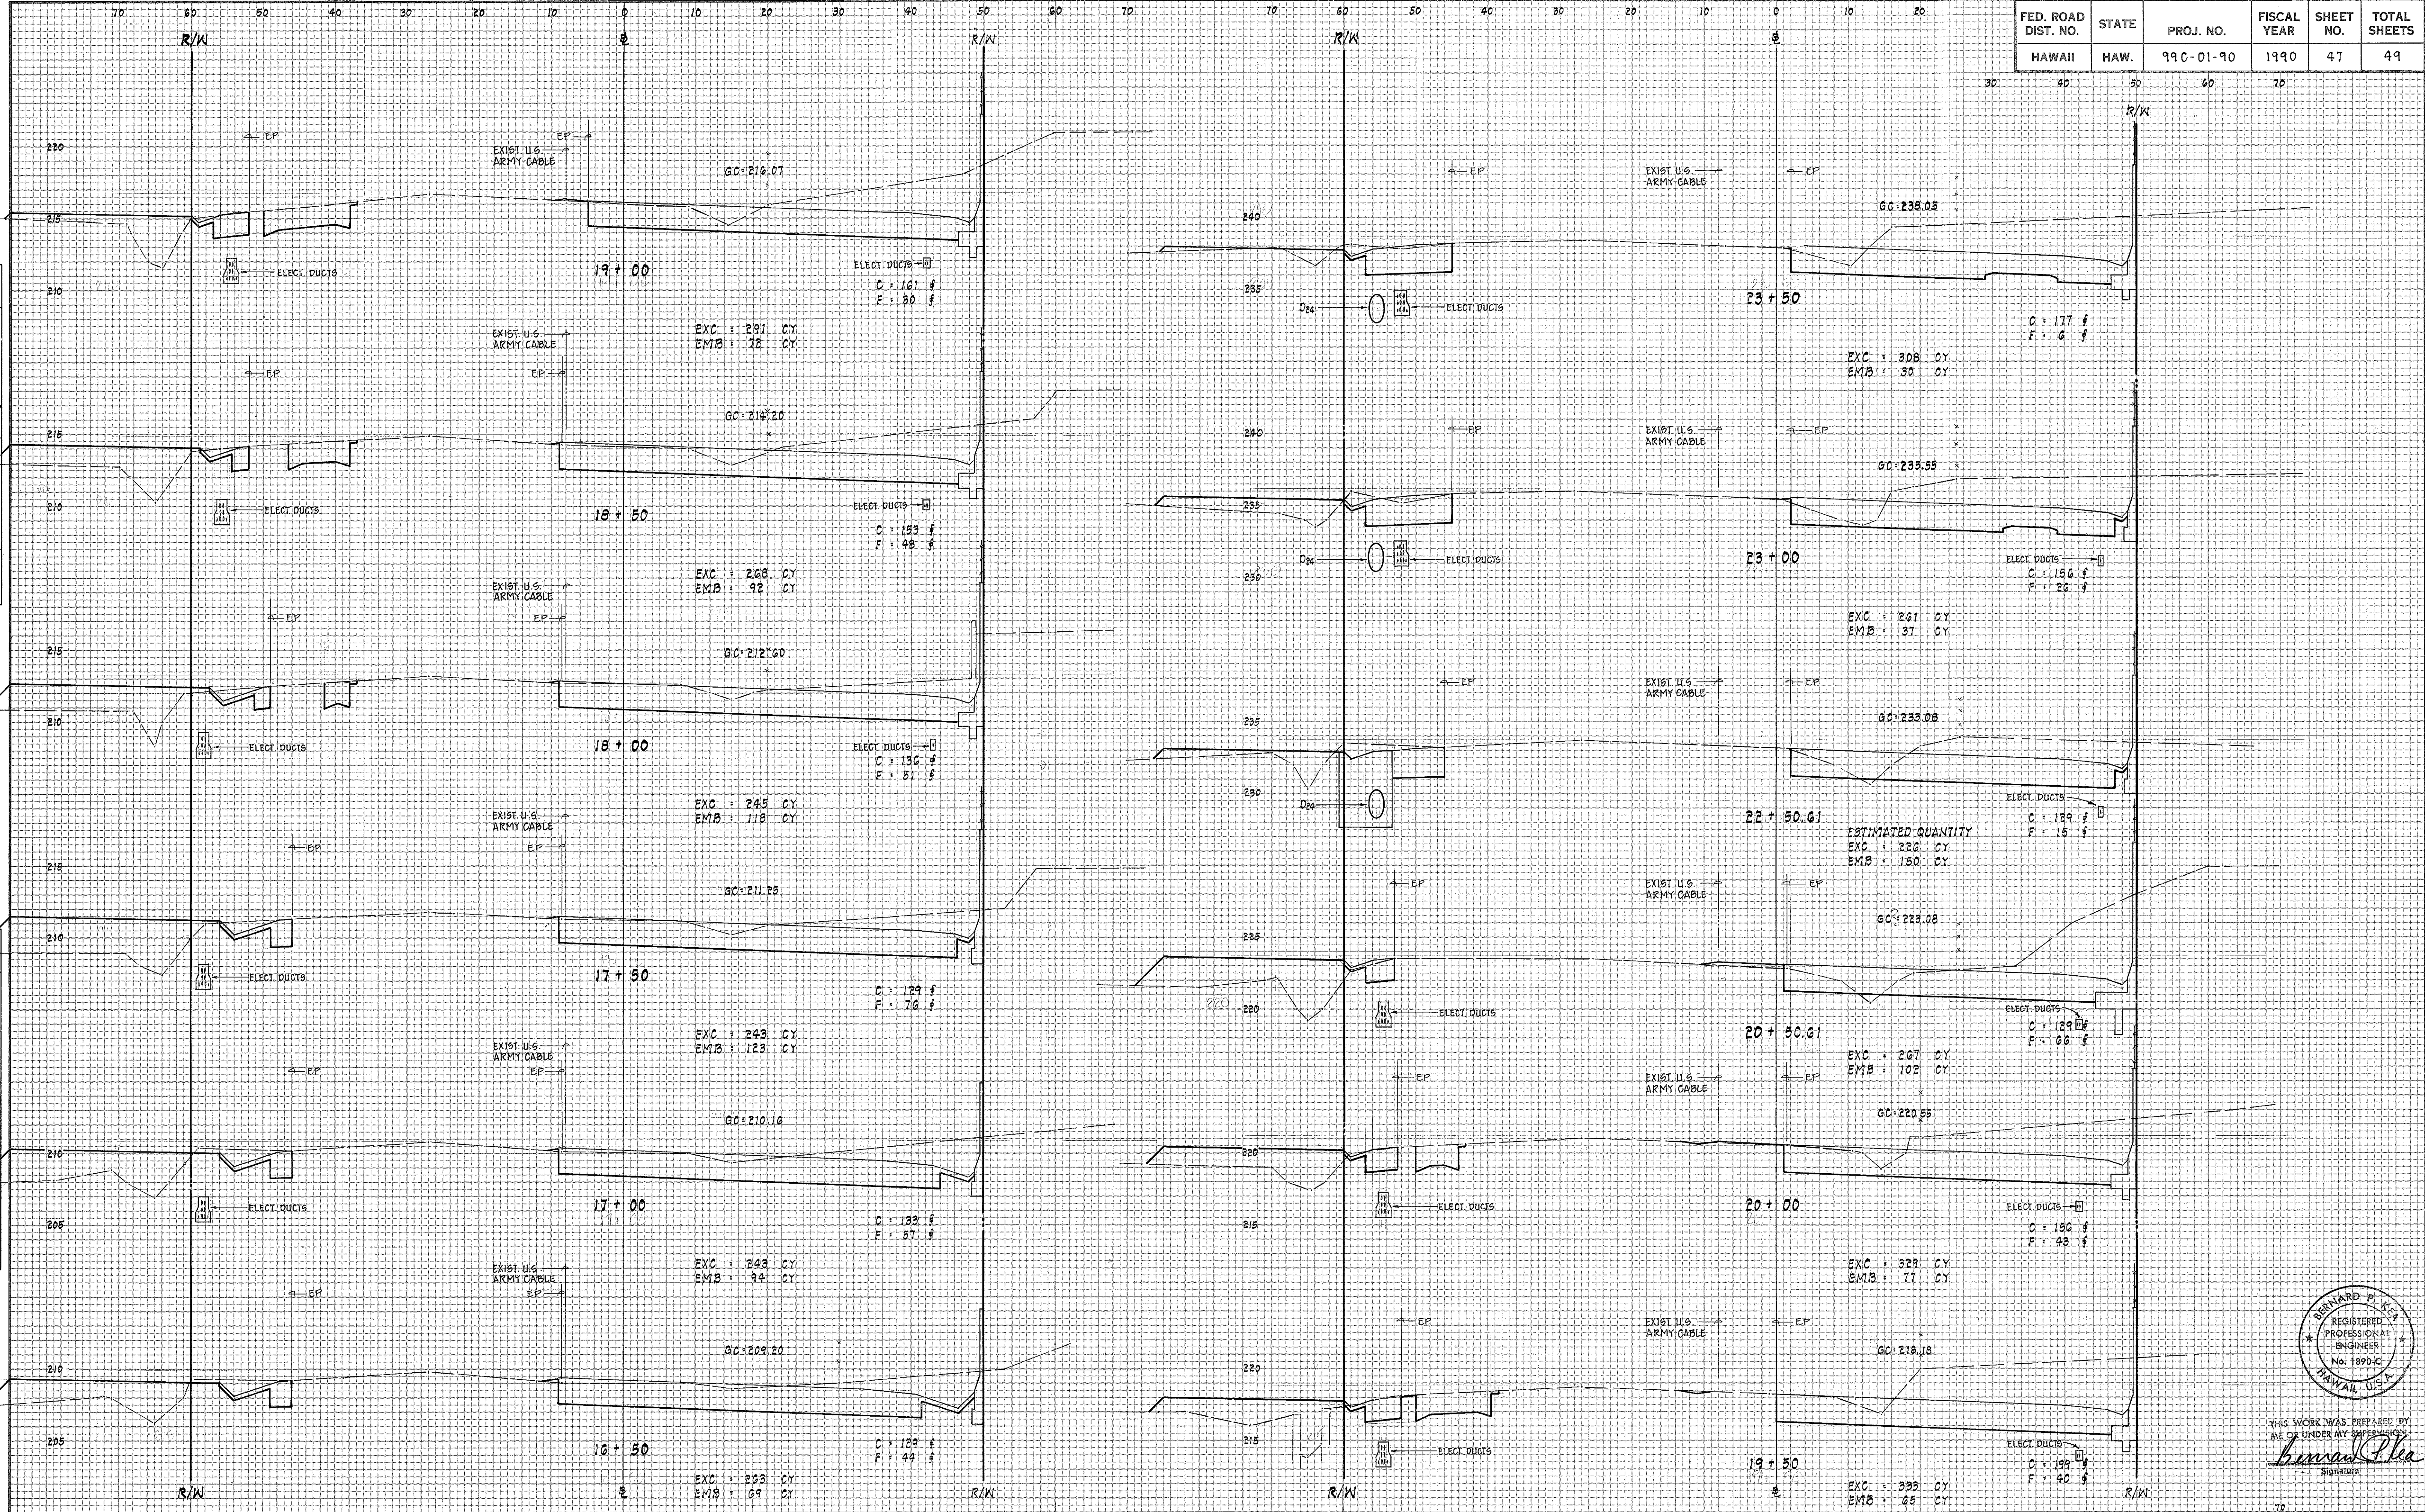

BERNARD P. KEE
REGISTERED PROFESSIONAL ENGINEER
No. 1890-C
HAWAII, U.S.A.
Signature: *Bernard P. Kee*

FED. ROAD DIST. NO.	STATE	PROJ. NO.	FISCAL YEAR	SHEET NO.	TOTAL SHEETS
HAWAII	HAW.	99C-01-90	1990	48	49

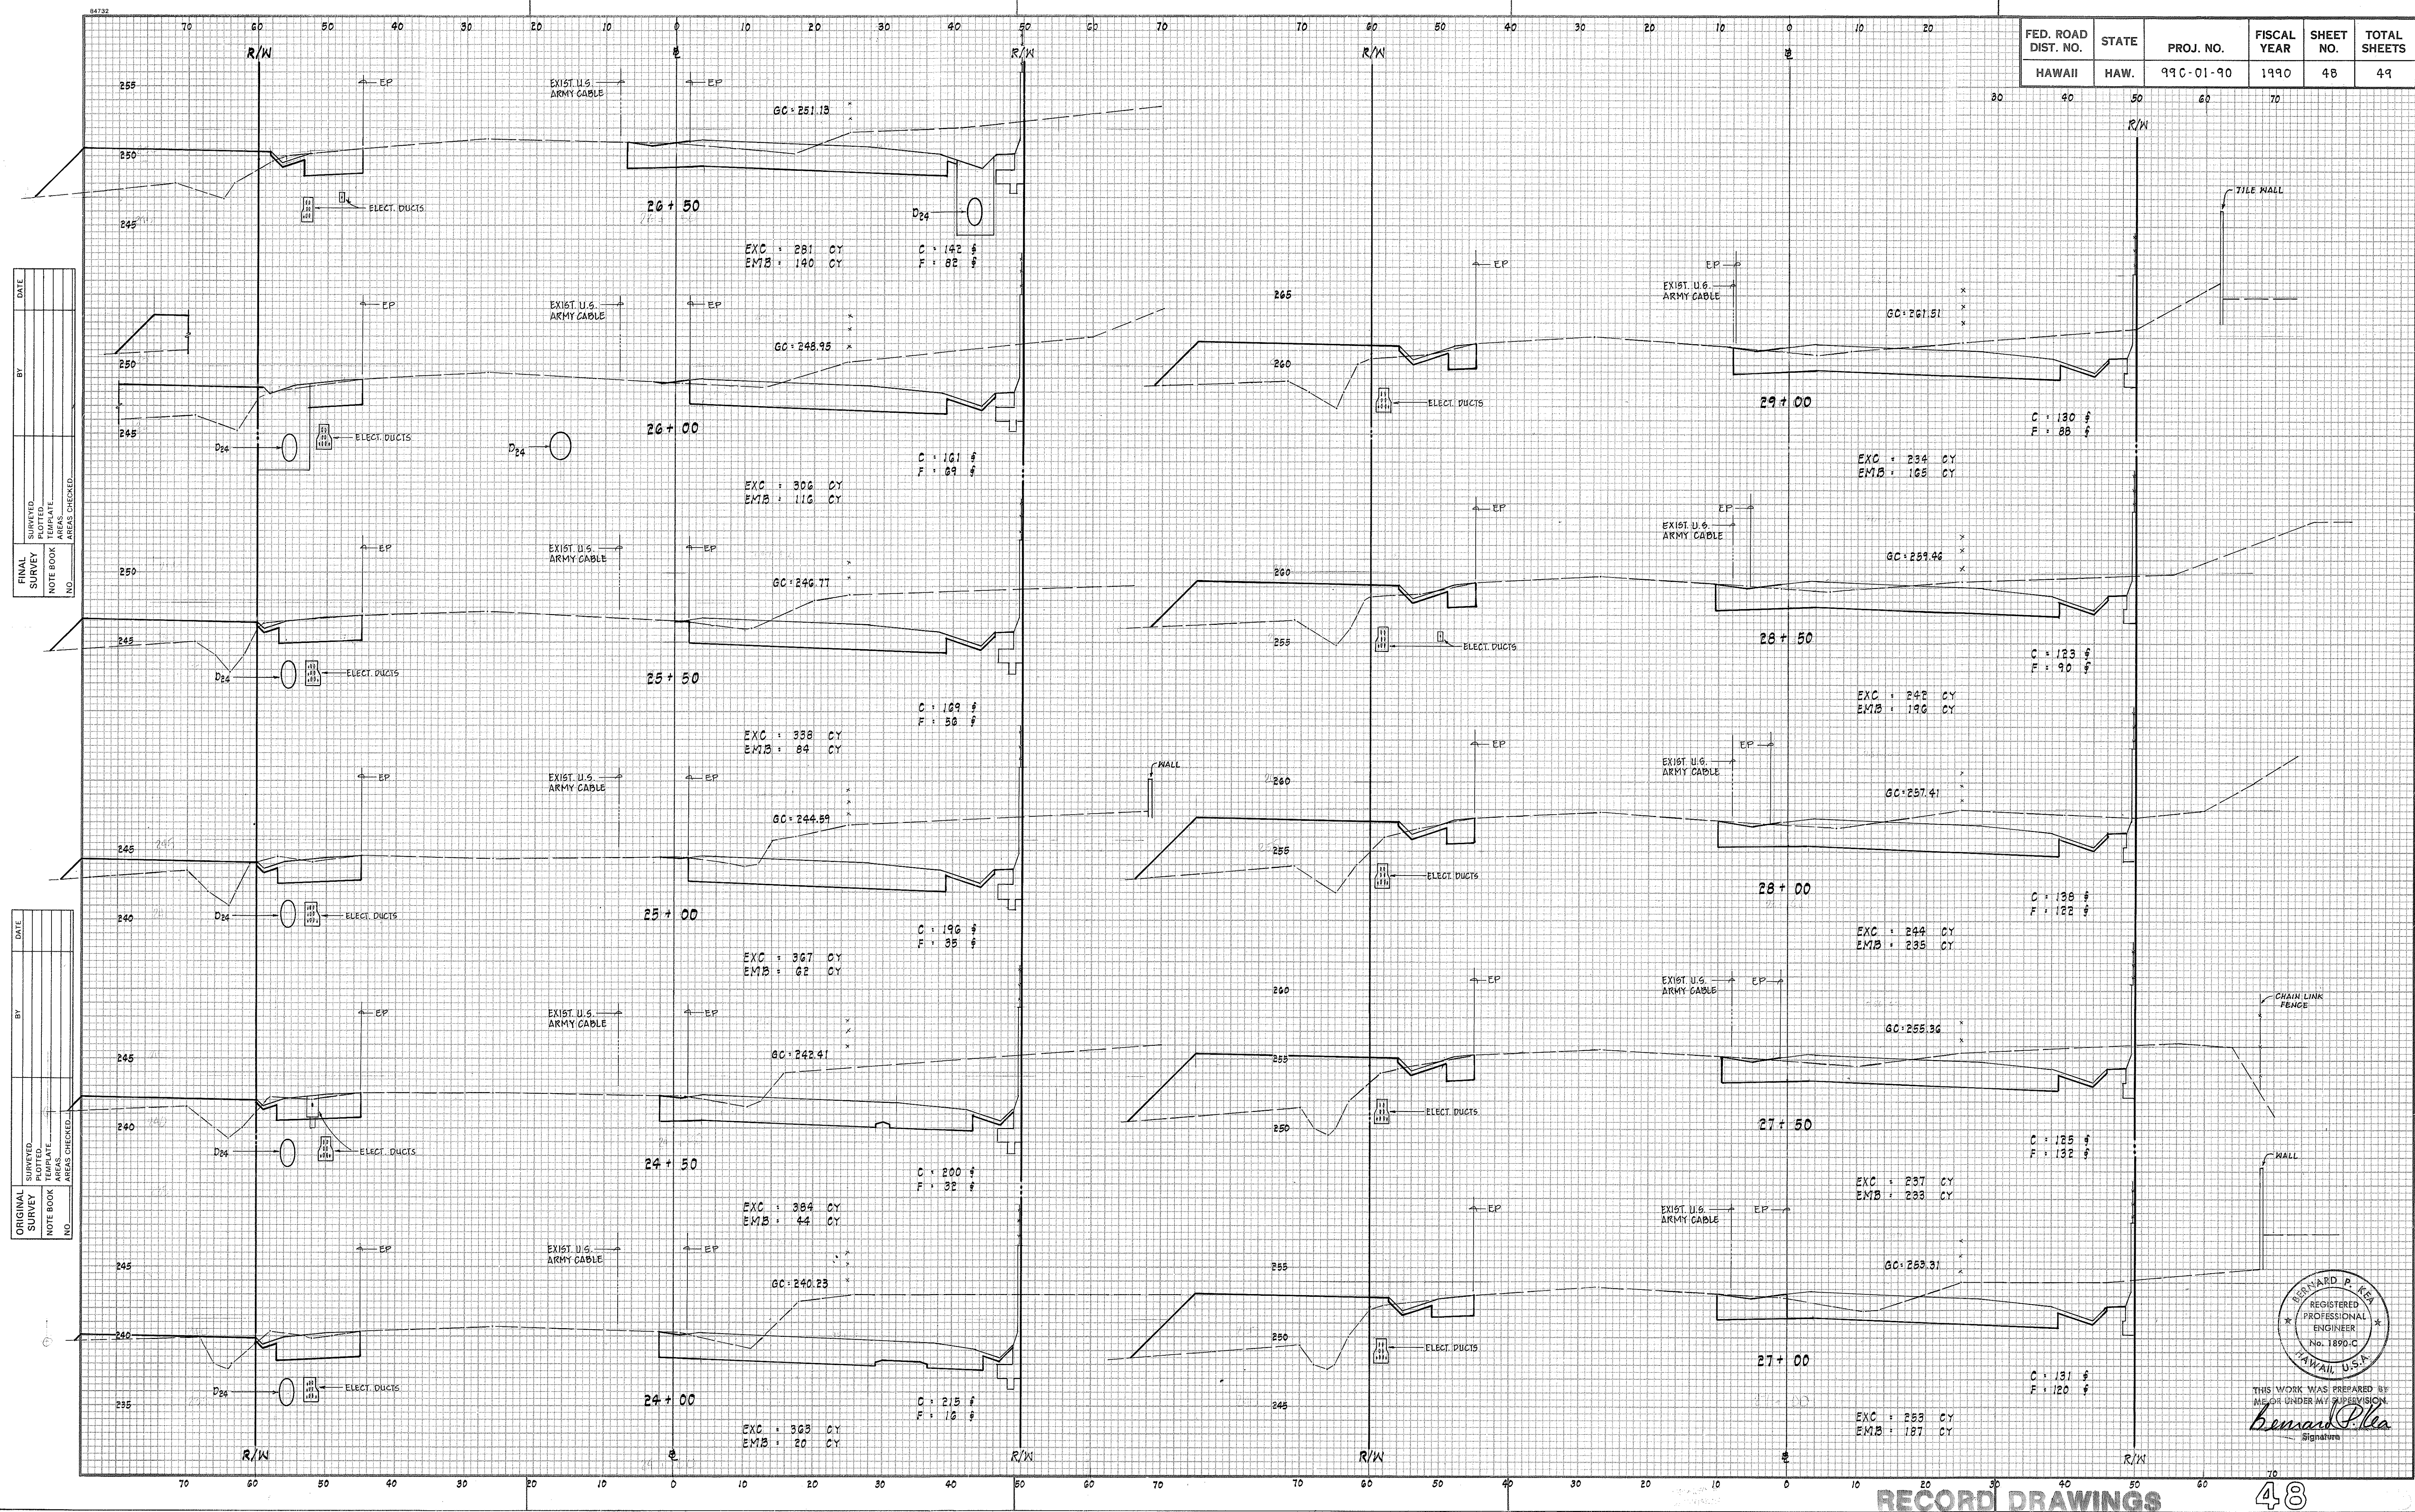

BERNARD P. KEA
REGISTERED
PROFESSIONAL
ENGINEER
No. 1890-C
HAWAII, U.S.A.

THIS WORK WAS PREPARED
FOR ME OR UNDER MY SUPERVISION


Bernard P. Kea
Signature

THIS WORK WAS PREPARED BY
ME OR UNDER MY SUPERVISION
Bernard P. Ke...
Signature

DATE	BY	FINAL SURVEY	SURVEYED	PLOTTED	TEMPLATE	NO.


DATE	BY	ORIGINAL SURVEY	SURVEYED	PLOTTED	TEMPLATE	NO.

FED. ROAD DIST. NO.	STATE	PROJ. NO.	FISCAL YEAR	SHEET NO.	TOTAL SHEETS
HAWAII	HAW.	99 C-01-90	1990	49	49

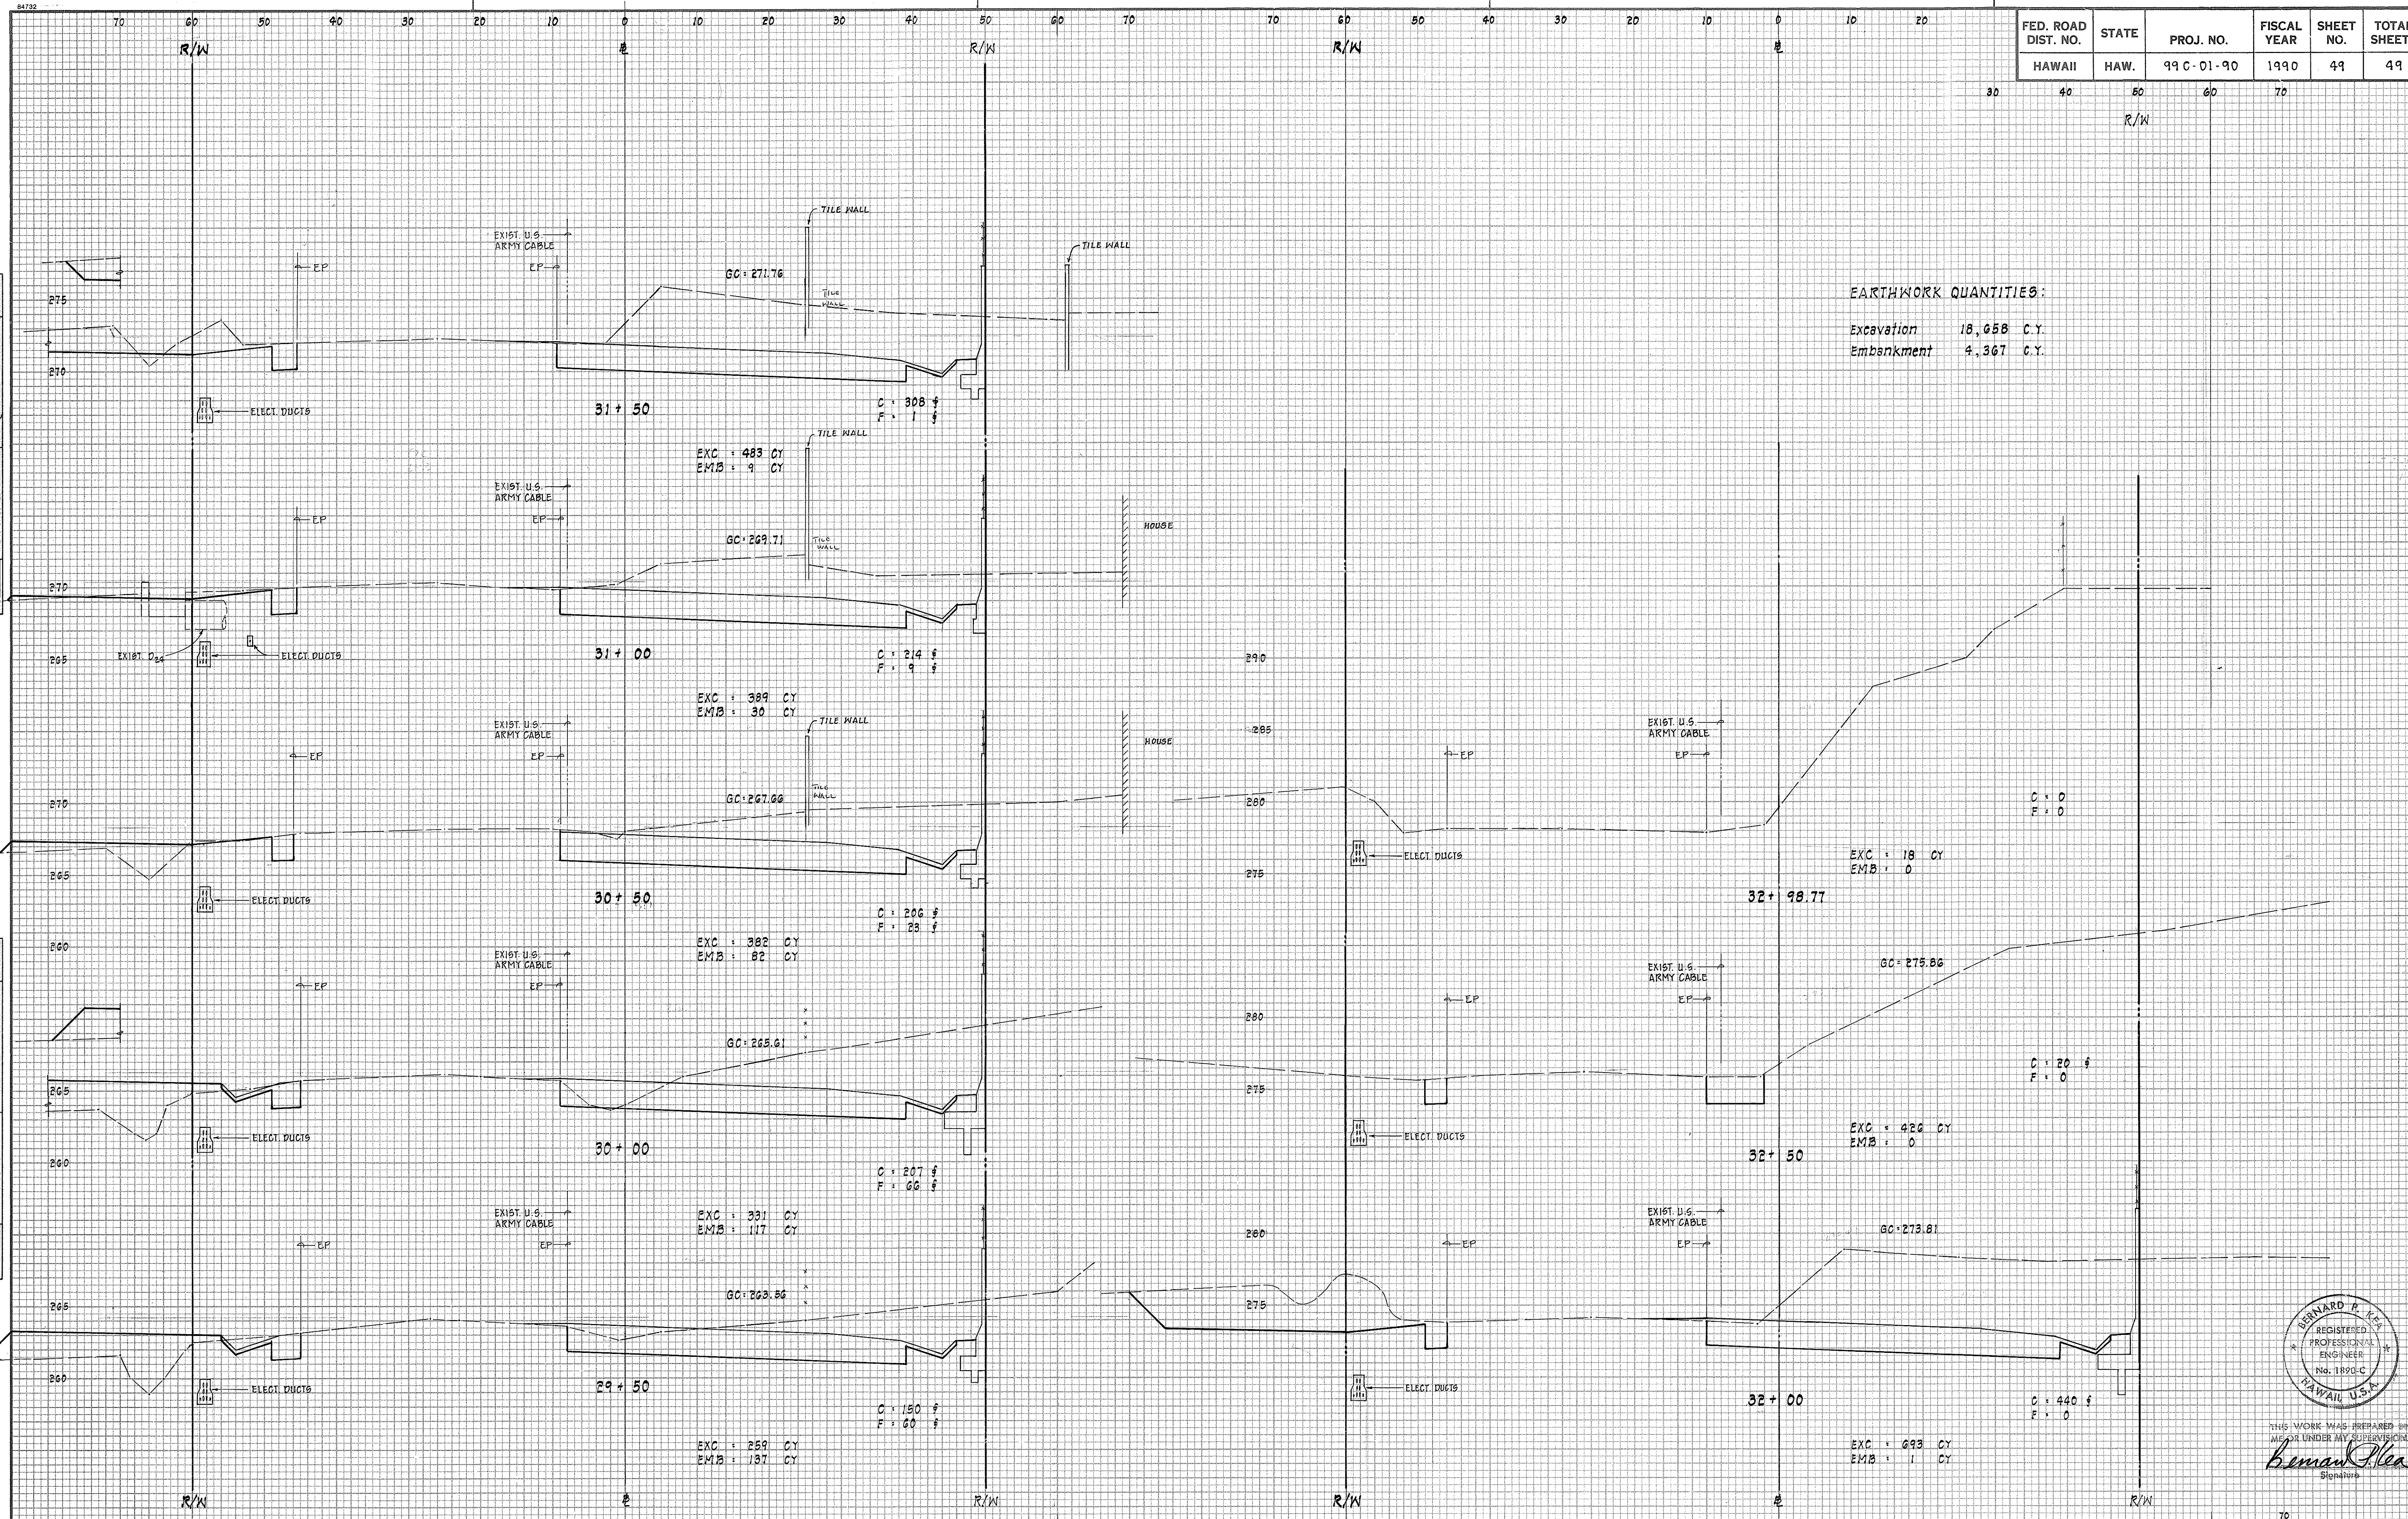

EARTHWORK QUANTITIES:

Excavation 18,658 C.Y.
Embankment 4,367 C.Y.

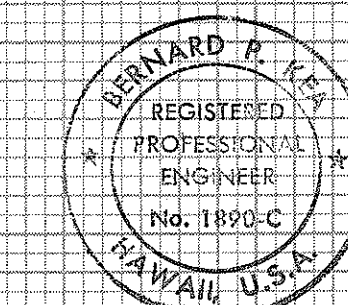

THIS WORK WAS PREPARED BY ME OR UNDER MY SUPERVISION
Bernard R. Kila
Signature

RECORD DRAWINGS

49