



FED. ROAD DIST. NO.	STATE	PROJ. NO.	FISCAL YEAR	SHEET NO.	TOTAL SHEETS
HAWAII	HAW.	99D-01-92M	1992	4	10

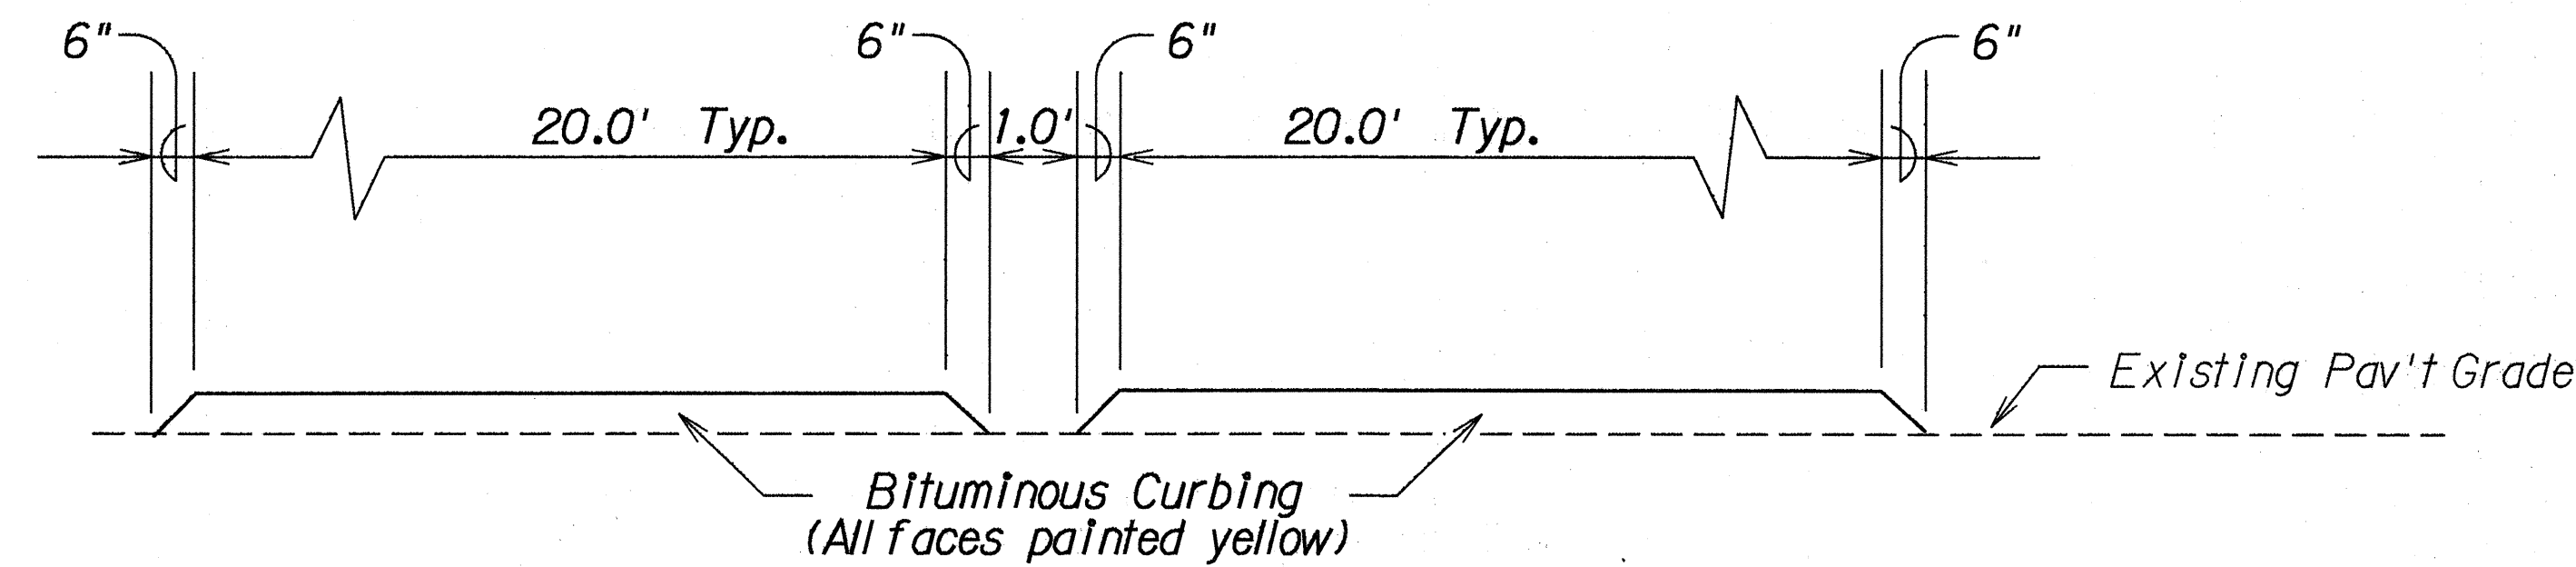


BITUMINOUS CURBING - SPACING DETAIL

Not To Scale

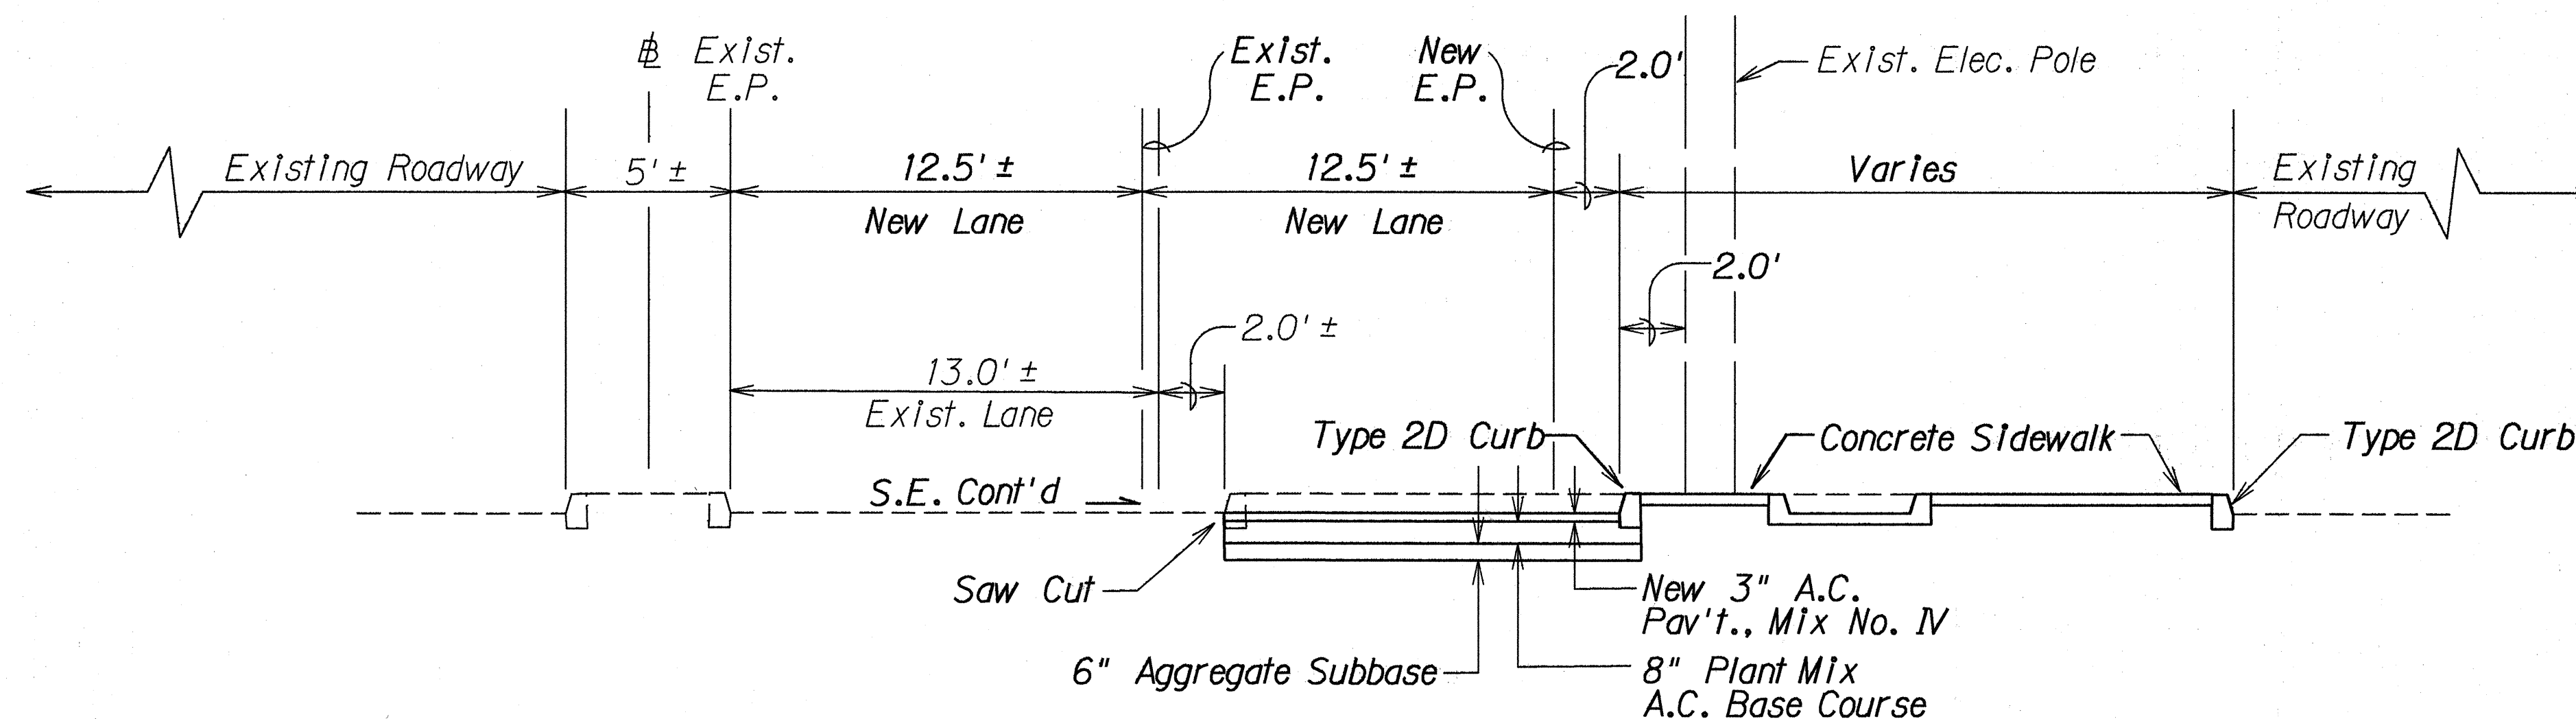


LANE WIDENING ON WAIMANO HOME ROAD

Scale: 1/4" = 1'-0"

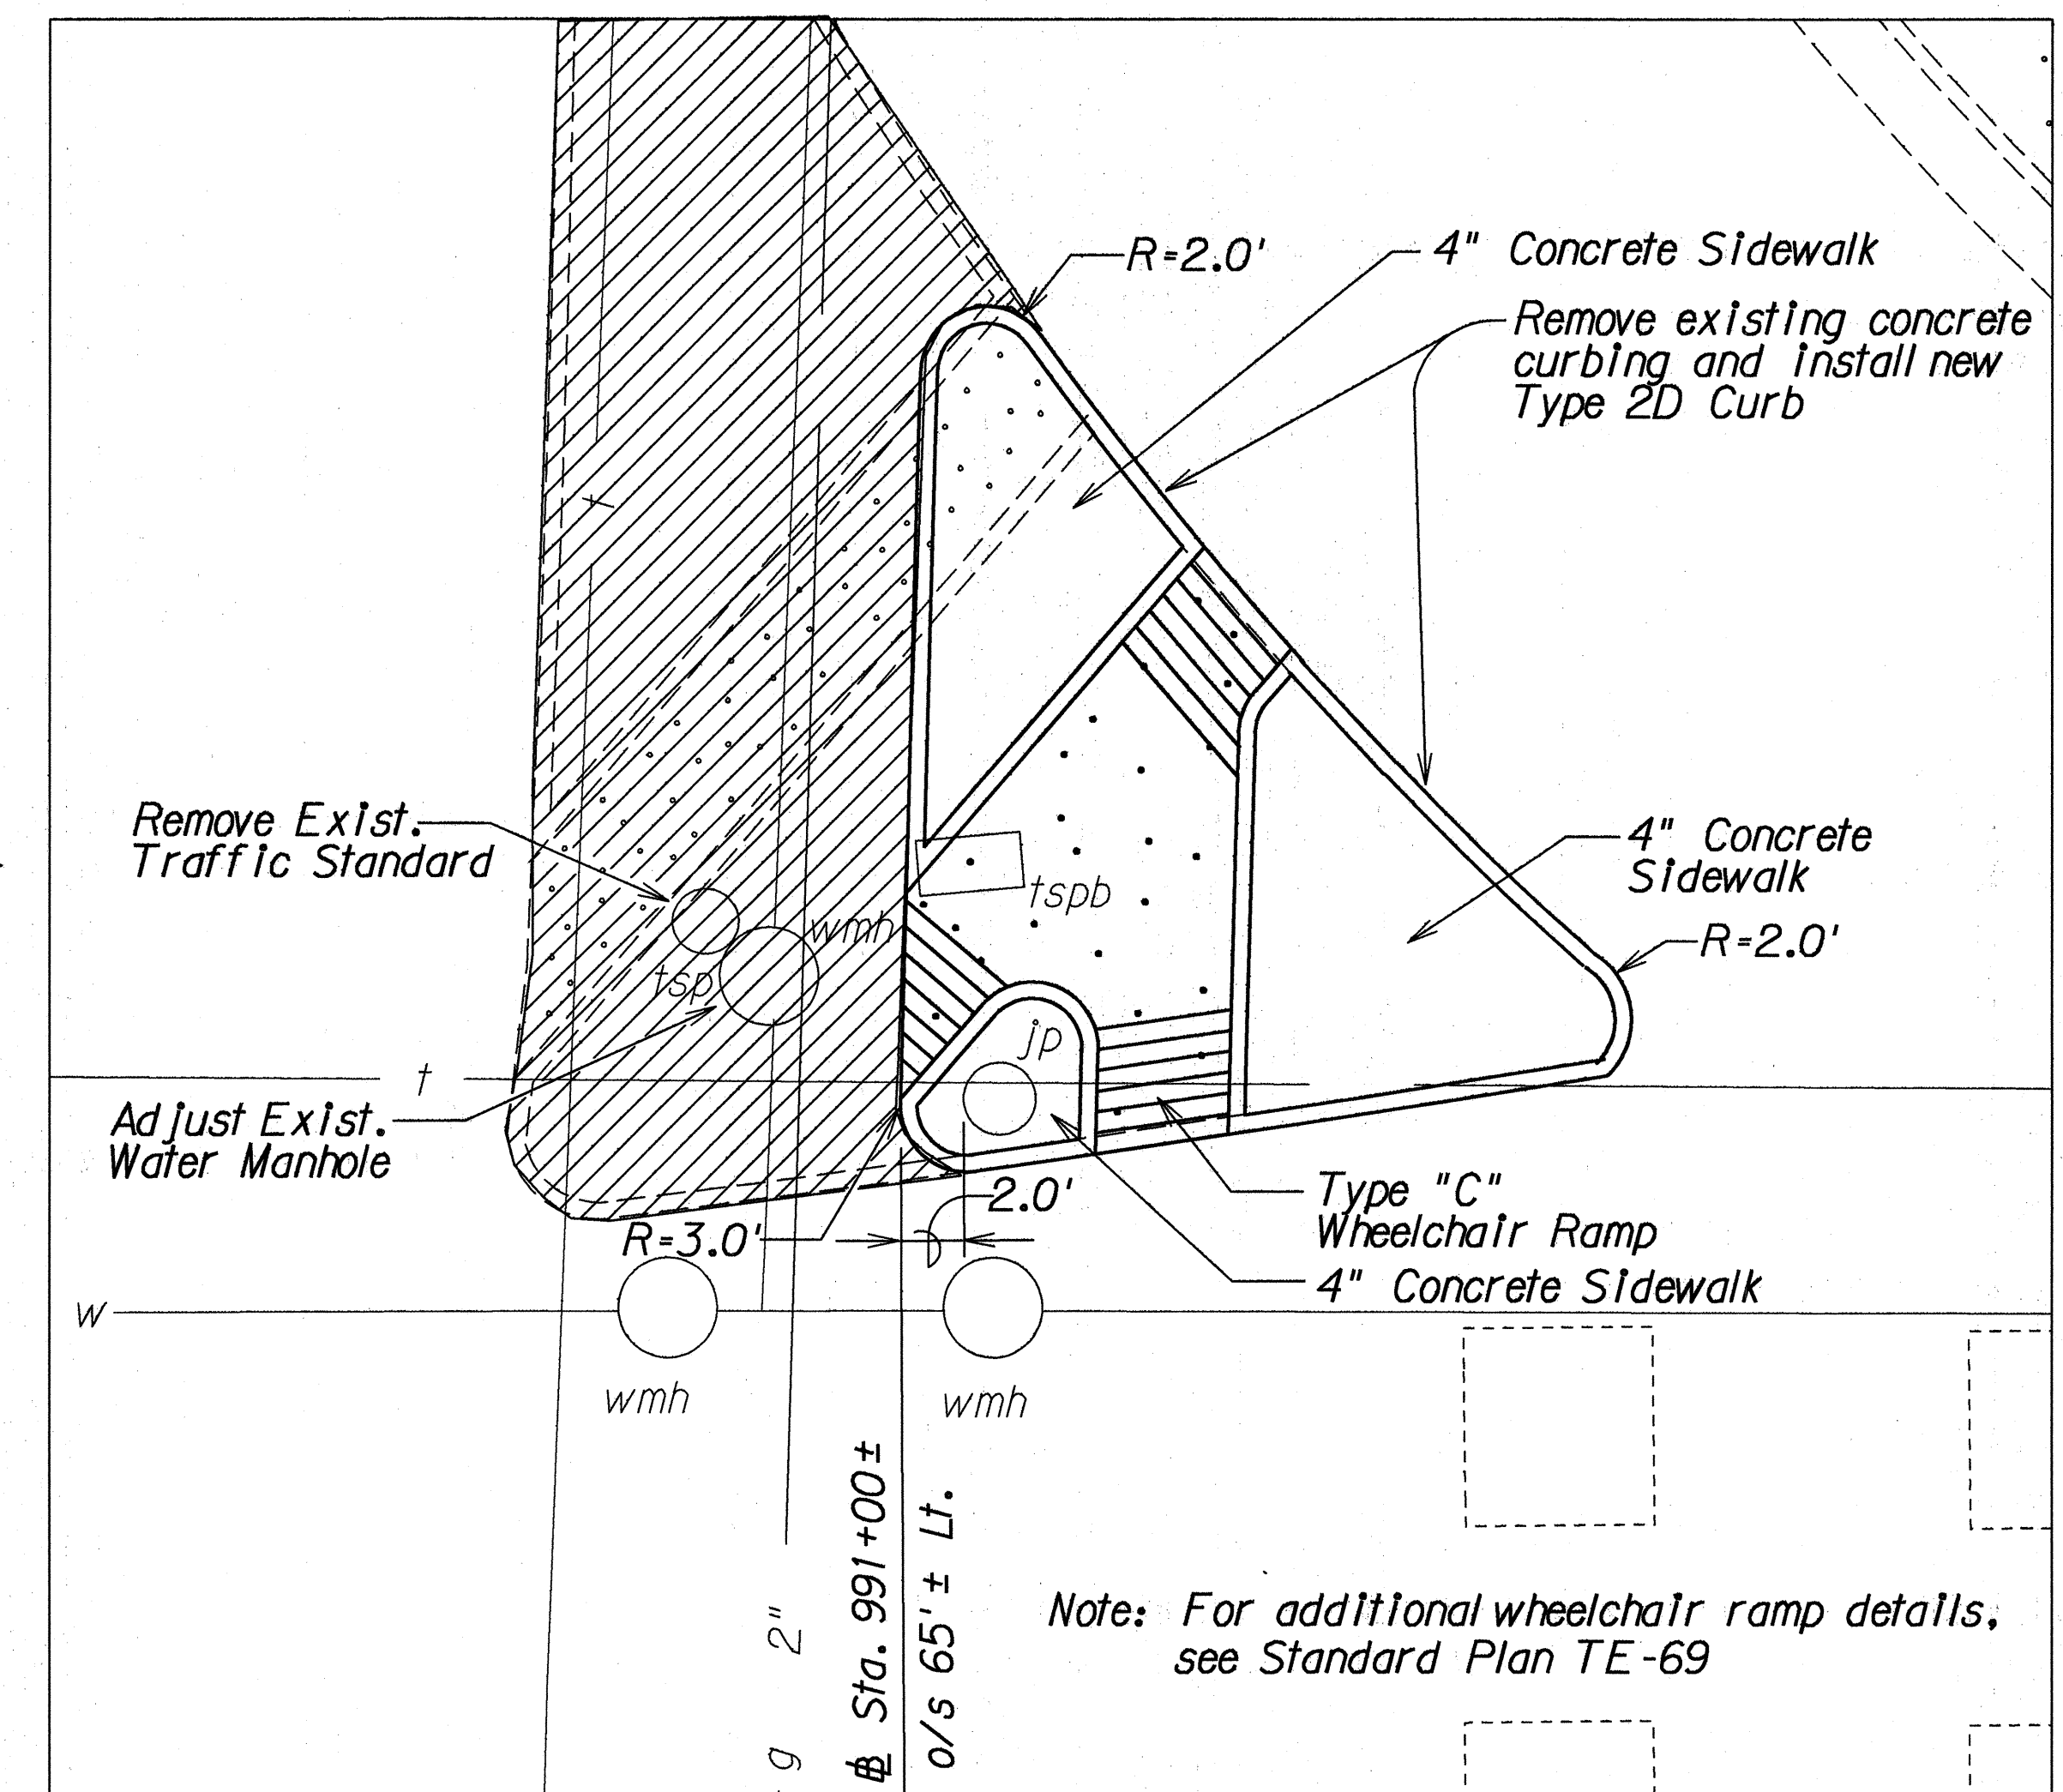

ROADWAY DETAILS AT WAIMANO HOME ROAD


Scale: 1" = 5'-0"

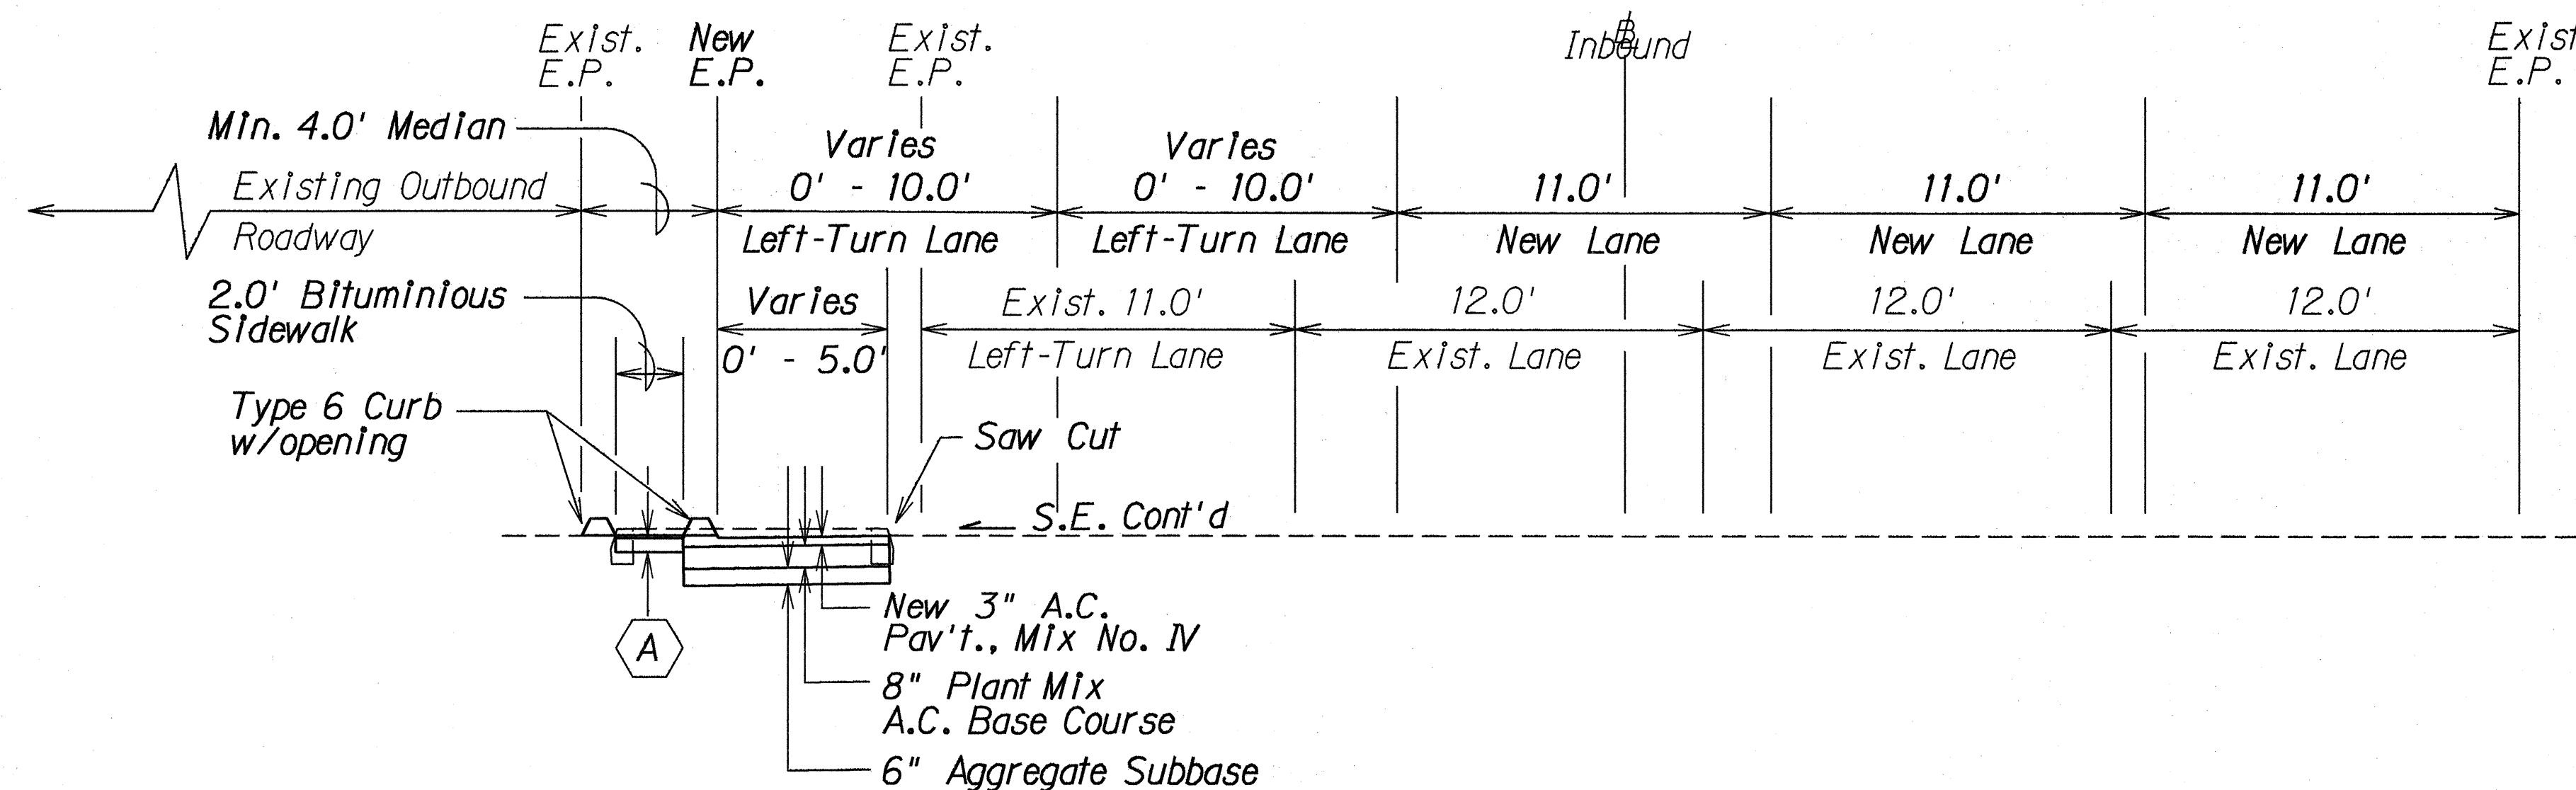

LEFT-TURN LANES NEAR WAIMANO HOME ROAD

Sta. 984+00 ± to Sta. 990+00 ±

Scale: 1/4" = 1'-0"

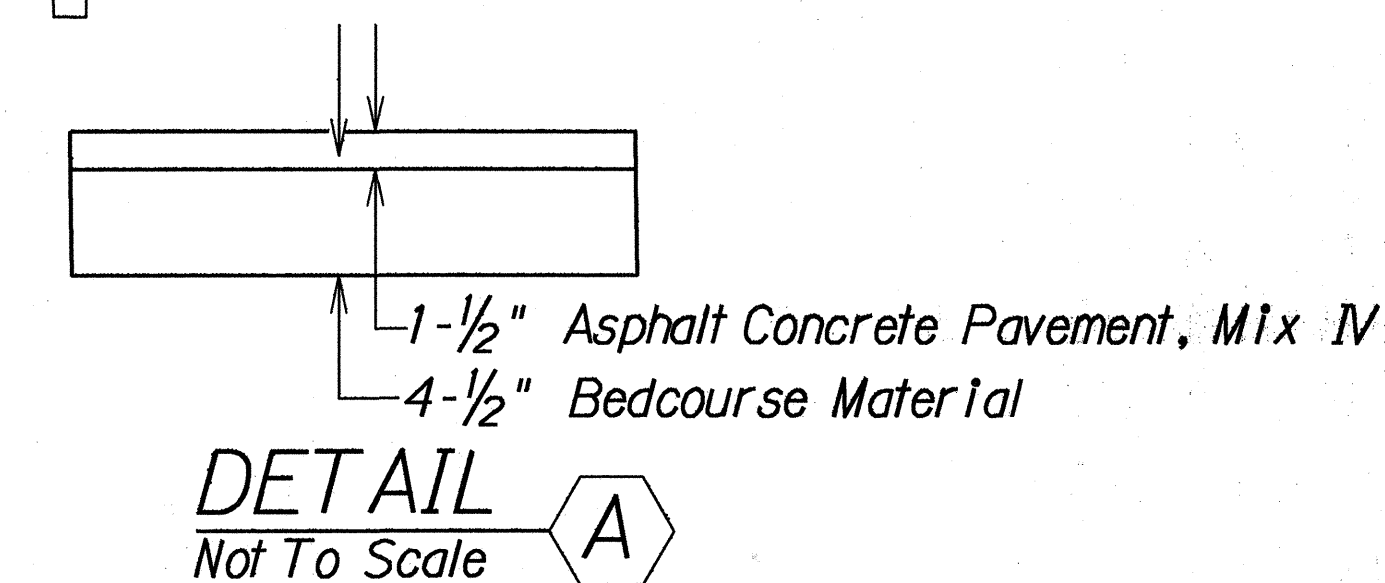

DETAIL A
Not To Scale

STATE OF HAWAII
DEPARTMENT OF TRANSPORTATION
HIGHWAYS DIVISION

TYPICAL SECTIONS & DETAILS
KAMEHAMEHA HIGHWAY
Left-Turn Lane at Waimano Home Road
PROJ. NO. 99D-01-92M

Scale: As Shown Date: Dec., 1991

SHEET No. 1 OF 3 SHEETS