



FED. ROAD DIST. NO.	STATE	FED. AID PROJ. NO.	FISCAL YEAR	SHEET NO.	TOTAL SHEETS
HAWAII	HAW.	STP-099-1(10)	1993	5	26

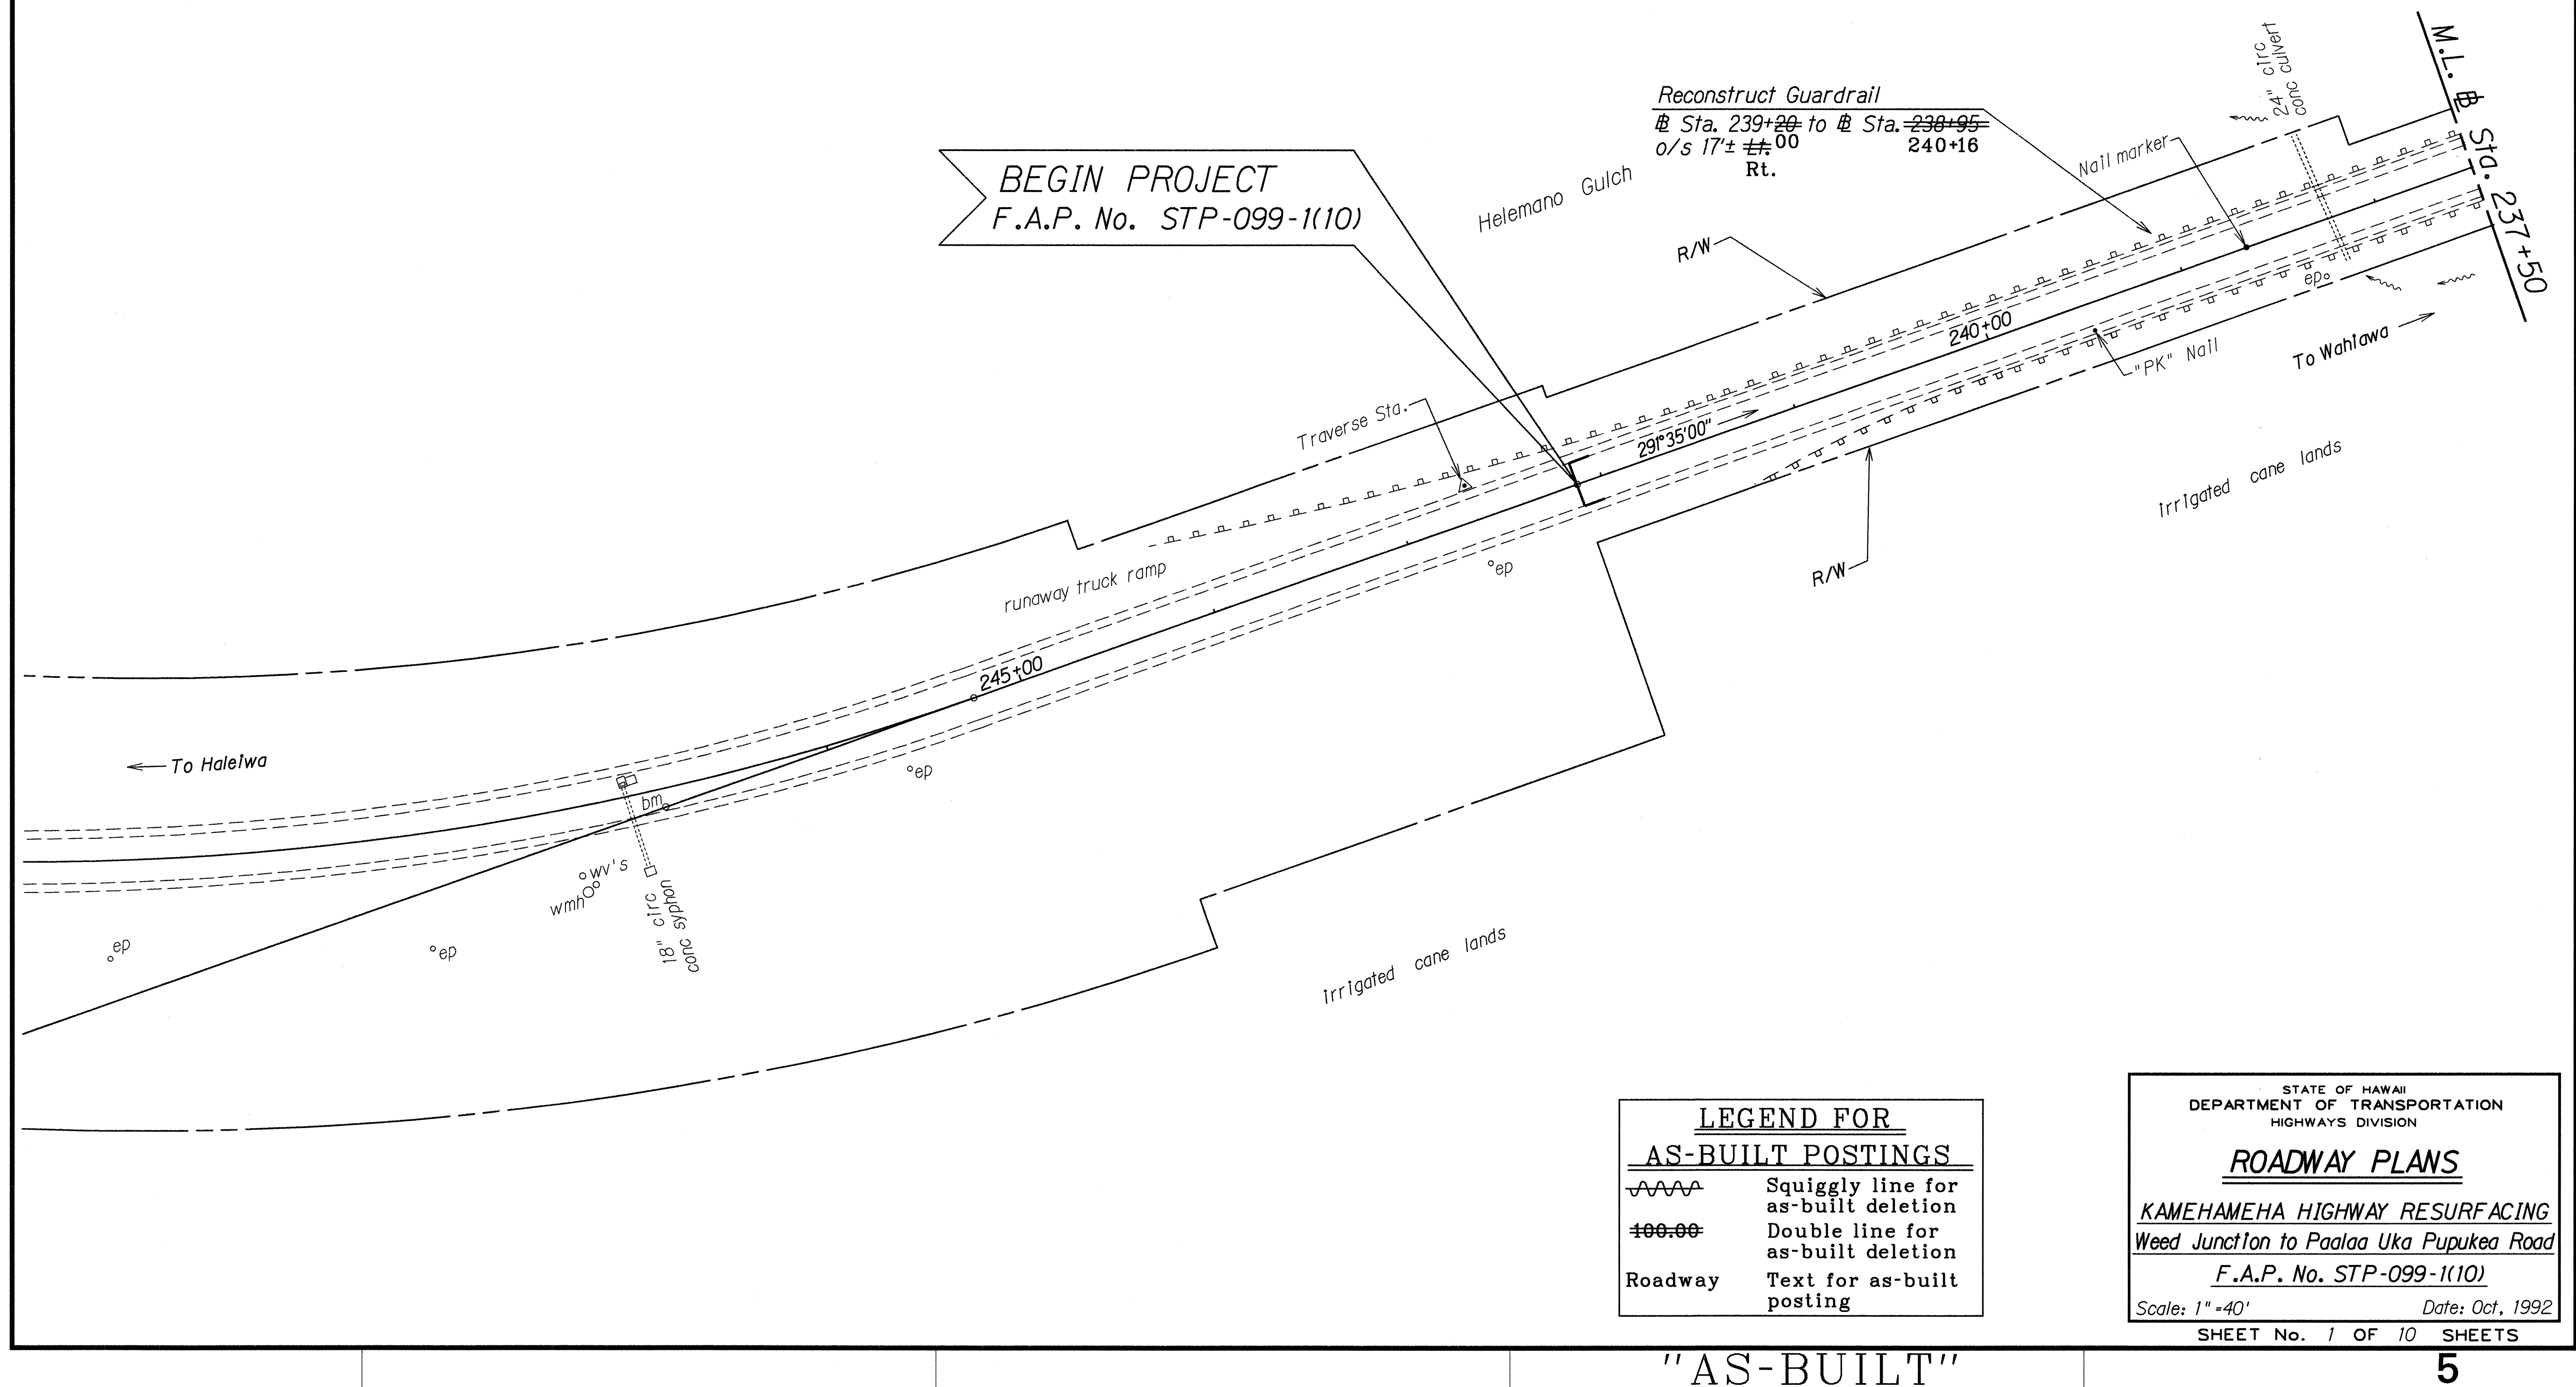

FED. ROAD DIST. NO.	STATE	FED. AID PROJ. NO.	FISCAL YEAR	SHEET NO.	TOTAL SHEETS
HAWAII	HAW.	STP-099-1(10)	1993	6	26

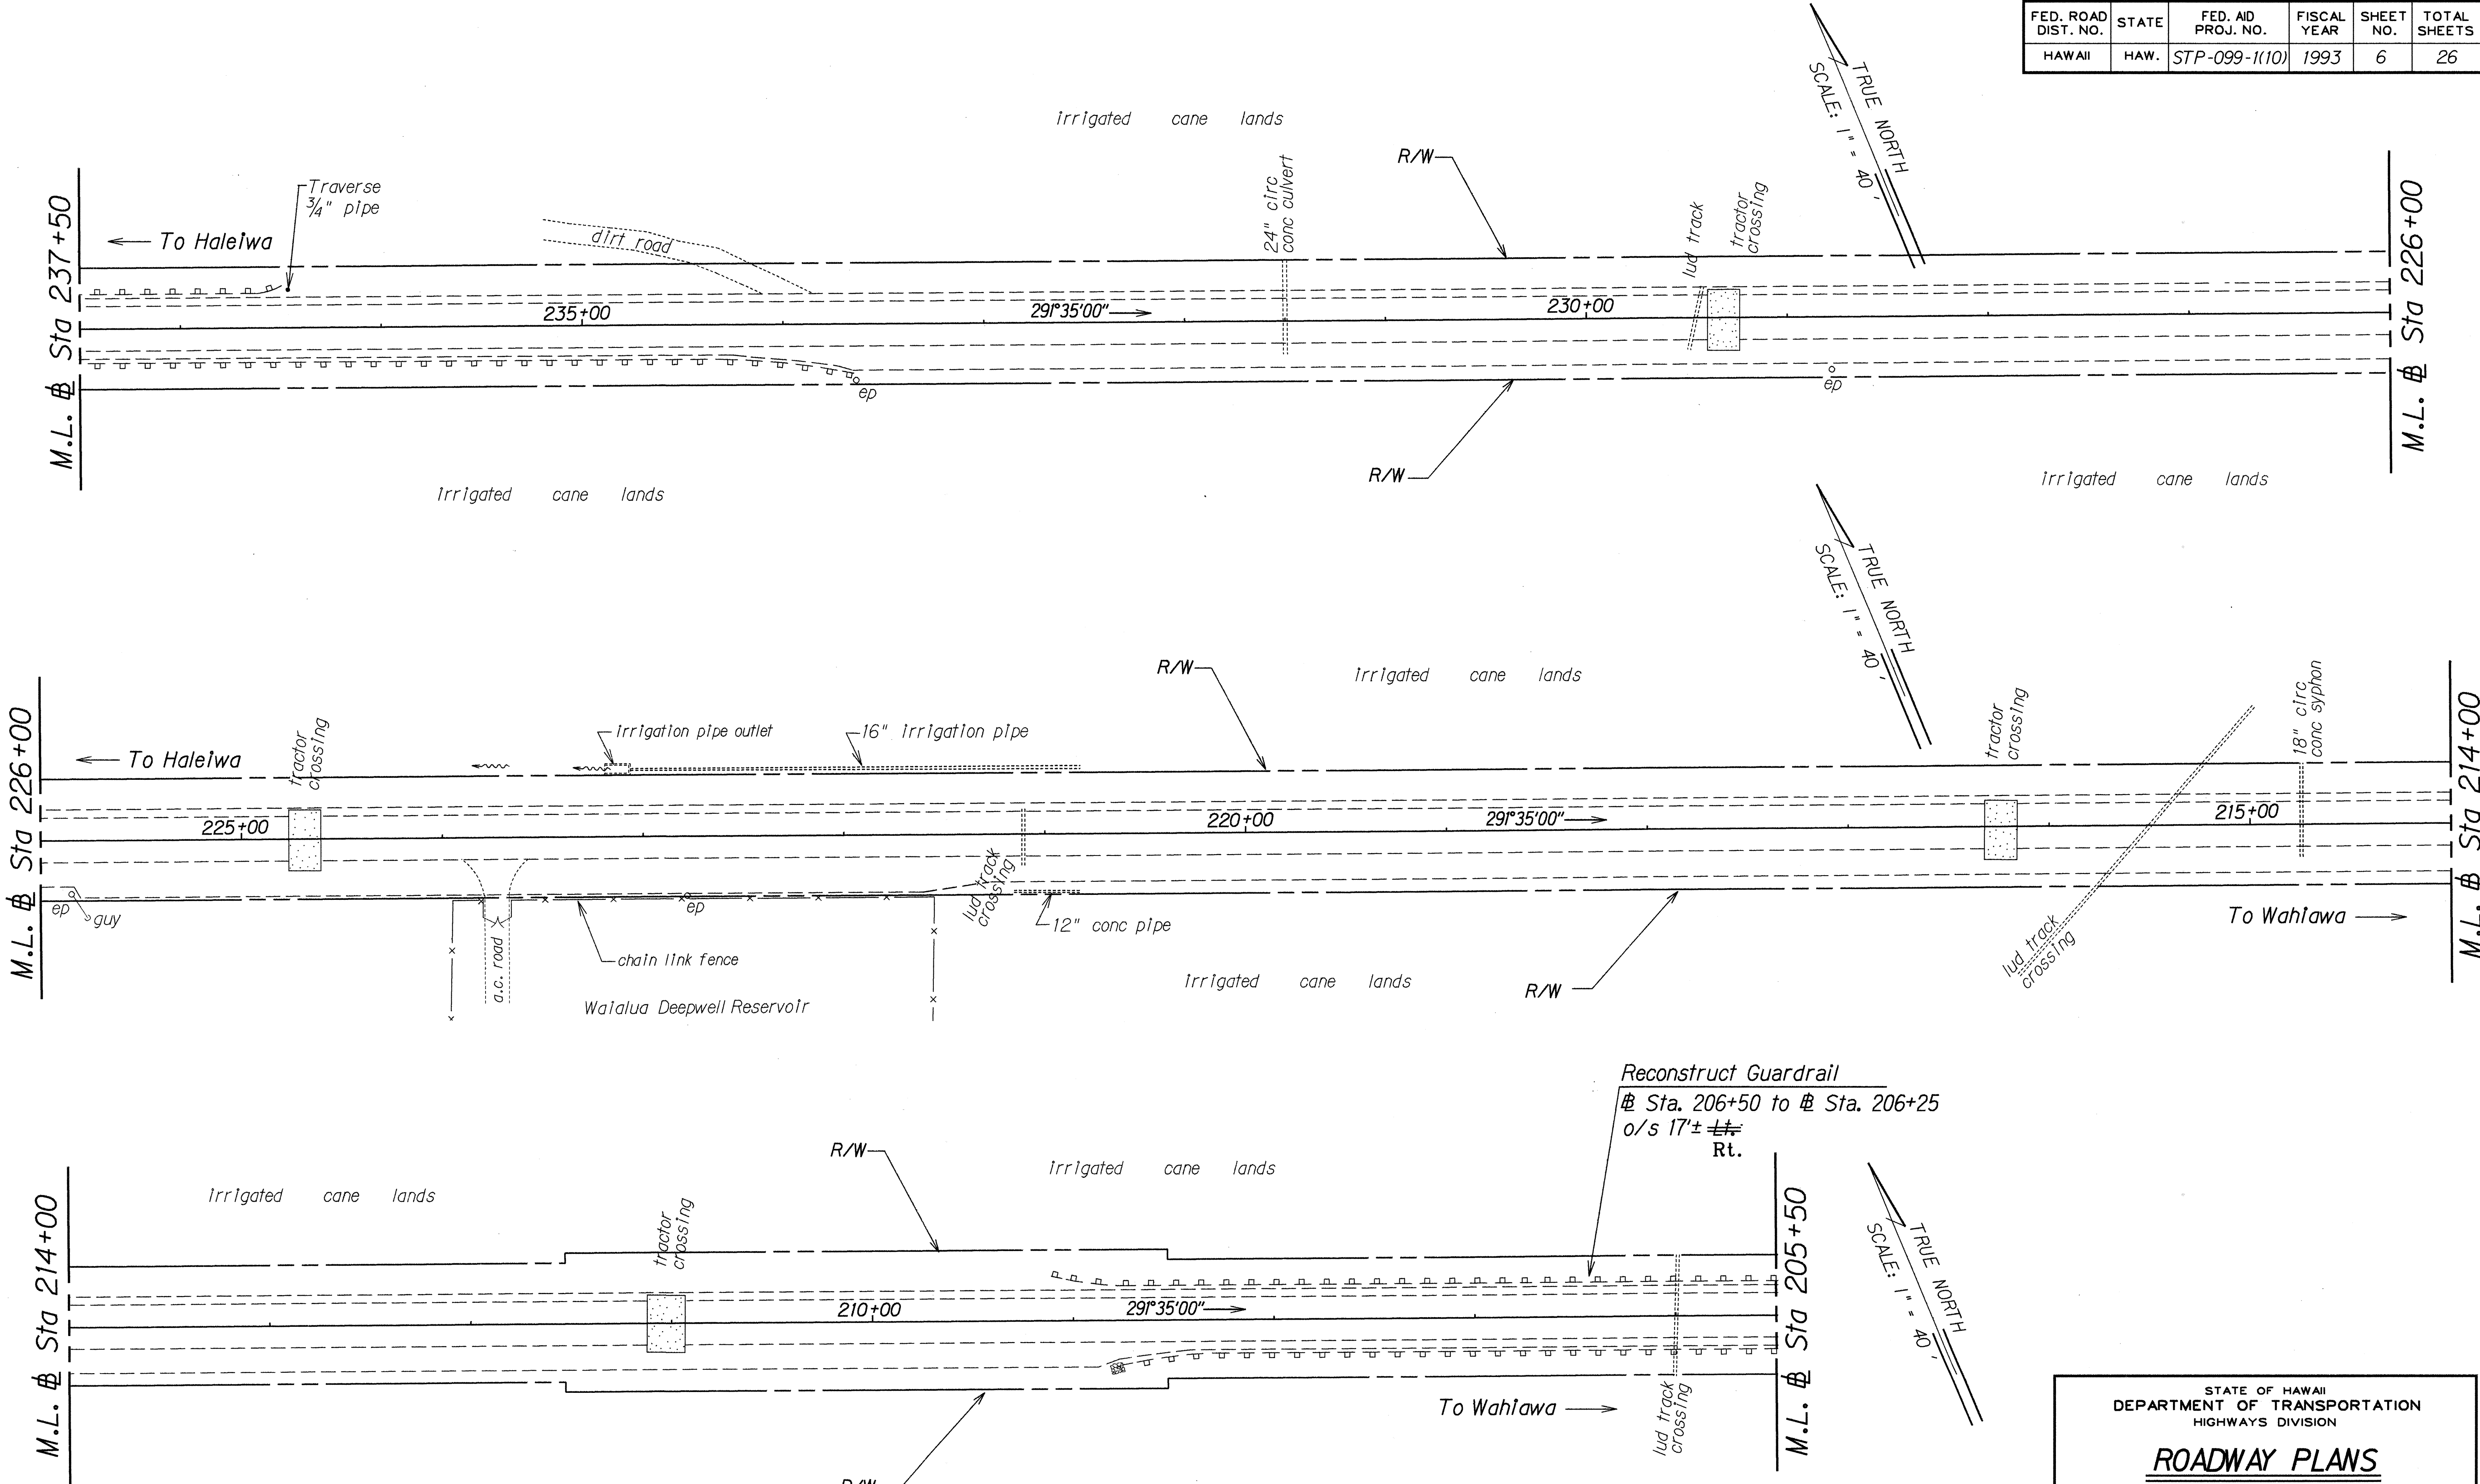

LEGEND FOR AS-BUILT POSTINGS	
	Squiggly line for as-built deletion
	Double line for as-built deletion
Roadway	Text for as-built posting

STATE OF HAWAII
DEPARTMENT OF TRANSPORTATION
HIGHWAYS DIVISION


ROADWAY PLANS
KAMEHAMEHA HIGHWAY RESURFACING
Weed Junction to Paalaa Uka Pupukea Road
F.A.P. No. STP-099-1(10)
Scale: 1" = 40'
Date: Oct, 1992

SHEET No. 2 OF 10 SHEETS

ORIGINAL PLAN	SURVEY PLOTTED BY	DATE
NOTE BOOK	DRAWN BY	
8kamdp2.dgn/ga	DESIGNED BY	
No.	QUANTITIES BY	
	CHECKED BY	

"AS-BUILT"

FED. ROAD DIST. NO.	STATE	FED. AID PROJ. NO.	FISCAL YEAR	SHEET NO.	TOTAL SHEETS
HAWAII	HAW.	STP-099-1(10)	1993	7	26

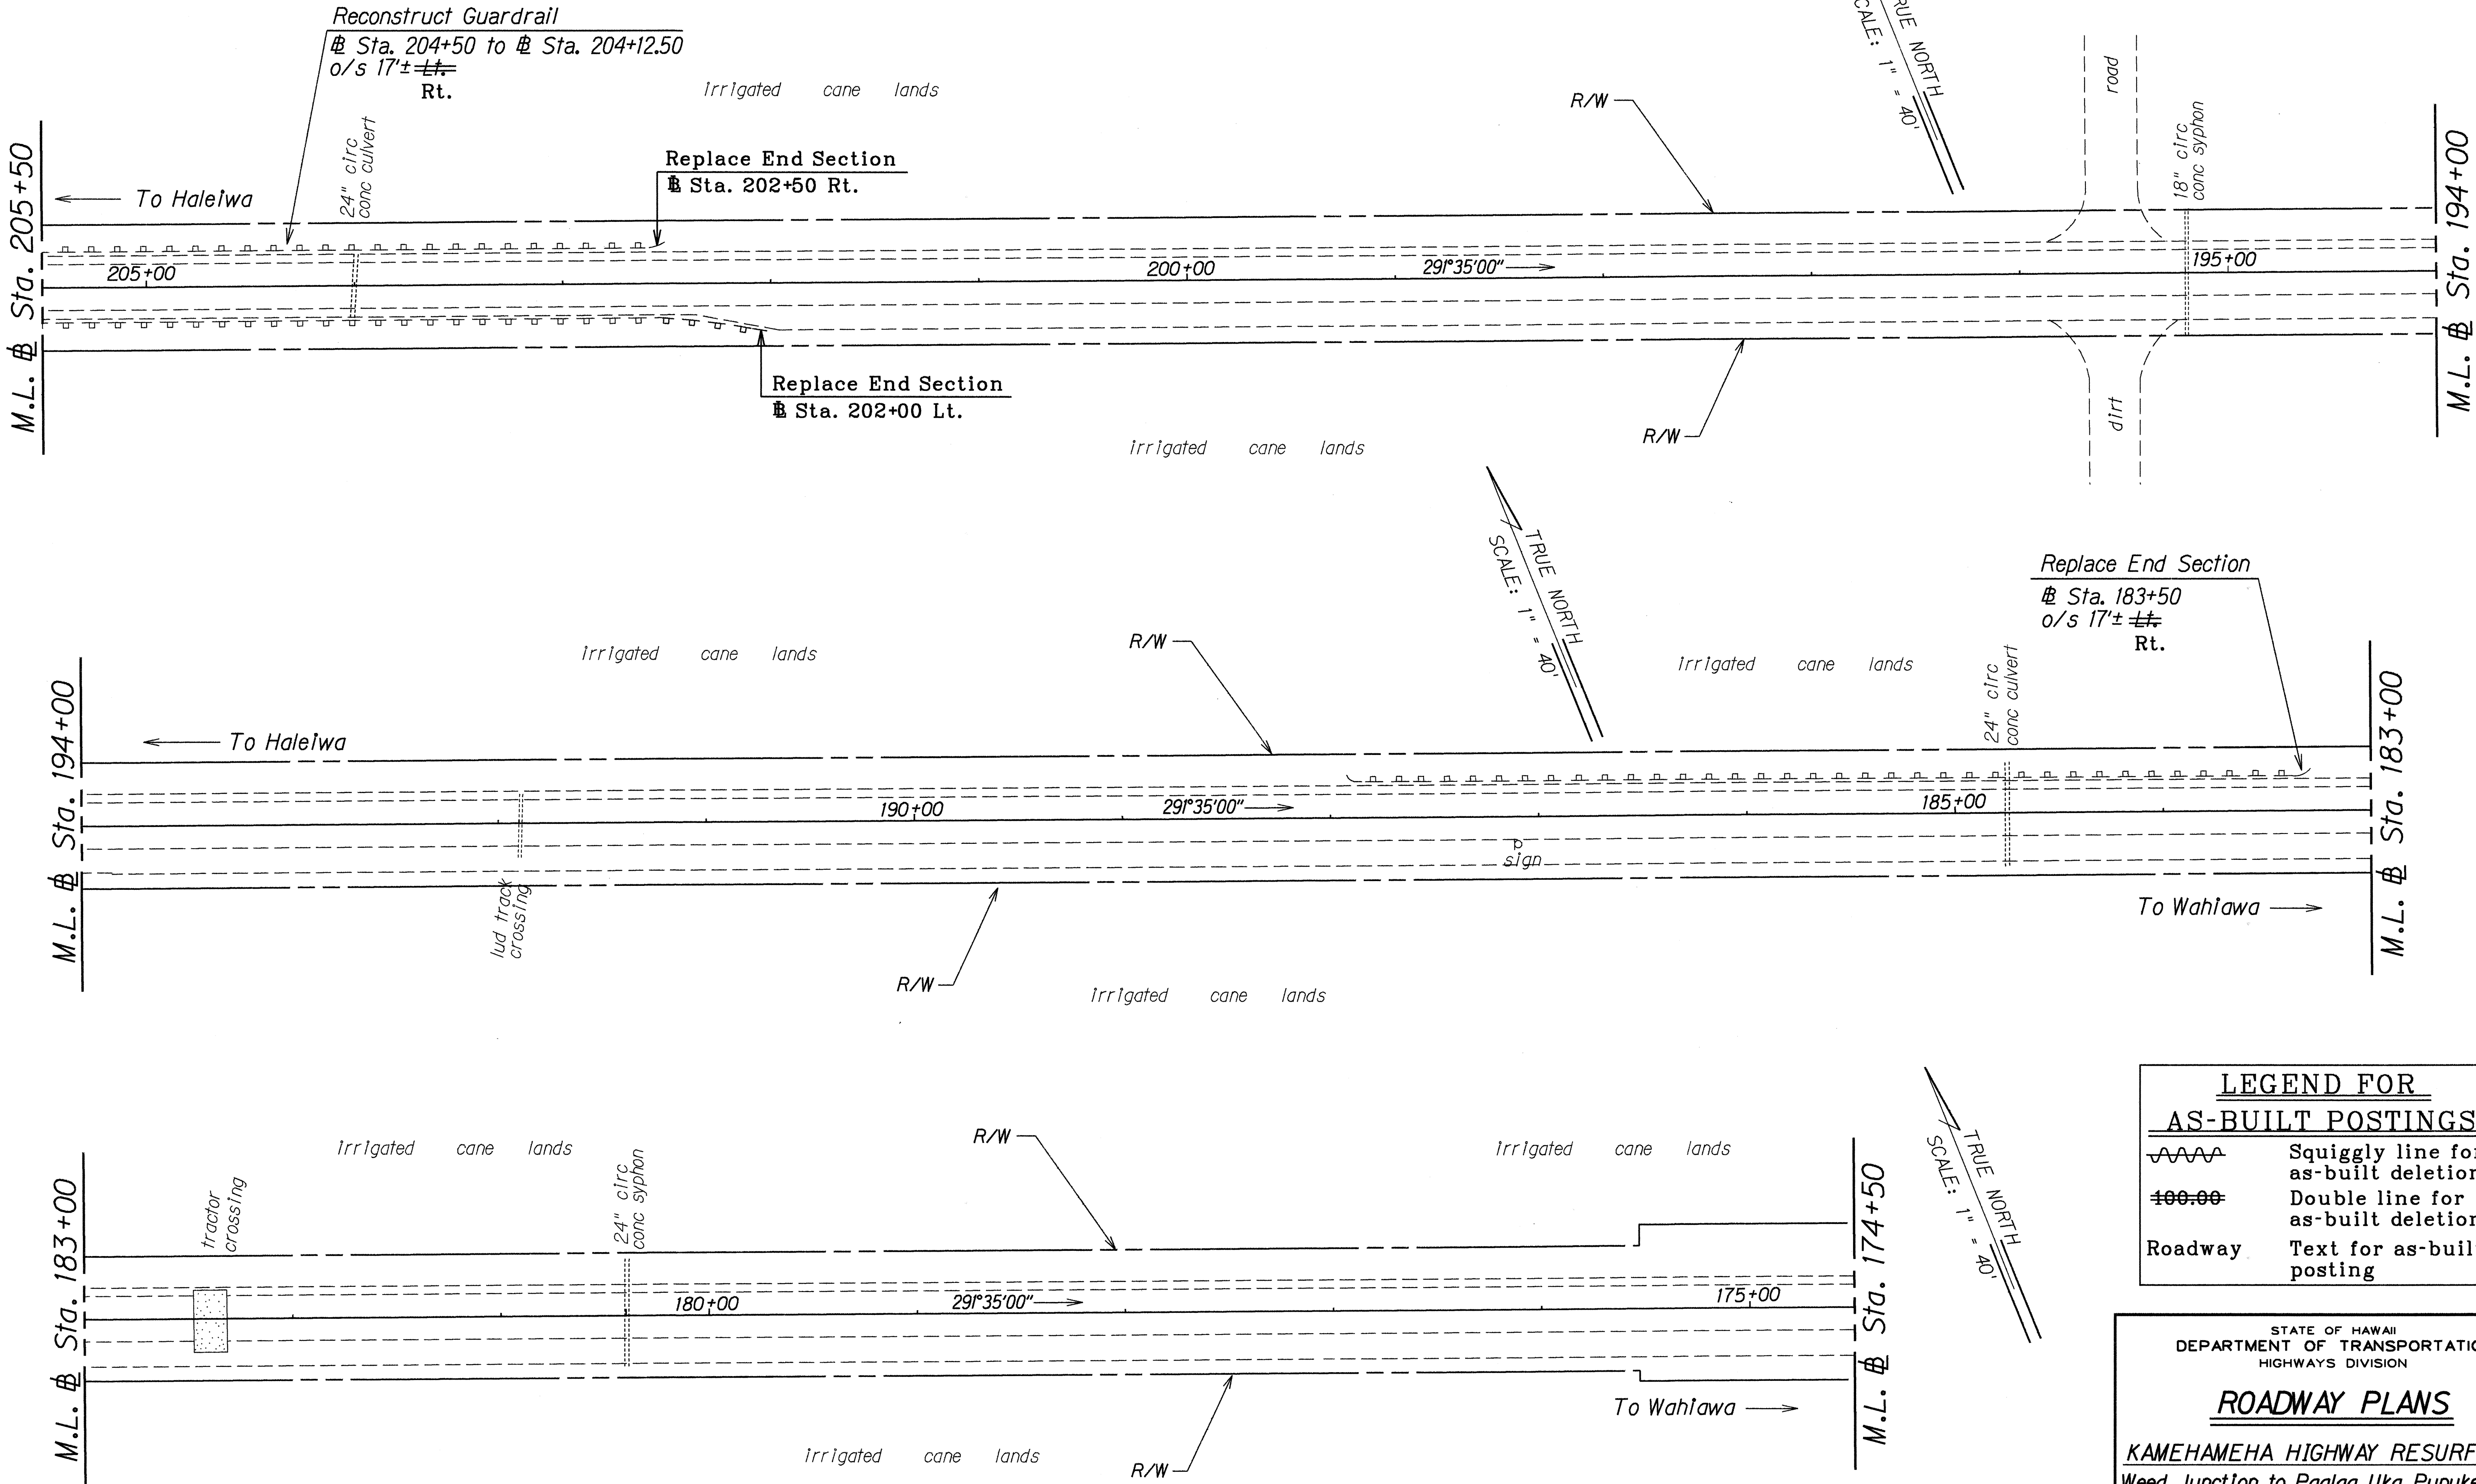

ORIGINAL PLAN	SURVEY PLOTTED BY	DATE
NOTE BOOK	DRAWN BY	
8kamdb3.dgn/qa	DESIGNED BY	
Ne	QUANTITIES BY	
	CHECKED BY	

LEGEND FOR AS-BUILT POSTINGS	
	Squiggly line for as-built deletion
	Double line for as-built deletion
Roadway	Text for as-built posting


STATE OF HAWAII
DEPARTMENT OF TRANSPORTATION
HIGHWAYS DIVISION

ROADWAY PLANS
KAMEHAMEHA HIGHWAY RESURFACING
Weed Junction to Paalaa Uka Pupukea Road
F.A.P. No. STP-099-1(10)
Scale: 1" = 40'

Date: Oct, 1992
SHEET No. 3 OF 10 SHEETS

"AS-BUILT"

FED. ROAD DIST. NO.	STATE	FED. AID PROJ. NO.	FISCAL YEAR	SHEET NO.	TOTAL SHEETS
HAWAII	HAW.	STP-099-1(10)	1993	8	26

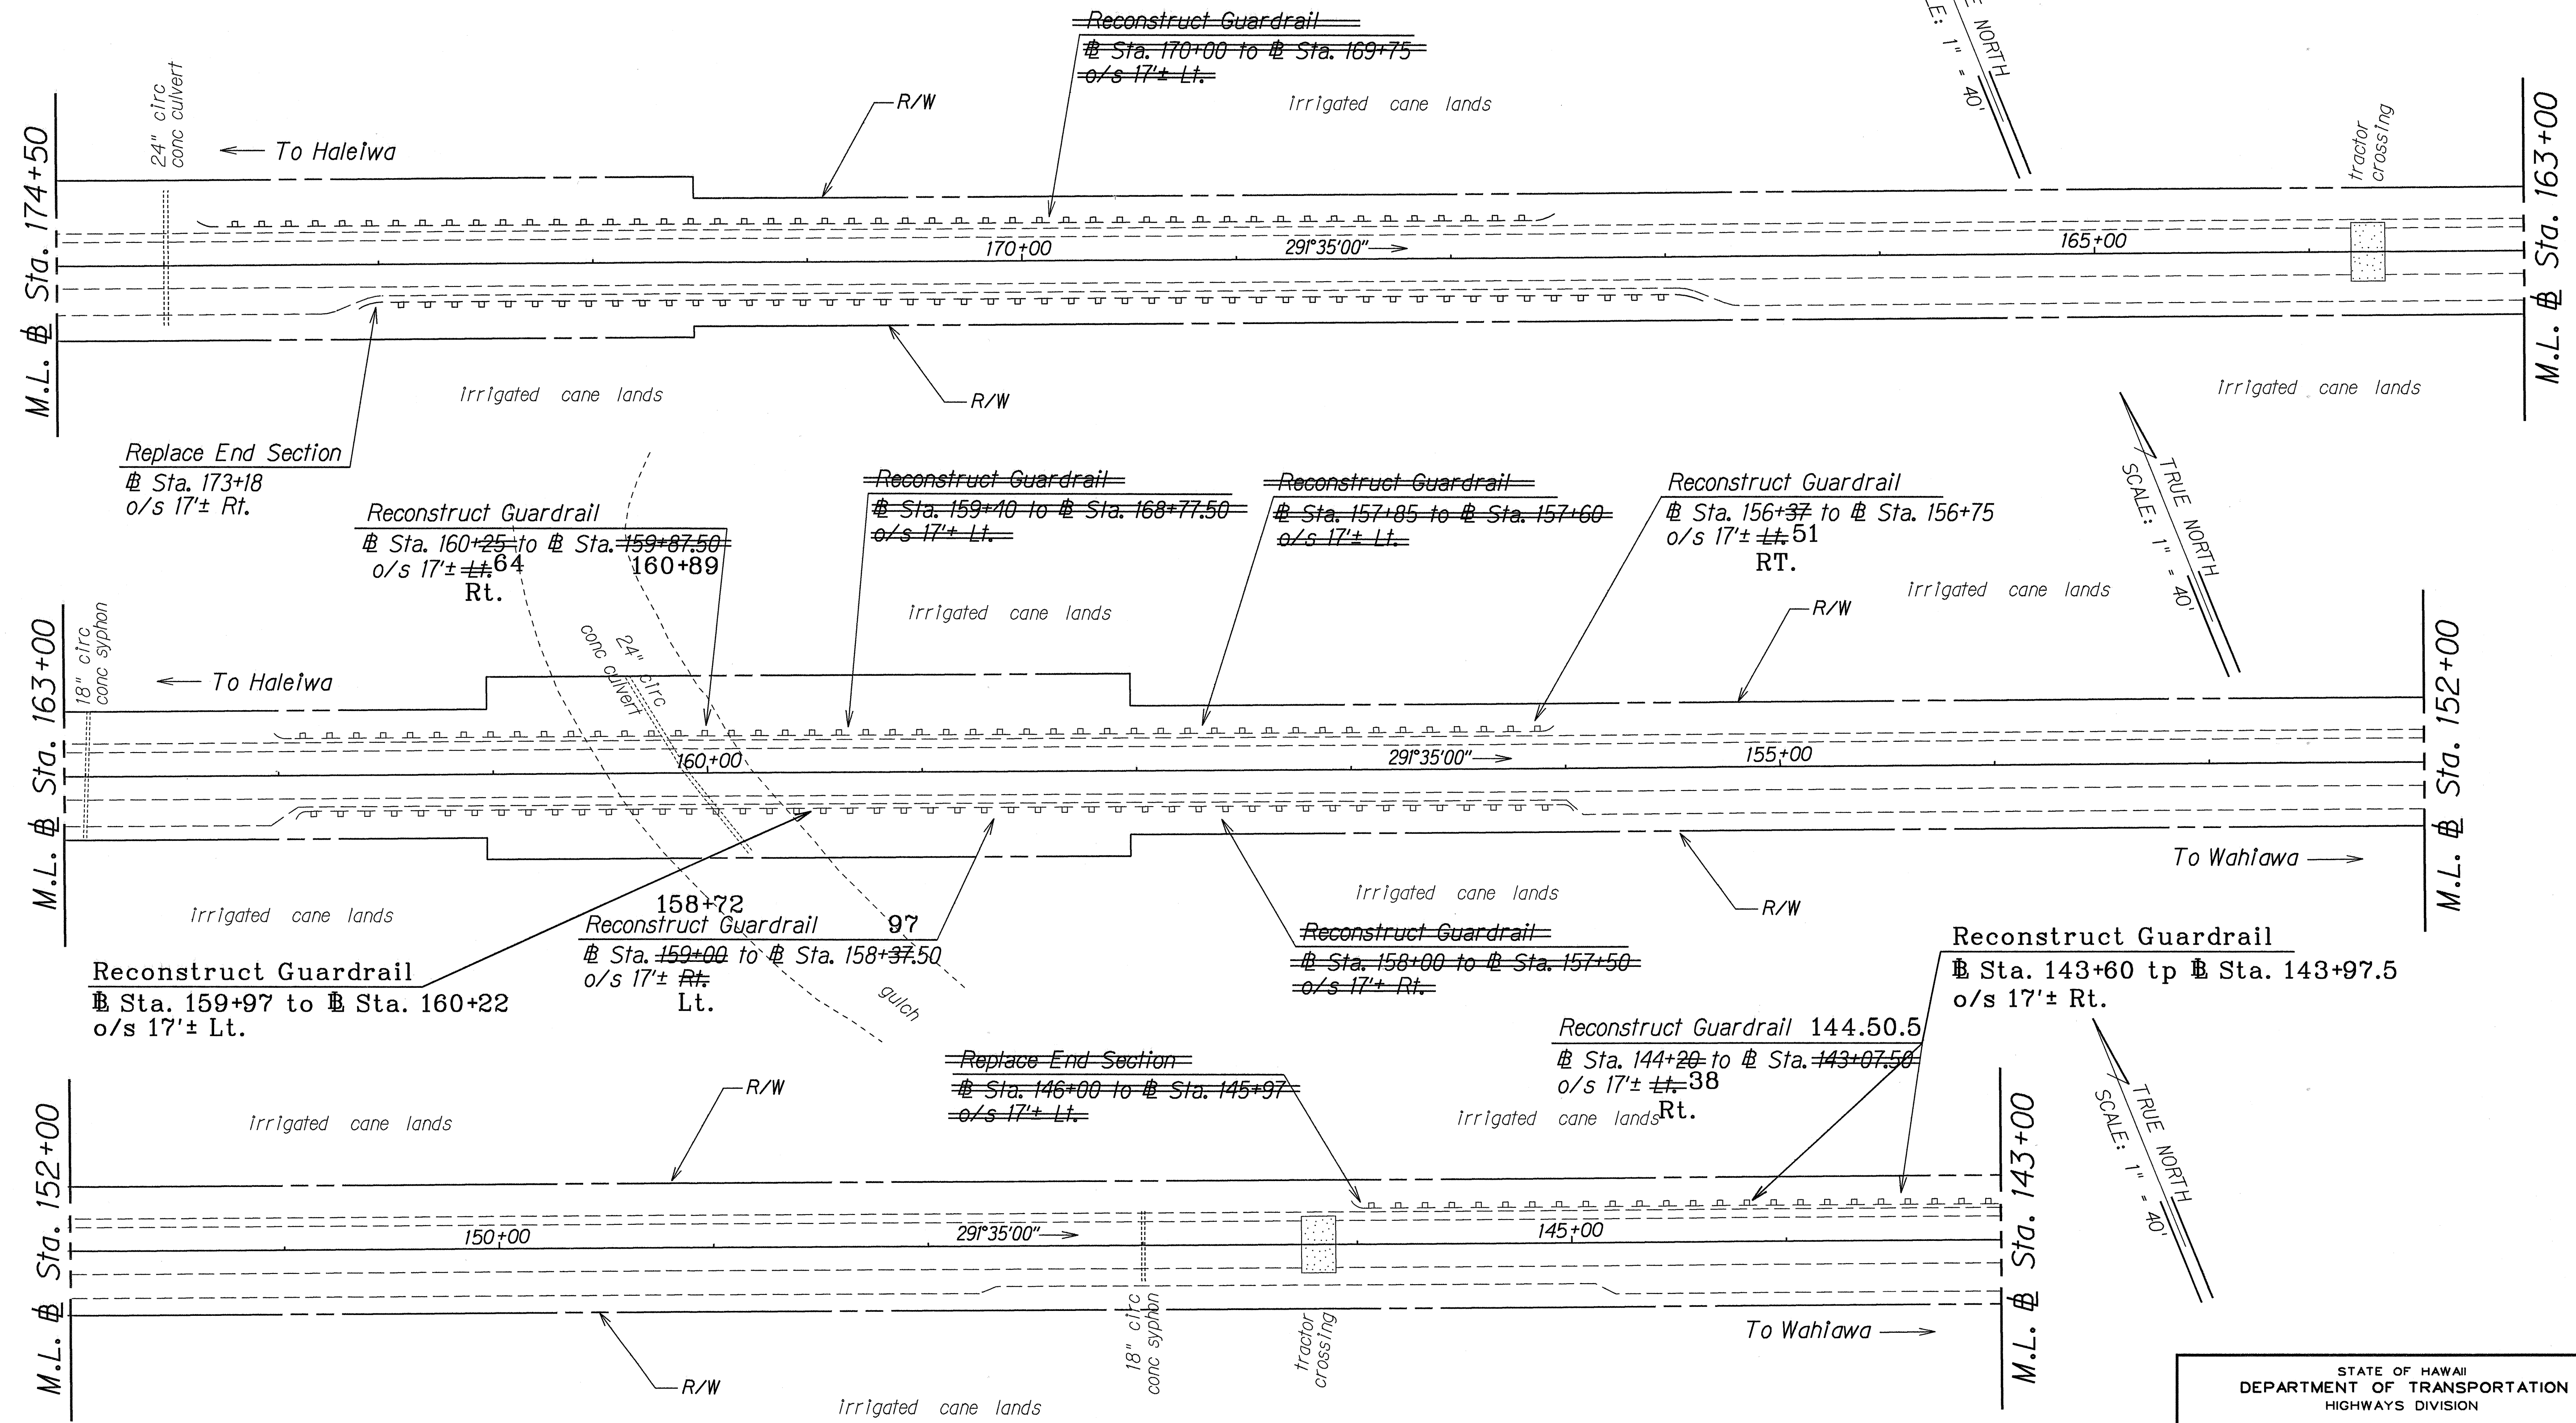

LEGEND FOR AS-BUILT POSTINGS	
	Squiggly line for as-built deletion
	Double line for as-built deletion
	Text for as-built posting

STATE OF HAWAII
DEPARTMENT OF TRANSPORTATION
HIGHWAYS DIVISION

ROADWAY PLANS

KAMEHAMEHA HIGHWAY RESURFACING

Weed Junction to Paalaa Uka Pupukea Road


F.A.P. No. STP-099-1(10)

Scale: 1" = 40' Date: Oct, 1992

SHEET No. 4 OF 10 SHEETS

"AS-BUILT"

FED. ROAD DIST. NO.	STATE	FED. AID PROJ. NO.	FISCAL YEAR	SHEET NO.	TOTAL SHEETS
HAWAII	HAW.	STP-099-1(10)	1993	9	26

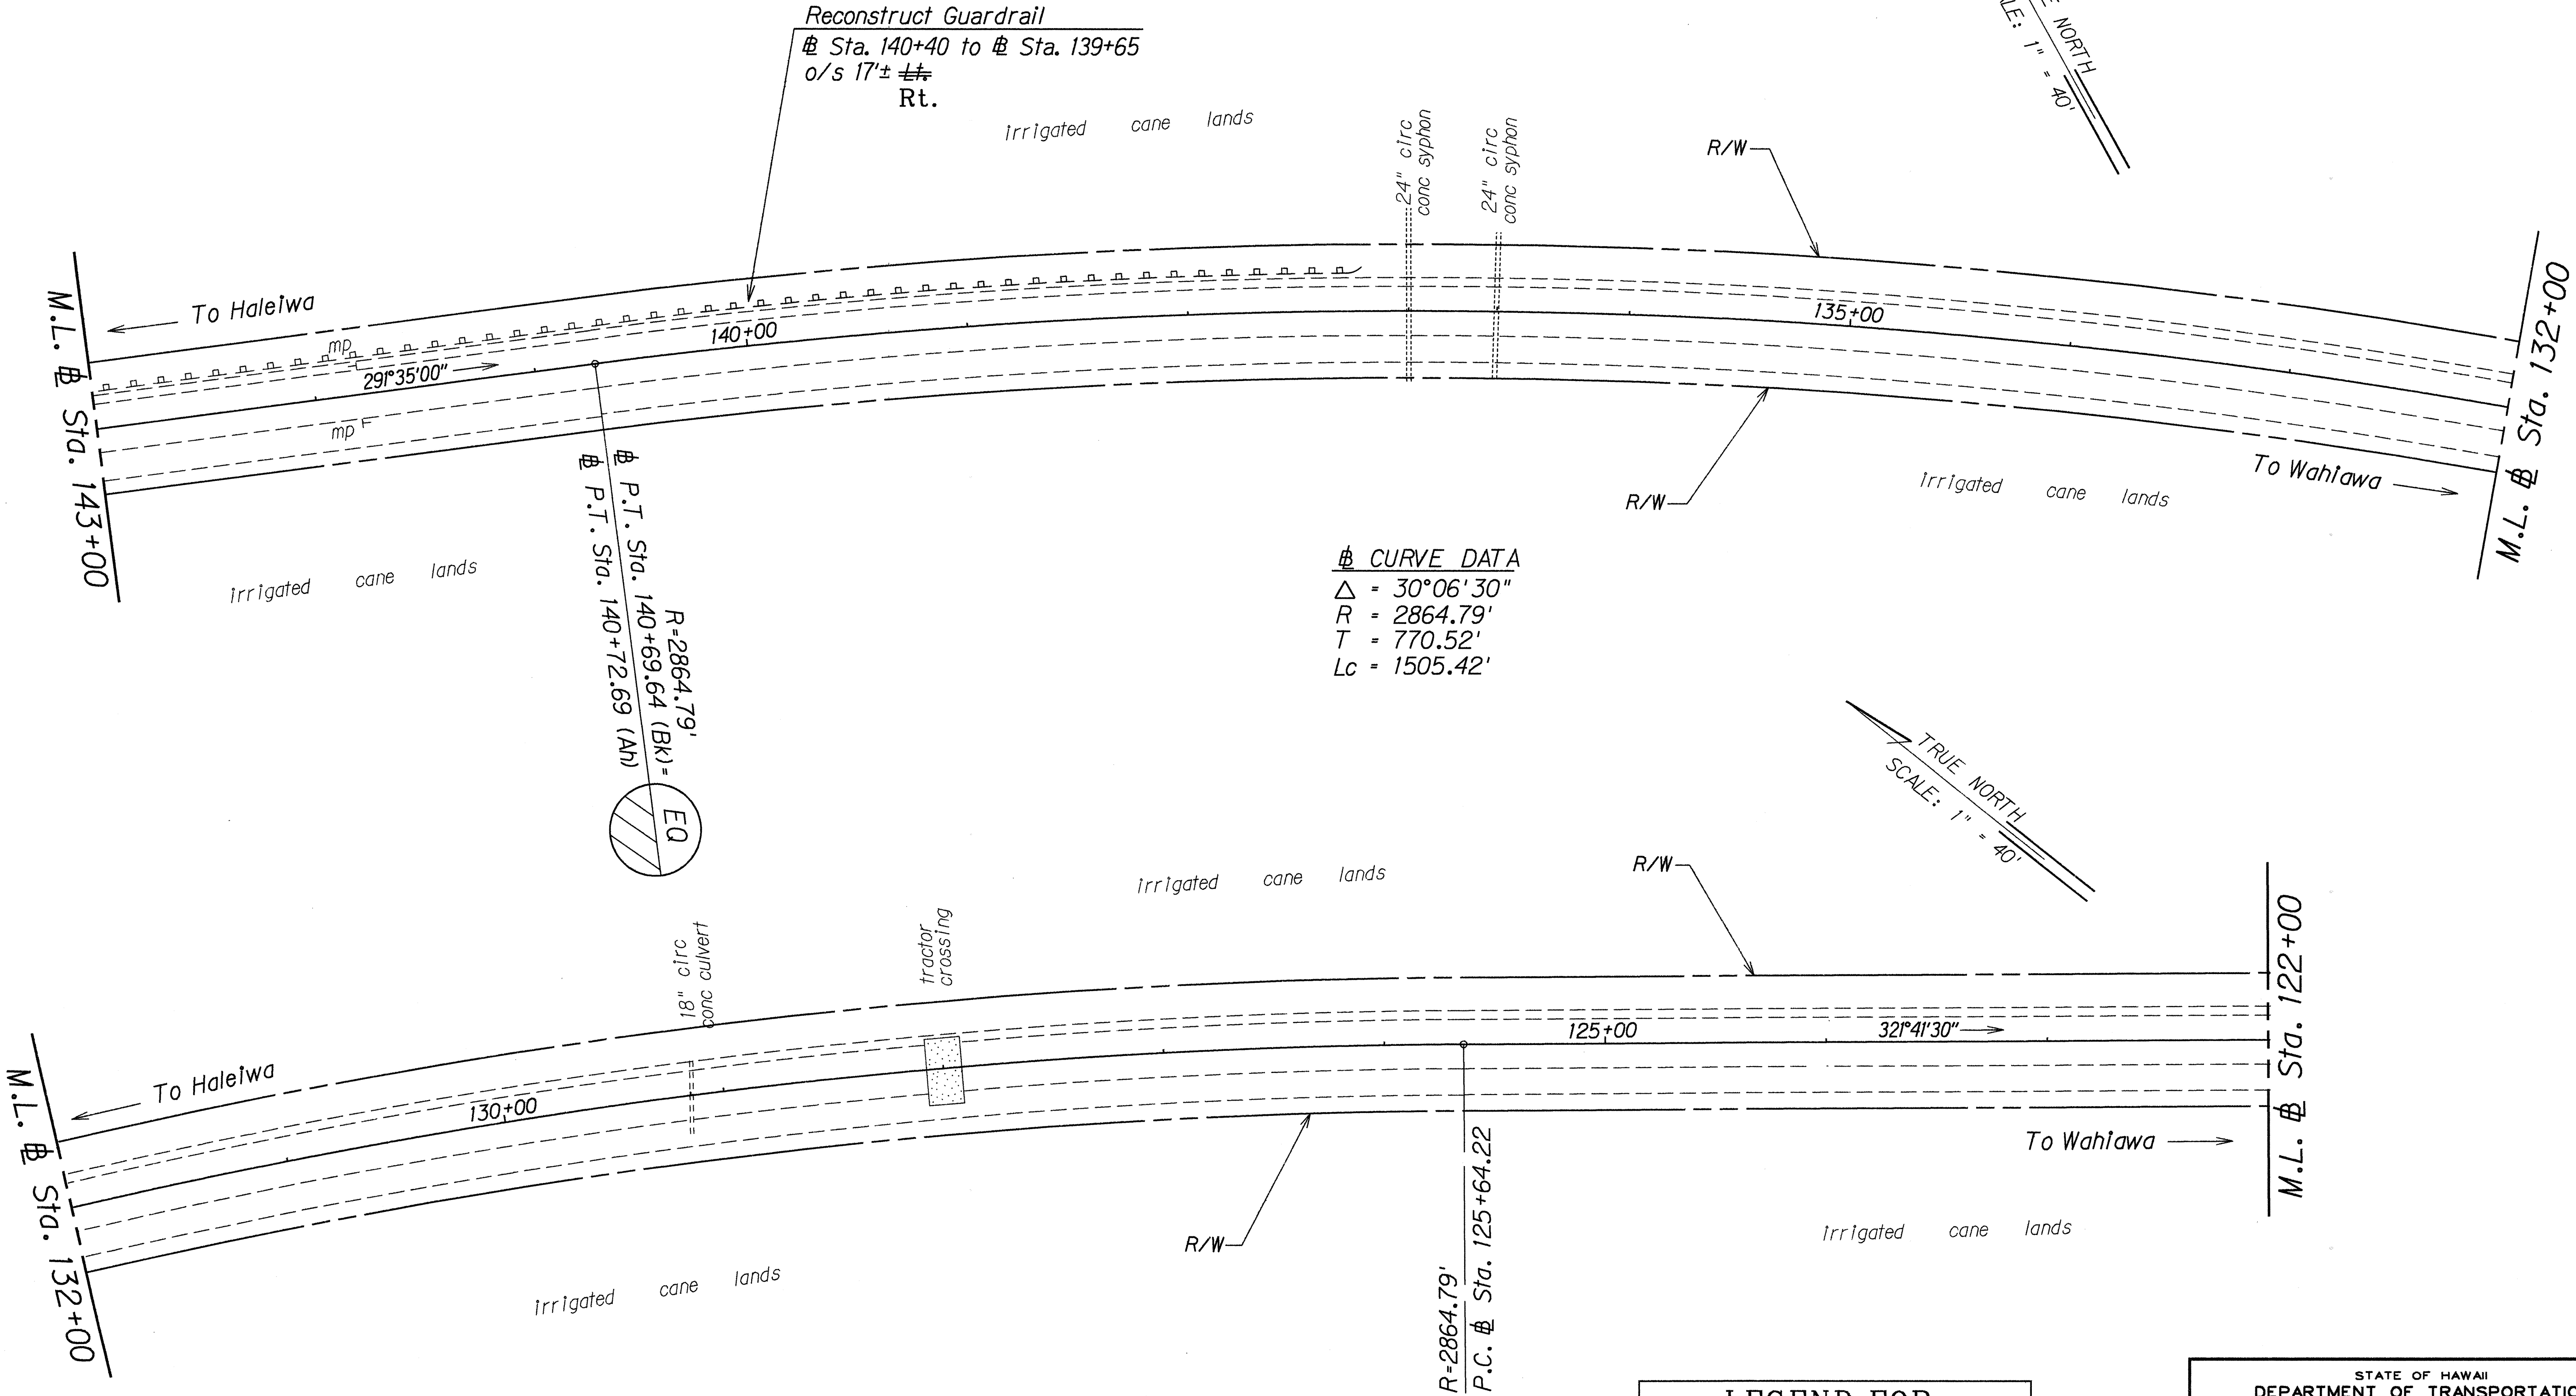

Δ CURVE DATA
Δ = 30°06'30"
R = 2864.79'
T = 770.52'
Lc = 1505.42'

LEGEND FOR AS-BUILT POSTINGS	
	Squiggly line for as-built deletion
	Double line for as-built deletion
Roadway	Text for as-built posting

STATE OF HAWAII
DEPARTMENT OF TRANSPORTATION
HIGHWAYS DIVISION

ROADWAY PLANS

KAMEHAMEHA HIGHWAY RESURFACING
Weed Junction to Paalaa Uka Pupukea Road
F.A.P. No. STP-099-1(10)


Scale: 1"=40' Date: Oct, 1992

SHEET No. 5 OF 10 SHEETS

"AS-BUILT"

ORIGINAL PLAN	SURVEY PLOTTED BY	DATE
NOTE BOOK	DRAWN BY	
8kamdp5.dgn/ga	DESIGNED BY	
No.	QUANTITIES BY	
	CHECKED BY	

FED. ROAD DIST. NO.	STATE	FED. AID PROJ. NO.	FISCAL YEAR	SHEET NO.	TOTAL SHEETS
HAWAII	HAW.	STP-099-1(10)	1993	10	26

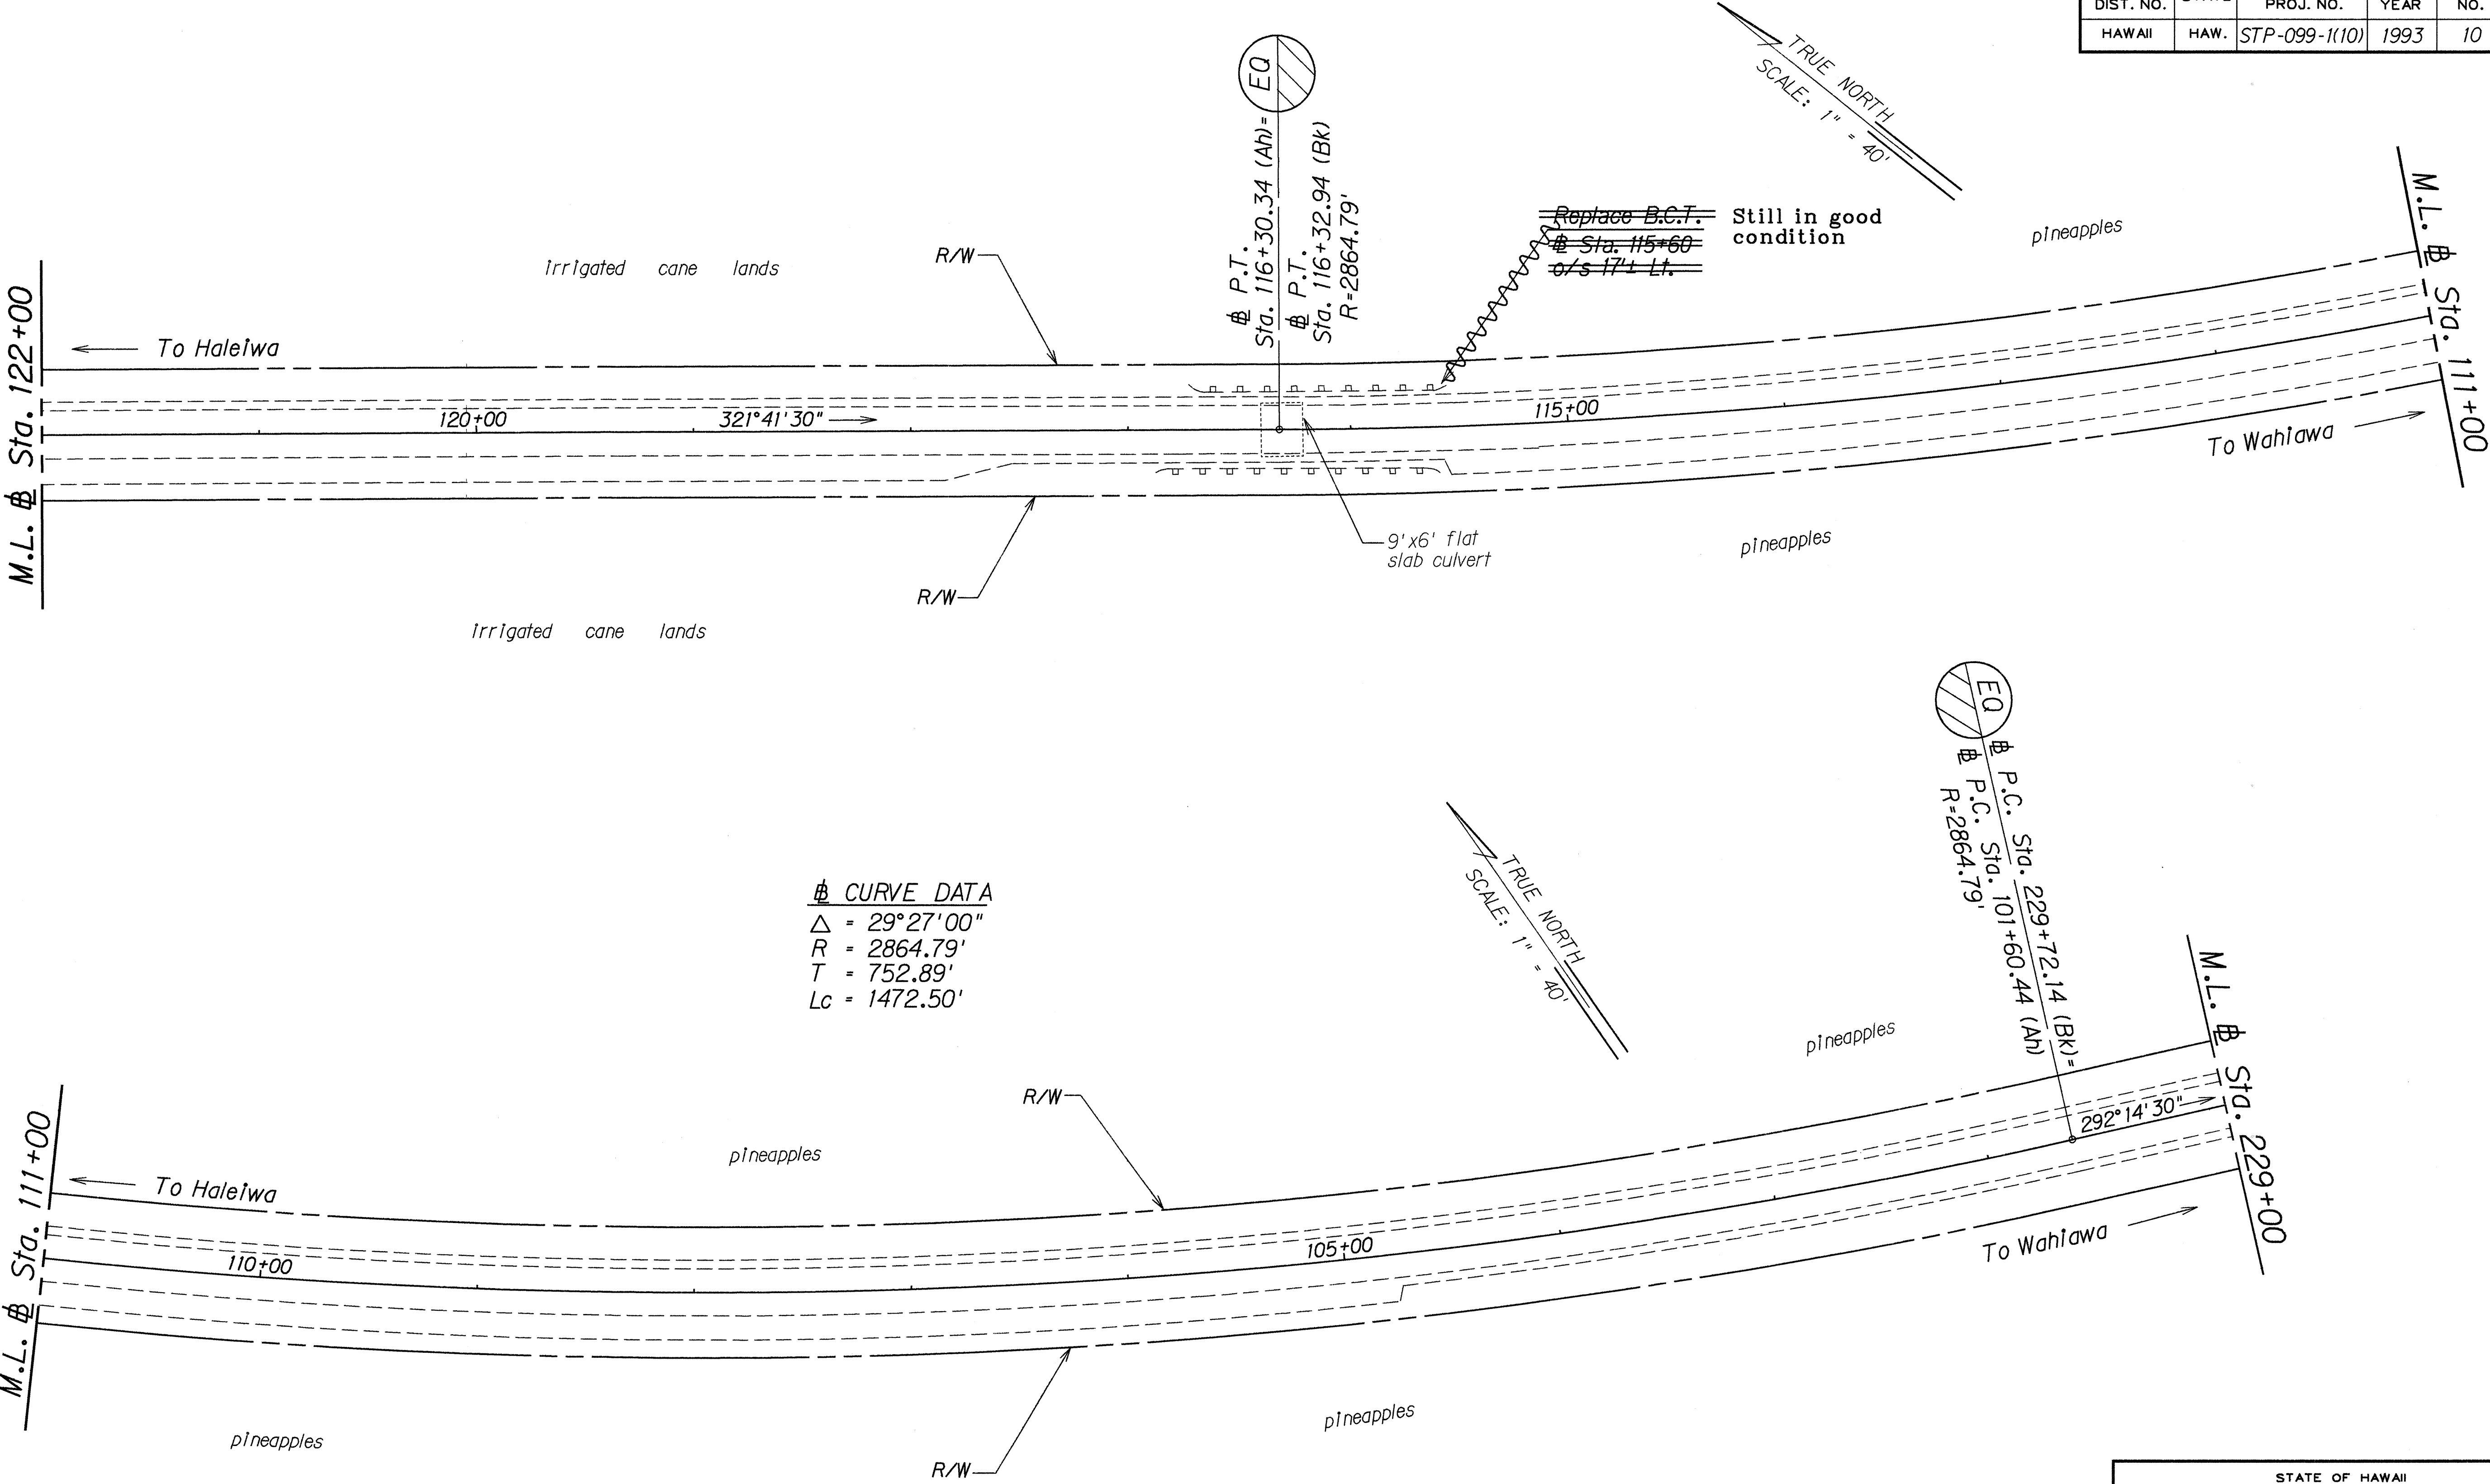

Δ CURVE DATA
Δ = 29°27'00\"
R = 2864.79'
T = 752.89'
Lc = 1472.50'

LEGEND FOR AS-BUILT POSTINGS	
	Squiggly line for as-built deletion
	Double line for as-built deletion
Roadway	Text for as-built posting

STATE OF HAWAII
DEPARTMENT OF TRANSPORTATION
HIGHWAYS DIVISION

ROADWAY PLANS

KAMEHAMEHA HIGHWAY RESURFACING
Weed Junction to Paalaa Uka Pupukea Road
F.A.P. No. STP-099-1(10)


Scale: 1" = 40' Date: Oct, 1992

SHEET No. 6 OF 10 SHEETS

"AS-BUILT"

ORIGINAL PLAN	SURVEY PLOTTED BY	DATE
NOTE BOOK	DRAWN BY	
8kamdp6.dgn/ga	DESIGNED BY	
No.	QUANTITIES BY	
	CHECKED BY	

FED. ROAD DIST. NO.	STATE	FED. AID PROJ. NO.	FISCAL YEAR	SHEET NO.	TOTAL SHEETS
HAWAII	HAW.	STP-099-1(10)	1993	11	26

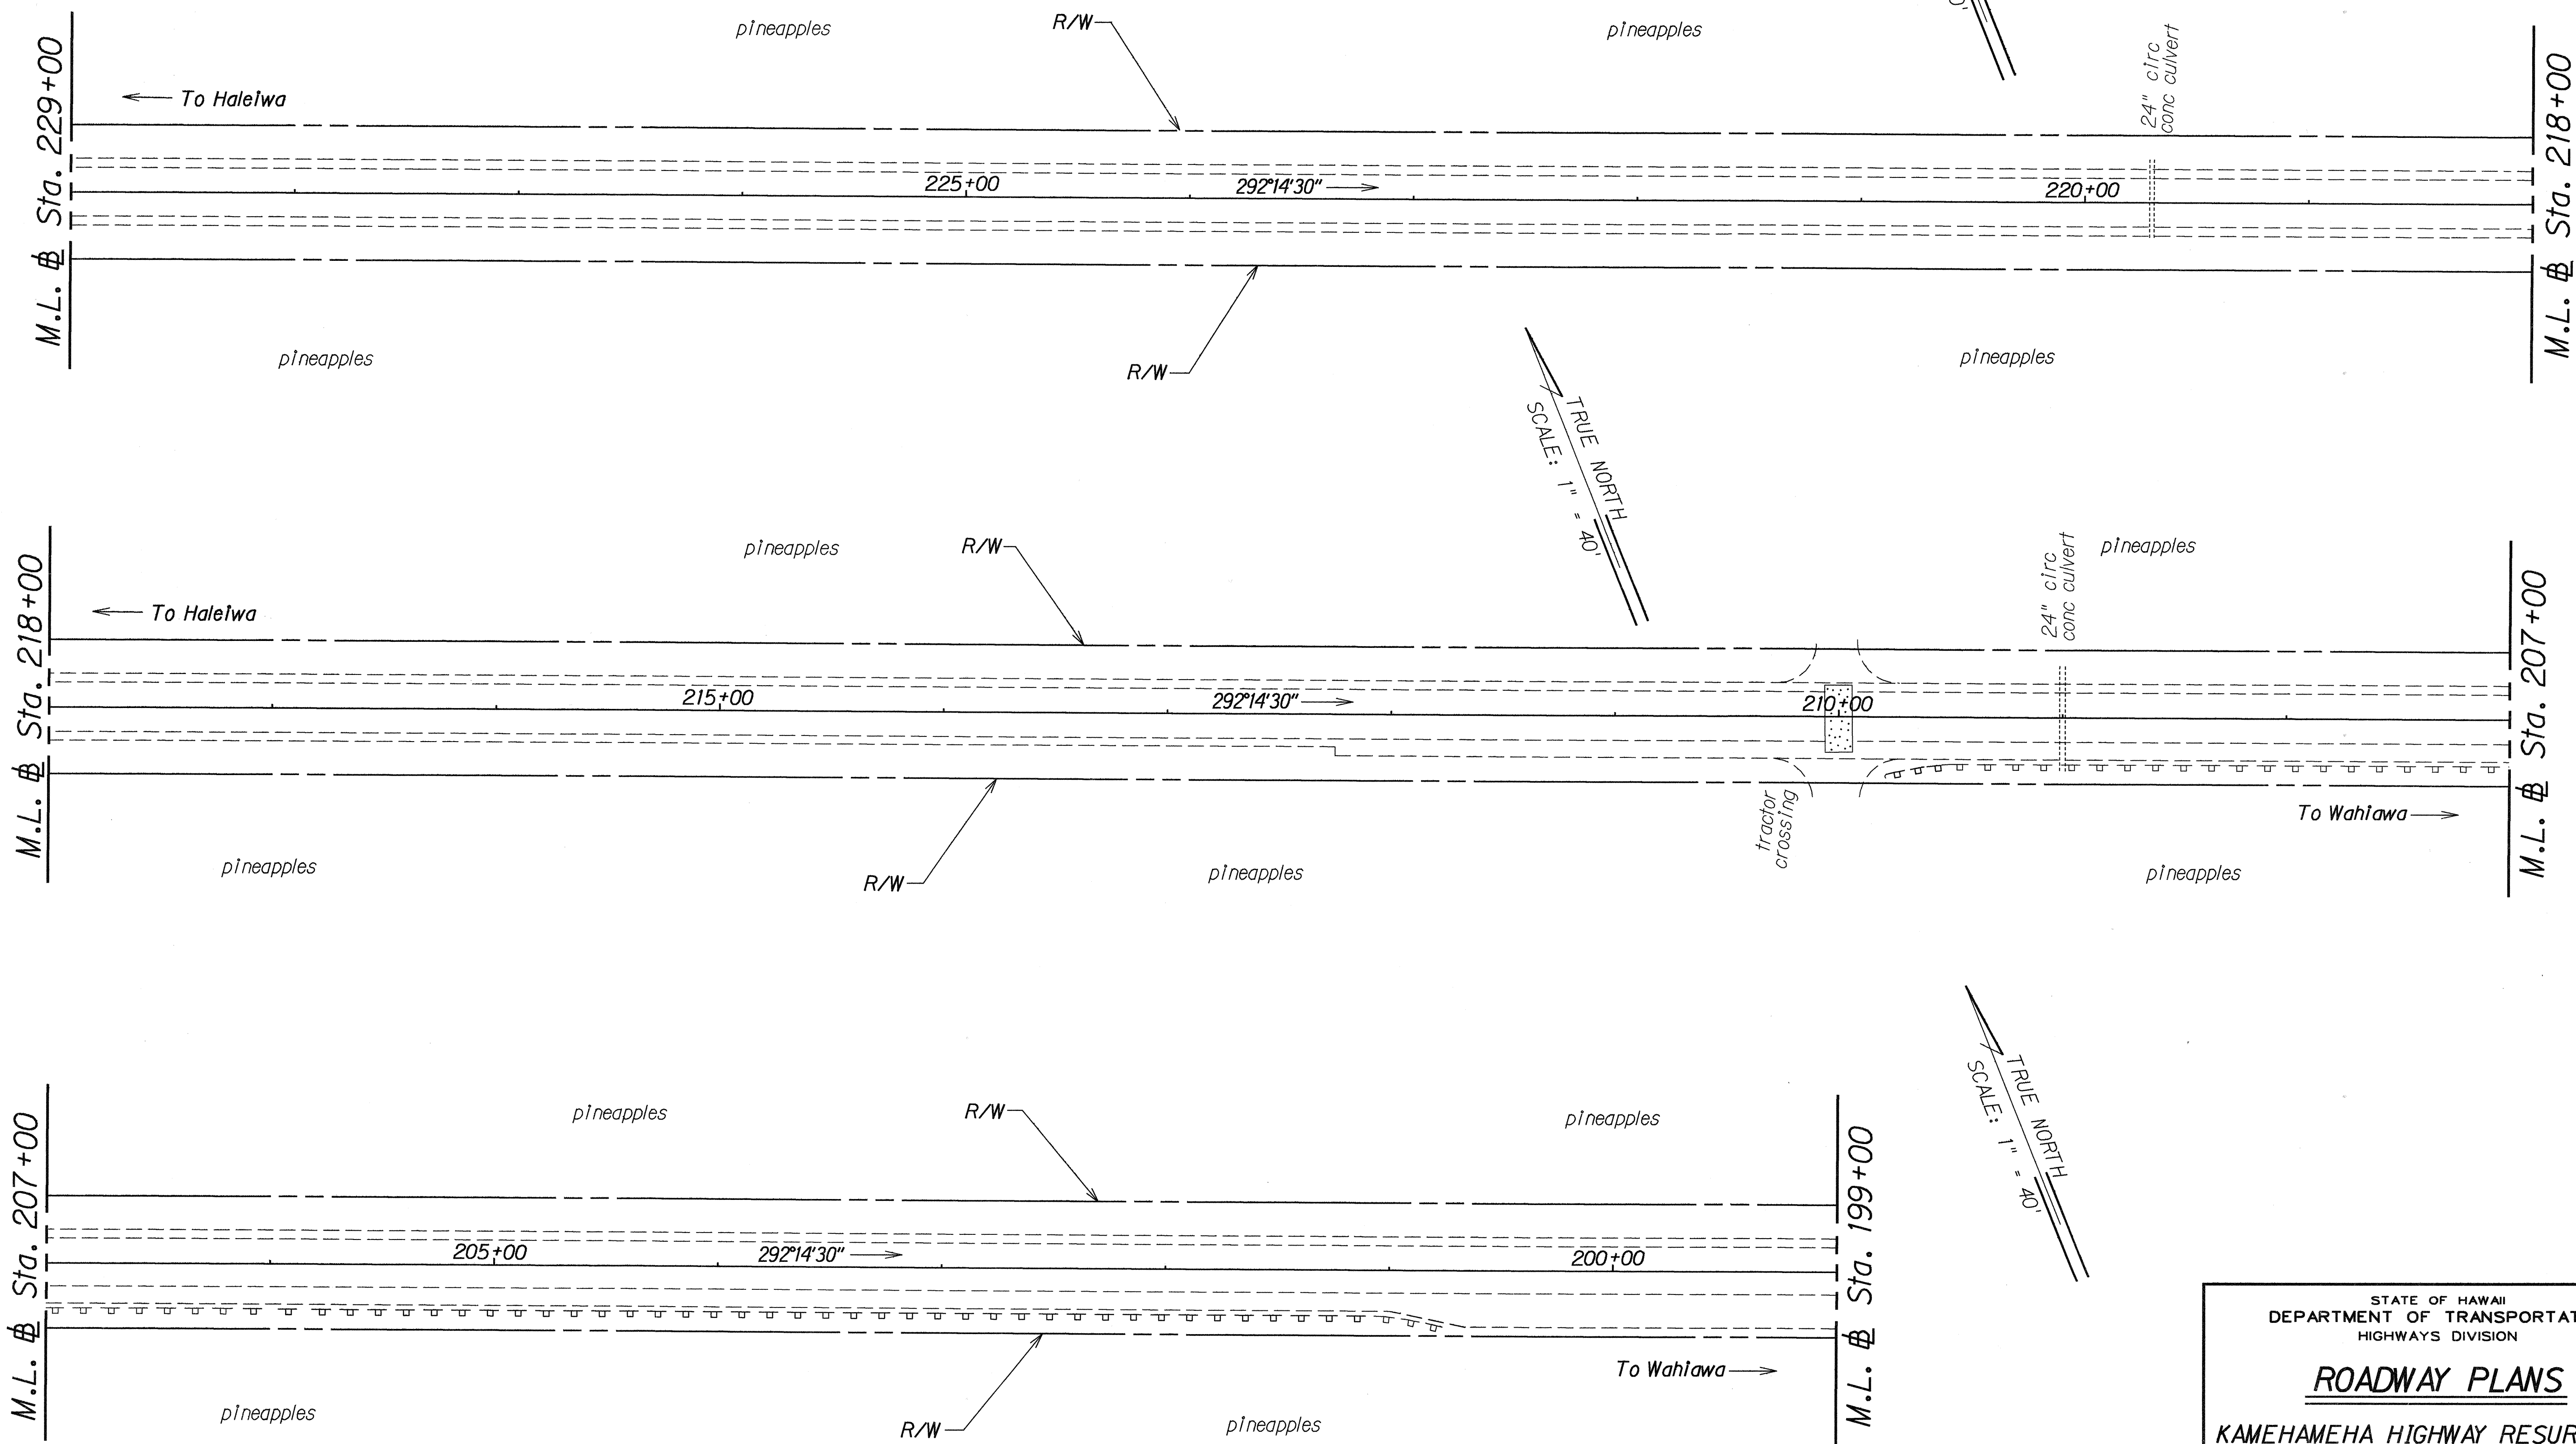

ORIGINAL PLAN	SURVEY PLOTTED BY	DATE
NOTE BOOK	DRAWN BY	
DESIGNED BY	CHECKED BY	
QUANTITIES BY		
Checked by		
No.		

STATE OF HAWAII
DEPARTMENT OF TRANSPORTATION
HIGHWAYS DIVISION


ROADWAY PLANS

KAMEHAMEHA HIGHWAY RESURFACING
Weed Junction to Paalaa Uka Pupukea Road
F.A.P. No. STP-099-1(10)

Scale: 1" = 40' Date: Oct, 1992

SHEET No. 7 OF 10 SHEETS

FED. ROAD DIST. NO.	STATE	FED. AID PROJ. NO.	FISCAL YEAR	SHEET NO.	TOTAL SHEETS
HAWAII	HAW.	STP-099-1(10)	1993	12	26

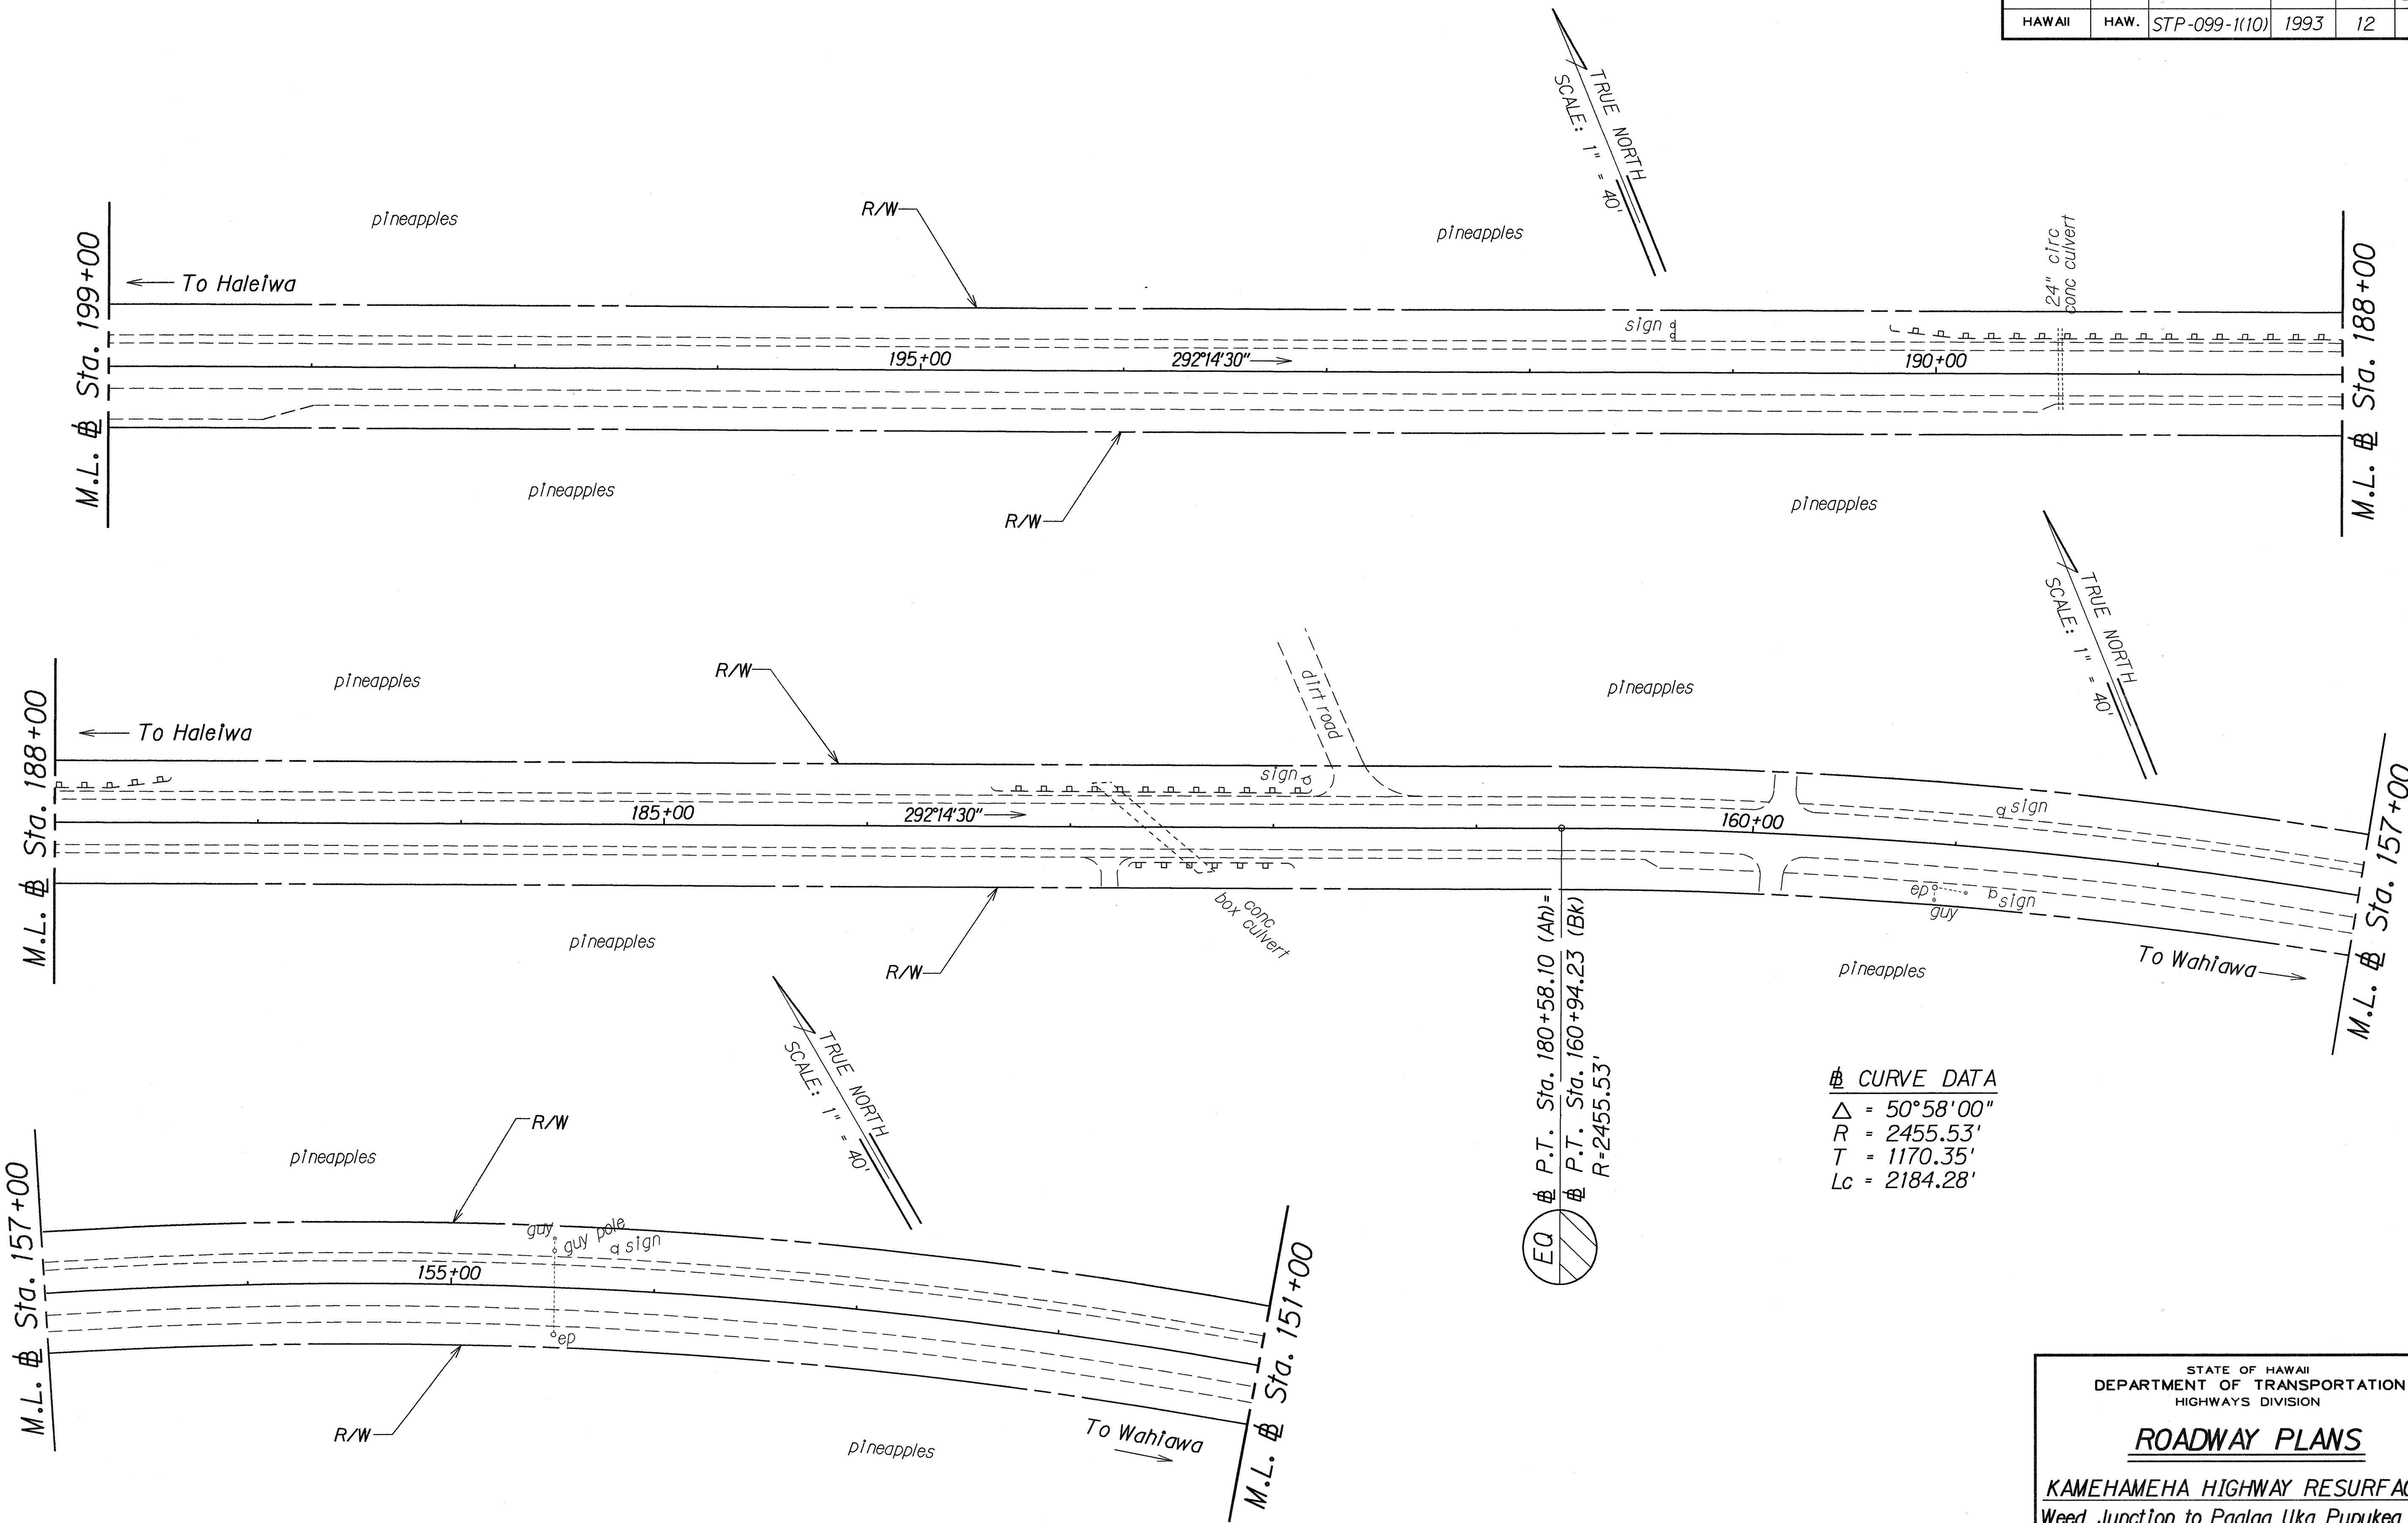

ORIGINAL PLAN	SURVEY PLOTTED BY	DATE
NOTE BOOK	DRAWN BY	
DESIGNED BY	CHECKED BY	
QUANTITIES BY		
Checked by		
No.		

STATE OF HAWAII
DEPARTMENT OF TRANSPORTATION
HIGHWAYS DIVISION


ROADWAY PLANS

KAMEHAMEHA HIGHWAY RESURFACING
Weed Junction to Paalaa Uka Pupukea Road
F.A.P. No. STP-099-1(10)

Scale: 1" = 40' Date: Oct, 1992

SHEET No. 8 OF 10 SHEETS

FED. ROAD DIST. NO.	STATE	FED. AID PROJ. NO.	FISCAL YEAR	SHEET NO.	TOTAL SHEETS
HAWAII	HAW.	STP-099-1(10)	1993	13	26

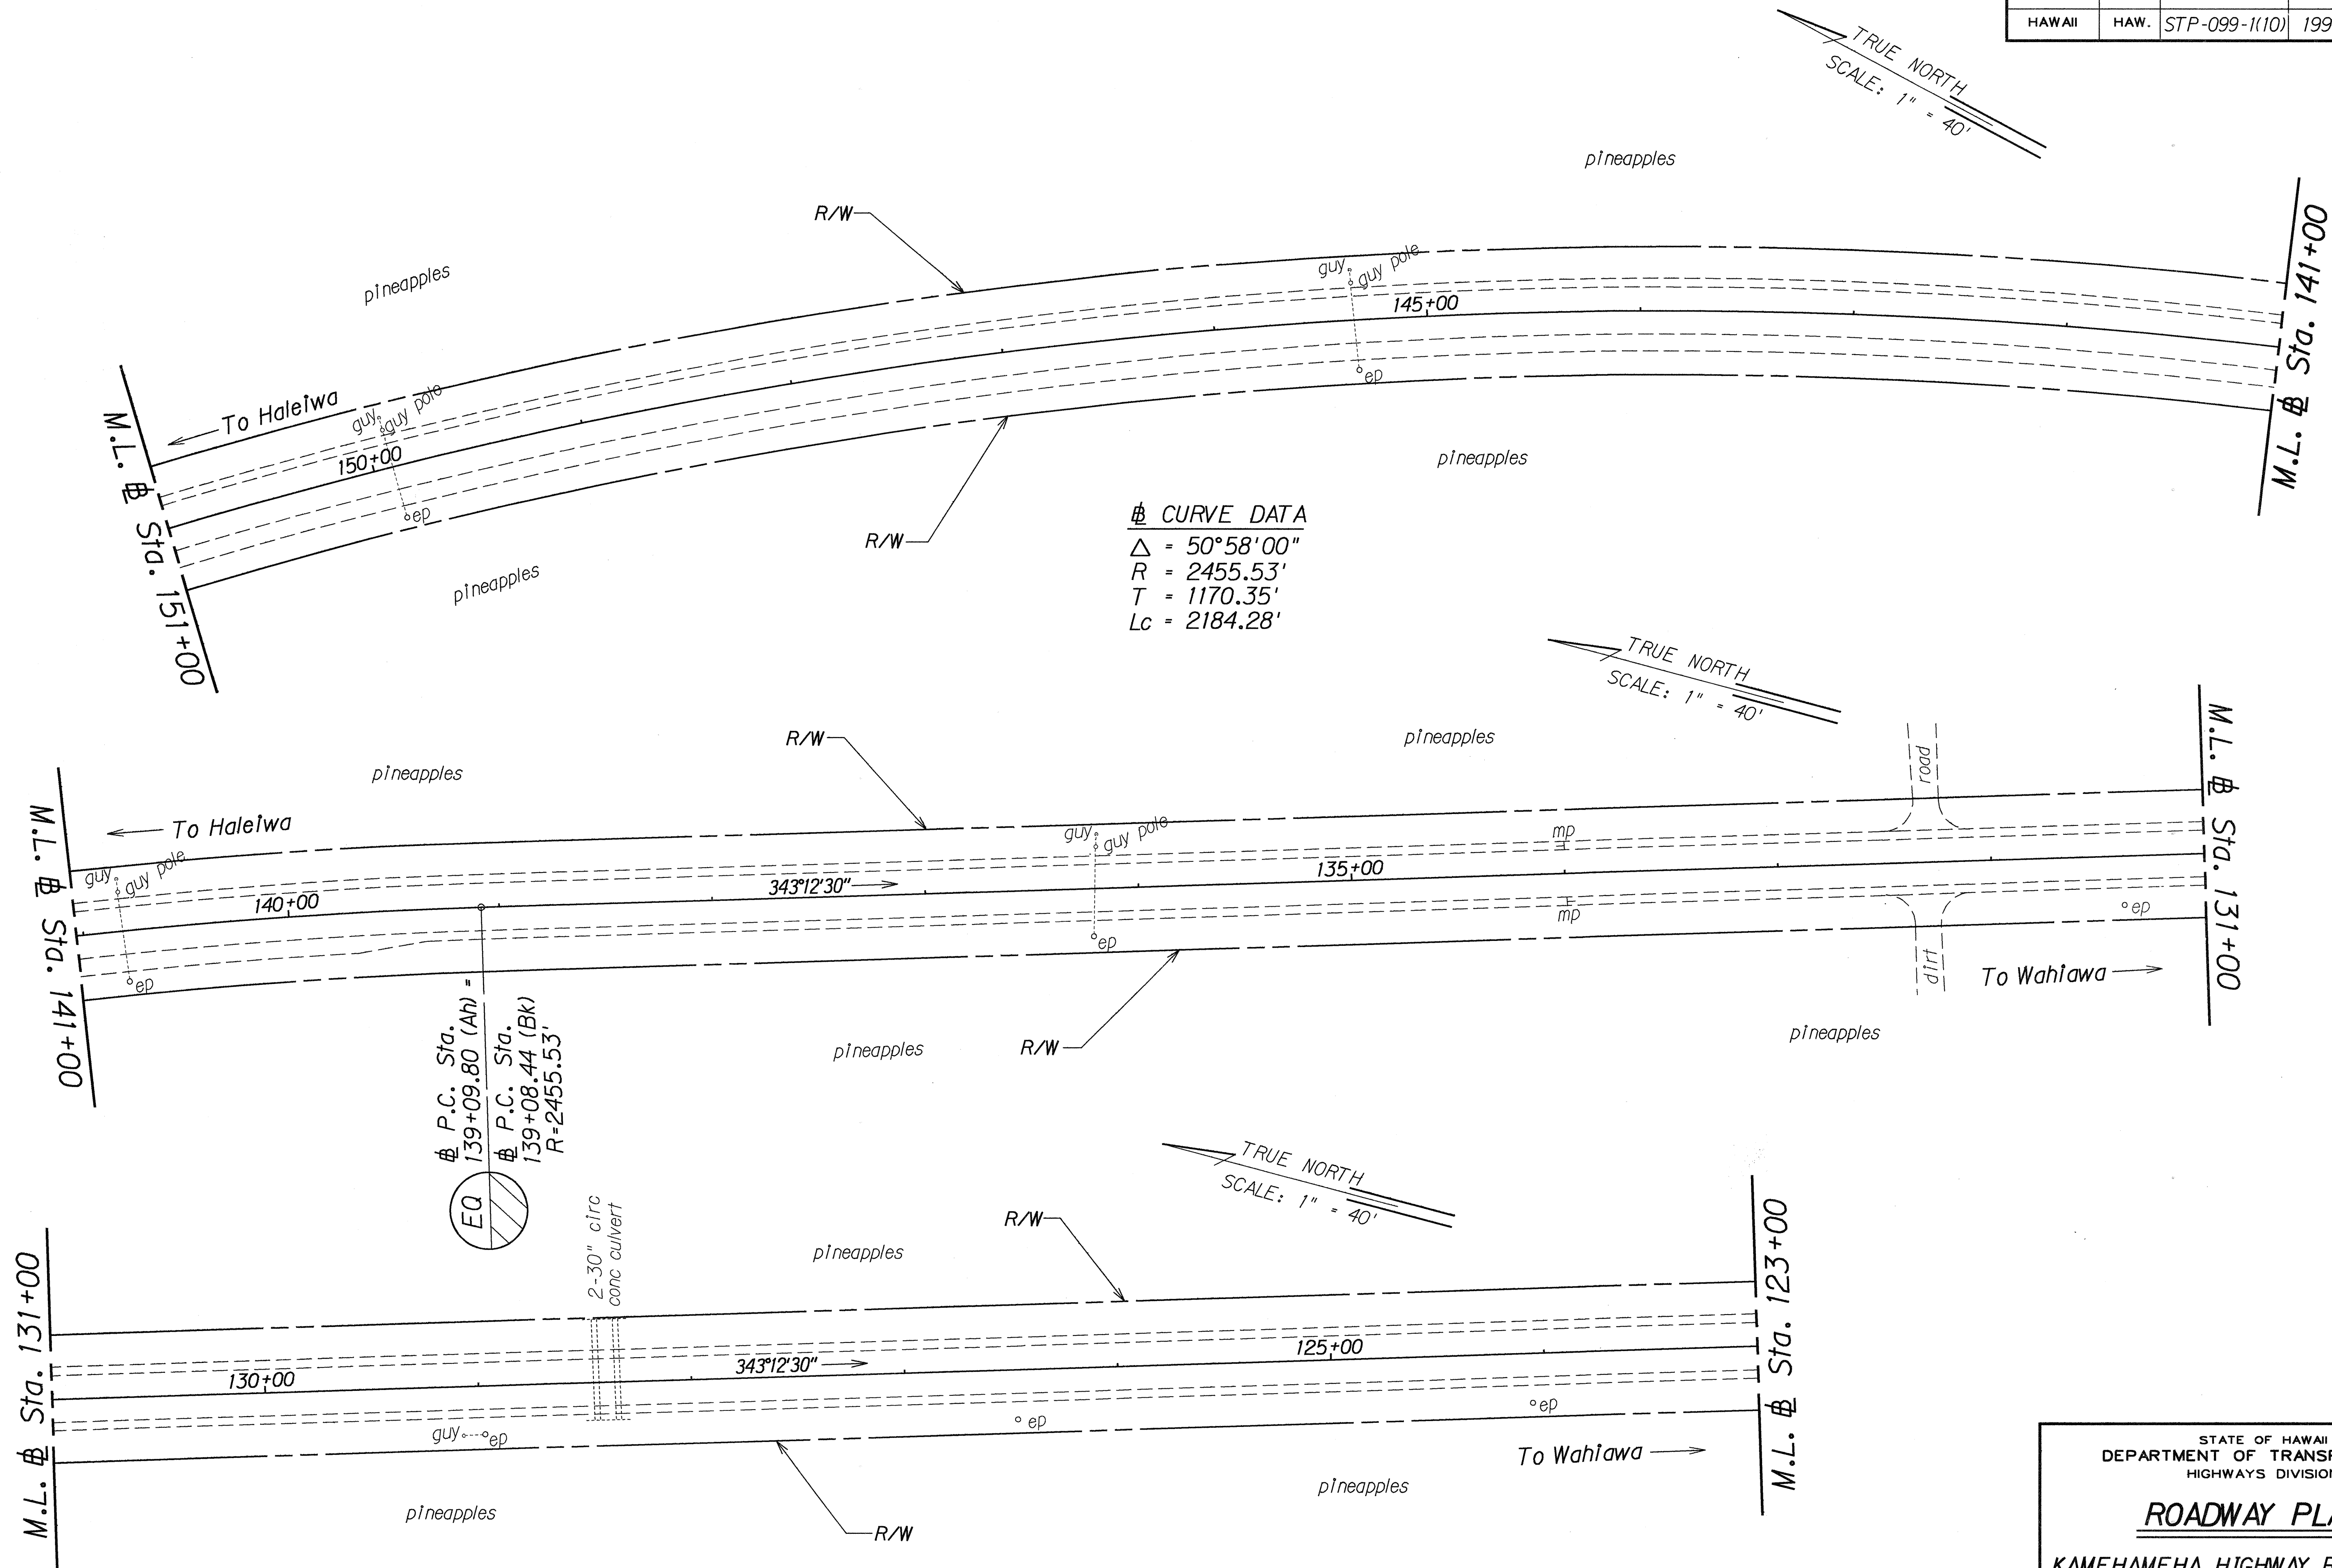

ORIGINAL PLAN	SURVEY PLOTTED BY	DATE
NOTE BOOK	DRAWN BY	
8kamdp9.dgn/10a	DESIGNED BY	
	CHECKED BY	

STATE OF HAWAII
 DEPARTMENT OF TRANSPORTATION
 HIGHWAYS DIVISION

ROADWAY PLANS

KAMEHAMEHA HIGHWAY RESURFACING
 Weed Junction to Paalaa Uka Pupukea Road
 F.A.P. No. STP-099-1(10)

Scale: 1" = 40' Date: Oct, 1992

SHEET No. 9 OF 10 SHEETS

