

ORIGINAL PLAN

SURVEY PLOTTED BY
DRAWN BY
DESIGN FILE
N. 5/10/1992

DATE
07/1992
07/1992
07/1992
07/1992

LWA
JF
JF
MT

GENERAL NOTES

DESIGN SPECIFICATIONS -- AASHTO:

AASHTO Standard Specifications for Highway Bridges (15th edition), with subsequent Interim Specification 1992.

ALLOWABLE DESIGN STRESSES:

1. Reinforced concrete:

$f_c = 0.40 f'_c$
2. Reinforced steel:

$f_s = 20,000$ psi for Grade 40; 24,000 psi for Grade 60
3. Except as noted otherwise, all structural steel plates and members shall conform to ASTM A 36 and be hot-dip galvanized after fabrication.

MATERIALS:

1. Reinforced concrete:

Class A
2. Reinforced steel:

ASTM A 615, Grade 40 or Grade 60
3. Admixture in concrete:

see Special Provisions
4. All expansion and premolded joint filler shall be incidental to concrete and will not be paid for separately.

CONSTRUCTION METHODS:

1. Refer to Standard Specifications for Road and Bridge Construction, 1985 Edition and Special Provisions.
2. Except as noted otherwise, all vertical dimensions are measured plumb.
3. For concrete finish, see Special Provisions.
4. Pneumatic or impacting type of equipment will not be permitted for drilling of holes.
5. Stagger all splices where possible.
6. Rebars shall be supported, bent and placed as per "Manual of Standard Practice for Detailing Concrete Structures" ACI 315 (latest)
7. For cast-in-place concrete, minimum reinforcement cover:
Concrete cast against earth: 3"
Retaining wall: 2"
8. At time concrete is placed, rebars shall be free from mud, oil, laitance or other coatings adversely affecting bond capacity.
9. Reinforcement, dowels and other embedded items shall be positively secured before pouring.
10. All footings shall bear on firm undisturbed natural soils or properly compacted structural fill.
11. Weepholes, 4 inches in diameter, shall be placed not more than 8 feet on center along walls. An 18 inch minimum thick continuous pea gravel drain shall be placed along the entire length of wall connecting the weepholes. Weepholes shall be incidental to concrete in retaining walls.
12. Large random stone pattern architectural finish on face of retaining wall is to be accomplished by form liners.
Coloring of the stone after curing shall be done per Manufacturer's Instructions.
Cost of the Large Random Stone Pattern Architectural Finish shall be incidental to "Concrete in Retaining Wall".

REFERENCE:

1. Refer to Standard Plans for additional details and notes not covered by details and typical drawings.

GENERAL:

1. All items noted incidental will not be paid for separately.
2. The Contractor shall verify the locations of all existing utility lines and notify their respective owners before commencing with any work.
3. The Contractor shall verify all grades and dimensions in the field before commencing with any work.
4. The Contractor shall be solely responsible for the protection of adjacent property, utility and existing and new structures from damage due to construction and repair any damage at his own expense, to the satisfaction of the Engineer. He shall conduct his work in such a manner and provide such temporary shoring or other measures as may be necessary to insure the safety of all concerned and to protect existing structures.
5. Excavation for all footings and stems shall be accomplished by maintaining as near a vertical cut as possible.
6. In the event of over-excavation, the space between the footing and ground shall be filled with a minimum of class D concrete at the Contractor's expense and as directed by the Engineer.
7. Unless noted otherwise, chamfer all exposed concrete edges three quarters (3/4") of an inch.

ESTIMATED QUANTITIES

ITEM NO.	DESCRIPTION	UNIT	QUANTITIES
206.5000	Structural Excavation For Retaining Walls	Cu. Yd.	3,550 c.y.
206.7250	Structural Backfill For Retaining Walls	Cu. Yd.	3,820 c.y.
206.8310	Pea Gravel Filter Material For Retaining Walls	Cu. Yd.	400 c.y.
503.1050	Concrete In Retaining Walls	Lump Sum	(1,490 cy.)
508.0100	Cement Rubble Masonry	Cu. Yd.	13 c.y.
602.0050	Reinforcing Steel In Retaining Walls	Lump Sum	(155,000 lbs.)
607.0260	6-Foot Chain Link Fence With Top Rail On Concrete Structure	Lin. Ft.	616 l.f.

FED. ROAD DIST. NO.	STATE	FED. AID PROJ. NO.	FISCAL YEAR	SHEET NO.	TOTAL SHEETS
HAWAII	HAW.	NH-099-1(19)	1994	38	54

STATE OF HAWAII
DEPARTMENT OF TRANSPORTATION
HIGHWAYS DIVISION

RETAINING WALL



GENERAL NOTES & ESTIMATED QUANTITIES

KAMEHAMEHA HIGHWAY WIDENING
LUMIAINA STREET TO WAIPIO UKA STREET
Project No. NH-099-1(19)

Scale: As Noted

Date: May, 1994

FED. ROAD DIST. NO.	STATE	FED. AID PROJ. NO.	FISCAL YEAR	SHEET NO.	TOTAL SHEETS
HAWAII	HAW.	NH-099-1(9)	1994	C.O.39	54

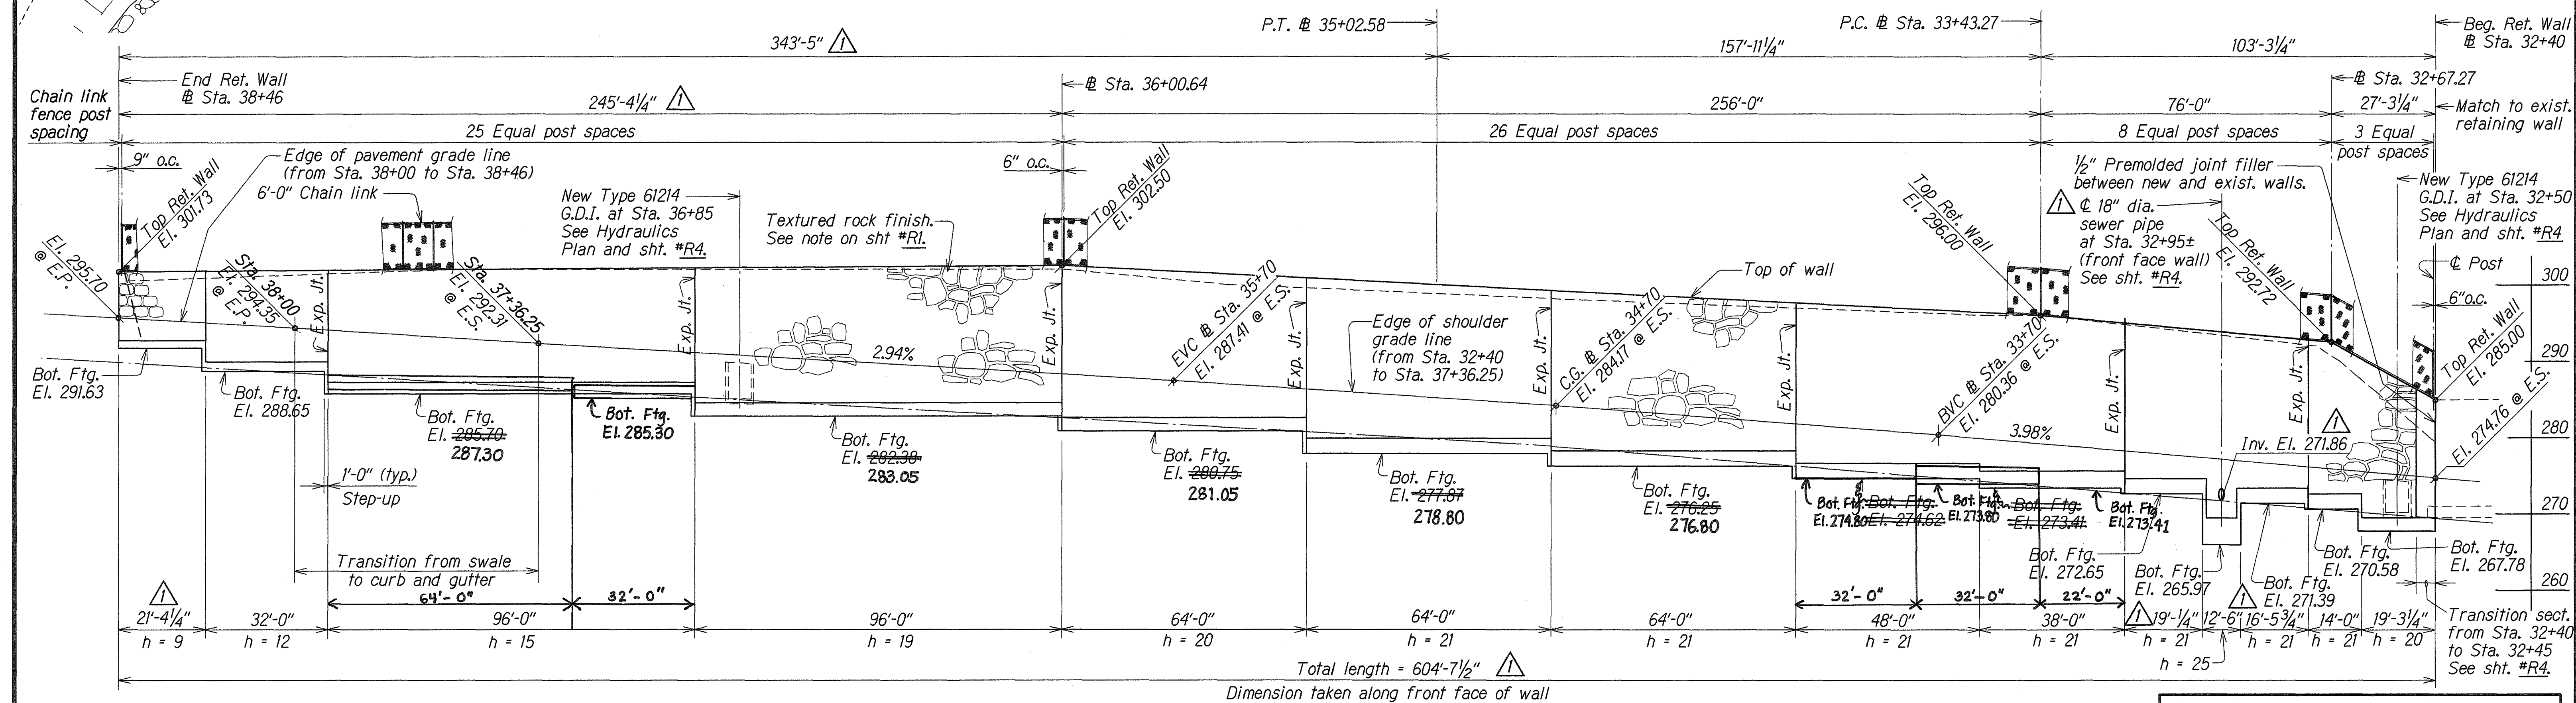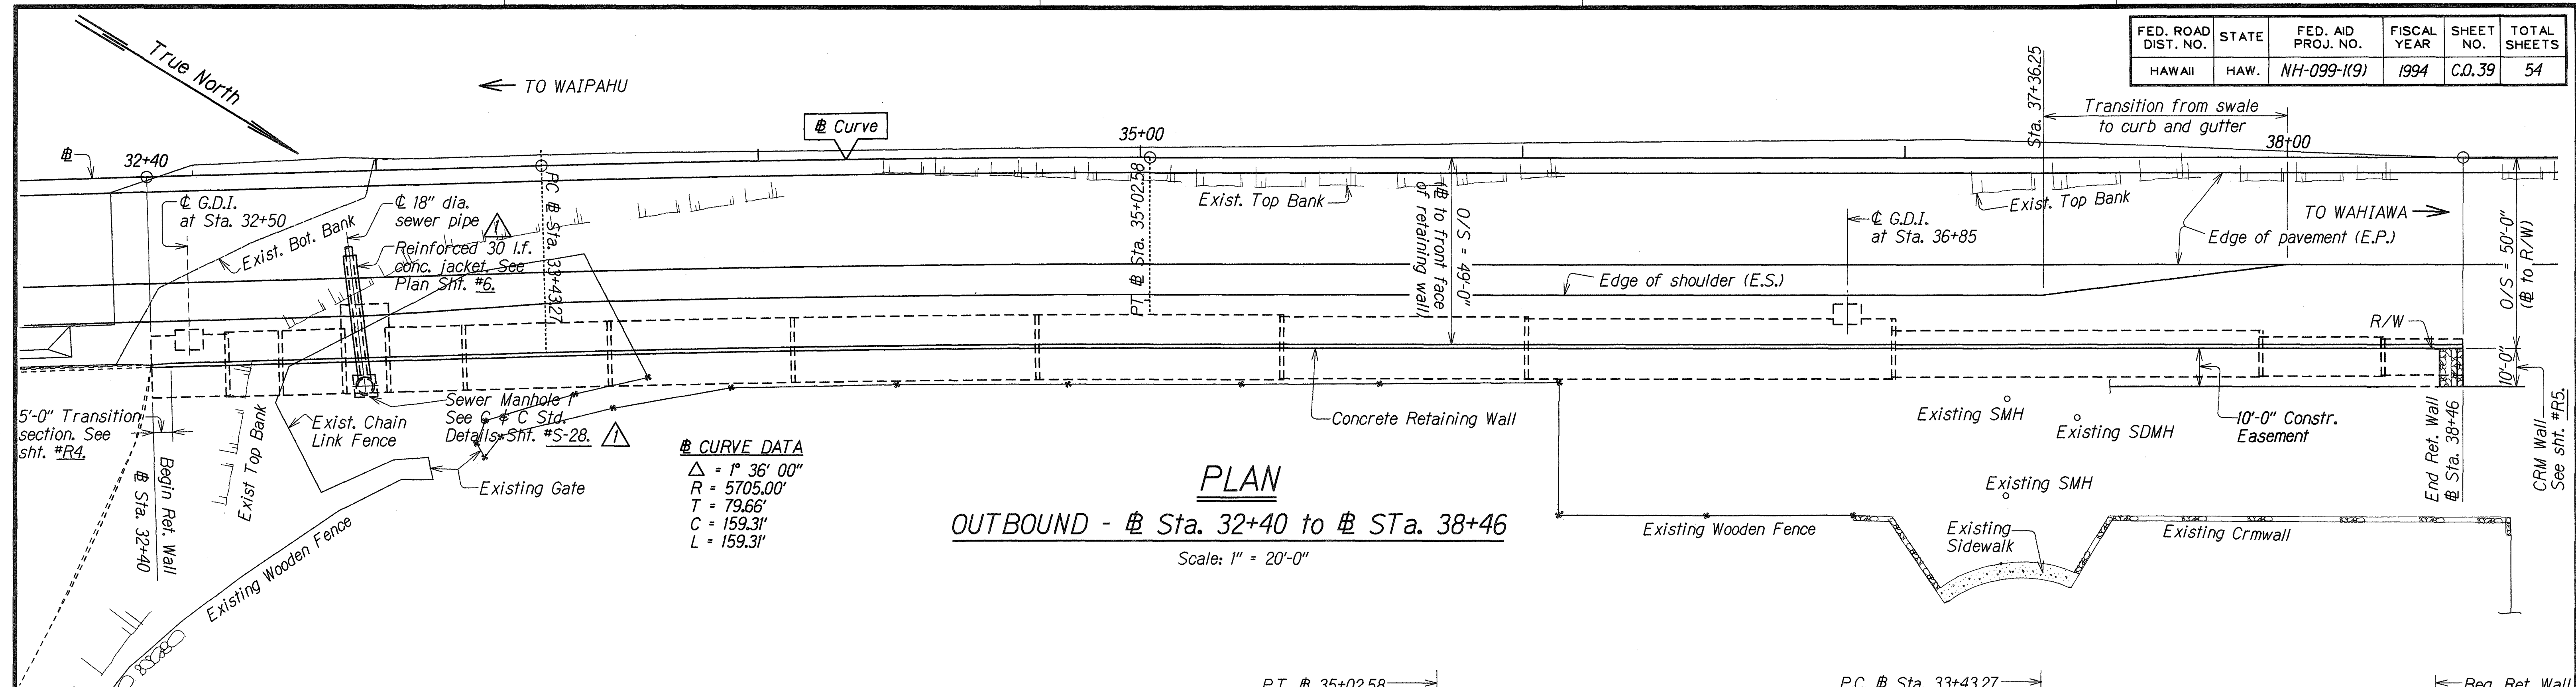

APPROVED:

[Signature]
 CHIEF, DIVISION OF PLANNING & SERVICES CONTROL
 DEPARTMENT OF WASTEWATER MANAGEMENT
 (FOR SEWER WORK WITHIN PUBLIC R/W
 AND EASEMENT ONLY)

2/15/95

DATE
[Signature]

Revised dimensions and elevation.
 Realigned 18" sewer pipe.
 Add reinforced 30 l.f. conc. jacket
 and C & C manhole.

DATE REVISION

STATE OF HAWAII
 DEPARTMENT OF TRANSPORTATION
 HIGHWAYS DIVISION
RETAINING WALL
PLAN AND ELEVATION
 OUTBOUND Sta. 32+40 TO 38+46
 KAMEHAMEHA HIGHWAY WIDENING
 LUMIAINA STREET TO WAIPIO UKA STREET
 Project No. NH-099-1(9)
 Scale: As Noted Date: May, 1994
 SHEET No. R2 OF 5 SHEETS


"AS-BUILT"

C.O. 39


DATE	OCT 1992
SURVEY PLOTTED BY	LMA
DRAWN BY	JE
DESIGNED BY	JE
QUANTITIES BY	JE
CHECKED BY	ML
ORIGINAL PLAN	NO. SK-000014

SCHEDULE OF DIMENSIONS # REINFORCING STEEL FOR RETAINING WALL							
Maximum "h"	9'	12'	15'	19'	20'	21'	25'
"a" bars	#6@8"	#6	#7	#8	#9	#9	#11
Short "c" bars	—	#5	#6	#7	#7	#7	#9
"c" bars	—	#5	#5	#5	#5	#5	#7
"b" bars	#6@6"	#6@4"	#7@4 1/2"	#8@6 1/2"	#8@6"	#7@5"	#6@5 1/2"
a	1'-6"	1'-9"	3'-6"	*6'-6"	*7'-0"	7'-9"	14'-0"
b	—	0'-10"	1'-6"	4'-0"	4'-0"	4'-3"	7'-6"
c	7'-0"	7'-0"	7'-0"	7'-0"	7'-0"	7'-0"	7'-0"
d	3'-9"	4'-0"	4'-2"	3'-6"	3'-6"	3'-6"	—
e	No batter	1/2 : 12	1/2 : 12	3/4 : 12	3/4 : 12	3/4 : 12	3/4 : 12
f	1'-9"	2'-3"	3'-0"	3'-6"	4'-0"	4'-0"	4'-6"
L	9'-6"	10'-3"	12'-2"	*15'-9"	*16'-3"	17'-0"	23'-7"
t	1'-2"	1'-3"	1'-6"	1'-9"	1'-9"	2'-0"	3'-6"
g	2'-3"	2'-11"	4'-9"	8'-2"	8'-8"	9'-6"	16'-0"

* Extend footing and reinforcing steel where G.D.I. (Grated Drop Inlet) occur. See details on Sht. #R3.
Maximum allowable bearing pressure = 3 ksf.

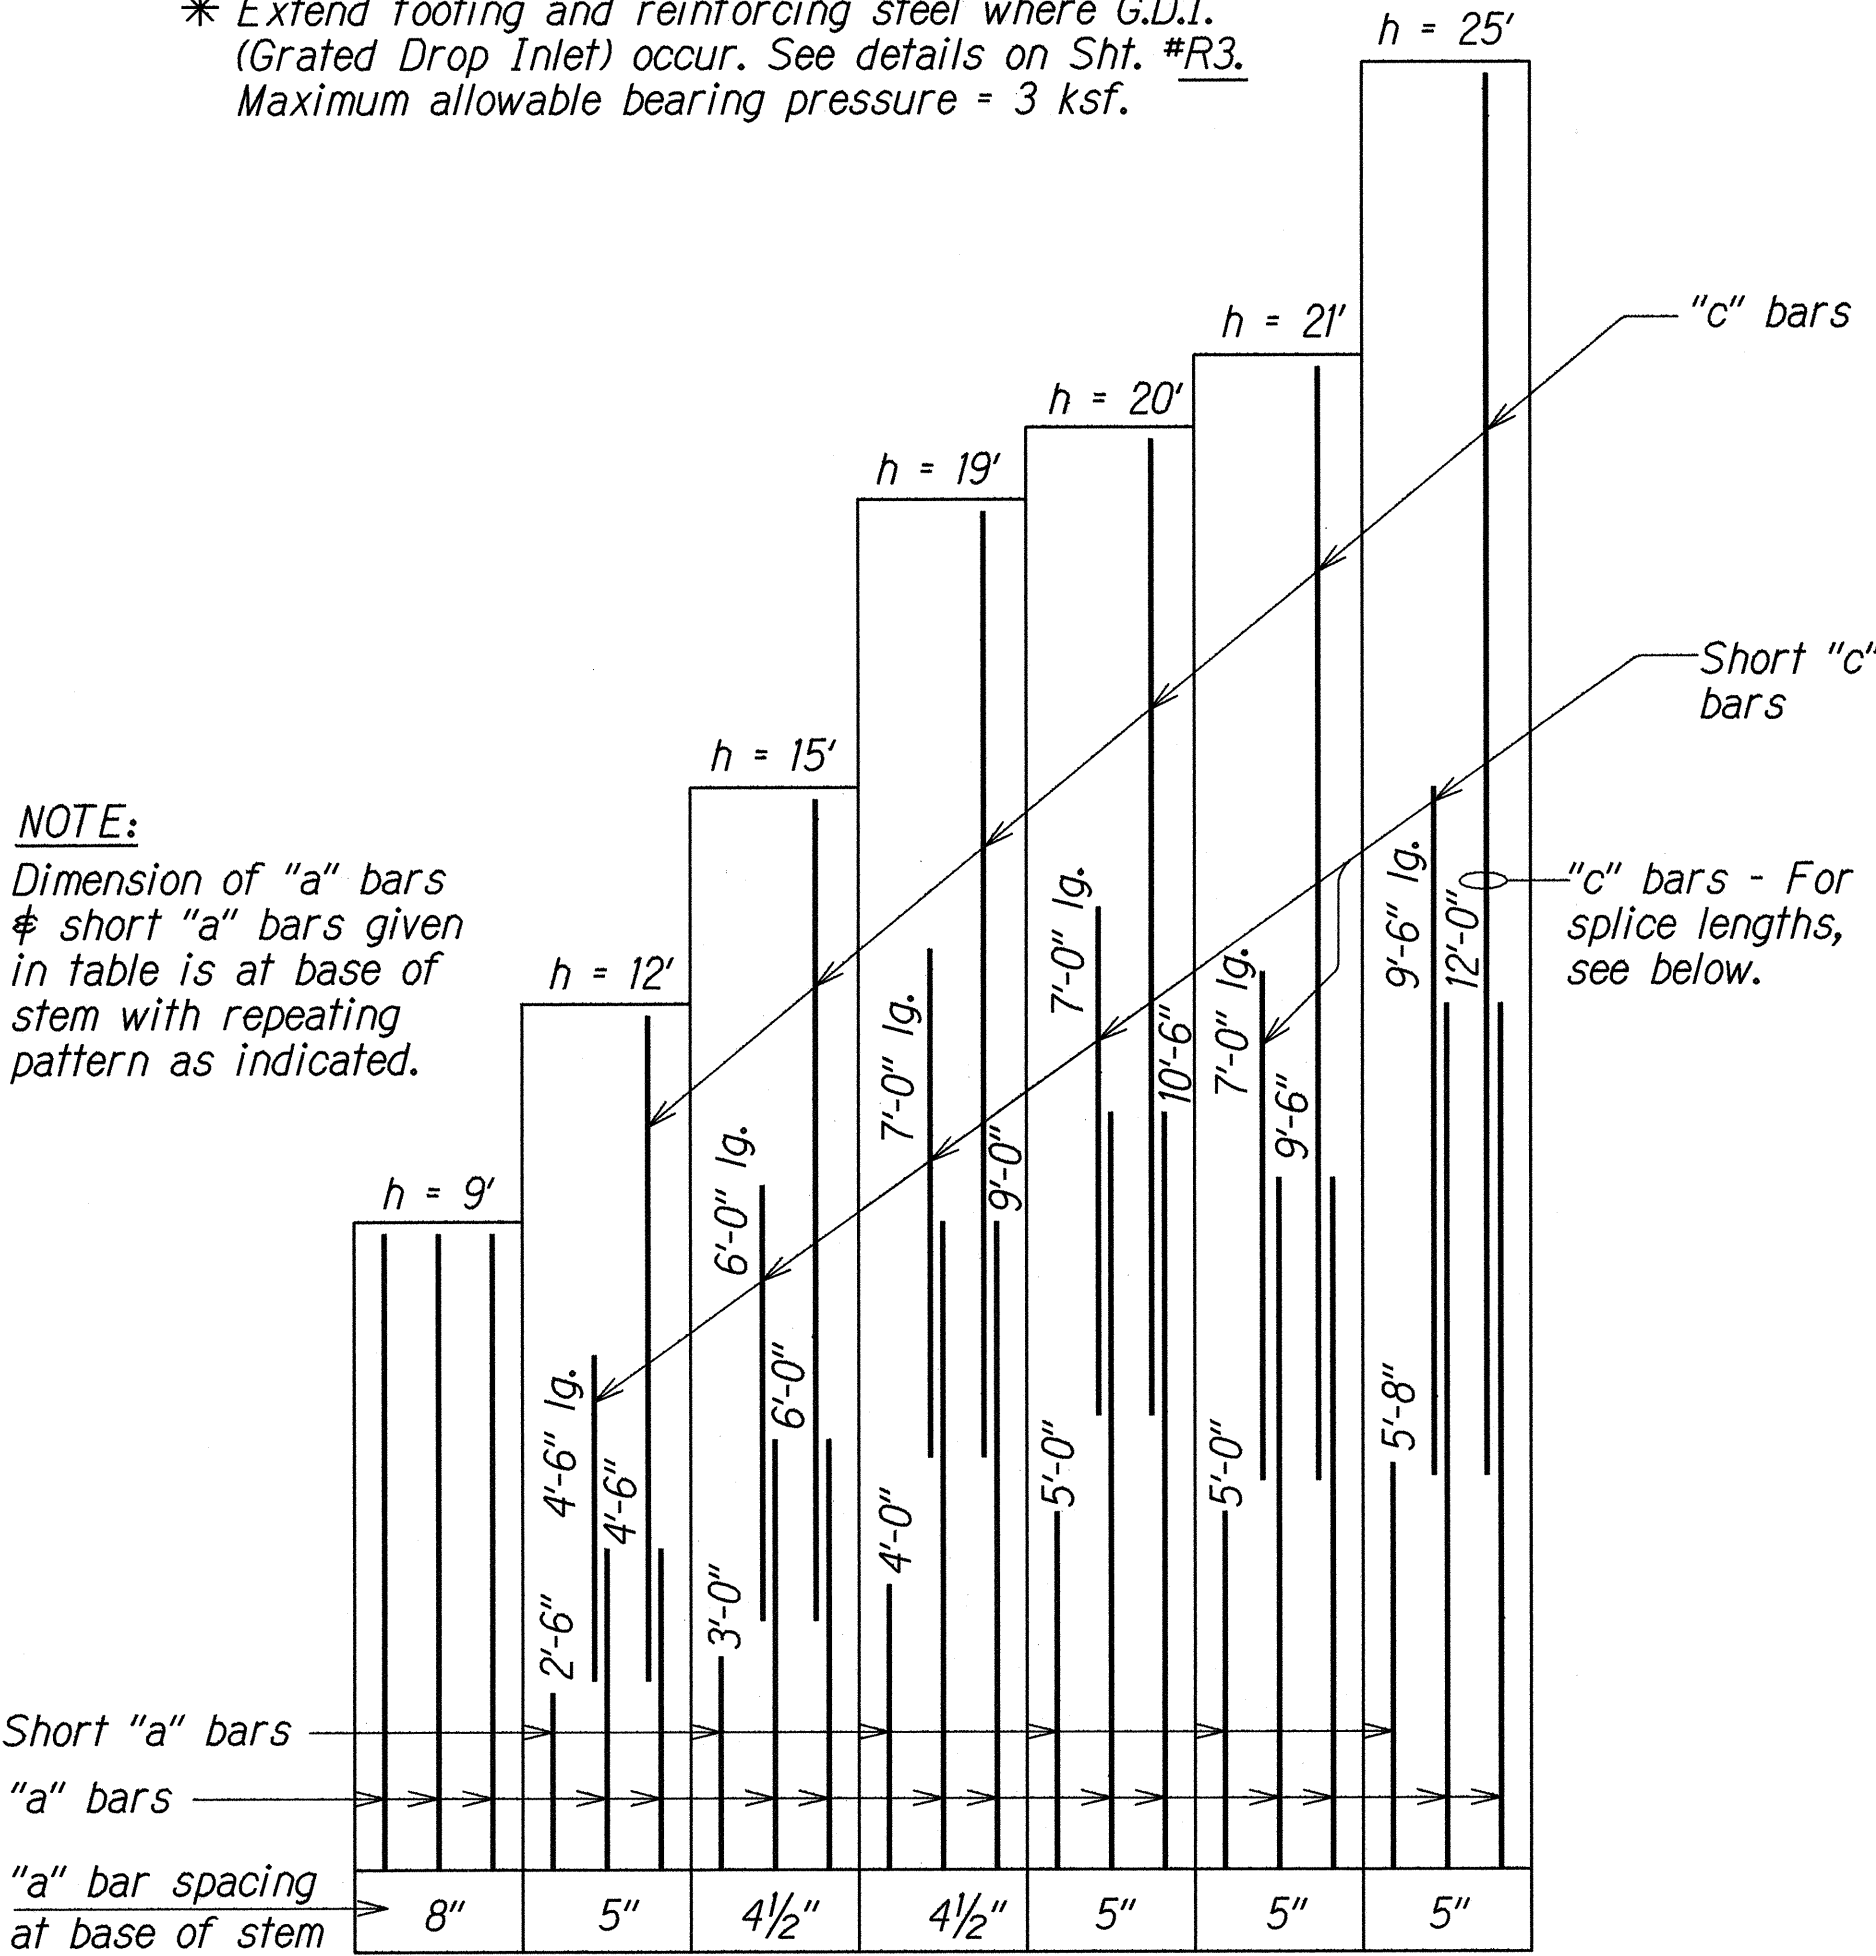

VERTICAL REINFORCING STEEL ARRANGEMENT

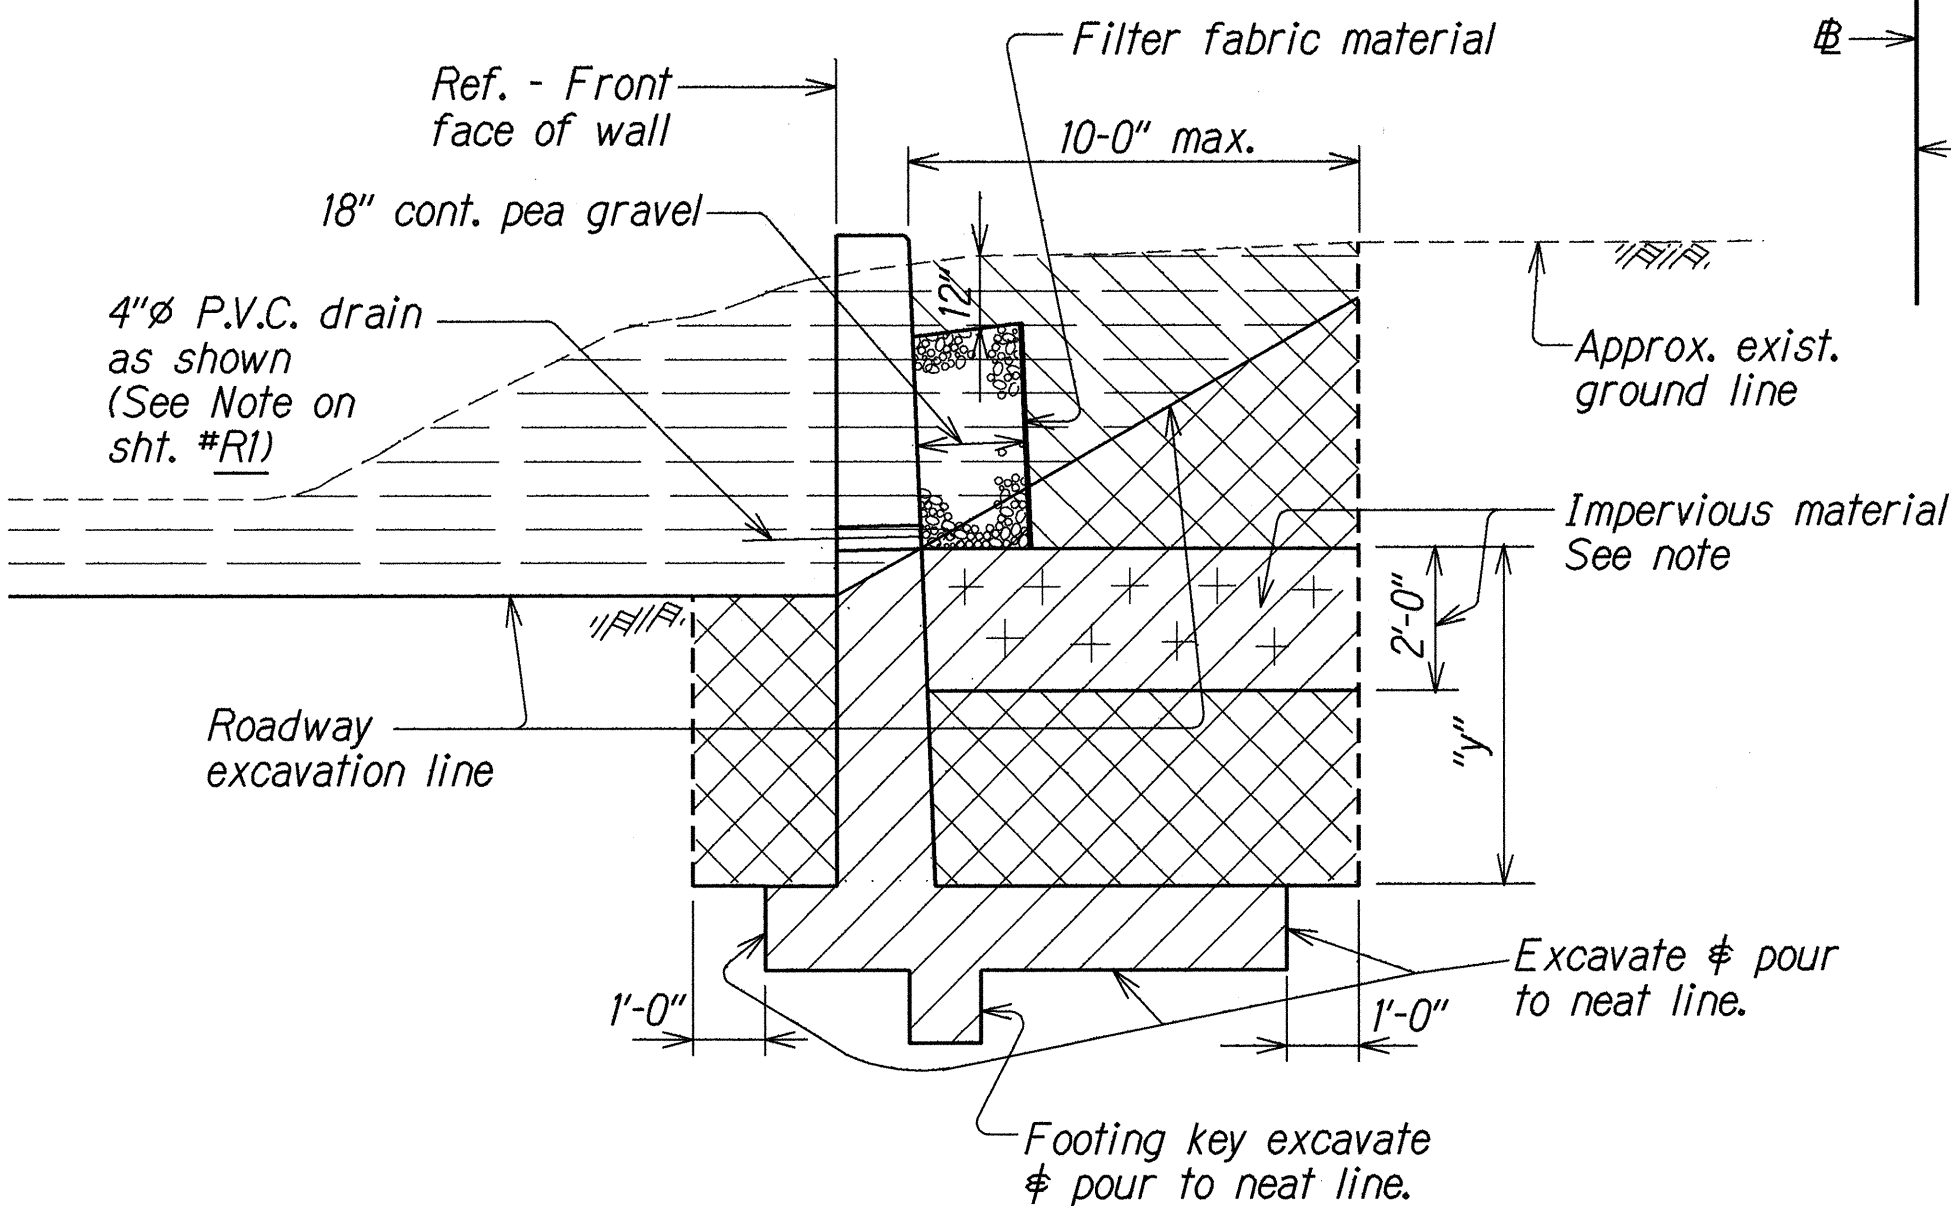

STRUCTURE EXCAVATION &
DRAINAGE DETAIL

Not to Scale

NOTES

HATCHED AREA


- Hatched area shown thus denotes limits of structure excavation payoffline.
- Hatched area shown thus denotes limits of structure backfill.
- Hatched area shown thus denotes limits of roadway excavation.

IMPERVIOUS MATERIAL

- Impervious material as selected by the Engineer shall be incidental to structure backfill.
- When "y" is 2'-0" or less, all backfill below PVC drain level shall be impervious material.
- The subgrade upon which filter material is to be placed shall be made as impervious as possible by pneumatic tamping or other approved methods.


BAR SIZE	SPLICE LENGTH (Inch)
6	22
7	30
8	39
9	50
11	78

When splicing different size bars, length of larger bar shall govern.

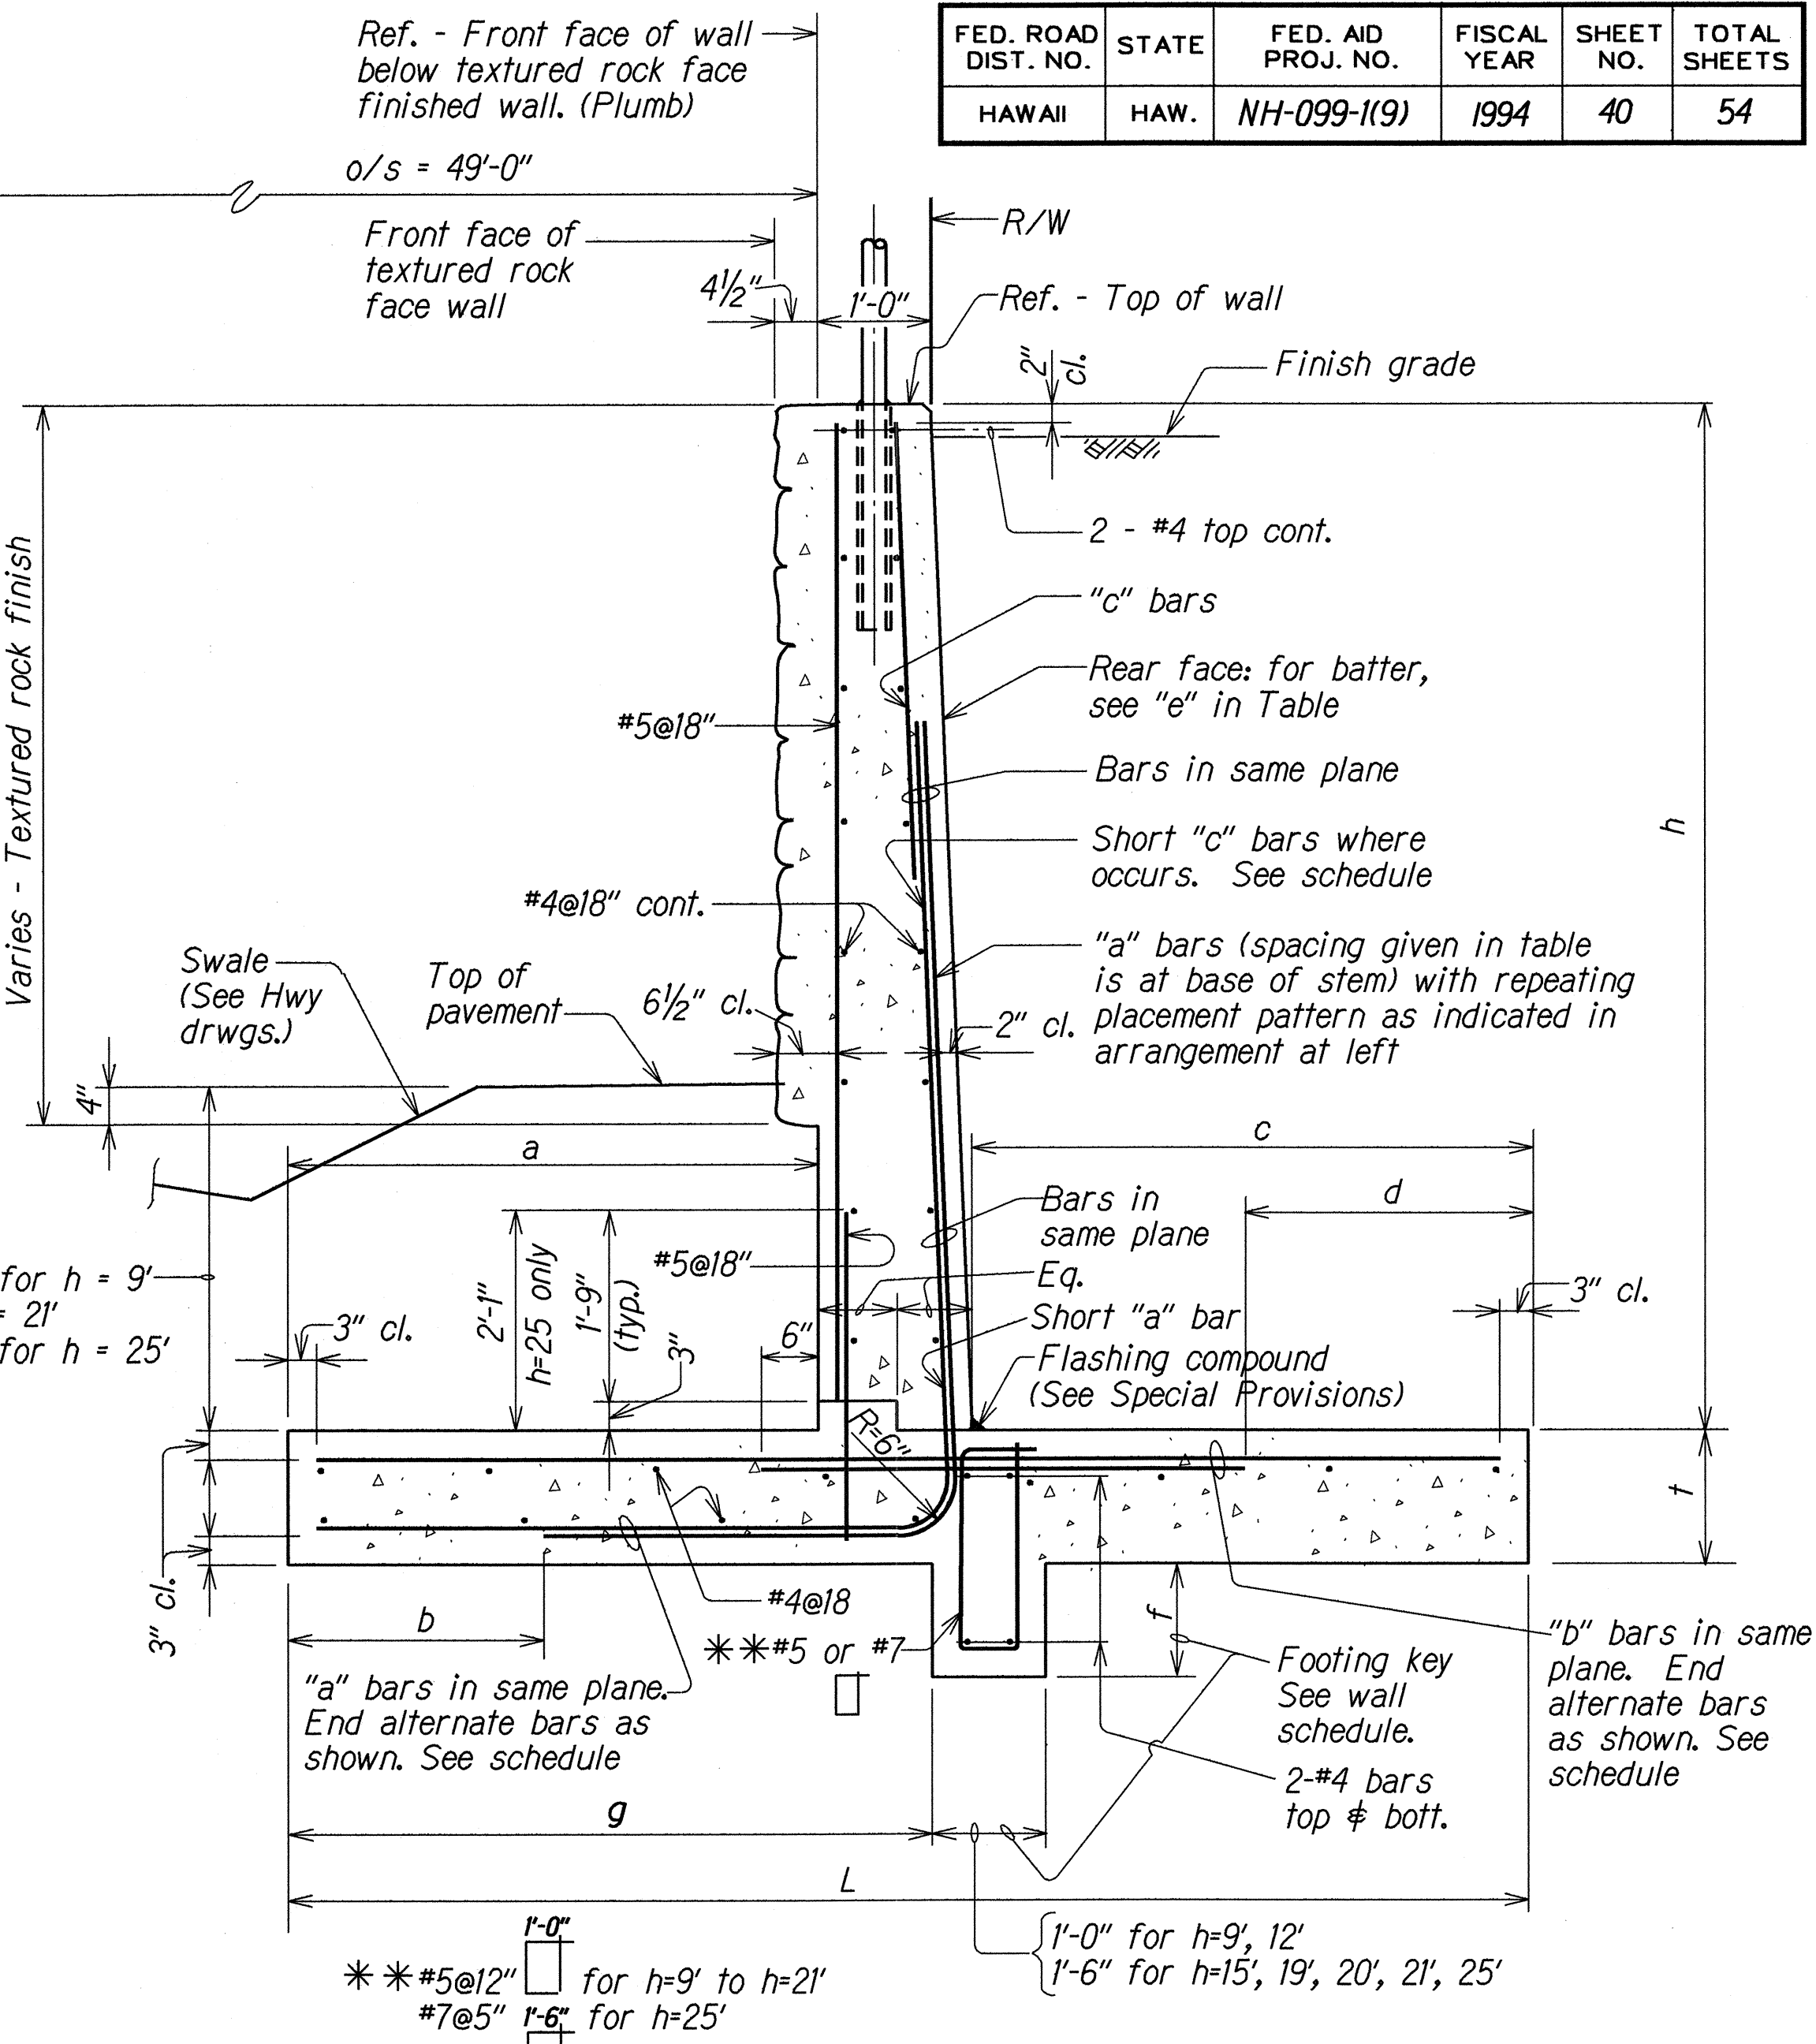

TYPICAL WALL SECTION

Not to Scale

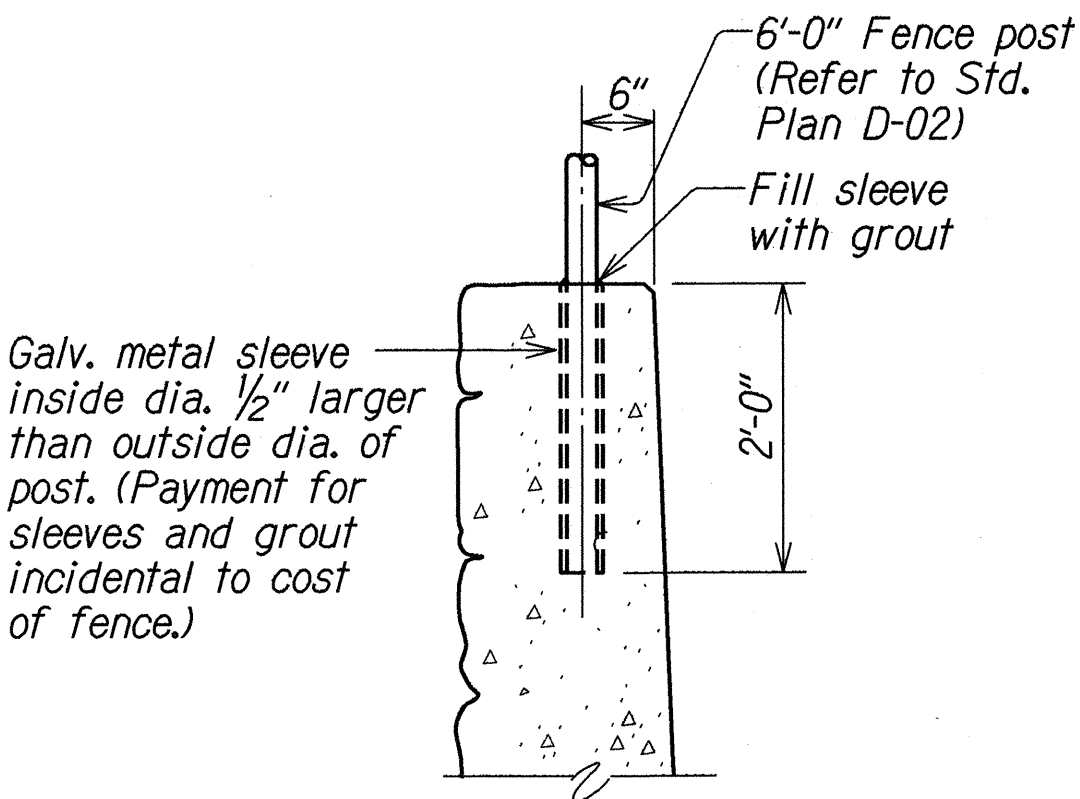

CHAIN LINK FENCE
POST DETAIL

Not to Scale


STATE OF HAWAII
DEPARTMENT OF TRANSPORTATION
HIGHWAYS DIVISION
RETAINING WALL
TYPICAL DETAILS, T-TYPE WALL
KAMAHAMEHA HIGHWAY WIDENING
LUMATA STREET TO WAIPIO UKA STREET
Project No. NH-099-1(9)

Scale: As Noted


Date: May, 1994

SHEET No. R3 OF 5 SHEETS


FED. ROAD DIST. NO.	STATE	FED. AID PROJ. NO.	FISCAL YEAR	SHEET NO.	TOTAL SHEETS
HAWAII	HAW.	NH-099-1(9)	1994	C.O. 41	54

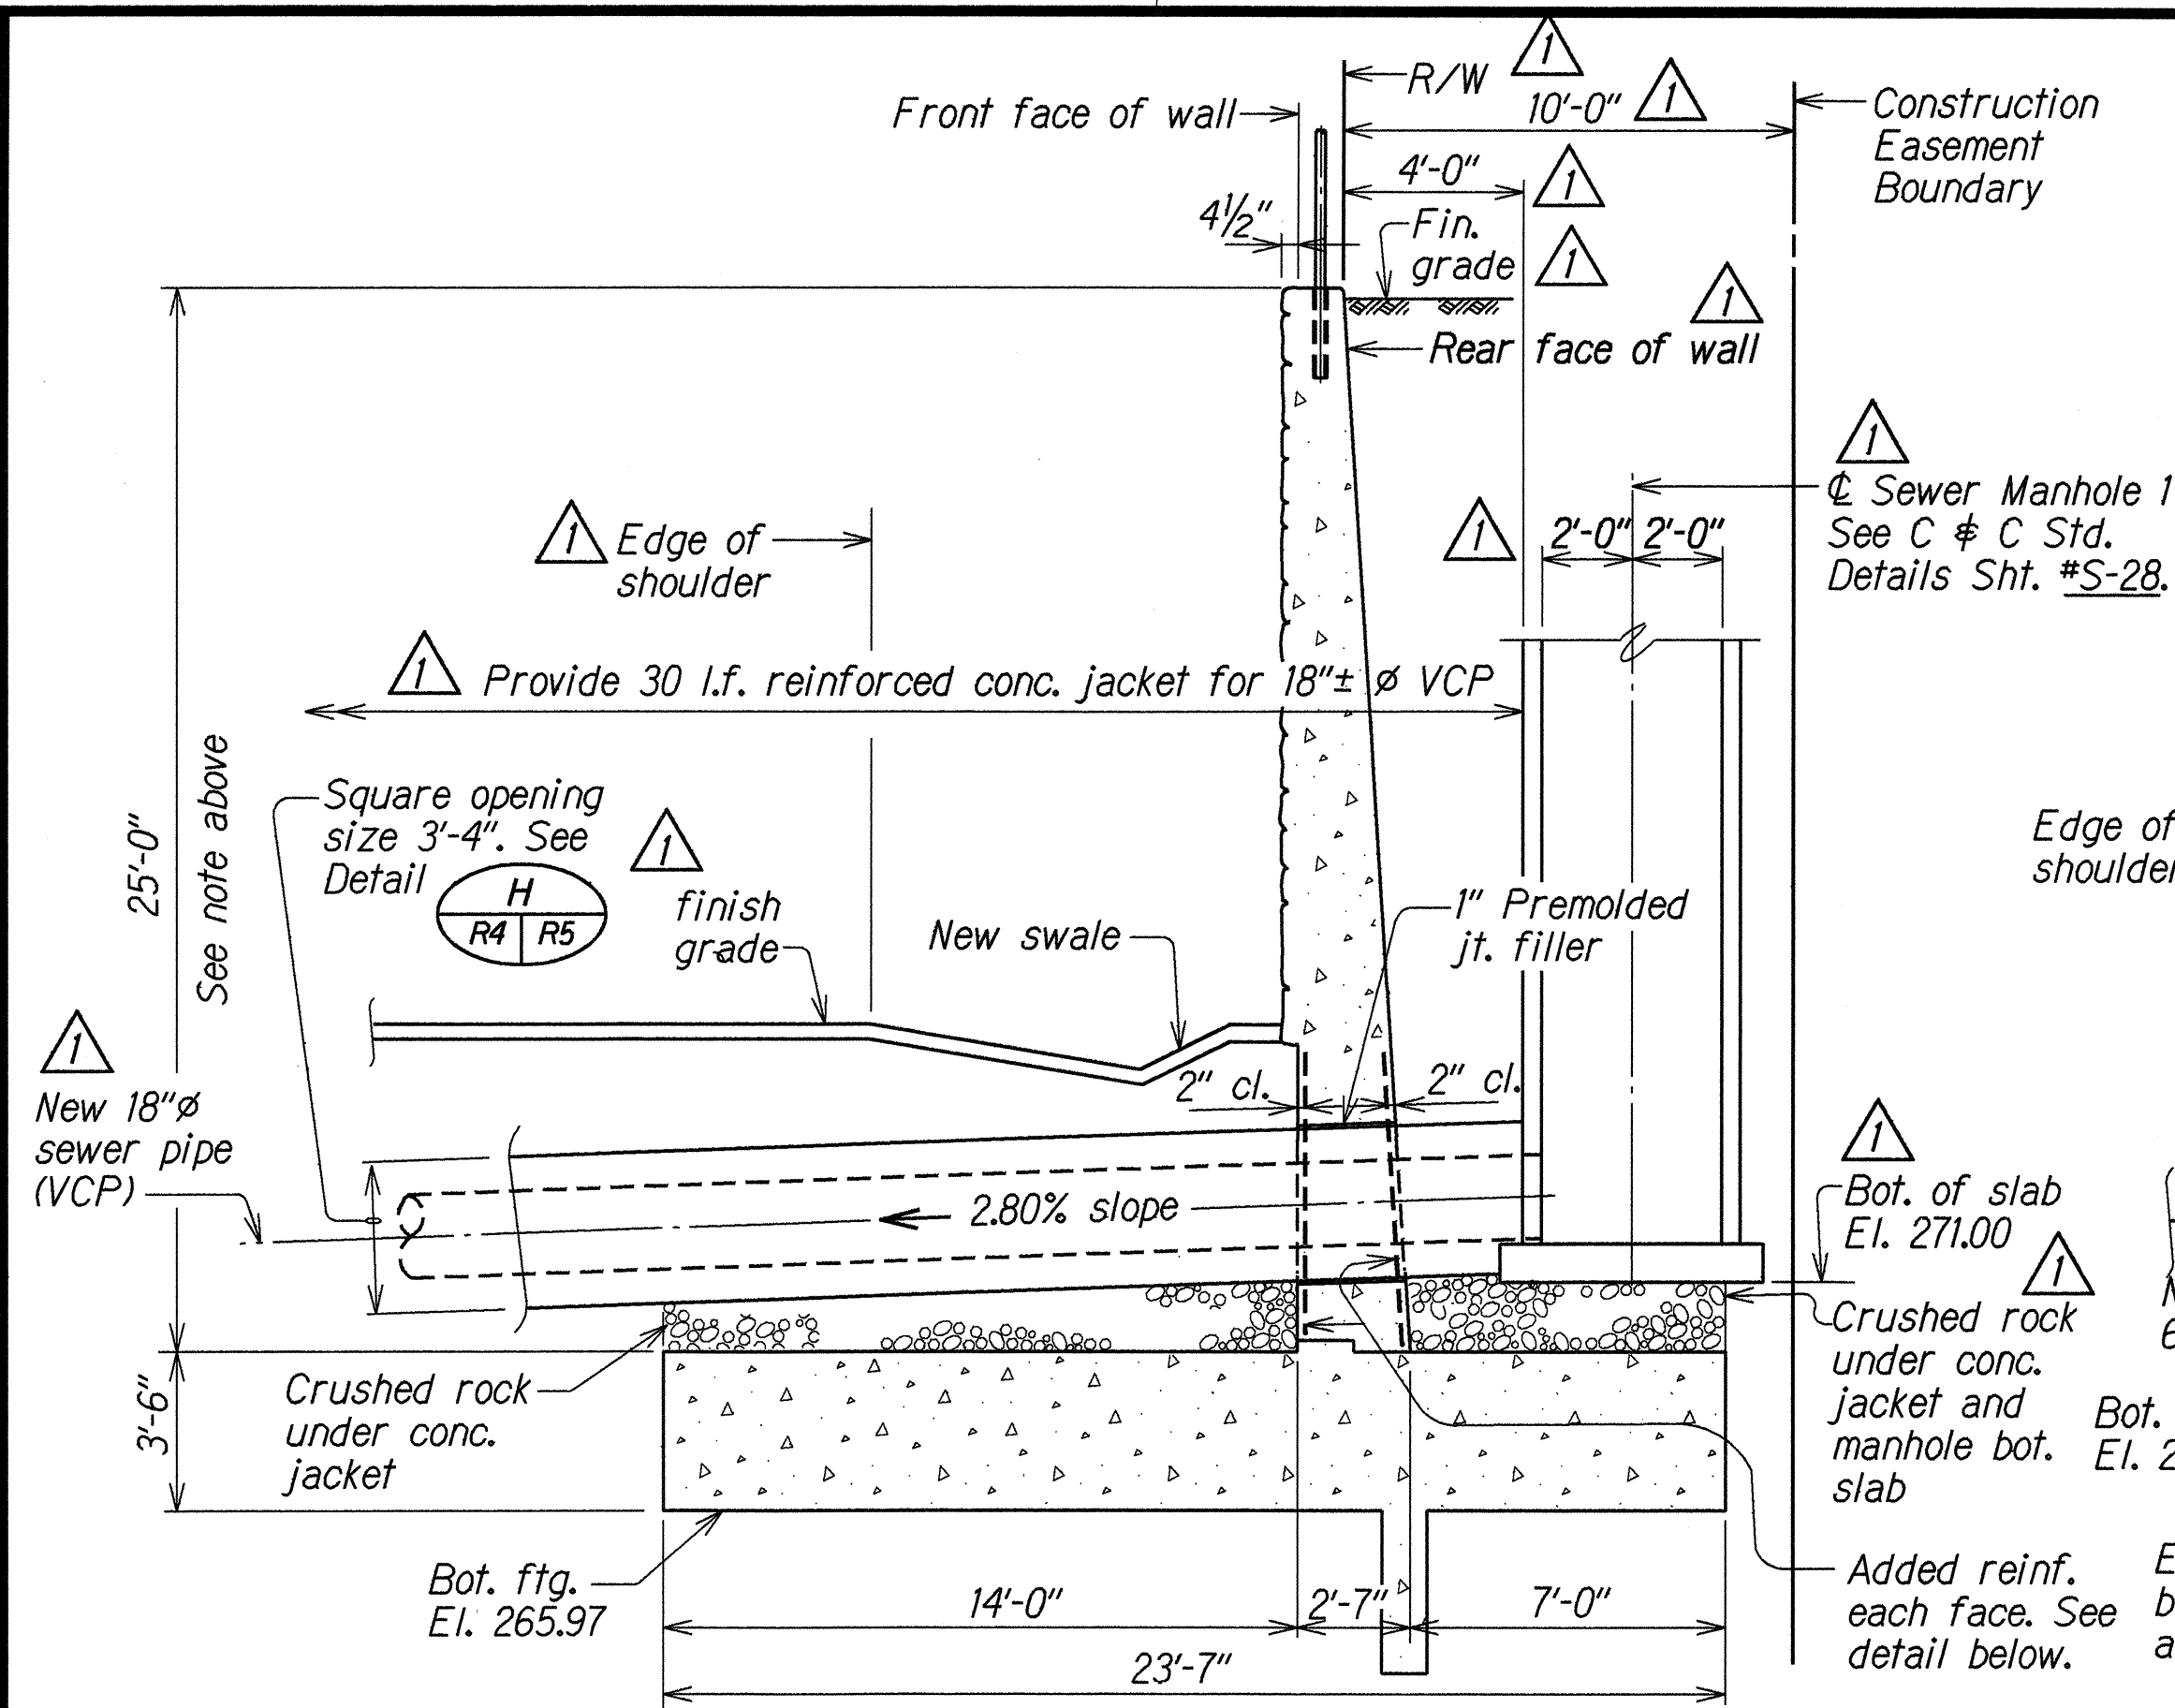


SECTION
ALONG 18" VCP
Scale: 1/4" = 1'-0"

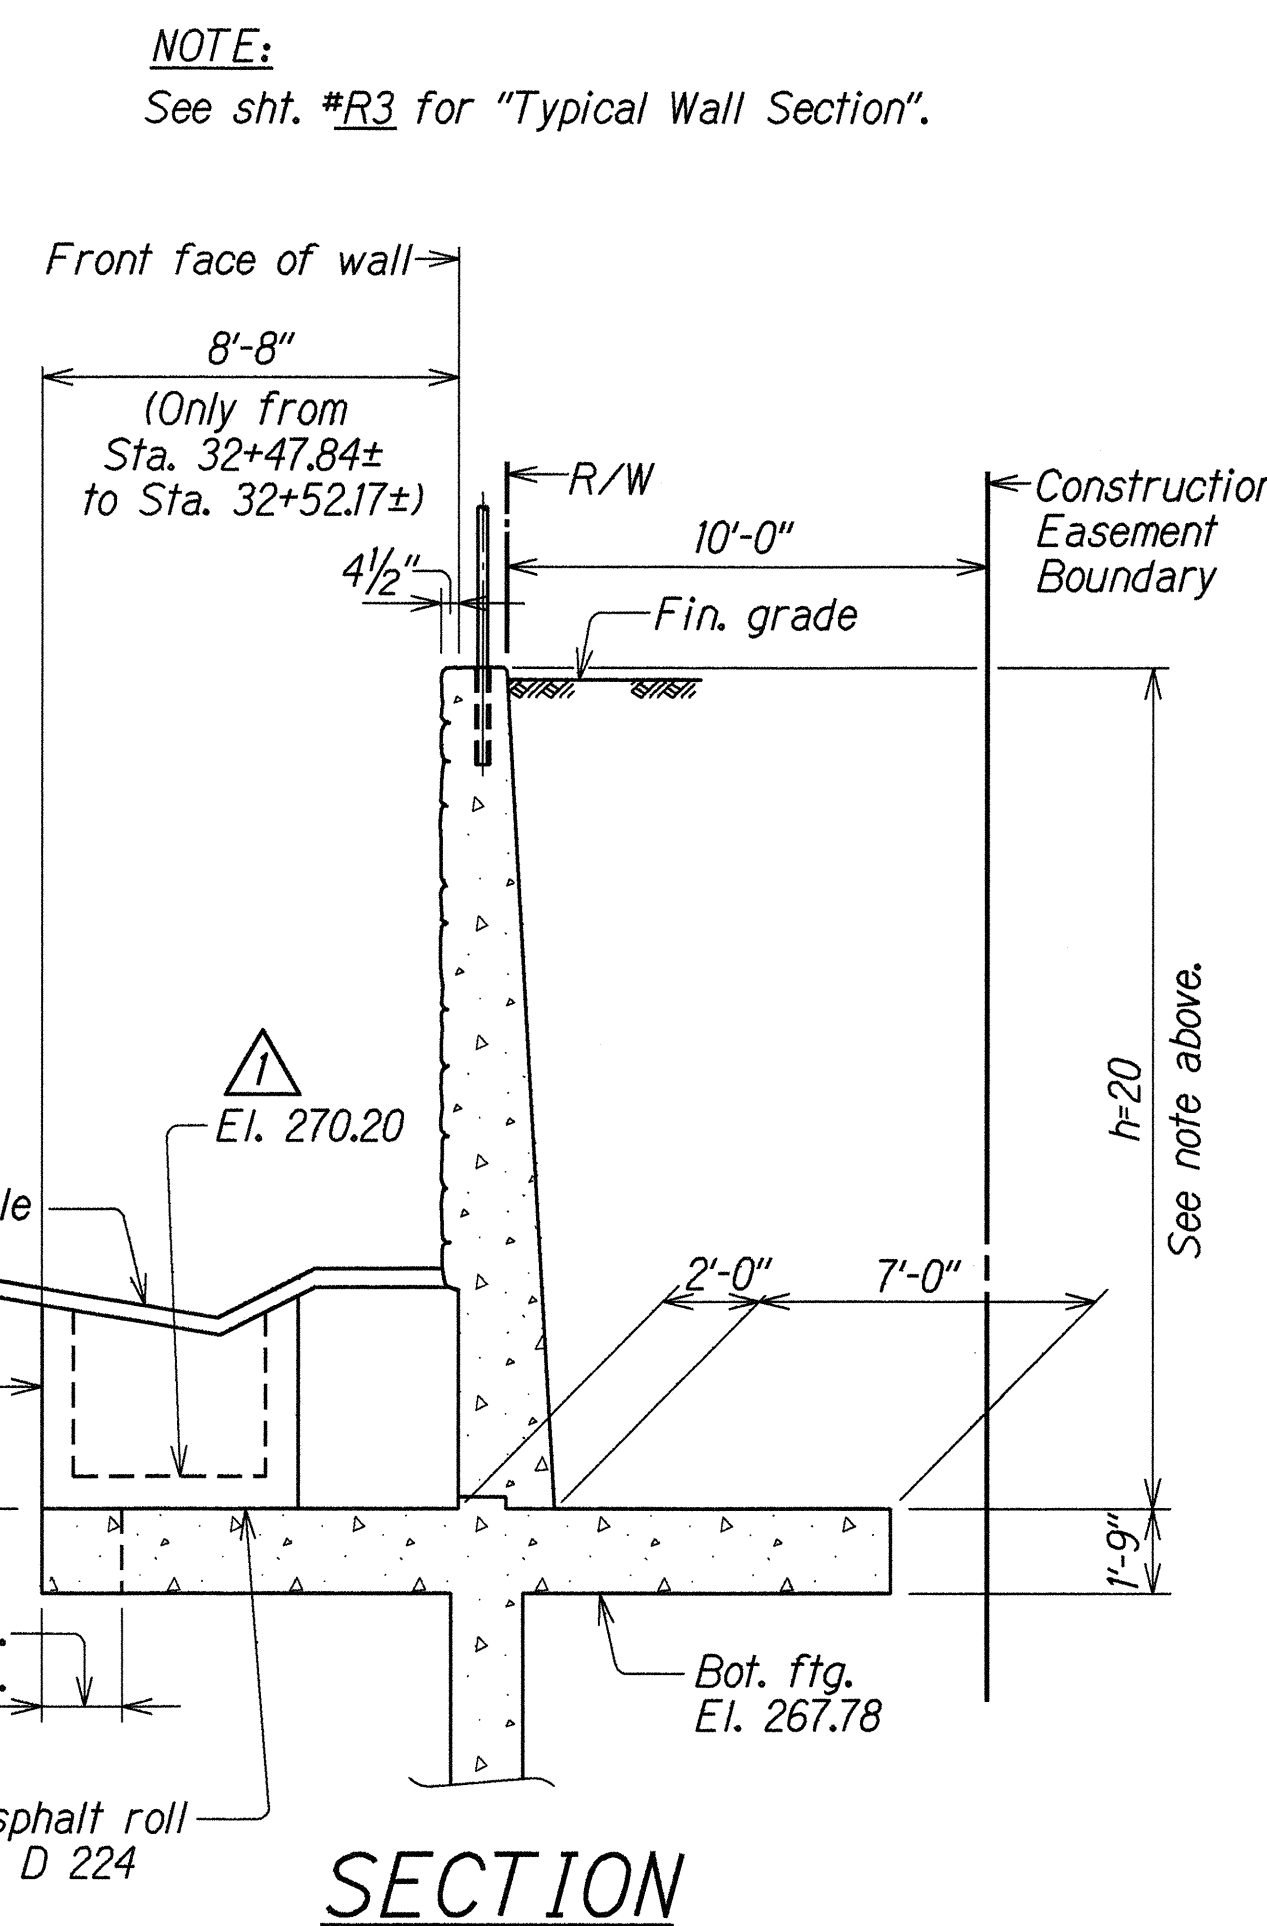


SECTION
AT STA. 32 + 50
Scale: 1/4" = 1'-0"

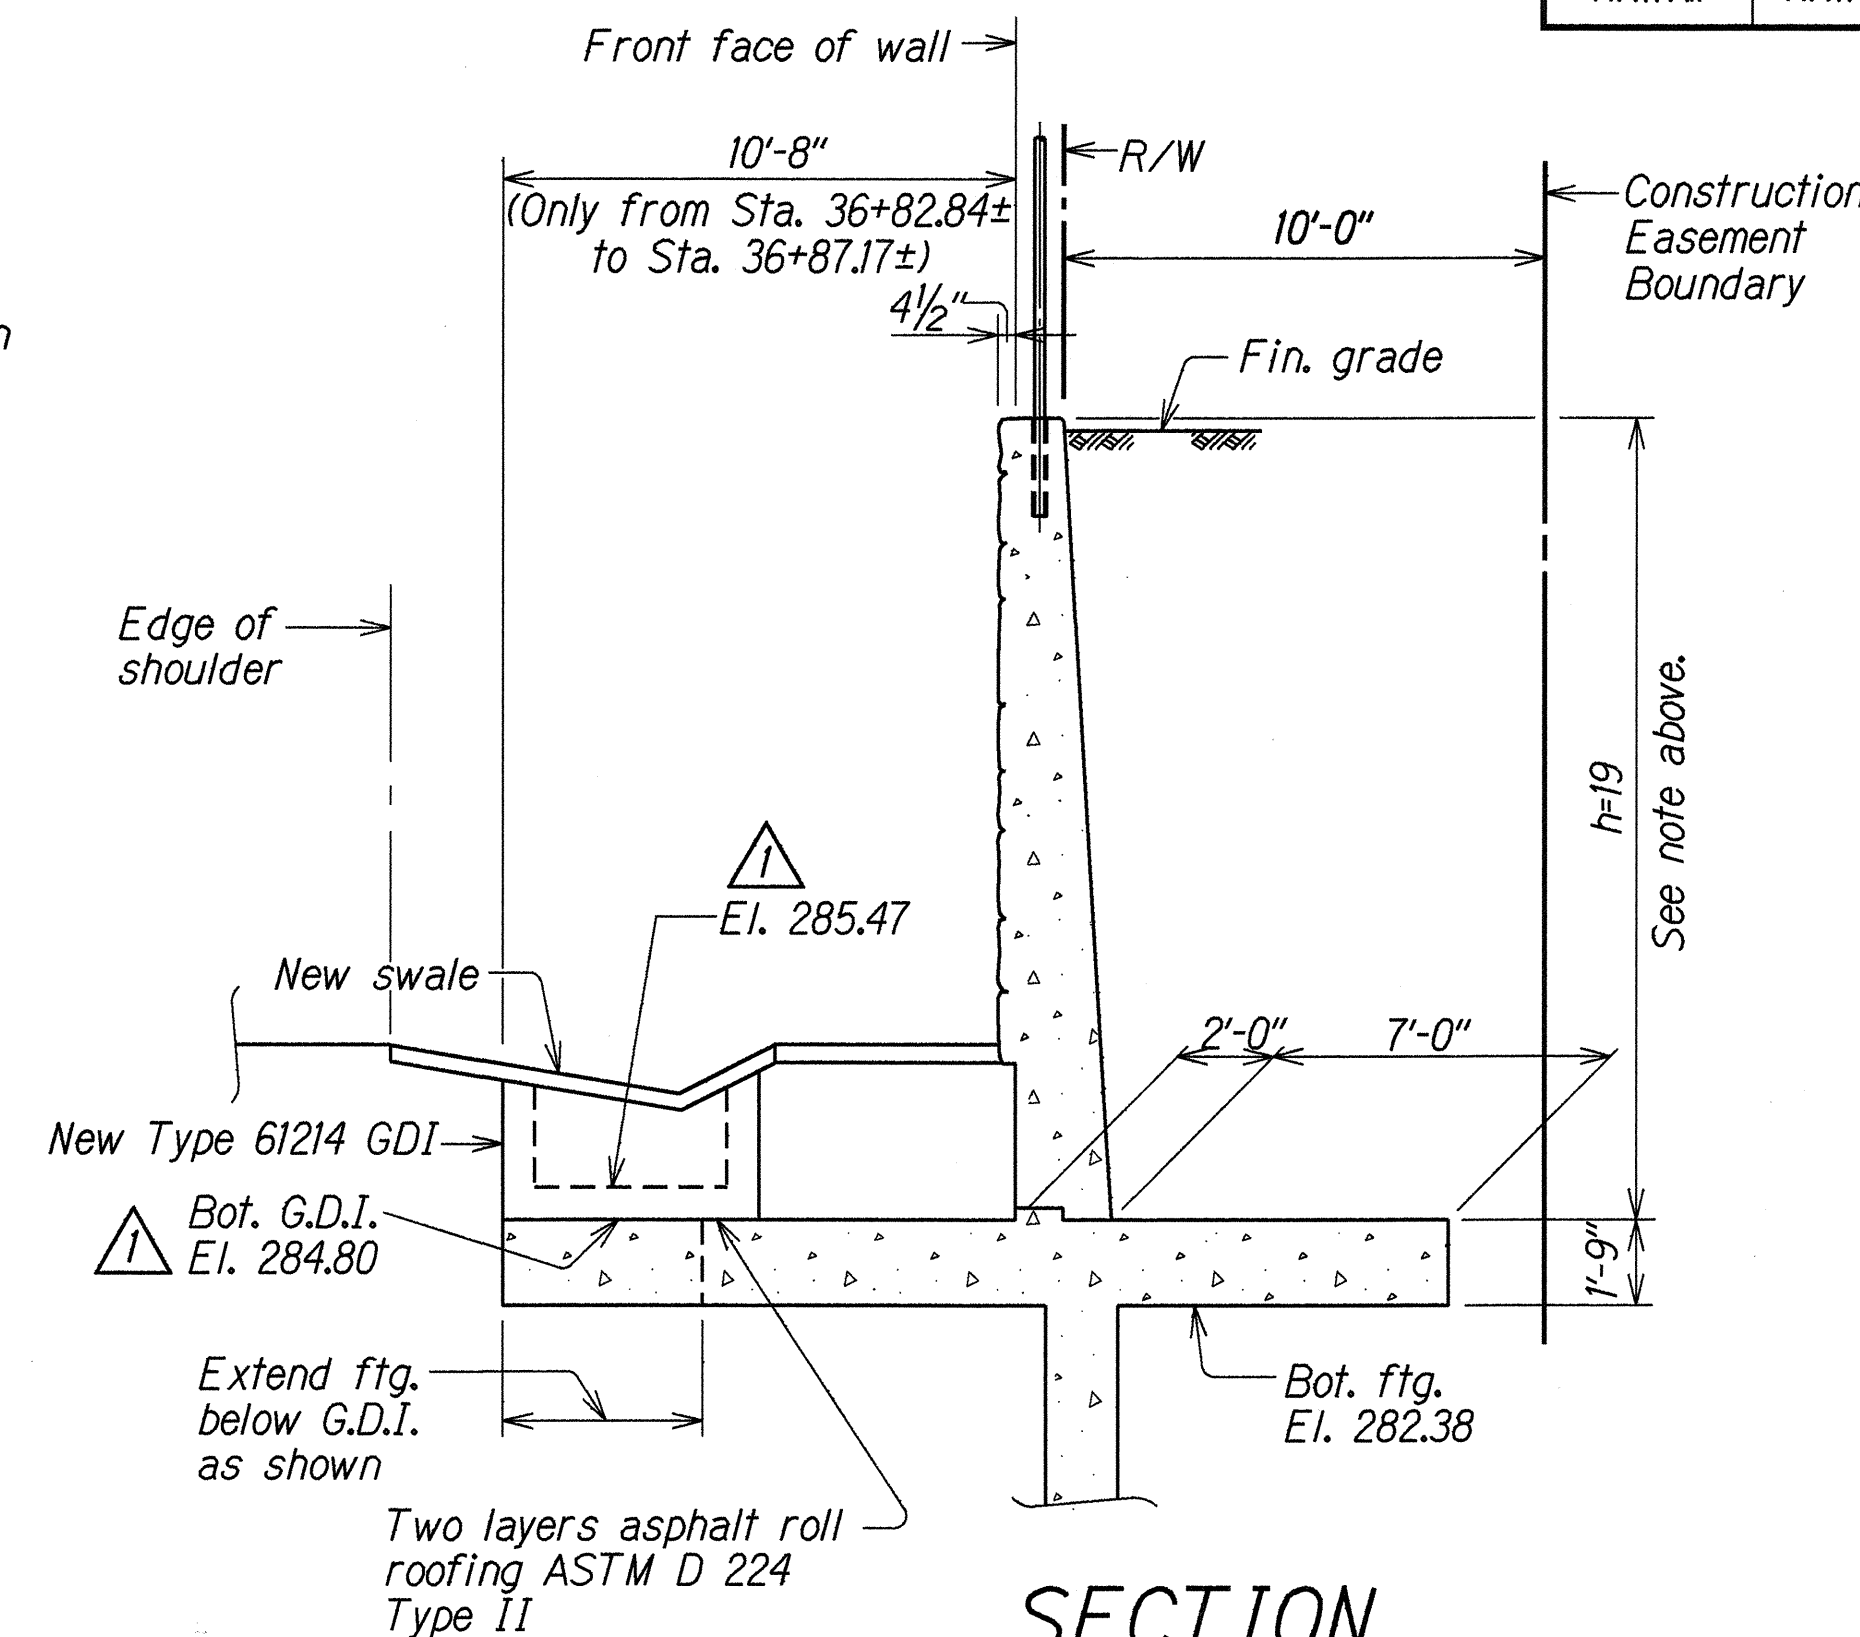


SECTION
AT STA. 36 + 85
Scale: 1/4" = 1'-0"

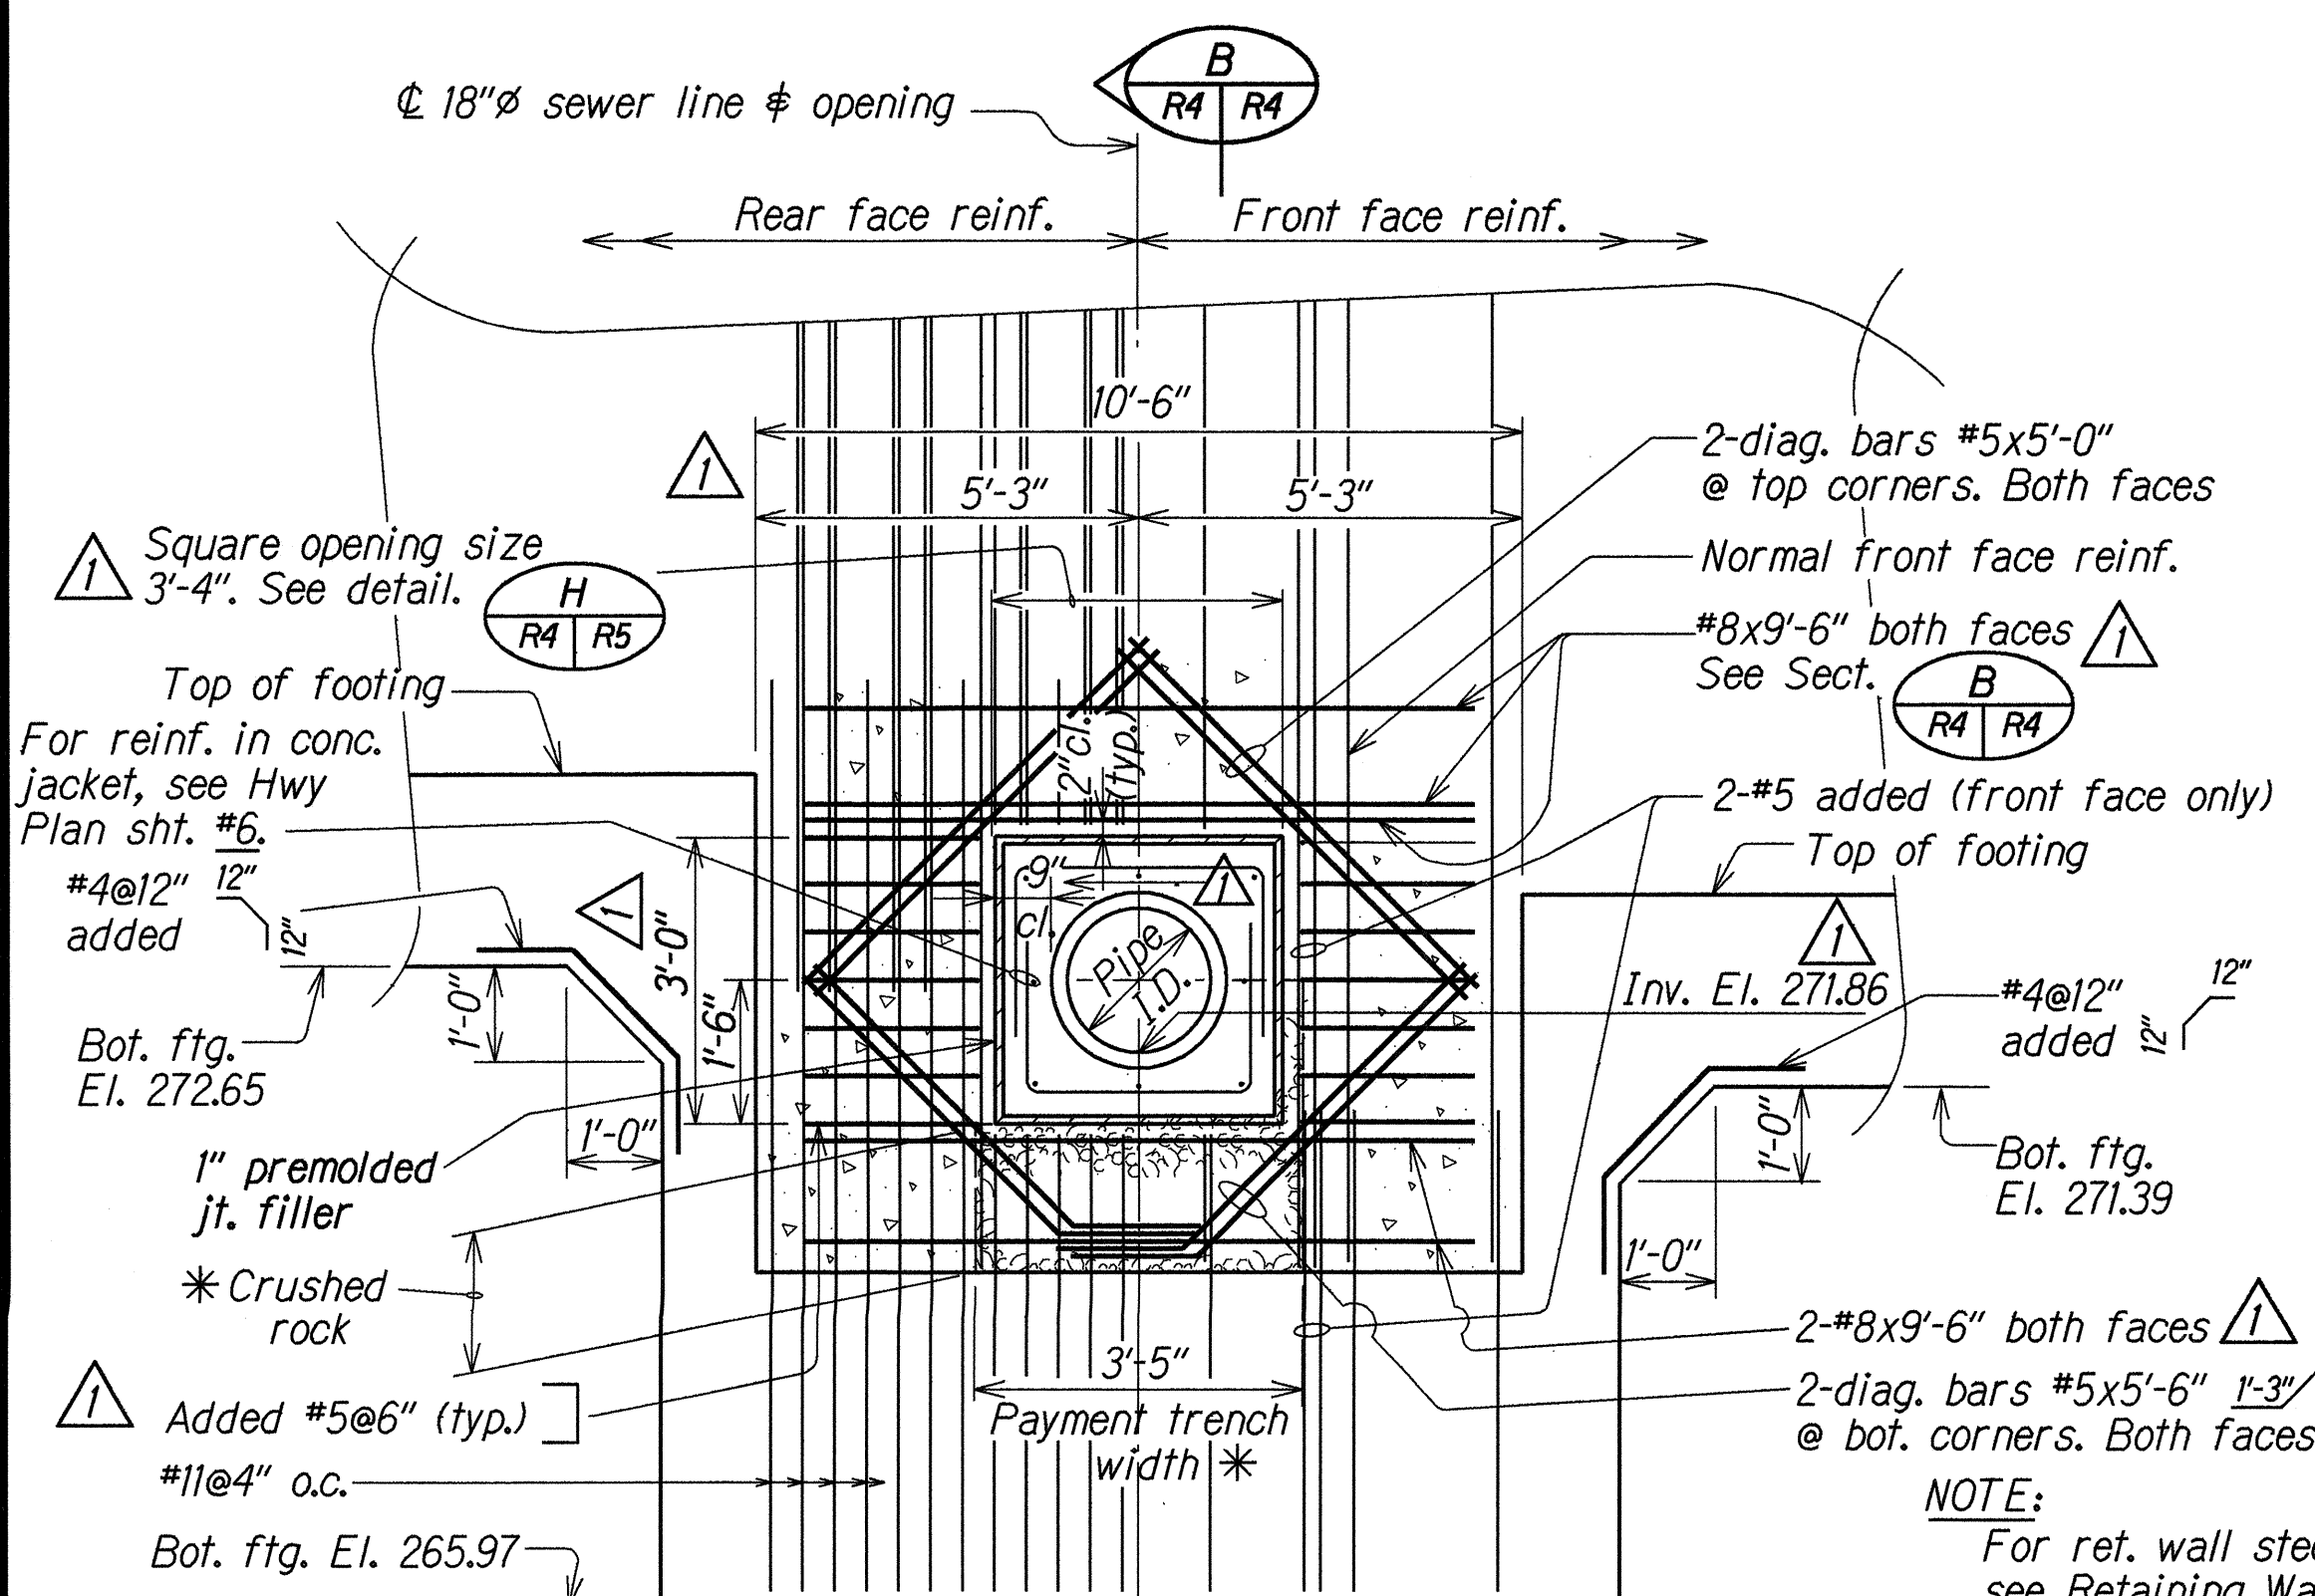


REINFORCING AT 18" SEWER PIPE
AT STA. 32 + 94.95
N.T.S.

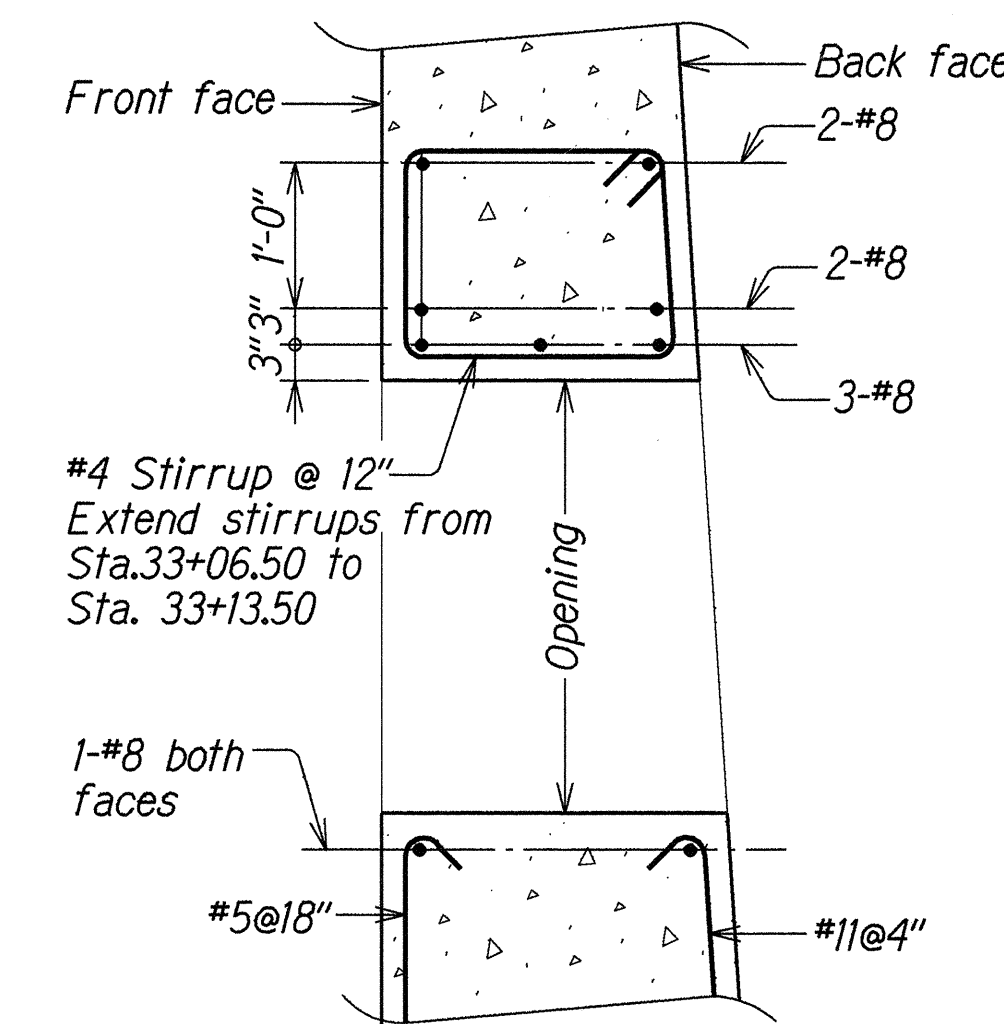

SECTION
AT STA. 32 + 50
Scale: 1/4" = 1'-0"

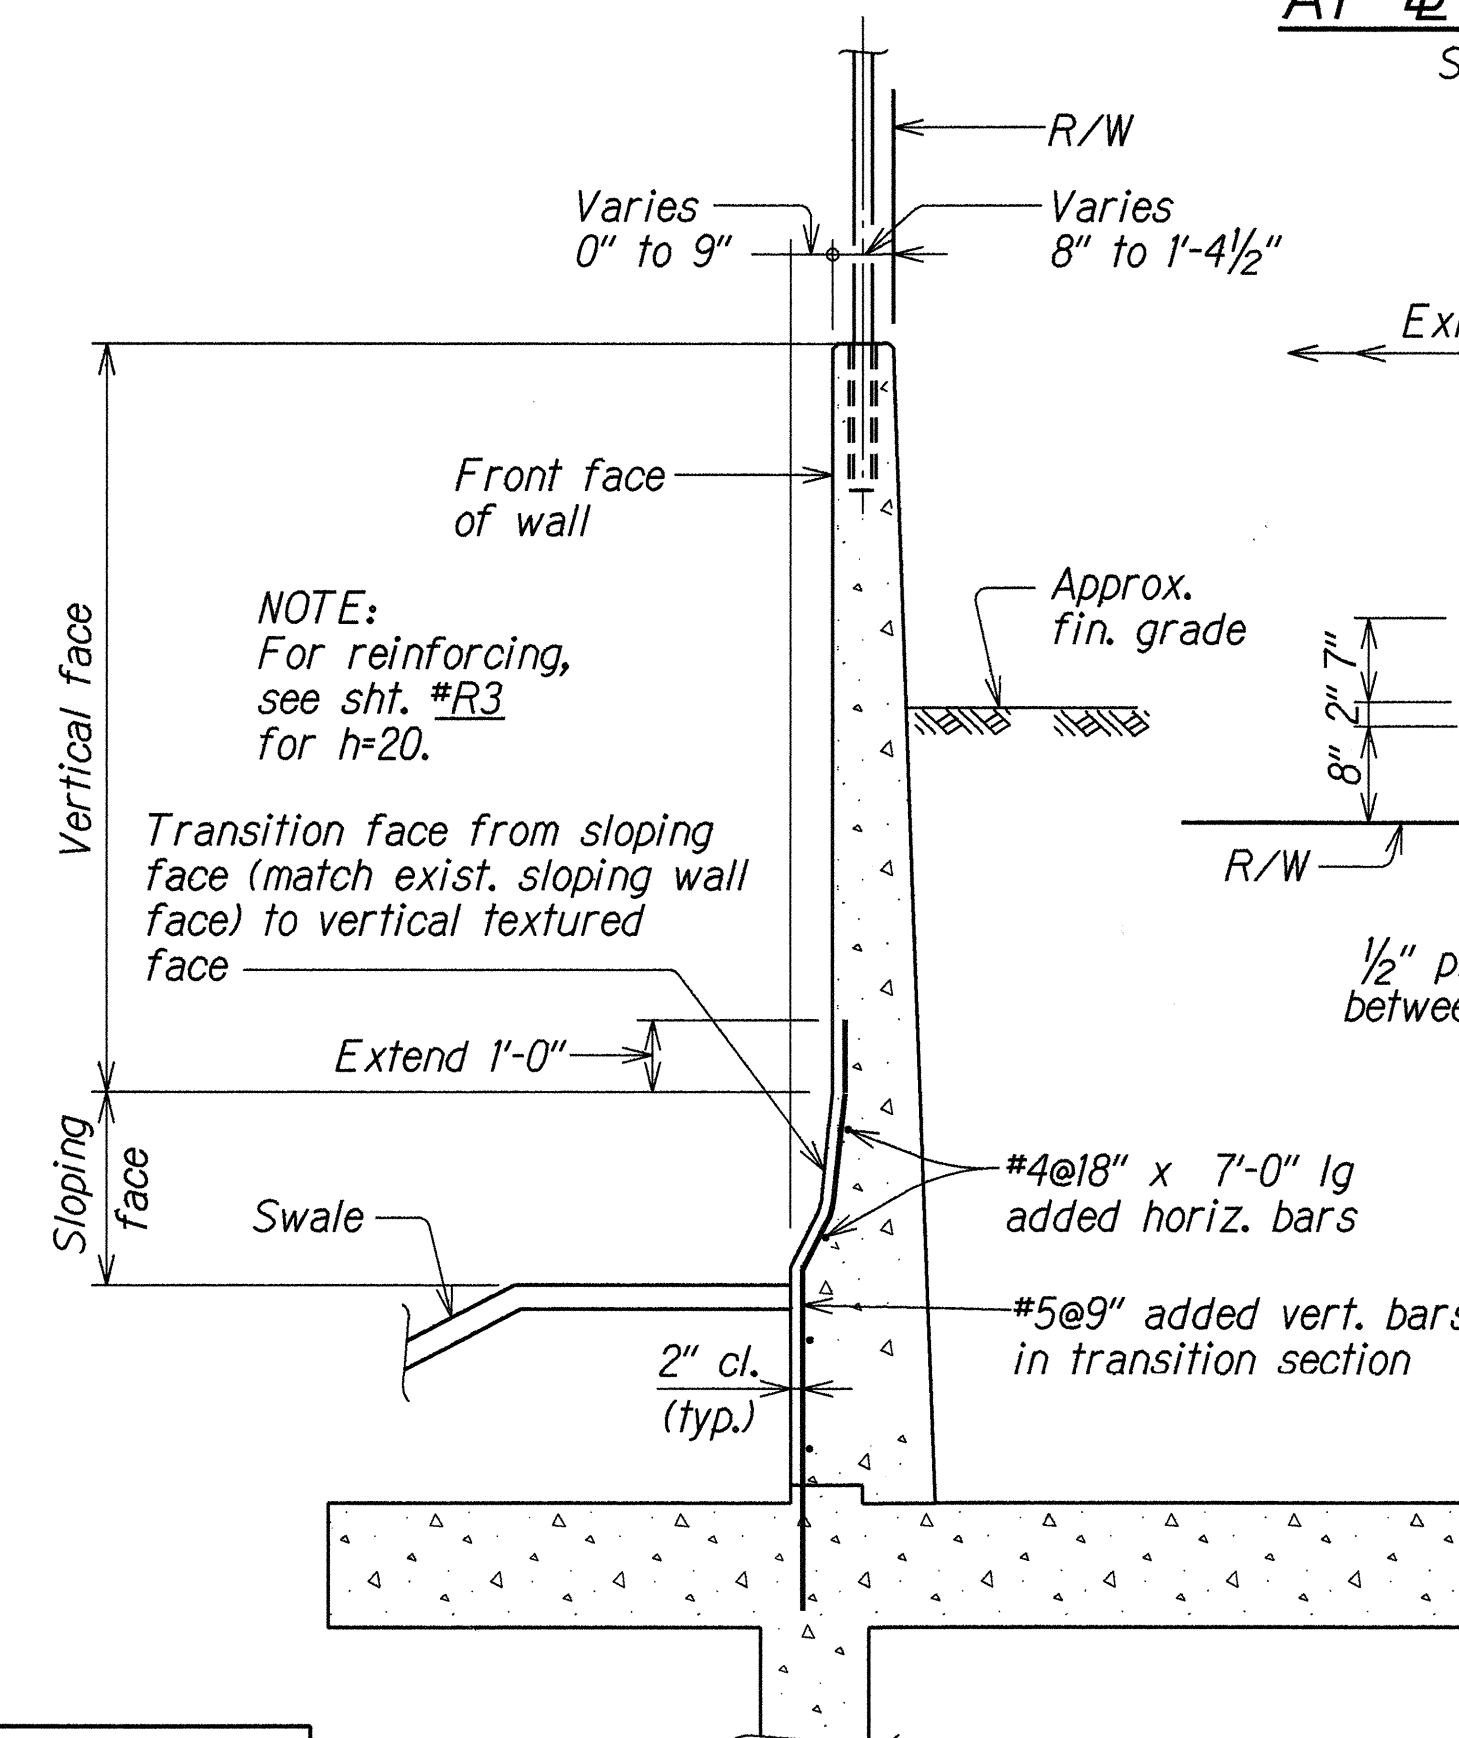

SECTION
TYPICAL TRANSITION SECTION
N.T.S.

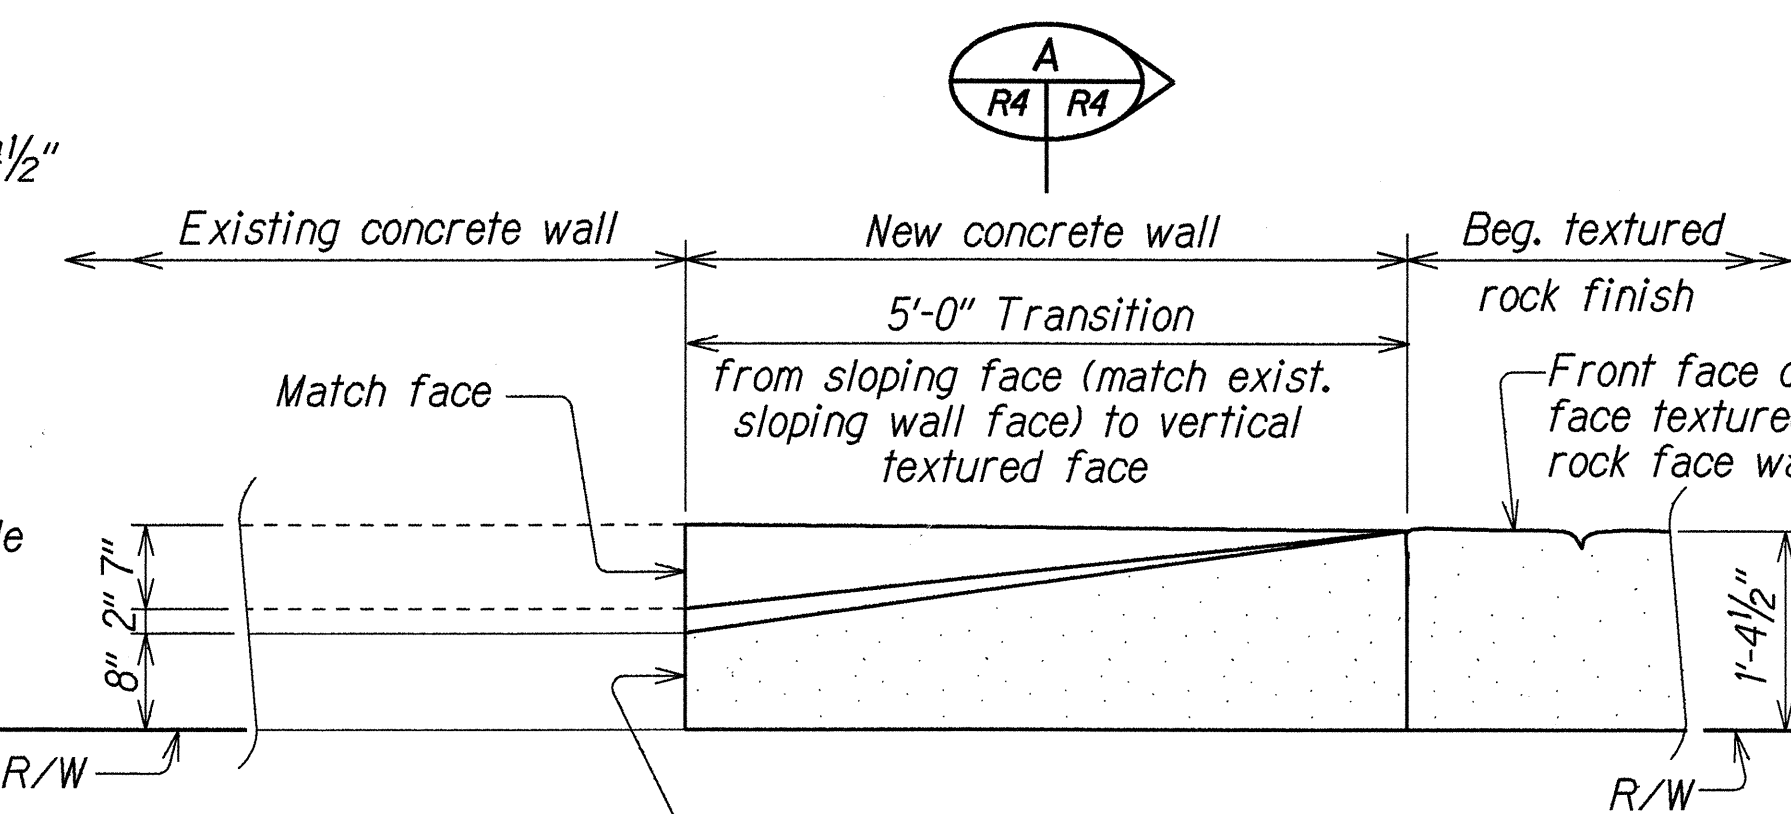

PLAN
Scale: 3/4" = 1'-0"

Concrete jacket lengthen to 30 l.f. and extended to sewer manhole at rear face. Revised clearance, dimensions, elevation & station. Revised, moved or deleted labels as necessary. Added & lengthen reinf. at square opening.

DATE	REVISION
------	----------

STATE OF HAWAII
DEPARTMENT OF TRANSPORTATION
HIGHWAYS DIVISION
RETAINING WALL
5'-0" TRANSITION, SECTIONS AT G. D. I.
SECTION AND DETAIL AT 18" SEWER PIPE
KAMEHAMEHA HIGHWAY WIDENING
LUMIAINA STREET TO WAIPIU UKA STREET
Project No. NH-099-1(9)

Scale: As Noted Date: May, 1994

SHEET No. R4 OF 5 SHEETS

C. O. 41

DATE	OCT 1992
DESIGNED BY	L.M.A.
CHECKED BY	L.M.A.
APPROVED BY	L.M.A.
QUANTITIES BY	L.M.A.
NOTED BY	L.M.A.

APPROVED:
[Signature]
2/15/95
DATE
CHIEF, DIVISION OF PLANNING & SERVICES CONTROL
DEPARTMENT OF WASTEWATER MANAGEMENT
(FOR SEWER WORK WITHIN PUBLIC R/W AND EASEMENT ONLY)

The image contains two technical drawings: a 'JOINT ELEVATION' on the left and a 'SECTION' on the right.

JOINT ELEVATION: This drawing shows a cross-section of a roof joint. A vertical wall on the left is labeled 'Reference- Front face of wall'. It is covered with '1- layer 45# composition roofing paper'. A 'key' is shown in the joint, with a circular detail 'A' showing a radius of 'R5'. A 'Construction jt.' is indicated at the base of the wall. 'Flashing compound' is applied around the base of the wall. The base of the wall is '12"'. The base of the joint is '4"'. A '1/2" premolded joint filler' is shown at the base of the wall. A '1 3/4" x 4" cont. key Similar as Section' is shown at the base of the joint. A circular detail 'B' shows a radius of 'R5'.

SECTION: This drawing shows a cross-section of a roof joint. It shows '1- layer 45# composition roofing paper' on both sides. A '1/2" premolded joint filler (expansion jt.)' is shown in the joint. A '1- layer 45# comp. roofing paper (contraction jt.)' is shown on the right side. A 'Premolded filler & key in footing at expansion joint only' is shown at the base of the joint. A circular detail 'A' shows a radius of 'R5'.



[illegible]

Diagram illustrating the plan and section views of a continuous footing.

PLAN View: Shows the front face of wall and the footing width of 12".

SECTION View: Shows the footing height of 12" and the reinforcement details. The reinforcement consists of #4@12" each face, with 2" cl. (clearance) and a typical spacing of 1'-6".

The diagram also includes a circular symbol with 'D' and 'R5' in both views.

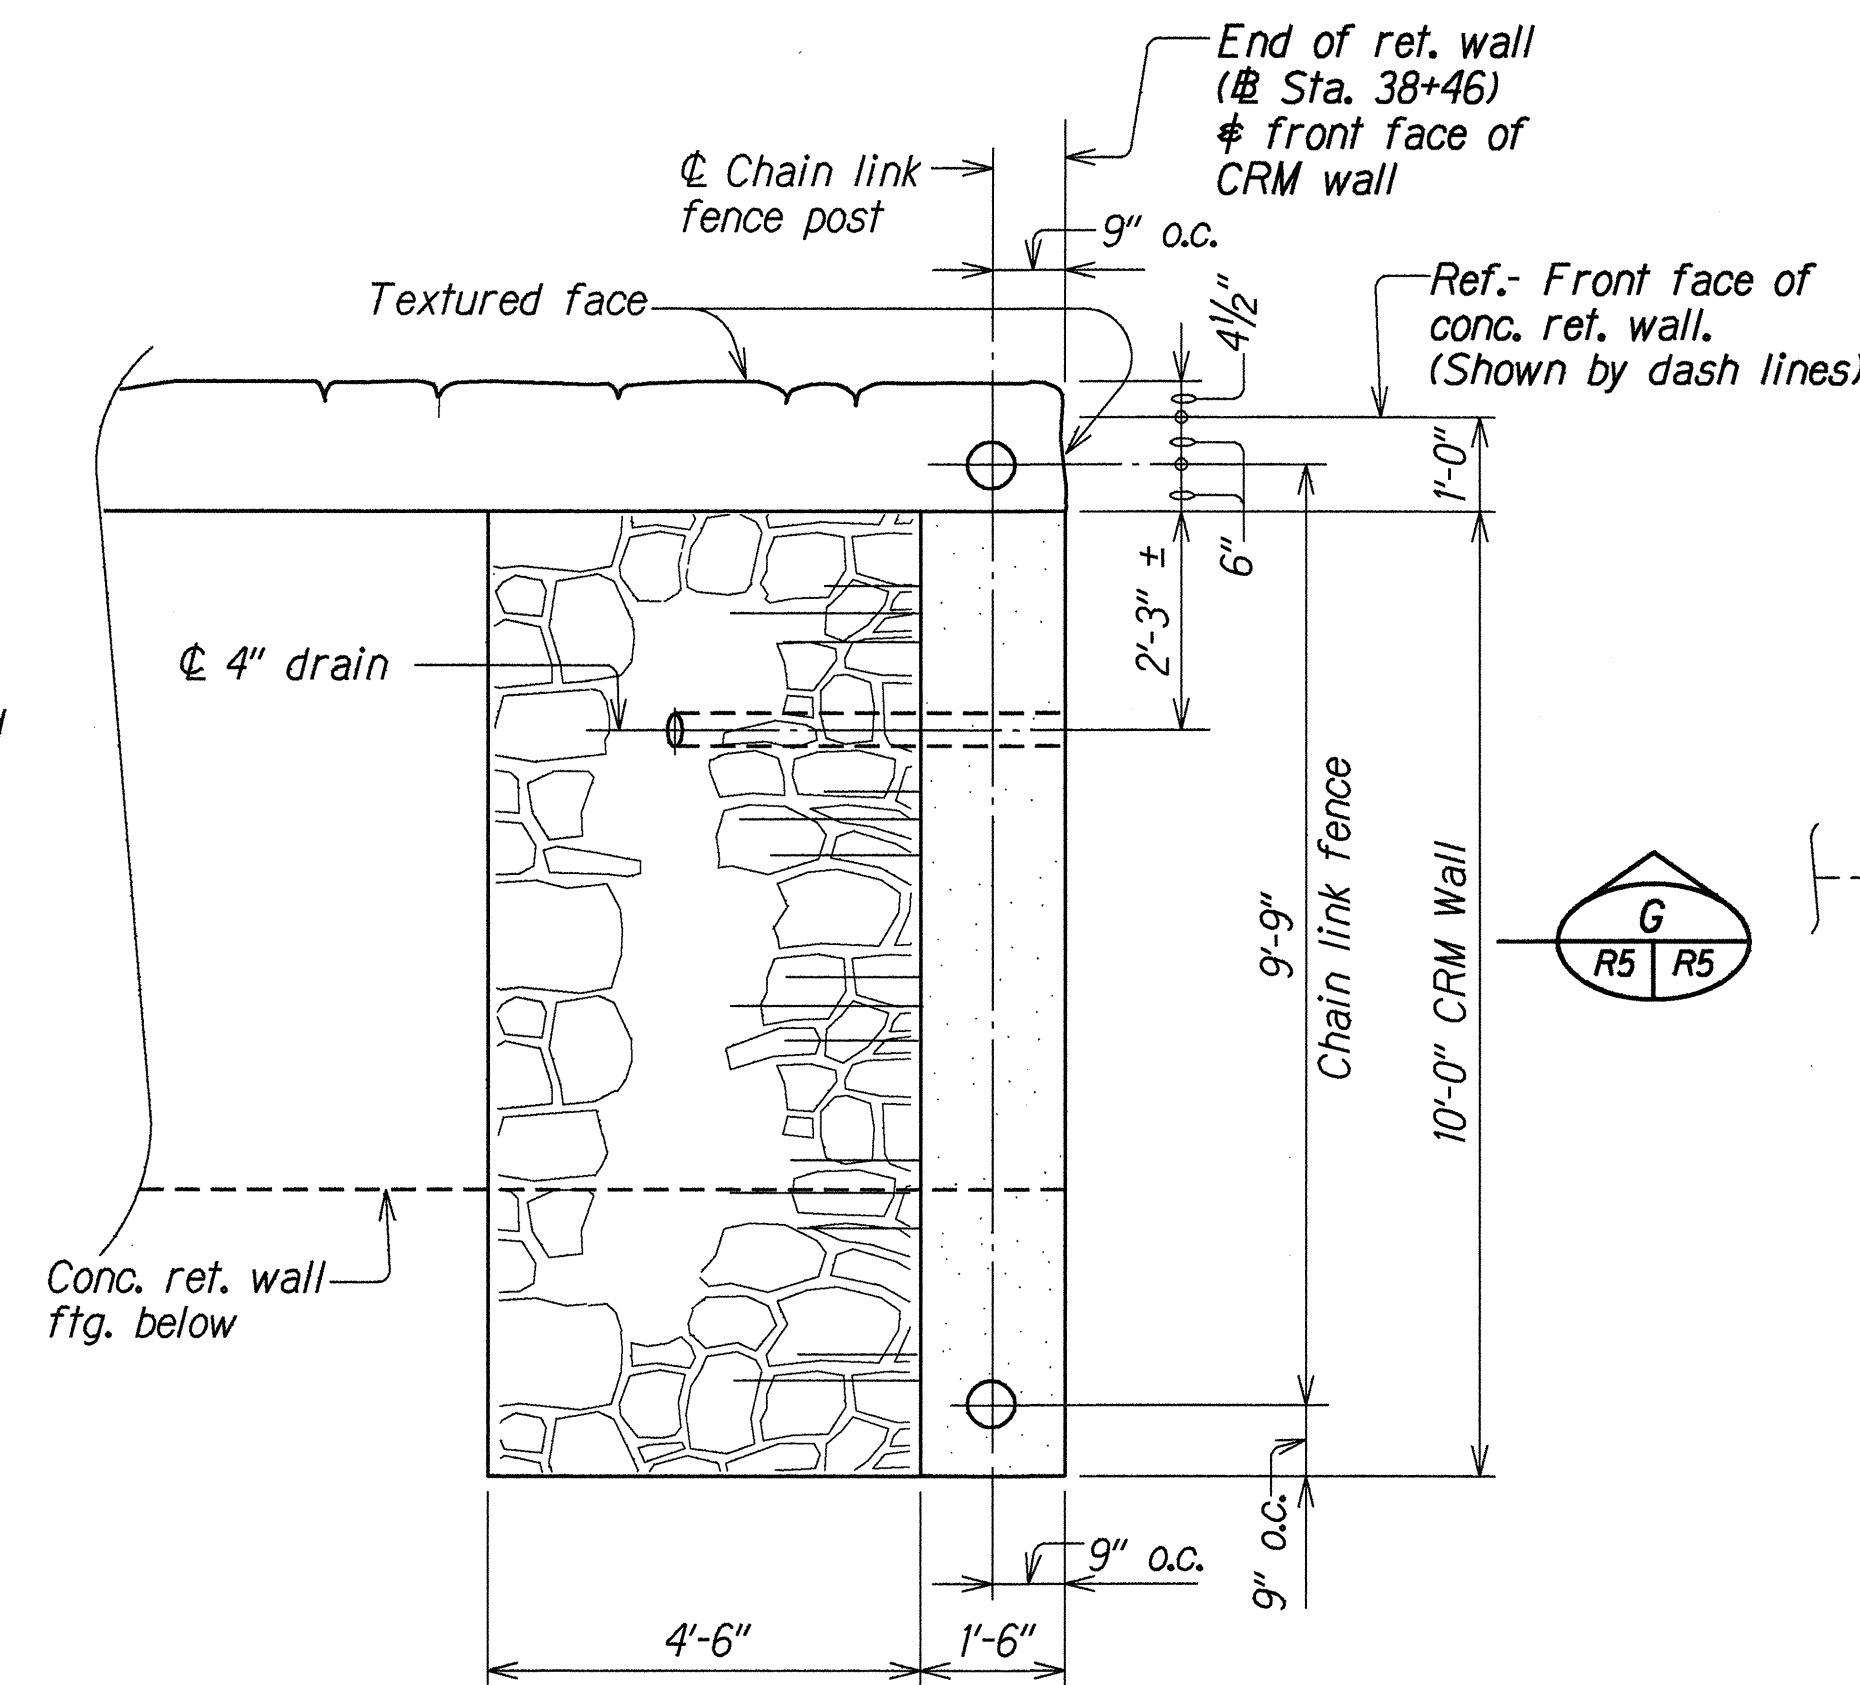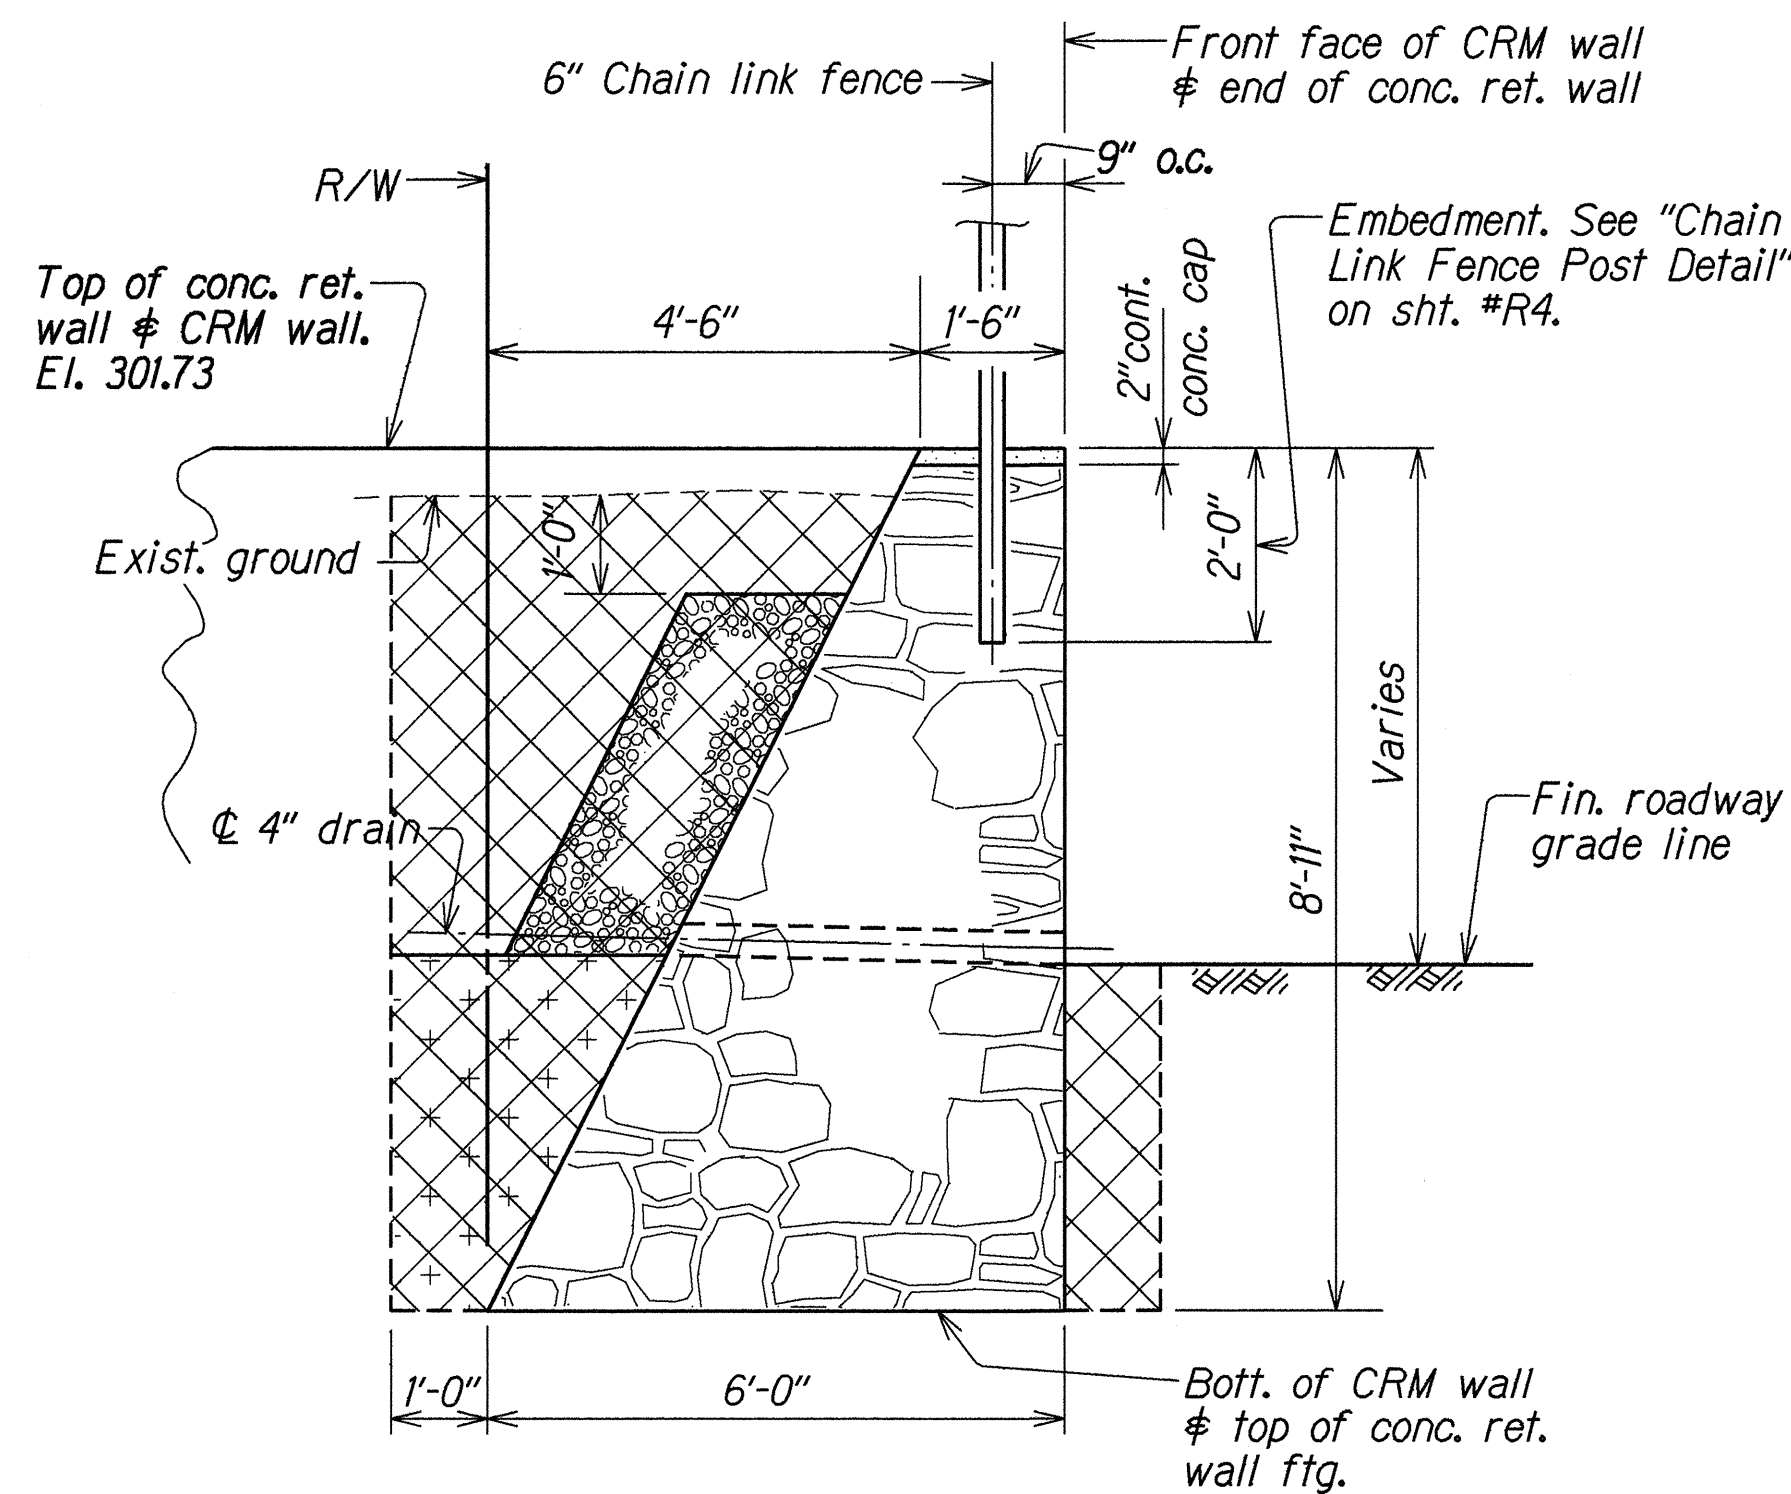

Front face of wall

1'-6" Typ.

2" cl.

2" cl.

12"

12"

4#12" each face

4#12" each face

12"

PLAN

SECTION

AT EXPANSION JOINT

TYPICAL FOOTING STEP-UP DETAILS

NOT TO SCALE

8' 2' 10"

sewer
(CP)

3'-4"

1'-8"

1'-8"

Reinforced conc.
jacket. See Plan
Sht. #6.

Front face of wall

Back face of wall

6"

Sta. 32+94.95±


Sta. 32+95.32±

Scale: 1/2" = 1'-0"

DETAIL

H

R4 R5

DETAIL 
Scale: 1/2" = 1'-0"

C. O. 42