\$1.50 P. P. C. C. N. S. C. C. S. C. S.	HERDE TO BE AND A CONTROL OF THE SECOND STATE OF THE SECOND STATE OF THE SECOND	
INDEX TO DRAWINGS		
SHEET NO.	DESCRIPTION	
1	TITLE SHEET	
2	STANDARD PLANS SUMMARY	
3	GENERAL NOTES AND LEGEND	
4	NPDES GENERAL NOTES	
5 – 7	TYPICAL SECTIONS	
8	TYPICAL DETAILS	
9 – 16	DETAILS	
17 – 18	GUARDRAIL SCHEDULE	
19 – 26	ROADWAY PLANS	
27 – 29	DRAINAGE DETAILS	
30	BRIDGE RAILING UPGRADE,	
	LOCATION PLAN, GENERAL NOTES,	
	AND ESTIMATED QUANTITIES	
31 – 34	WAIPAHU OVERPASS	
35 – 36	STRUCTURES NO. 4A AND NO. 4B	
37 – 38	STRUCTURES NO. 10A AND NO. 10B	
39 – 42	STRUCTURE NO. 12	
43 – 44	BRIDGE DETAILS	
45	TRAFFIC LEGEND, DETAIL AND	
	NOTES	
46 – 53	PAVEMENT MARKING AND SIGNING	
	PLANS	
54 – 57	TRAFFIC DETAILS	
58	TRAFFIC SUMMARIES	

STATE OF HAWAII

DEPARTMENT OF TRANSPORTATION

HIGHWAYS DIVISION HONOLULU, HAWAII


"AS-BUILT"

PLANS FOR

KAMEHAMEHA HIGHWAY RESURFACING

LUMIAINA STREET TO FARRINGTON HIGHWAY FEDERAL AID PROJECT NO. STP-099-1(13)

DISTRICT OF EWA
ISLAND OF OAHU

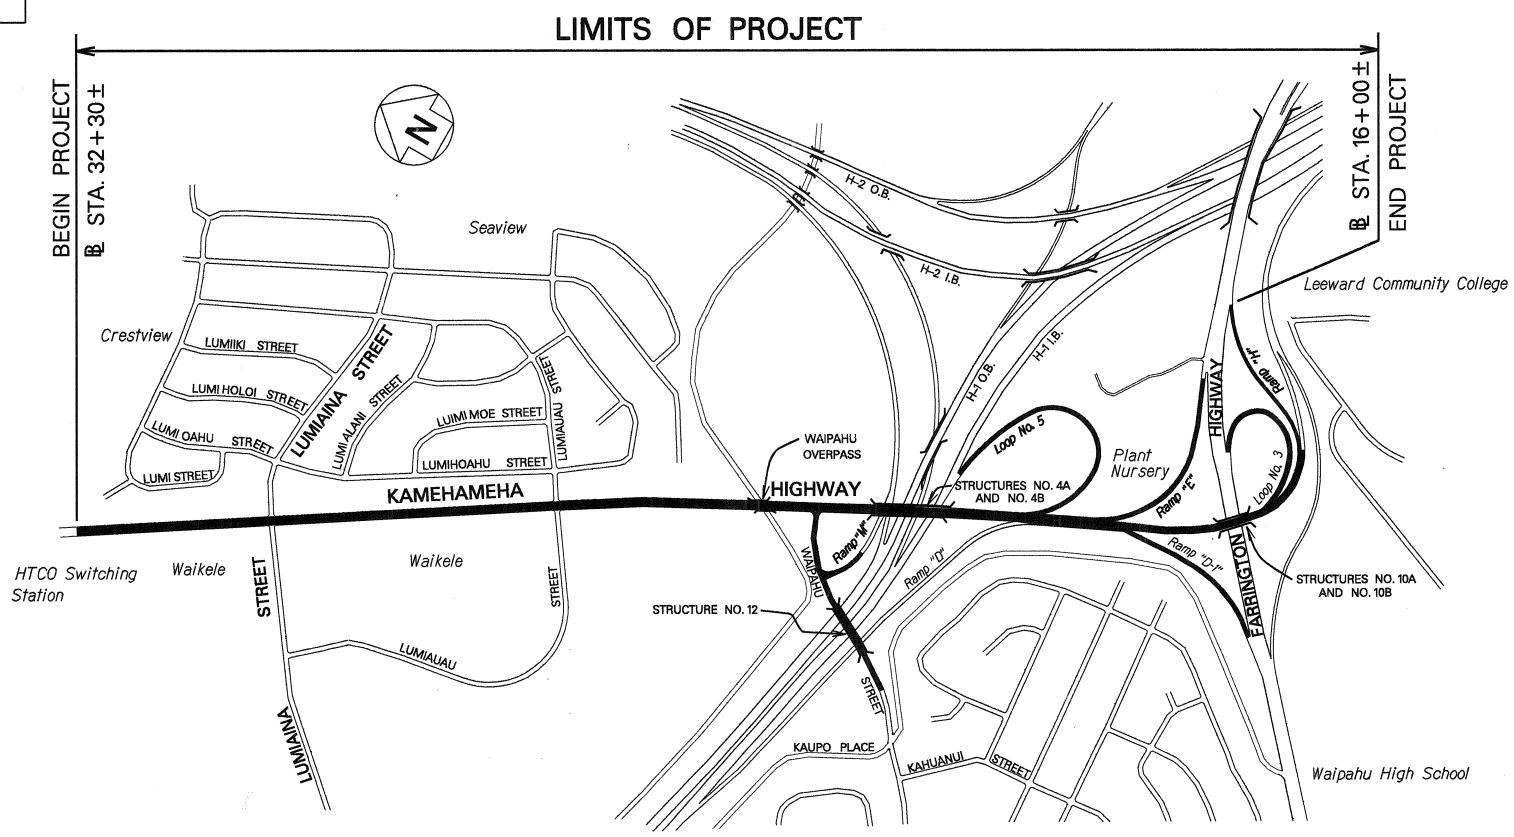

Walance
Walanc

FEDERAL AID PROJECTS PREVIOUSLY CONSTRUCTED OR UNDER CONSTRUCTION

SCALE IN MILES

FED. AÍD PROJ. NO.


STP-099-1(13)

MILE POST 16.10 TO MILE POST 17.73

DESIGN DESIGNATION

	(1995)	
	(2015)	
D		70/30
V		40 IVI.P.H.

LOCATION PLAN
LENGTH OF PROJECT.....1.63 MILES

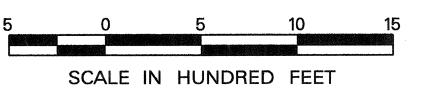

CHANGES MADE DURING CONSTRUCTION HAVE BEEN INCORPORATED ON THESE PLANS EXCEPT CHANGES IN THE ORIGINAL THEORETICAL QUANTITIES. FOR ACTUAL QUANTITIES, REFER TO PROJECT LEDGER AND/OR COMPUTATION BOOK

DEPARTMENT OF TRANSPORTATION STATE OF HAWAII

APPROVED:

| Jayanhah 3/8/95

DIR: OF TRANSPORTATION DATE