



FED. ROAD DIST. NO.	STATE	FED. AID PROJ. NO.	FISCAL YEAR	SHEET NO.	TOTAL SHEETS
HAWAII	HAW.	STP-099-1(13)	1995	5	58

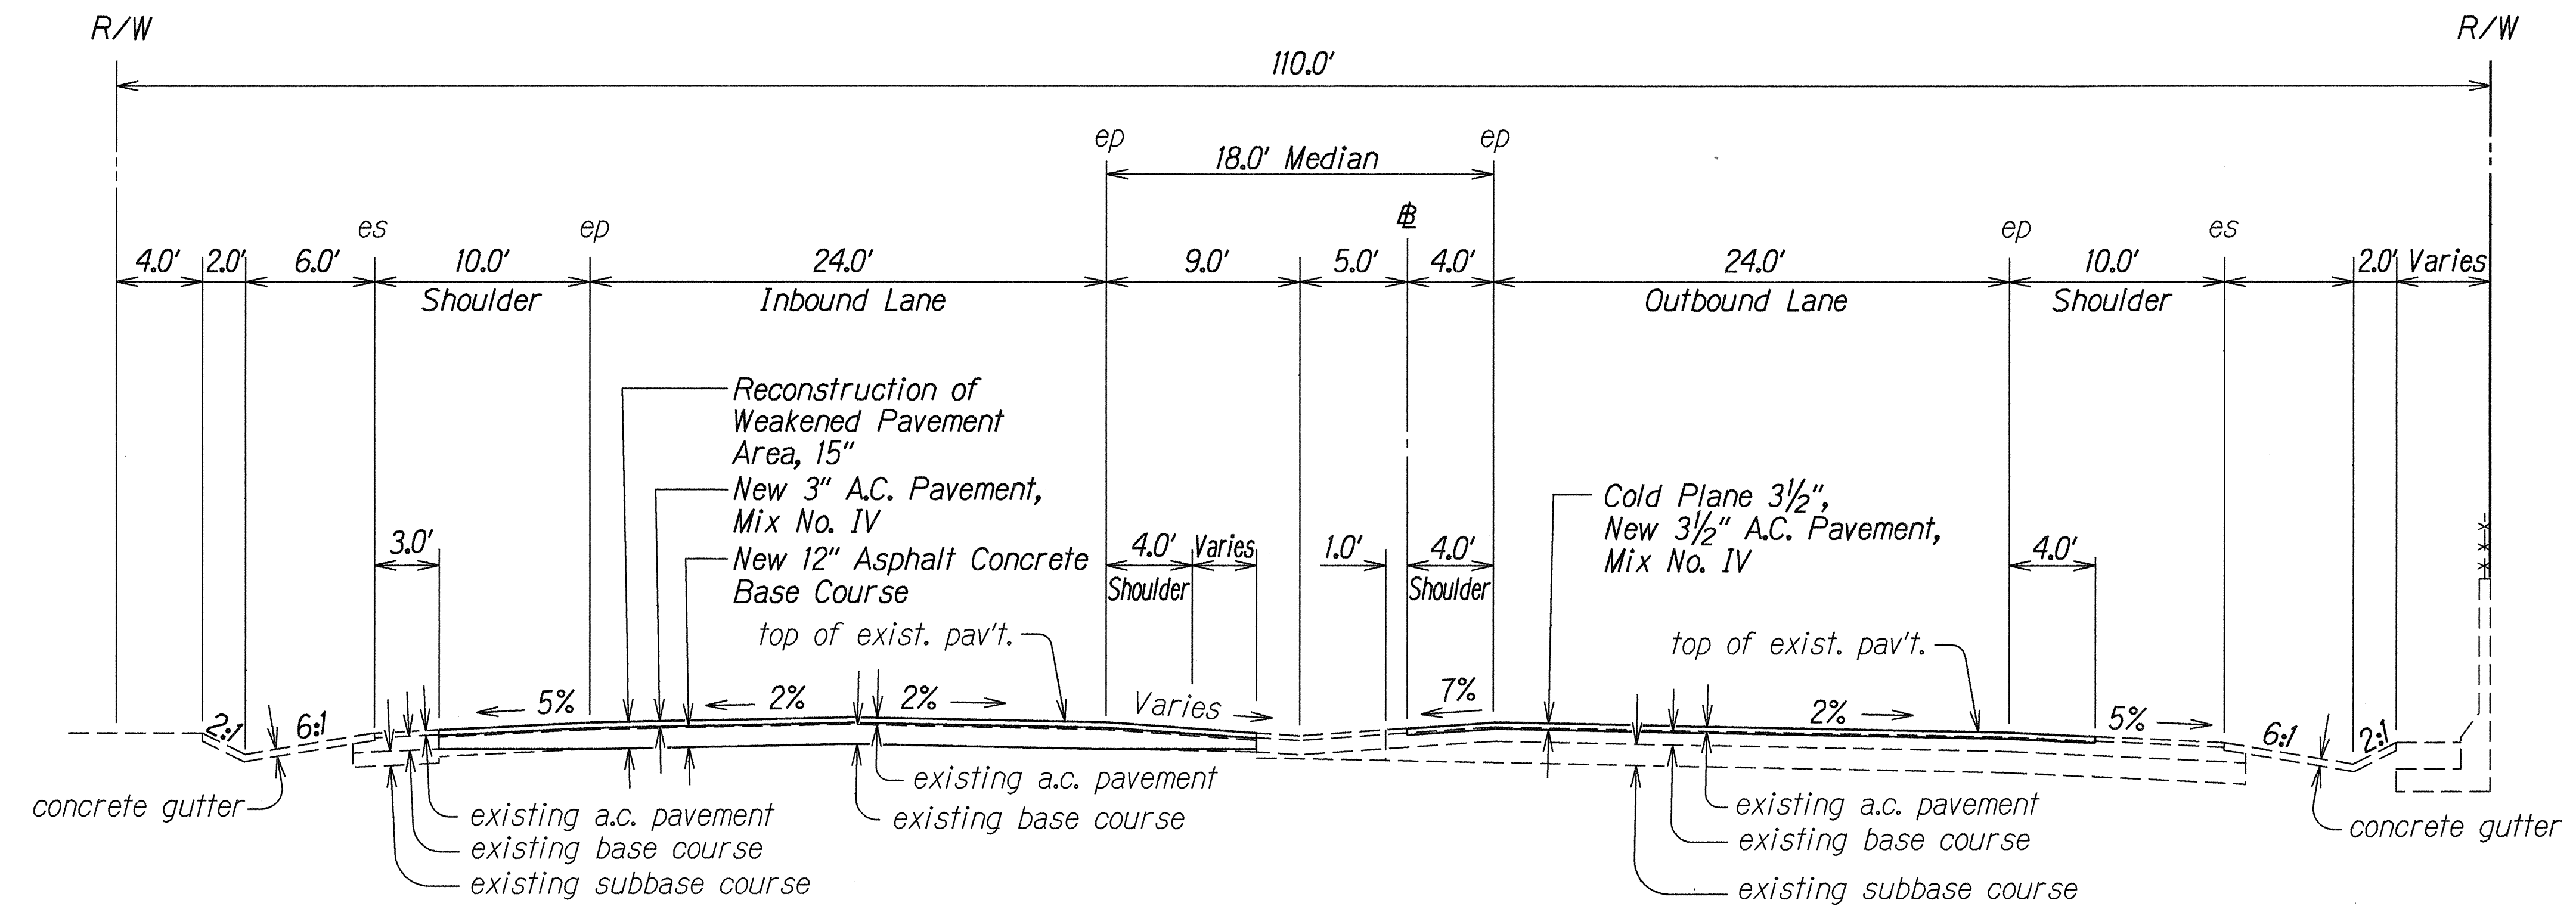

TYPICAL ROAD SECTION
 # STA. 32+30± TO # STA. 0+00
 # STA. 0+00 TO # STA. 3+45±
 Scale: 3/16"=1'-0"

Note:
 Resurfacing work was not performed on Inbound Lanes from # Sta. 32+30(BK) to # Sta. 3+00(AH).

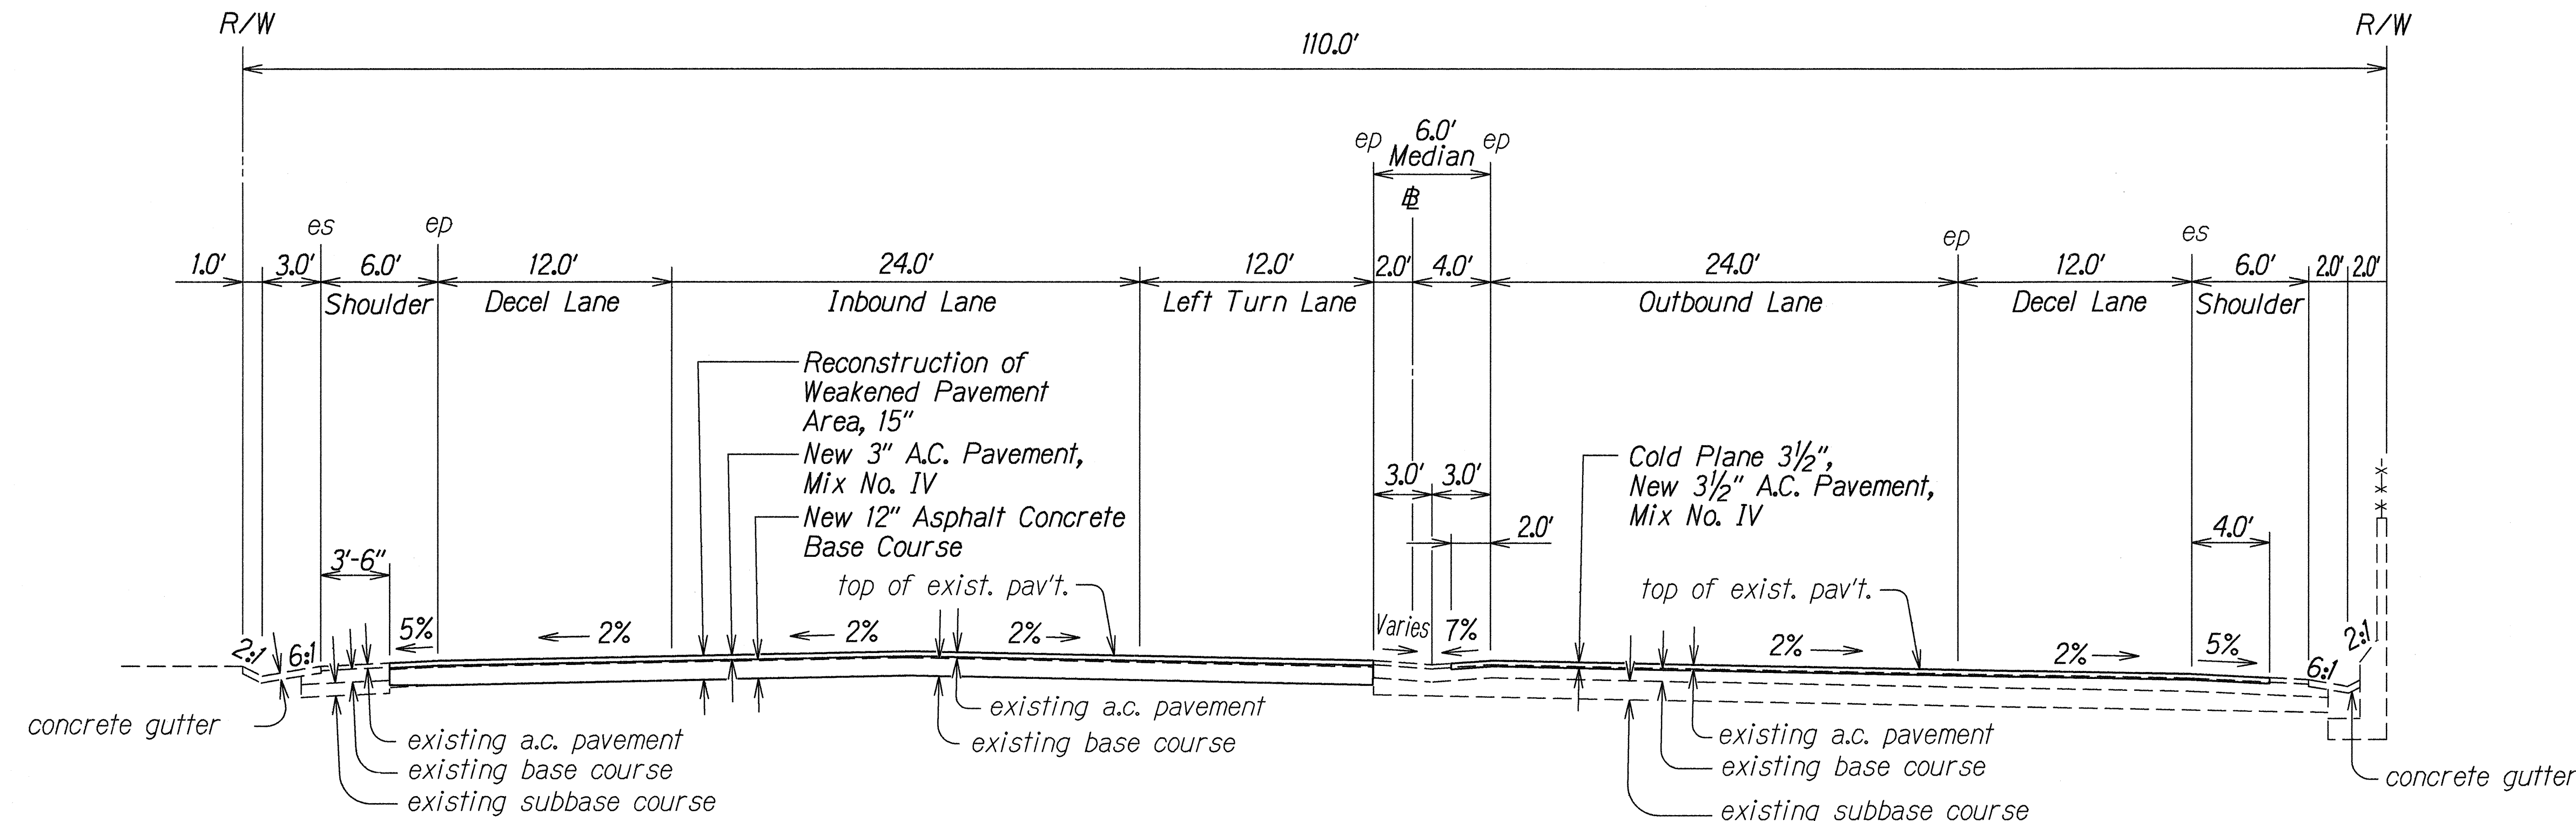

TYPICAL ROAD SECTION WITH DECELERATION LANES
 Scale: 3/16"=1'-0"

LEGEND FOR AS-BUILT POSTINGS

	Squiggly line for as-built deletion
	Double line for as-built deletion
Roadway	Text for as-built posting

STATE OF HAWAII
 DEPARTMENT OF TRANSPORTATION
 HIGHWAYS DIVISION

TYPICAL SECTIONS

KAMEHAMEHA HIGHWAY RESURFACING
 Lumiaina Street to Farrington Highway
 Federal Aid Project No. STP-099-1(13)


Scale: As Shown Date: Aug., 1994

SHEET No. 1 OF 3 SHEETS

ORIGINAL PLAN	DATE
SURVEY PLOTTED BY	12-12-94
DRAWN BY	
DESIGNED BY	
CHECKED BY	
NOTED BY	
APPROVED BY	


"AS-BUILT"

FED. ROAD DIST. NO.	STATE	FED. AID PROJ. NO.	FISCAL YEAR	SHEET NO.	TOTAL SHEETS
HAWAII	HAW.	STP-099-1(13)	1995	6	58

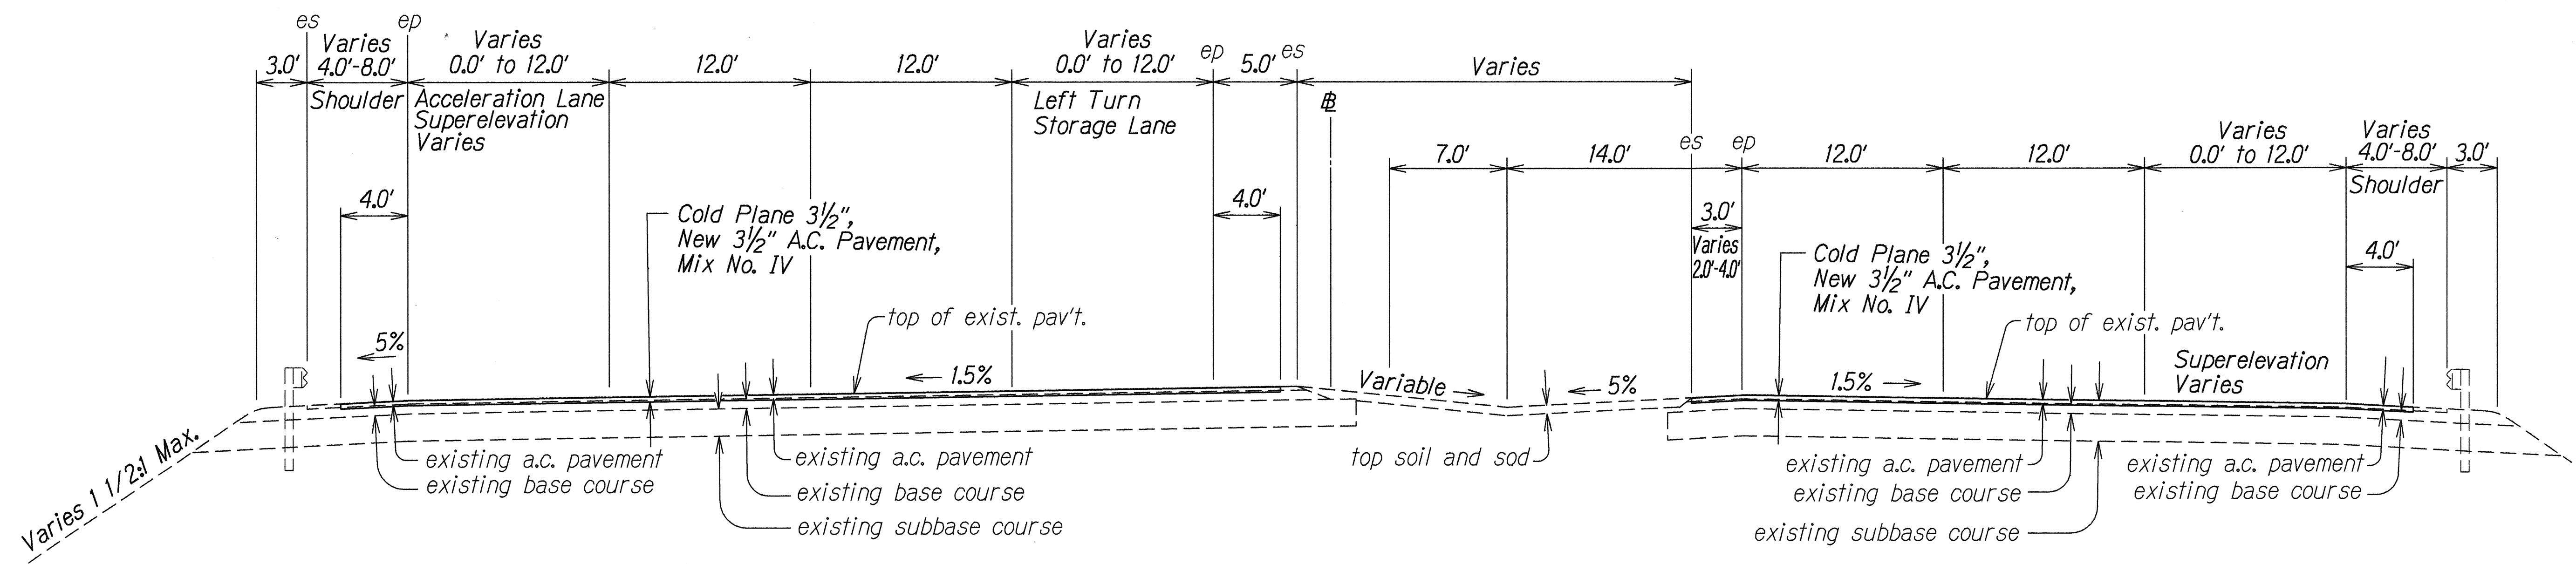

TYPICAL ROAD SECTION - OUTBOUND LANES
 ± STA. 4+10 TO ± STA. 22+82.69
 Scale: 3/16"=1'-0"

TYPICAL ROAD SECTION - INBOUND LANES
 ± STA. 4+10 TO ± STA. 23+51.65
 Scale: 3/16"=1'-0"

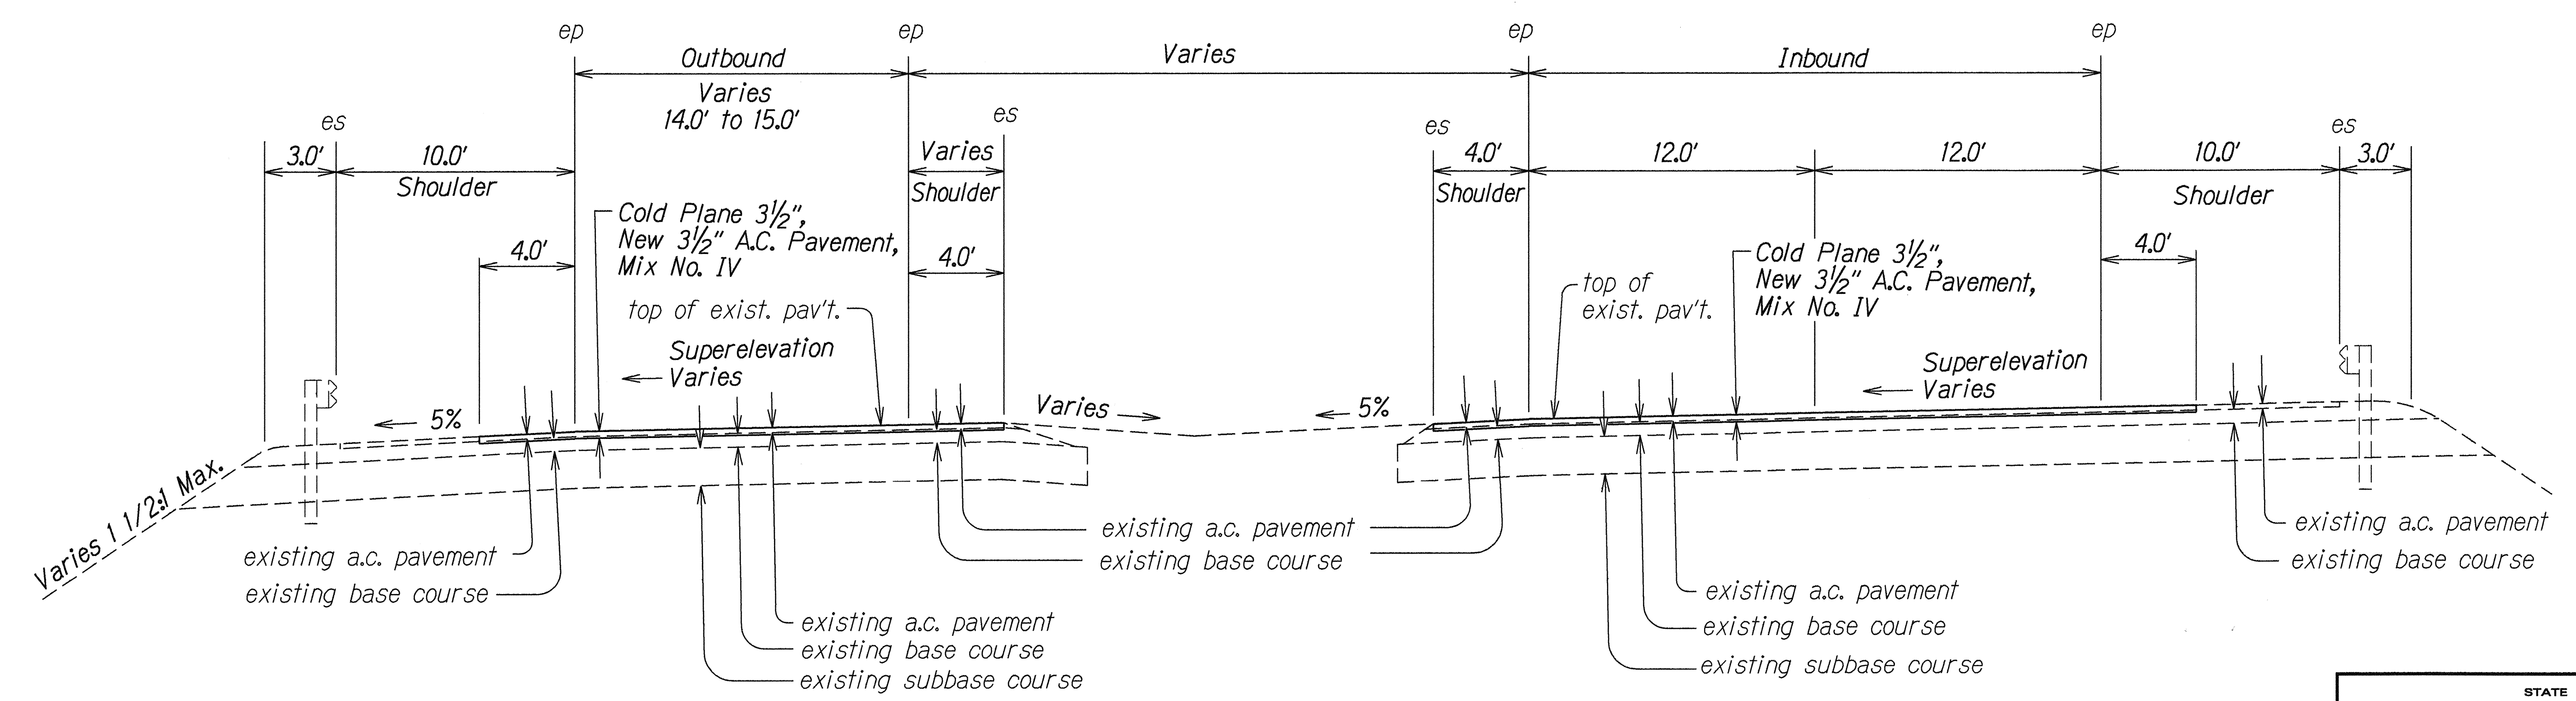

TYPICAL ROAD SECTION
 INBOUND - STA. 23+51.65 TO STA. 26+30.00
 OUTBOUND - STA. 22+82.69 TO STA. 26+30.00
 RAMP "H" STA. 0+00 TO STA. 1+35
 LOOP #3 STA. 16+00 TO STA. 17+06.34
 Scale: 1/4"=1'-0"

ORIGINAL PLAN	DATE
DESIGNED BY	12-12-94
DRAWN BY	
CHECKED BY	
NOTED BY	
DATE	

STATE OF HAWAII
 DEPARTMENT OF TRANSPORTATION
 HIGHWAYS DIVISION


TYPICAL SECTIONS

KAMEHAMEHA HIGHWAY RESURFACING
 Lumiala Street to Farrington Highway
 Federal Aid Project No. STP-099-1(13)


Scale: As Shown Date: Aug., 1994

SHEET No. 2 OF 3 SHEETS


FED. ROAD DIST. NO.	STATE	FED. AID PROJ. NO.	FISCAL YEAR	SHEET NO.	TOTAL SHEETS
HAWAII	HAW.	STP-099-1(13)	1995	7	58

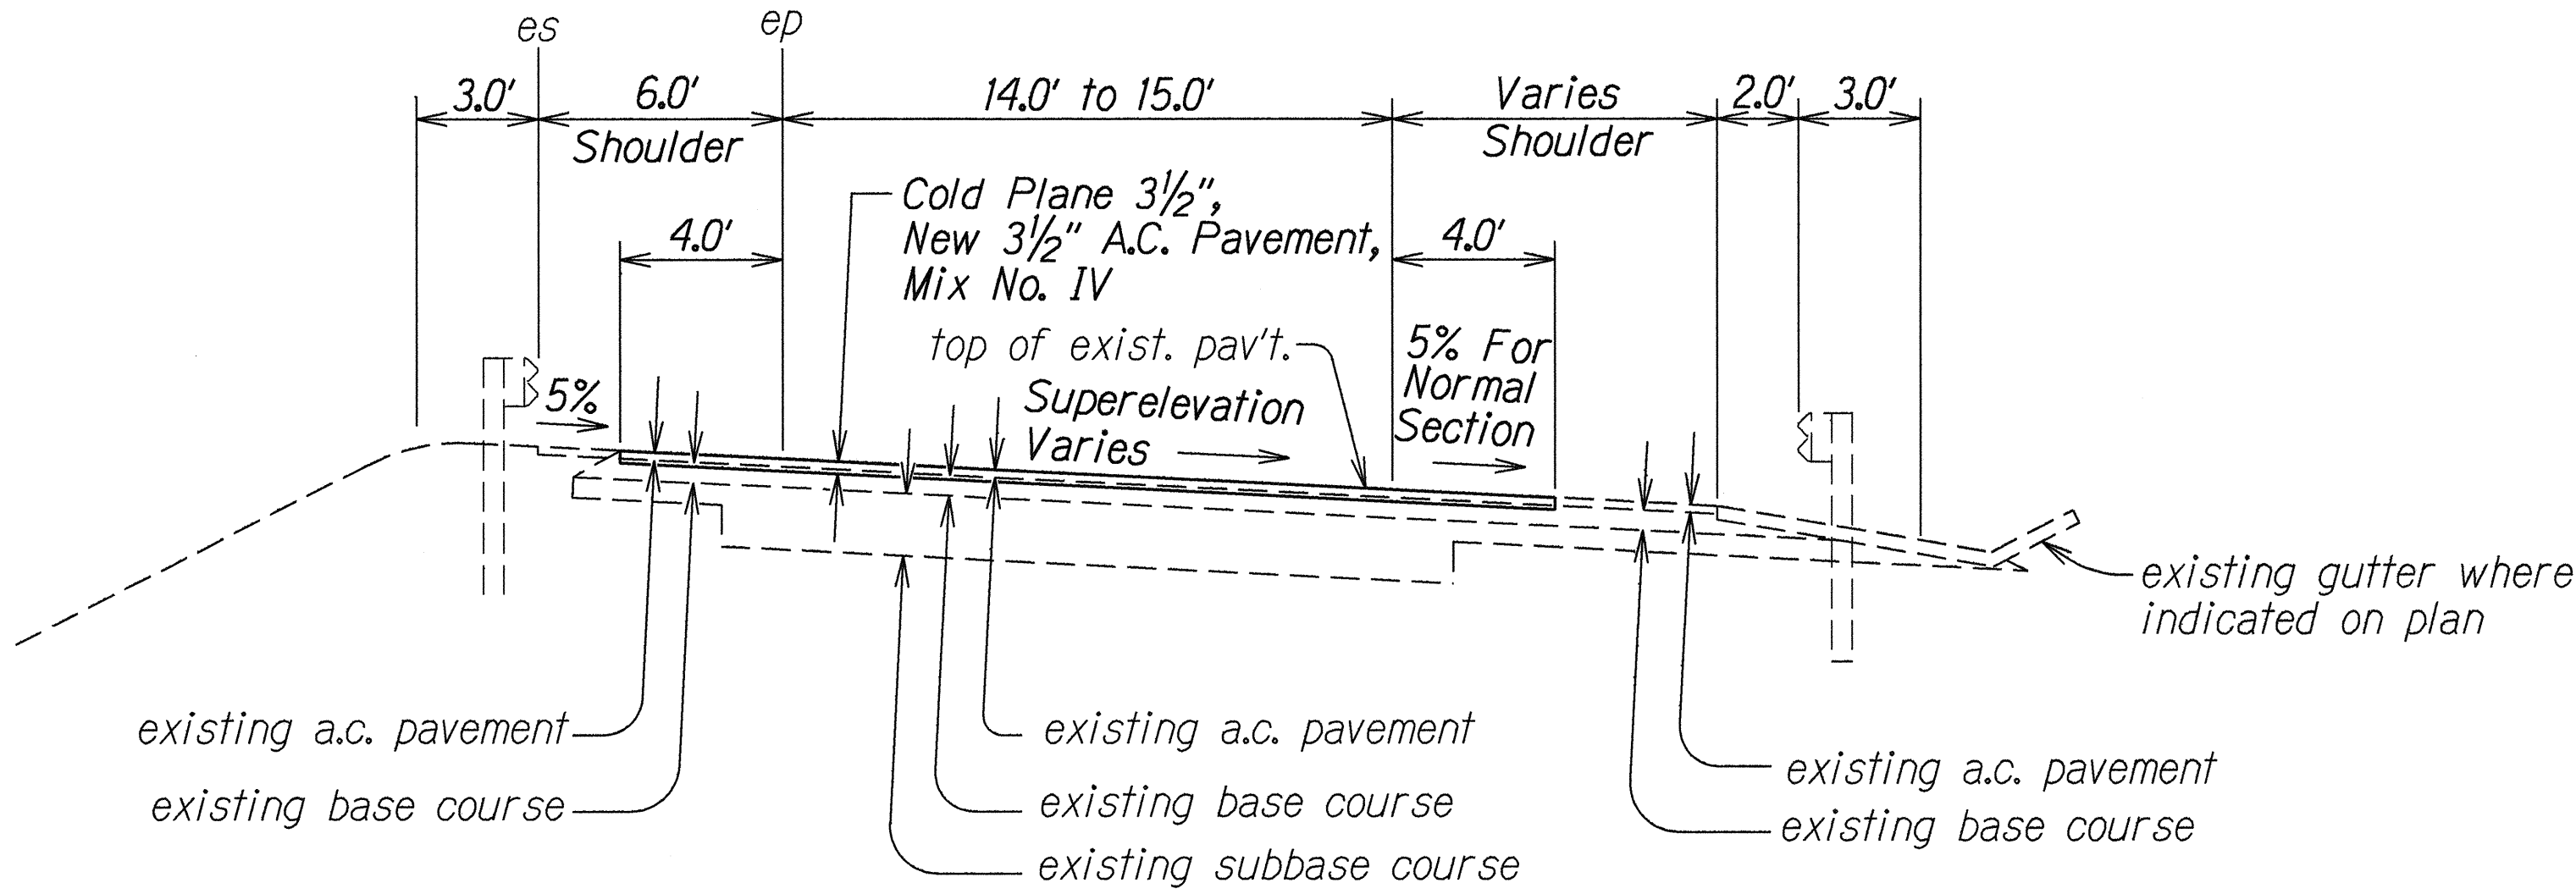

TYPICAL ROAD SECTION
 LOOP NO. 3, LOOP NO. 5, RAMP "D-I", RAMP "E"
 Scale: 1/4"=1'-0"

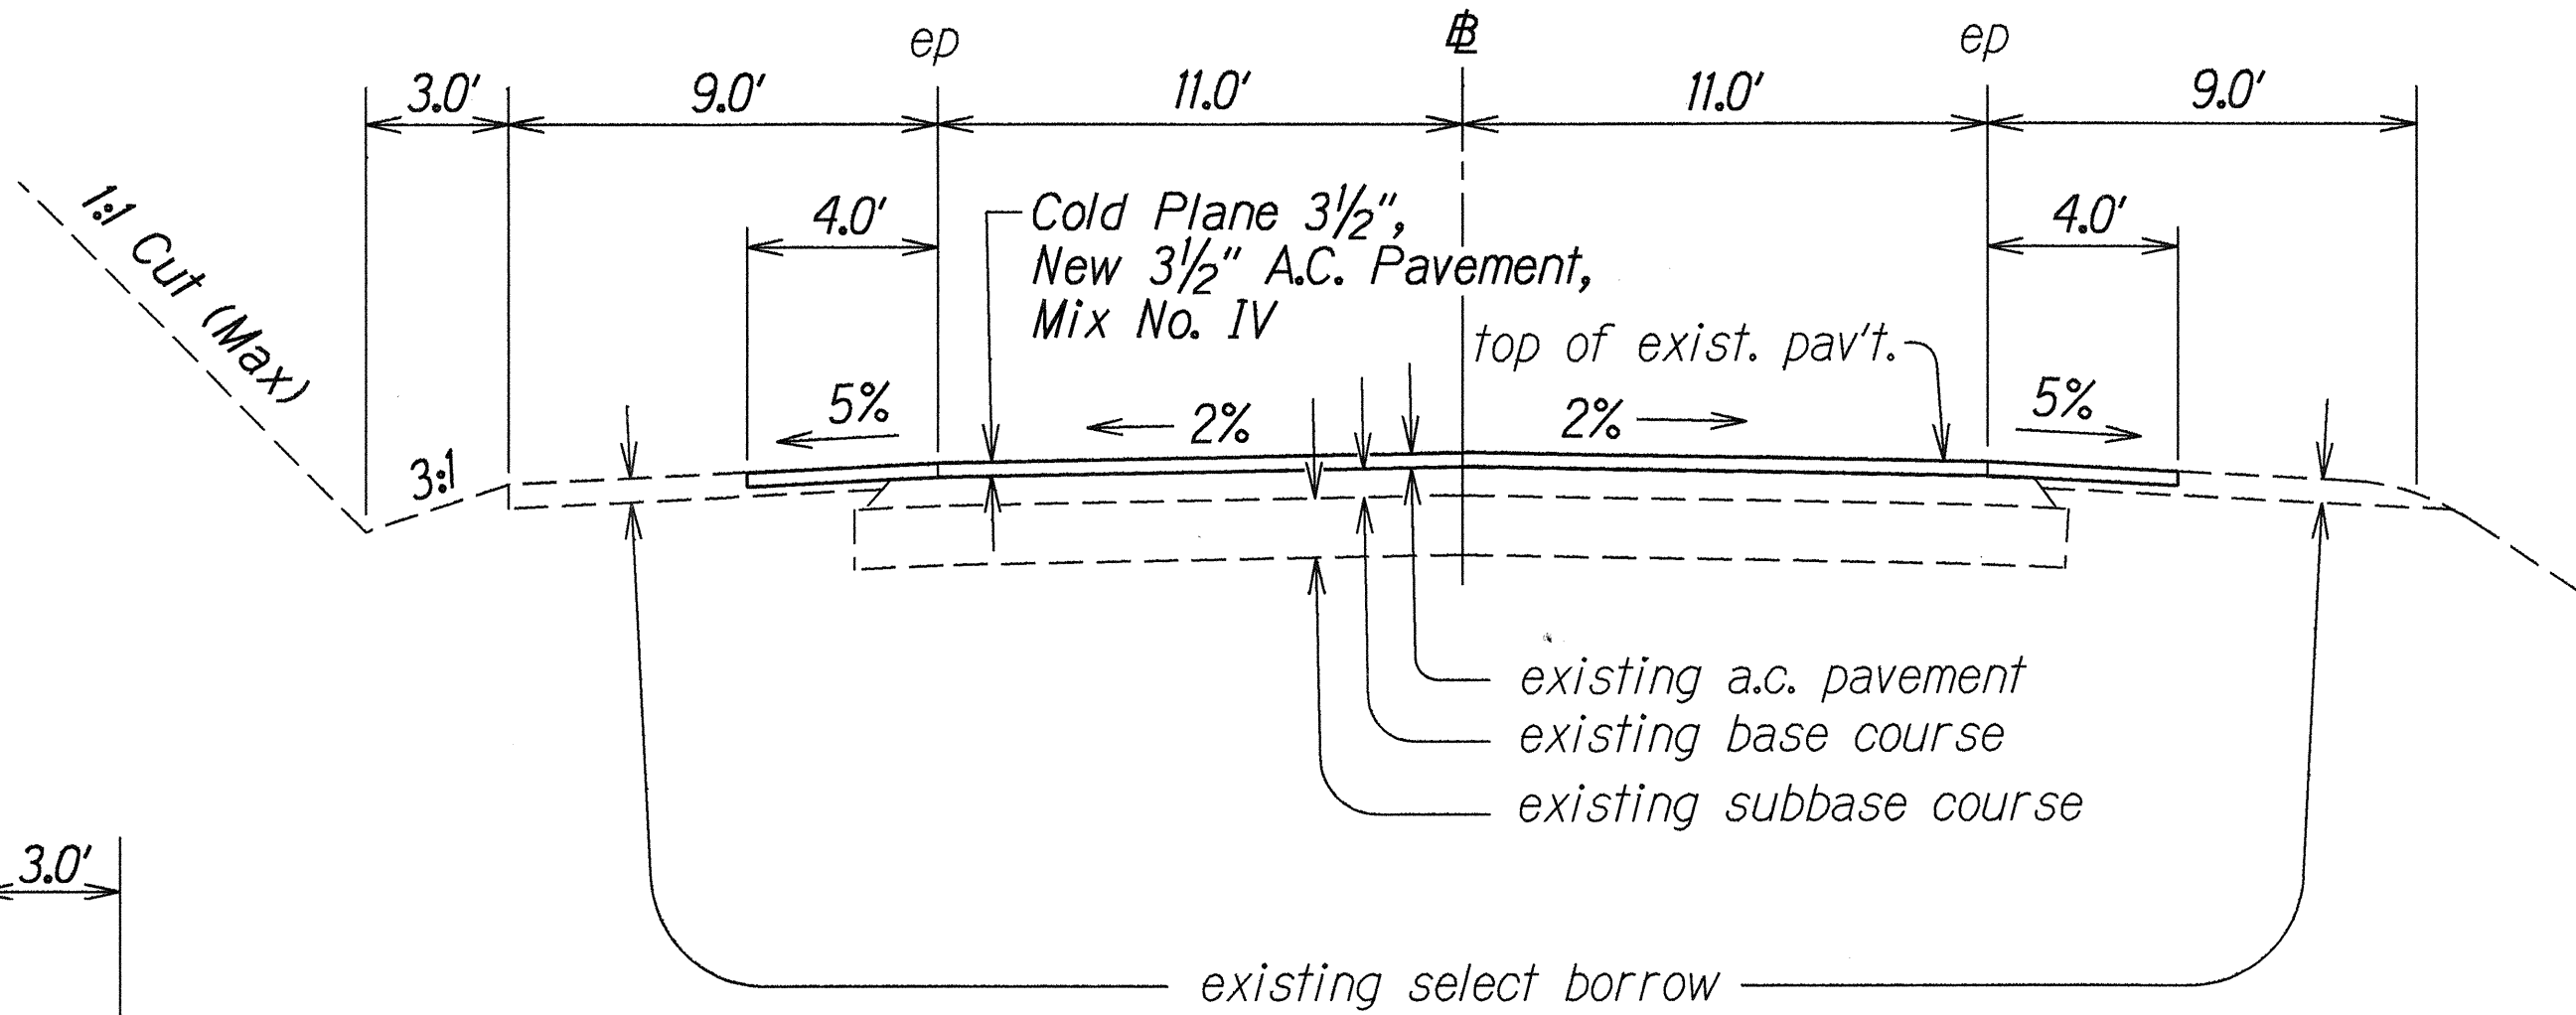

TYPICAL ROAD SECTION
 WAIPAHU STREET REALIGNMENT
 Scale: 1/4"=1'-0"

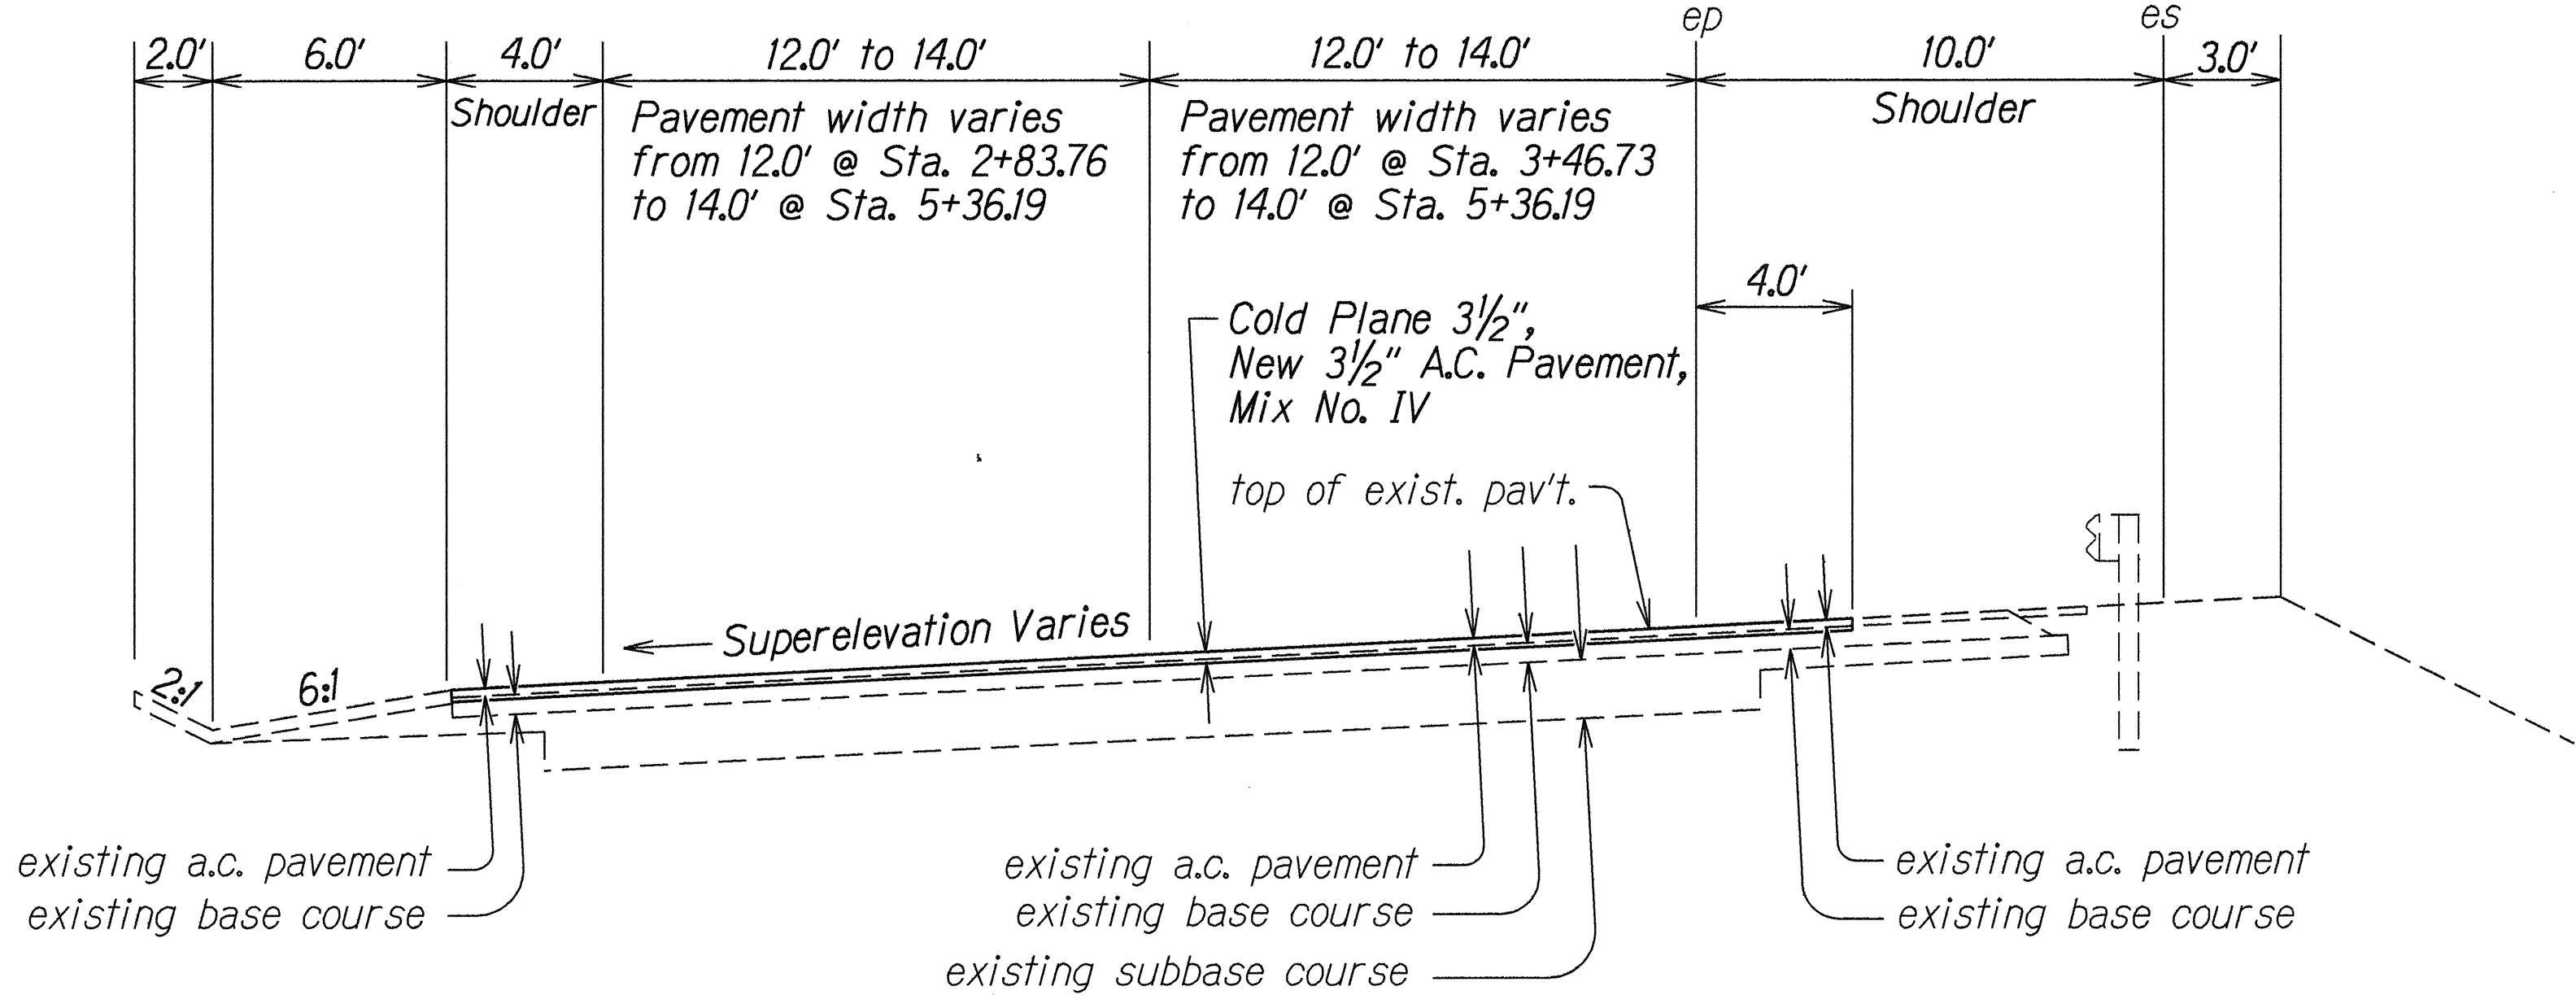

TYPICAL ROAD SECTION - RAMP "H"
 FROM STRUCTURE 10-B TO STA. 5+36.19
 Scale: 1/4"=1'-0"

SURVEY PLOTTED BY	DATE
DRAWN BY	19.13.94
TRACED BY	
CHECKED BY	
QUANTITIES BY	
CHECKED BY	
ORIGINAL PLAN	
NOTE BOOK	
ddk	
4/2/94	

STATE OF HAWAII
DEPARTMENT OF TRANSPORTATION
HIGHWAYS DIVISION


TYPICAL SECTIONS

KAMEHAMEHA HIGHWAY RESURFACING
Lumiaina Street to Farrington Highway
Federal Aid Project No. STP-099-1(13)


Scale: As Shown
Date: Sept., 1994

SHEET No. 3 OF 3 SHEETS

FED. ROAD DIST. NO.	STATE	FED. AID PROJ. NO.	FISCAL YEAR	SHEET NO.	TOTAL SHEETS
HAWAII	HAW.	STP-099-1(13)	1995	8	58

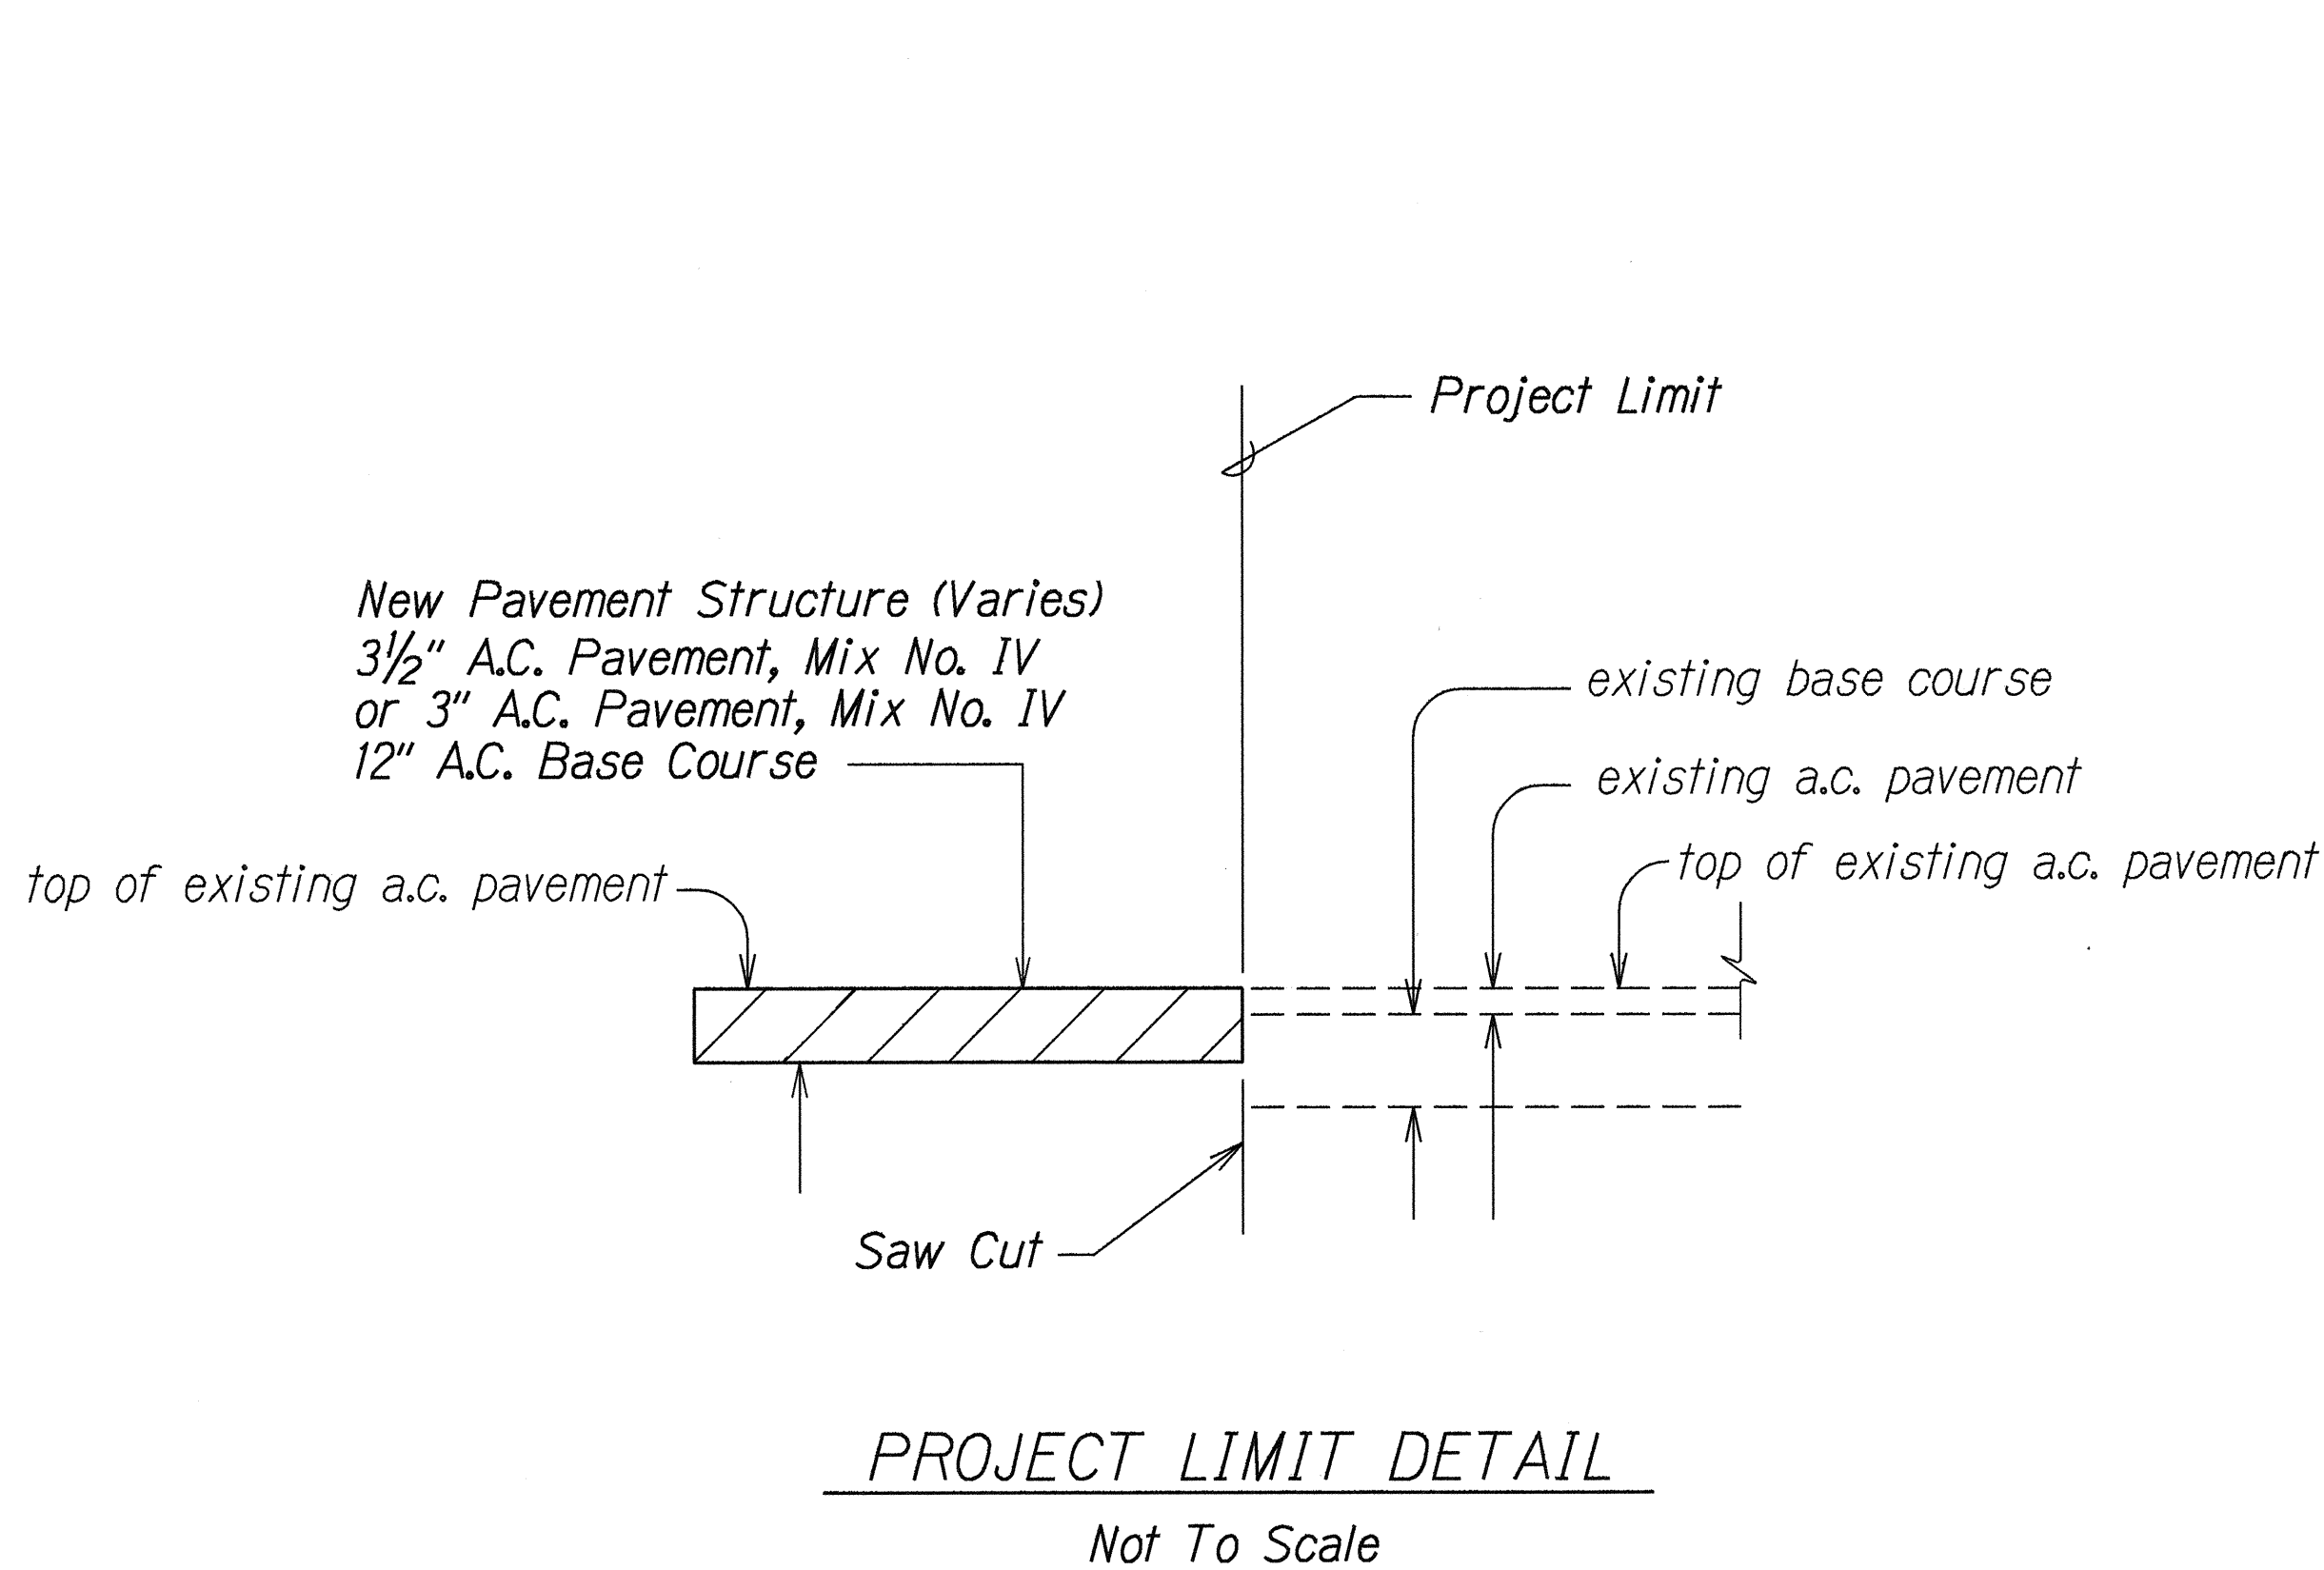

Note: In cold planing the pavement over the structure, the Contractor shall exercise care not to damage any portion of the structure, especially the slab, joints, drainage pipes or reinforcement. Any damage to the structure during the cold planing operations shall be repaired by the Contractor at his expense. Repair work shall be directed by the Engineer. The Contractor shall verify the thickness of the pavement by taking several measurements throughout the structure.

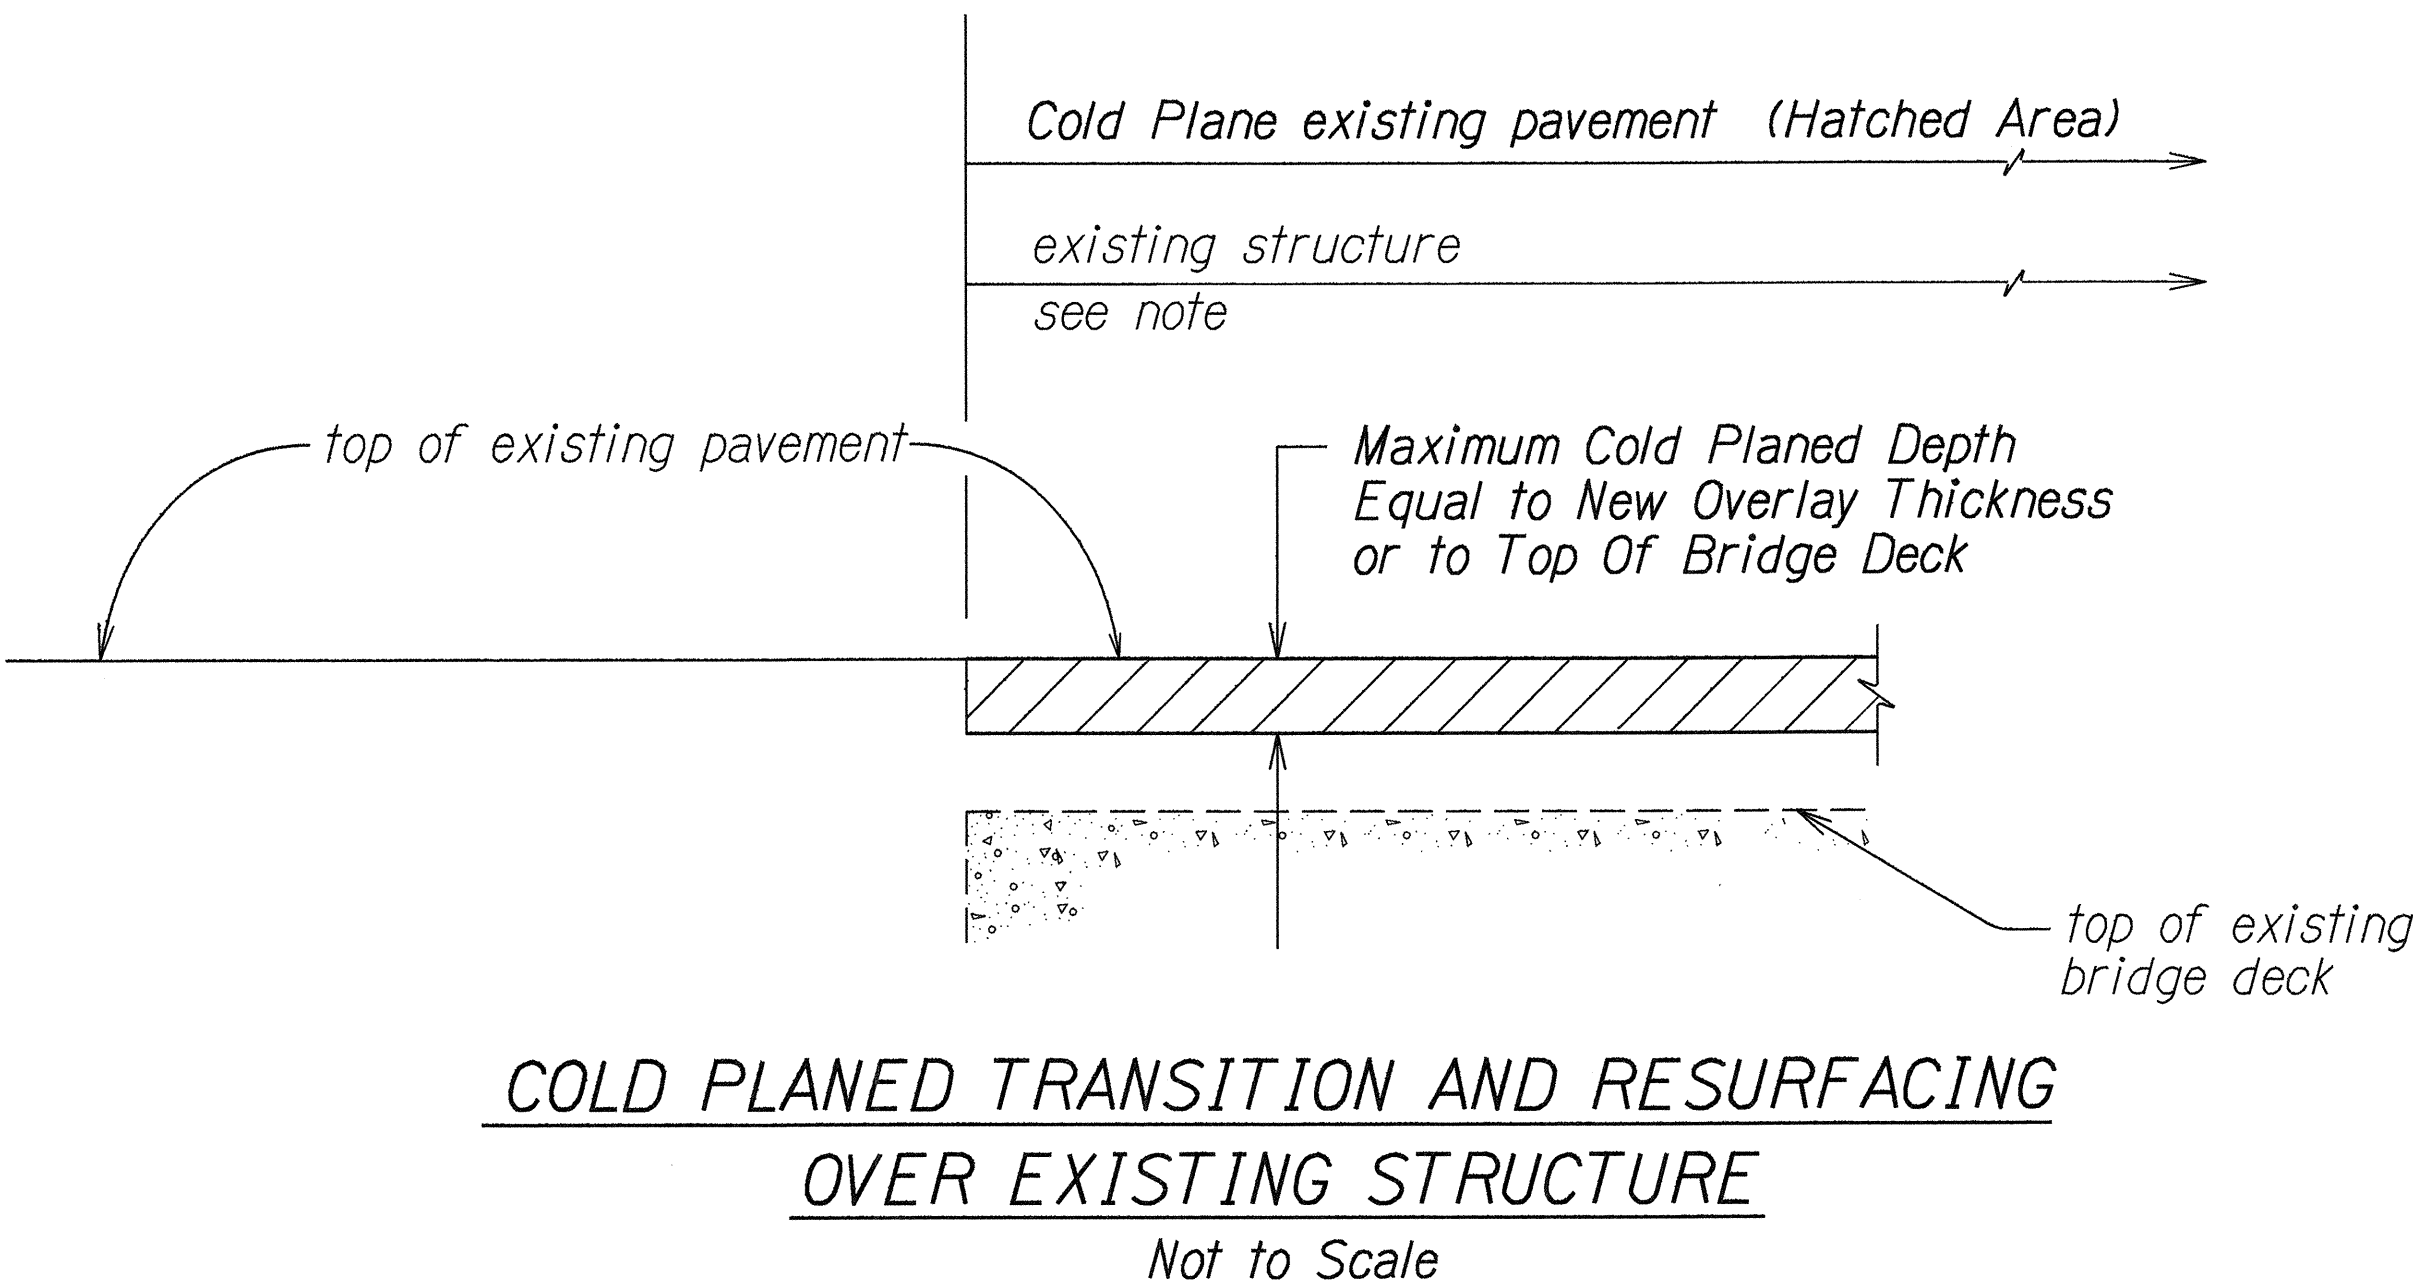

ORIGINAL PLAN	SURVEY PLOTTED BY	DATE
NOTE BOOK	DRAWN BY K. Tanaka	9-7-94
00241	TRACED BY B. Hirose	
00241	QUANTITIES BY	
00241	CHECKED BY	

STATE OF HAWAII
DEPARTMENT OF TRANSPORTATION
HIGHWAYS DIVISION

TYPICAL DETAILS
KAMEHAMEHA HIGHWAY RESURFACING
Lumaina Street to Farrington Highway
Federal Aid Project No. STP-099-1(13)

Scale: Not to Scale Date: Sept., 1994
SHEET No. 1 OF 1 SHEETS