


FED. ROAD DIST. NO.	STATE	FED. AID PROJ. NO.	FISCAL YEAR	SHEET NO.	TOTAL SHEETS
HAWAII	HAW.	STP-099-1(15)	1995	15	26

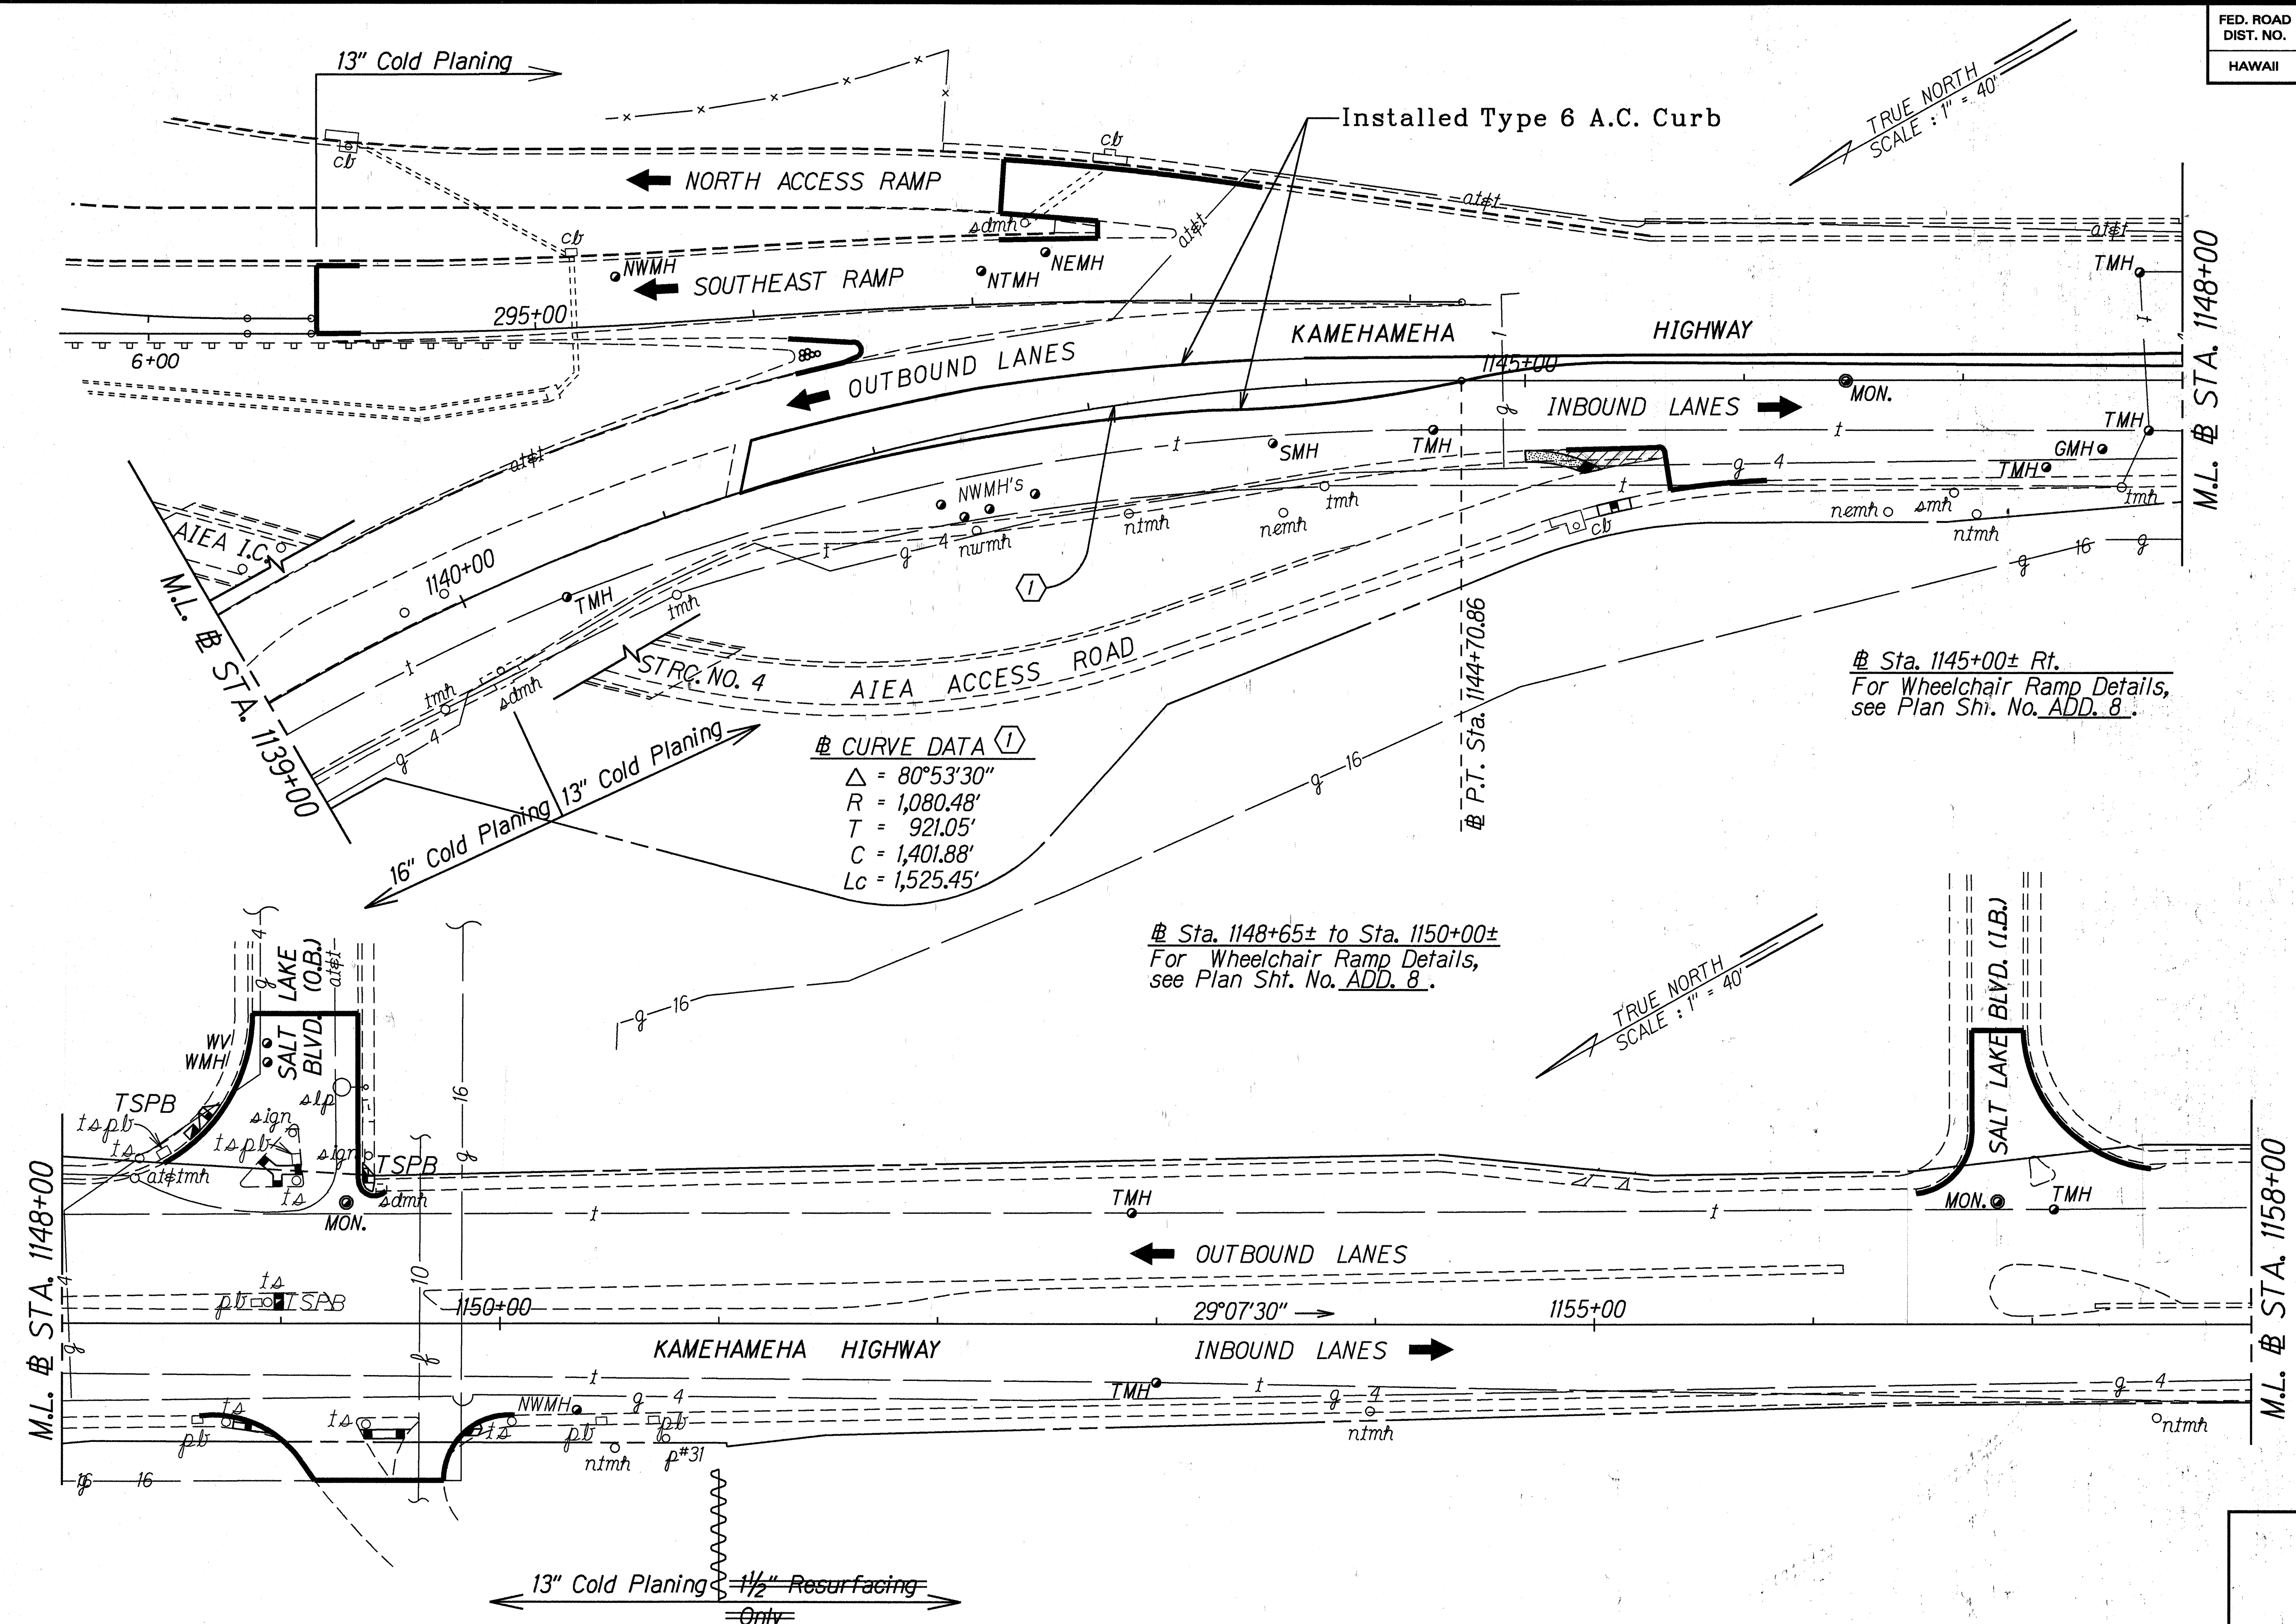

① CURVE DATA
 $\Delta = 80^{\circ}53'30''$
 $R = 1,080.48'$
 $T = 921.05'$
 $C = 1,401.88'$
 $L_c = 1,525.45'$

LEGEND FOR AS-BUILT POSTINGS	
	Squiggly line for as-built deletion
	Double line for as-built deletion
Roadway	Text for as-built posting

6/21/95	Revise Utility Manhole Designation, Wheelchair Ramps and Construction Note.
DATE	REVISION

STATE OF HAWAII
DEPARTMENT OF TRANSPORTATION
HIGHWAYS DIVISION

PLAN

KAMEHAMEHA HIGHWAY RESURFACING
Vicinity of Honomanu St. to Halawa Dr.
Fed. Aid Project No. STP-099-1(15)

Scale: 1" = 40' Date: June, 1995


SHEET No. 2 OF 3 SHEETS

ORIGINAL PLAN	DATE 16-10-95
DESIGNED BY R. Ueno	
CHECKED BY g. and 2/96	


"AS-BUILT"

ADD. 15

FED. ROAD DIST. NO.	STATE	FED. AID PROJ. NO.	FISCAL YEAR	SHEET NO.	TOTAL SHEETS
HAWAII	HAW.	STP-099-1(15)	1995	16	26

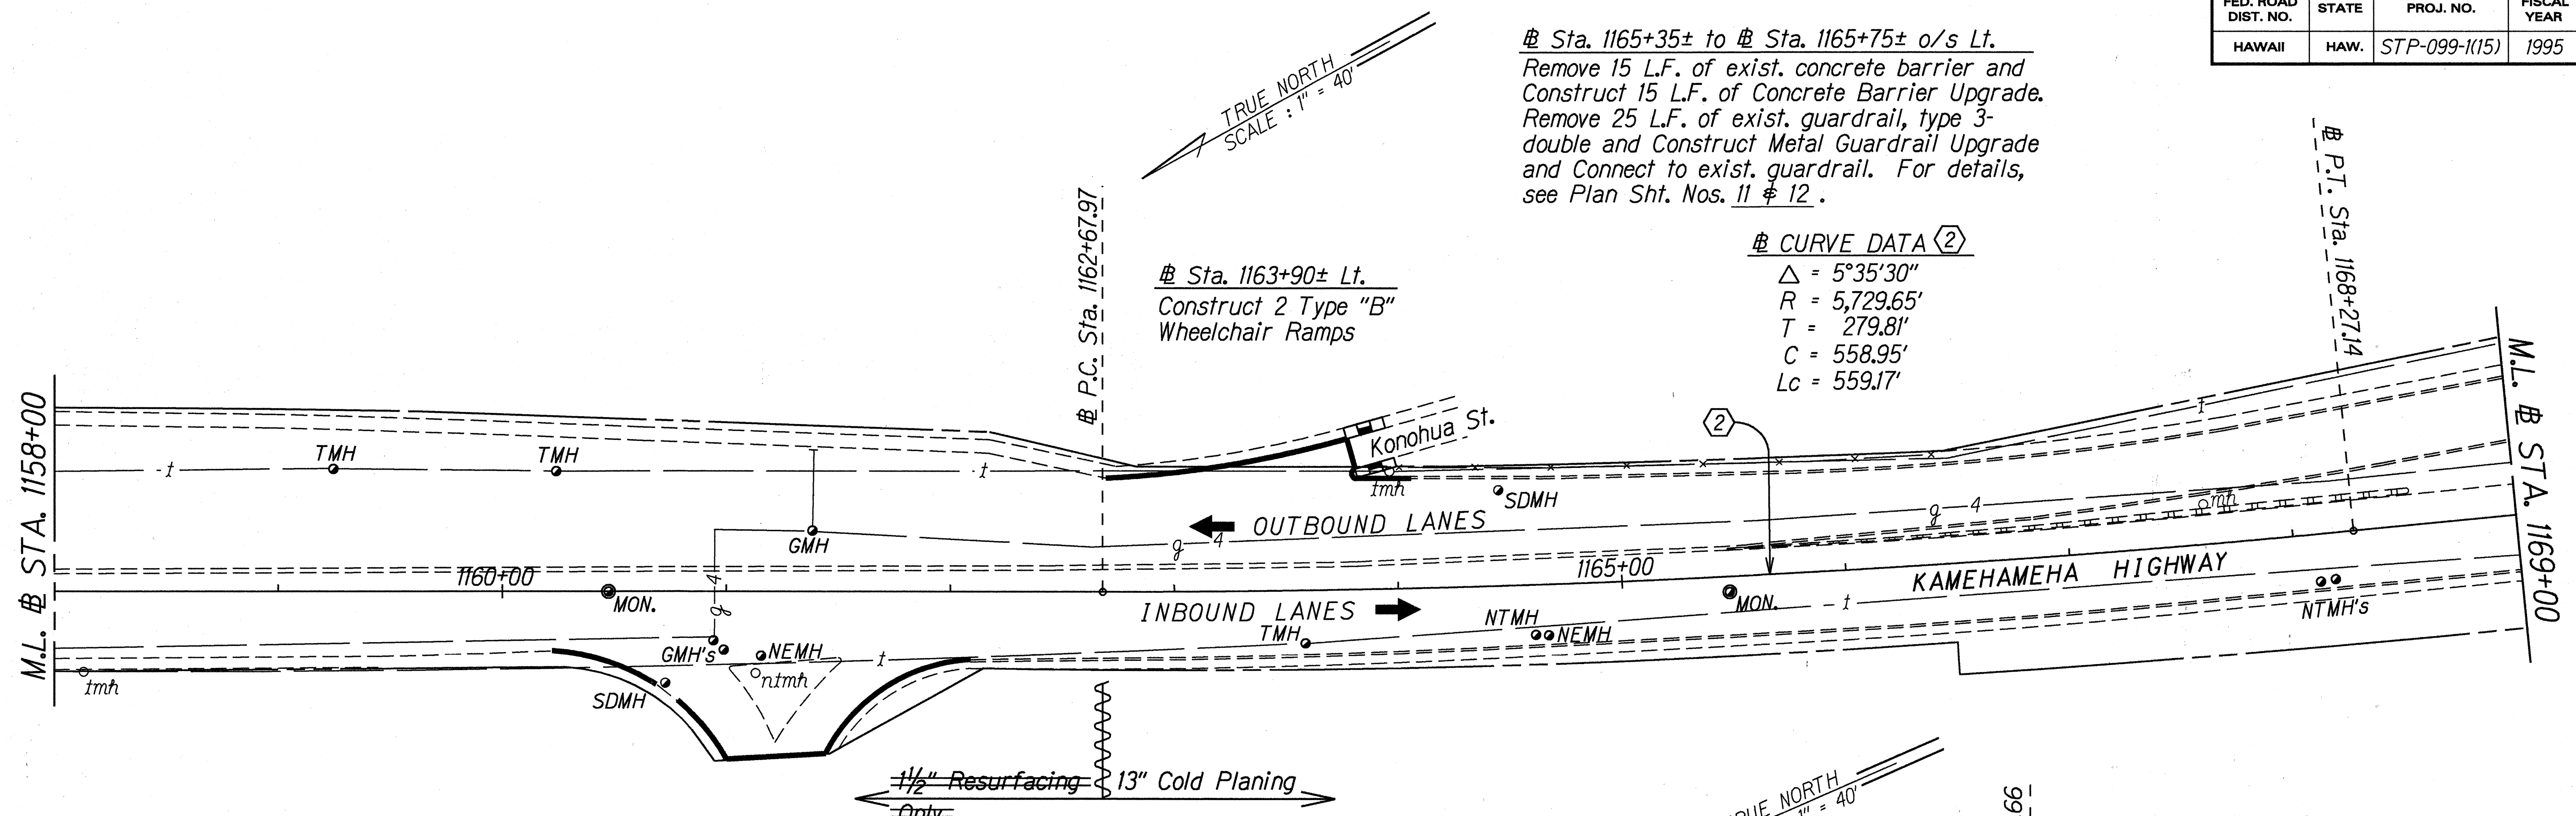

CURVE DATA ②
 $\Delta = 5^\circ 35' 30''$
 $R = 5,729.65'$
 $T = 279.81'$
 $C = 558.95'$
 $L_c = 559.17'$

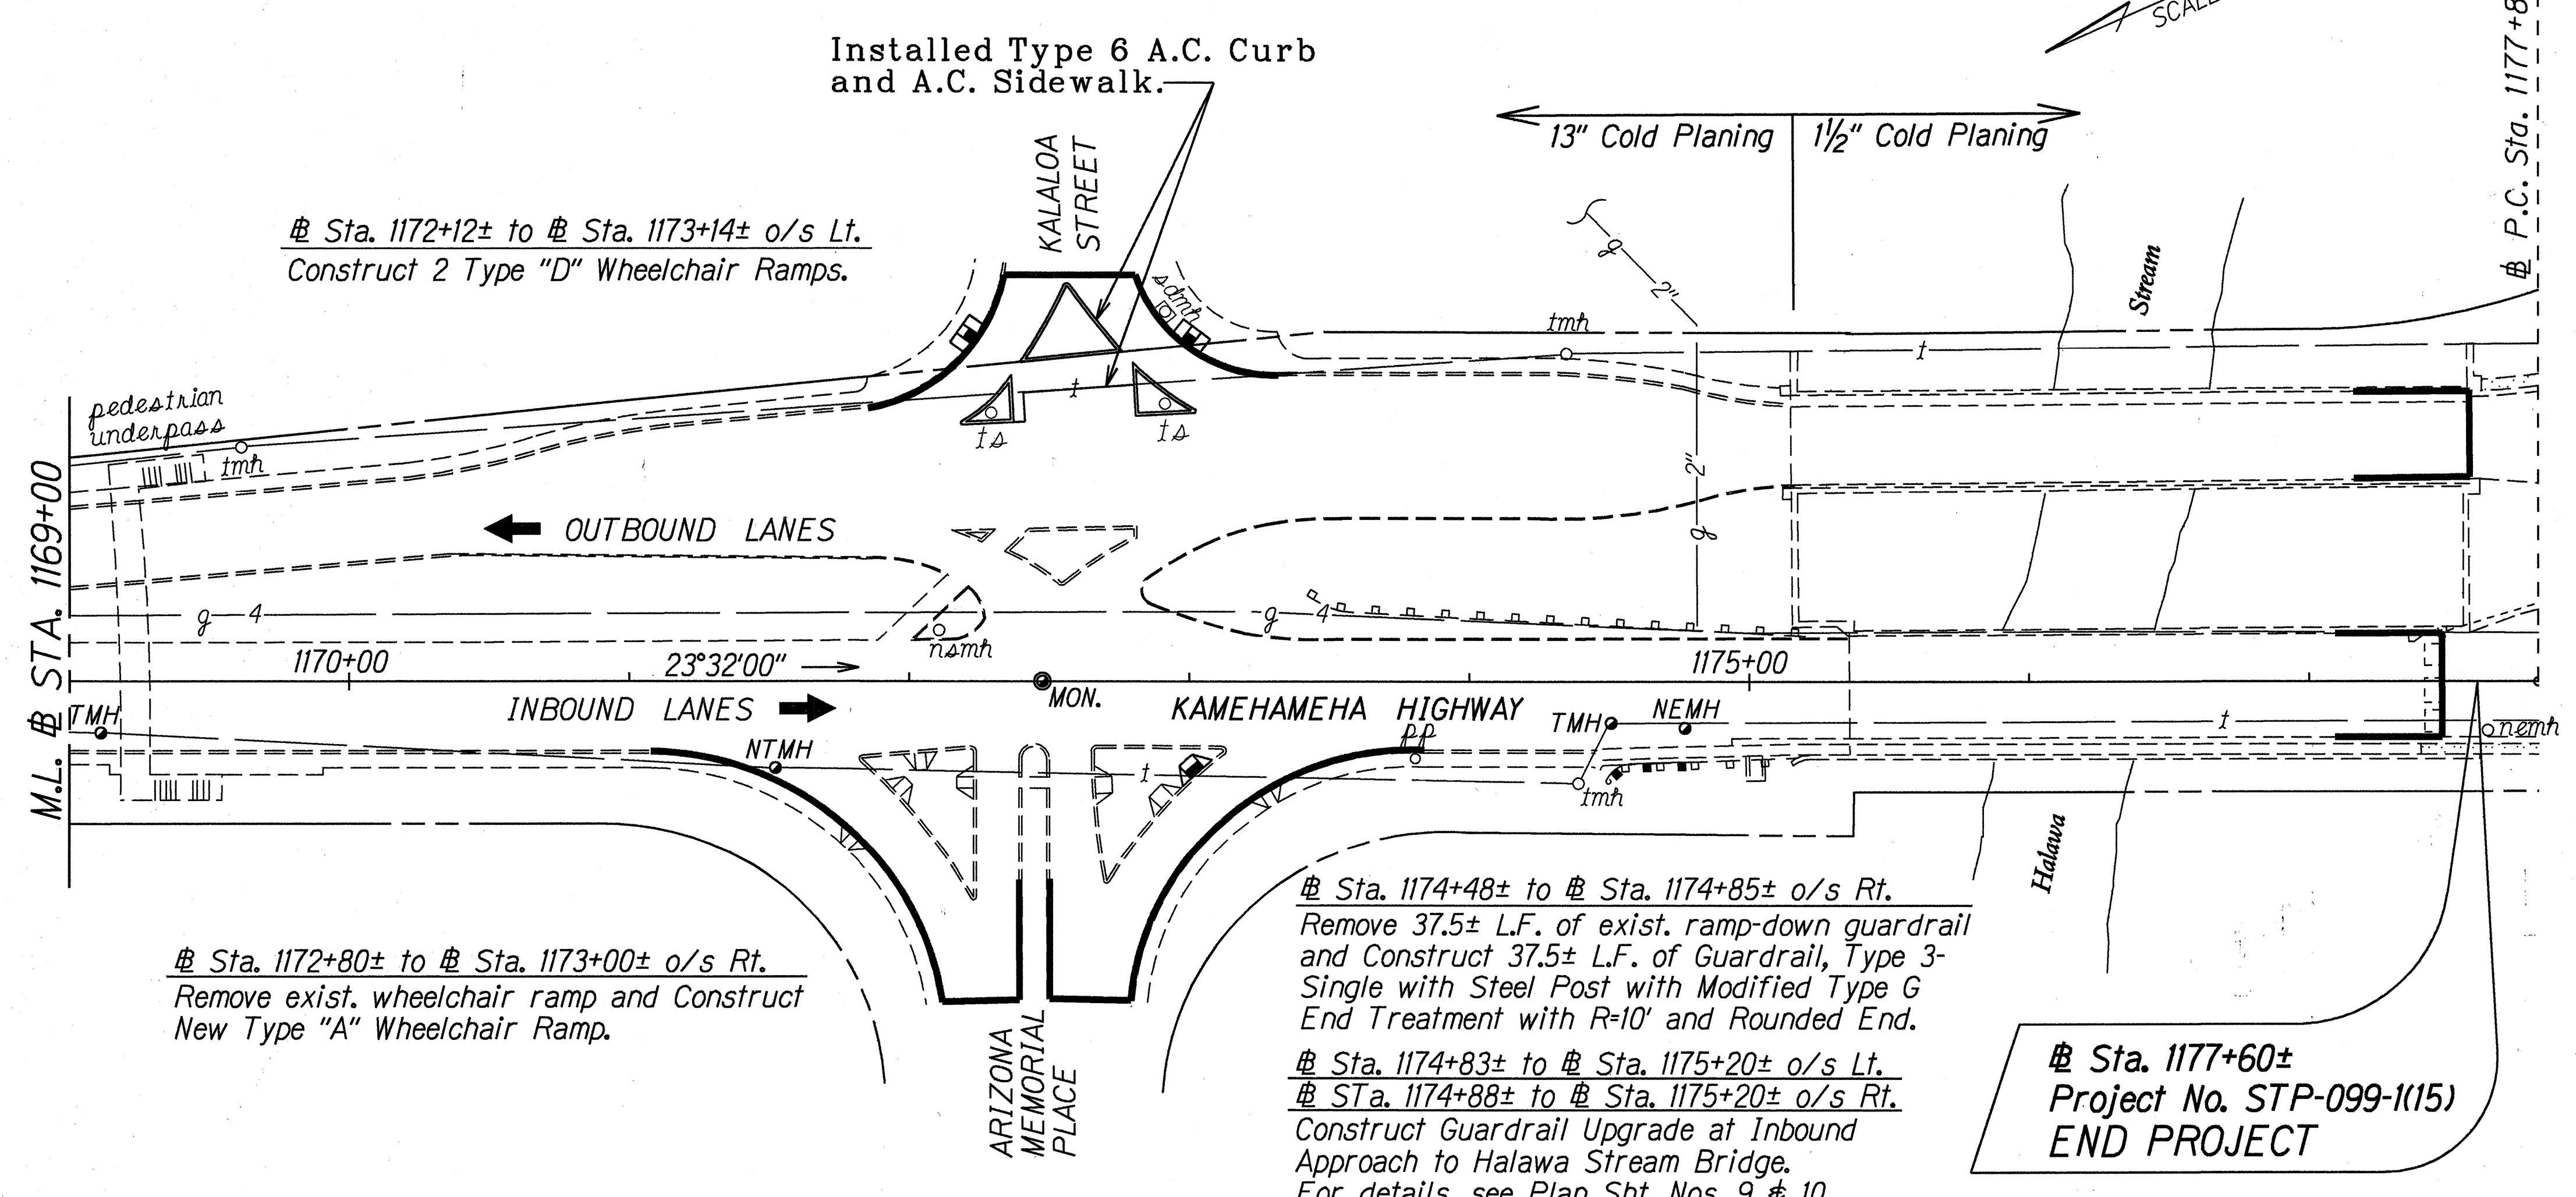

LEGEND FOR AS-BUILT POSTINGS	
	Squiggly line for as-built deletion
	Double line for as-built deletion
Roadway	Text for as-built posting

6-21-95	Add Wheelchair Ramps, revise Construction Notes and revise Utility Manhole designation.
DATE	REVISION
STATE OF HAWAII DEPARTMENT OF TRANSPORTATION HIGHWAYS DIVISION	
PLAN	
KAMEHAMEHA HIGHWAY RESURFACING Vicinity of Honomanu St. to Halawa Dr. Fed. Aid Project No. STP-099-1(15)	
Scale: 1" = 40'	Date: June, 1995
SHEET No. 3 OF 3 SHEETS	

ORIGINAL PLAN	SURVEY PLOTTED BY	DATE
NOTE BOOK	DRAWN BY L. M. M. M.	16-21-95
QUANTITIES BY	DESIGNED BY R. Ueno	
CHECKED BY		

Sta. 1177+60±
Project No. STP-099-1(15)
END PROJECT

"AS-BUILT"

ADD. 16