
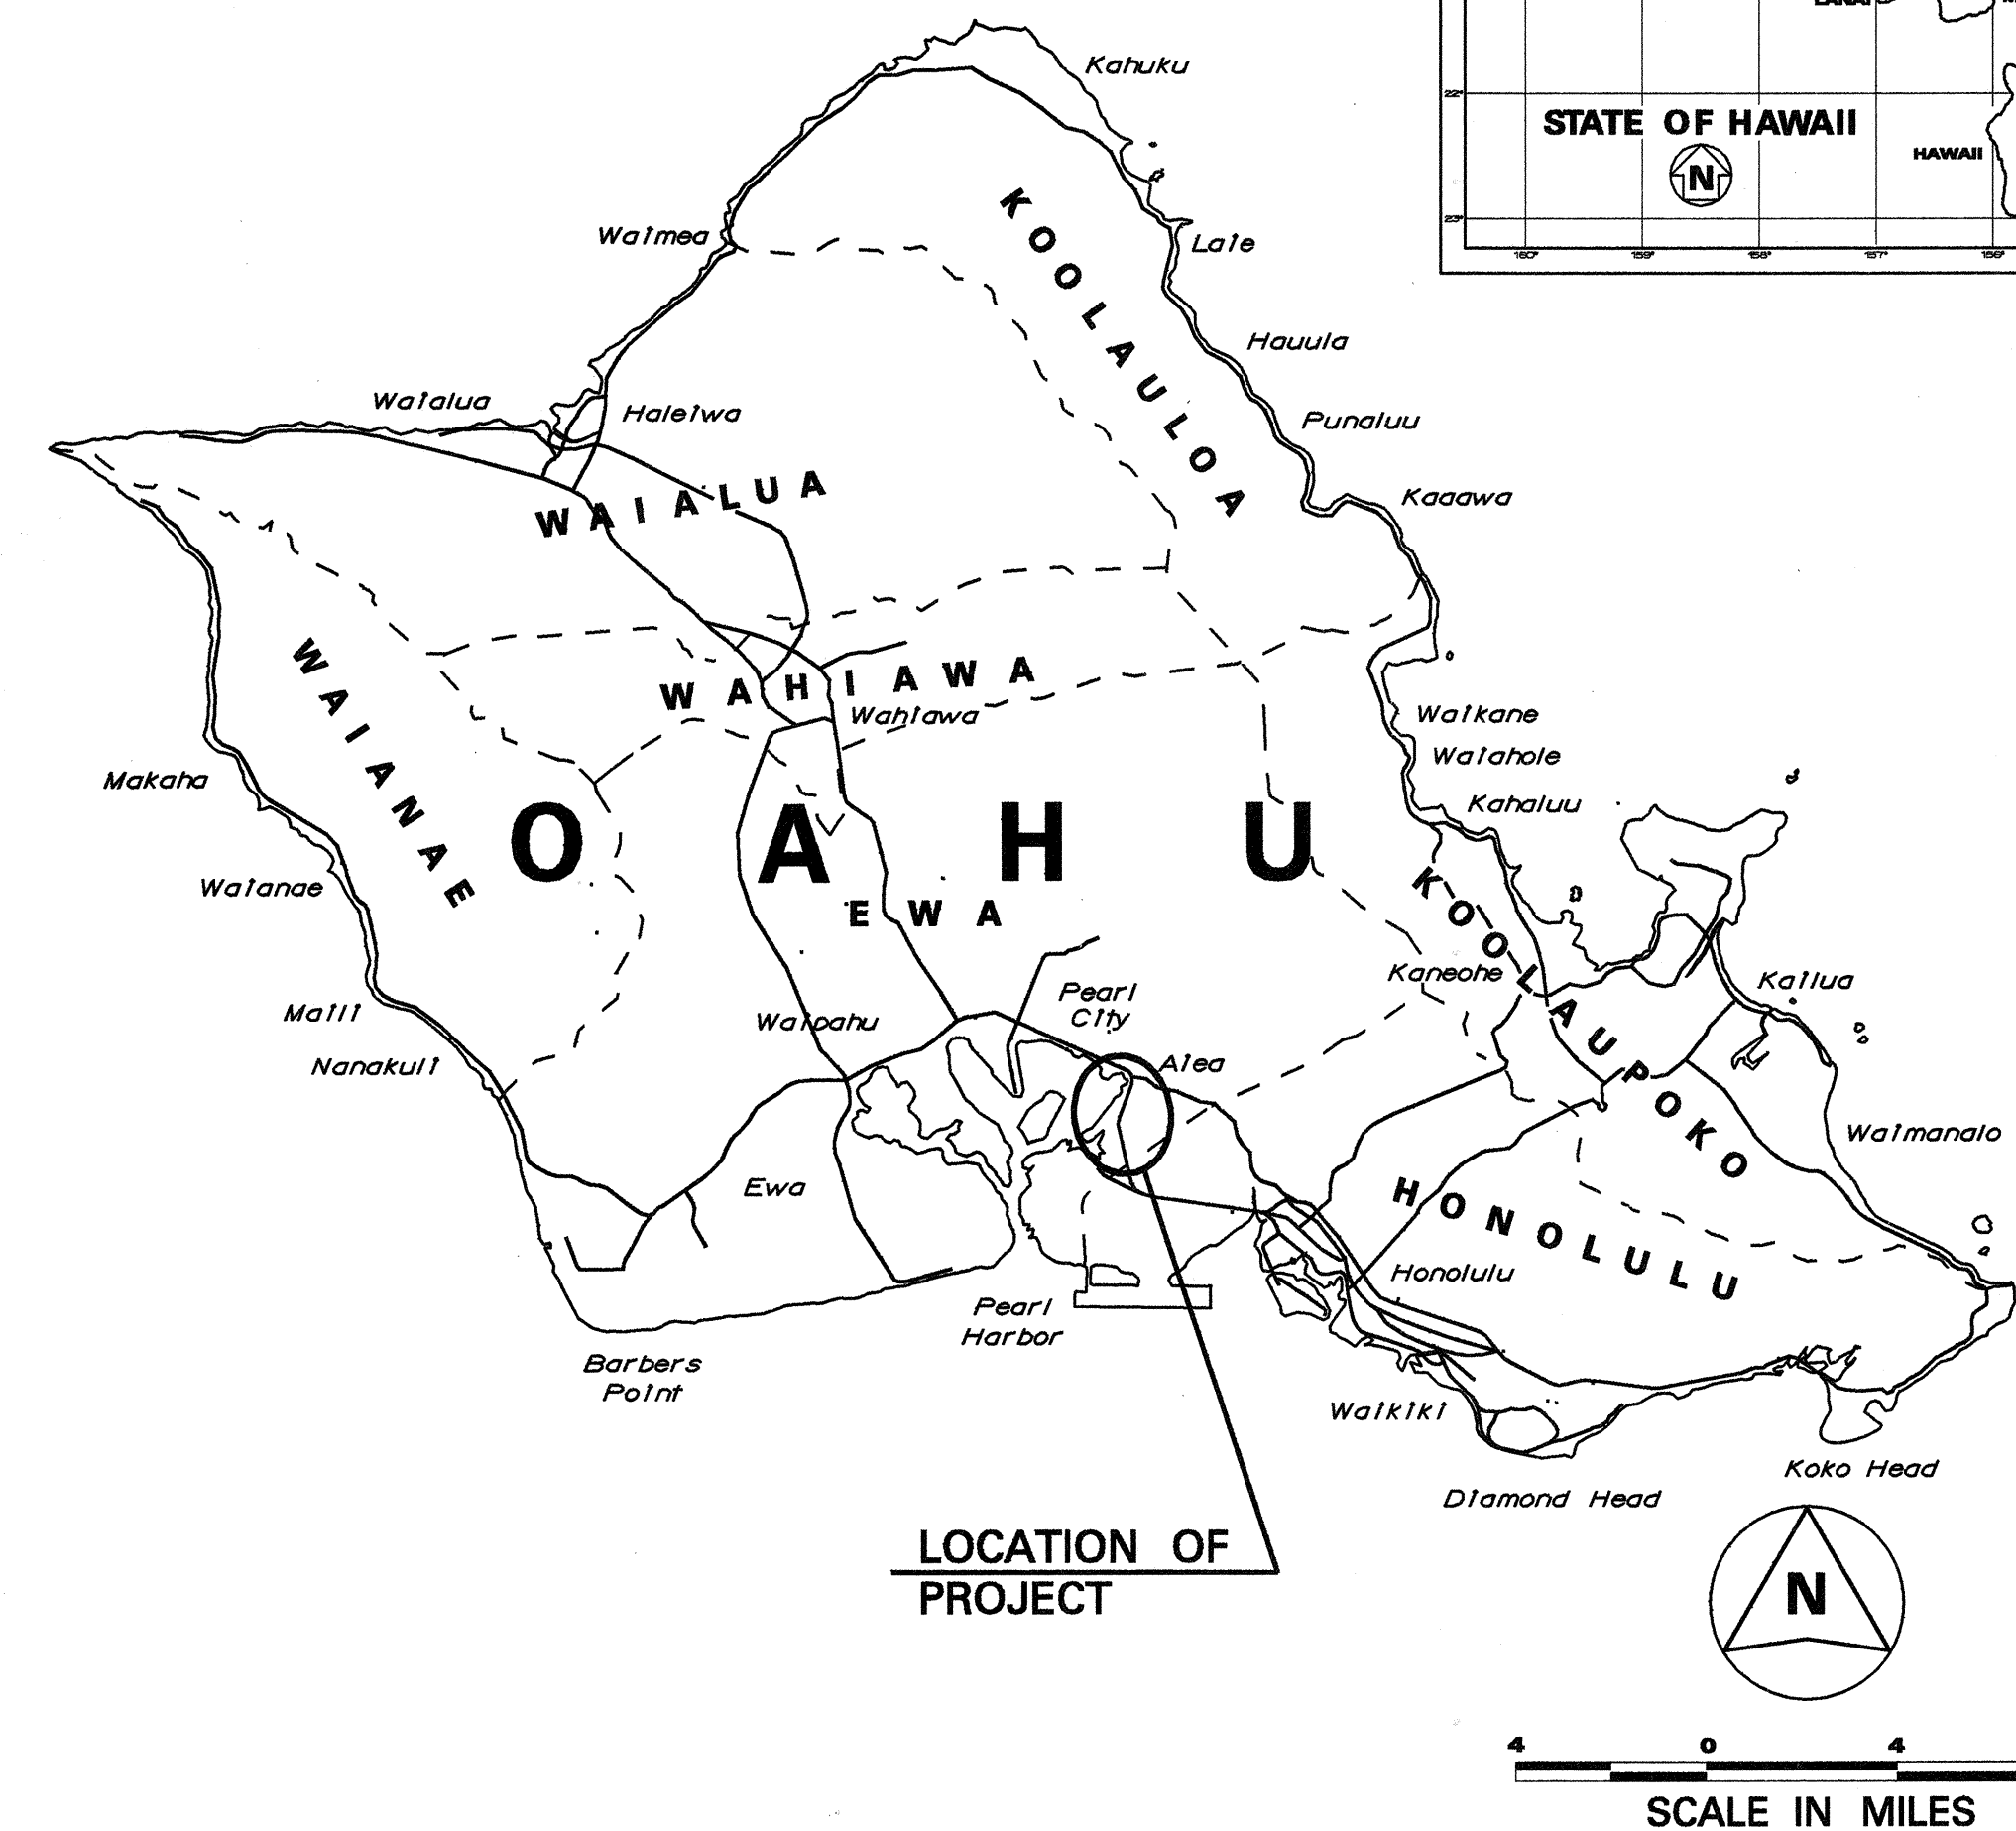


INDEX TO DRAWINGS	
SHEET NO.	DESCRIPTION
1	TITLE SHEET
2	STANDARD PLANS SUMMARY
3	GENERAL NOTES & LEGEND
4	NPDES GENERAL NOTES
5-7	TYPICAL SECTIONS & MISC. DETAILS
8	WHEELCHAIR RAMP PLAN & DETAILS
9-10	HALAWA STREAM BRIDGE GUARDRAIL UPGRADE
11-12	MEDIAN CONCRETE BARRIER & GUARDRAIL UPGRADE
13	UTILITY & MONUMENT ADJUSTMENT SCHEDULES
14-16	PLANS
17-26	PAVEMENT MARKING & SIGNING AND LOOP DETECTOR PLANS, DETAILS & SUMMARIES

STATE OF HAWAII
DEPARTMENT OF TRANSPORTATION
HIGHWAYS DIVISION
HONOLULU, HAWAII
"AS-BUILT"
PLANS FOR
KAMEHAMEHA HIGHWAY RESURFACING
VICINITY OF HONOMANU STREET TO HALAWA DRIVE
FEDERAL AID PROJ. NO. STP-099-1(15)
DISTRICT OF EWA
ISLAND OF OAHU


FED. ROAD DIST. NO.	STATE	FED. AID PROJ. NO.	FISCAL YEAR	SHEET NO.	TOTAL SHEETS
HAWAII	HAW.	STP-099-1(15)	1995	1	26

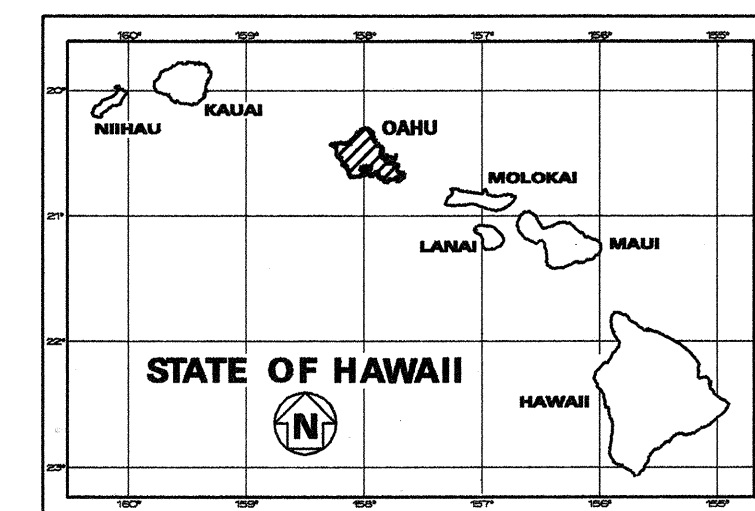

MILE POST 21.19 TO MILE POST 22.10

DESIGN DESIGNATION

ADT (1994).....	44,300
DESIGN ADT (2014)....	76,600
DHV	6,900
D	85/15
T24.....	4.0 %

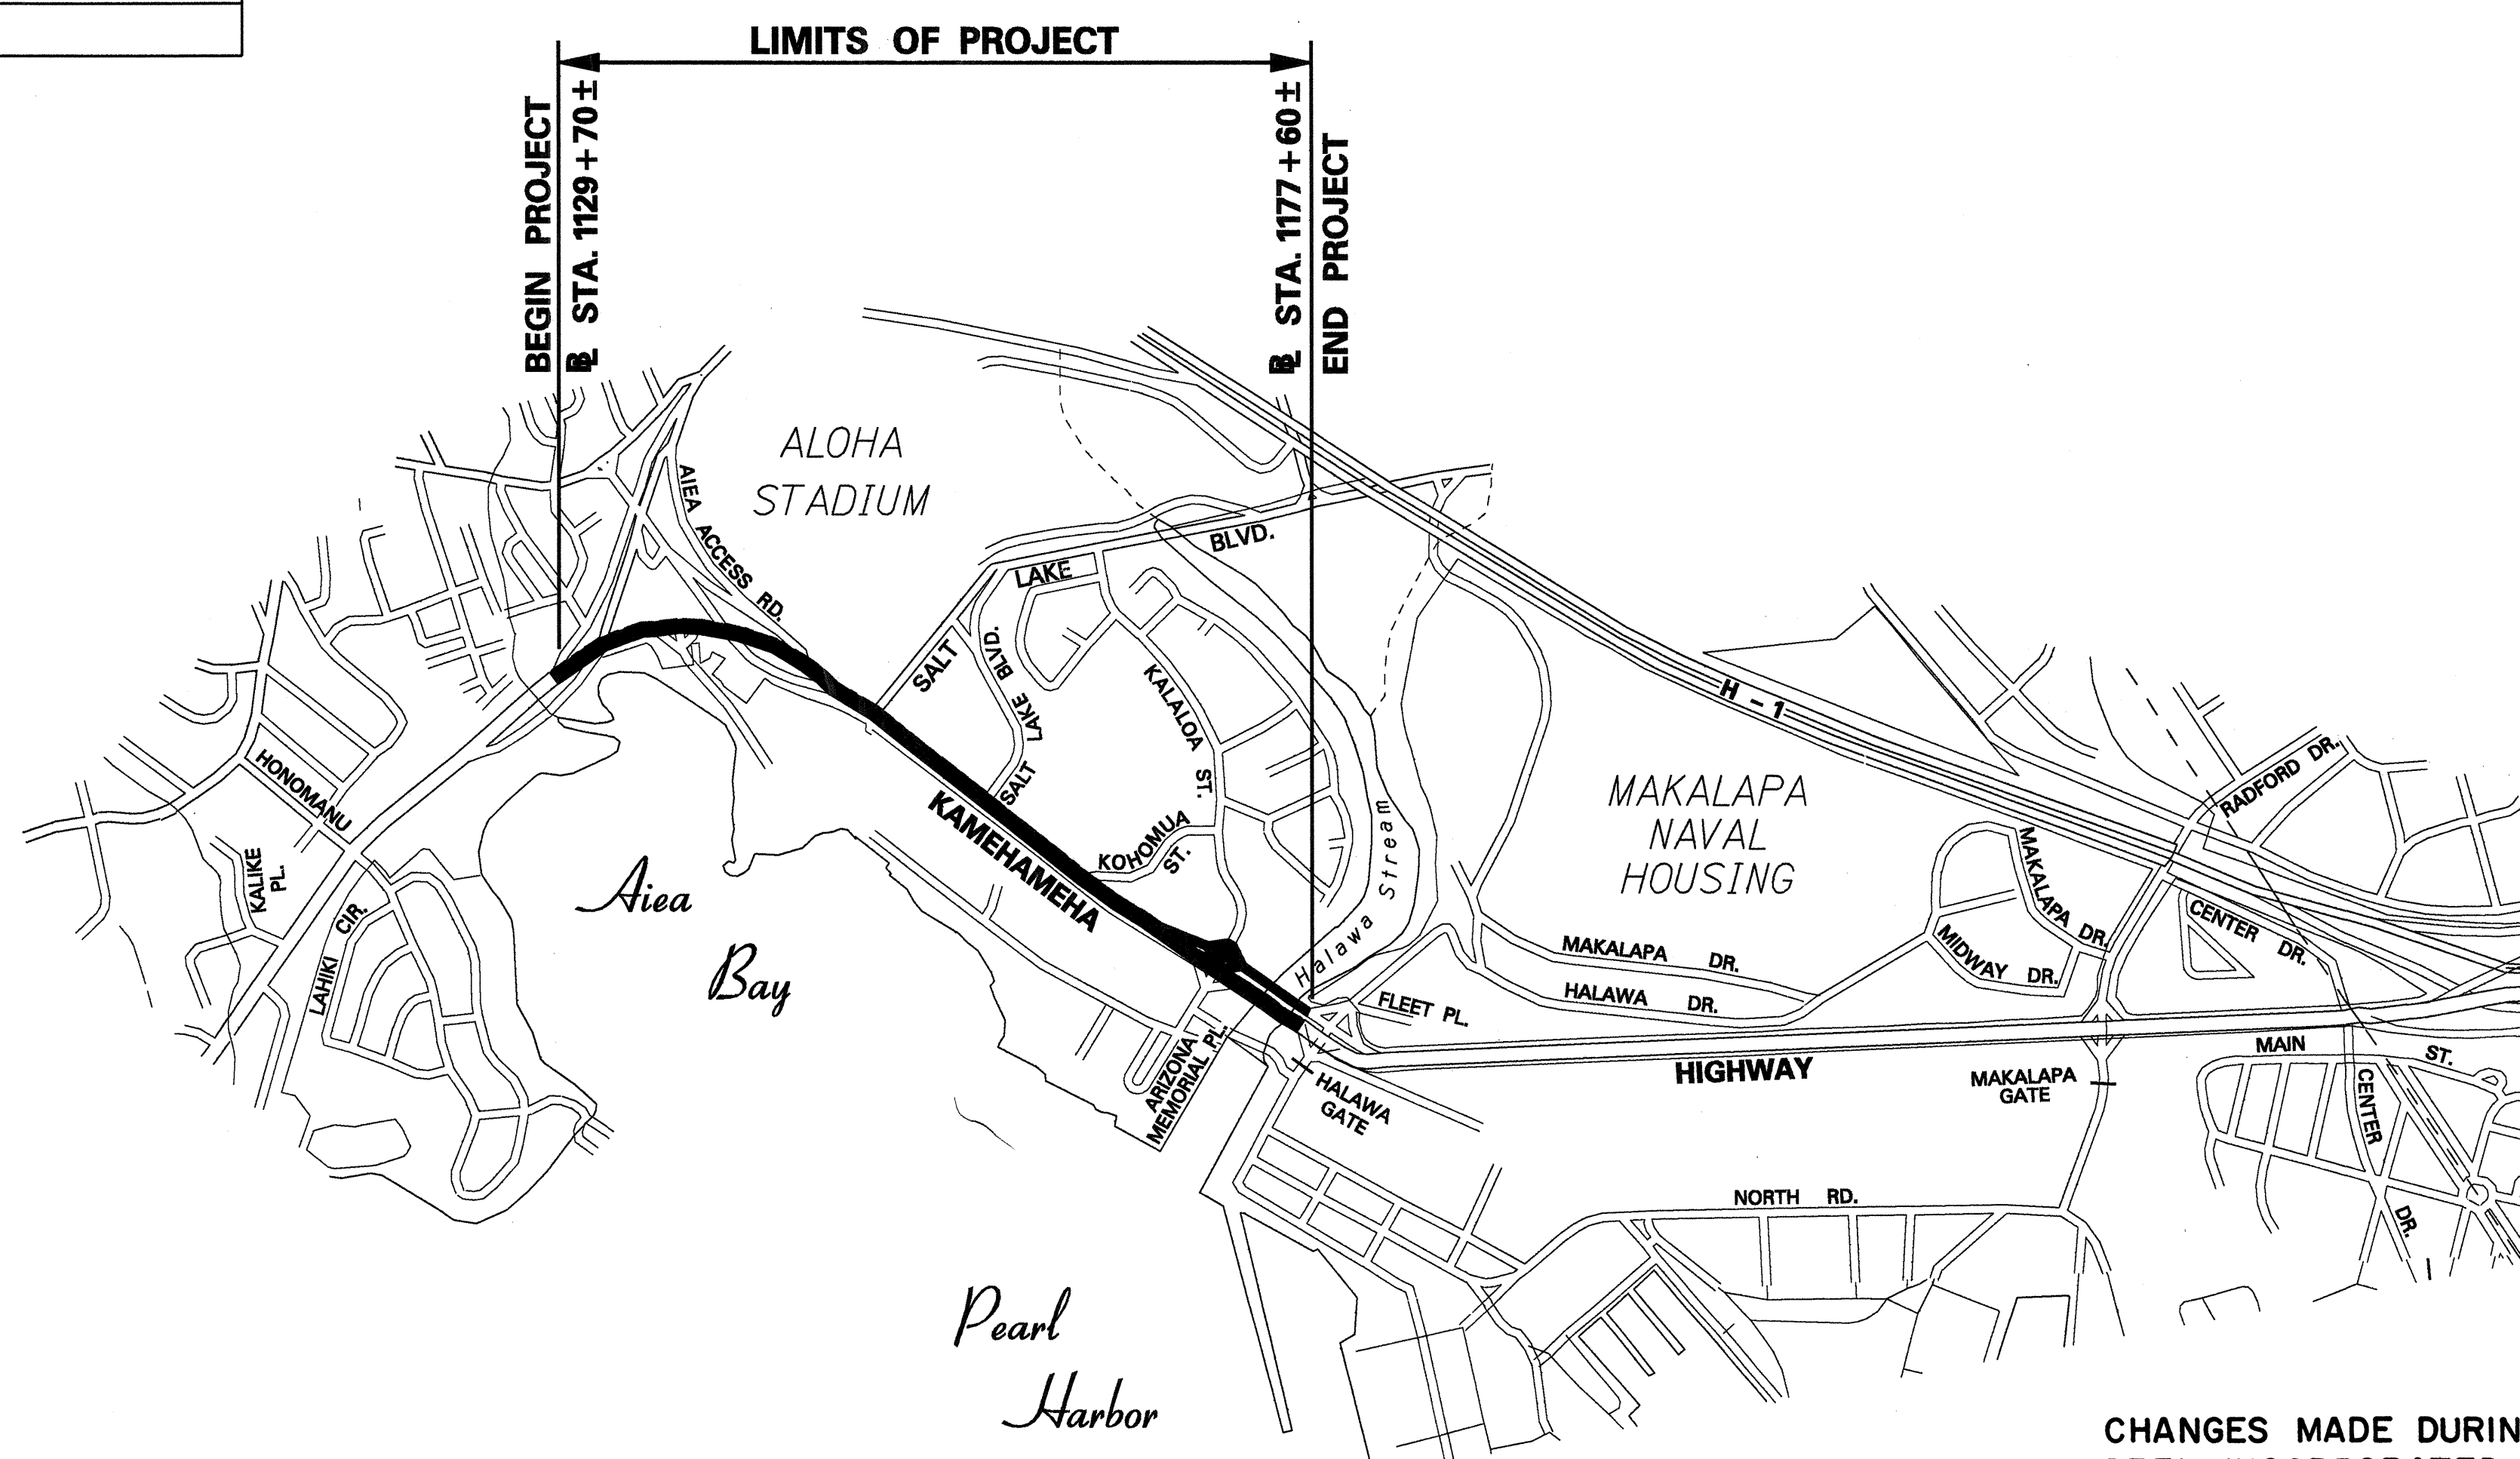

LOCATION PLAN

GROSS LENGTH OF PROJECT.....0.907 MILES
NET LENGTH OF PROJECT.....0.885 MILES

CHANGES MADE DURING CONSTRUCTION HAVE BEEN INCORPORATED ON THESE PLANS EXCEPT CHANGES IN THE ORIGINAL THEORETICAL QUANTITIES FOR ACTUAL QUANTITIES, REFER TO PROJECT LEDGER AND/OR COMPUTATION BOOK.

Robert Shin
RESIDENT ENGINEER

2-10-2002
DATE

DEPARTMENT OF TRANSPORTATION STATE OF HAWAII	
APPROVED:	
<i>Suzanne Koyashida</i>	6/13/95
DIR. OF TRANSPORTATION	DATE