




FED. ROAD DIST. NO.	STATE	FED. AID PROJ. NO.	FISCAL YEAR	SHEET NO.	TOTAL SHEETS
HAWAII	HAW.	STP-099-1(15)	1995	6	26

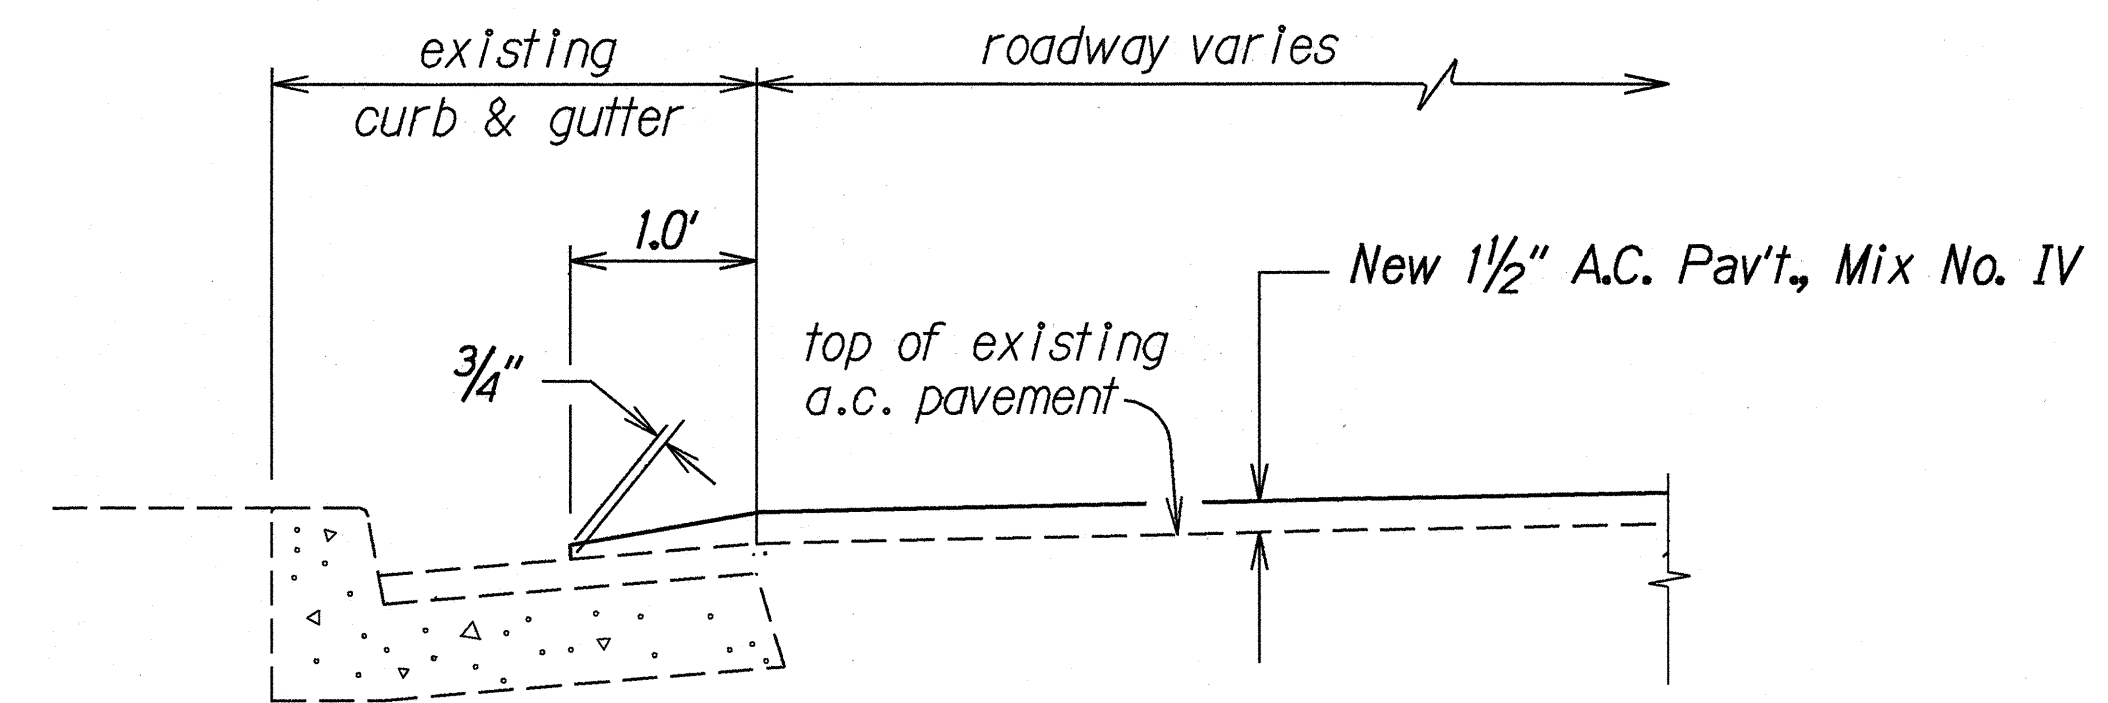


**RESURFACING OVER EXISTING PAVEMENT
AT GUTTER SECTION**
Not to Scale

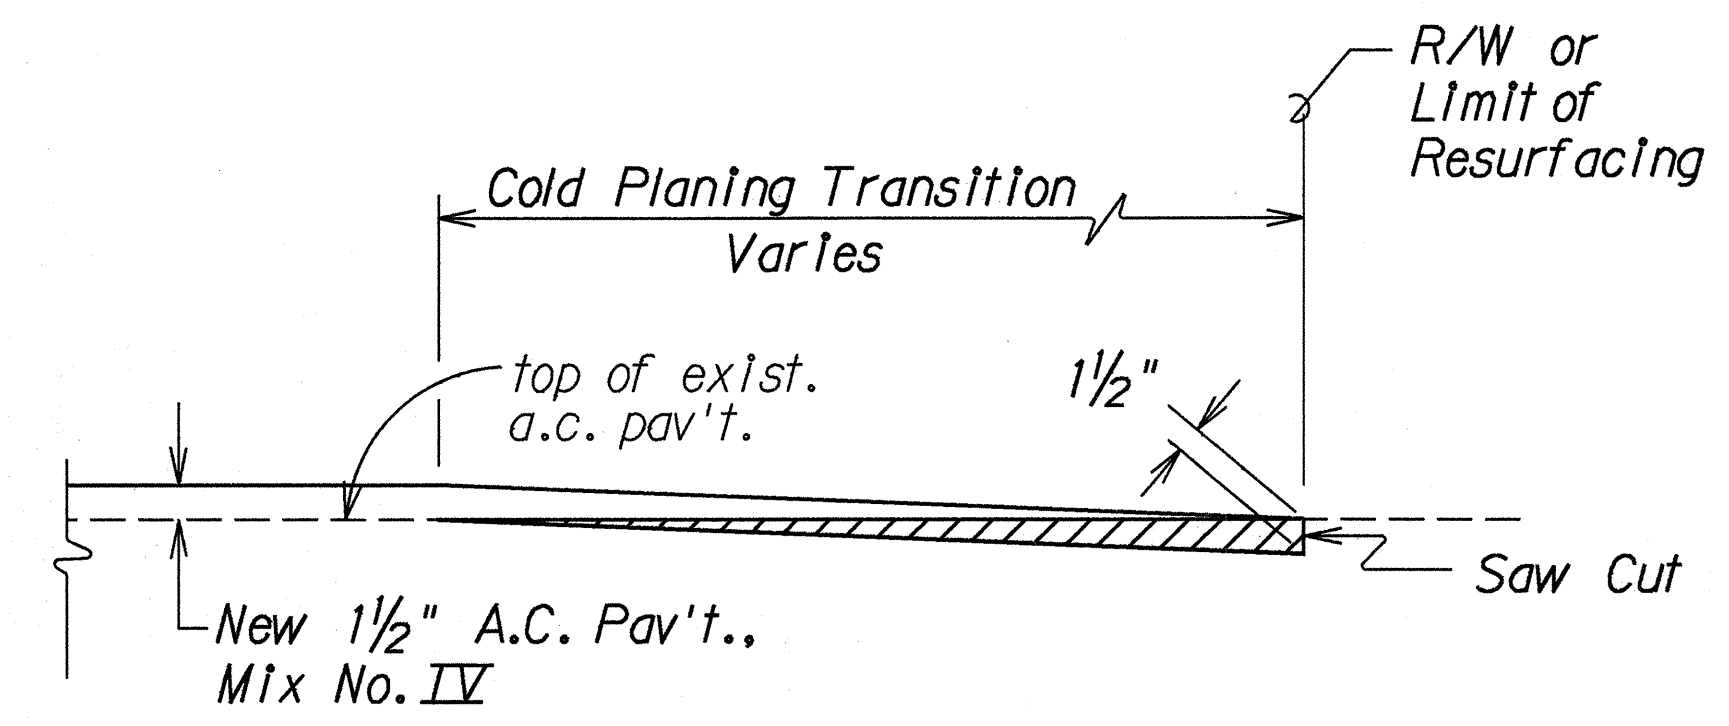


SIDE STREET RESURFACING DETAIL
Not to Scale

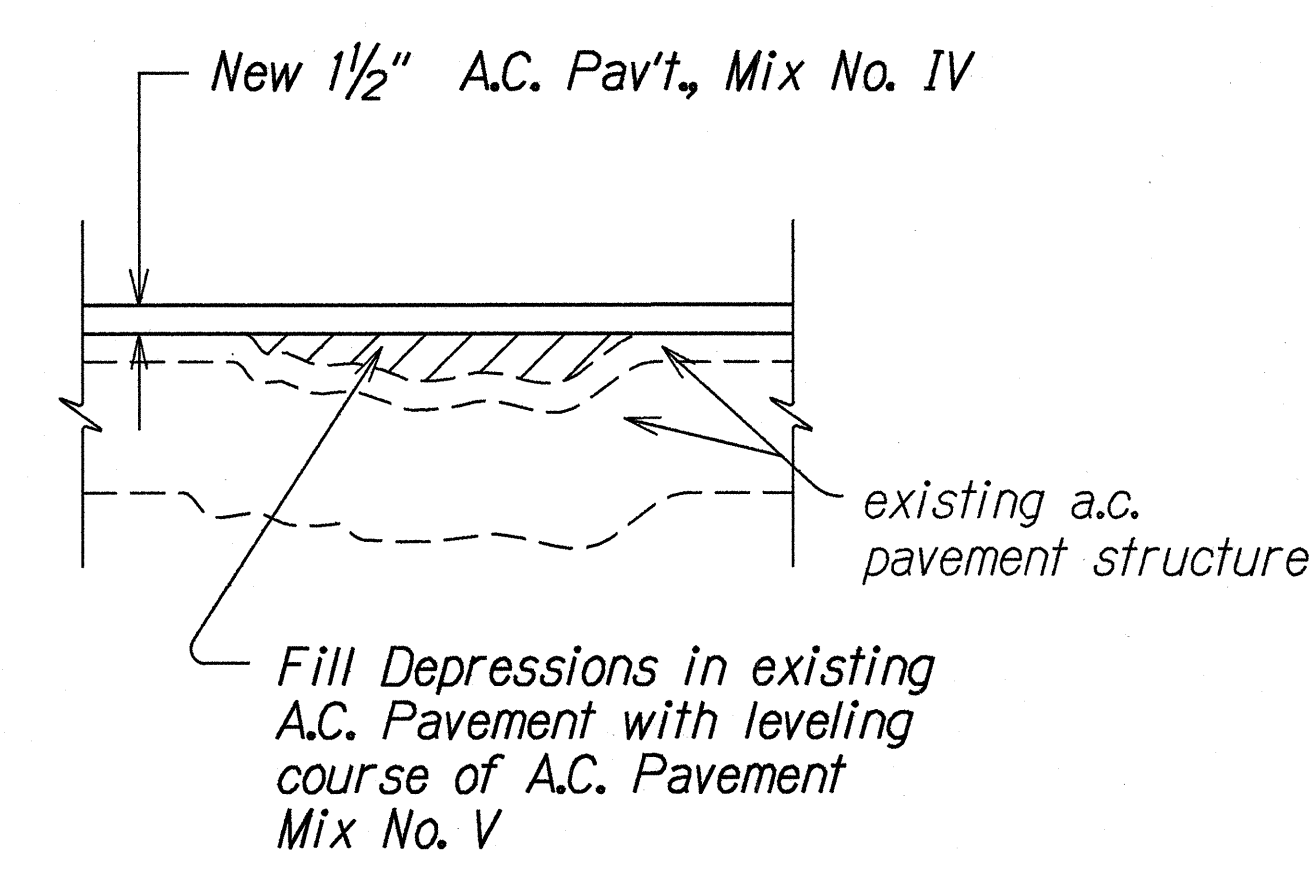

LEVELING COURSE DETAIL
Not To Scale

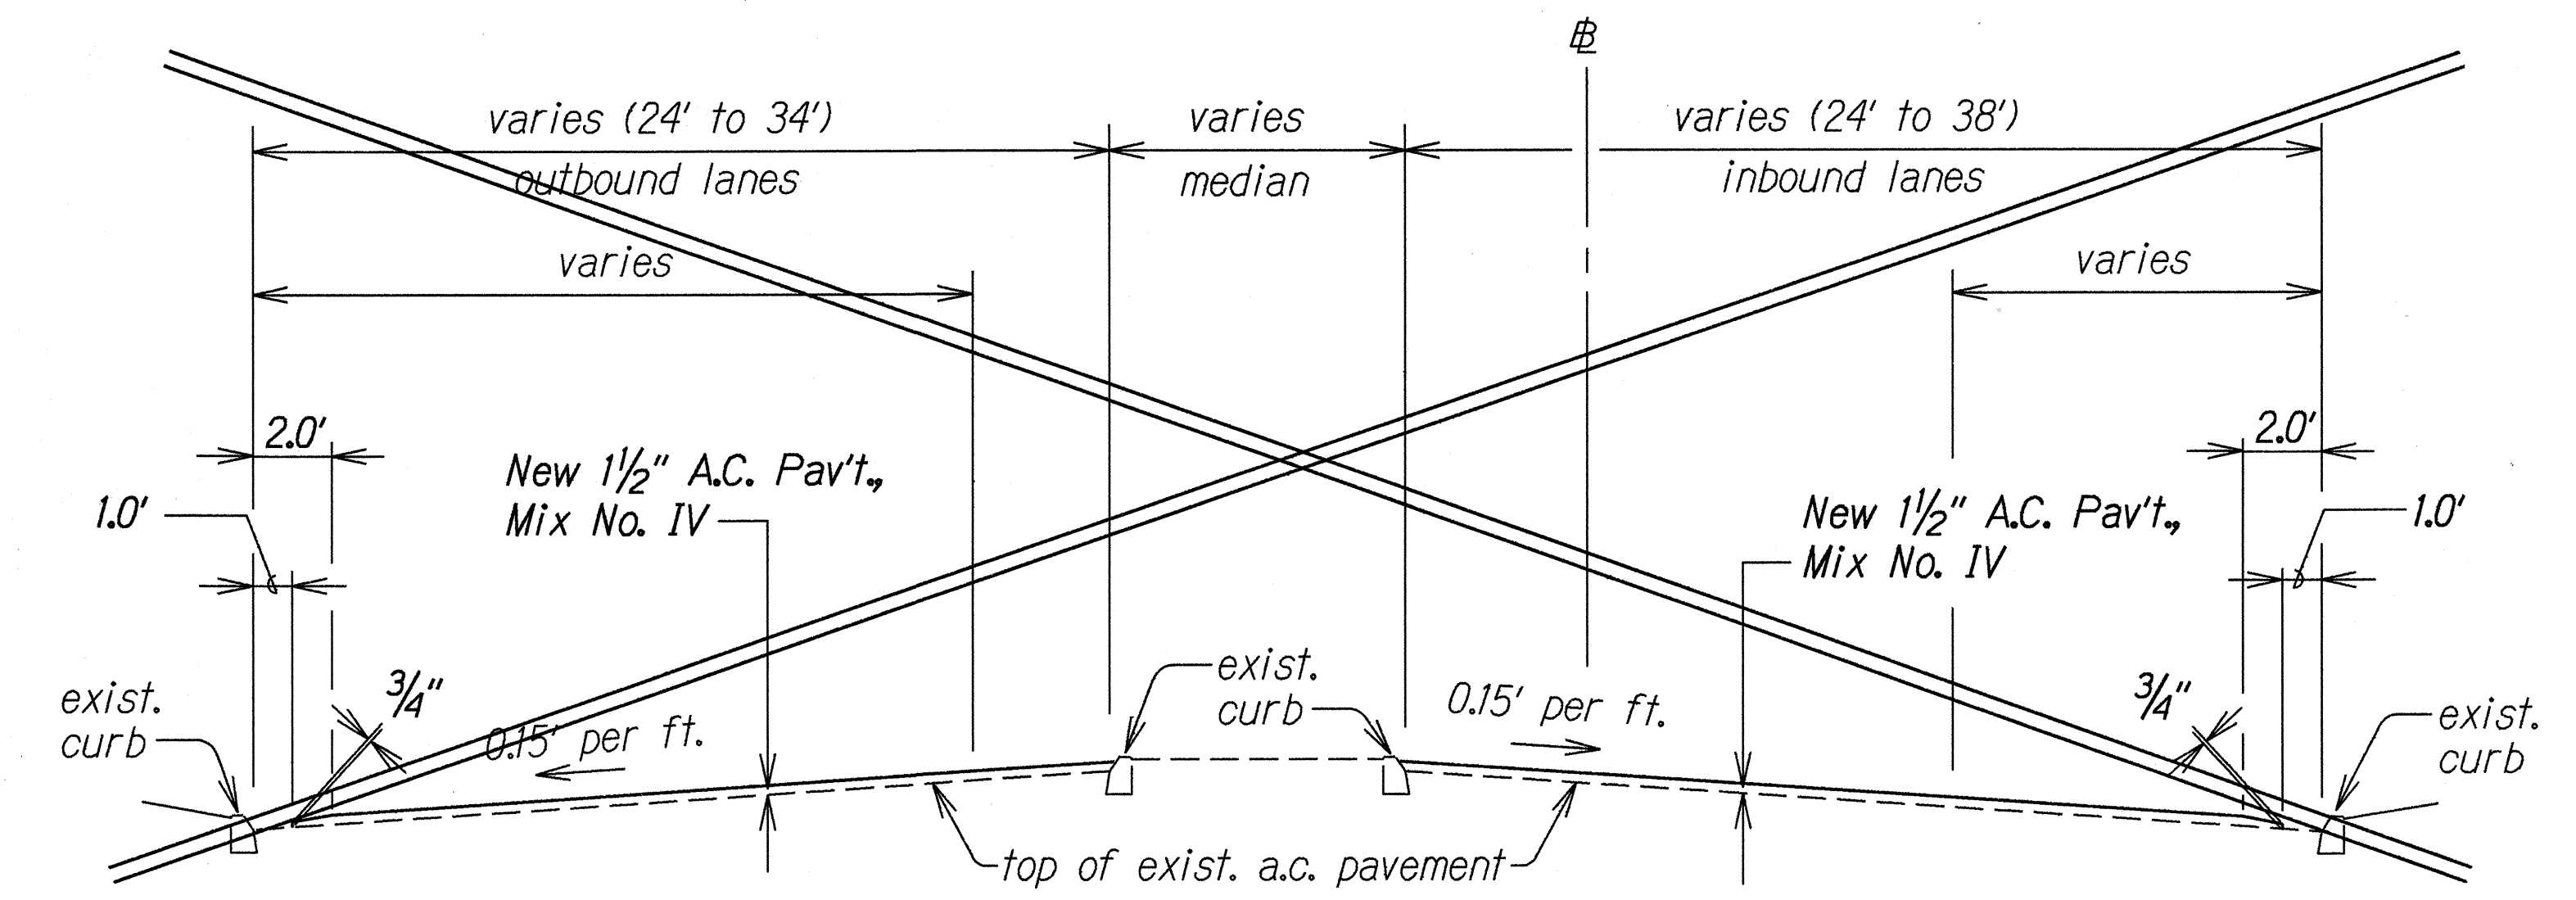

TYPICAL SECTION
~~# Sta. 1151+00± to 1156+30±~~
~~Scale: 1/4"=1'-0"~~

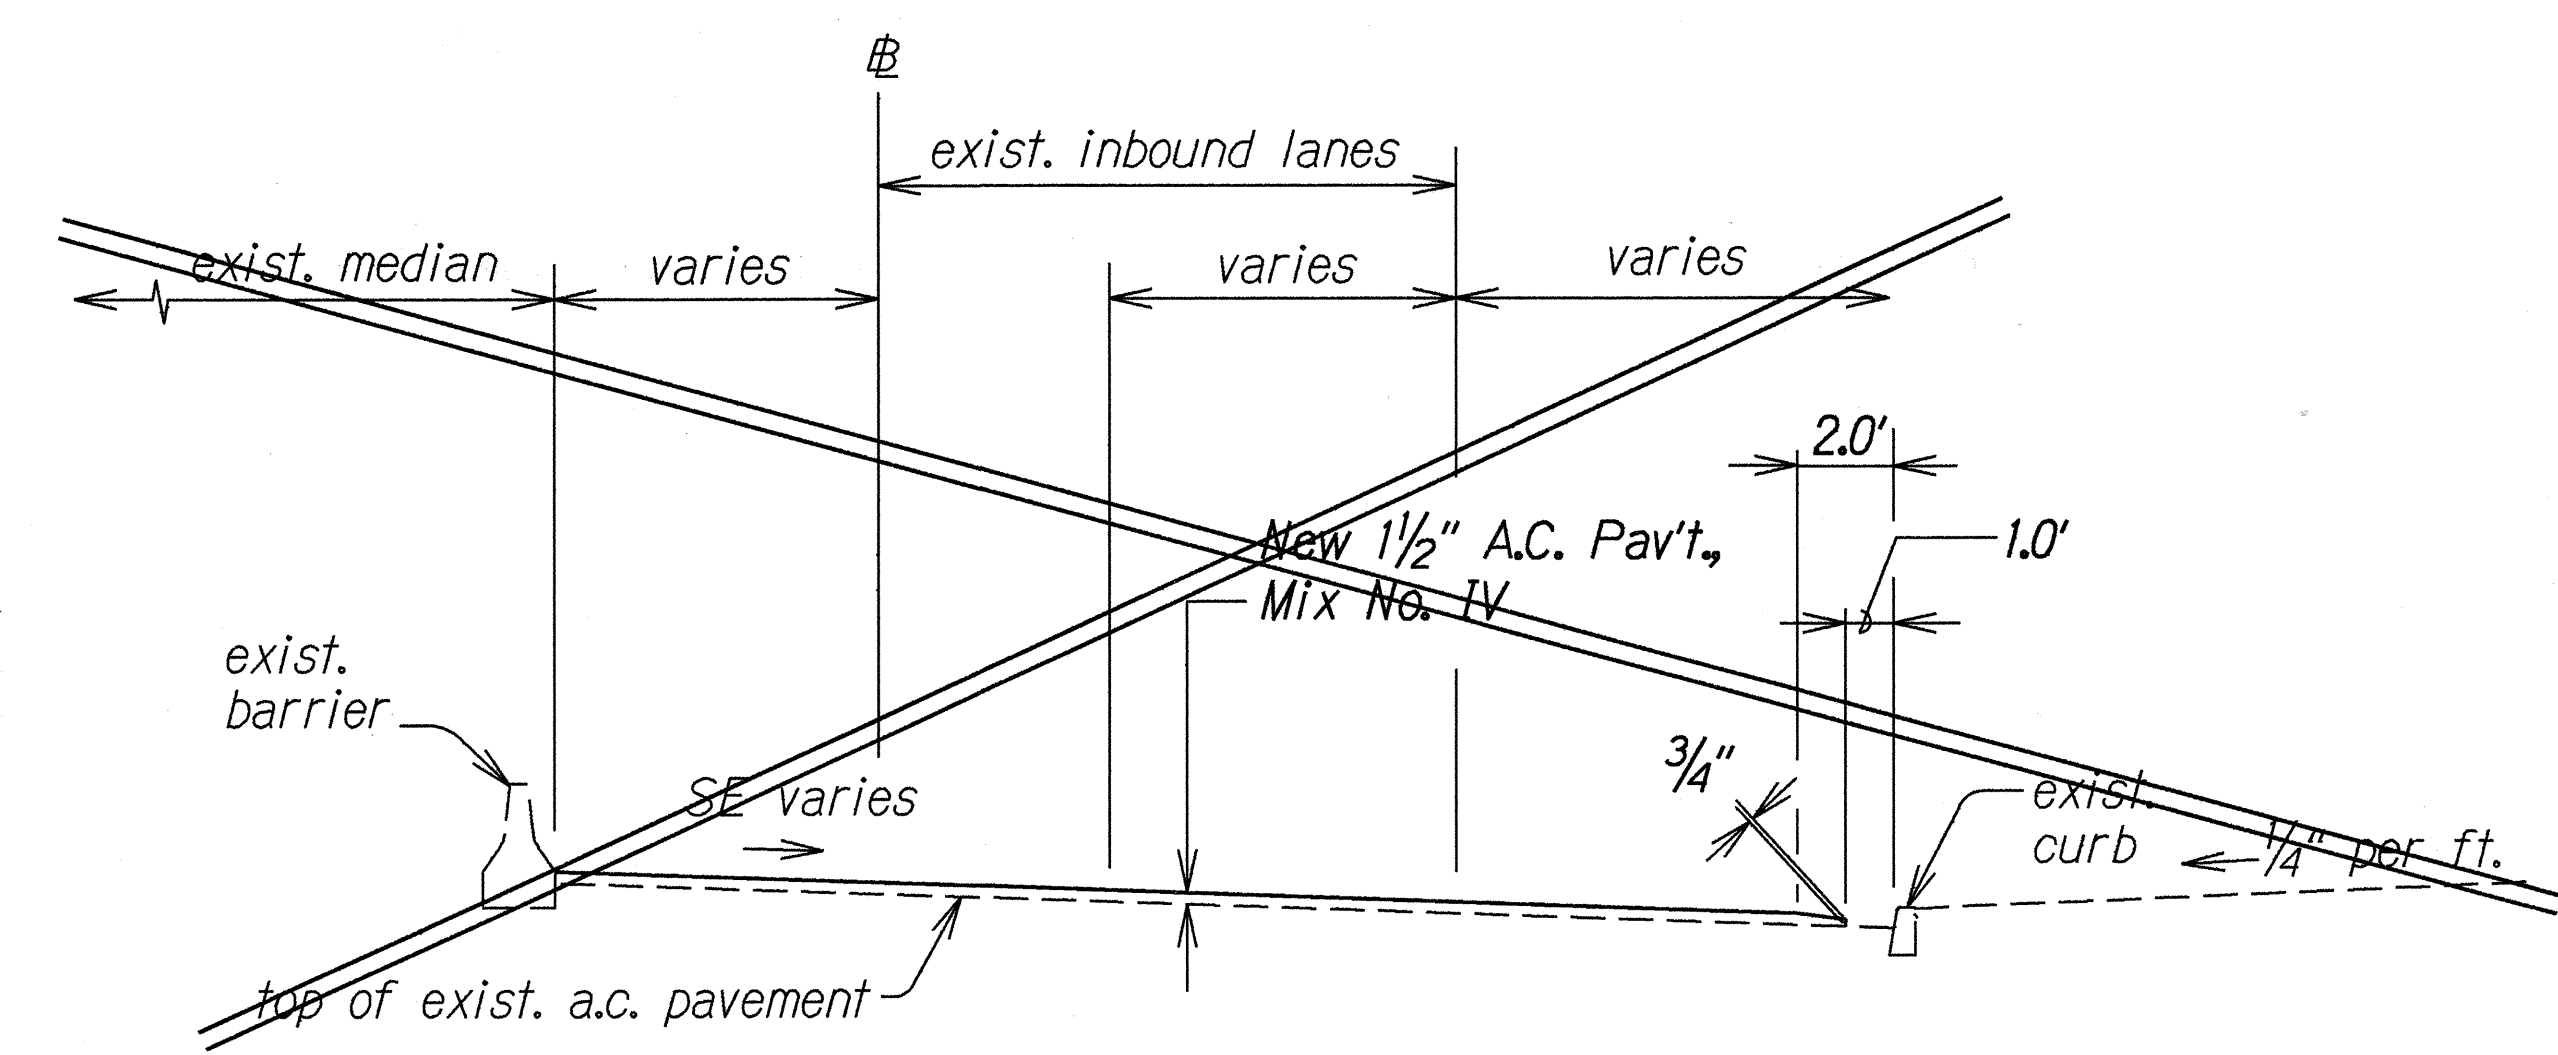

TYPICAL SECTION
~~# Sta. 1156+30± to 1162+67.97~~
~~Scale: 1/4"=1'-0"~~

LEGEND FOR AS-BUILT POSTINGS	
	Squiggly line for as-built deletion
	Double line for as-built deletion
Roadway	Text for as-built posting



STATE OF HAWAII
DEPARTMENT OF TRANSPORTATION
HIGHWAYS DIVISION

TYPICAL SECTIONS #
MISCELLANEOUS DETAILS
KAMEHAMEHA HIGHWAY RESURFACING
Vicinity of Honomanu St. to Halawa Dr.
Fed. Aid Project No. STP-099-1(15)
Scale: As Shown Date: June, 1995


SHEET No. 2 OF 3 SHEETS

DATE	16/09/95
DESIGNED BY	L. Yodanis
CHECKED BY	N. Brundage
QUANTITIES BY	
NOTED BY	
ORIGINAL PLAN	


FED. ROAD DIST. NO.	STATE	FED. AID PROJ. NO.	FISCAL YEAR	SHEET NO.	TOTAL SHEETS
HAWAII	HAW.	STP-099-1(15)	1995	7	26

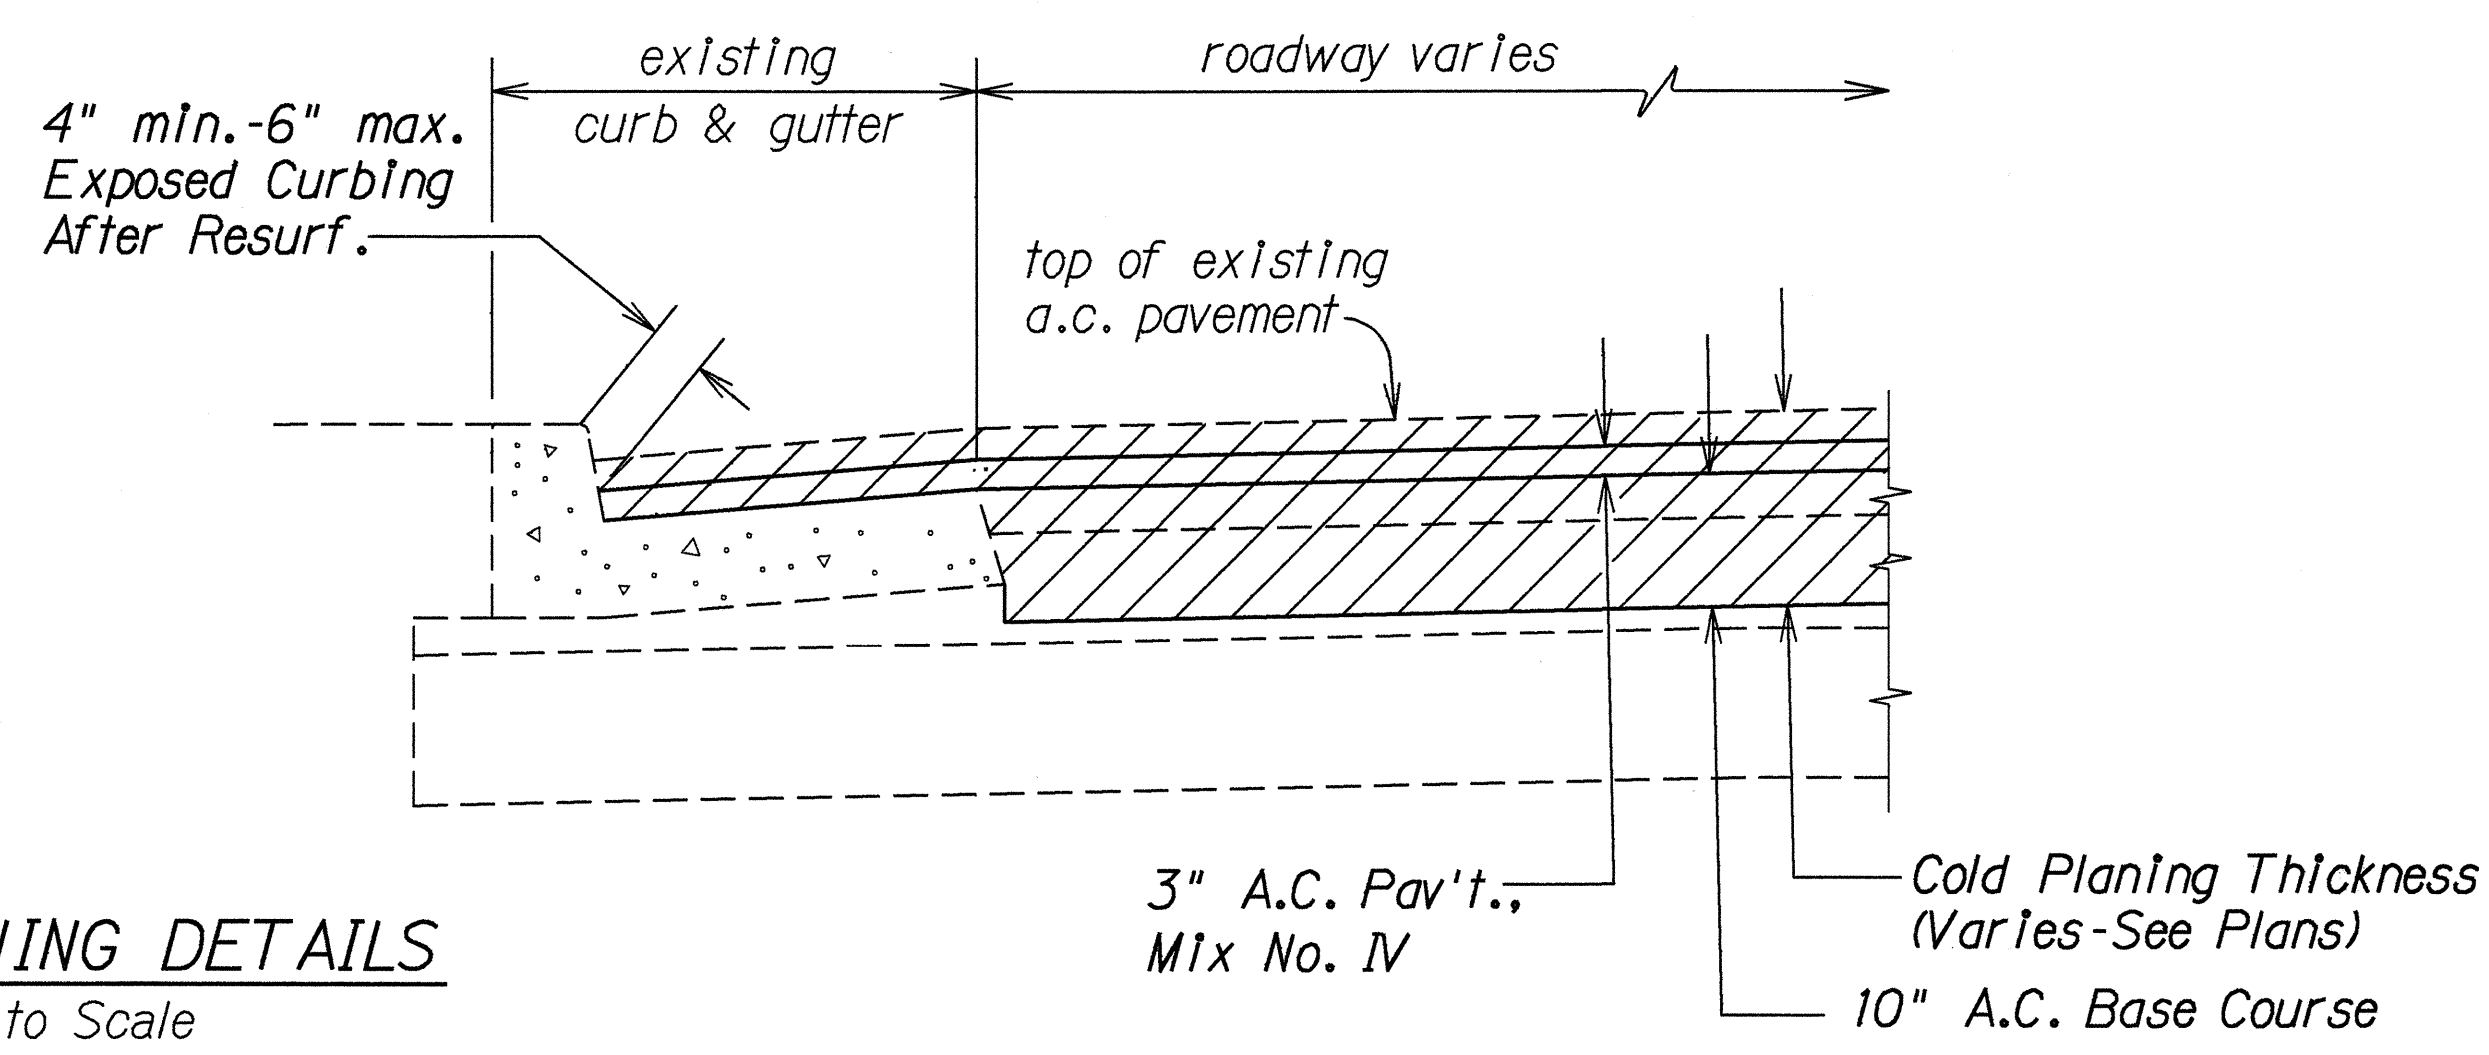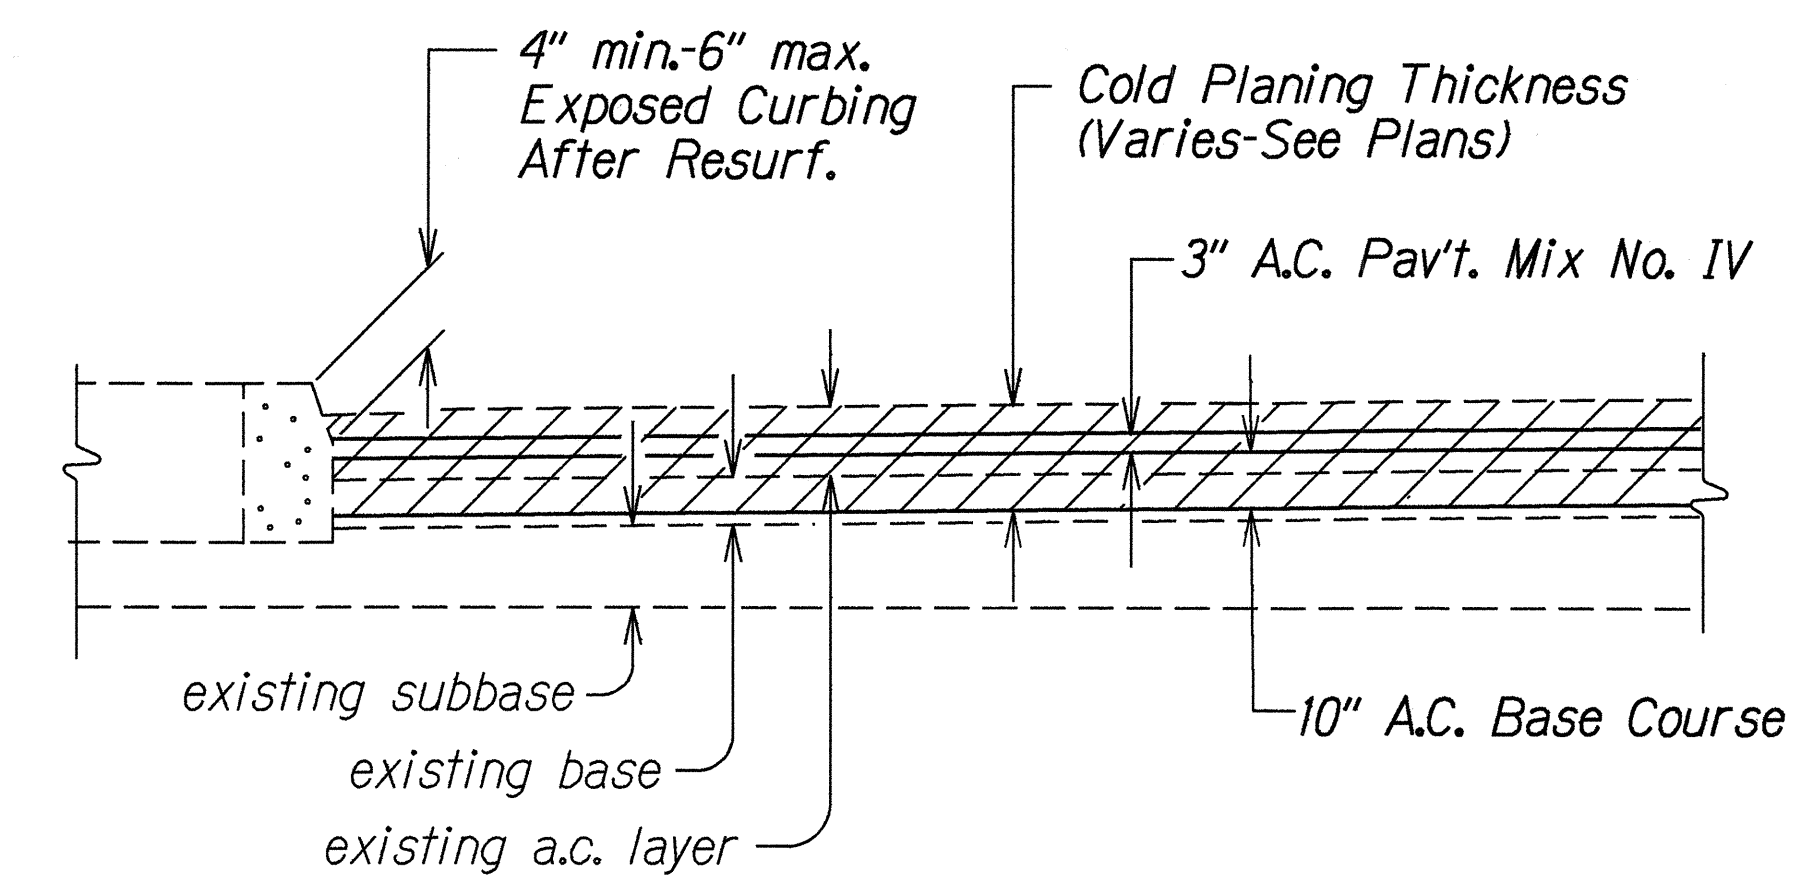


COLD PLANING DETAILS
Not to Scale

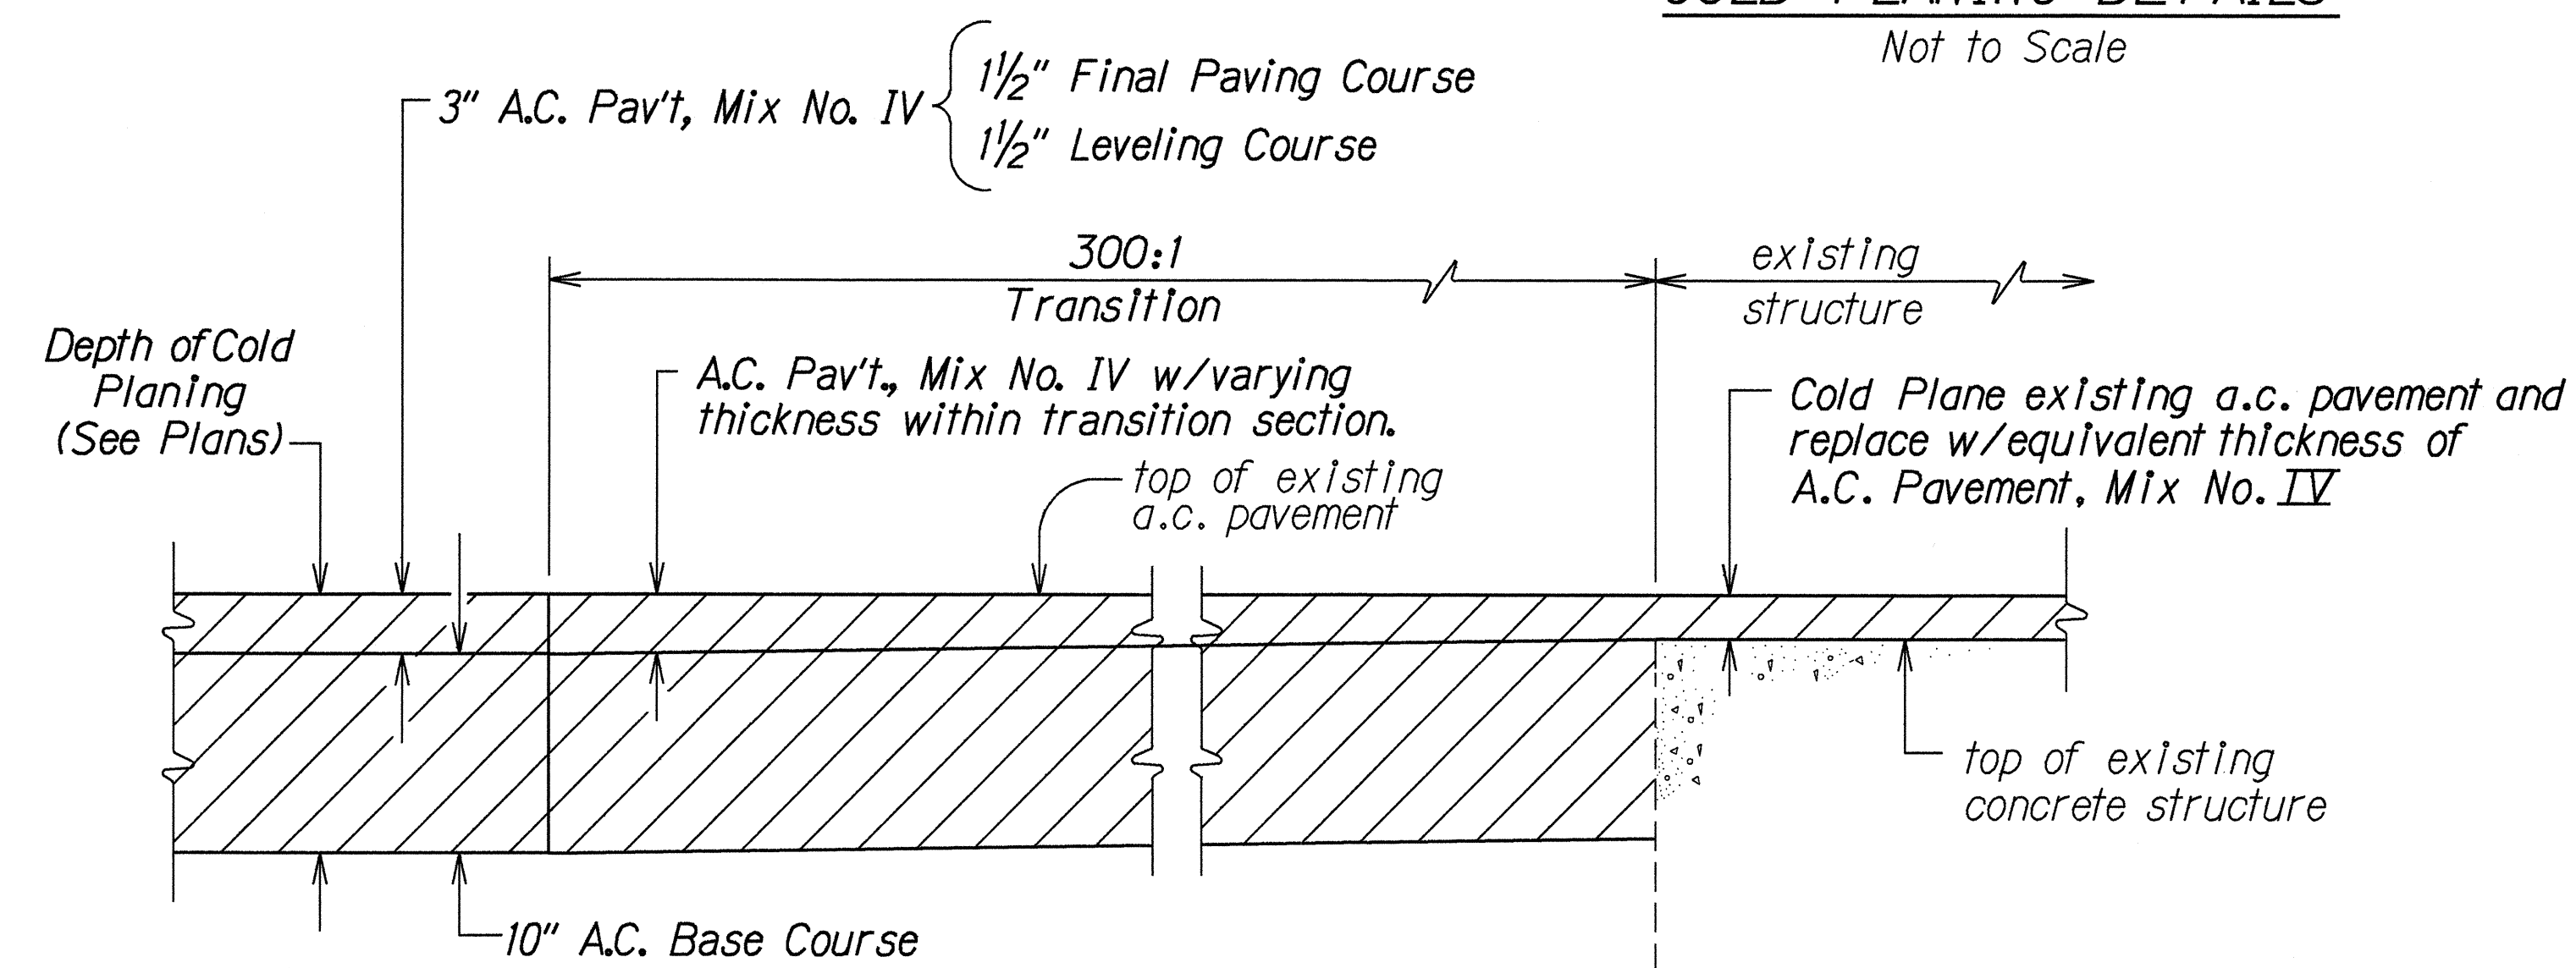


COLD PLANING TRANSITION AND RESURFACING OVER EXISTING STRUCTURE DETAIL
Not to Scale

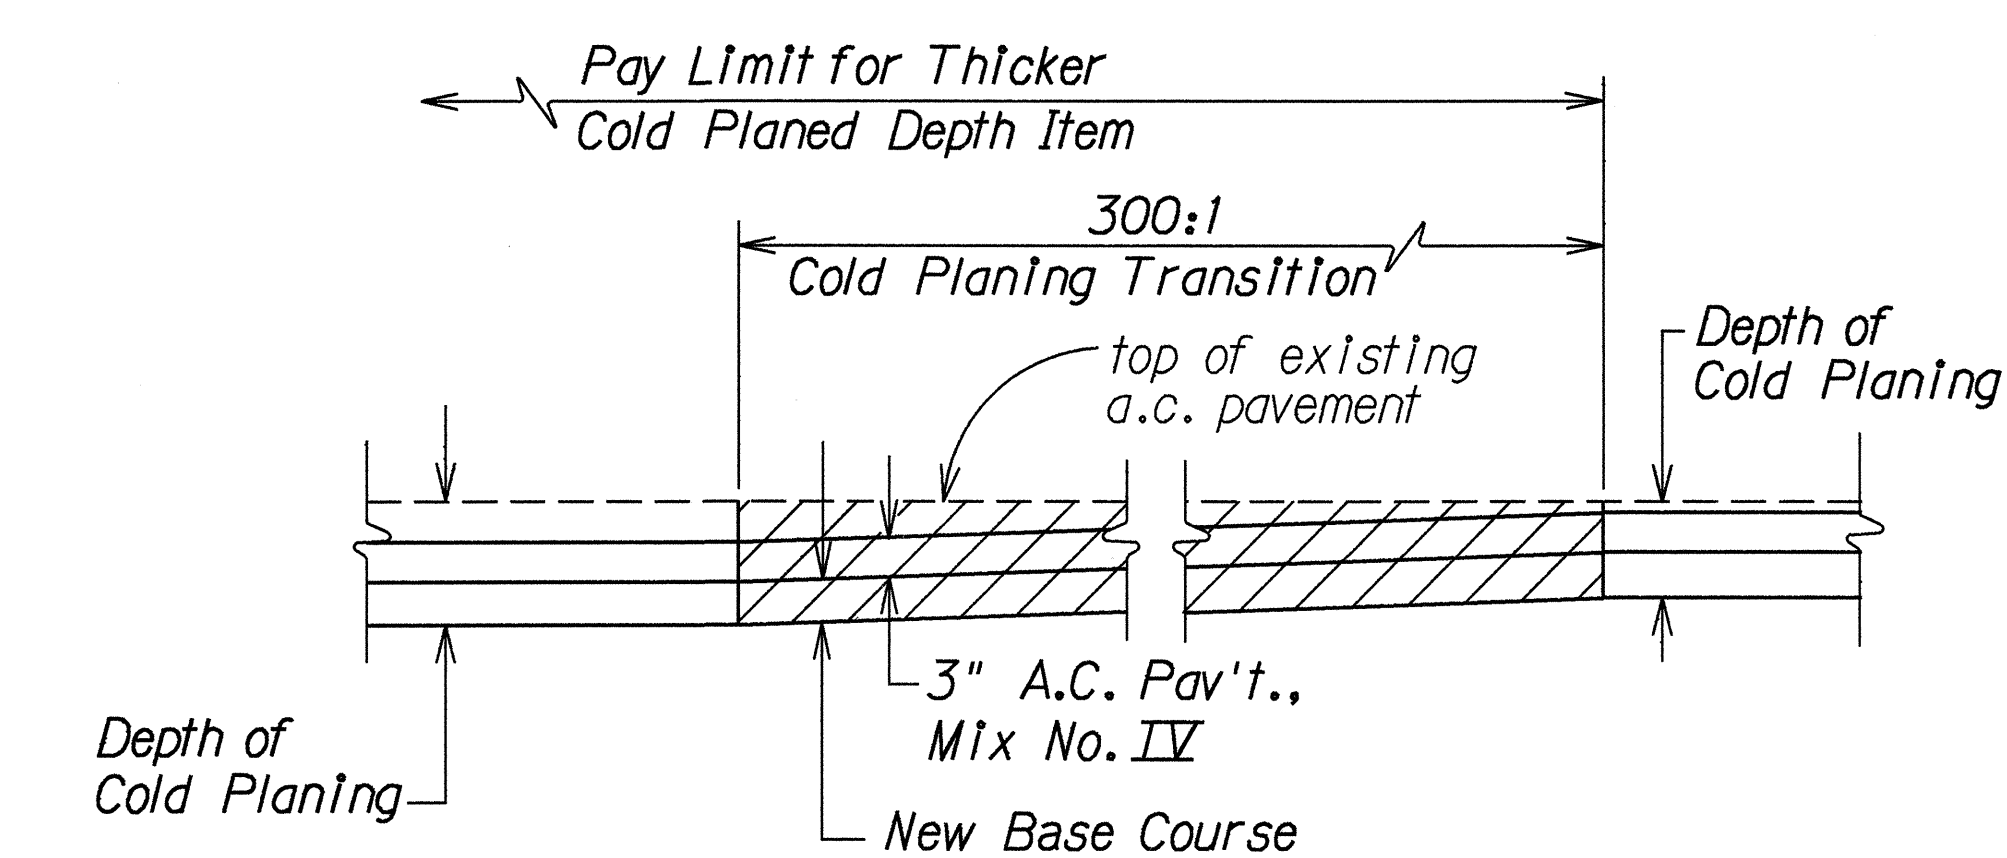

LONGITUDINAL COLD PLANING TRANSITION DETAIL
Not to Scale

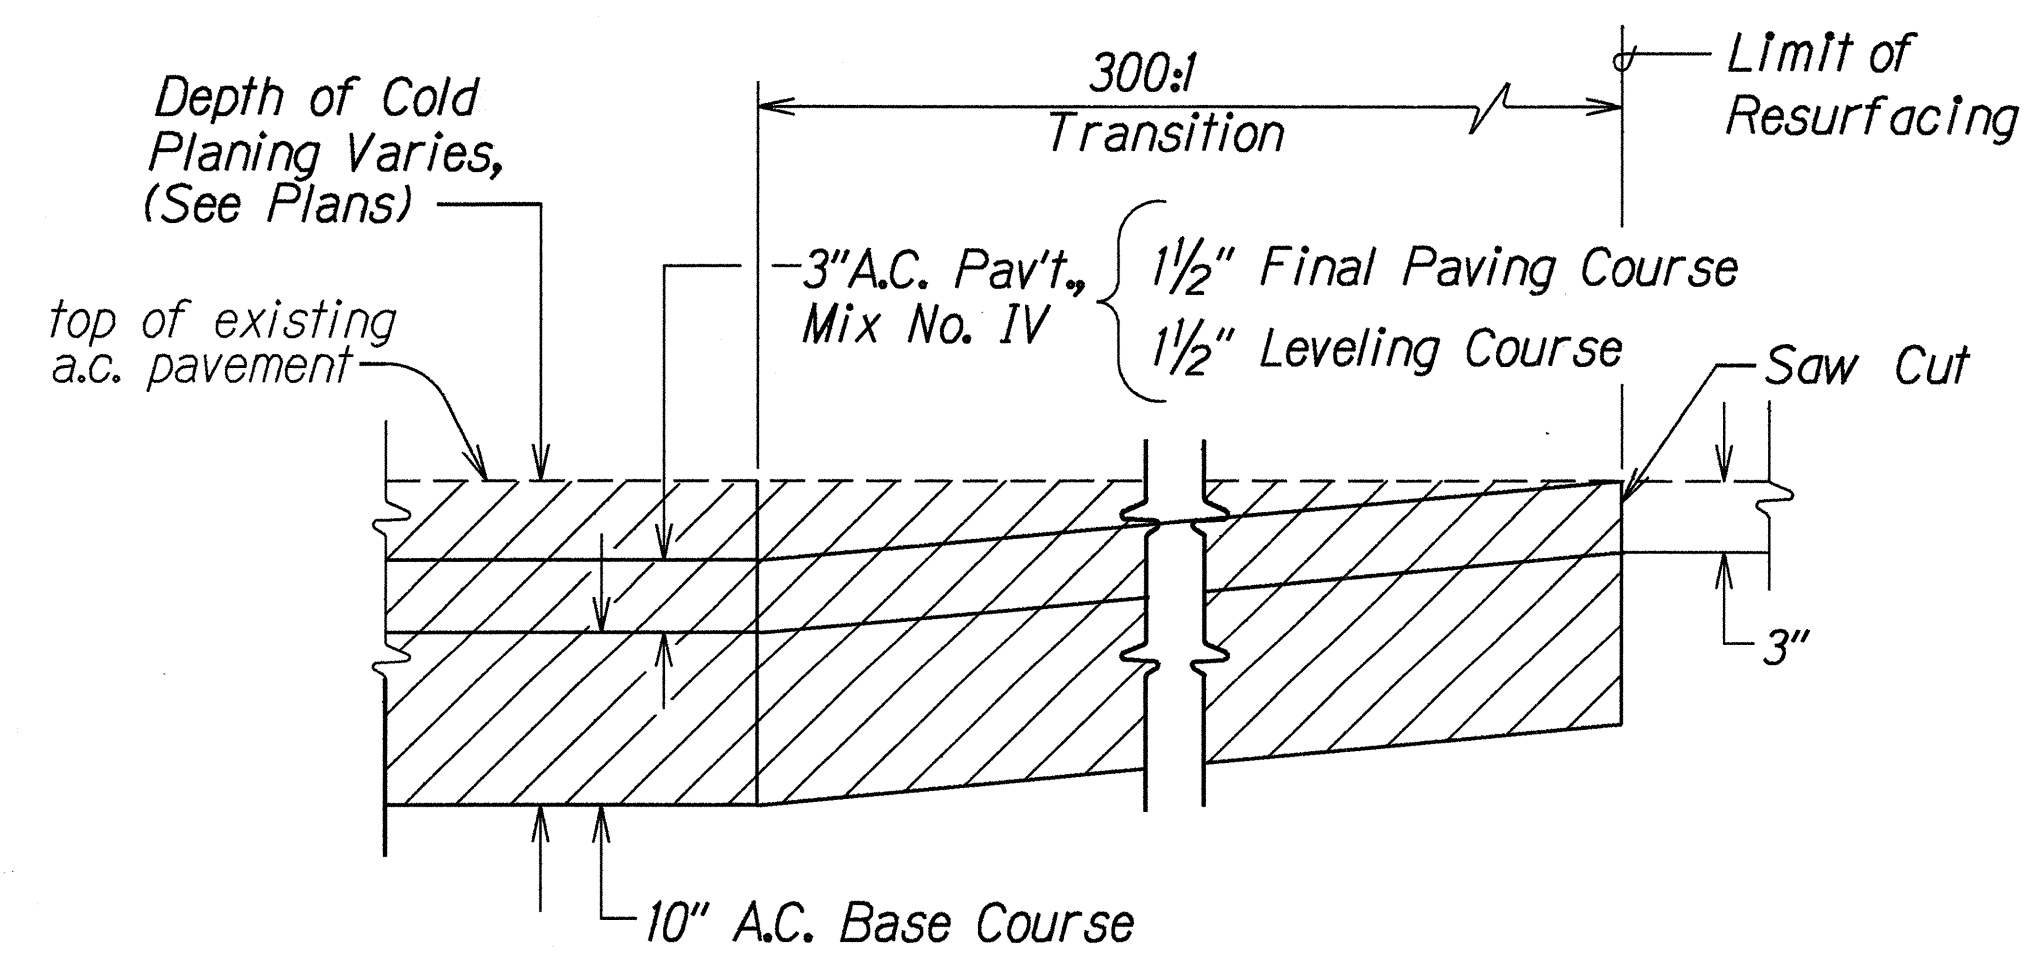

COLD PLANING AND RESURFACING DETAIL BEGINNING OF PROJECT
Not to Scale

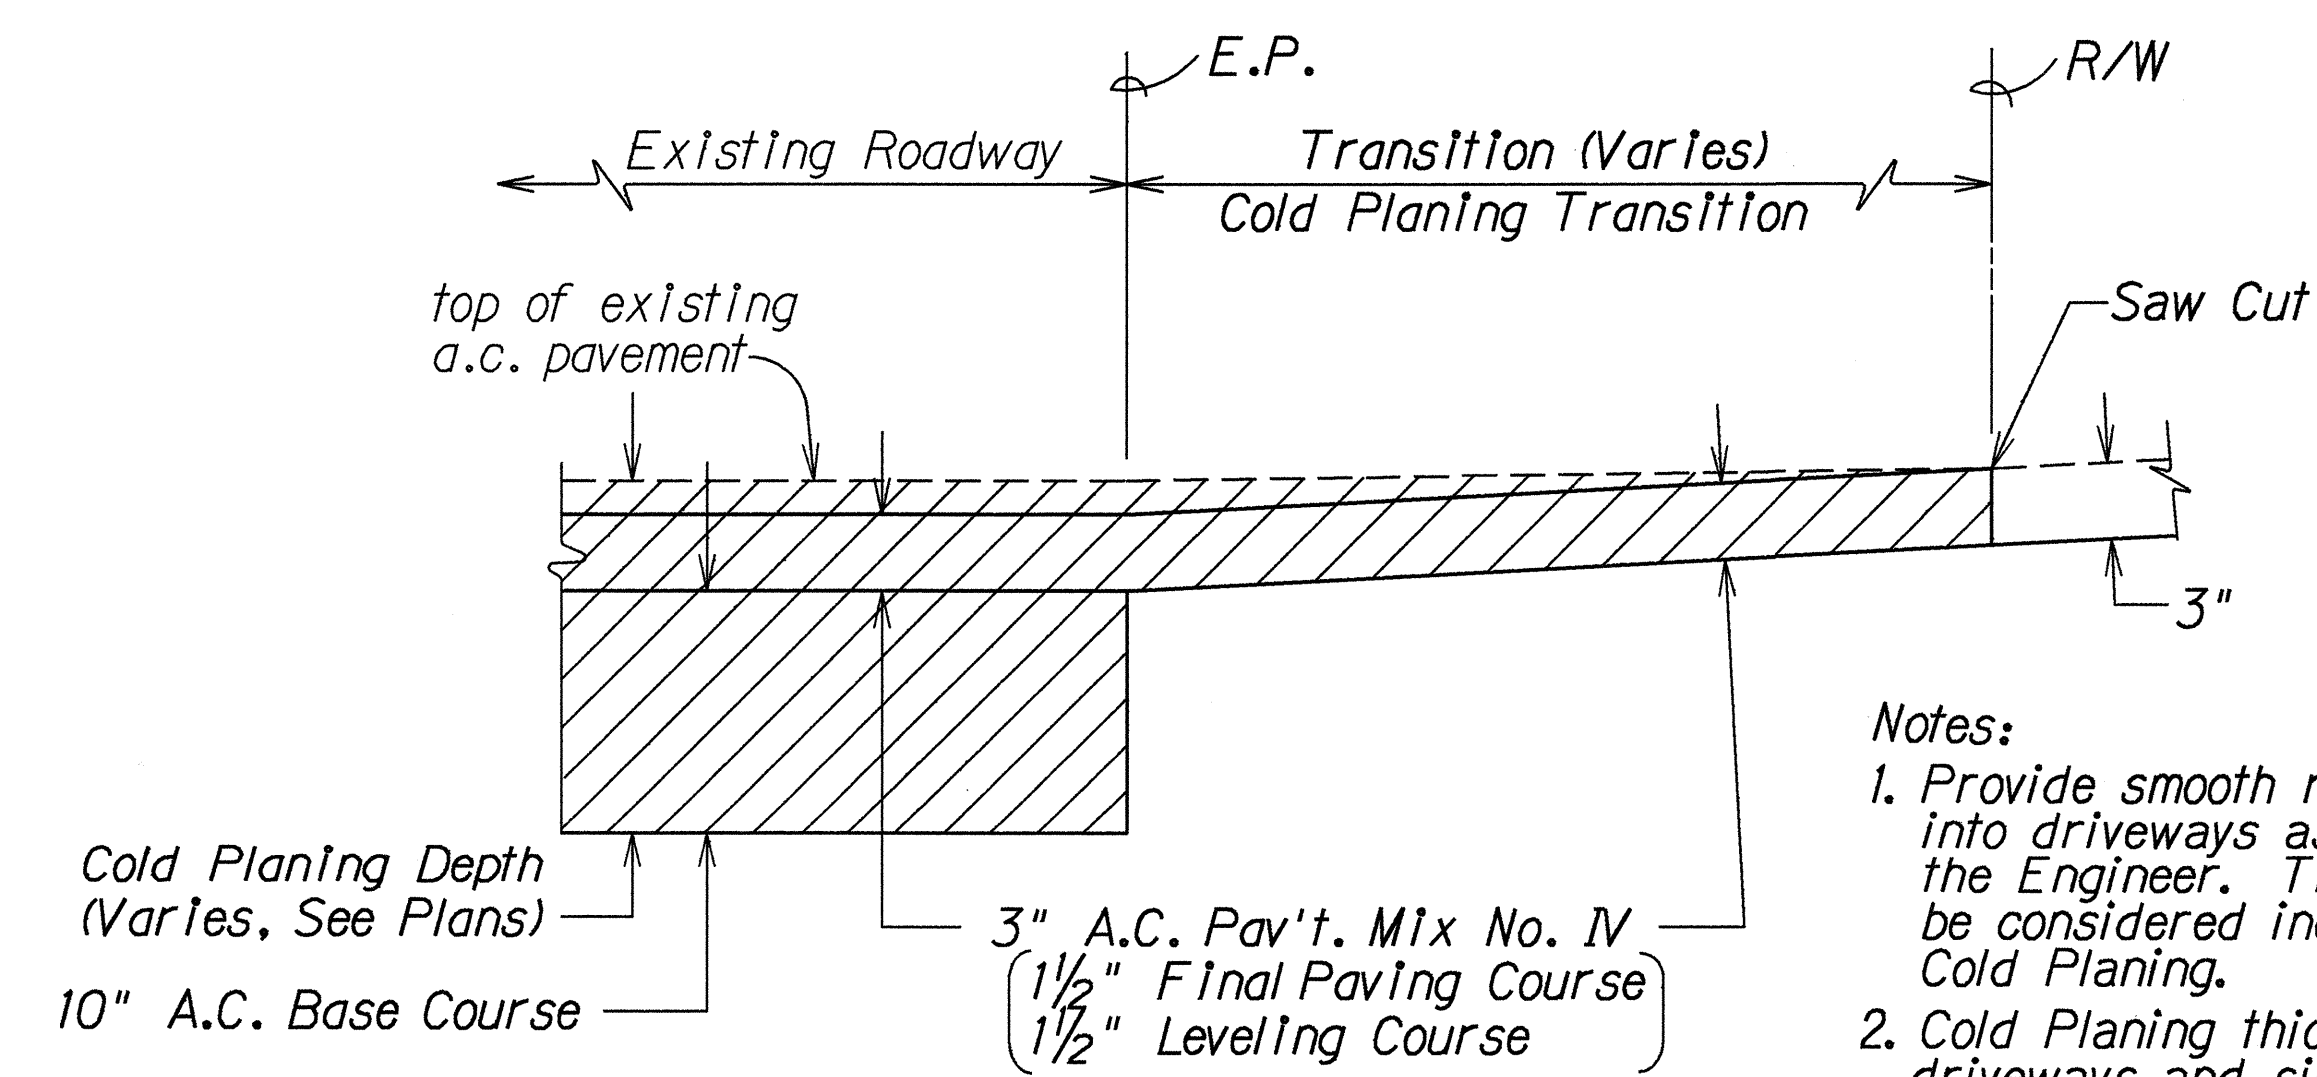

SIDE STREETS AND DRIVEWAY COLD PLANING AND RESURFACING DETAIL
Not to Scale

- Notes:
1. Provide smooth riding transition into driveways as directed by the Engineer. This work shall be considered incidental to Cold Planing.
 2. Cold Planing thickness for driveways and side streets shall be 3" unless otherwise noted on the plans.

7-11-95	Revise Cold Planing Transition per Addendum No. 1
DATE	REVISION
STATE OF HAWAII DEPARTMENT OF TRANSPORTATION HIGHWAYS DIVISION	
MISCELLANEOUS SECTIONS	
KAMEHAMEHA HIGHWAY RESURFACING Vicinity of Honomanu St. to Halawai Dr. Fed. Aid Project No. STP-099-1(15)	
Scale: As Shown	Date: June, 1995
SHEET No. 3 OF 3 SHEETS	

DESIGNED BY	DATE
DRAWN BY	7-11-95
CHECKED BY	
NOTED BY	
QUANTITIES BY	
REVISIONS	