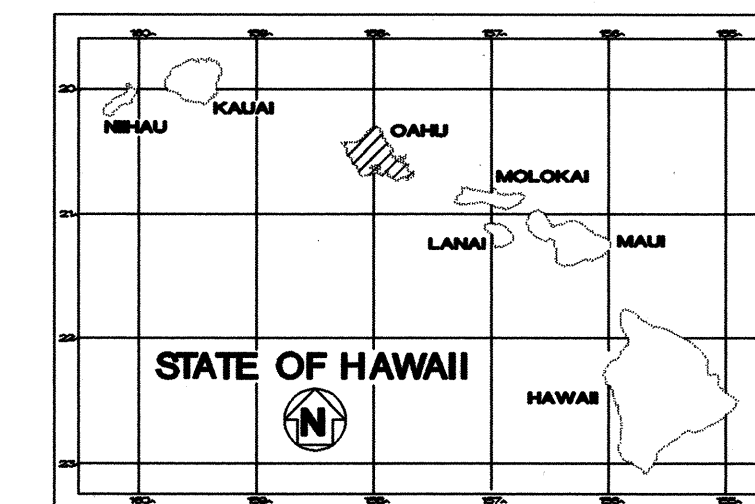
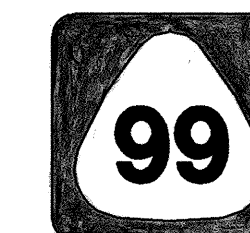


[illegible]

STATE OF HAWAII

DEPARTMENT OF TRANSPORTATION

HIGHWAYS DIVISION

HONOLULU, HAWAII

"AS-BUILT"


PLANS FOR

KAMEHAMEHA HIGHWAY

INSTALLATION OF HIGHWAY LIGHTS

KIPAPA STREET TO WAIKALANI DRIVE

PROJECT NO. NH-099-1(16)

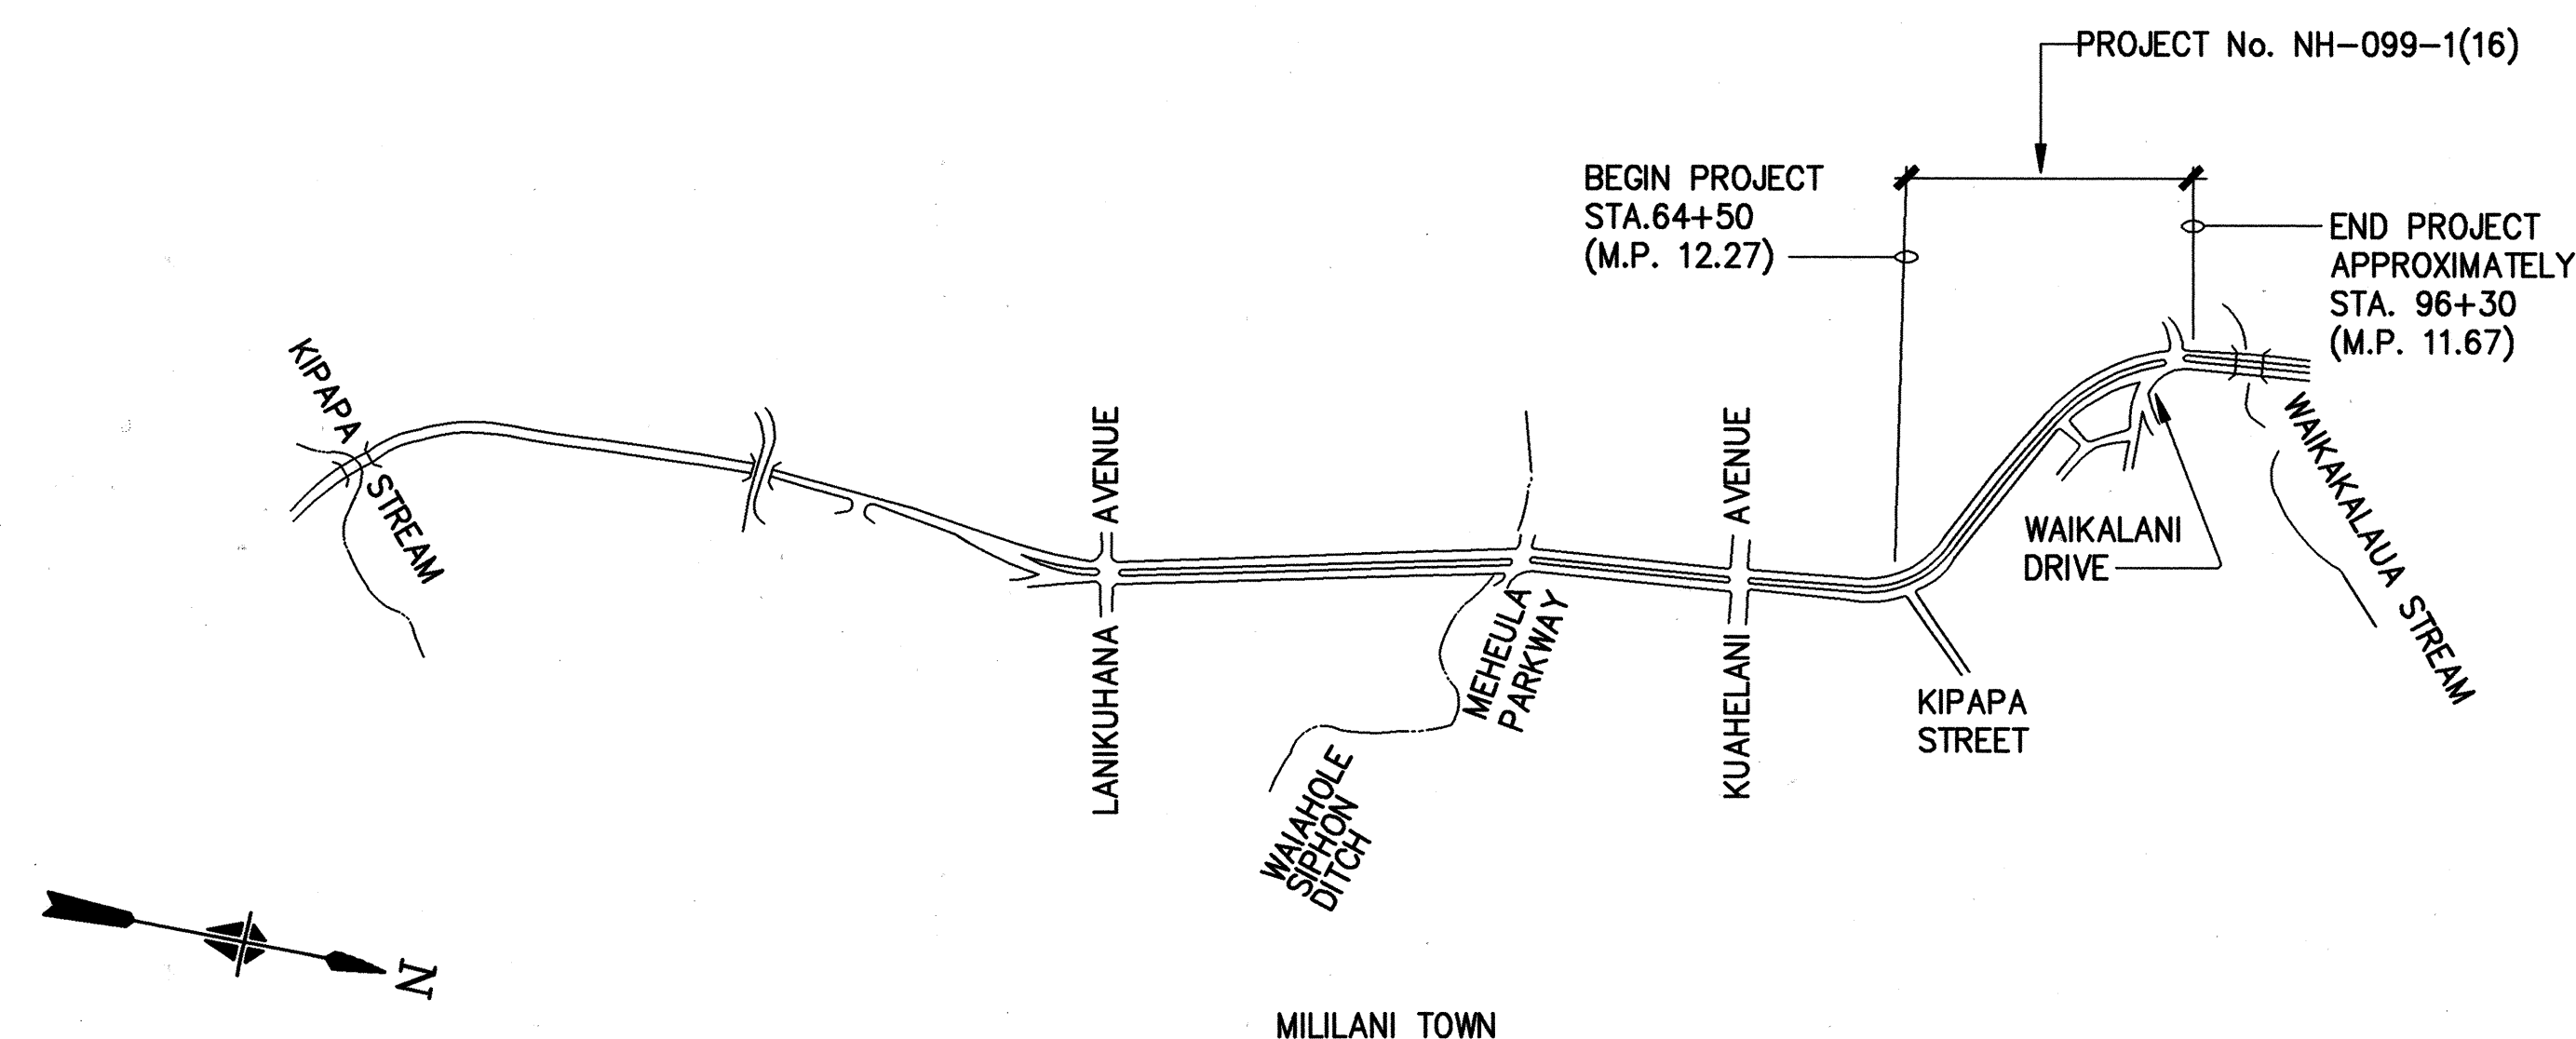DISTRICT OF EWA  
ISLAND OF OAHU

## LOCATION MAP

(LENGTH OF PROJECT: APPROX. 0.6 MILES)

## FEDERAL AID PROJECTS PREVIOUSLY CONSTRUCTED OR UNDER CONSTRUCTION

MILE POST 12.27 TO MILE POST 11.67

CHANGES MADE DURING CONSTRUCTION HAVE BEEN INCORPORATED ON THESE PLANS EXCEPT CHANGES IN THE ORIGINAL THEORETICAL QUANTITIES. FOR ACTUAL QUANTITIES, REFER TO PROJECT LEDGER AND / OR MEASUREMENT BOOK.

RESIDENT ENGINEER

DATE \_\_\_\_\_

# DEPARTMENT OF TRANSPORTATION STATE OF HAWAII

APPROVED: \_\_\_\_\_

Approved: *Ann Harris, h. l.* 11/16/90

DIV. OF TRANSPORTATION DATE

**SHEET No. 1 OF 12 SHEETS**

---