




FED. ROAD DIST. NO.	STATE	PROJ. NO.	FISCAL YEAR	SHEET NO.	TOTAL SHEETS
HAWAII	HAW.	99D-01-96	1996	5	11

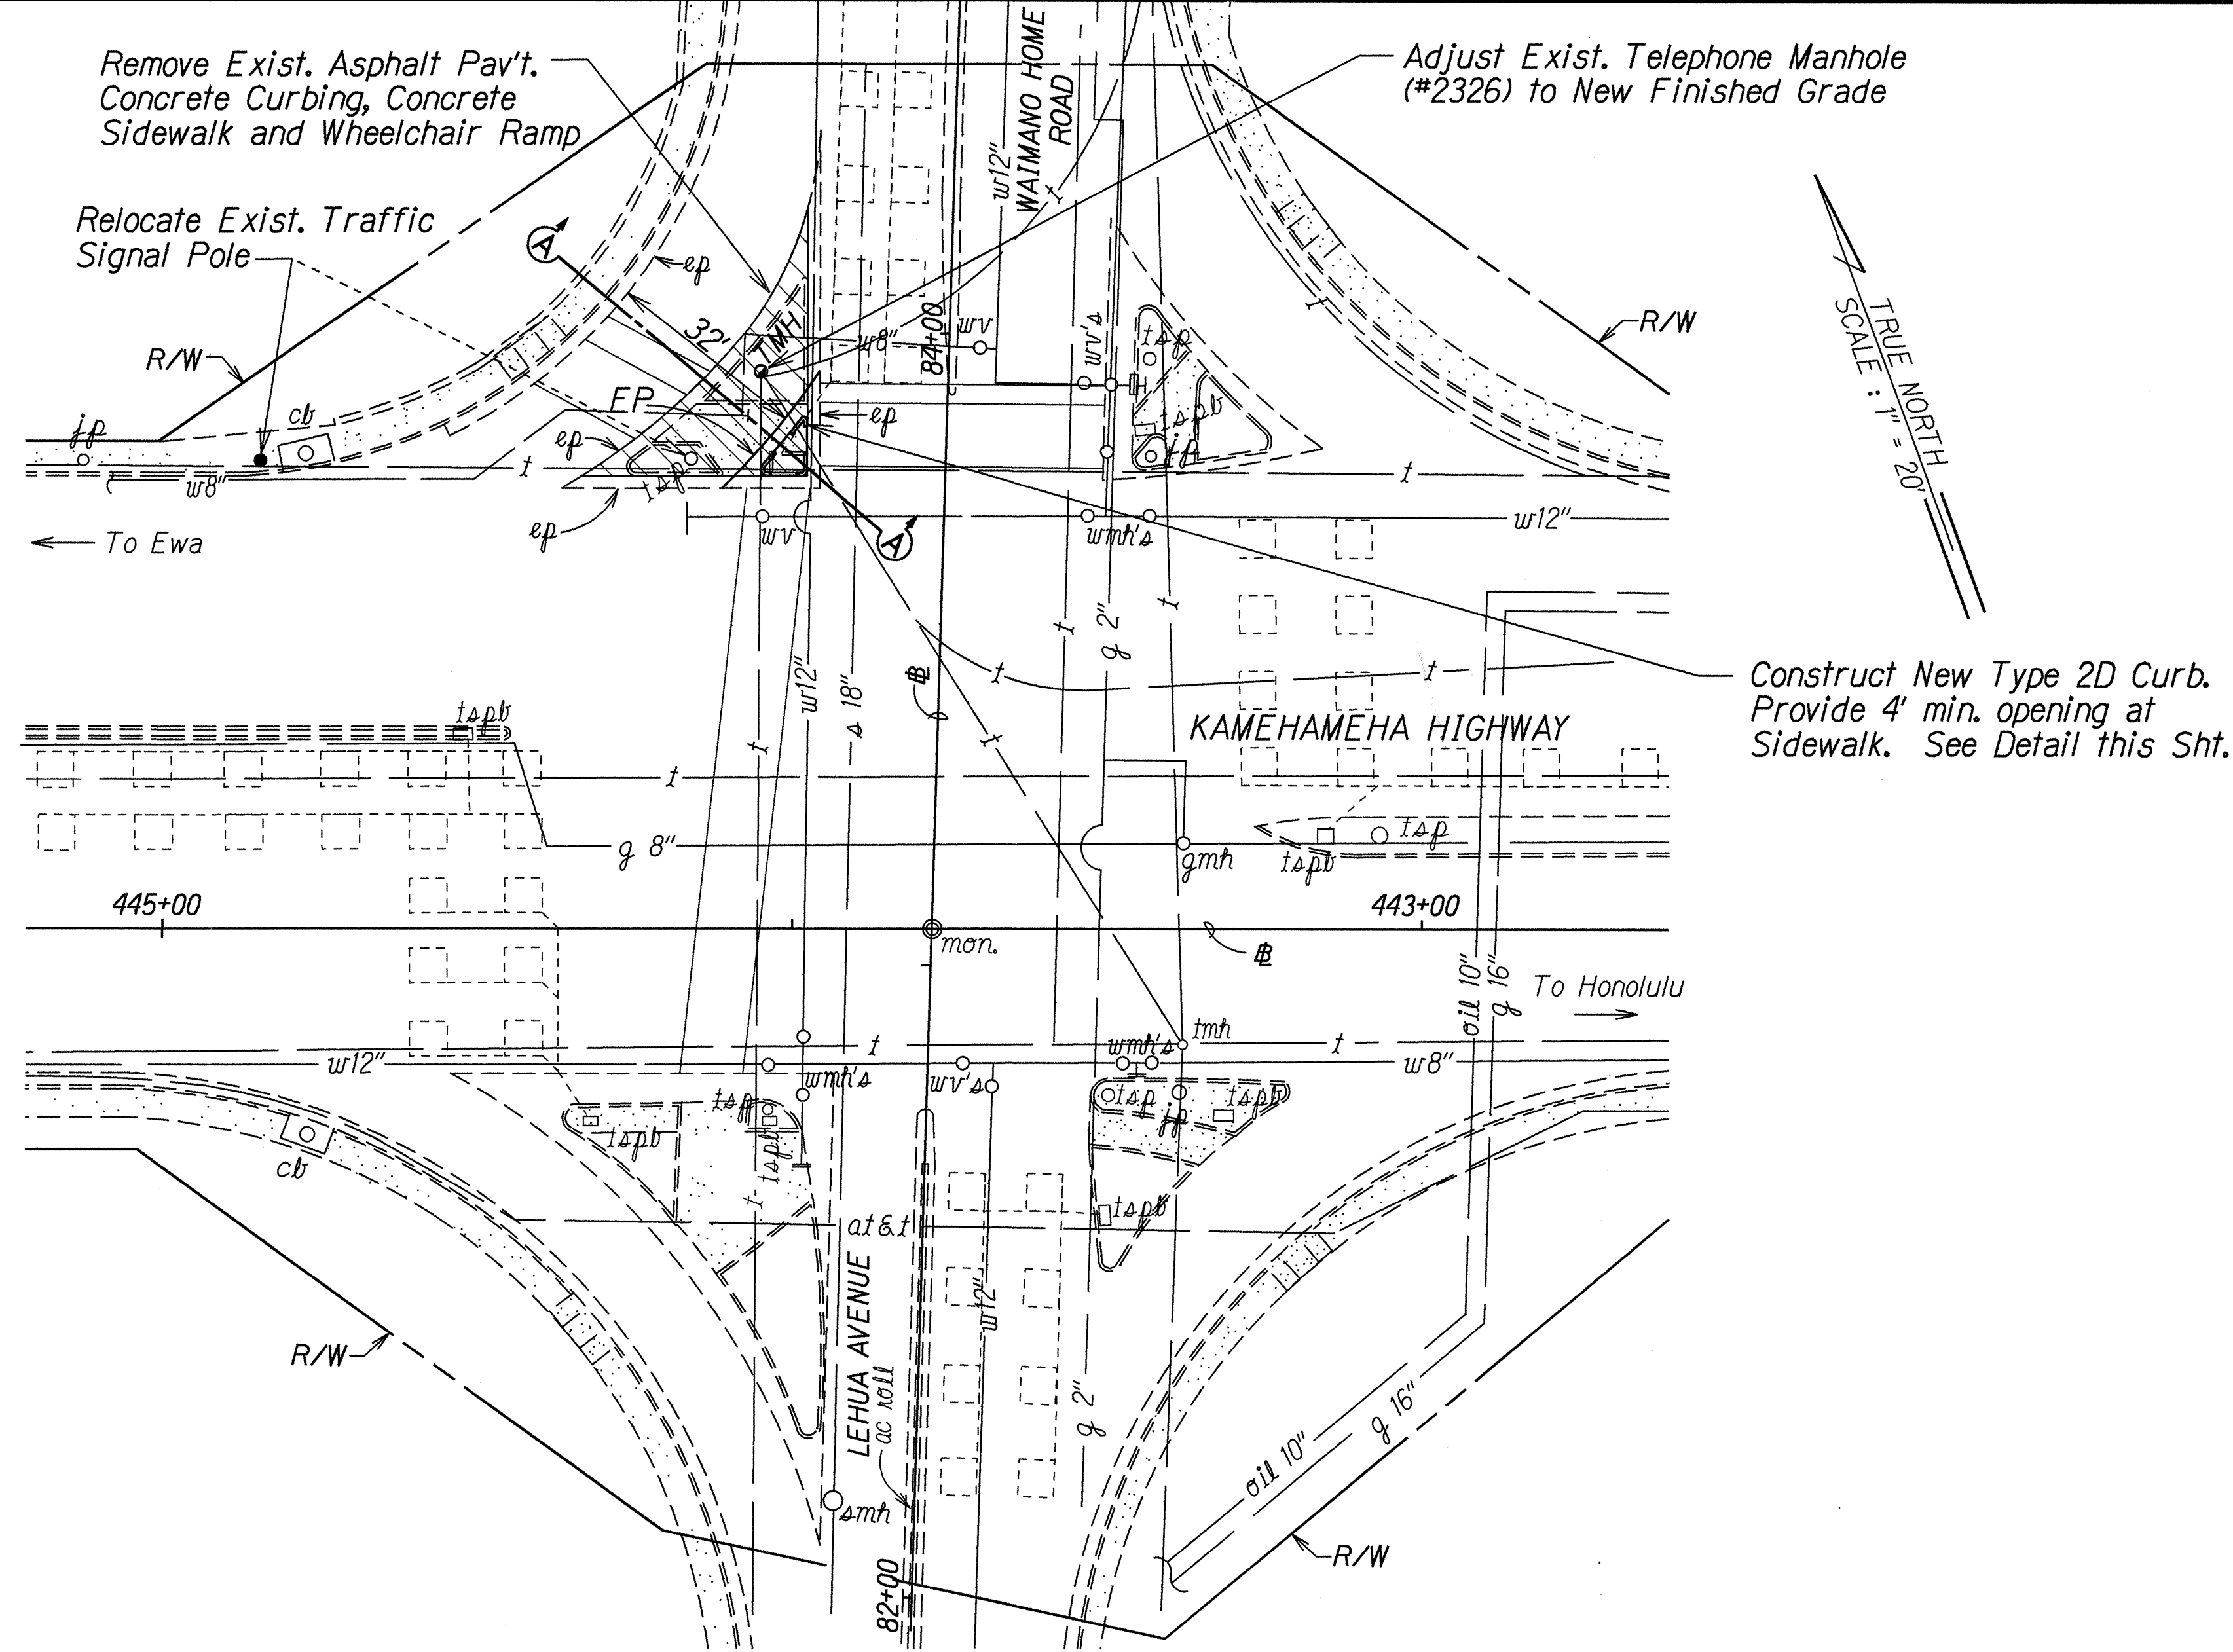


PLAN
Scale: 1" = 20'

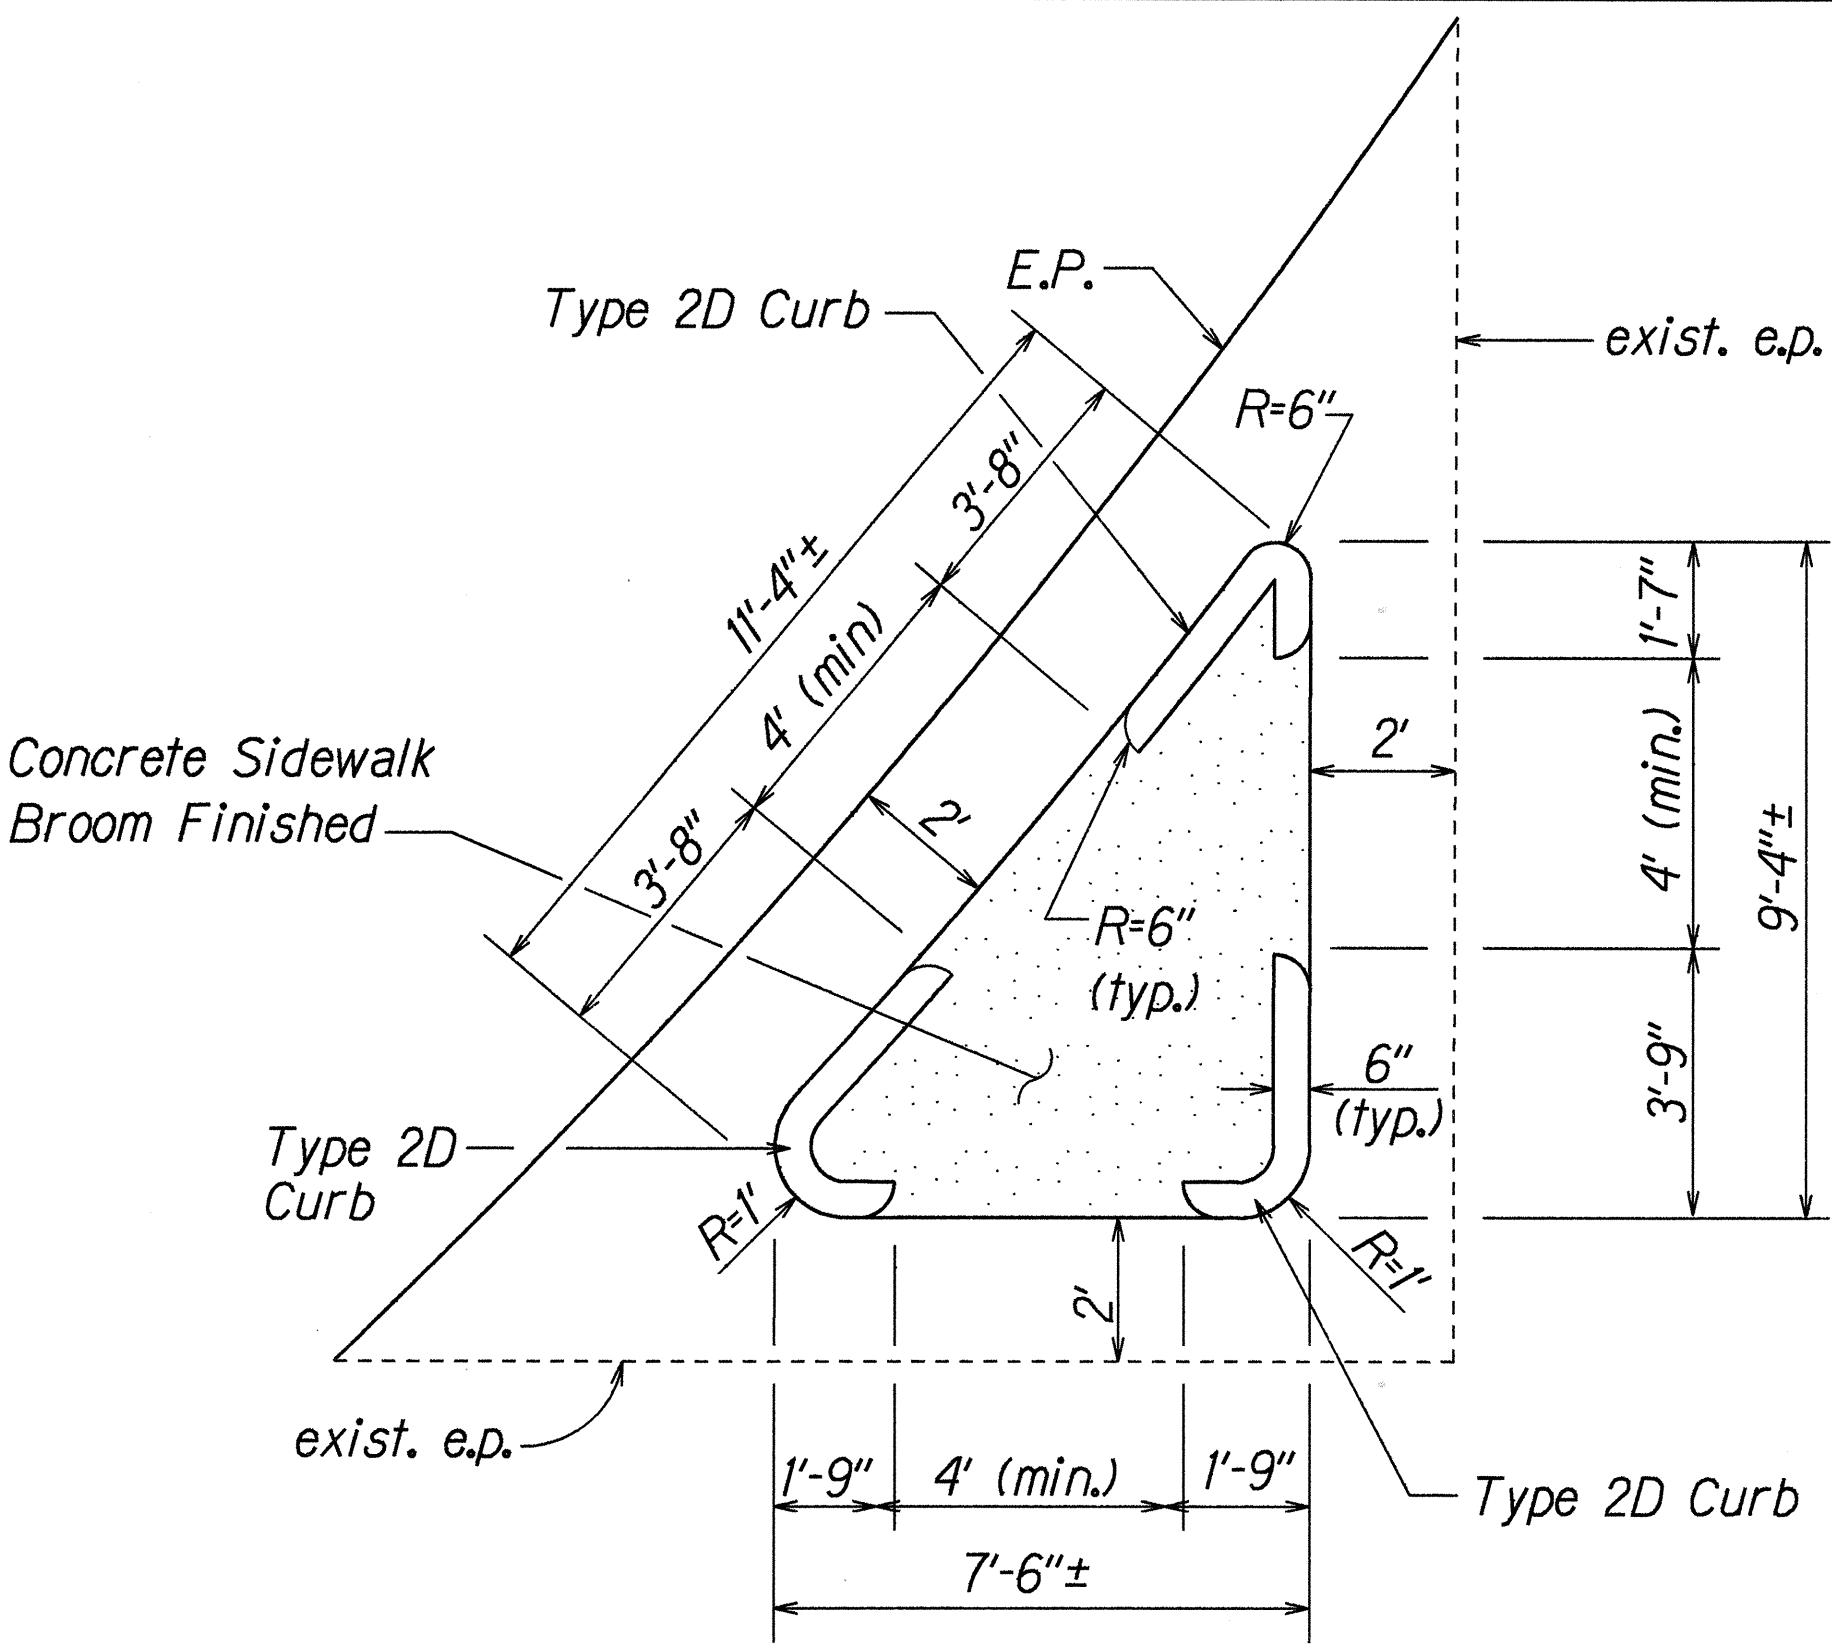

MEDIAN OPENING DETAIL
Scale: 3/8" = 1'-0"

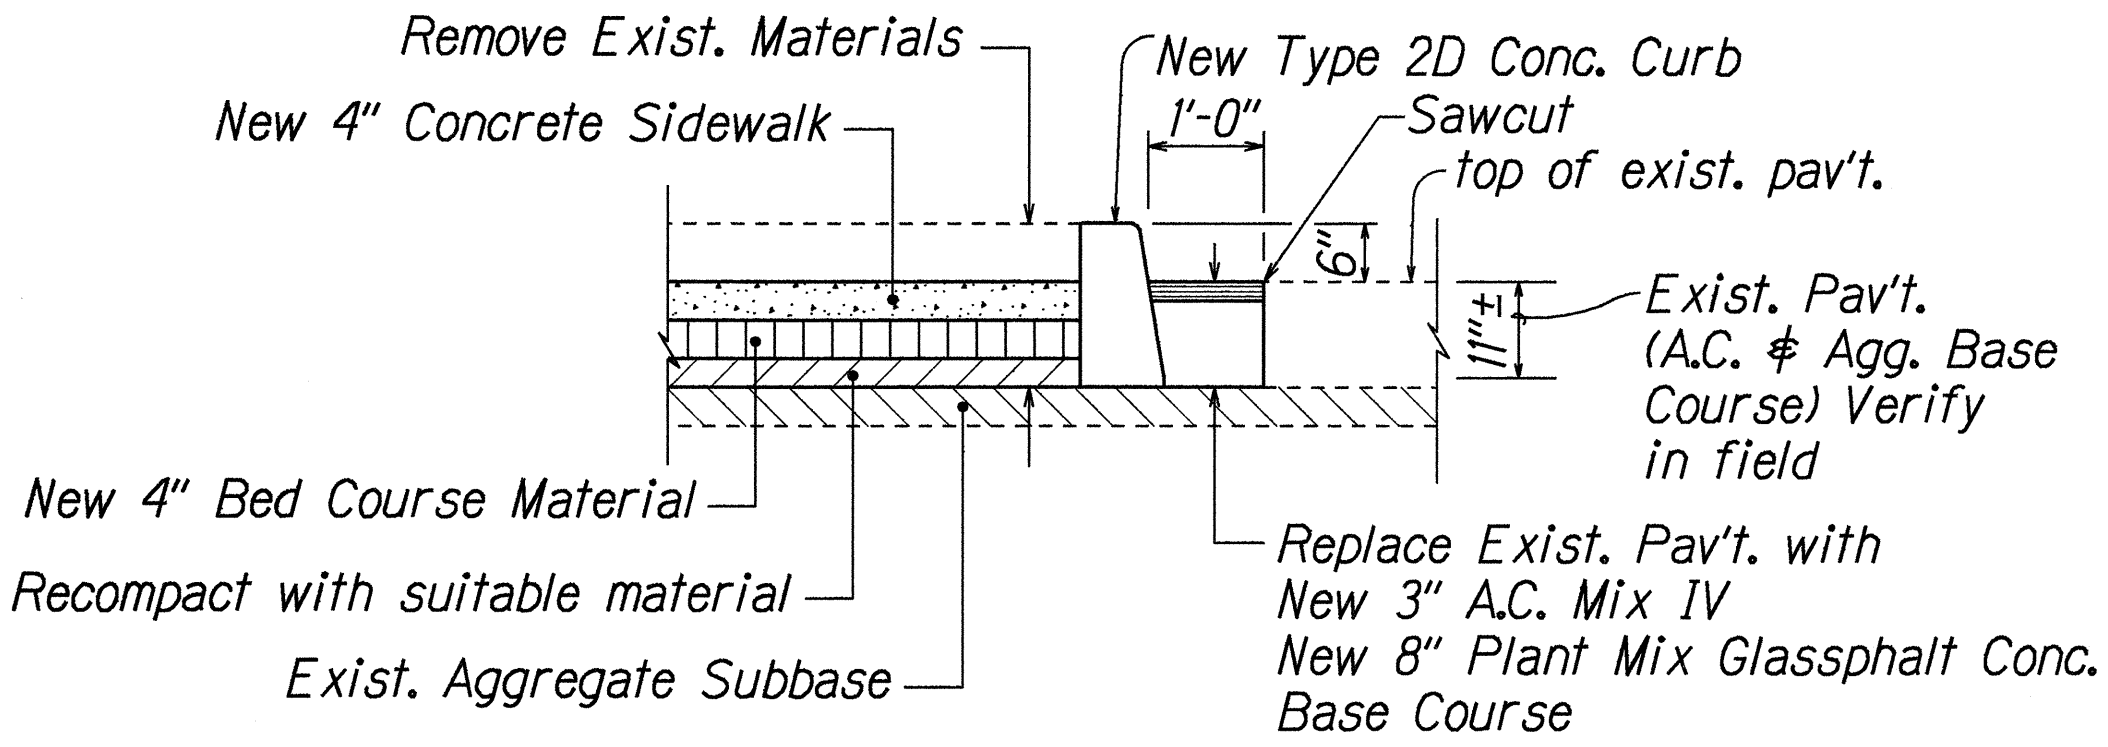

TYPICAL SECTION - MEDIAN OPENING
Not to Scale

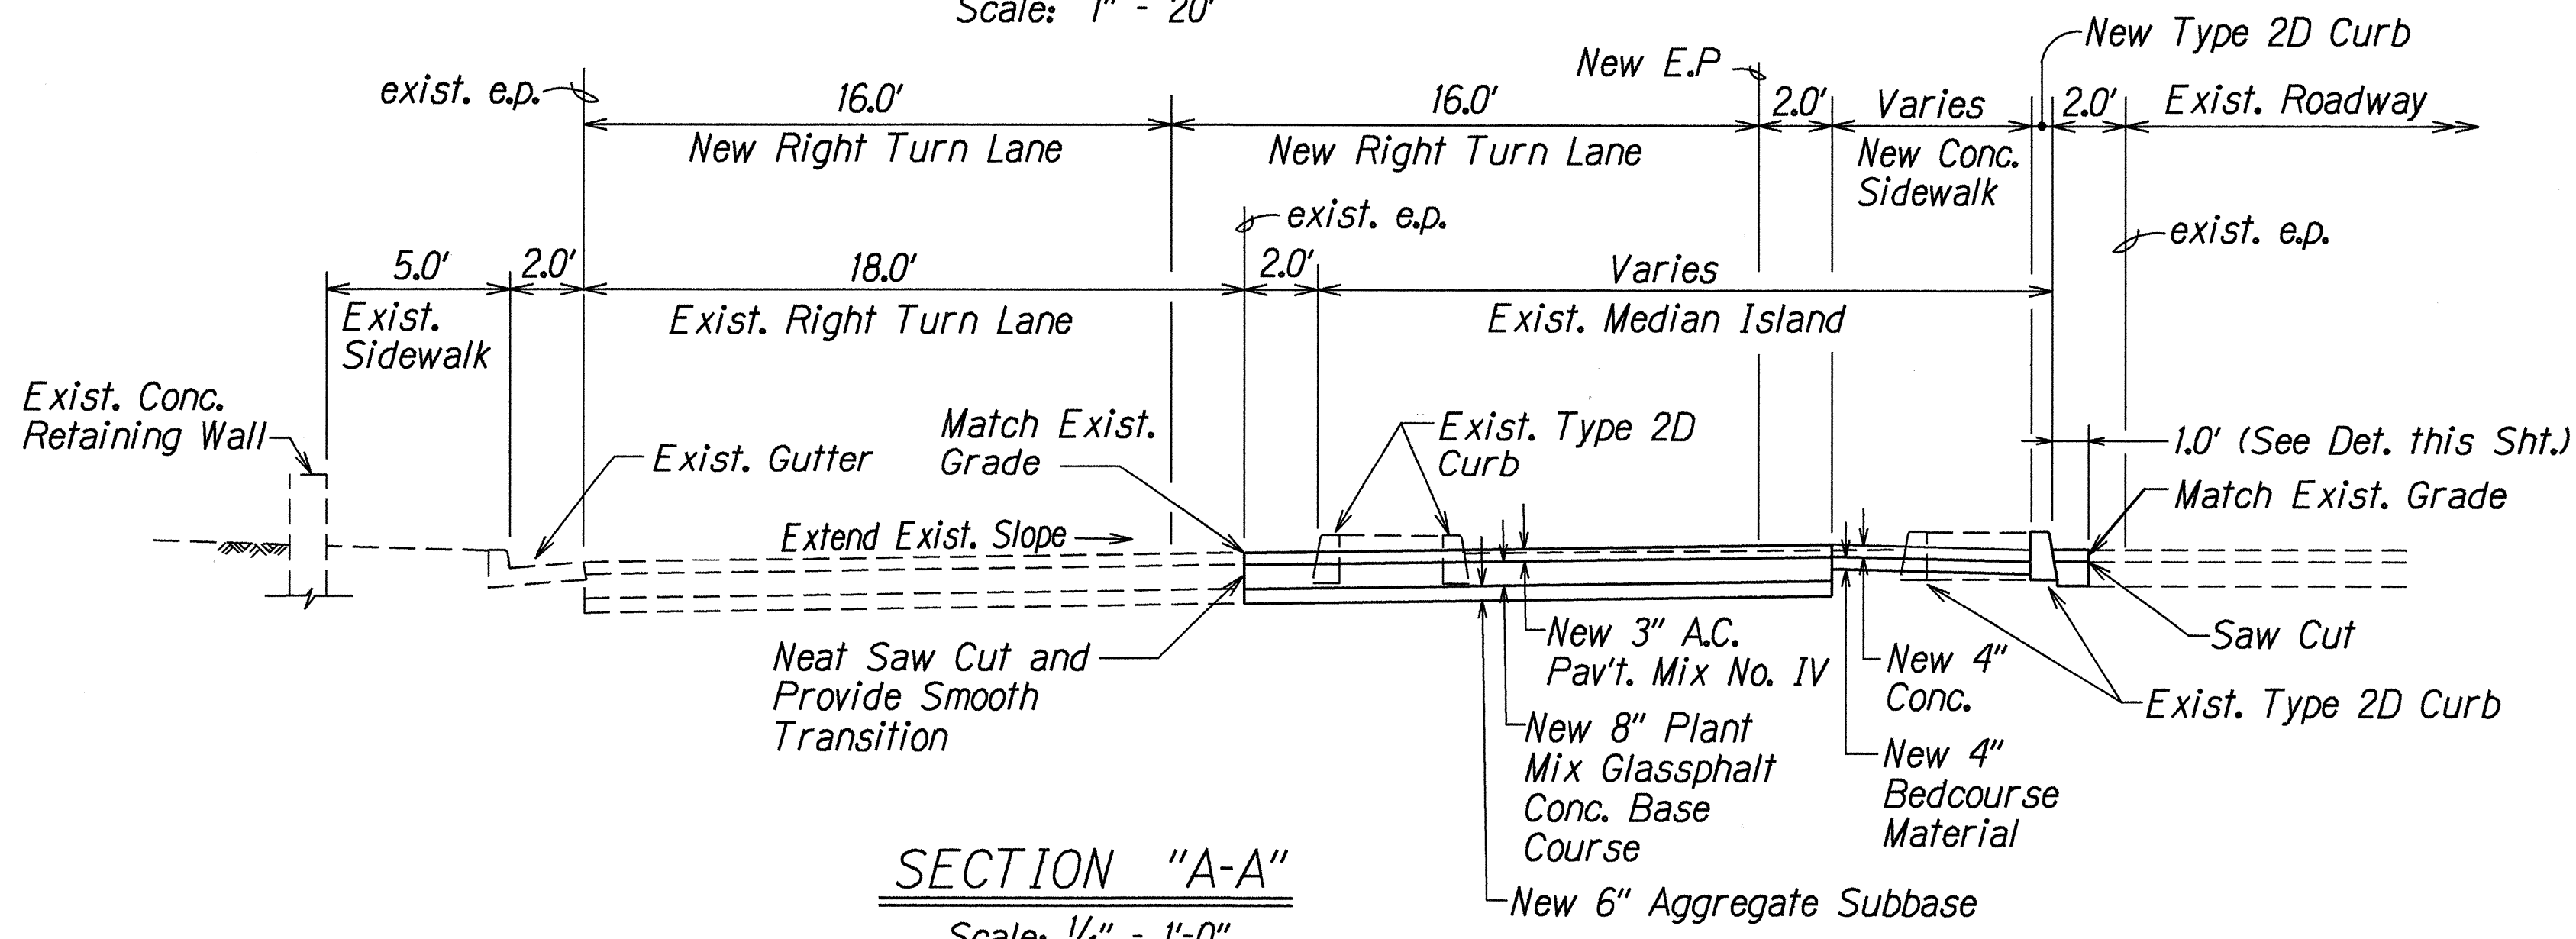

SECTION "A-A"
Scale: 1/4" = 1'-0"

STATE OF HAWAII

DEPARTMENT OF TRANSPORTATION

HIGHWAYS DIVISION

TYPICAL SECTION & PLAN

KAMEHAMEHA HIGHWAY

INTERSECTION IMPROVEMENTS

AT WAIMANO HOME ROAD

Project No. 99D-01-96

Scale: As Noted Date: Mar., 1996

SHEET No. 1 OF 1 SHEETS

SURVEY PLOTTED BY	DATE
DRAWN BY	2/10/96
DESIGNED BY	
QUANTITIES BY	
CHECKED BY	