
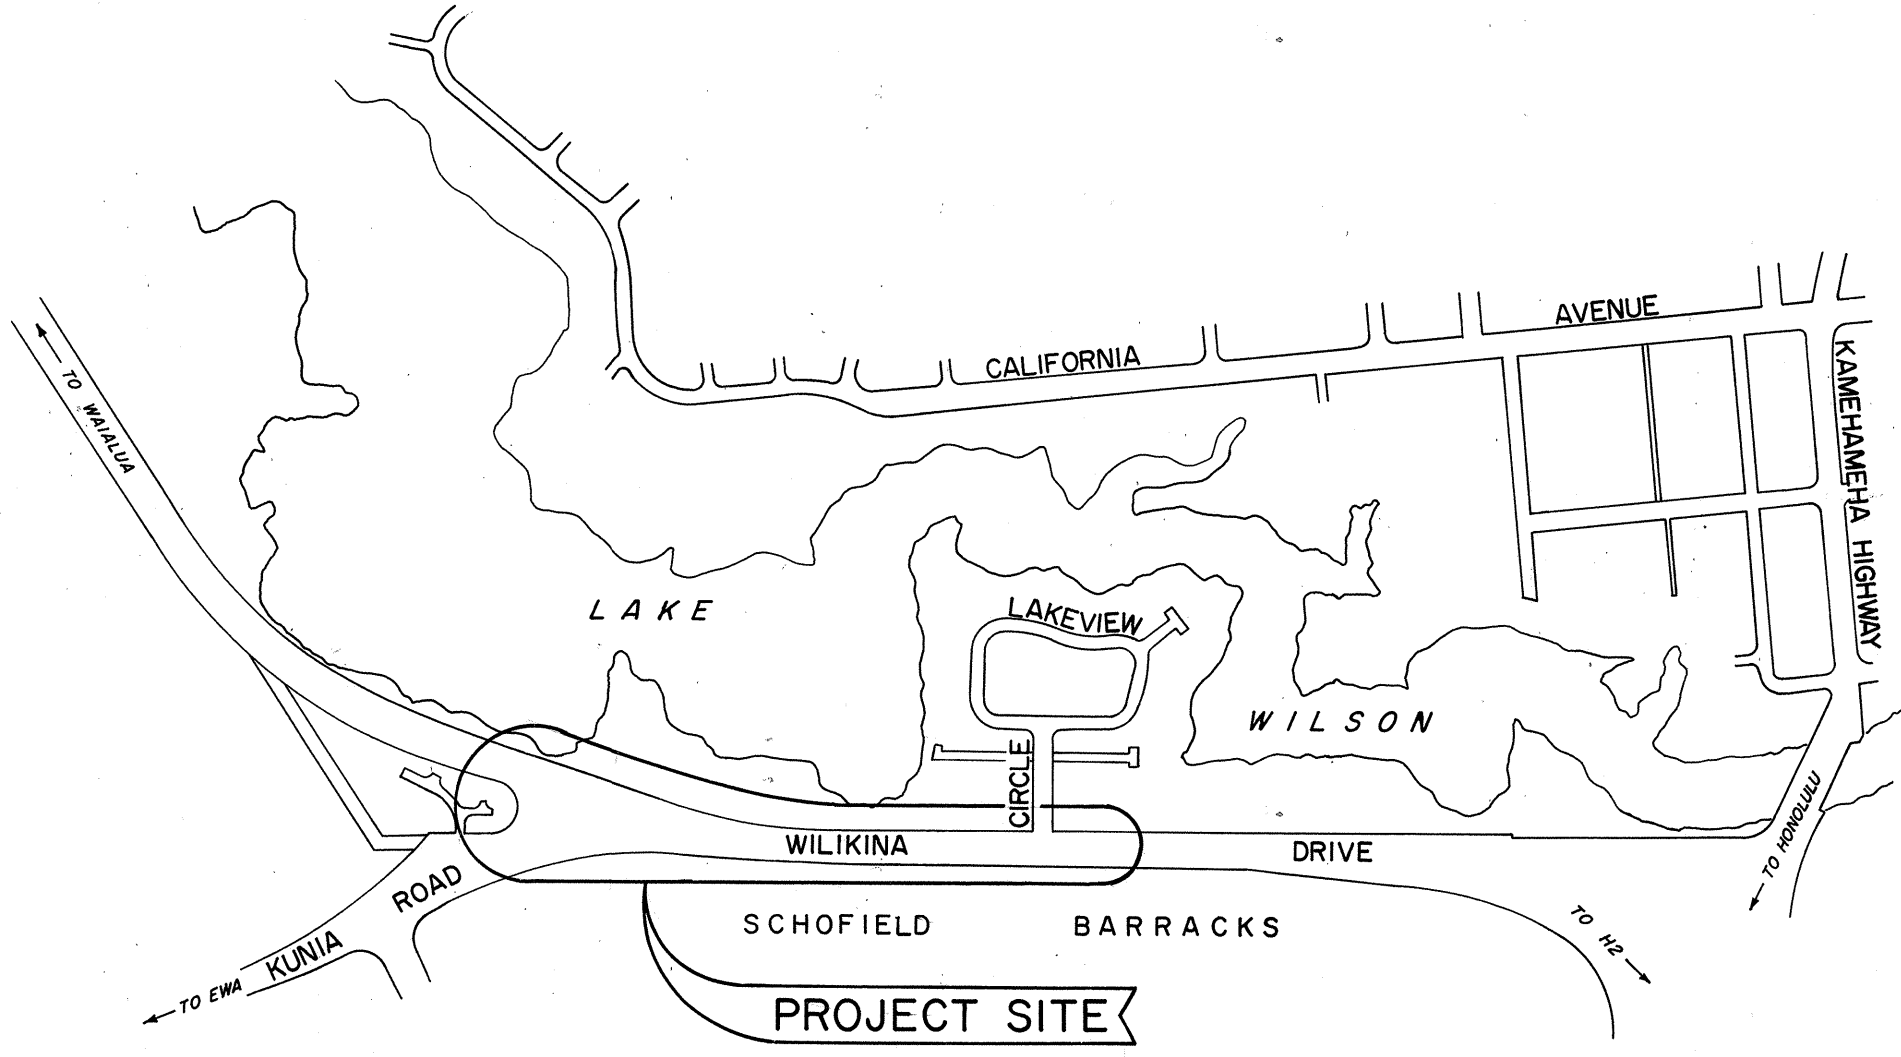
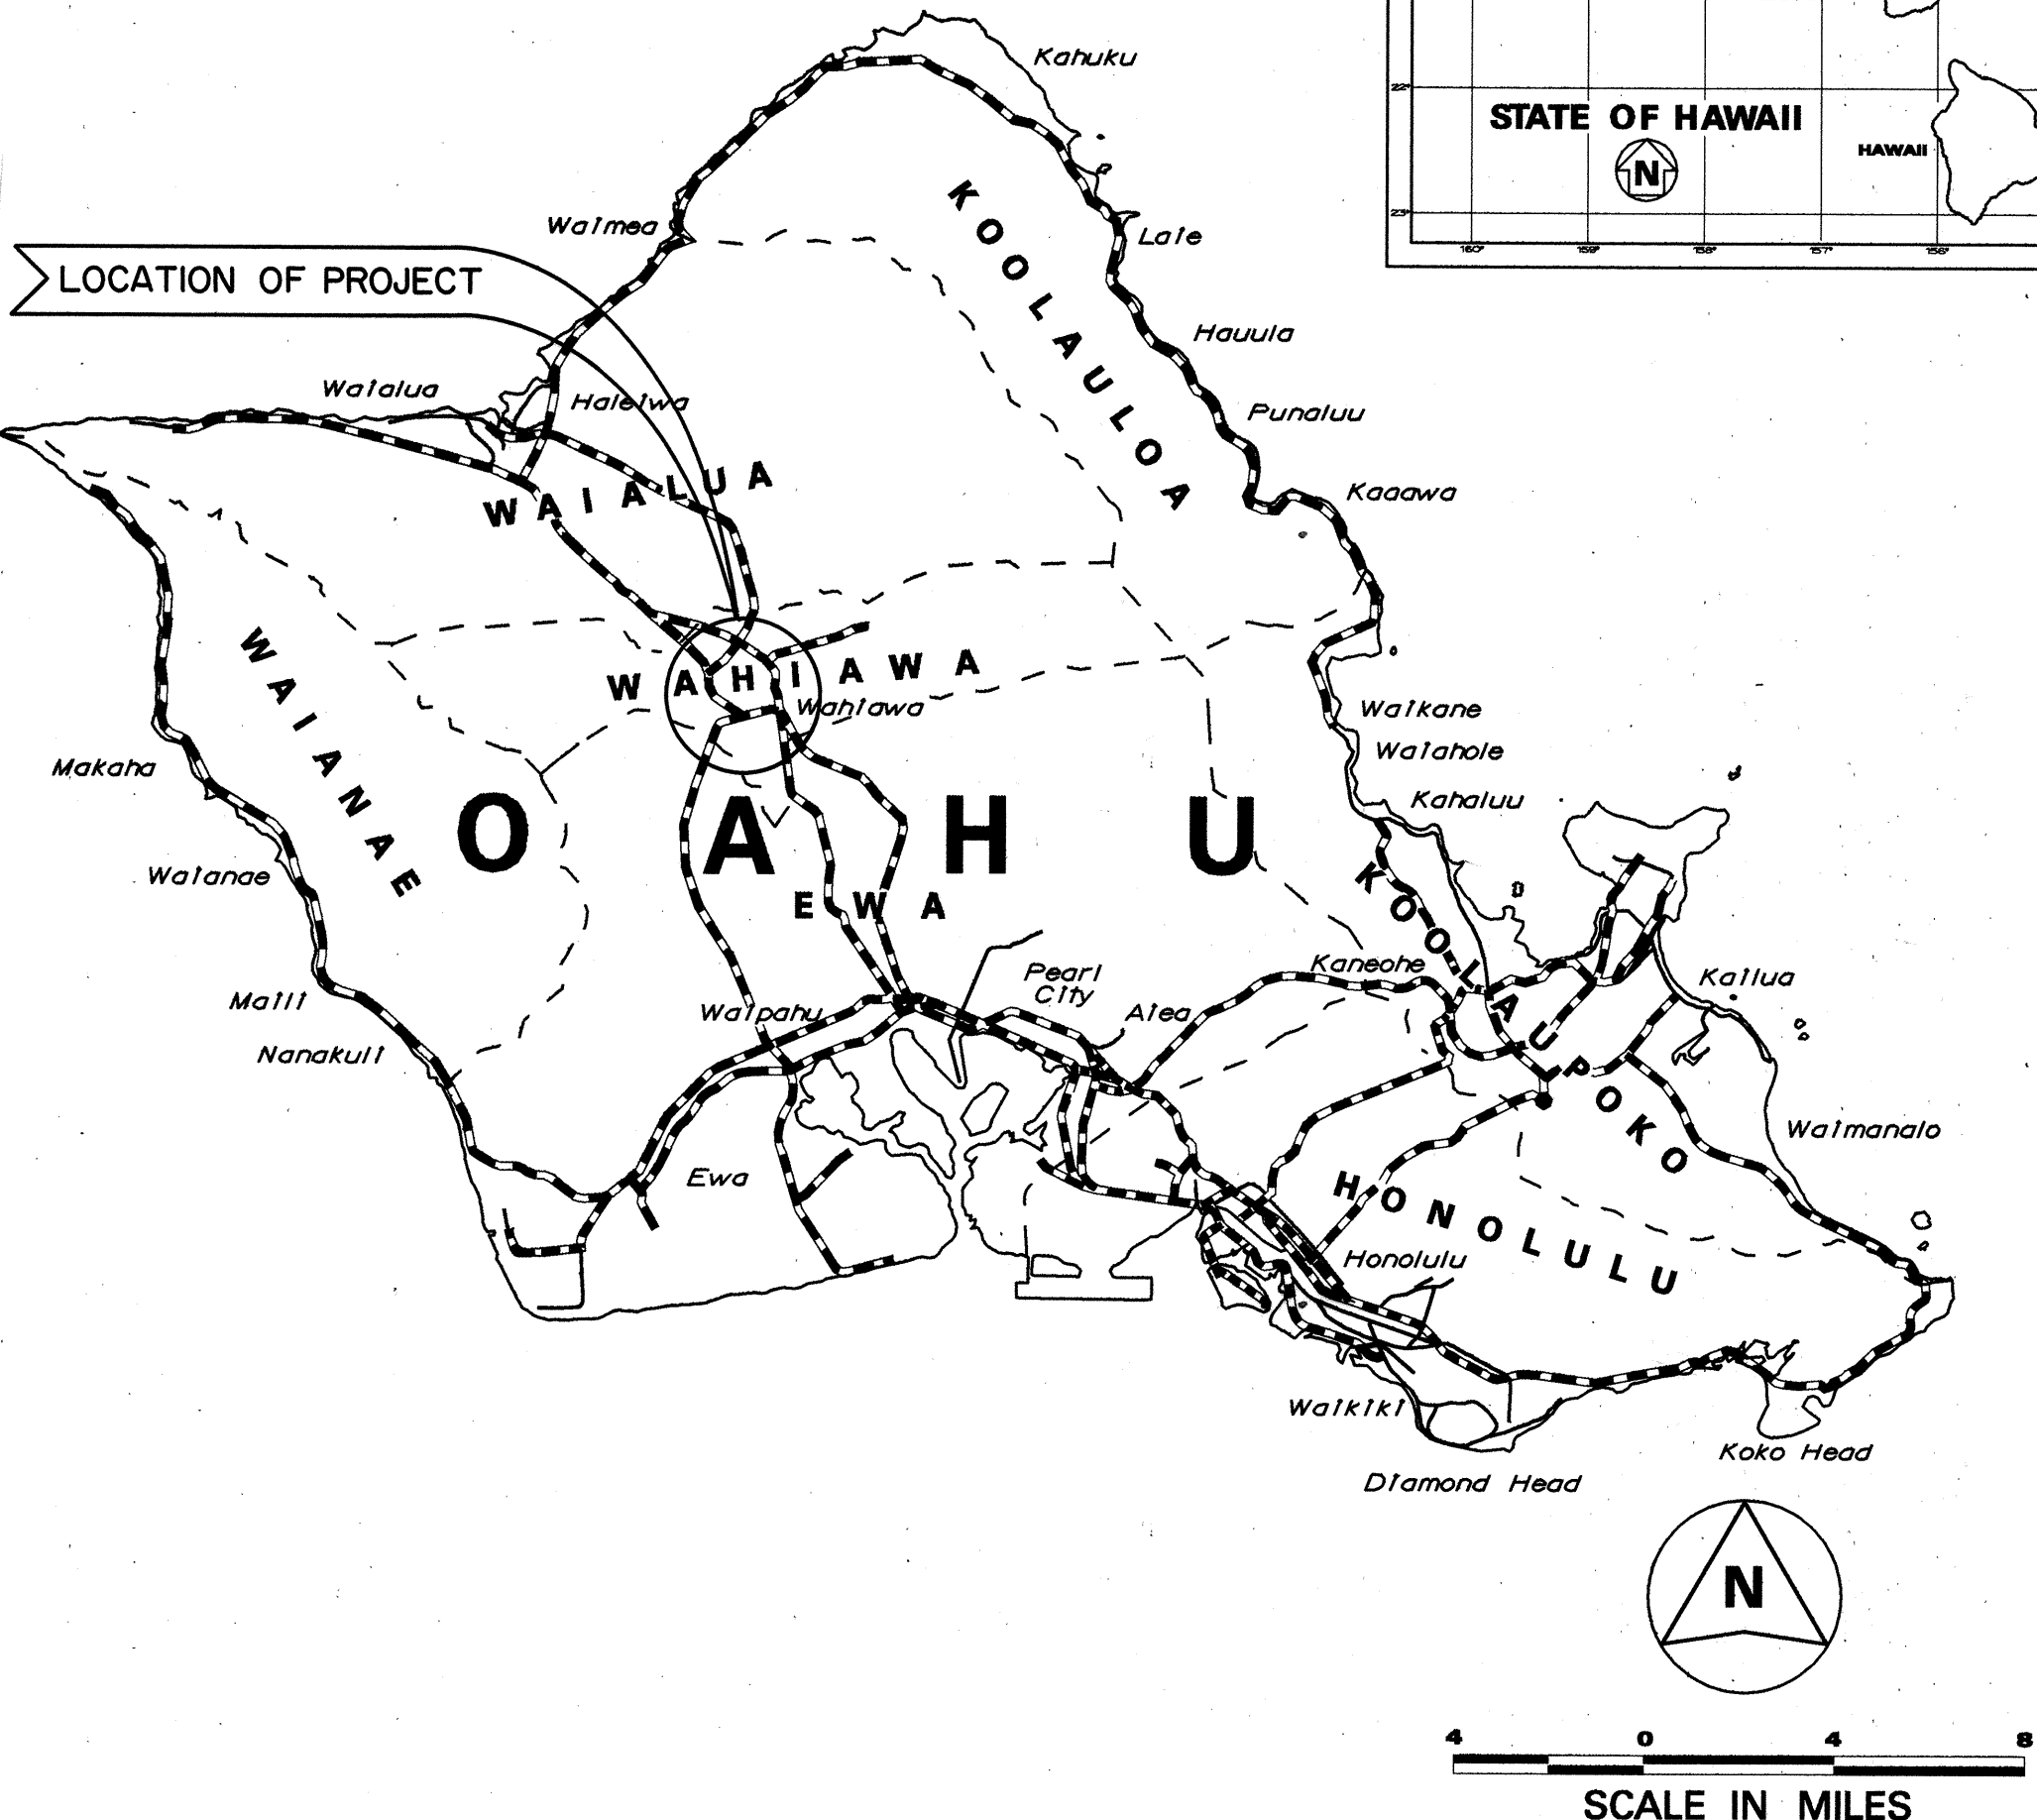


INDEX TO DRAWINGS	
SHEET NO.	DESCRIPTION
1	TITLE SHEET
2	STANDARD PLANS SUMMARY
3-4	NOTES
5	TRAFFIC SIGNAL PLAN
6	WILIKINA DRIVE TRAFFIC SIGNAL MODERNIZATION AT KUNIA ROAD
7	PLAN-OVERHEAD INTERCONNECTION CABLE
8	PLAN-INTERSECTION IMPROVEMENTS
9	MARKING, STRIPING, AND SIGNING PLAN
10-11	DETAILS
12	LOOP DETECTOR DETAILS
13	SWING SIGN BRACKET DETAILS

STATE OF HAWAII
DEPARTMENT OF TRANSPORTATION
HIGHWAYS DIVISION
HONOLULU, HAWAII
"AS-BUILT"
PLANS FOR
WILIKINA DRIVE
TRAFFIC SIGNALS AT LAKEVIEW CIRCLE
FEDERAL AID PROJECT NO. STP-099-1(17)
DISTRICT OF WAHIAWA
ISLAND OF OAHU

FED. ROAD DIST. NO.	STATE	FED. AID PROJ. NO.	FISCAL YEAR	SHEET NO.	TOTAL SHEETS
HAWAII	HAW.	STP-099-1(17)	1997	1	13

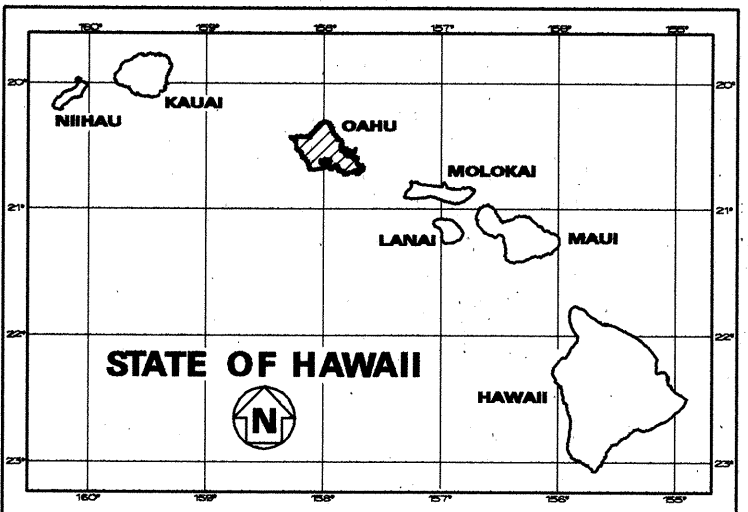

CHANGES MADE DURING CONSTRUCTION HAVE BEEN INCORPORATED ON THESE PLANS EXCEPT CHANGES IN THE ORIGINAL THEORETICAL QUANTITIES. FOR ACTUAL QUANTITIES, REFER TO PROJECT LEDGER AND/OR COMPUTATION BOOK.

Robert Shi 2-28-02
RESIDENT ENGINEER DATE

LAYOUT PLAN
TMK: 7-3-01

DEPARTMENT OF TRANSPORTATION
STATE OF HAWAII
APPROVED:
Raymond S. Uyehara 2/26/97
DIR. OF TRANSPORTATION DATE

SHIMABUKURO, ENDO & YOSHIZAKI, INC.
1126 12TH AVE., HONOLULU, HI.
DESIGNED BY
P.S. & E. BY
KARL KUNISHIGE
587-2173
PHONE
JAN. 1997
DATE