INDEX TO DRAWINGS	
SHEET NO.	DESCRIPTION
1	TITLE SHEET
2	STANDARD PLANS SUMMARY
3	GENERAL NOTES
4 – 6	EXISTING BRIDGE OVERPASS DETAILS
	FOR INFORMATION ONLY
·	

STATE OF HAWAII

## DEPARTMENT OF TRANSPORTATION

HIGHWAYS DIVISION
HONOLULU, HAWAII


\*\*AS-BUILT\*\*

PLANS FOR


## KAMEHAMEHA HIGHWAY

REPAINT STEEL GIRDERS AND LUBRICATE BEARINGS
ON WAIPAHU OVERPASS
PROJECT NO. 99C-02-98M

DISTRICT OF EWA ISLAND OF OAHU

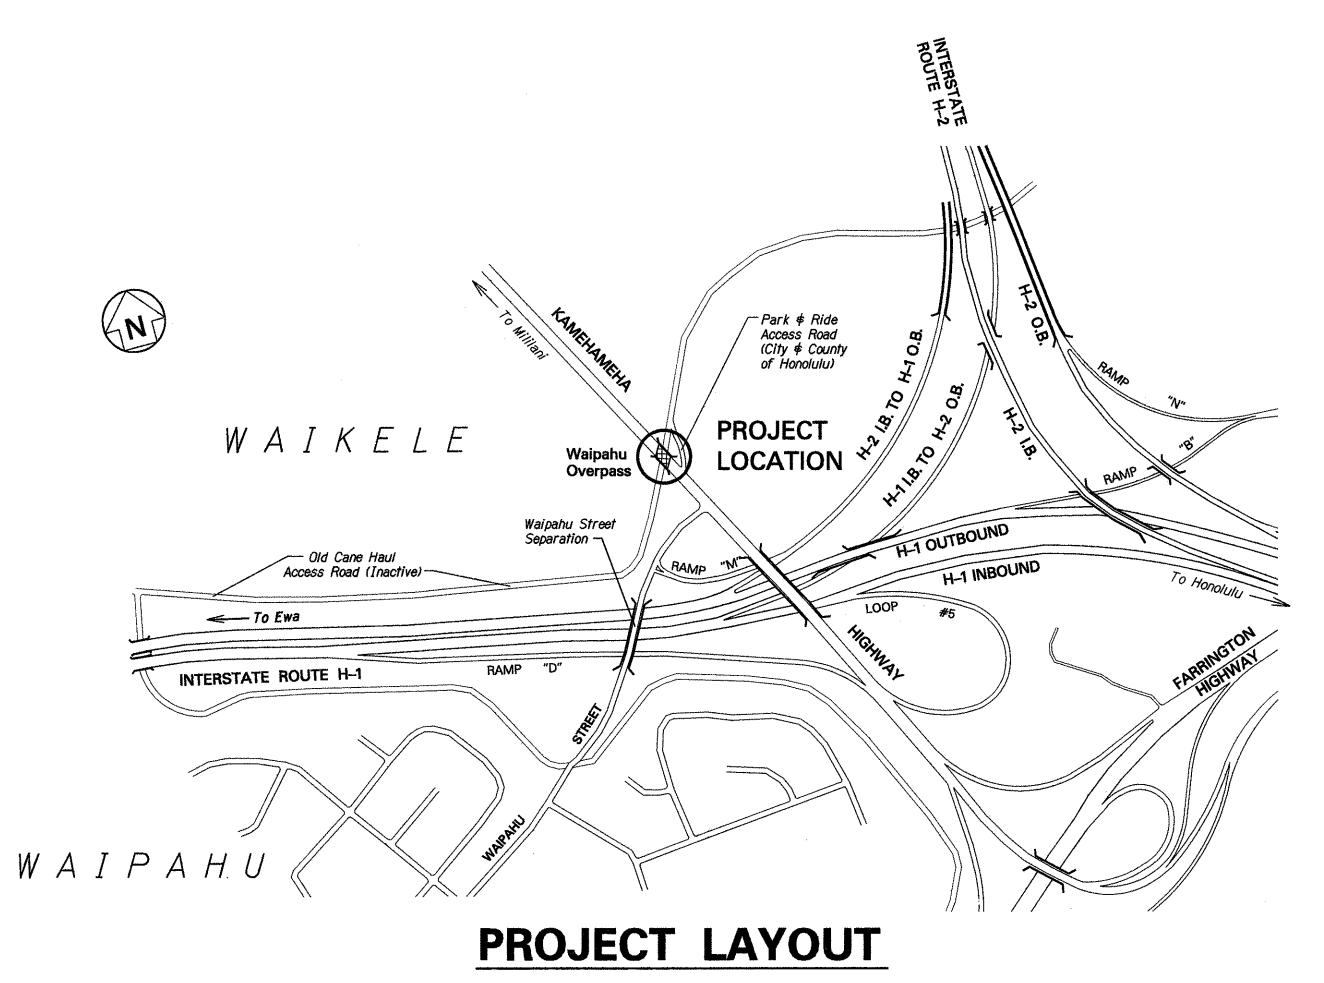

SCALE IN HUNDRED FEET

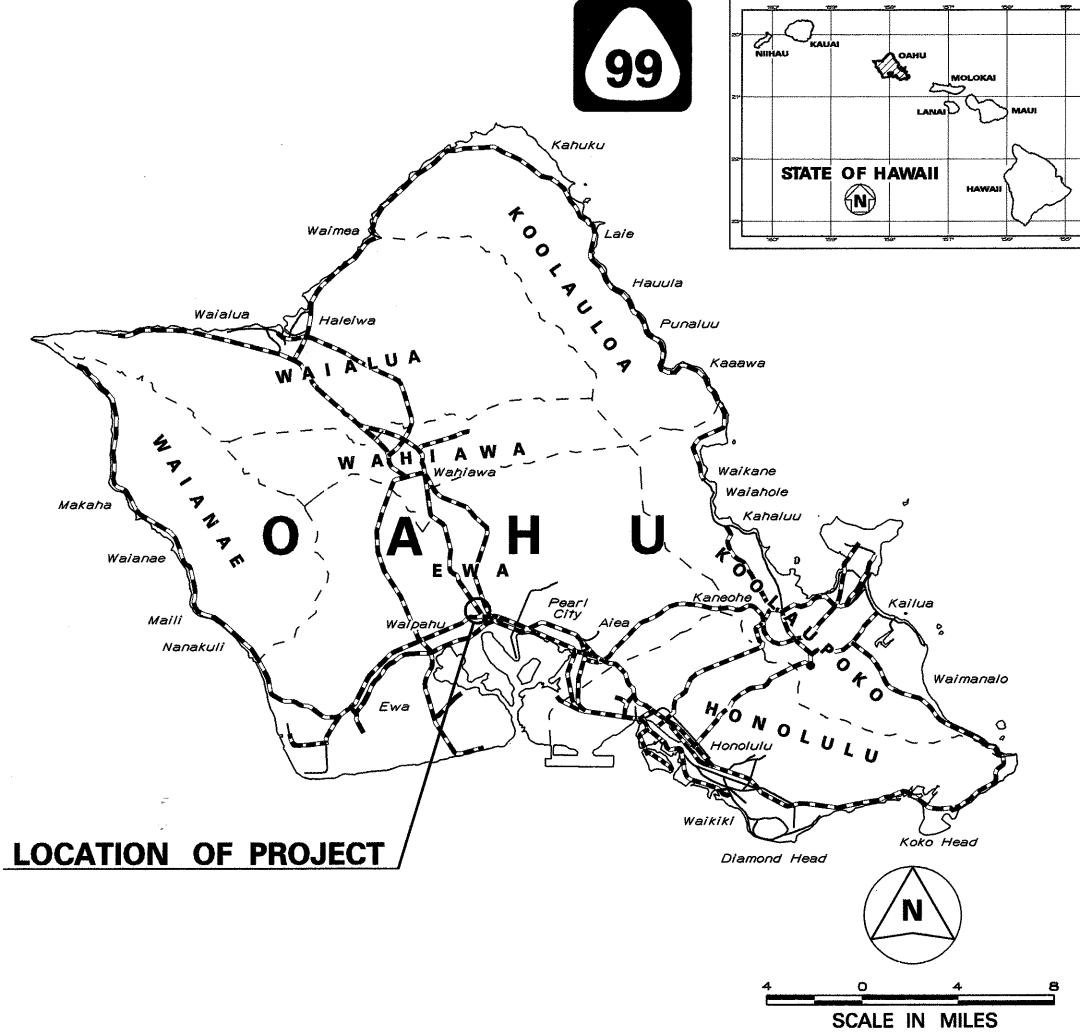

----- FEDERAL AID PROJECTS PREVIOUSLY CONSTRUCTED OR UNDER CONSTRUCTION

MILE POST 16.79

NO SIGNIFICANT CHANGES WERE MADE DURING CONSTRUCTION ON THESE PLANS EXCEPT CHANGES IN THE ORIGINAL THEORETICAL QUANTITIES. FOR ACTUAL QUANTITIES, REFER TO PROJECT LEDGER AND/OR COMPUTATION BOOK.

AND/OR COMPUTATION BOOK.

Kelvin Ukazawa 8-10-99

ACTING RESIDENT ENGINEER DATE

DEPARTMENT OF TRANSPORTATION STATE OF HAWAII

APPROVED:

Pura Mairi

DIR. OF TRANSPORTATION

DATE

FISCAL YEAR

PROJ. NO.

99C-02-98M

JEFFREY FUJIMOTO 587–2249 JUNE, 1998
P. S. & E. BY PHONE DATE

UNIT "E" JEFFREY
DESIGNED BY P. S. 8