

INDEX TO DRAWINGS	
SHEET NO.	DESCRIPTION
1	TITLE SHEET
2	STANDARD PLANS SUMMARY
3	LAYOUT PLANS, GENERAL NOTES AND LEGEND
4 - 6	ROCKFALL PROTECTION NETTING DETAILS
7	ROADWAY PLAN
8 - 9	CROSS SECTIONS

① ADDED SHEET S6-I TO THIS PROJECT TOTAL SHEET COUNT AFTER "AS-BUILT" POSTING 10 SHEETS.

STATE OF HAWAII

DEPARTMENT OF TRANSPORTATION

HIGHWAYS DIVISION

HONOLULU, HAWAII

"AS-BUILT"

PLANS FOR

KAMEHAMEHA HIGHWAY



ROCKFALL PROTECTION

KIPAPA GULCH TOWARDS MILILANI, PHASE III

PROJECT NO. 99C-01-98

DISTRICT OF EWA

ISLAND OF OAHU

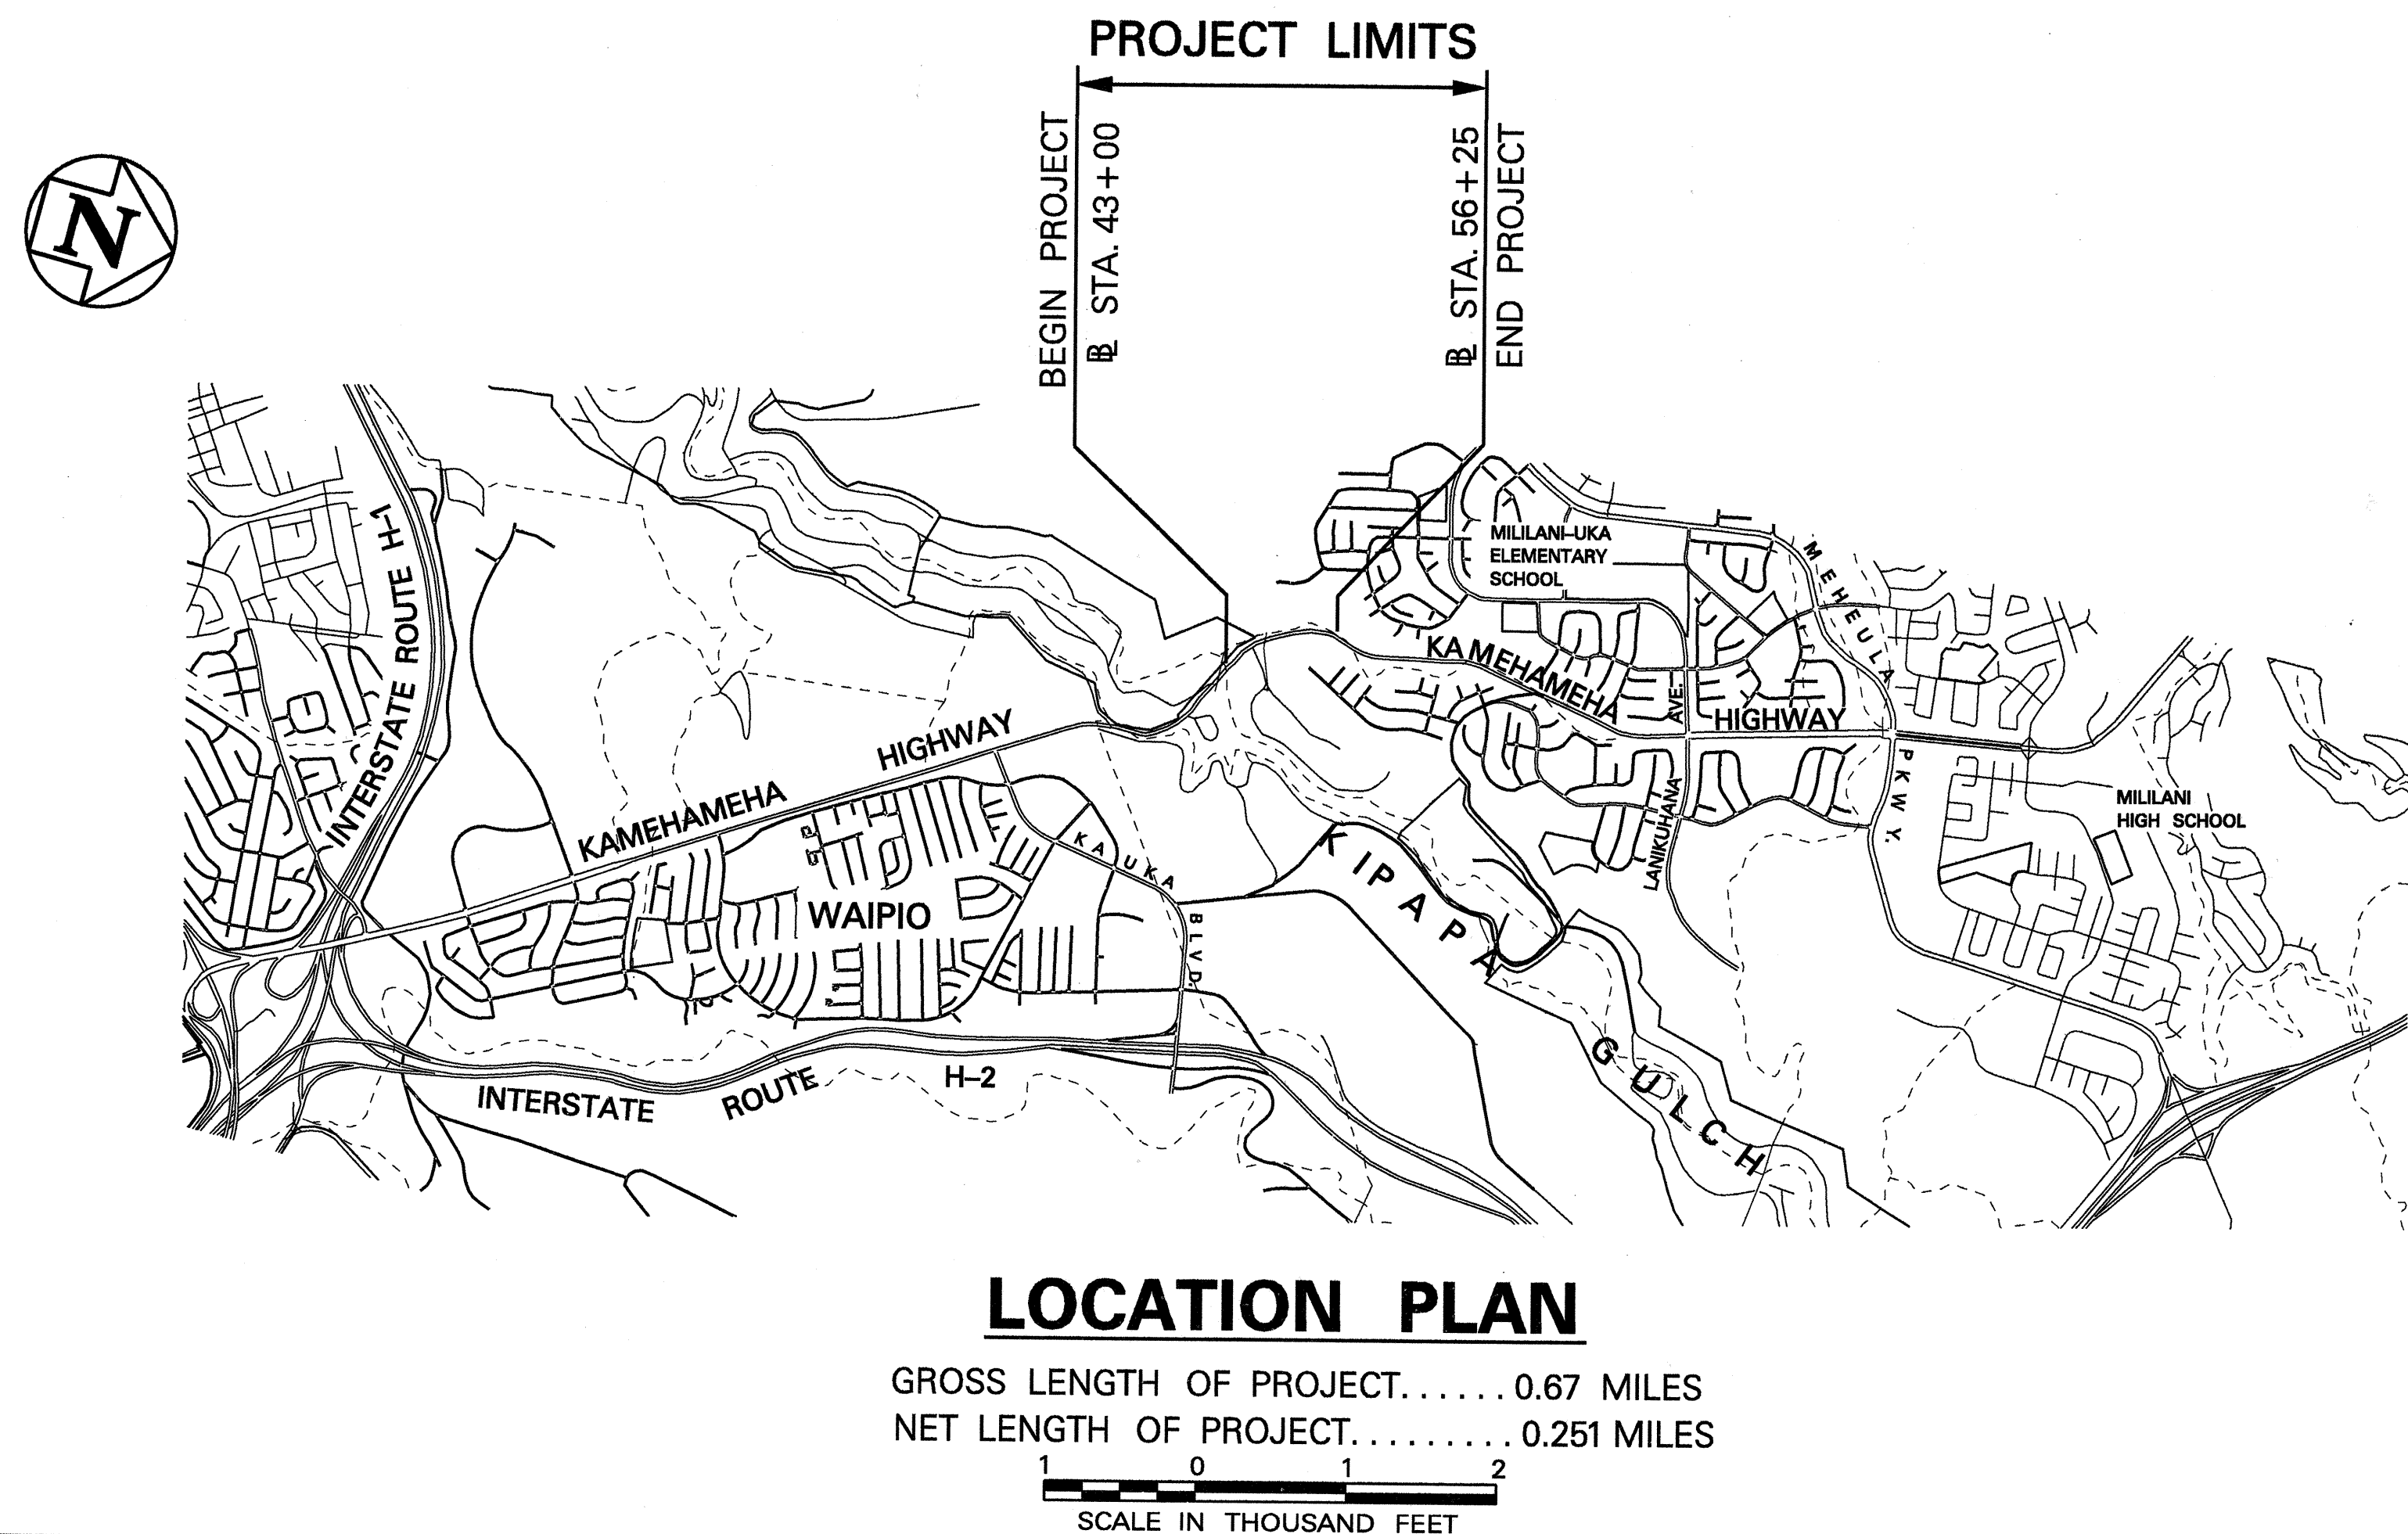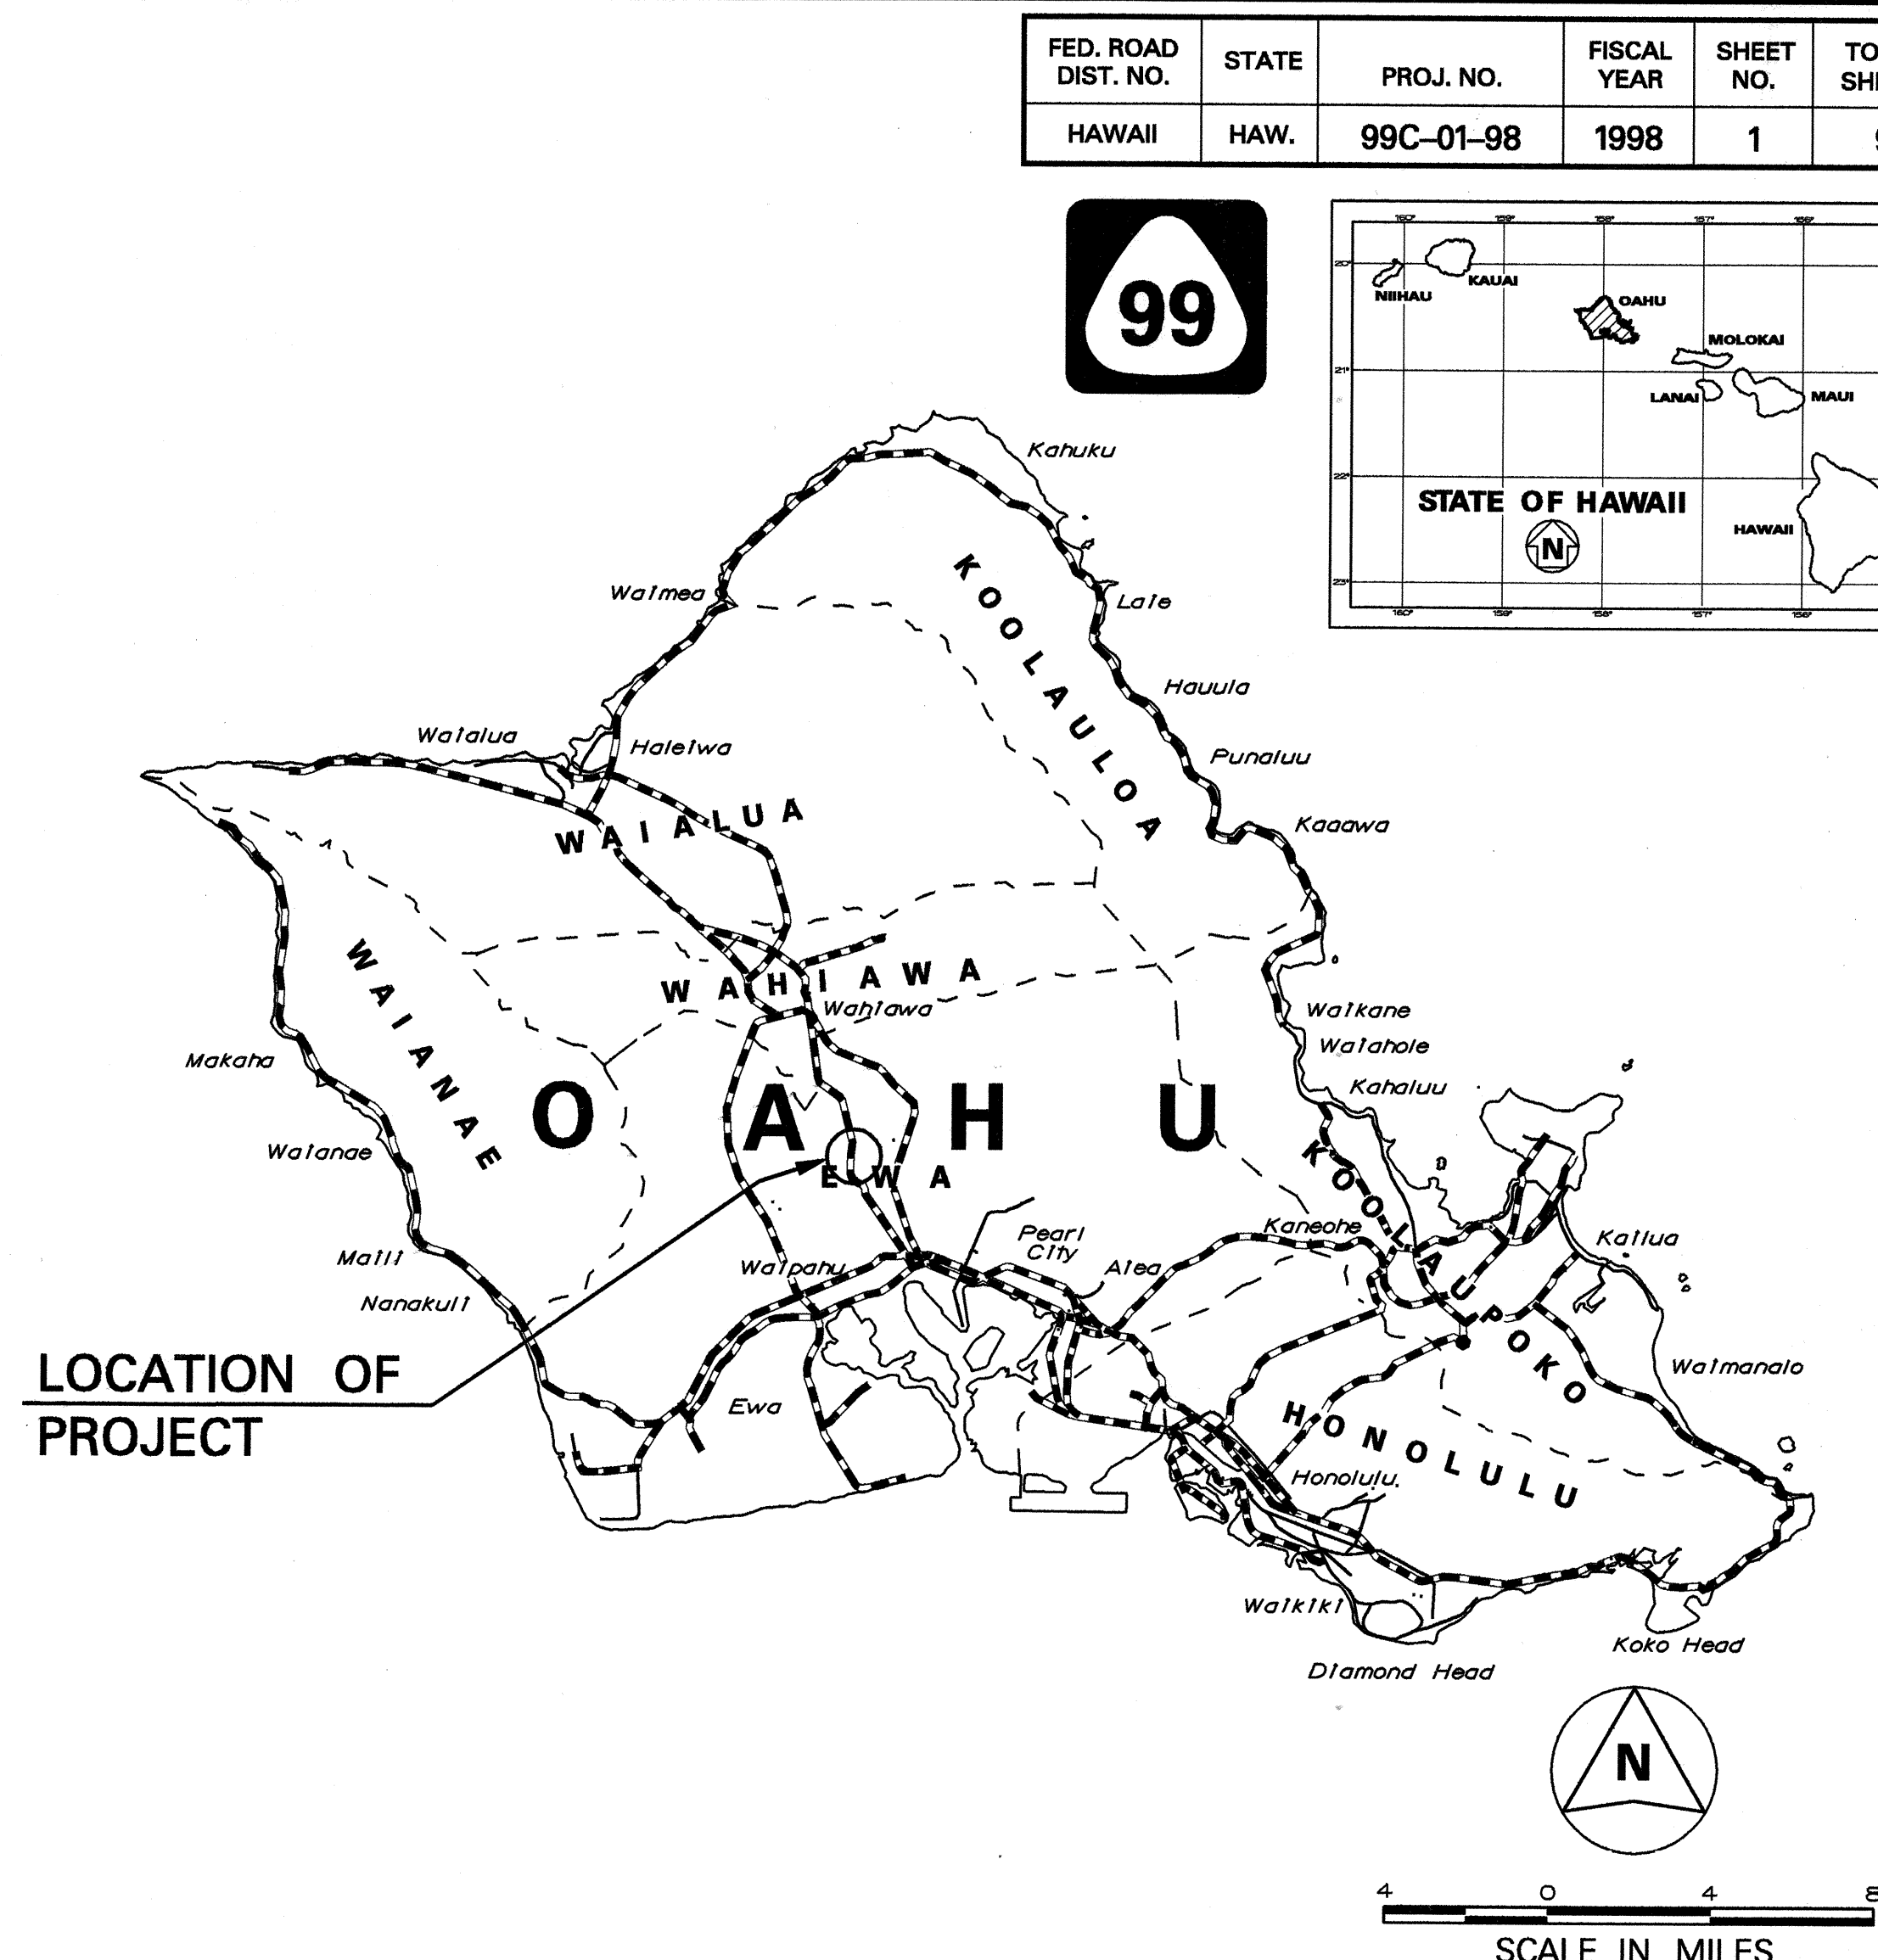

UNIT "E"

DESIGNED BY

J. FUJIMOTO

P.S. & E. BY

587-2249

PHONE

FEB. 1998

DATE