


FED. ROAD DIST. NO.	STATE	FED. AID PROJ. NO.	FISCAL YEAR	SHEET NO.	TOTAL SHEETS
HAWAII	HAW.	BR-099-1(19)	2001	ADD.20	105

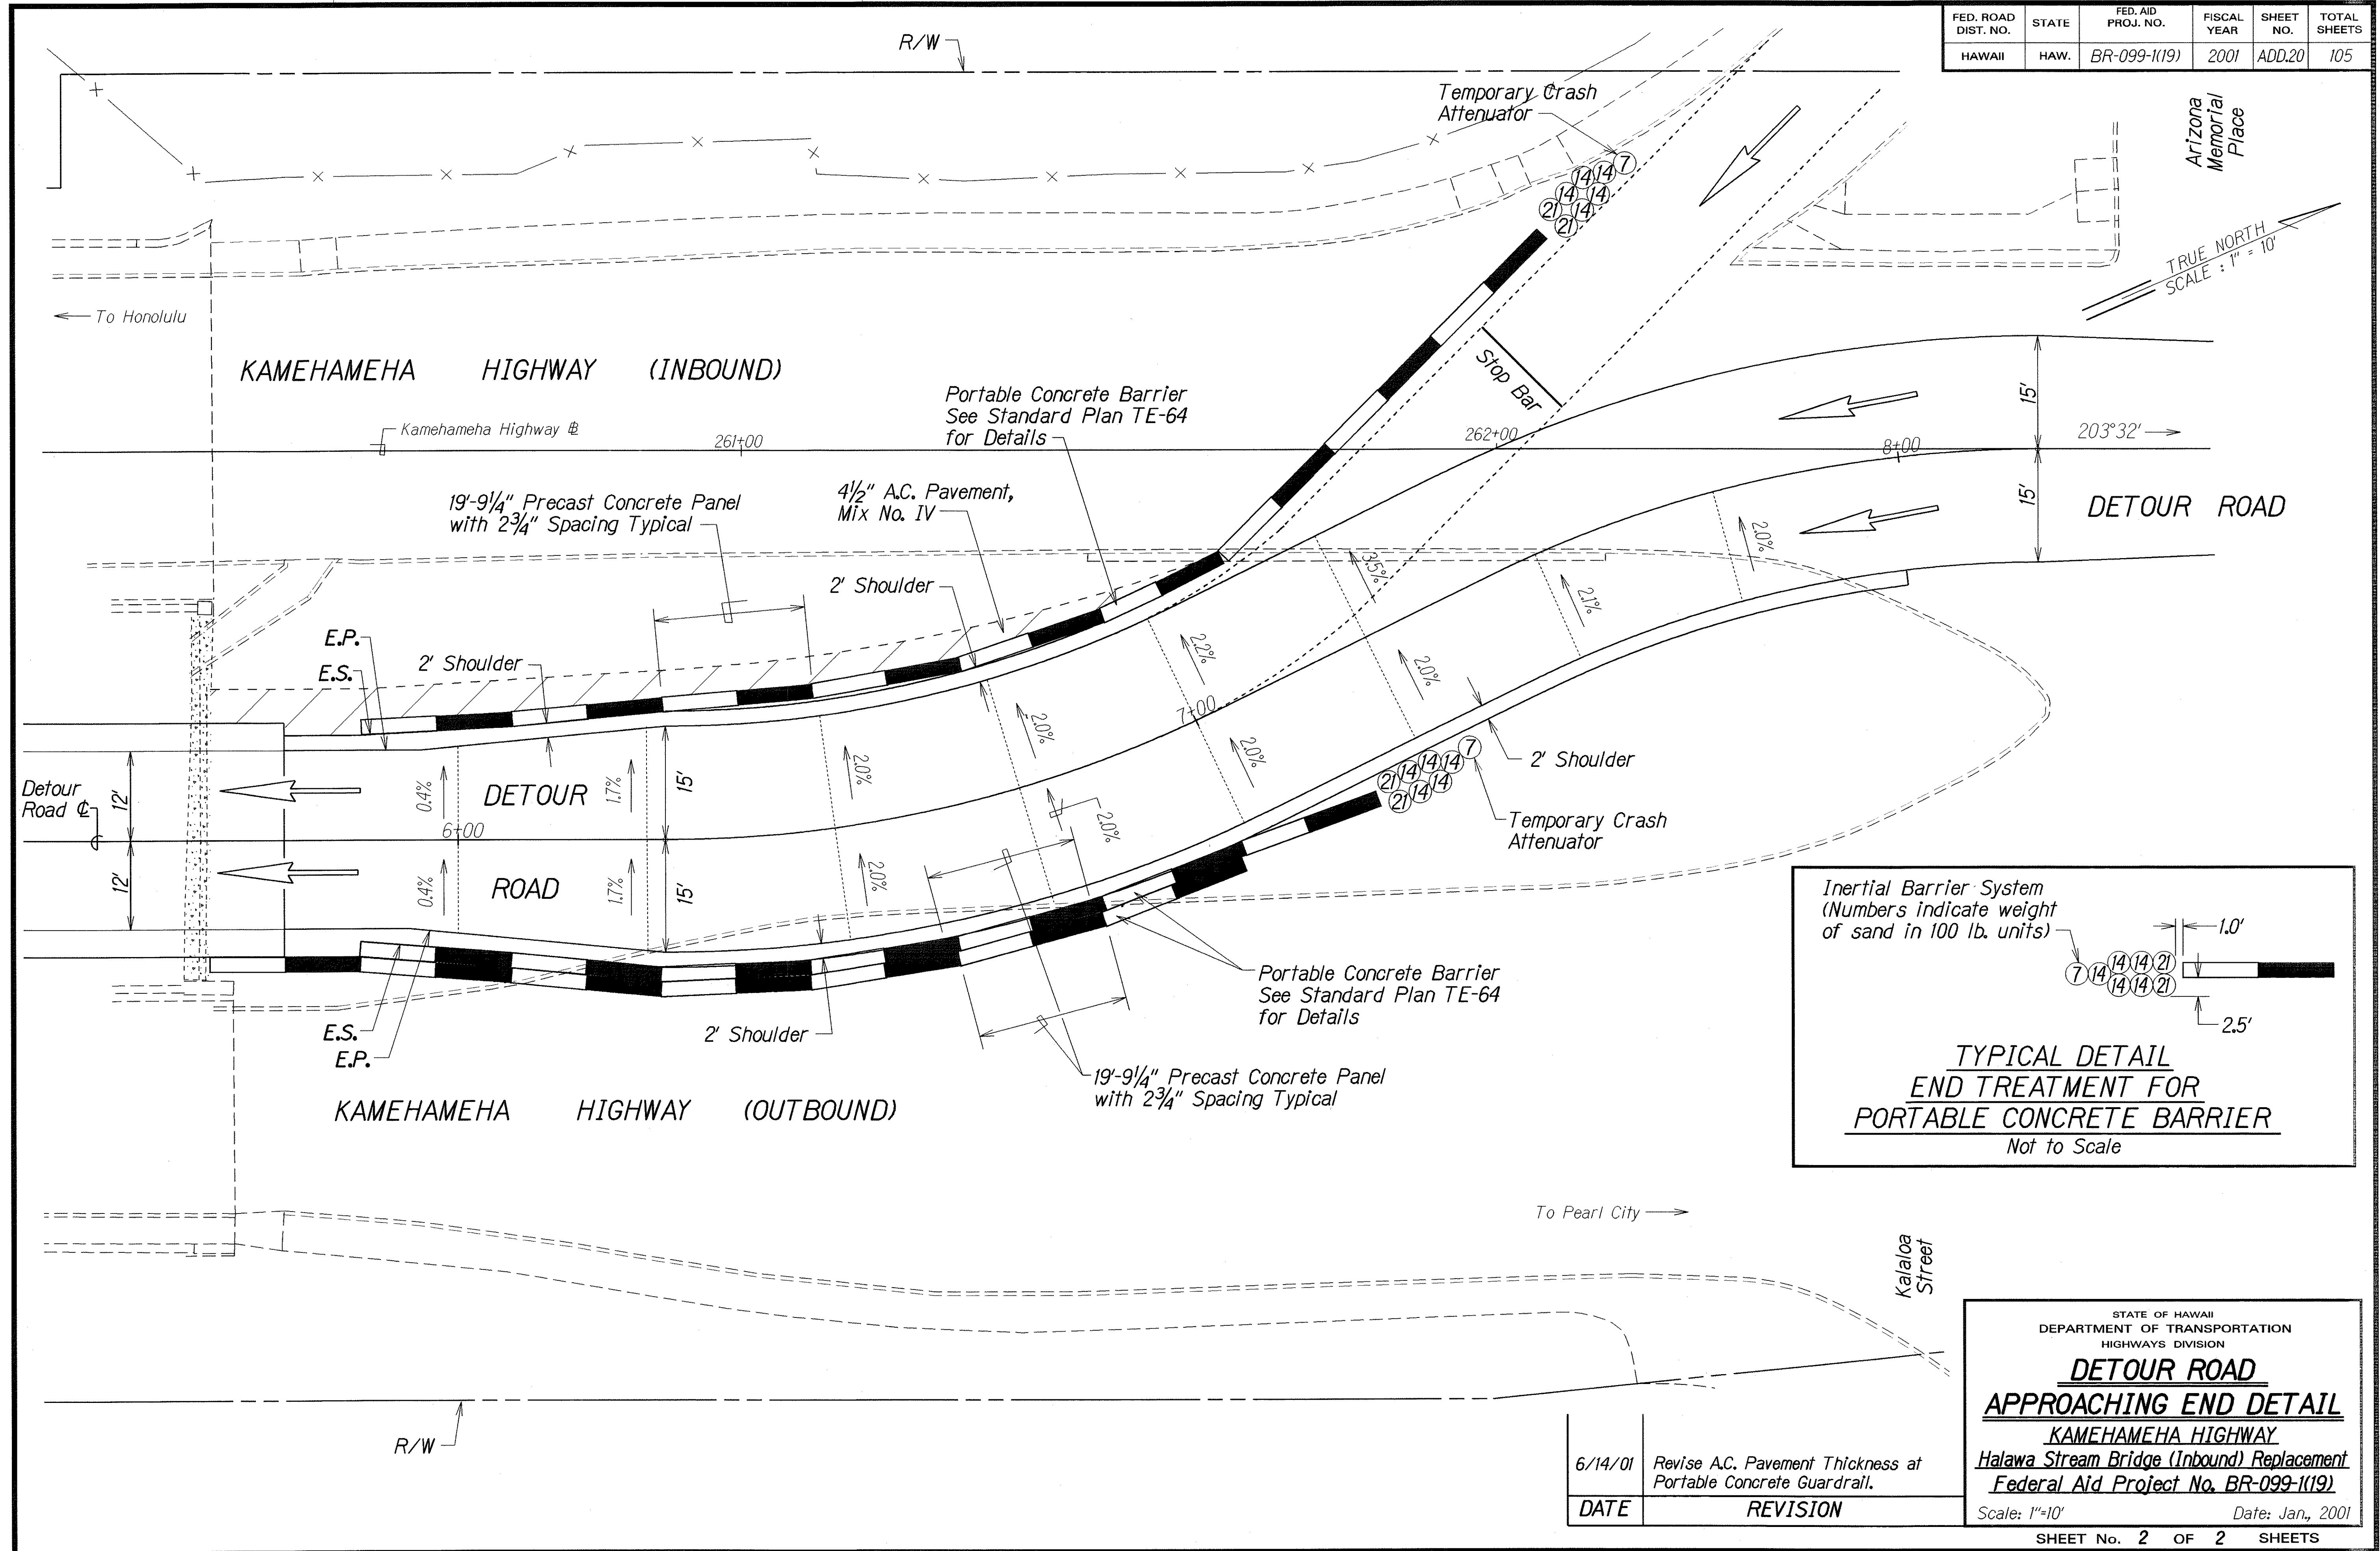

ORIGINAL PLAN	DATE	12/7/00
SURVEY PLOTTED BY		
DRAWN BY		
NOTES BOOK		
QUANTITIES BY		
CHECKED BY		