


FED. ROAD DIST. NO.	STATE	FED. AID PROJ. NO.	FISCAL YEAR	SHEET NO.	TOTAL SHEETS
HAWAII	HAW.	BR-099-1(19)	2001	ADD.104	105

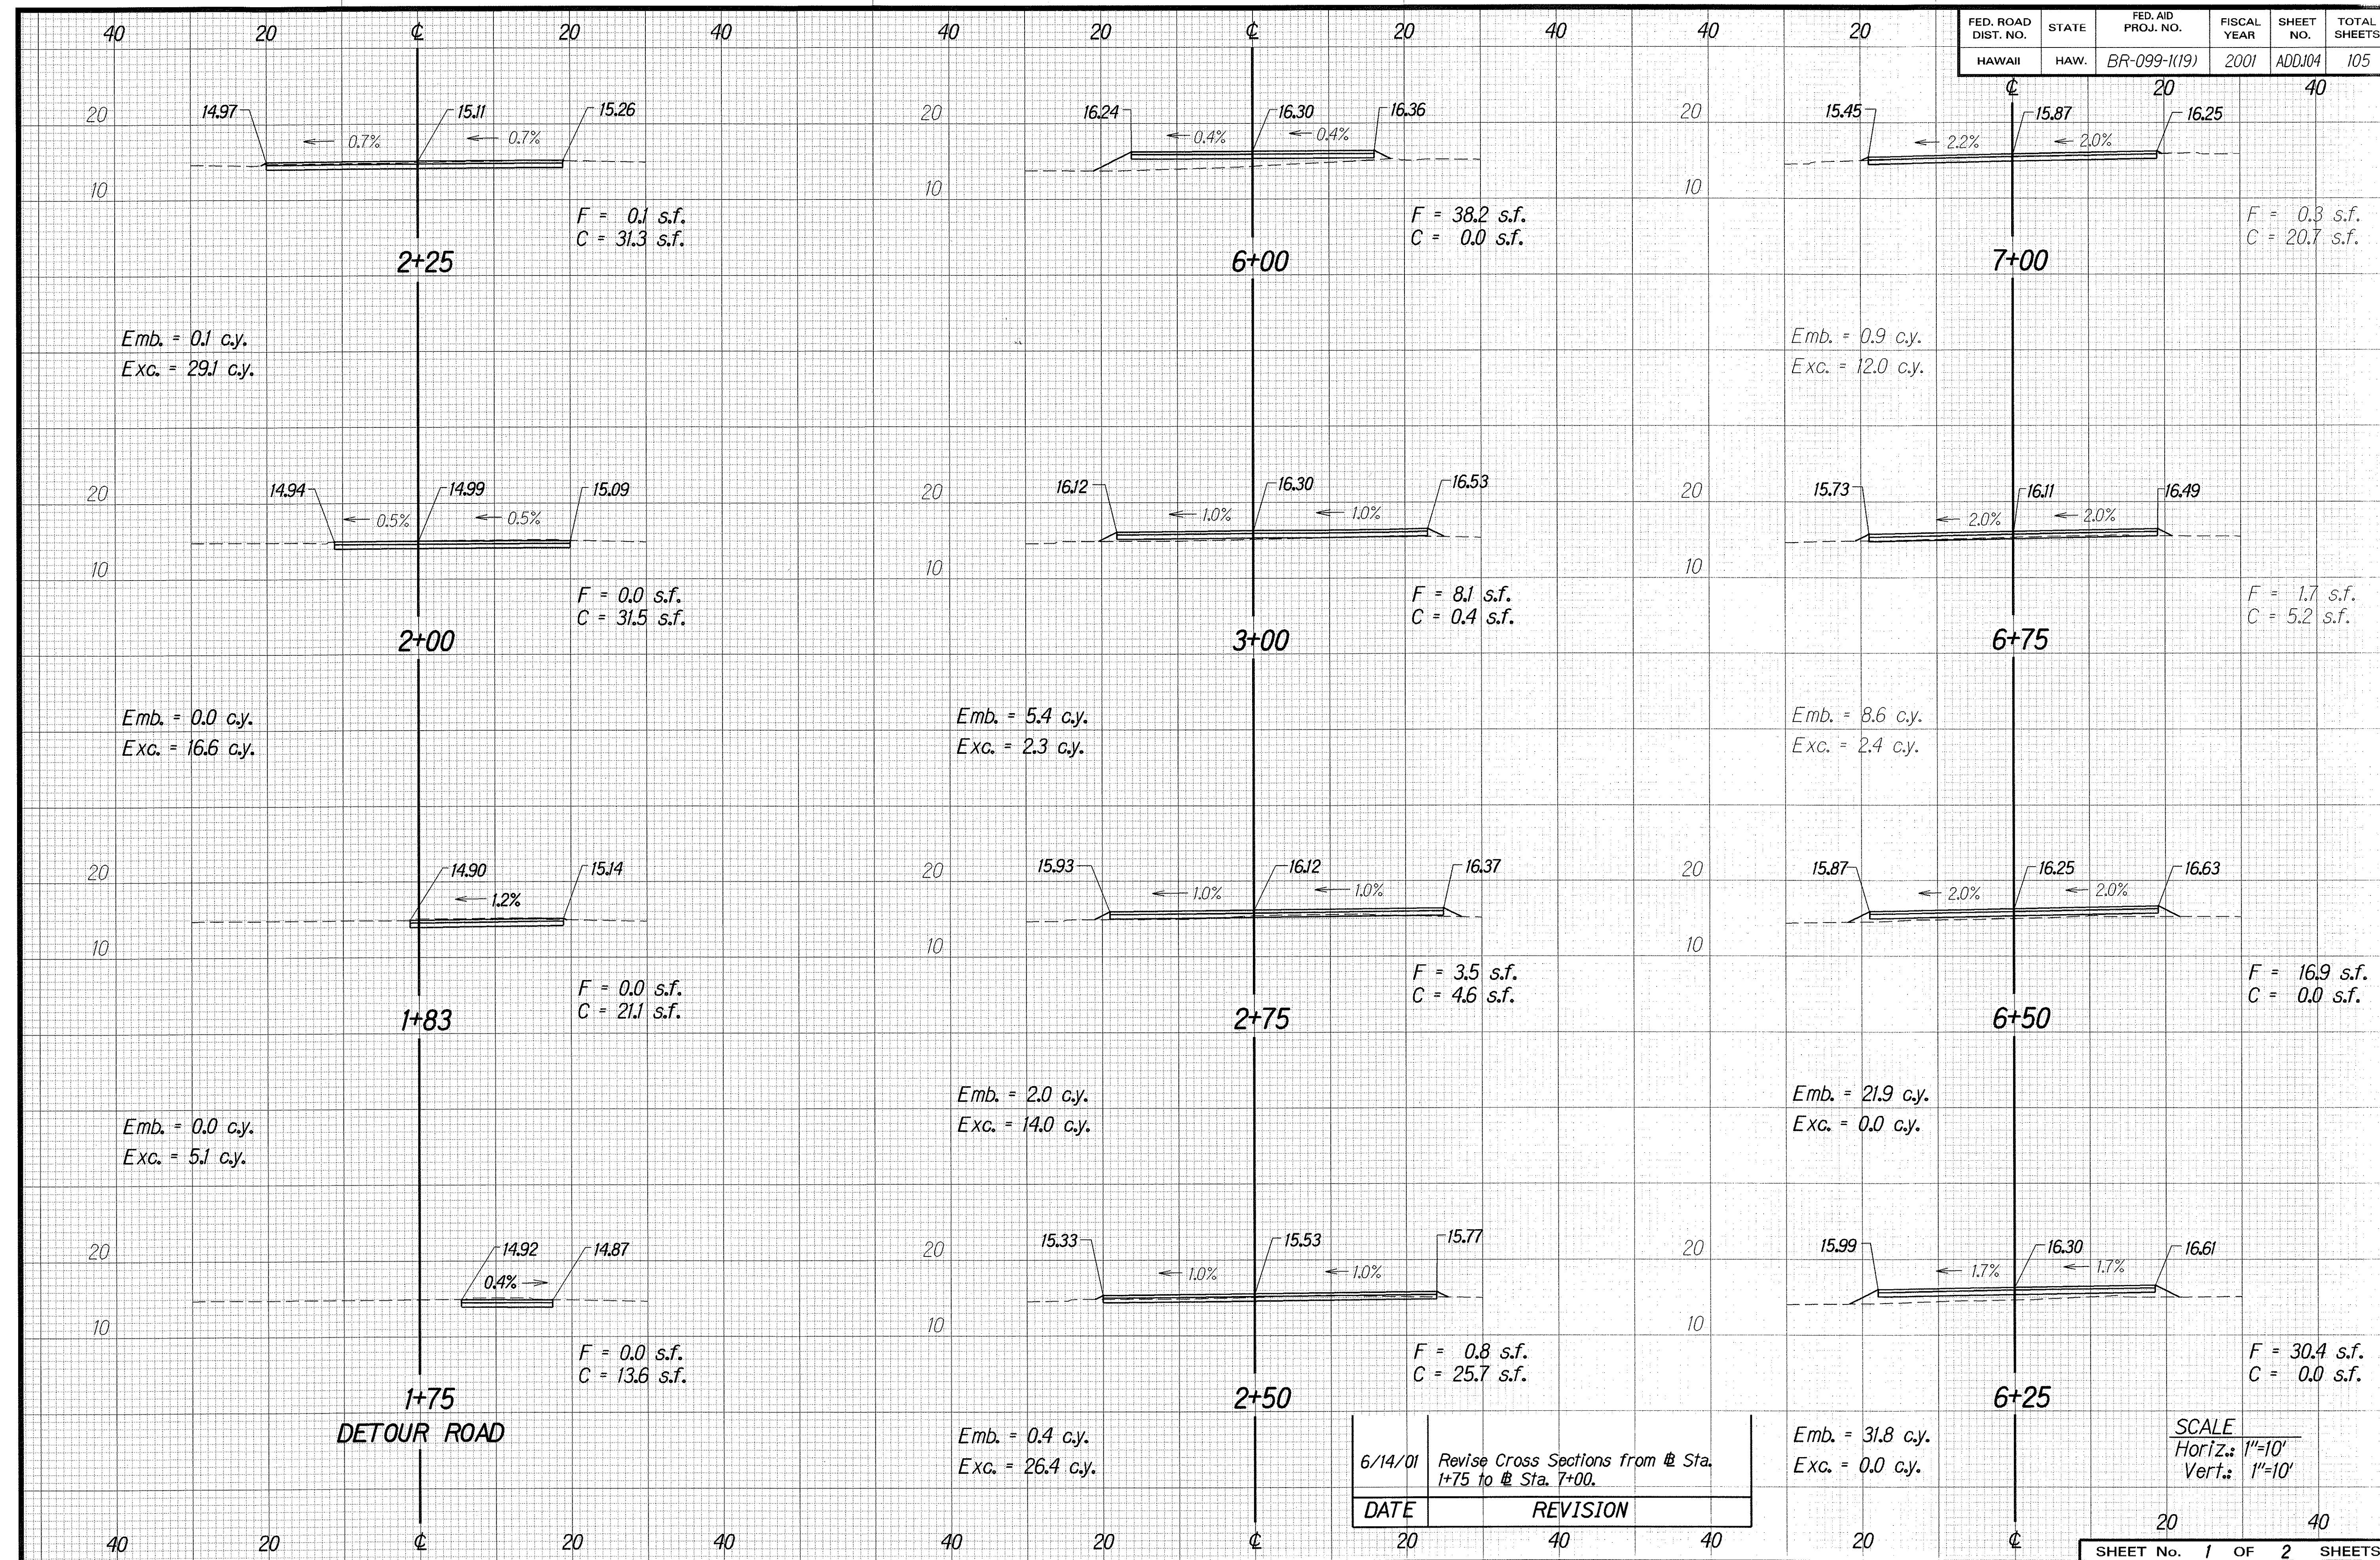




ORIGINAL PLAN	DATE	11/20/01
SURVEY PLOTTED BY	DESIGNED BY	2/11/2001
NOTE BOOK	CHECKED BY	
QUANTITIES BY		

6/14/01	Revise Cross Sections from Sta. 1+75 to Sta. 7+00.
DATE	REVISION

SCALE
 Horiz.: 1"=10'
 Vert.: 1"=10'

FED. ROAD DIST. NO.	STATE	FED. AID PROJ. NO.	FISCAL YEAR	SHEET NO.	TOTAL SHEETS
HAWAII	HAW.	BR-099-1(19)	2001	ADD.105	105

40 20 0 20 40

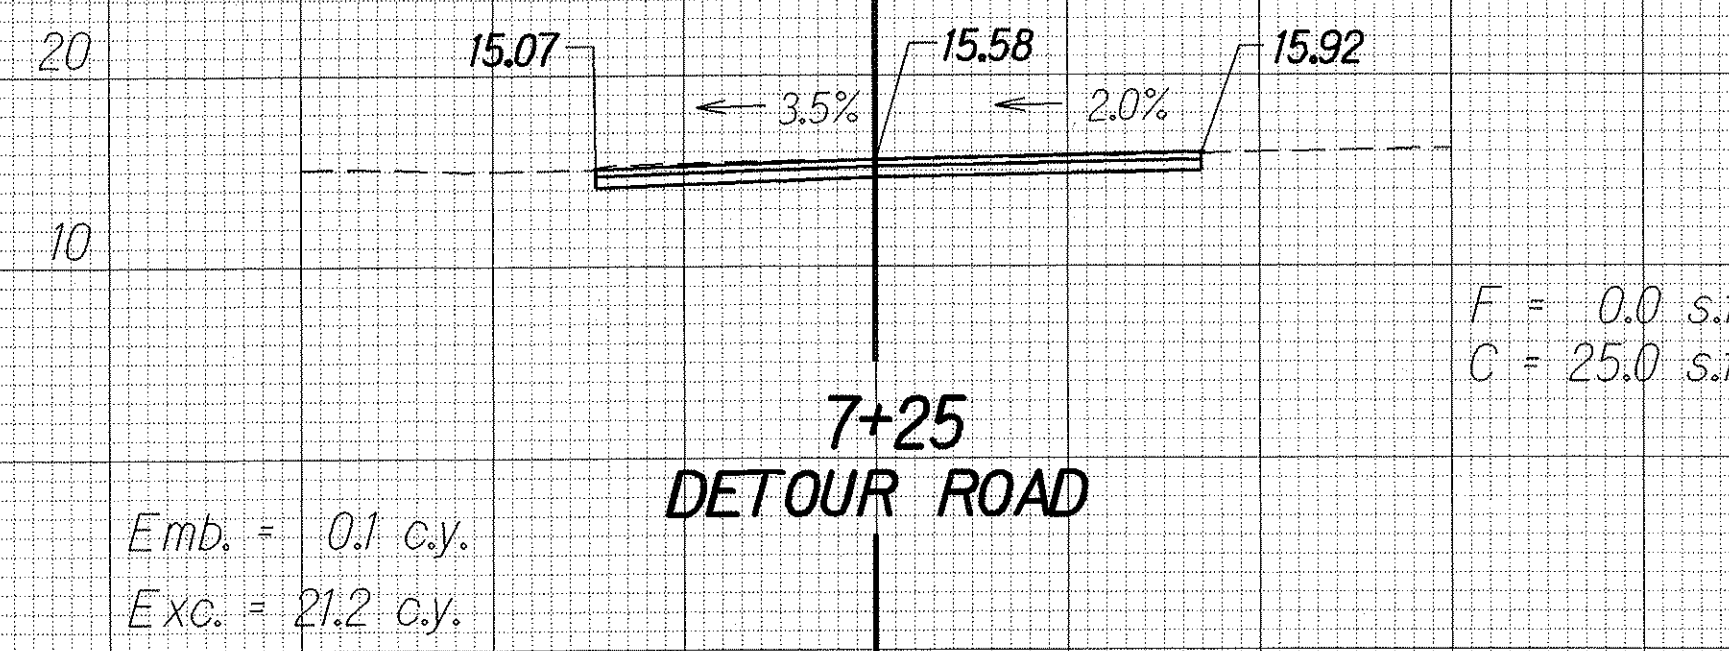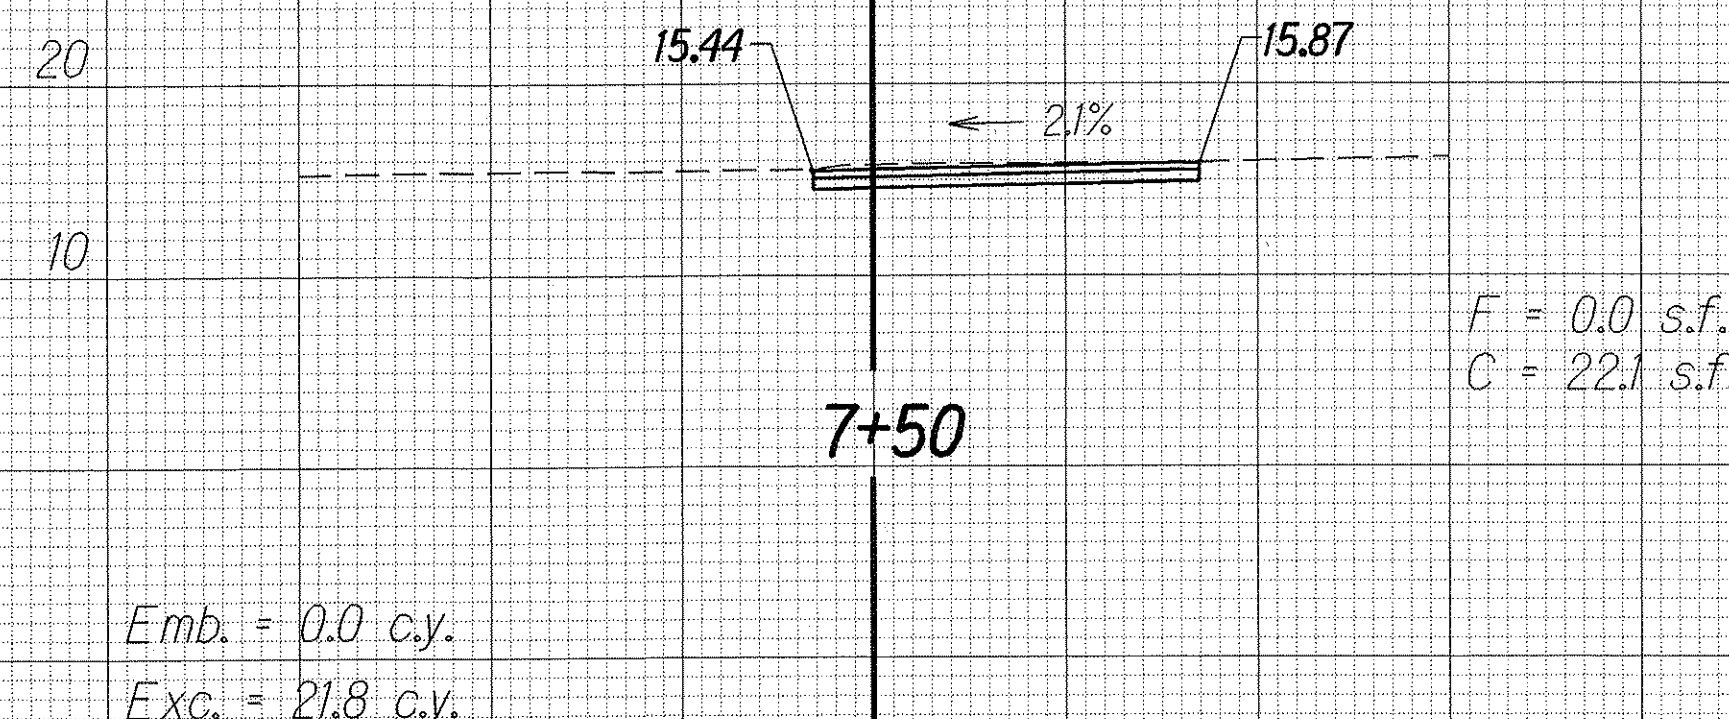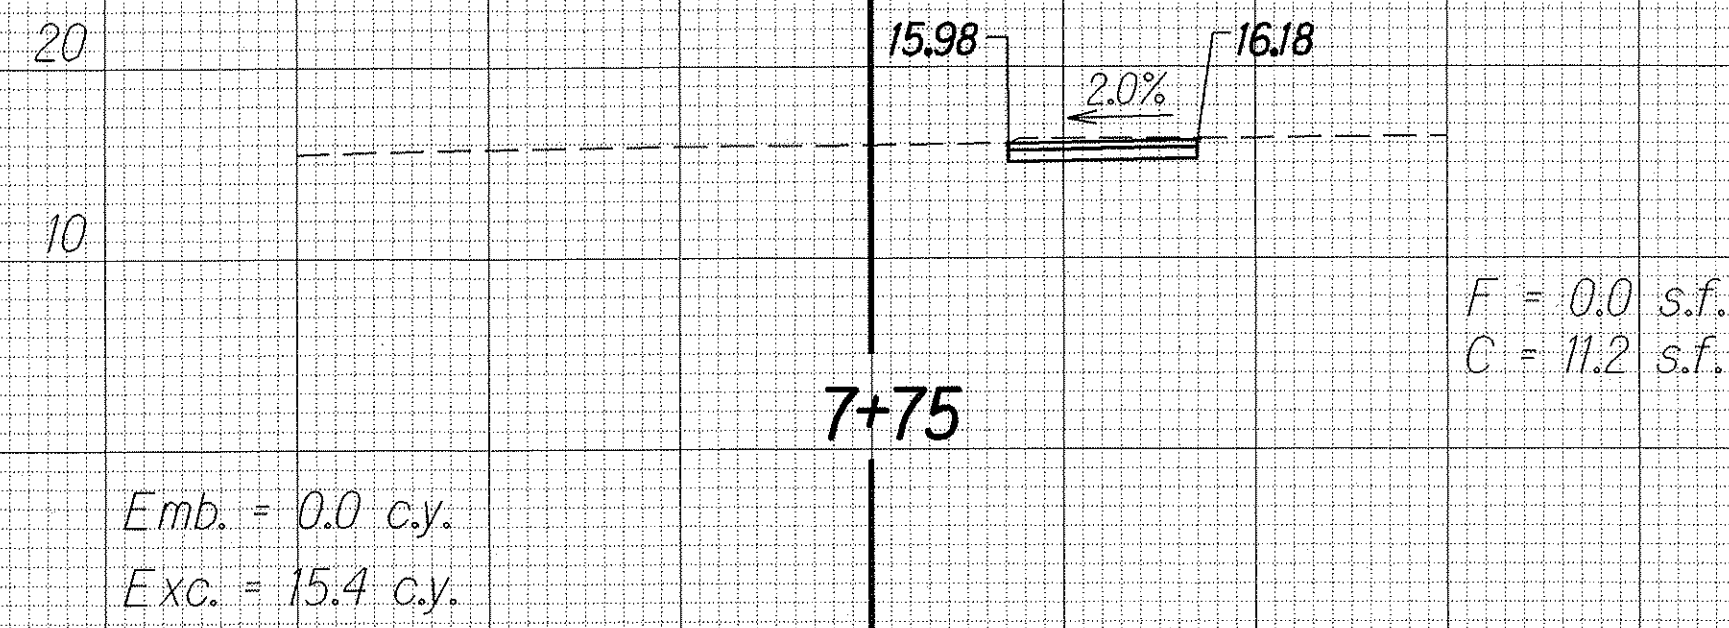

DETOUR ROAD

DESIGNED BY	DATE
12/23/01	
TRACED BY	
DESIGNED BY	
QUANTITIES BY	
CHECKED BY	

6/14/01	Revise Cross Sections from Sta. 7+25 to Sta. 7+75.
DATE	REVISION

SCALE
Horiz.: 1"=10'
Vert.: 1"=10'